



DETAIL 3

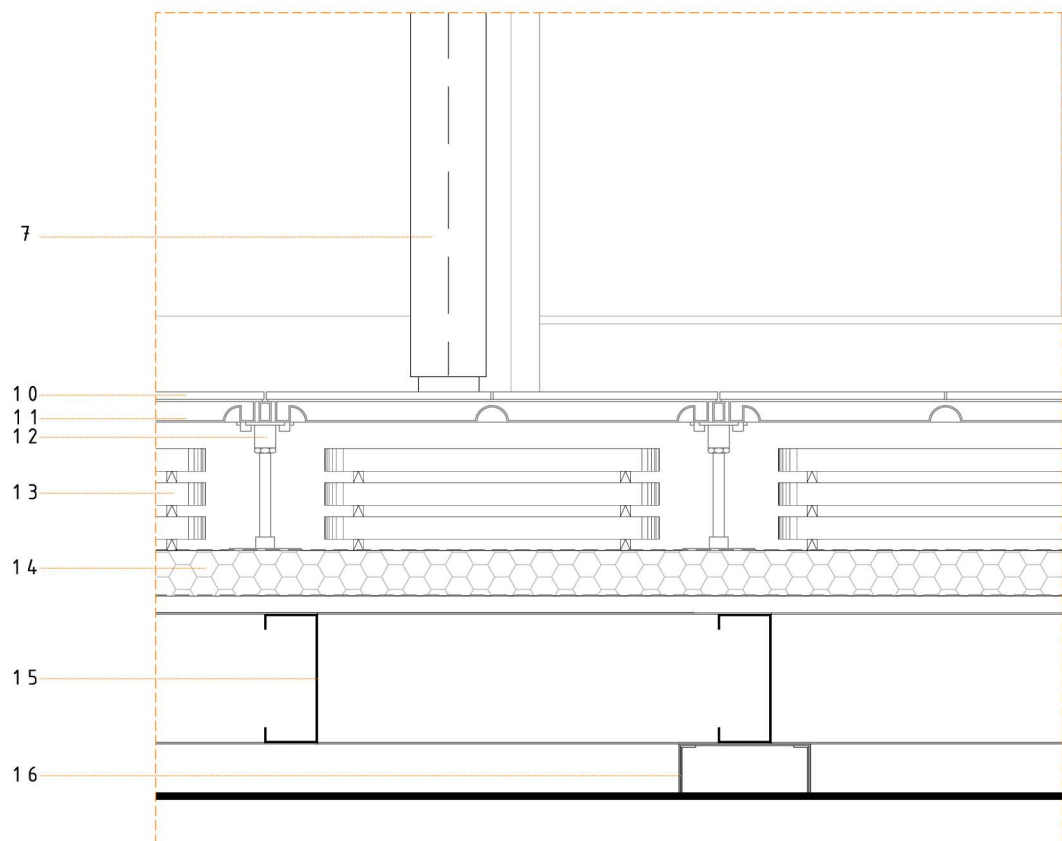

DETAIL 4

LEGEND


- 01. TRUSS
- 02. ANTI DRIFT SHEET
- 03. PVC WATERPROOFING
- 04. 40.80.3mm LAMINATED STEEL TUBE
- 05. 112.70.1mm C-SHAPED STEEL JOIST
- 06. MOVABLE WALL TRACK
- 07. MOVABLE WALL
- 08. 100mm-THICK GLASS WOOL
- 09. ALMOND SHELL PANEL
- 10. 600x300mm CERAMIC TILE
- 11. 600x600mm CAST IRON BASE
- 12. FLOOR PLOT
- 13. CHANGE-OF-PHASE GEL CAPSULES
- 14. 60mm thick WOOD-FIBER INSULATION
- 15. 170.70.20.2mm C-SHAPED STEEL JOIST
- 16. 60mm-THICK WOOD FIBER INSULATION
- 17. FOOTING: C-SHAPED STEEL JOIST 170.70.20.2mm + U-SHAPED STEEL JOIST 170.70.2mm

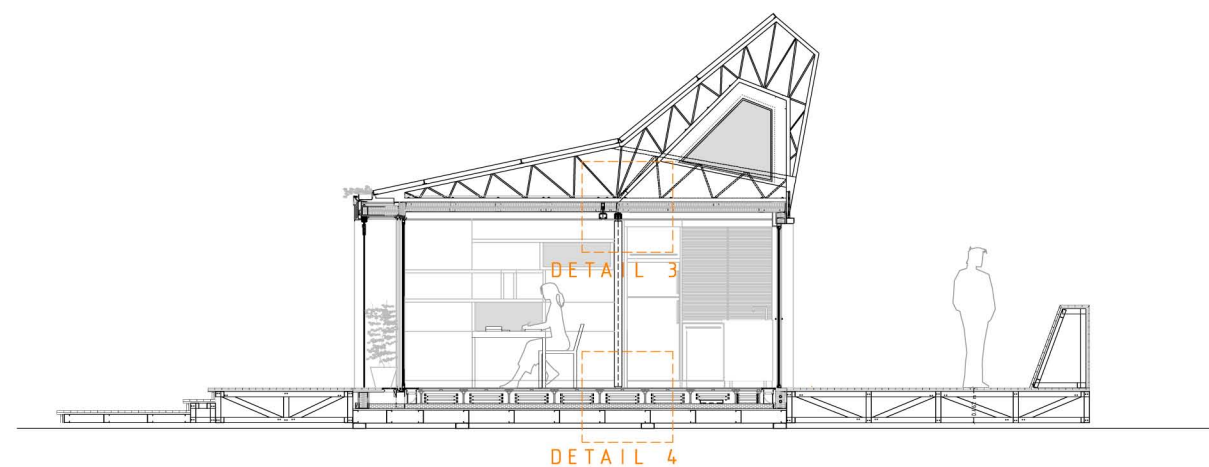


SCALE 1:100

BC - 34

DATE: 08.04.2005

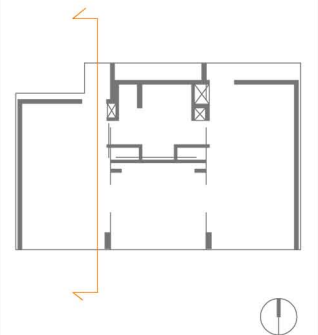

SCALE_1:10

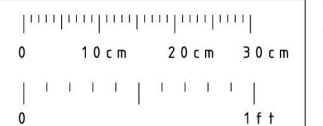

RAFAEL PALOMARES
CARLOTREZZO
plan designer

CARLOS BERMEJO
design coordinator

MIGUEL GOMEZ
general coordinator

JOE WORCESTER
professional engineer

ALFONSO GARCIA-SANTOS
construction manager

JAVIER NEILA
architecture manager

ESTEFANIA CAAMAÑO
general coordinator

CONSTRUCTION DETAILS



Universidad Politécnica de Madrid (UPM)