
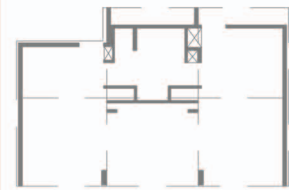


CONCEBIDO EN 2005 UPM

FCA-02


DATE: 08.04.2005





FCA-02 01/02

SCALE 1:40

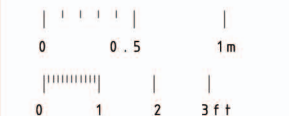

1:40

COORDINATORS SUPERVISORS

HELDER J. MARTINS  
plan designer

CARLOS BERMEJO  
design coordinator

MIGUEL GOMEZ  
general coordinator


COORDINATORS SUPERVISORS

ALFONSO GARCIA-SANTOS  
construction manager

JAVIER NEILA  
architecture manager

ESTEFANIA CAAMAÑO  
general coordinator

FOOTPRINT FOLDED LAYOUT



unfolding under the sun

Universidad Politécnica de Madrid (UPM)