



TO MADISON STREET

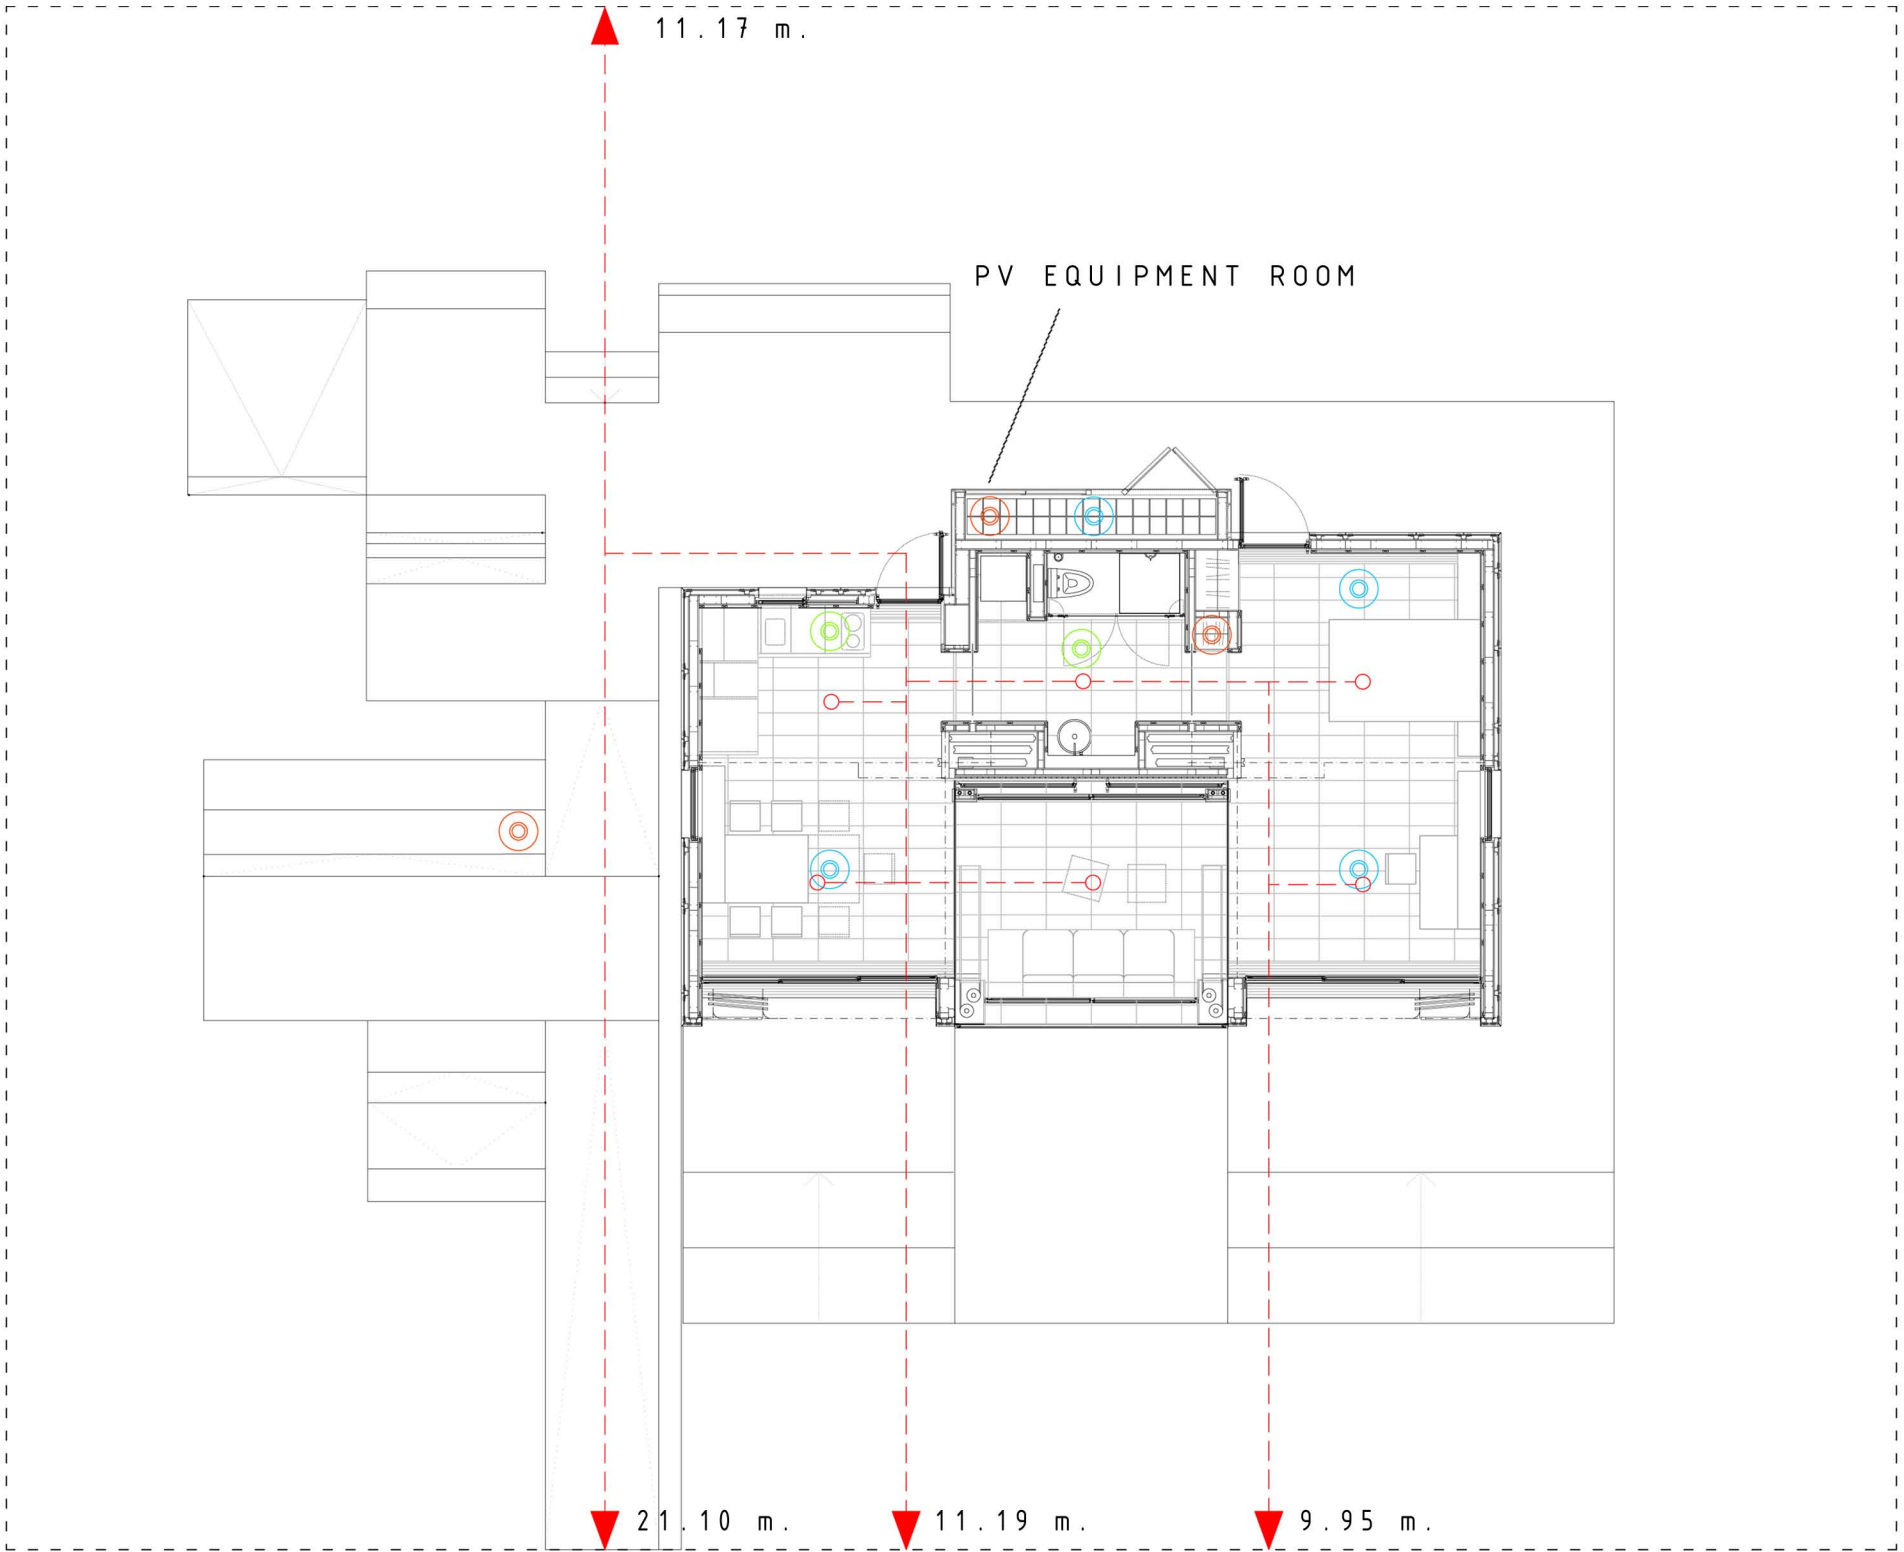

- FIRE EXTINGUISHERS
- SMOKE DETECTORS
- OPTICAL DIFFERENTIAL TEMPERATURE DETECTOR
- START POINTS
- ▶ EXIT ROUTE

TO DECATHLETE WAY  
LONGER EXIT ROUTE 21.10 m.

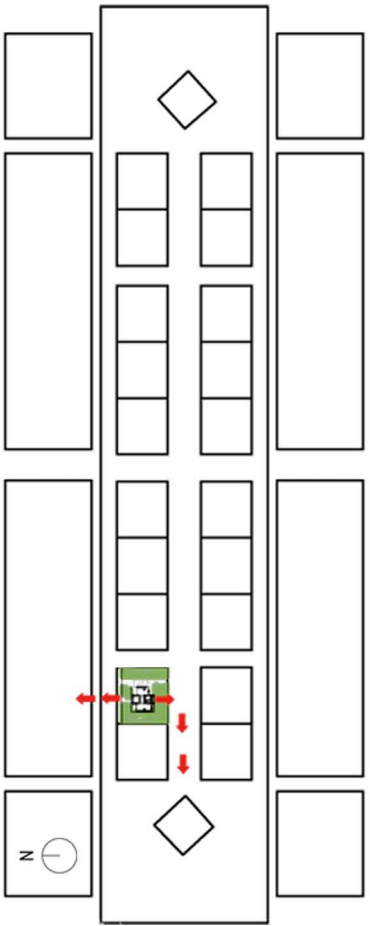

FIRE EVACUATION PLAN



SM-65


DATE: 08.04.2005



01/01

SM-65

SCALE 1:100

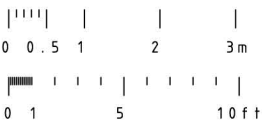

1:100

IVÁN ALCANTARILLA  
plan designer

CARLOS BERMEJO  
design coordinator

MIGUEL GOMEZ  
general coordinator

ALFONSO GARCIA-SANTOS  
construction manager

JAVIER NEILA  
architecture manager

ESTEFANIA CAAMAÑO  
general coordinator

FIRE SAFETY AND EVACUATION PLAN



unfolding under the sun  
Universidad Politécnica de Madrid (UPM)