


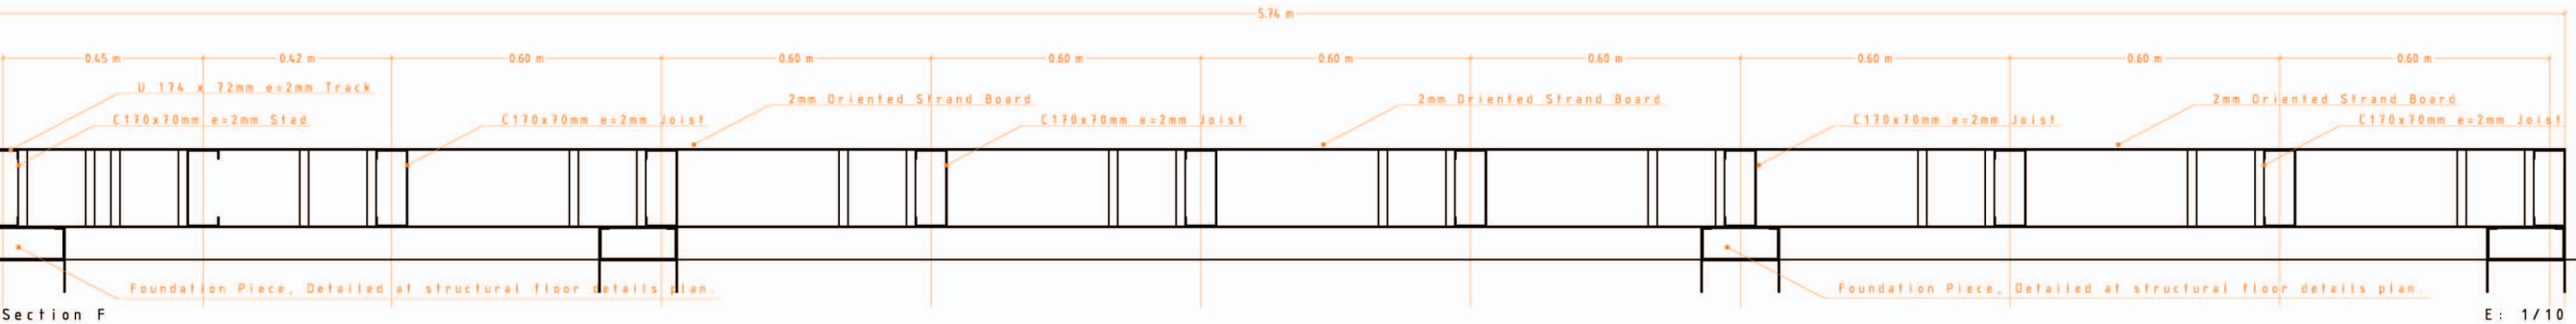
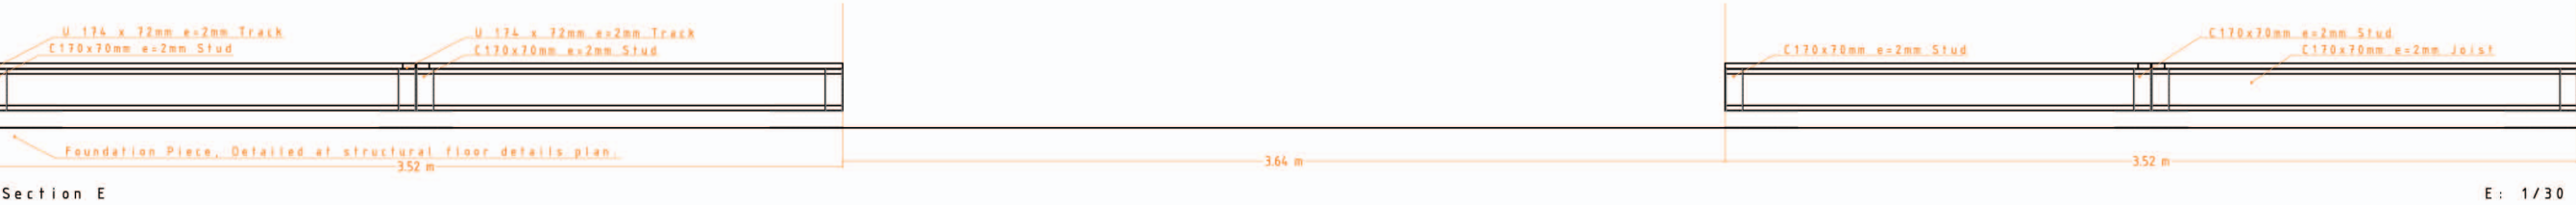
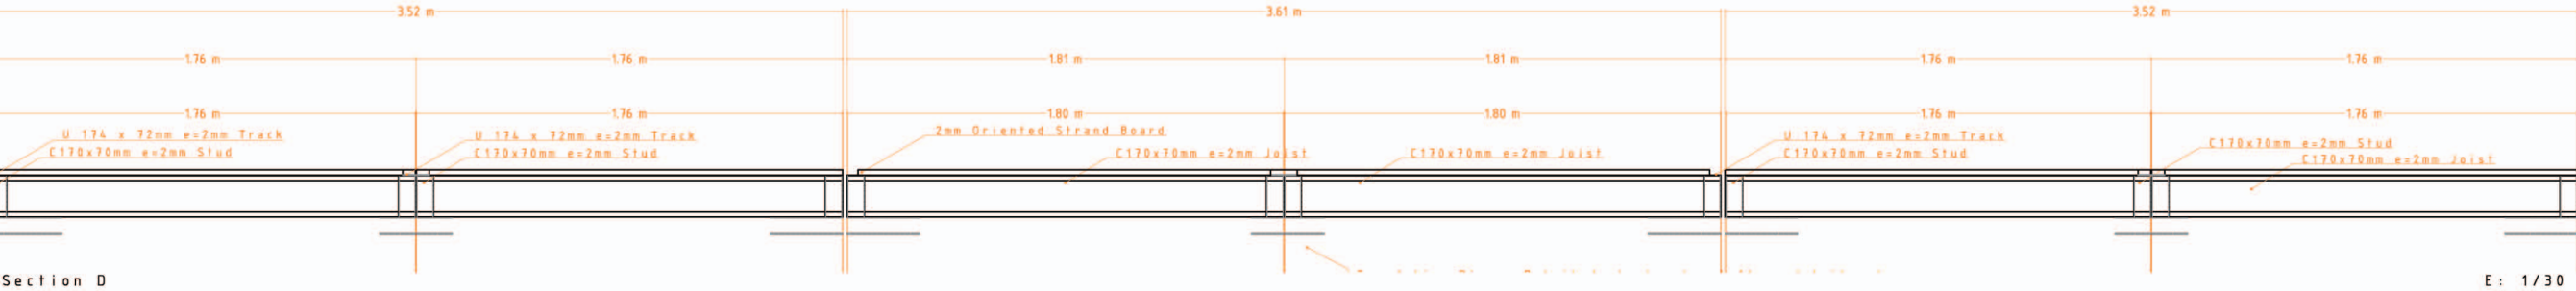
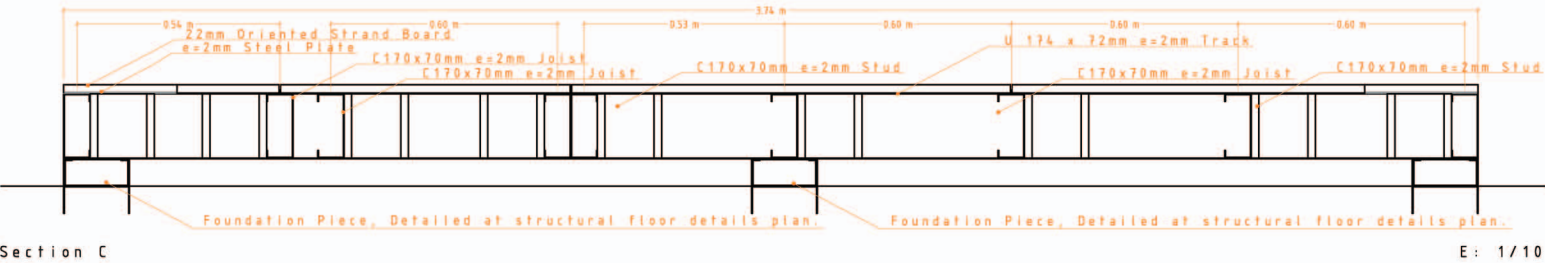



GROUND FLOOR- MAIN SECTIONS

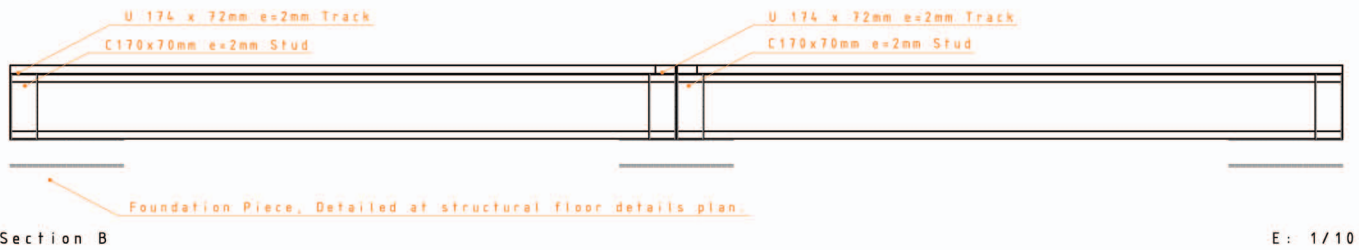

Schematic structural floor plan.

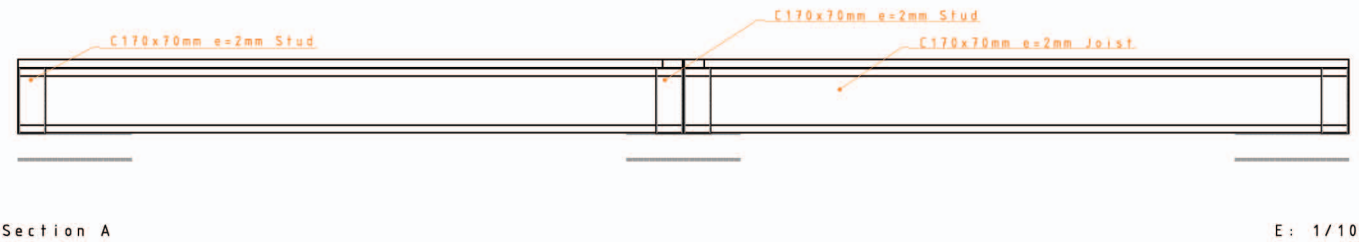


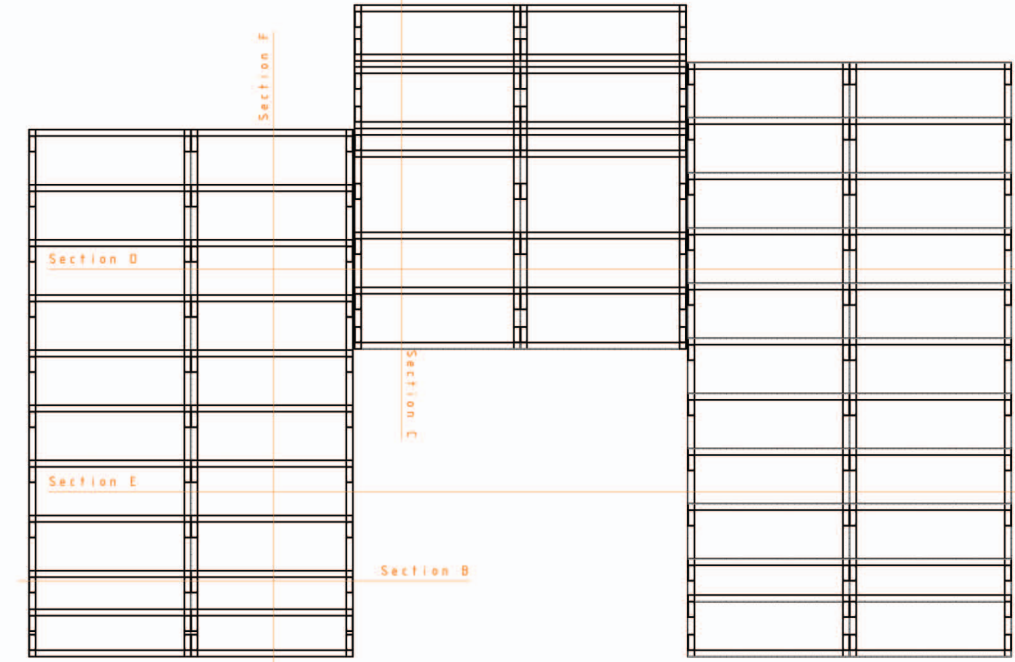

2005 UPM Madrid

S - 18

DATE: 08.04.2005

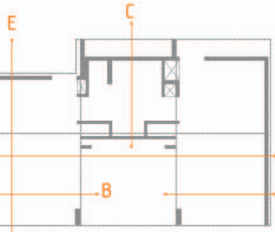

SCALE_1:30

JOAQUIN HIDALGO
plan designer

CARLOS BERMEJO
design coordinator

MIGUEL GOMEZ
general coordinator

JOE WORCESTER
professional engineer

ALFONSO GARCIA-SANTOS
construction manager

JAVIER NEILA
architecture manager

ESTEFANIA CAAMAÑO
general coordinator

magic BOX

unfolding under the sun

Universidad Politécnica de Madrid (UPM)

GROUND FLOOR STRUCTURE