


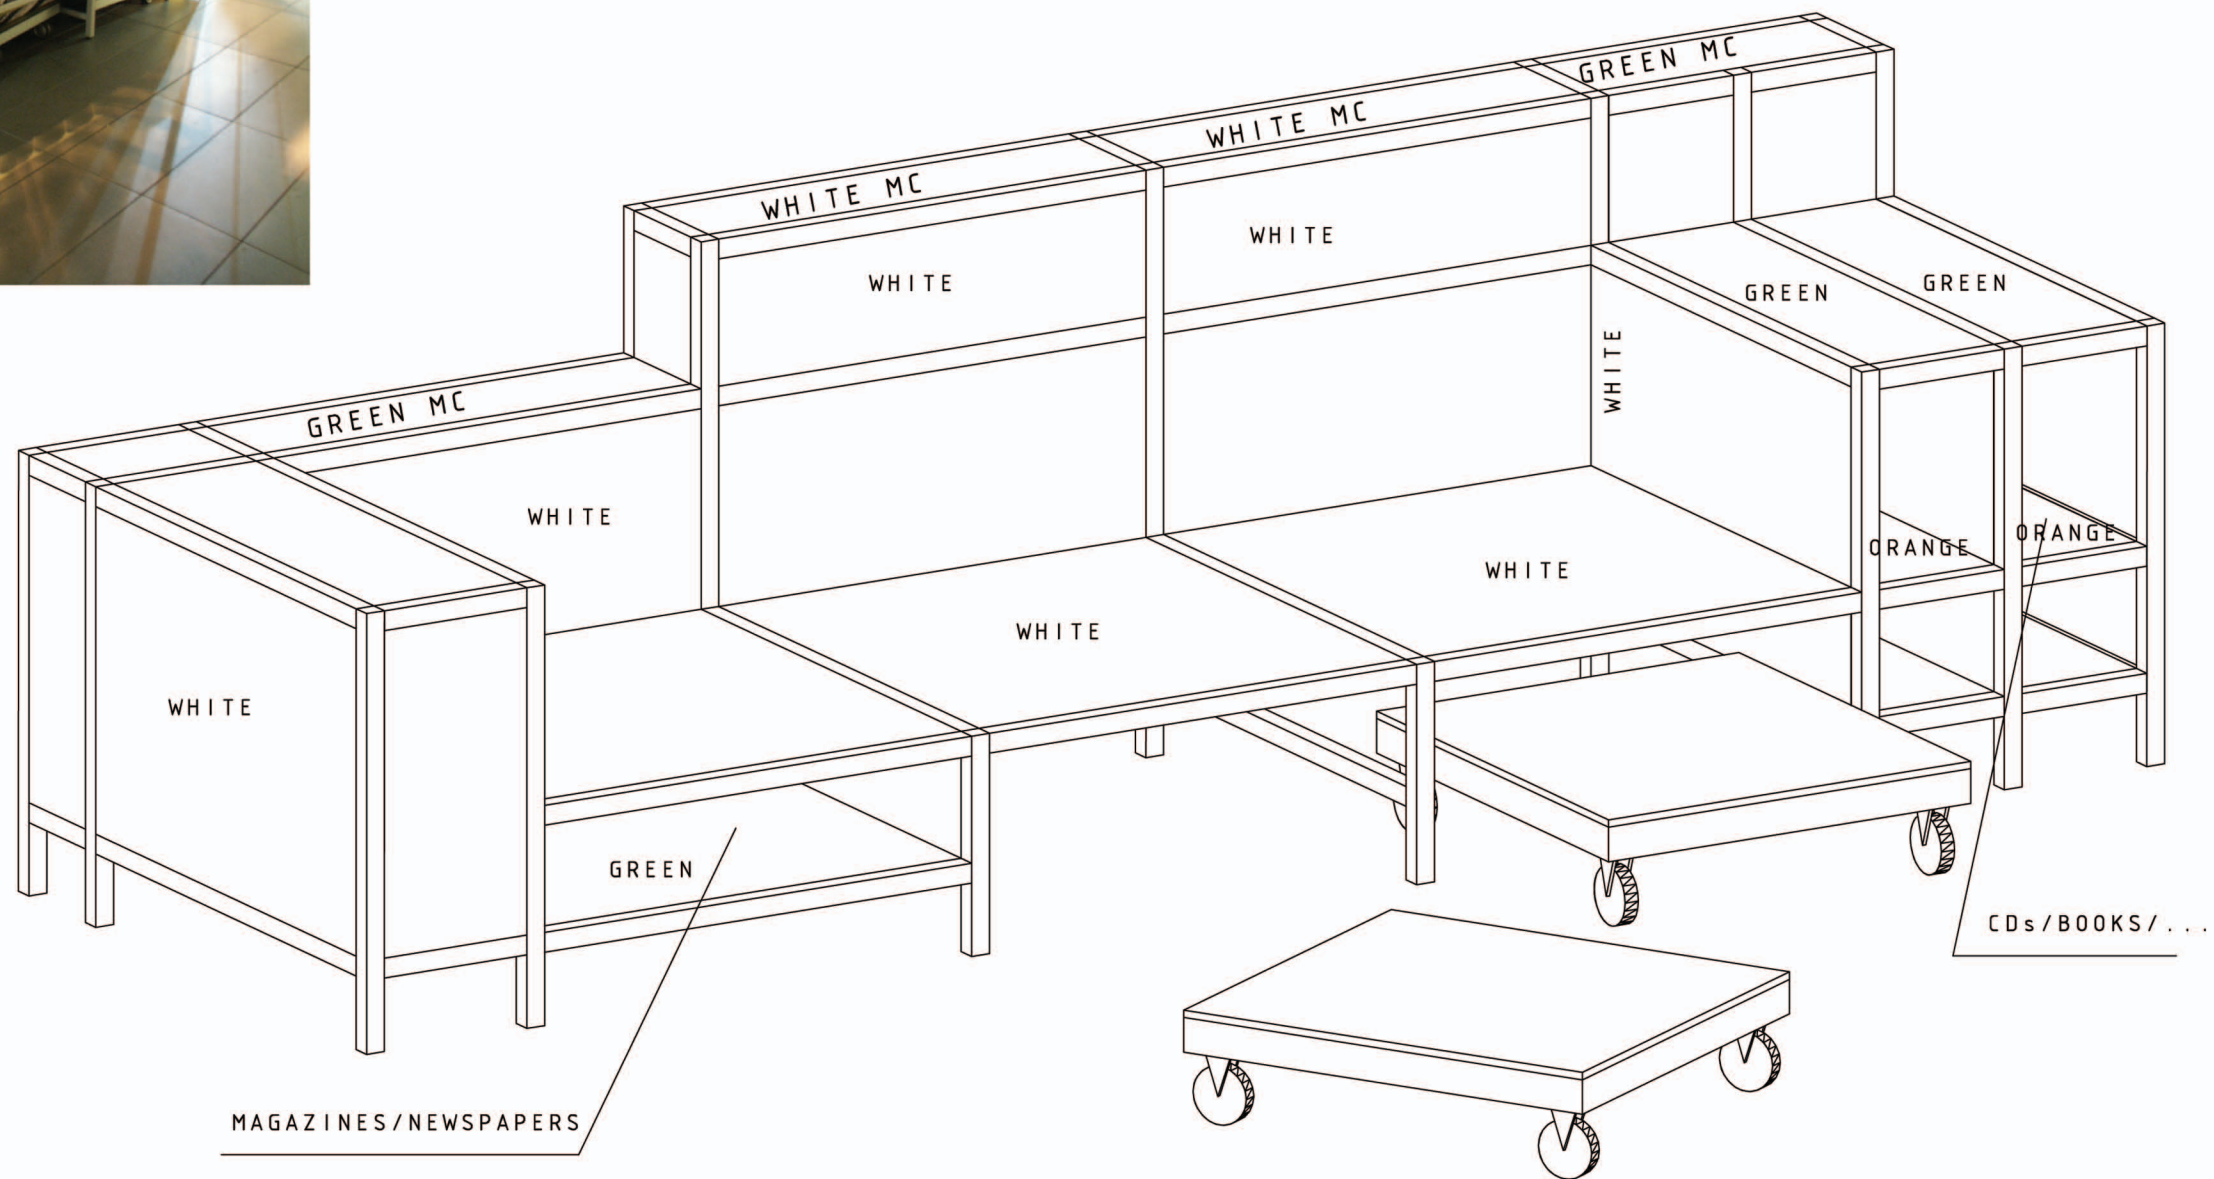

THREE-SEAT COUCH 273x71(+20)x30(+30+20)cm
 ALUMINUM STRUCTURE
 WHITE, GREEN FINISH
 WHITE, GREEN AND ORANGE METHACRYLATE
 2 MOVABLE PIECES 55x60x10cm

CUSHIONS_RECYCLED TRUCK-COVER CANVAS




LOUNGE




BC - 40

DATE: 2005.02.04

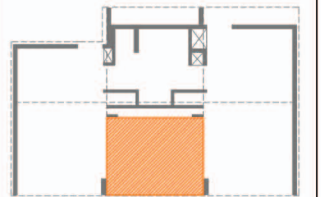

SCALE_1:10

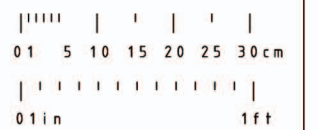

DESIGNER
 COORDINATOR
 SUPERVISOR
 DECATHLON

MONICA ALMAGRO
 plan designer

CARLOS BERMEJO
 design coordinator

MIGUEL GOMEZ
 general coordinator

ALFONSO GARCIA-SANTOS
 construction manager

JAVIER NEILA
 architecture manager

ESTEFANIA CAAMAÑO
 general coordinator

GENERAL FURNITURE



unfolding under the sun
 Universidad Politécnica de Madrid (UPM)