


AREA 3 SLOPED ROOF LAYOUT (BEDROOM AREA)



BEDROOM AREA

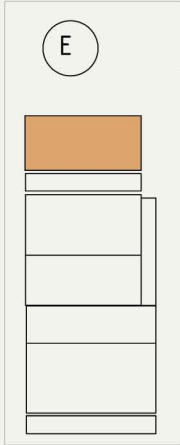

LATERAL SLOPED-ROOF





NORTH SIDE ROOF

ENCLOSURE


LAYOUT

H LATERAL SLOPED-ROOF ENCLOSURE (2)

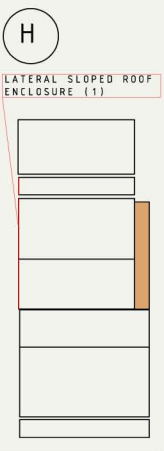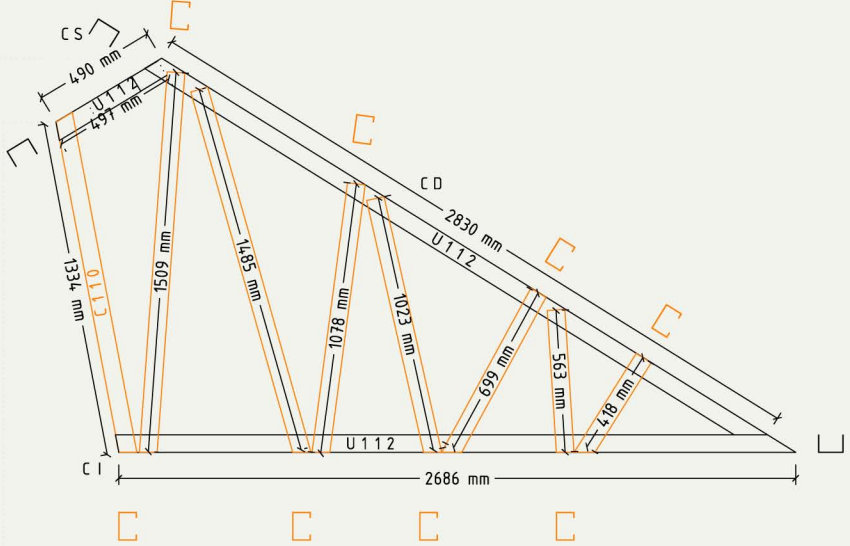


E NORTH SIDE ROOF ENCLOSURE


ROOF LAYOUT

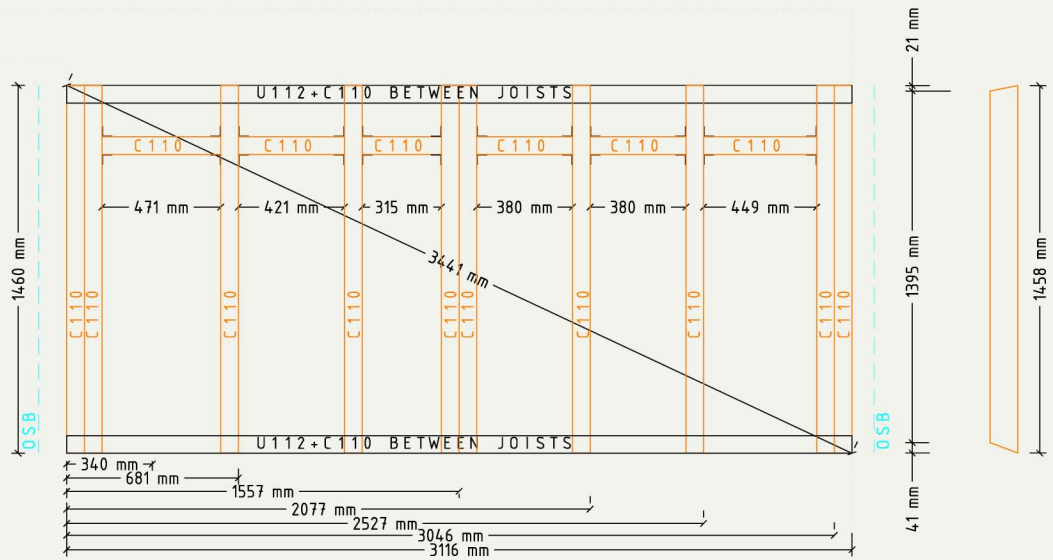

STEEL FRAME ELEMENTS(E)

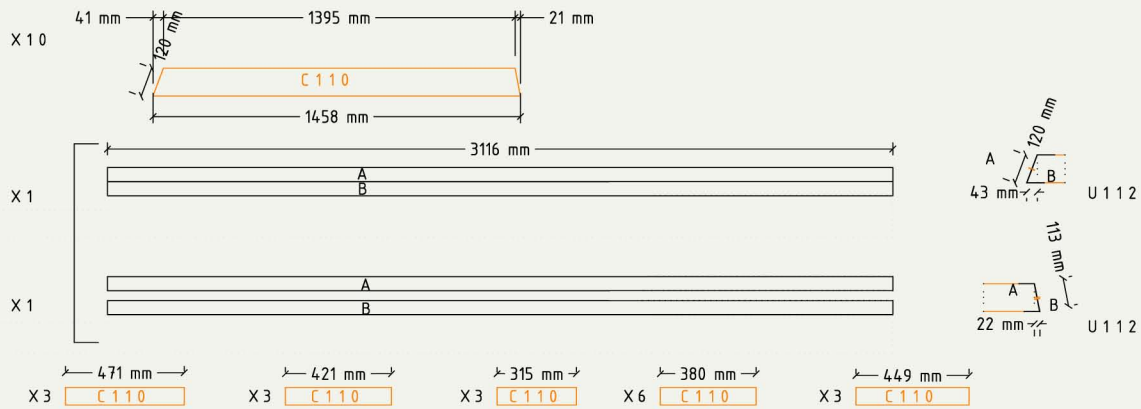


STEEL FRAME ELEMENTS(2)

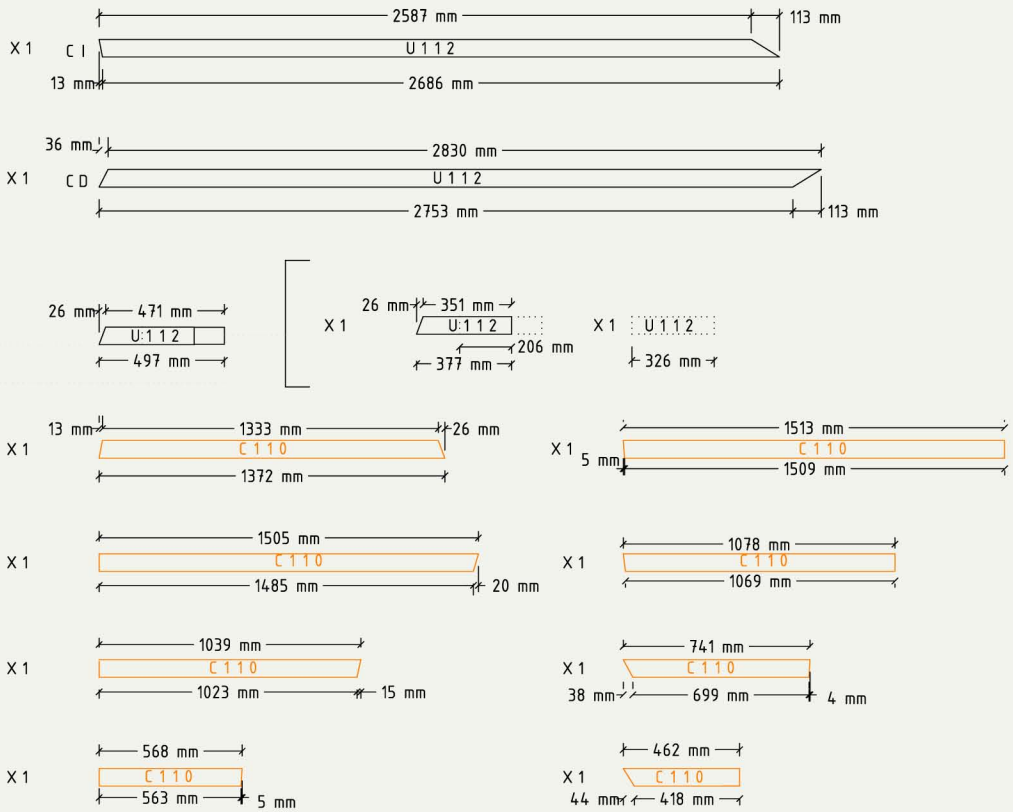

S - 22

DATE: 08.04.2005

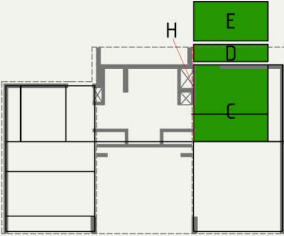

SCALE_1:30



SUPERVISORS	LETICIA RO-BER plan designer
	CARLOS BERMEJO design coordinator
	MIGUEL GOMEZ general coordinator
COORDINATORS	JOE WORCESTER professional engineer
	ALFONSO GARCÍA-SANTOS construction manager
	JAVIER NEILA architecture manager
COORDINATORS	ESTEFANÍA CAAMAÑO general coordinator



07/11

S - 22

1:30

STEEL FRAMING: ROOF LAYOUT