



A - 10

DATE: 08.04.2005



SCALE_1:40

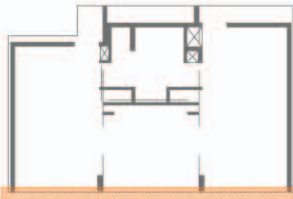

DANIEL CARDOSO
plan designer


CARLOS BERMEJO
design coordinator

MIGUEL GOMEZ
general coordinator

ALFONSO GARCIA-SANTOS
construction manager

JAVIER NEILA
architecture manager

ESTEFANIA CAAMAÑO
general coordinator



Intelling under the sun

Universidad Politécnica de Madrid (UPM)

01/01

A - 10

1:40

SOUTH SIDE