




4 PANEL HSW SYSTEM

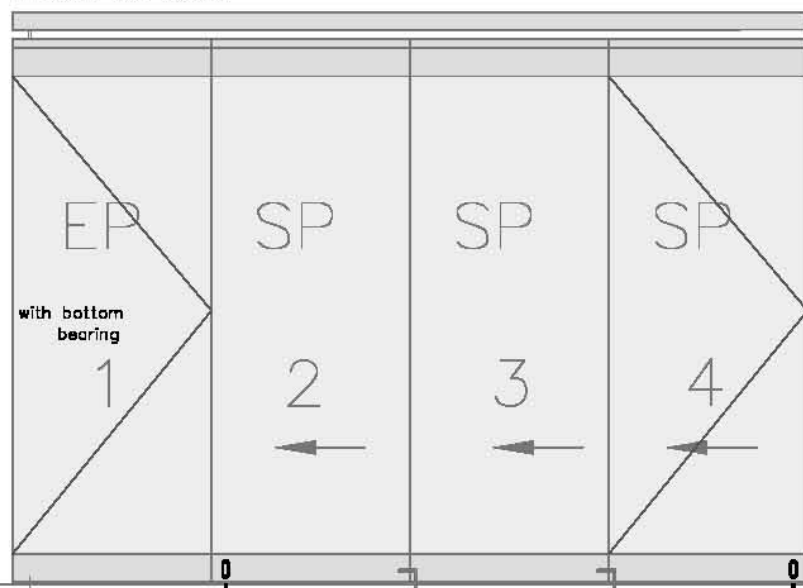

SOUTH WEST WINDOW
SCALE: 1/20

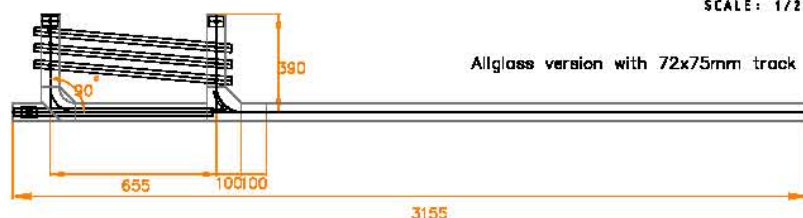

4 PANEL HSW SYSTEM

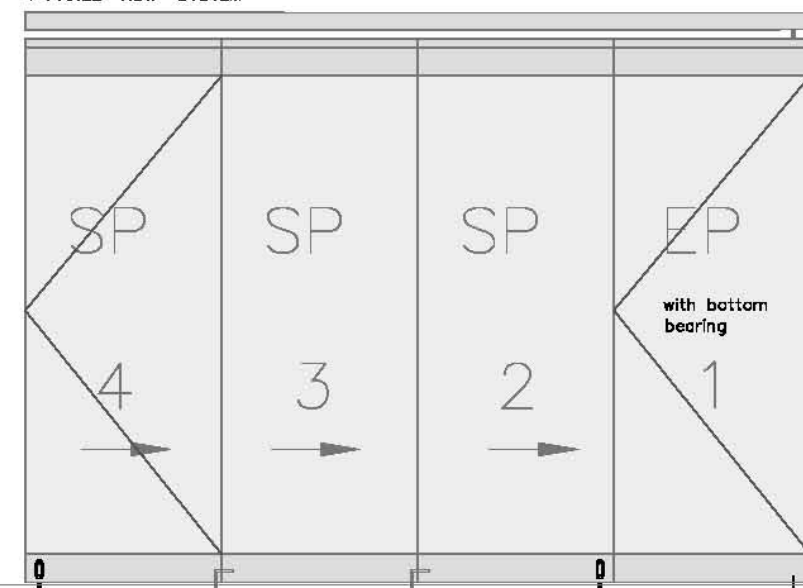

SOUTH EAST WINDOW



SCALE: 1/20




PICTURE 1



PICTURE 2




PICTURE 3

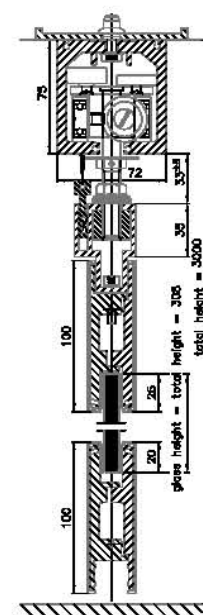

SECTION SLIDING PANEL
SCALE: 1/5

GLASS THICKNESS 10mm
WITH TOP BRUSH
TRACK COLOUR RAL:7022
PANEL COLOUR RAL:7022

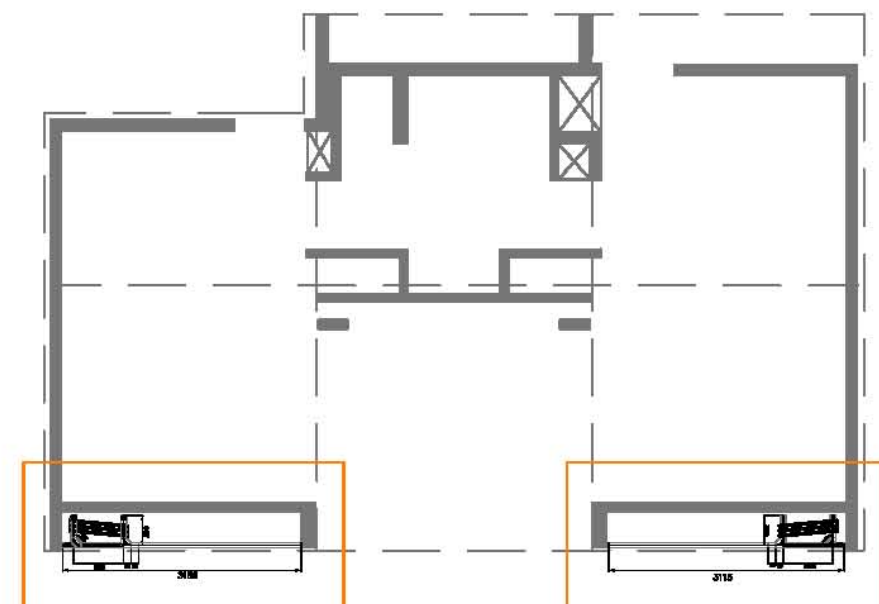

SCALE: 1/100




SOUTH SIDE
SCALE: 1/100



BC - 47

DATE: 08.04.2005

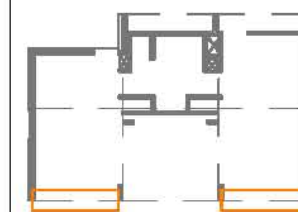

01/07

BC - 47

SEVERAL SCALES

1:100
1:20
1:5

SEVERAL
SCALES

José Luis
Pérez-Griffó
plus designer

CARLOS BERNEJO
design coordinator

MIGUEL GÓMEZ
general coordinator

COORDINATORS SUPERVISORS DECAATHLETES

ALFONSO GARCÍA-SANTOS
construction manager

JAVIER NEILA
architectural manager

ESTEFANIA CAAMAÑO
general coordinator

COORDINATORS SUPERVISORS DECAATHLETES



unfolding under the sun
Universidad Politécnica de Madrid (UPM)

GLAZING AND FRAMING: GREENHOUSES