



Metal Enclosure
North side
(5 pieces)

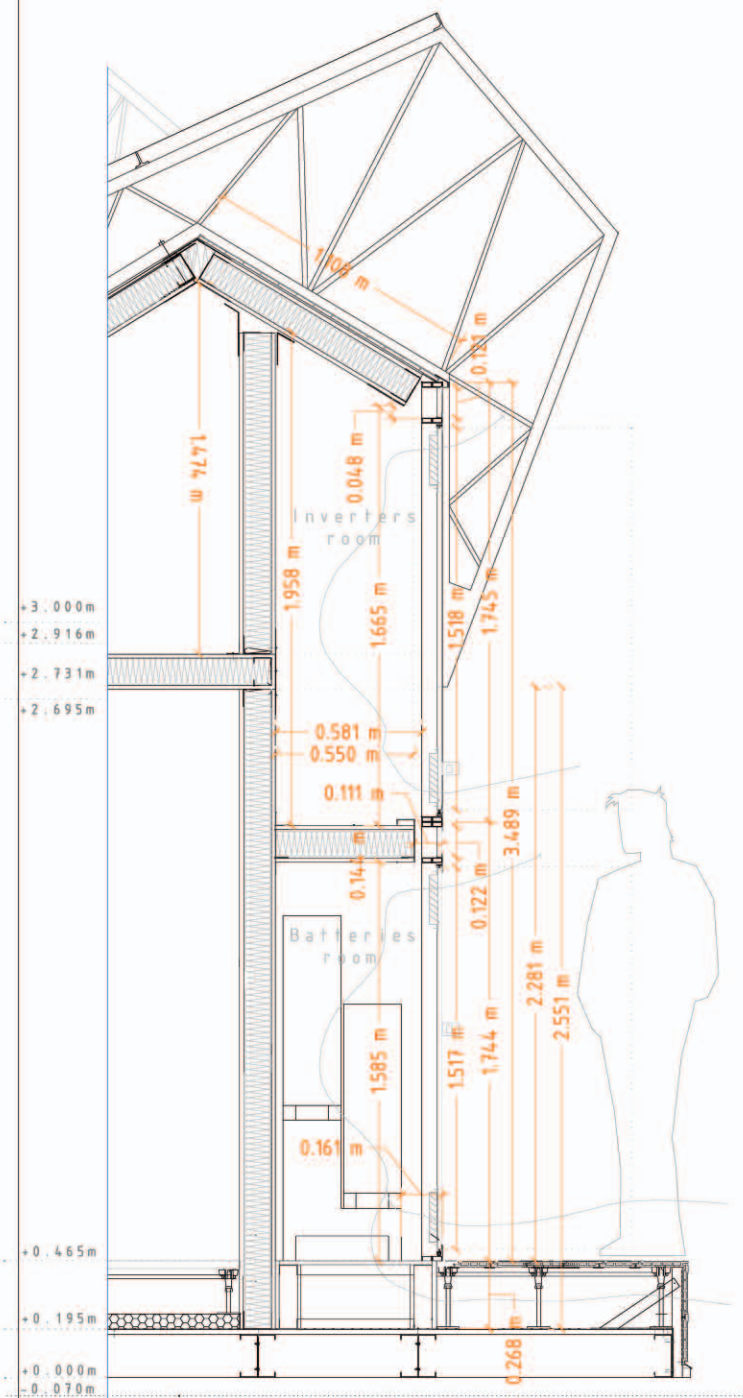


- 1 Stainless steel tube 40x20x2mm
- 2 Stainless steel angle 20x20x2mm
- 3 Stainless steel plate 1mm thick
- 4 Stainless steel wire mesh
- 5 Stainless steel guide and nylon roller 1.5mm thick
- 6 Stainless steel slotted plate for ventilation 1mm thick
- 7 Stainless steel continuous hinge 1mm thick

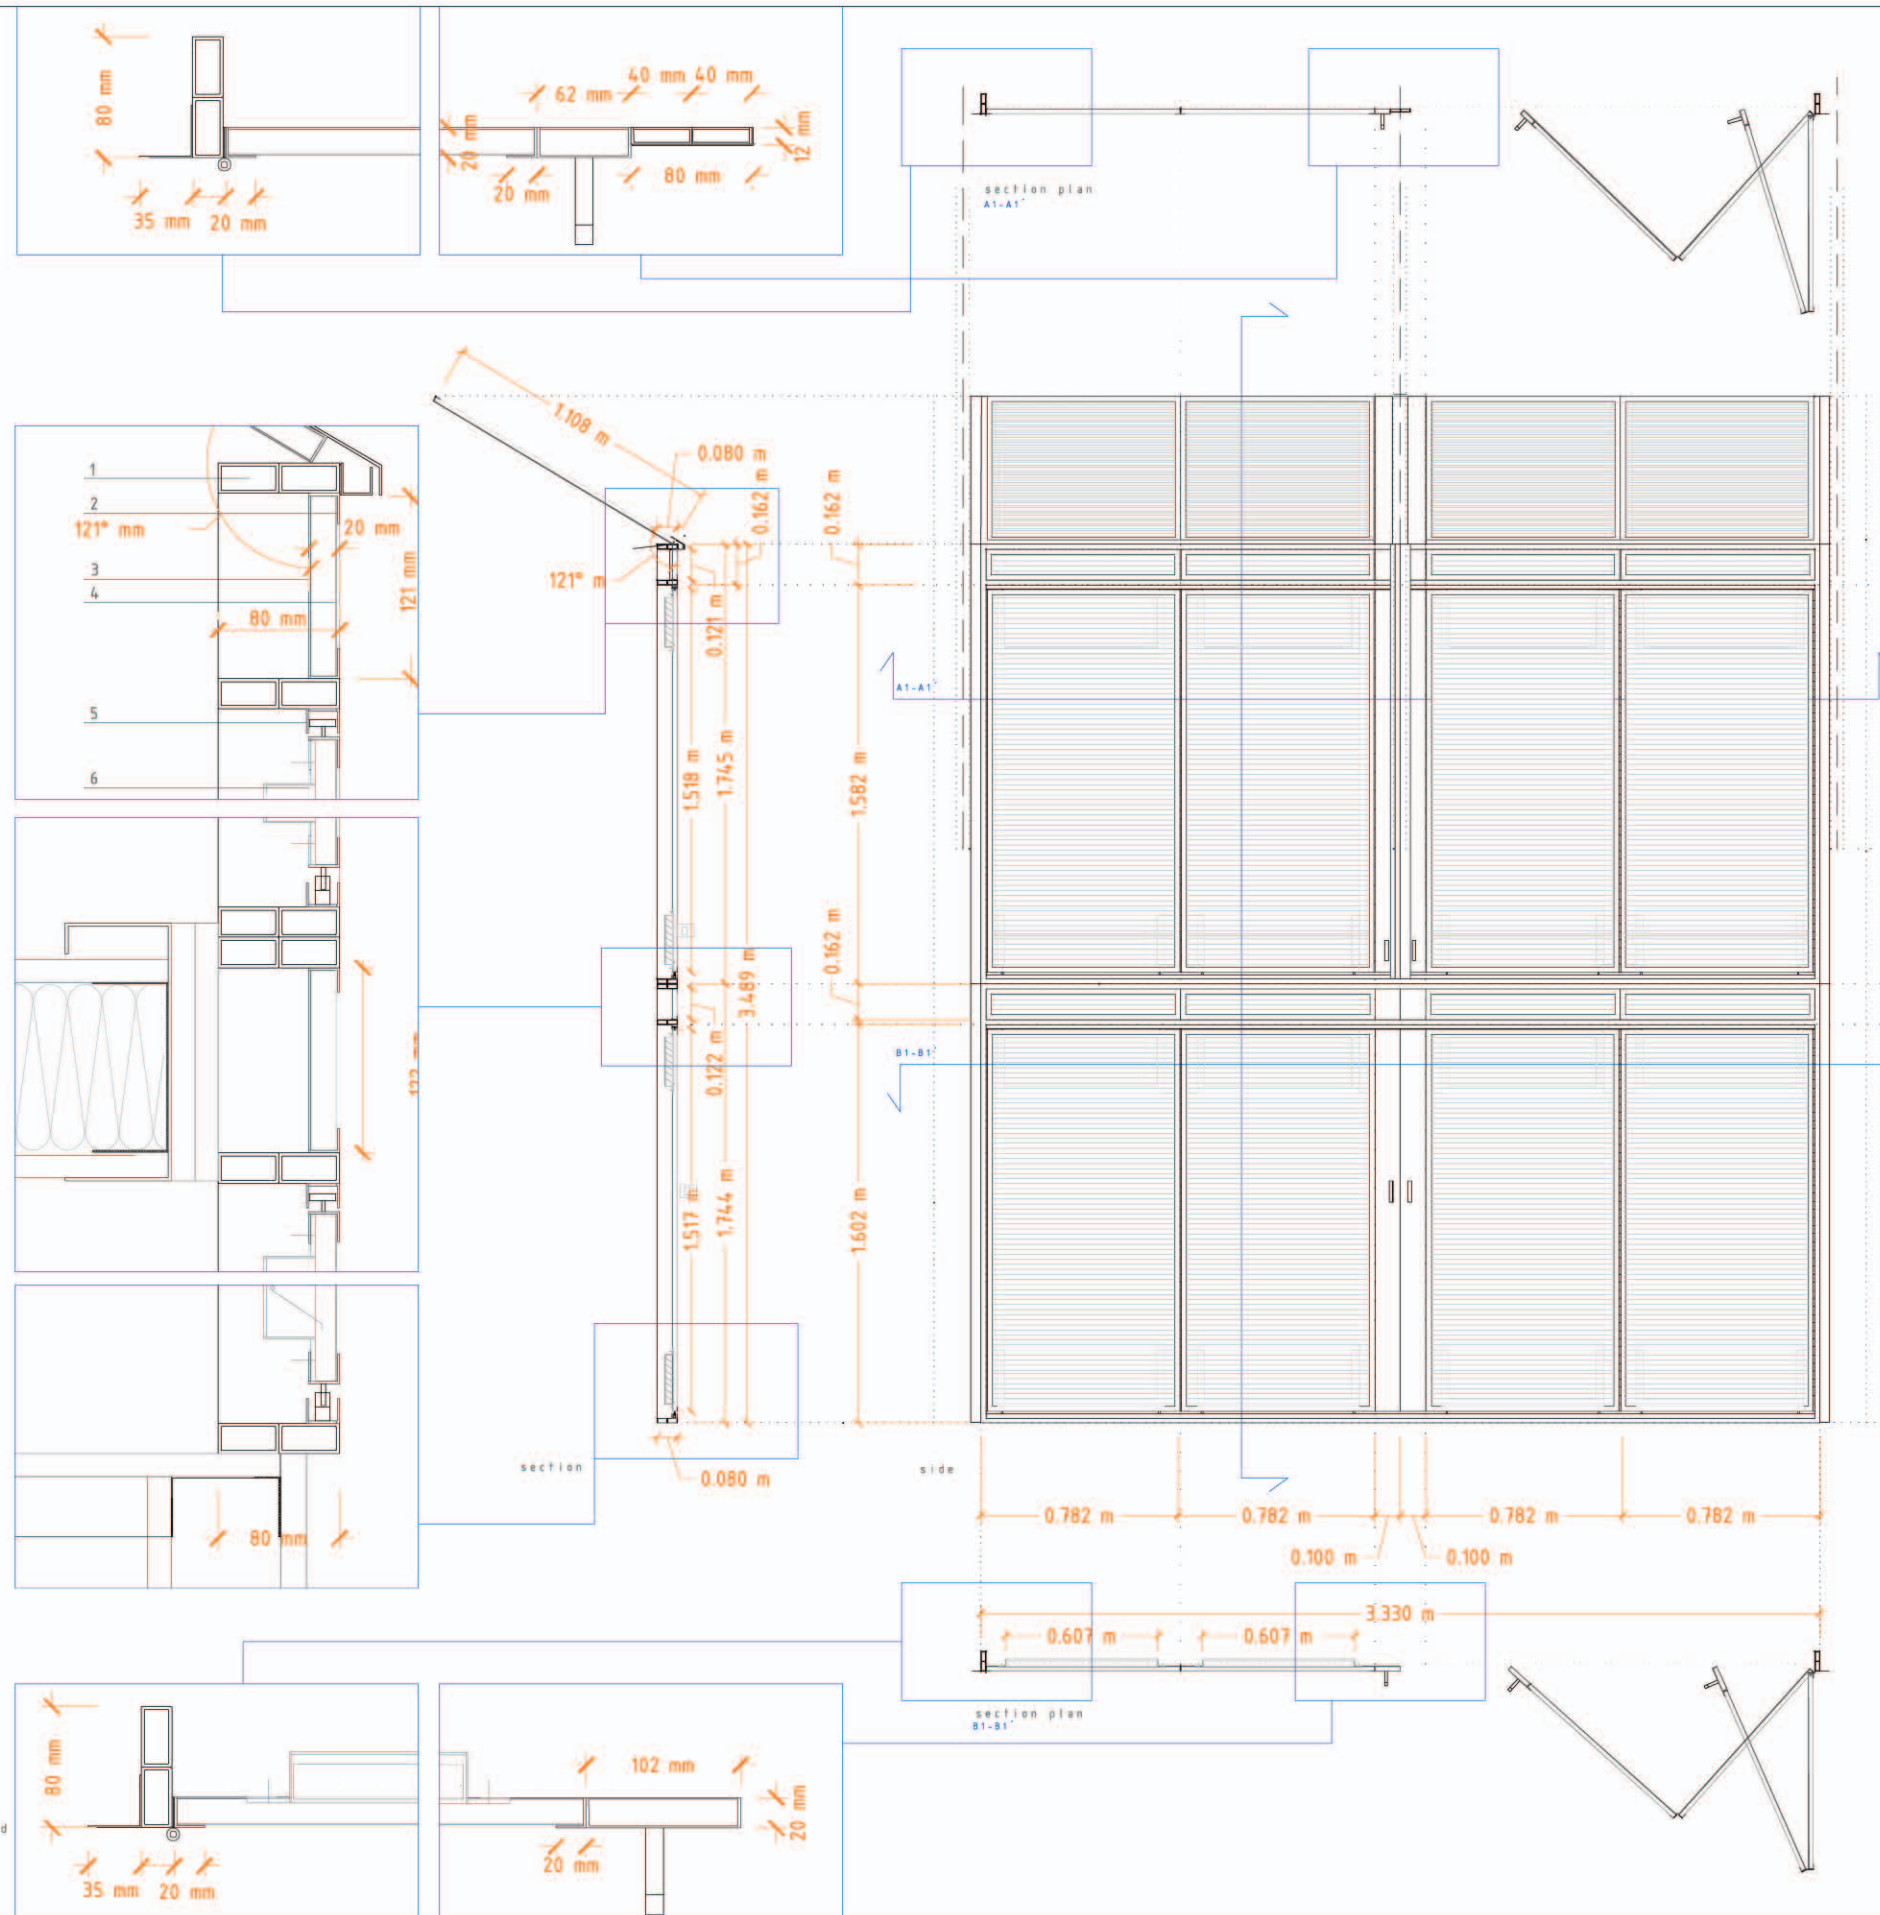

BC - 44

DATE: 08.04.2005

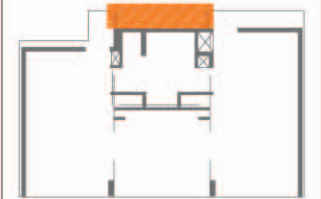

01/04

BC - 44

SEVERAL SCALES

SCALE_1:5
SCALE_1:30

SEVERAL SCALES

COORDINATORS	DANIEL CARDOSO plan designer
	CARLOS BERMEJO design coordinator
	MIGUEL GOMEZ general coordinator
SUPERVISORS	ALFONSO GARCIA-SANTOS construction manager
	JAVIER NEILA architecture manager
	ESTEFANIA CAAMAÑO general coordinator
DECATHLETES	

EXT.FINISH:PV-EQUIPMENT ROOM



Intelling under the sun
Universidad Politécnica de Madrid (UPM)