


A-04

DATE : 08.04.2005

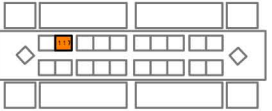

01/02

A - 04

SCALE_1 : 2000

1 : 2000

COORDINATORS

DECATHLETES

SUPERVISORS

ALFONSO GARCIA-SANTOS
construction manager

JAVIER NEILA
architecture manager

ESTEFANIA CAAMAÑO
general coordinator

IVÁN ALCANTARILLA
plan designer

CARLOS BERMEJO
design coordinator

MIGUEL GOMEZ
general coordinator

MAGIC BOX

unfolding under the sun

Universidad Politécnica de Madrid (UPM)

MALL LAYOUT