


UPM 2005

A - 11

DATE: 08.04.2005

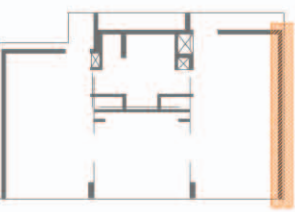

01/01

A - 11

SCALE_1:40

0 0.5 1m

0 1 2 3ft

1:40

SUPERVISORS

DANIEL CARDOSO
plan designer

CARLOS BERMEJO
design coordinator

MIGUEL GOMEZ
general coordinator


COORDINATORS

ALFONSO GARCIA-SANTOS
construction manager

JAVIER NEILA
architecture manager

ESTEFANIA CAAMAÑO
general coordinator

EAST SIDE



magic BOX

Intelling under the sun

Universidad Politécnica de Madrid (UPM)