


- V3. BATH-BED LIGHTING
- V2. PUSH. BATH-BED
- V1. PUSH. BATH CEILING
- V4. C1
- V5. MIRROR LIGHTING

BATHROOM (south)

- V6. BATH CEILING LIGHTING
- V7. PUSH. MIRROR
- V8. PUSH. BATH-KITCHEN
- V9. PUSH. BATH CEILING


- L3. BATH-KITCHEN LIGHTING
- L4. PUMPS
- L5. CONTROL
- L1. WASHING MACHINE
- L2. DRYER

BATHROOM (north)



**E - 5 2**

DATE: 08.04.2005

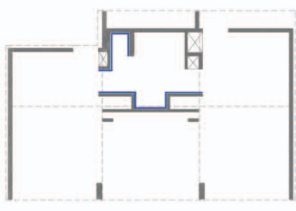


SCALE\_1 : 30

0 0.5 1m  
0 1 2 3ft

**SUSANA FERNANDEZ**  
plan designer

**MONICA ALMAGRO**  
graphic designer

**MIGUEL GOMEZ**  
general coordinator


  
ENGINEERING, ARCHITECTURE AND CONSULTING


**ANTONIO VILLANUEVA**  
IDOM industrial engineer

**ALFONSO GARCIA-SANTOS**  
construction manager

**JAVIER NEILA**  
architecture manager

**ESTEFANIA CAAMAÑO**  
general coordinator

  
unfolding under the sun  
Universidad Politécnica de Madrid (UPM)



02/03

**E - 5 2**

**1 : 30**

**WALL WIRING: BATHROOM**