

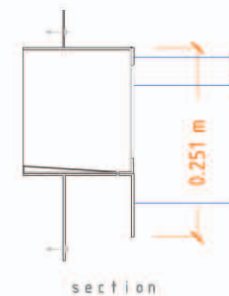



OPENING E3

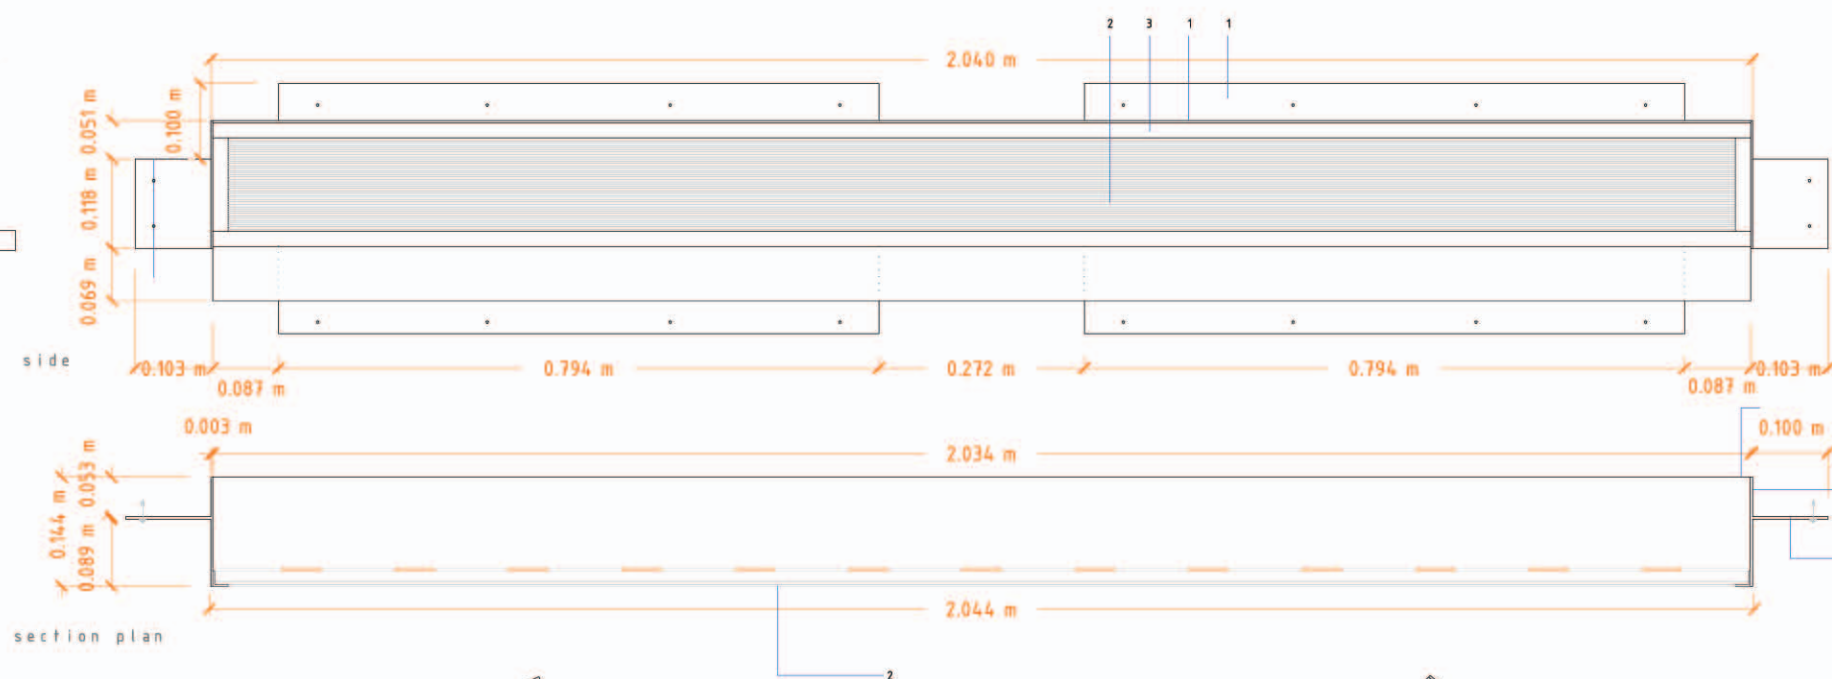


section

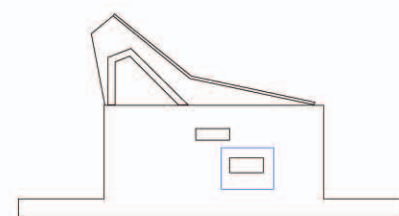


OPENING W1

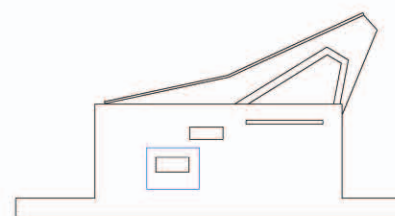



OPENING E1

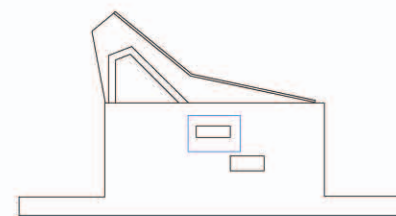

OPENING W2

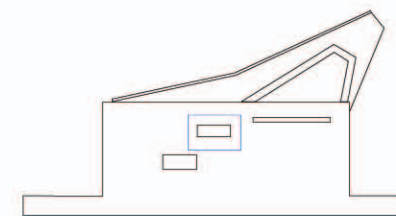

OPENING E2

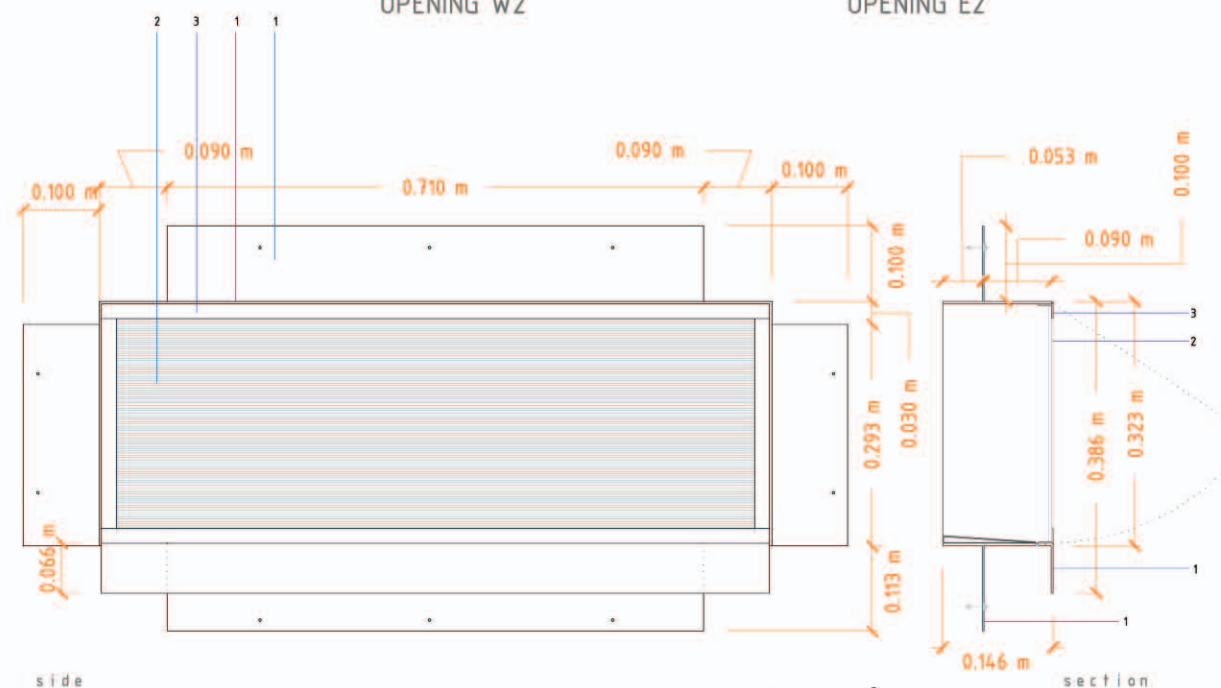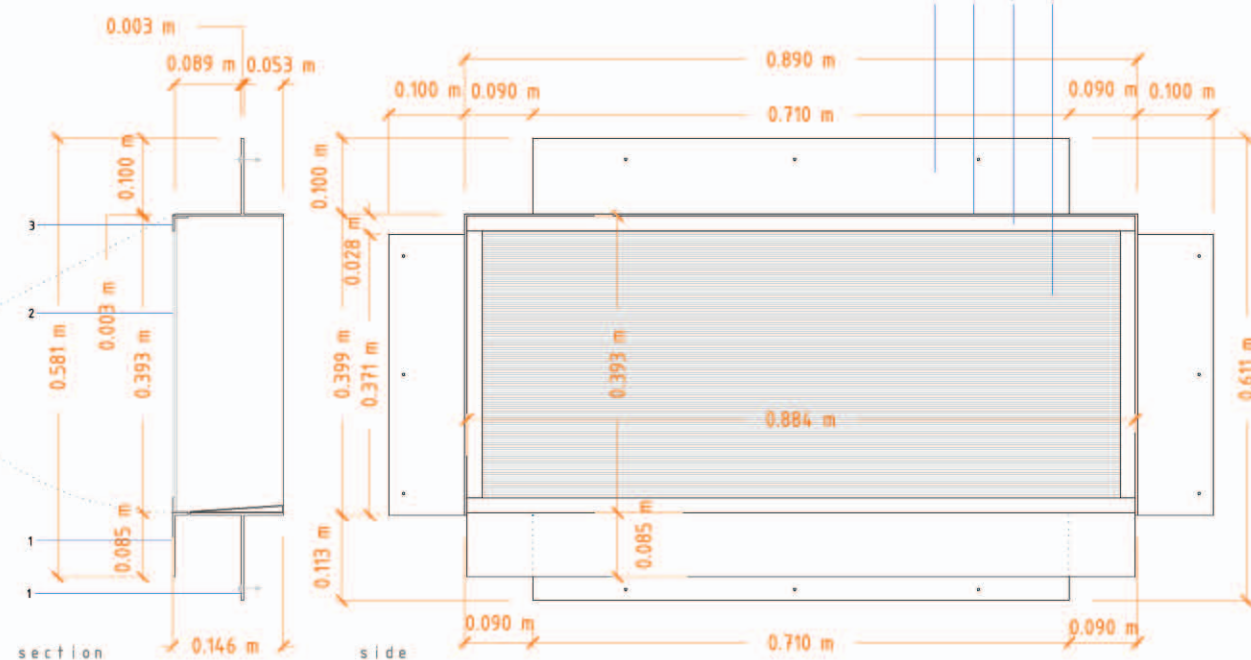

- 1-Stainless steel plate 2mm
- 2-Stainless steel wire mesh
- 3-Stainless steel angle 2mm
- 4-Stainless steel tube 2mm



BC - 45

DATE: 08.04.2005



SCALE 1:10



DANIEL CARDOSO
plan designer

CARLOS BERMEJO
design coordinator

MIGUEL GOMEZ
general coordinator

ALFONSO GARCIA-SANTOS
construction manager

JAVIER NEILA
architecture manager

ESTEFANIA CAAMAÑO
general coordinator



Universidad Politécnica de Madrid (UPM)



03/05

BC - 45

1:10

EXT.FINISH:OPENING FRAMING