



WINTER DAY - SECTION F

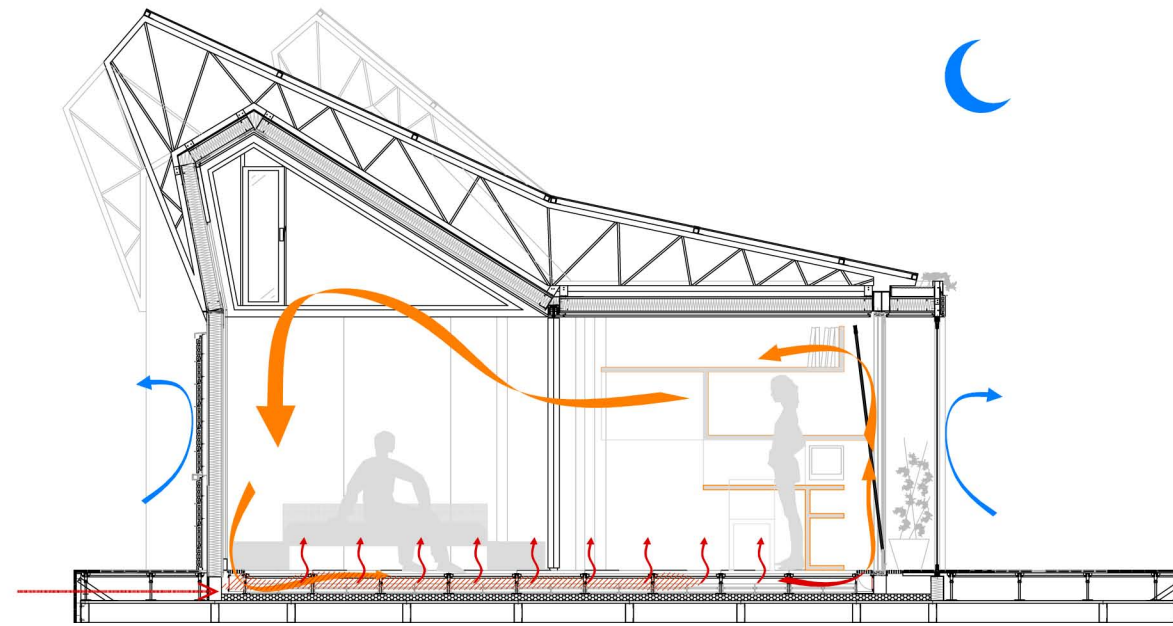


WINTER NIGHT - SECTION F

→ EXTERIOR AIR ENTRY POSSIBILITY

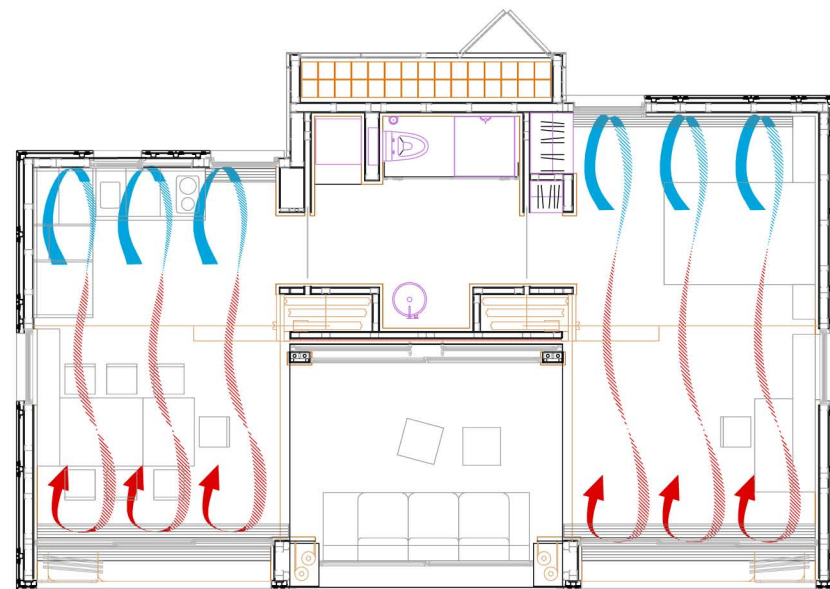

WINTER NIGHT - PLAN

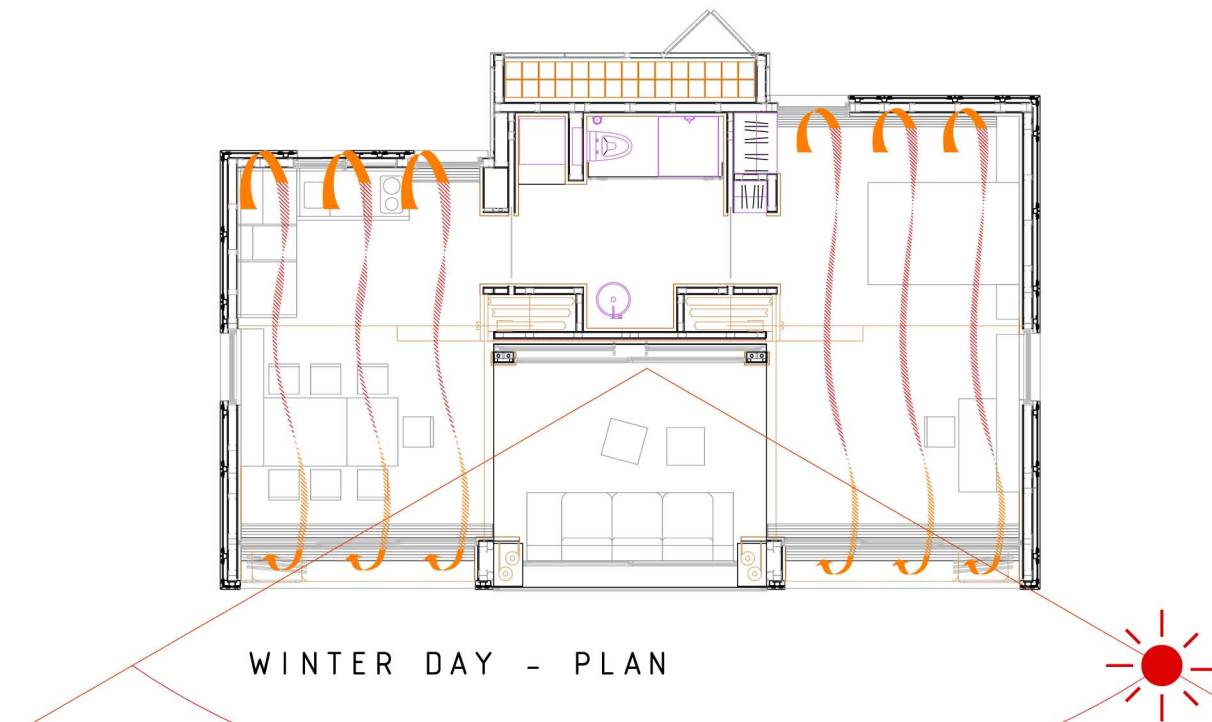


WINTER DAY - PLAN



BD - 25

DATE: 08.04.2005

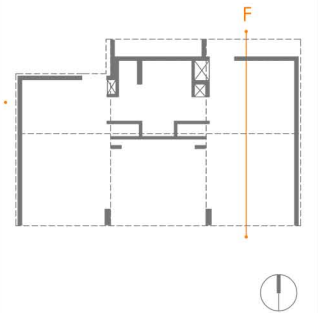

SEVERAL SCALES

SCALE\_1:50  
SCALE\_1:100

COORDINATORS SUPERVISORS DECATHLETES

CARLOS BERMEJO  
plan designer

CARLOS BERMEJO  
design coordinator

MIGUEL GOMEZ  
general coordinator

ALFONSO GARCIA-SANTOS  
construction manager

JAVIER NEILA  
architecture manager

ESTEFANIA CAAMAÑO  
general coordinator

1° F

01/03

BD - 25

SEVERAL  
SCALES

BIOCLIMATIC WORKING: WINTER



Universidad Politécnica de Madrid (UPM)