



BC - 26

DATE: 08.04.2005

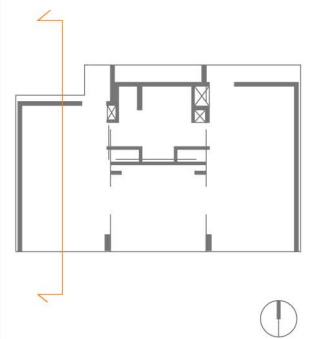

SCALE_1:40

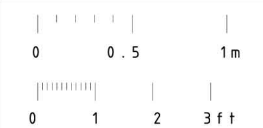

- COORDINATOR SUPERVISOR DECATHLETES
- CARLOTREZZO
plan designer
 - CARLOS BERMEJO
design coordinator
 - MIGUEL GOMEZ
general coordinator
 - JOE WORCESTER
professional engineer
 - ALFONSO GARCIA-SANTOS
construction manager
 - JAVIER NEILA
architecture manager
 - ESTEFANIA CAAMAÑO
general coordinator



01/01

BC - 26

1:40

SECTION A: KITCHEN