


GROUND FLOOR STRUCTURE. OSB PIECES

Oriented Strad Board cuttings for structural working.
All boards are 22 mm thick.



S - 18

DATE: 08.04.2005

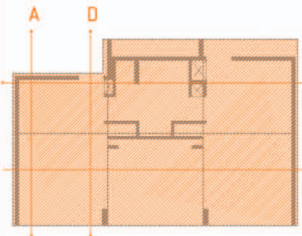

SCALE_1:30



JOAQUIN HIDALGO
plan designer
CARLOS BERMEJO
design coordinator
MIGUEL GOMEZ
general coordinator

JOE WORCESTER
professional engineer

ALFONSO GARCIA-SANTOS
construction manager

JAVIER NEILA
architecture manager

ESTEFANIA CAAMAÑO
general coordinator




unfolding under the sun
Universidad Politécnica de Madrid (UPM)

05/05

S - 18

1:30

GROUND FLOOR STRUCTURE

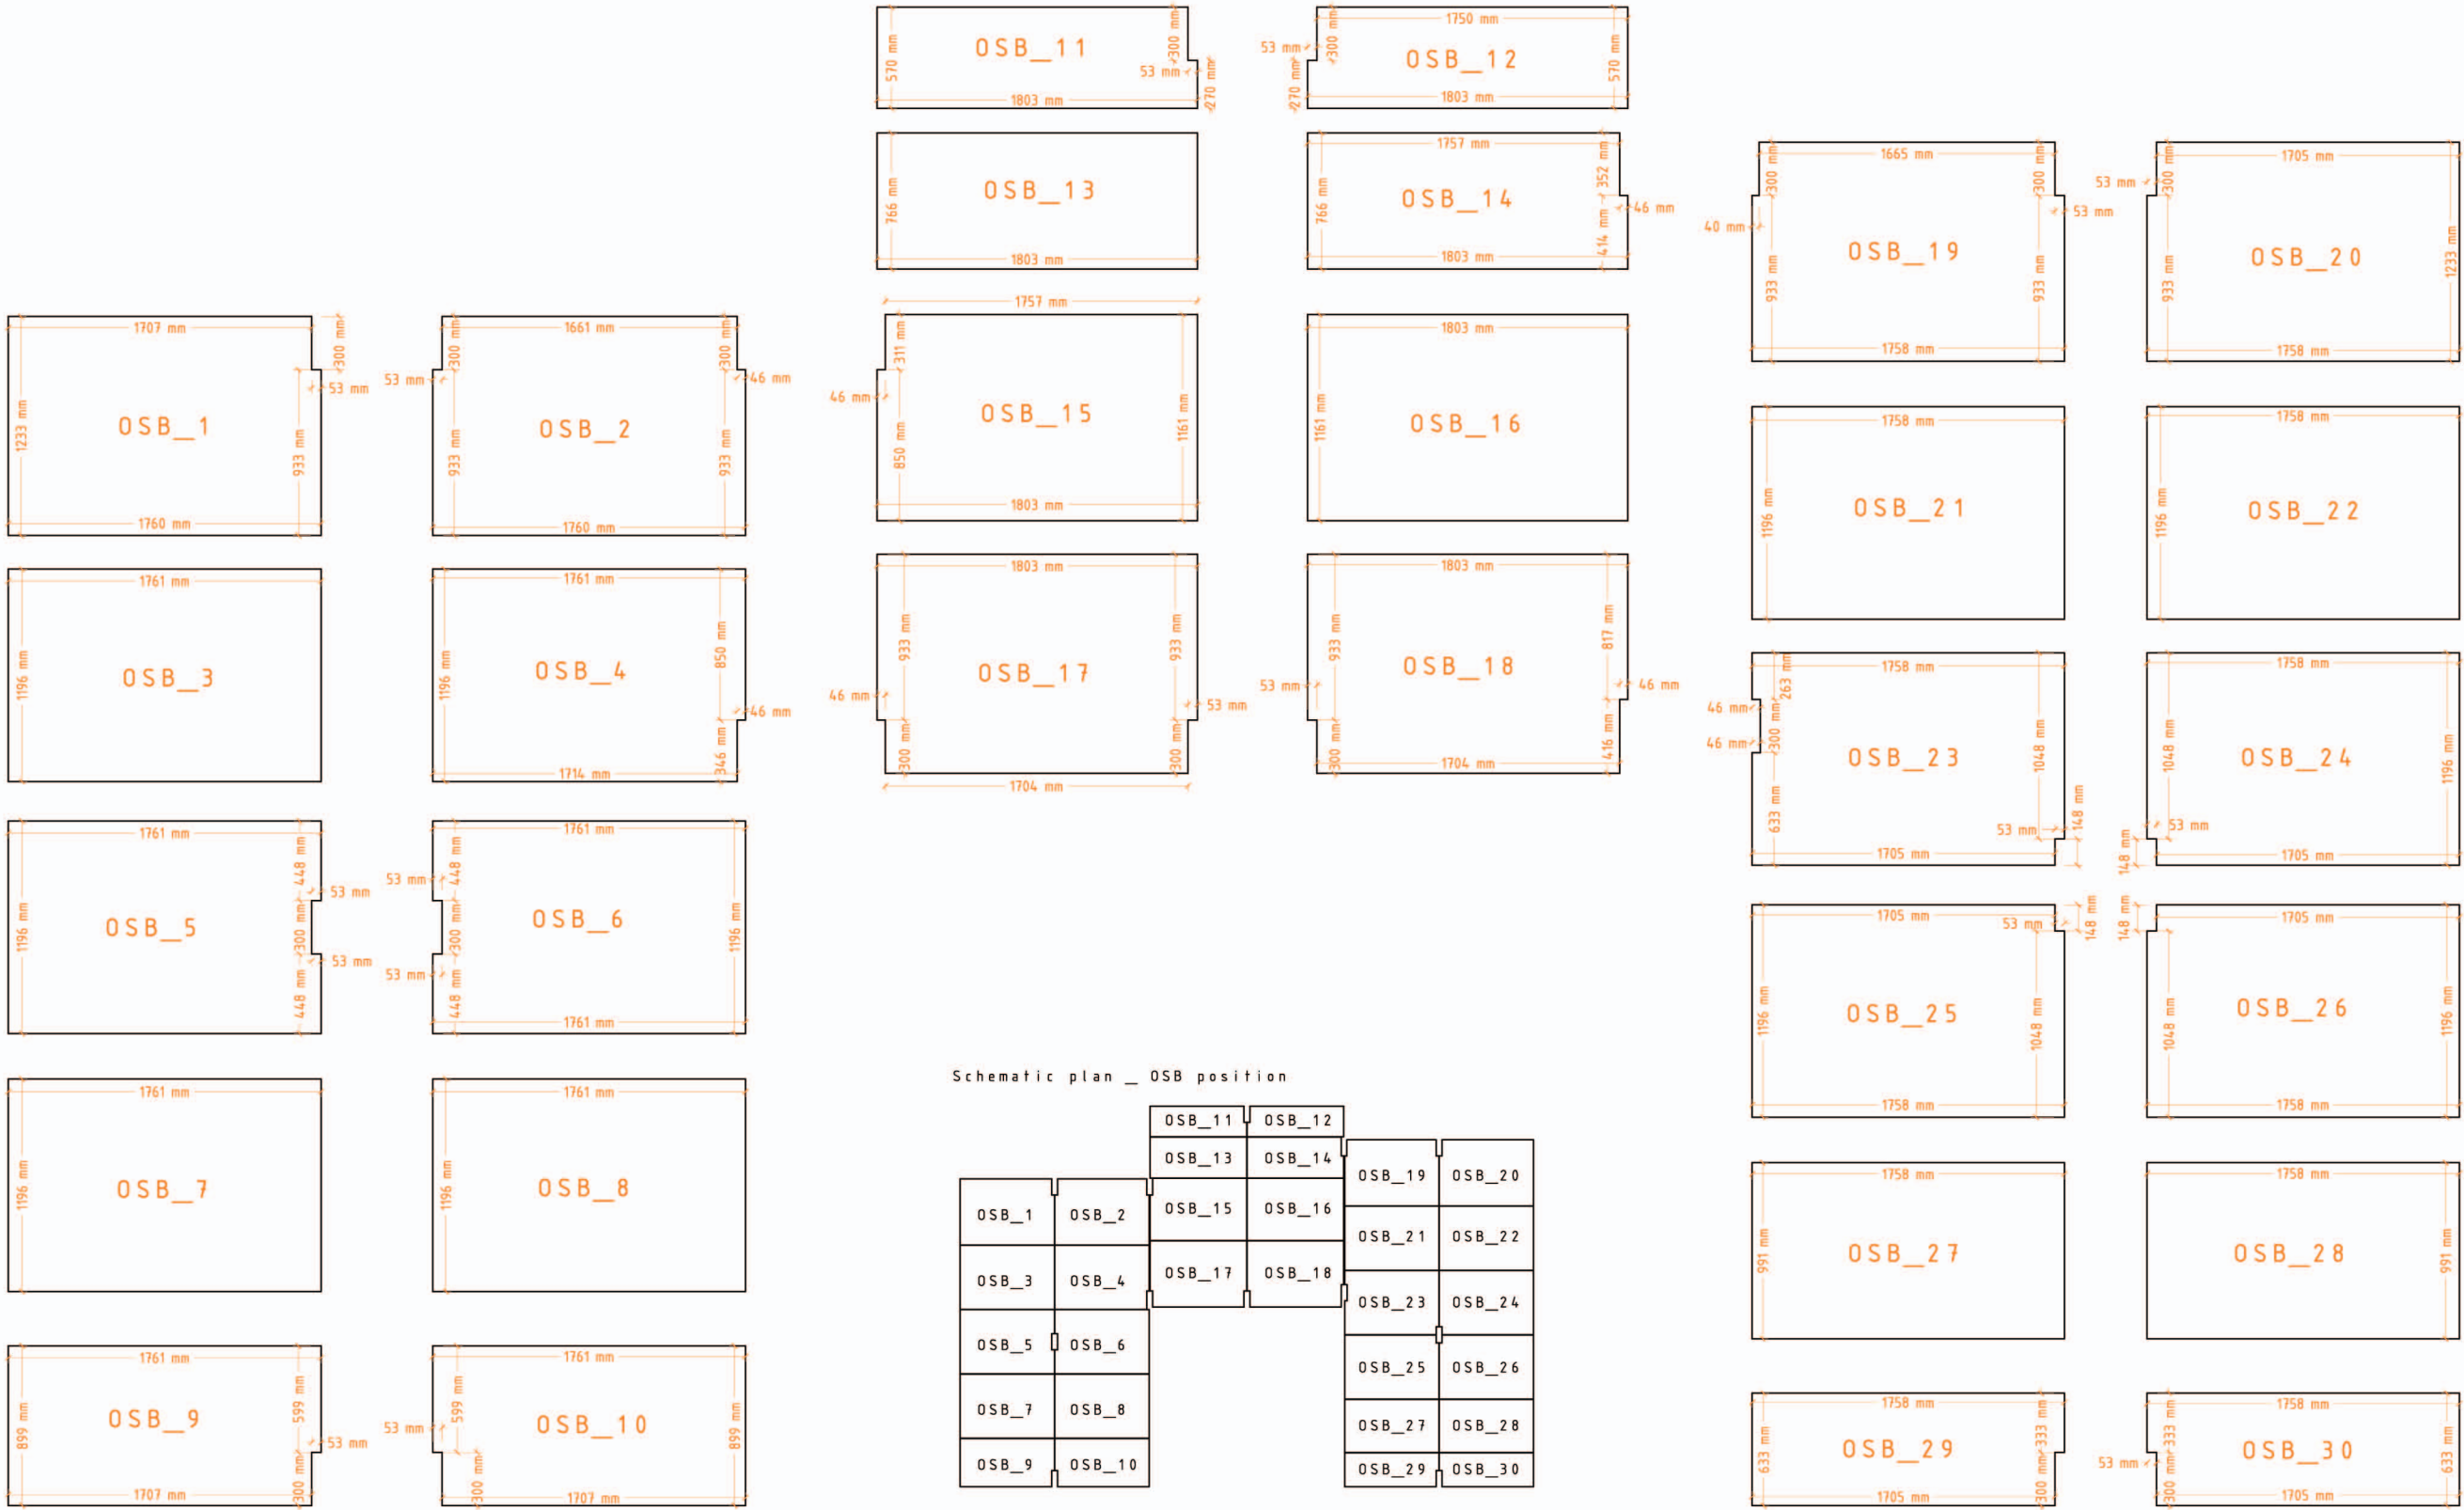

Schematic plan _ OSB position

		OSB_11	OSB_12		
		OSB_13	OSB_14	OSB_19	OSB_20
OSB_1	OSB_2	OSB_15	OSB_16	OSB_21	OSB_22
OSB_3	OSB_4	OSB_17	OSB_18	OSB_23	OSB_24
OSB_5	OSB_6			OSB_25	OSB_26
OSB_7	OSB_8			OSB_27	OSB_28
OSB_9	OSB_10			OSB_29	OSB_30