



MOBILE BOX, GROUND FLOOR STRUCTURE AND MECHANISMS (LAYER 2)


UNFOLDED LAYOUT

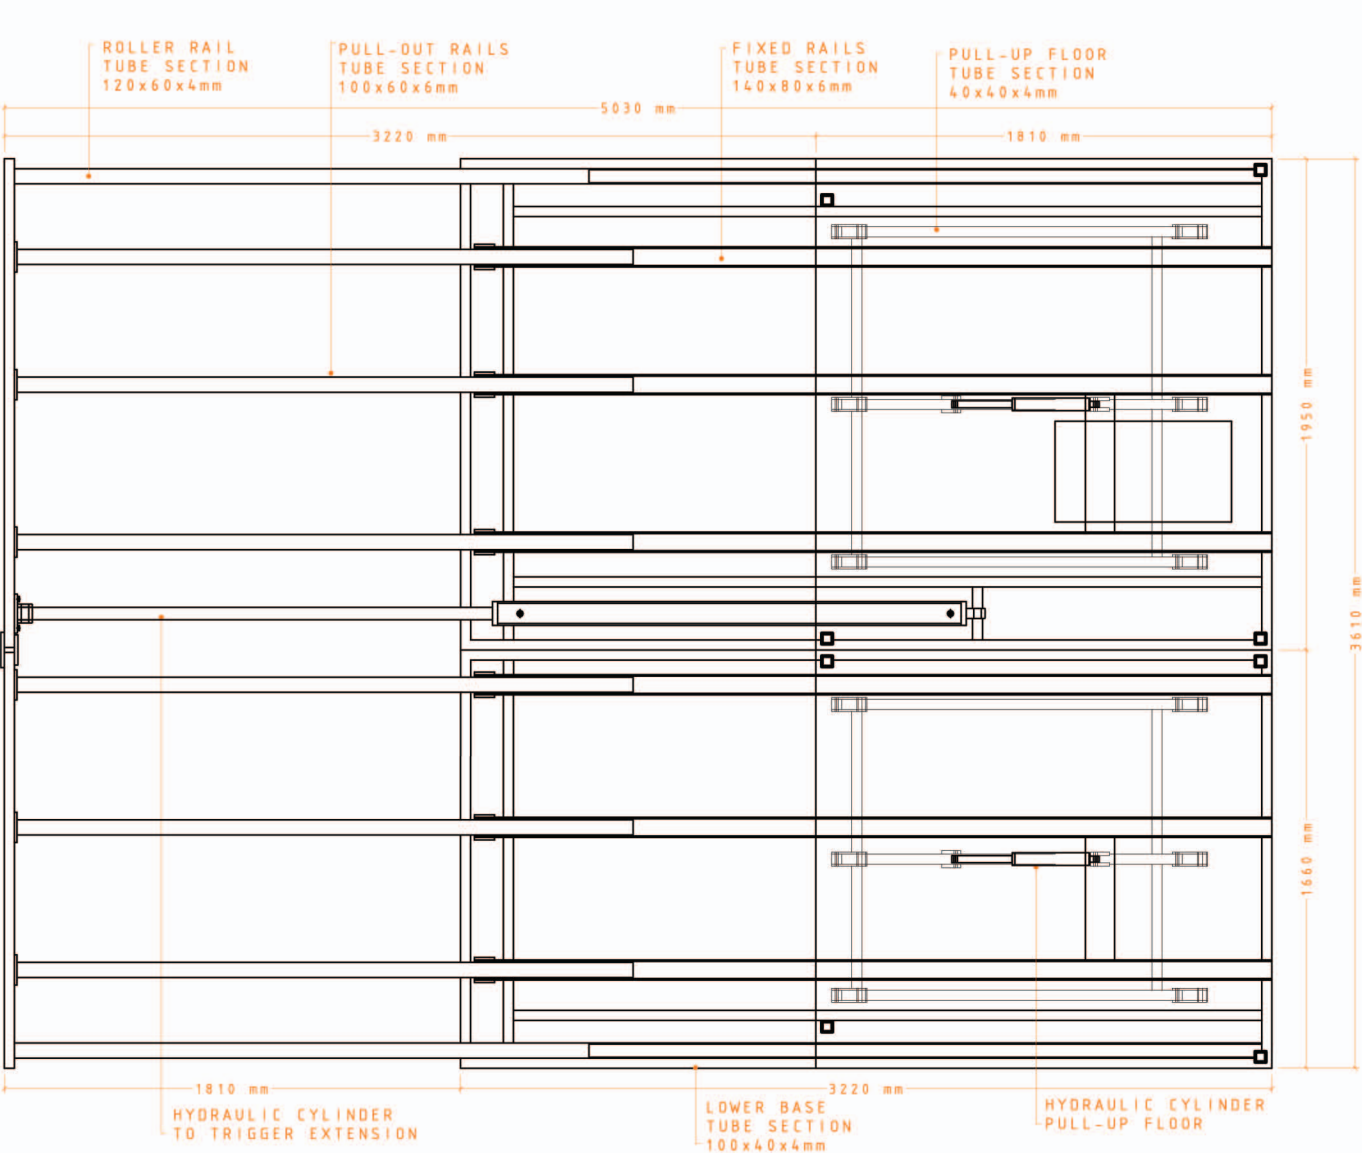

FOLDED LAYOUT

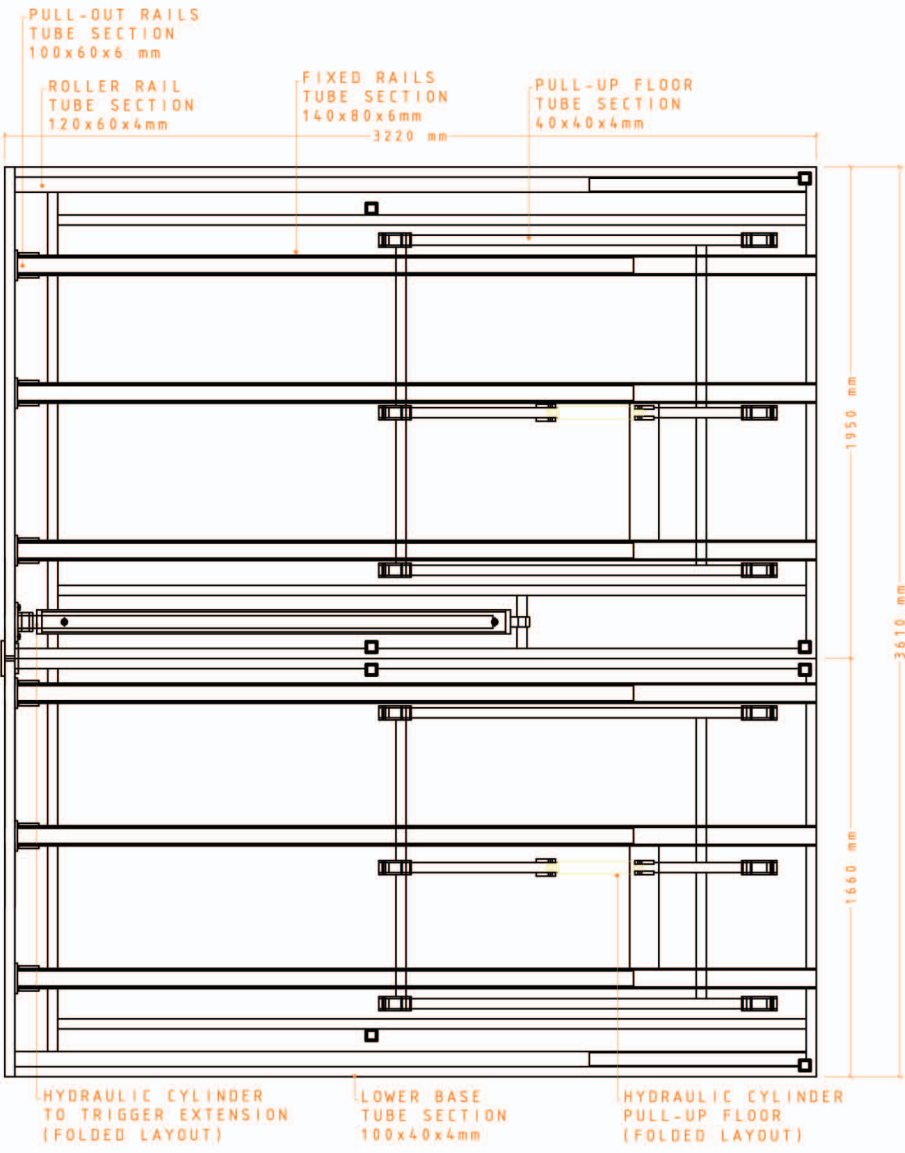

GROUND FLOOR SECTION, UNFOLDED LAYOUT

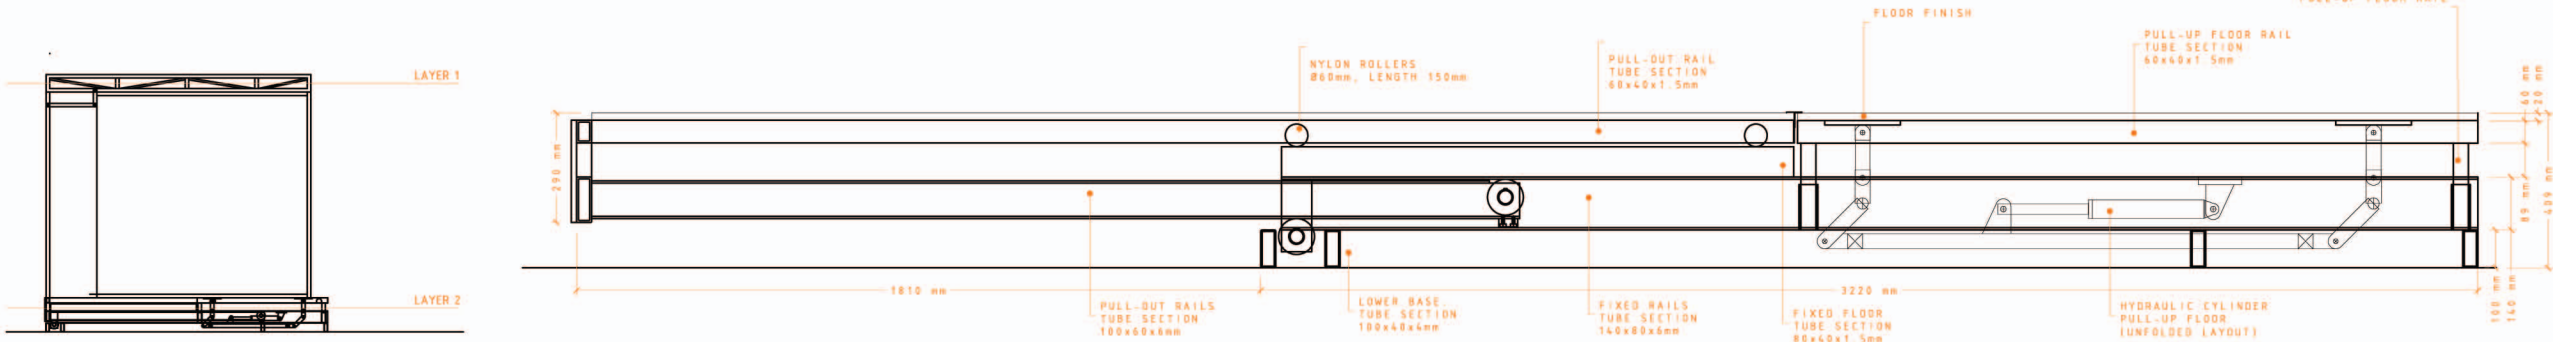


SECTION



S - 19

DATE: 08.04.2005

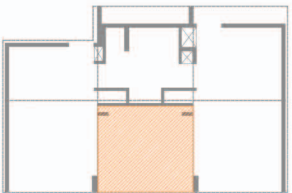

SCALE_1:30



JOAQUIN HIDALGO
plan designer

CARLOS BERMEJO
design coordinator

MIGUEL GOMEZ
general coordinator

JOE WORCESTER
professional engineer

ALFONSO GARCIA-SANTOS
construction manager

JAVIER NEILA
architecture manager

ESTEFANIA CAAMAÑO
general coordinator



unfolding under the sun
Universidad Politécnica de Madrid (UPM)

03/06

S - 19

1:30

MOVABLE MODULE