


CONDITIONED AREA - FOLDED LAYOUT 52.25 m²



FCA-03

DATE: 08.04.2005

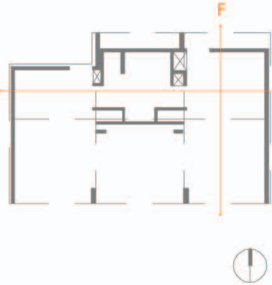

SCALE_1:40



01/02

FCA-03

1:40

COORDINATORS SUPERVISORS DECATHLETES

HELDER J. MARTINS
plan designer

CARLOS BERMEJO
design coordinator

MIGUEL GOMEZ
general coordinator

ALFONSO GARCIA-SANTOS
construction manager

JAVIER NEILA
architecture manager

ESTEFANIA CAAMAÑO
general coordinator

CONDITIONED AREA



Universidad Politécnica de Madrid (UPM)