


[illegible]

DATE: 08.04.2005

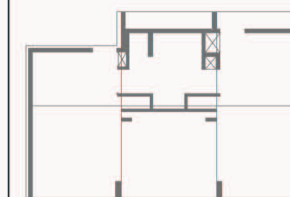

Q

SCALE_ 1:50

DE MIGUEL GOMEZ
general coordinator

ESTEFANIA CAAMAÑO
general coordinator

02/07

BC-49

OUTDOOR AREAS

magic BOX

Unfolding under the sun
Universidad Politécnica de Madrid (UPM)