


Y1. OUTDOOR LIGHTING
Y2. PUSH. FLUORESCENT
Y3. PUSH. HEADBOARD
Y4. FLUORESCENT


BEDROOM

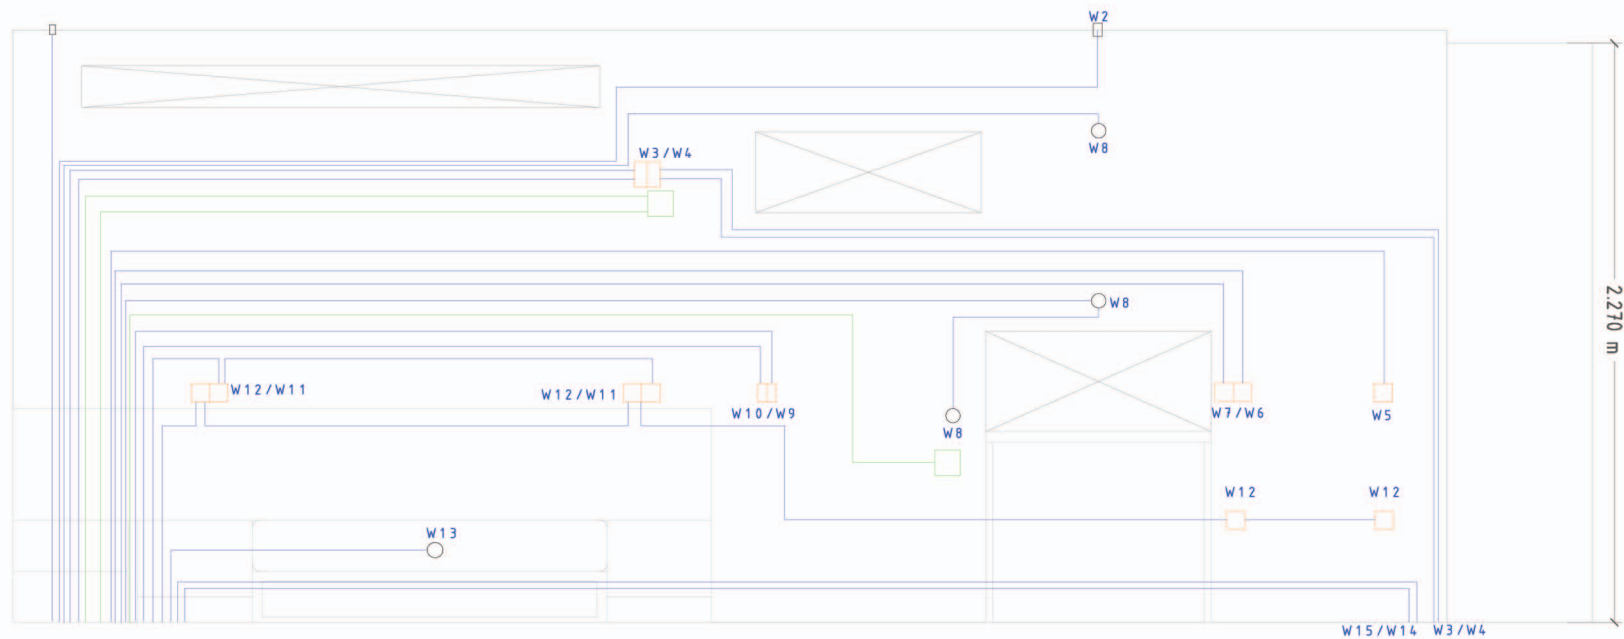


W1. FIRE ALARM SYSTEM
W2. CEILING LIGHT
W3. POWER
W4. SIGNAL
W5. PUSH. SOLAR GREENHOUSE
W6. NETWORK (X2)
W7. PUSH. OFFICE LIGHTING
W8. OFFICE LIGHTING

BEDROOM + OFFICE


— WIRING INSTALLED BY THE ORGANIZATION



E - 52
DATE: 08.04.2005

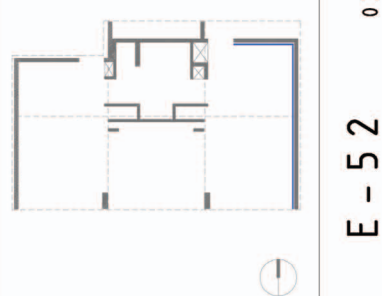

SCALE_1:30

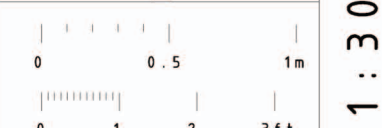

1:30

WALL WIRING: EAST SIDE

COORDINATORS SUPERVISORS DECATHLETES

ANTONIO VILLANUEVA
IDOM industrial engineer

ALFONSO GARCIA-SANTOS
construction manager

JAVIER NEILA
architecture manager


ESTEFANIA CAAMAÑO
general coordinator

SUSANA FERNANDEZ
plan designer

MONICA ALMAGRO
graphic designer

MIGUEL GOMEZ
general coordinator

idom
ENGINEERING, ARCHITECTURE AND CONSULTING



unfolding under the sun
Universidad Politécnica de Madrid (UPM)