



SECTION OUTDOOR AREA E


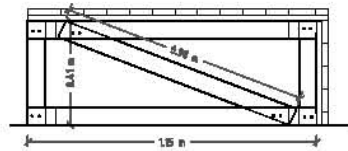


SECTION OUTDOOR AREA E.1

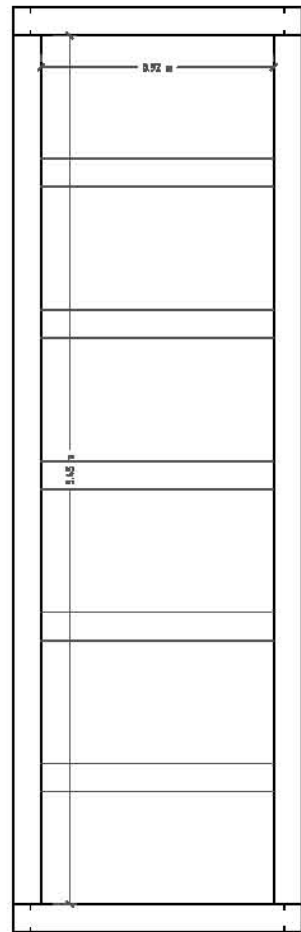


TOP OUTDOOR AREA D.1


SECTION OUTDOOR AREA F

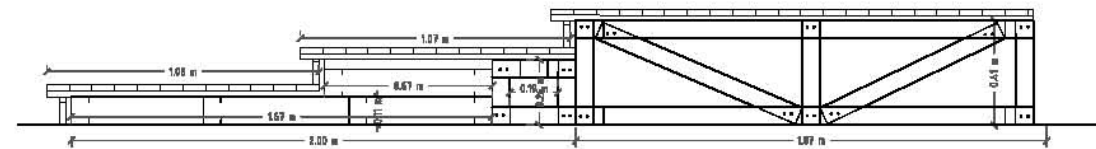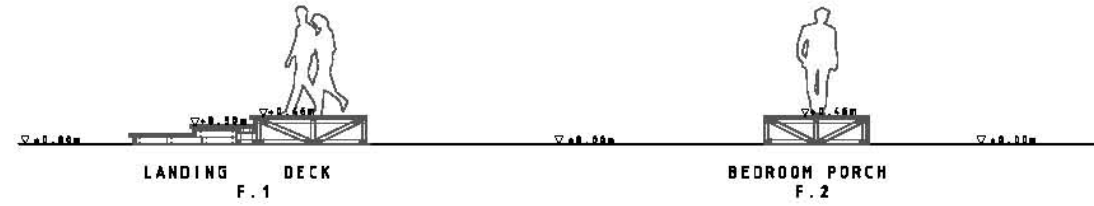


SECTION OUTDOOR AREA F.1

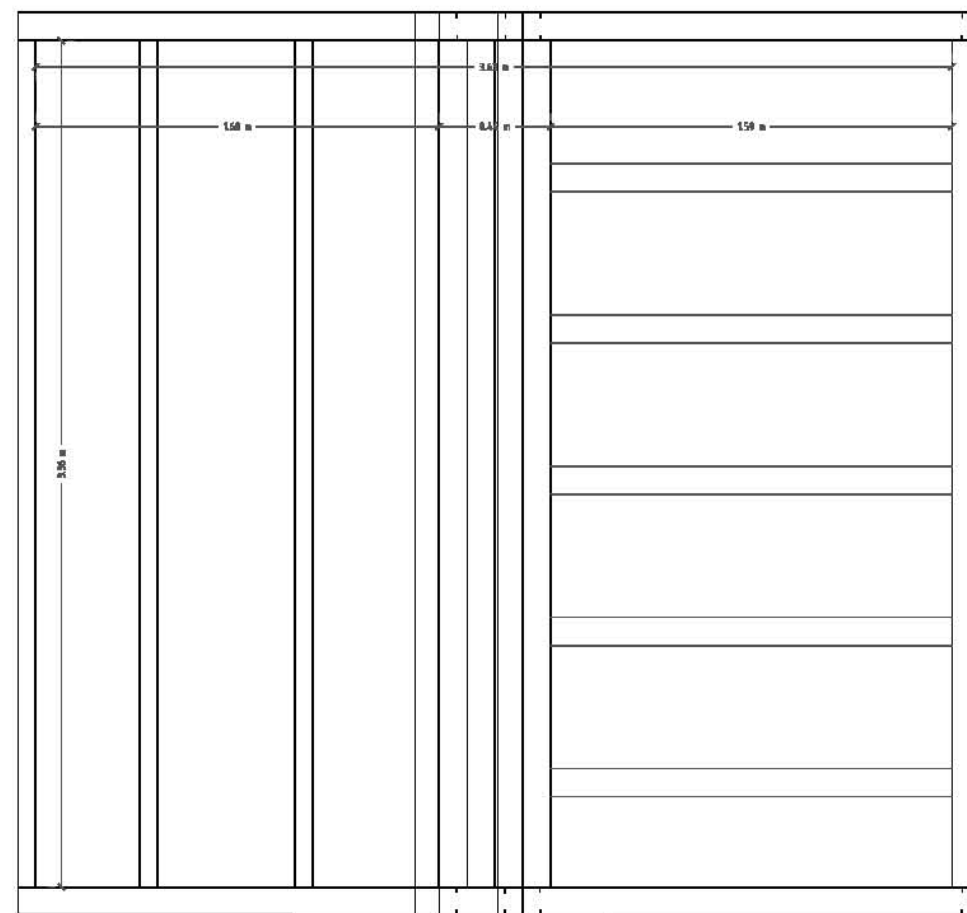

TOP OUTDOOR AREA F.1

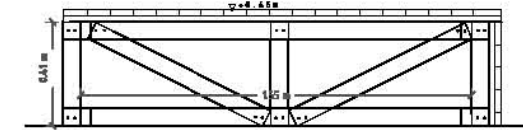

SECTION OUTDOOR AREA F.2

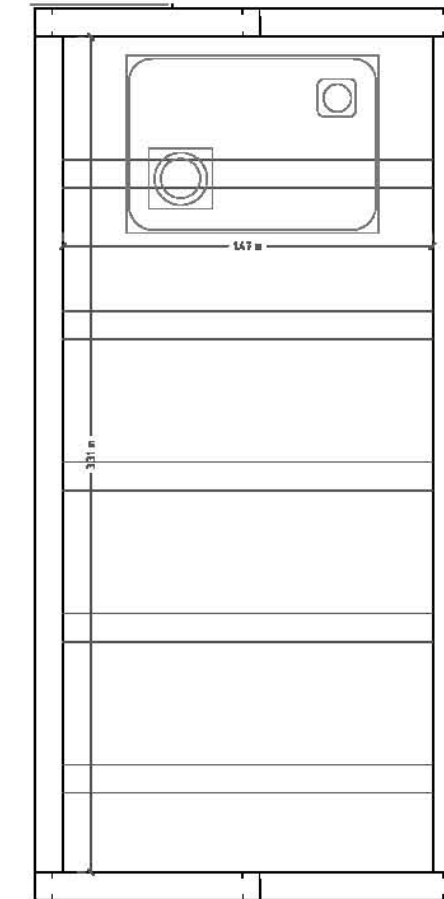


TOP OUTDOOR AREA F.2



BC-50

DATE: 08.04.2005

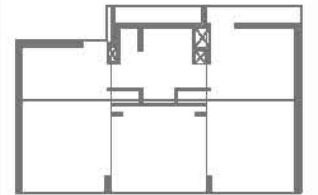

SCALE_1:30



MERCEDES PEÑA
ISABEL MONTANES
plan designer

CARLOS BERMEJO
design coordinator

MIGUEL GOMEZ
general coordinator

JOE WORCESTER
professional engineer

ALFONSO GARCIA-SANTOS
construction manager

JAVIER NEILA
architecture manager

ESTEFANIA CAAMAÑO
general coordinator



06/07

BC-50

1:30

OUTDOOR AREAS