

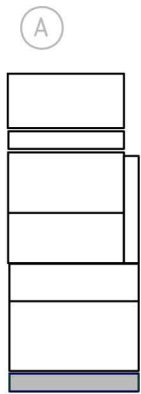



AREA 3
OSB FLAT ROOF PANELS (OFFICE AREA)

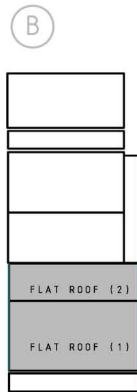

OSB ROOF PANELS (A)

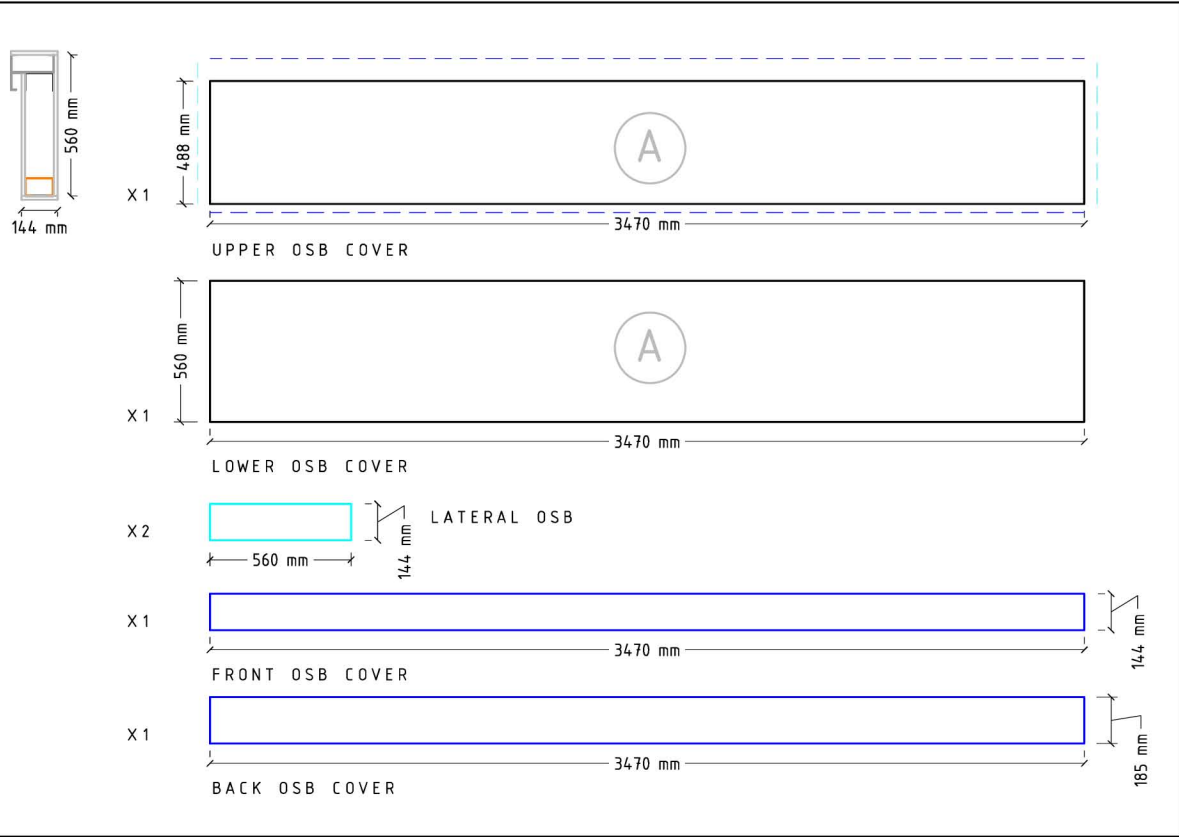


OSB ROOF PANELS (B)

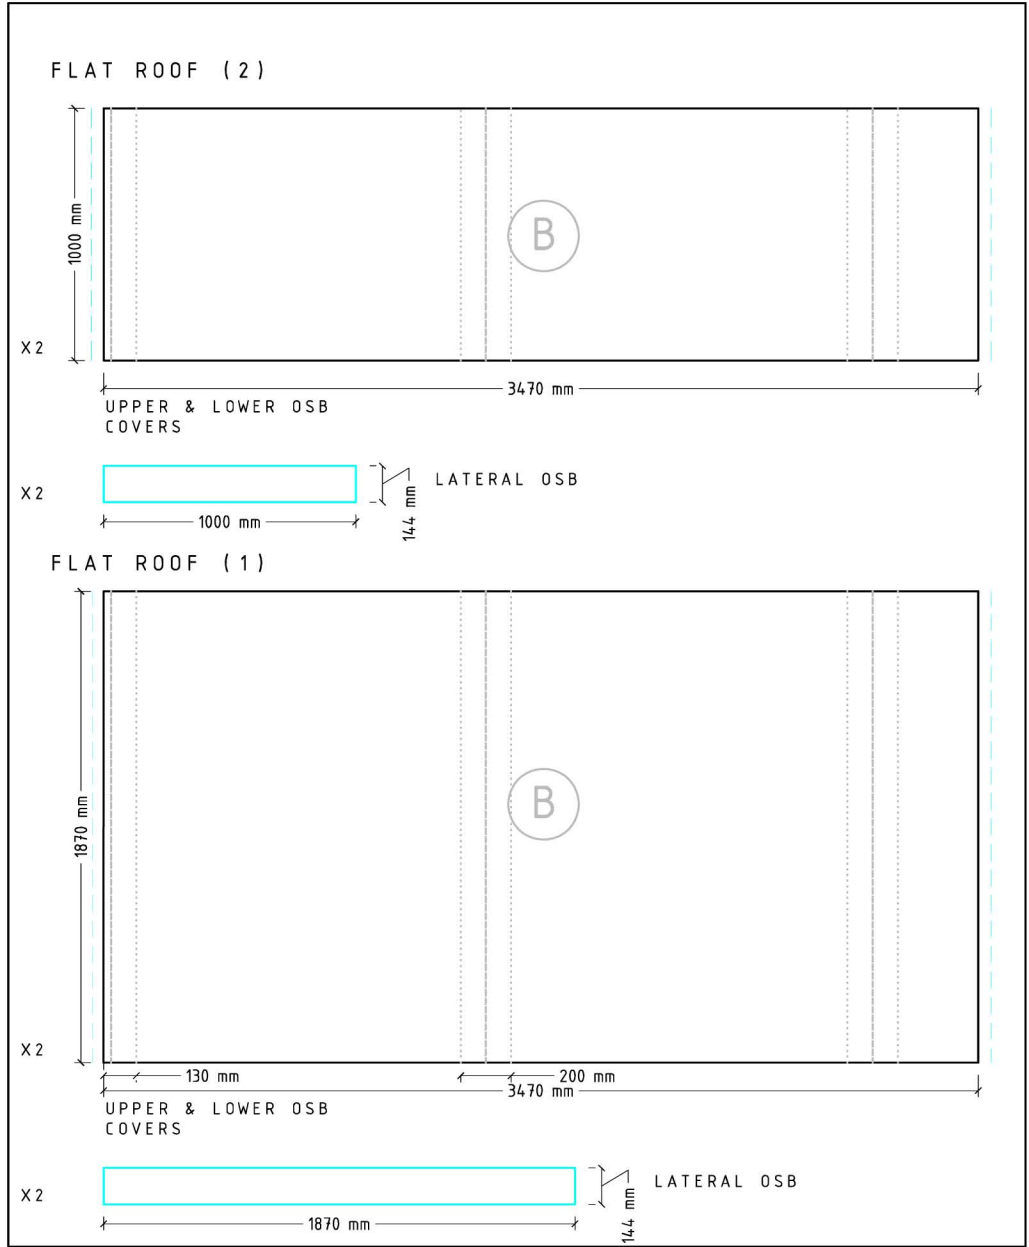


S - 22

DATE: 08.04.2005

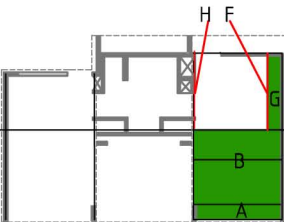

SCALE_1:30

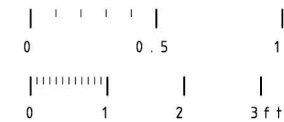

LETICIA RO-BER
plan designer
CARLOS BERMEJO
design coordinator
MIGUEL GOMEZ
general coordinator

JOE WORCESTER
professional engineer

ALFONSO GARCÍA-SANTOS
construction manager

JAVIER NEILA
architecture manager

ESTEFANÍA CAAMAÑO
general coordinator



Universidad Politécnica de Madrid (UPM)

04/10

S - 22

1:30

OSB PANELS: ROOF LAYOUT