


DAY 1



ASSEMBLED ELEMENT  
WALLS  
PACKING LIST REFERENCE  
1.4  
ESTIMATED TIME OF ASSEMBLY  
4 HOURS




WEST ELEVATION

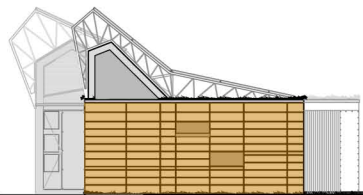

NORTH ELEVATION

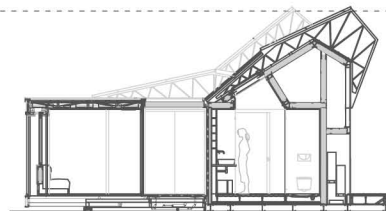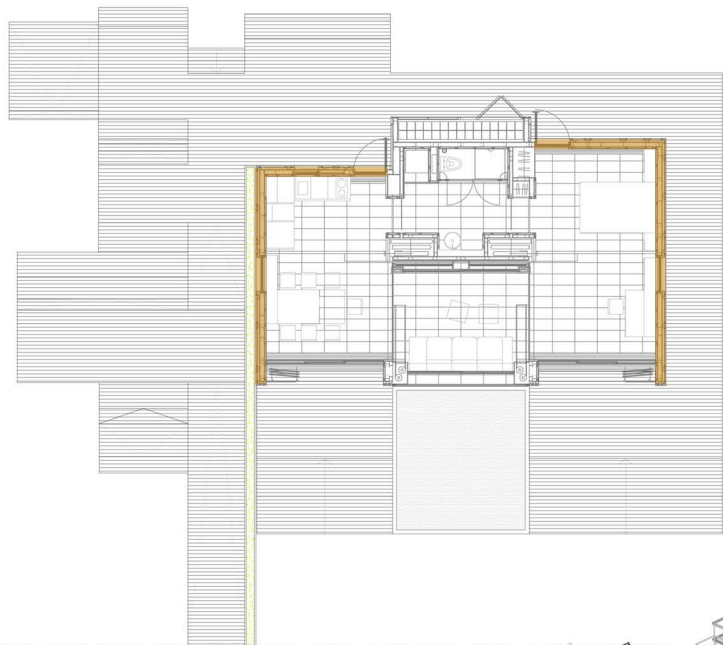

CROSS SECTION

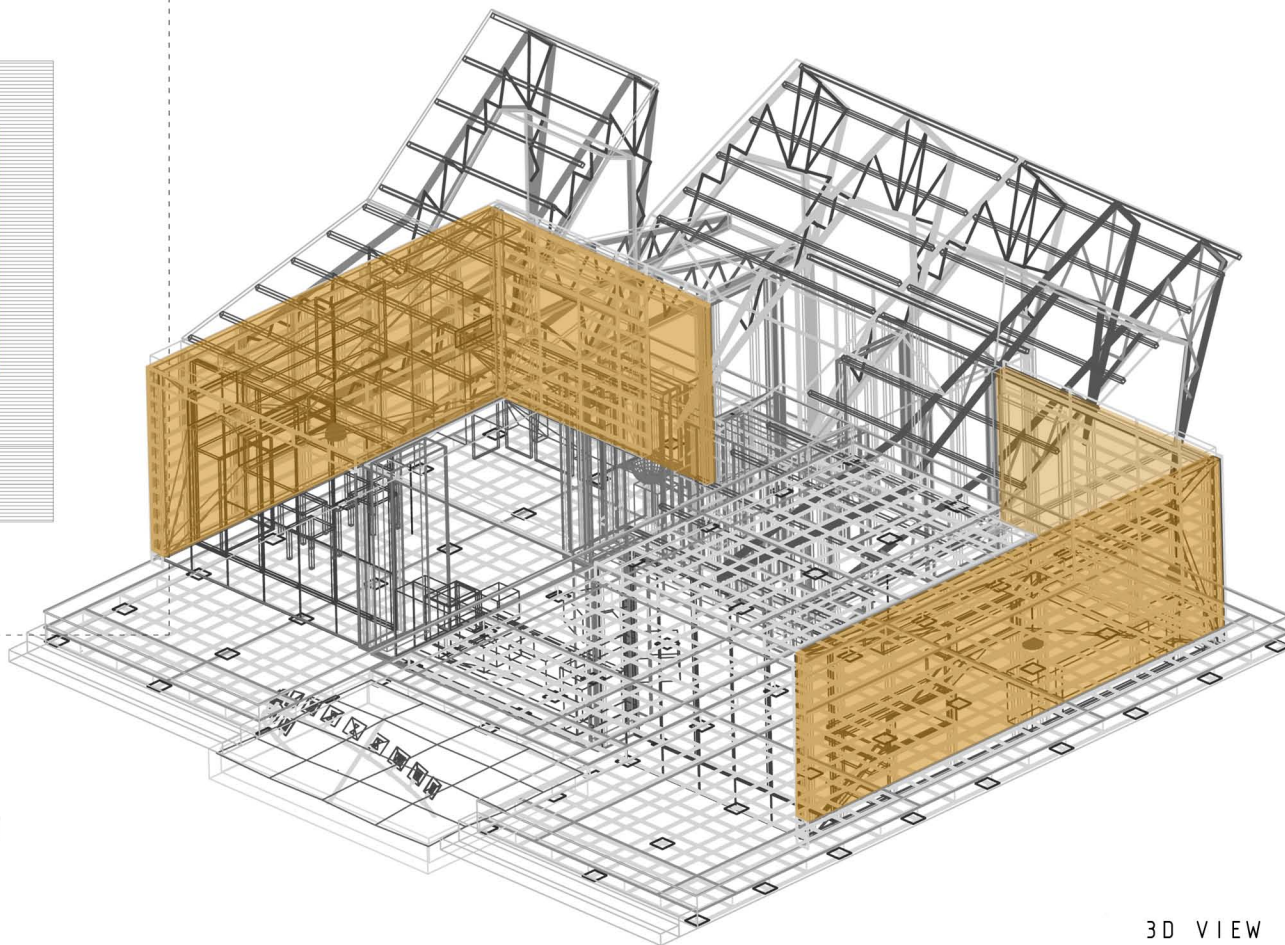

3D VIEW



AD-59

DATE: 08.04.2005



SCALE\_1:200

0 1 2 3m  
0 5 10ft

DESIGNER  
COORDINATORS  
SUPERVISORS  
DECATHLETES

IVÁN ALCANTARILLA  
plan designer

CARLOS BERMEJO  
design coordinator

MIGUEL GOMEZ  
general coordinator

ALFONSO GARCIA-SANTOS  
construction manager

JAVIER NEILA  
architecture manager

ESTEFANIA CAAMAÑO  
general coordinator



unfolding under the sun  
Universidad Politécnica de Madrid (UPM)



04 / 10

AD - 59

1:200

ASSEMBLY