

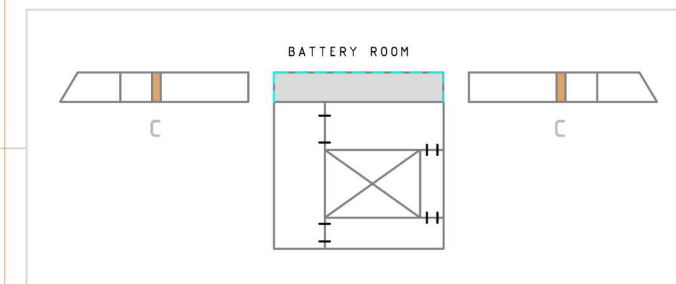
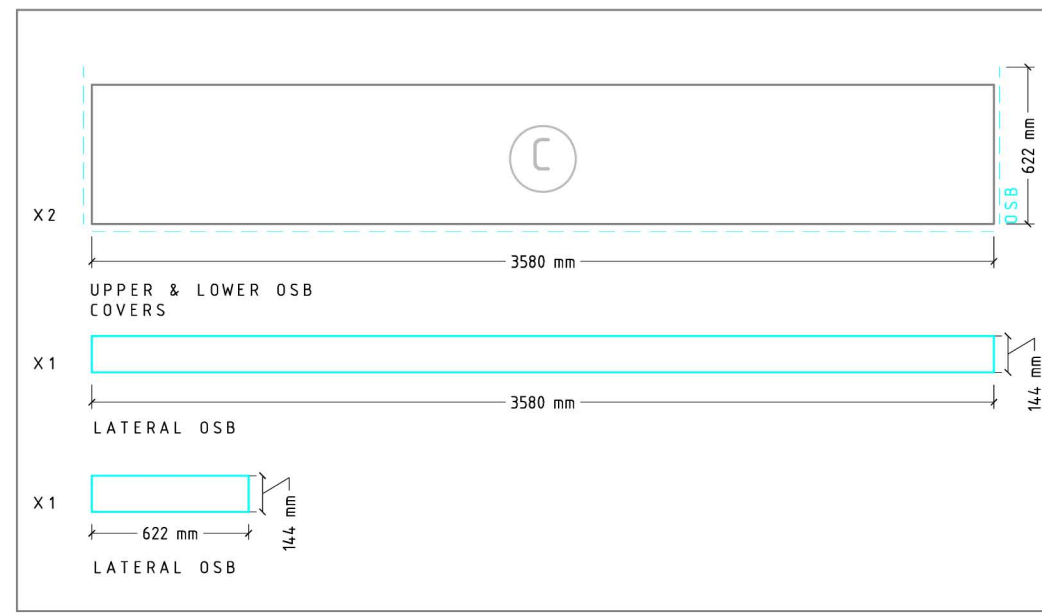
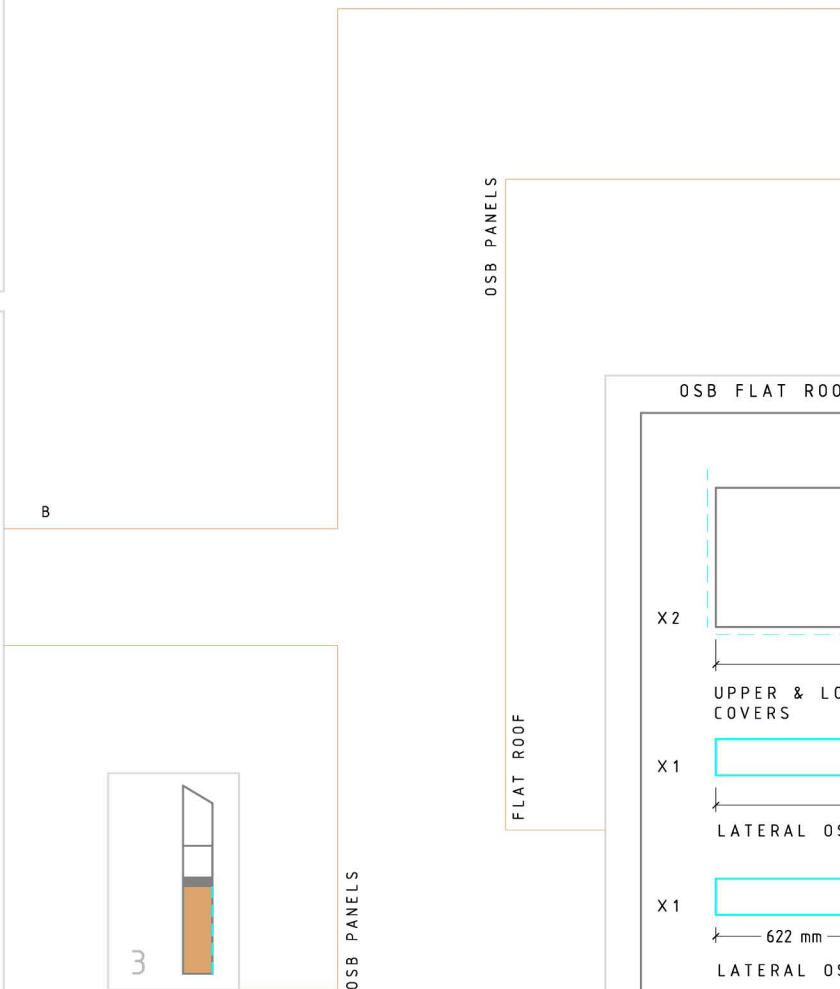
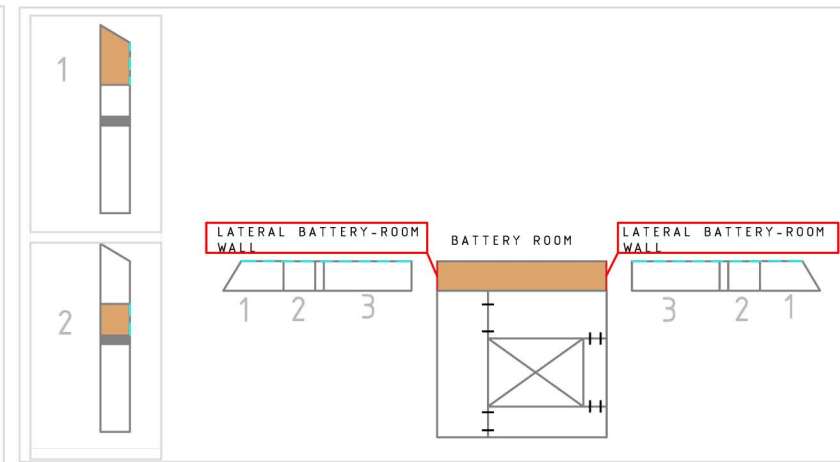
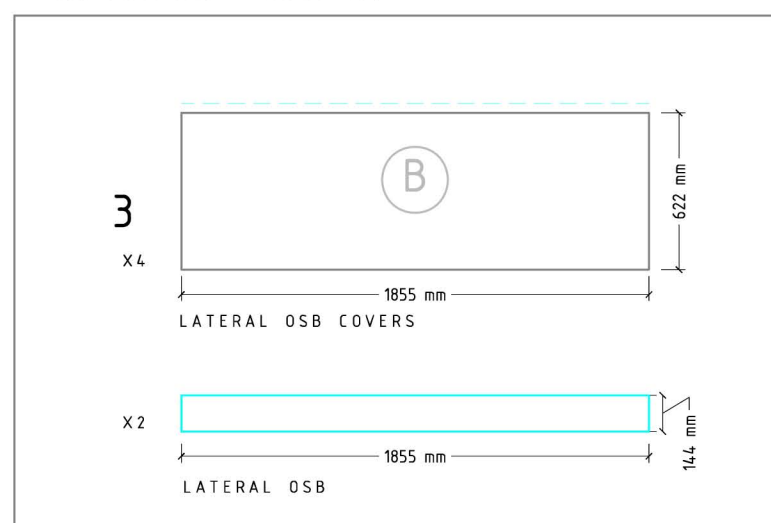


OSB PANELS (BATTERY ROOM ROOF AND WALL STRUCTURE)

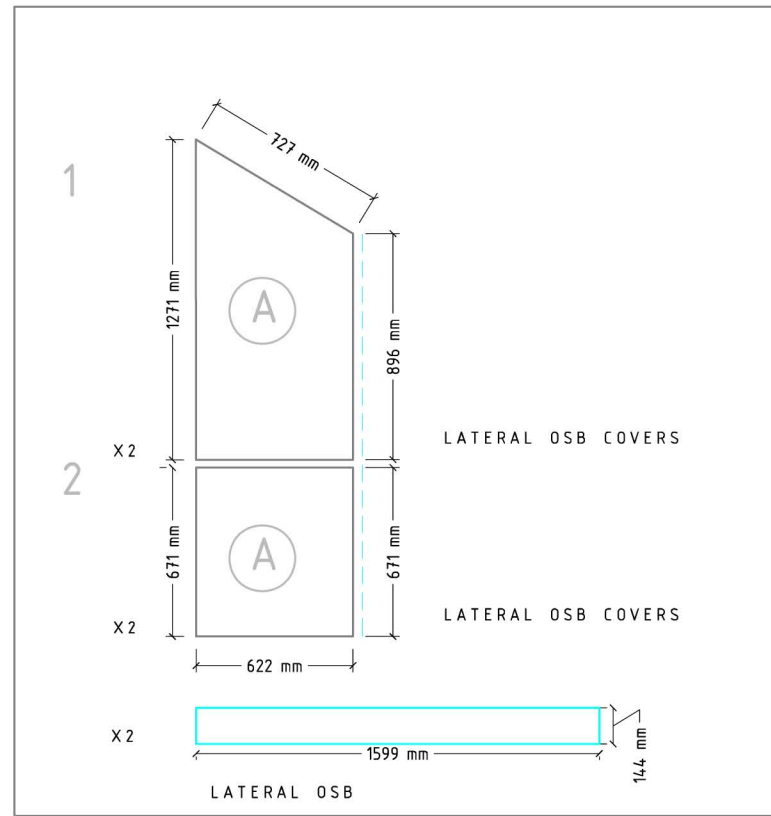

DATE: 08.04.2005

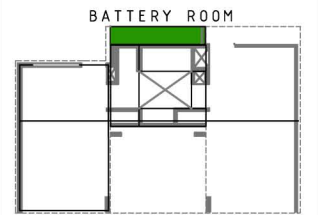

MIGUEL GOMEZ
general coordinator

ESTEFANÍA CAAMAÑO
general coordinator

