
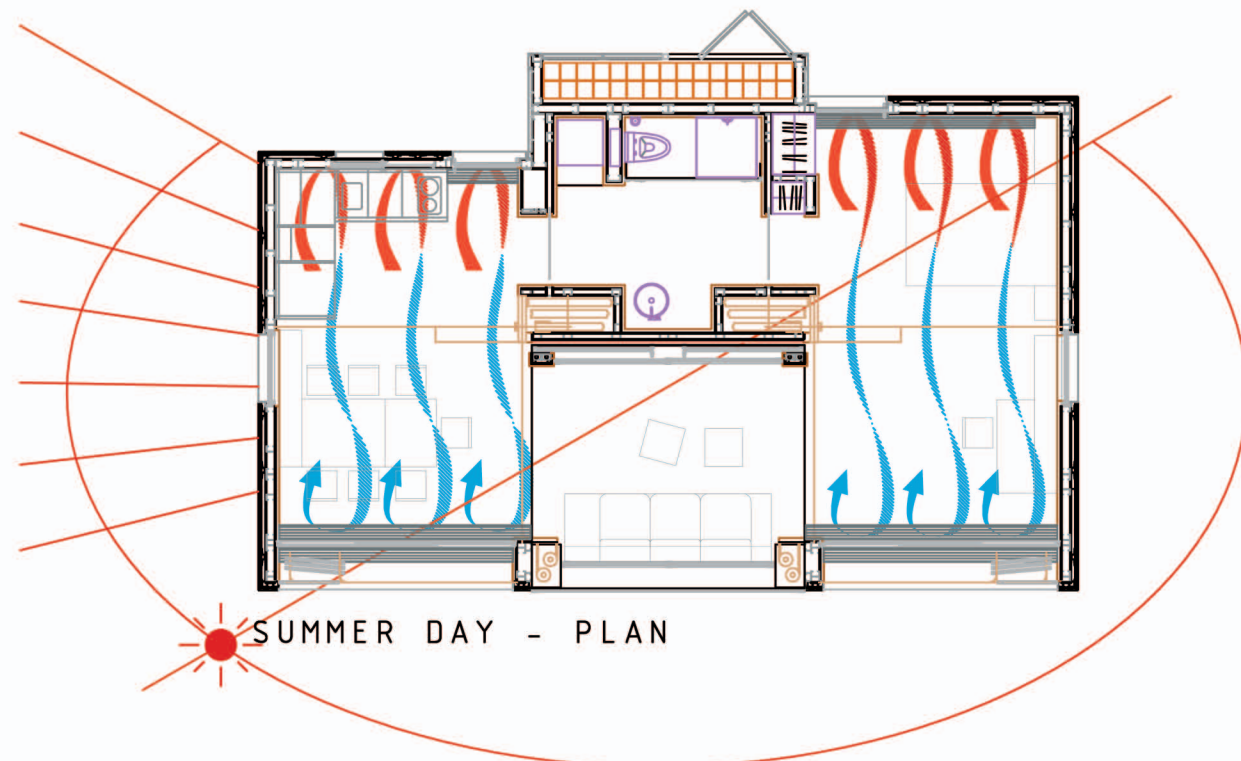


SUMMER DAY - SECTION F

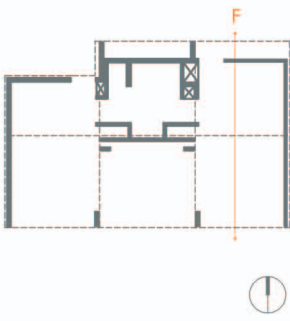

SUMMER DAY - PLAN

C O O R D I N A T O R S			BIOCLIMATIC WORKING: SUMMER	
E S T E F A N I A C A A M A Ñ O general coordinator				
J A V I E R N E I L A architecture manager				
A L F O N S O G A R C I A - S A N T O S construction manager				
S U P E R V I S O R S				
D E C A T H L E T E S				
M I G U E L G O M E Z general coordinator				
C A R L O S B E R M E J O design coordinator				
C A R L O S B E R M E J O plan designer				
SEVERAL SCALES			SEVERAL SCALES	
SCALE_1: 50 SCALE_1: 100				
SEVERAL SCALES				
			BD - 25 03/03	
DATE: 08.04.2005			BD - 25	
BD - 25			F	
C:\Documents and Settings\bermejo\My Documents\BIOCLIMATIC\BIOCLIMATIC\BIOCLIMATIC.rvt				
Universidad Politécnica de Madrid (UPM)				