


WINDOW C1
SCALE: 1/20

A. DOUBLE LAYER OF TRANSLUCENT POLYCARBONATE
+ SEE-THROUGH CELLULOSE
B. MECHANICALLY / MANUALLY OPERABLE WINDOW

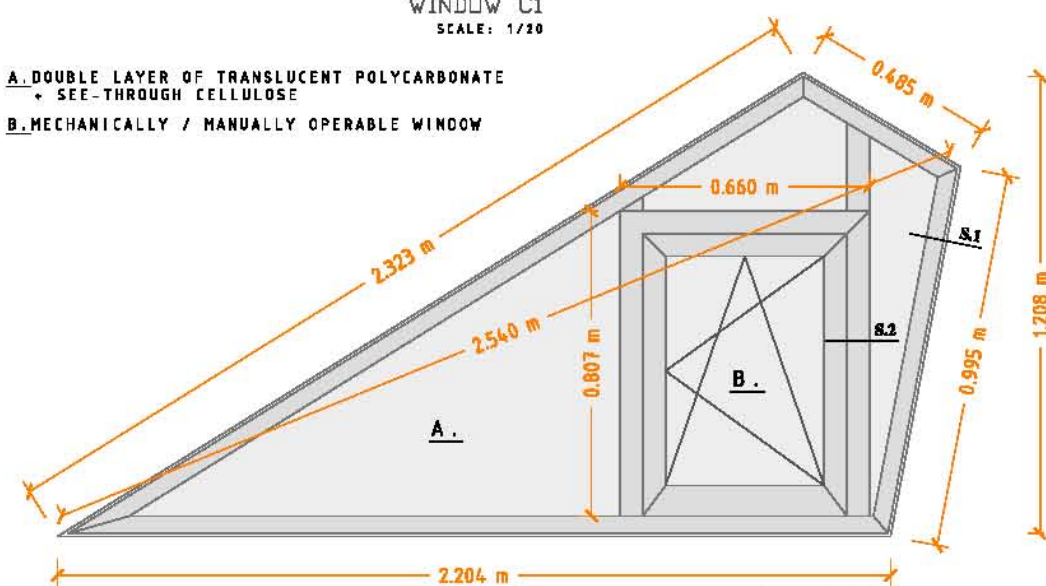


WINDOW C2
SCALE: 1/20



WINDOW C1




WINDOW C2

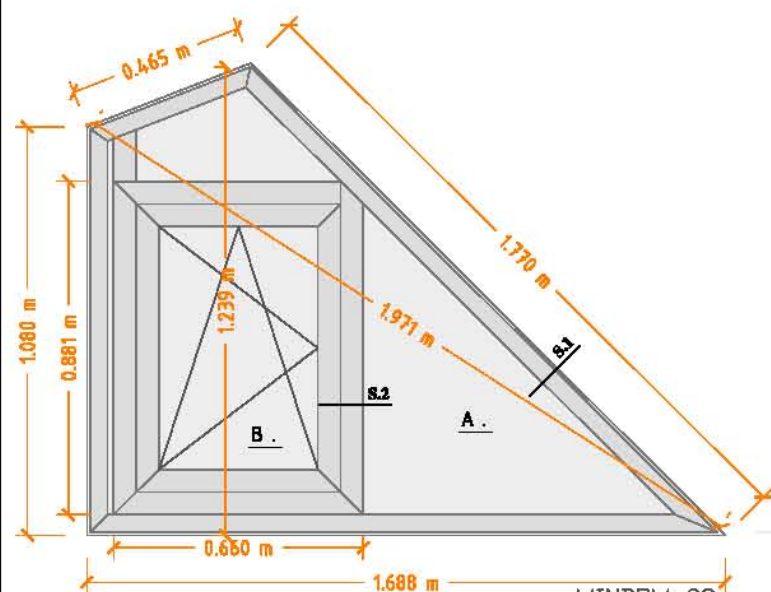


WINDOW C3
SCALE: 1/20



WINDOW C3

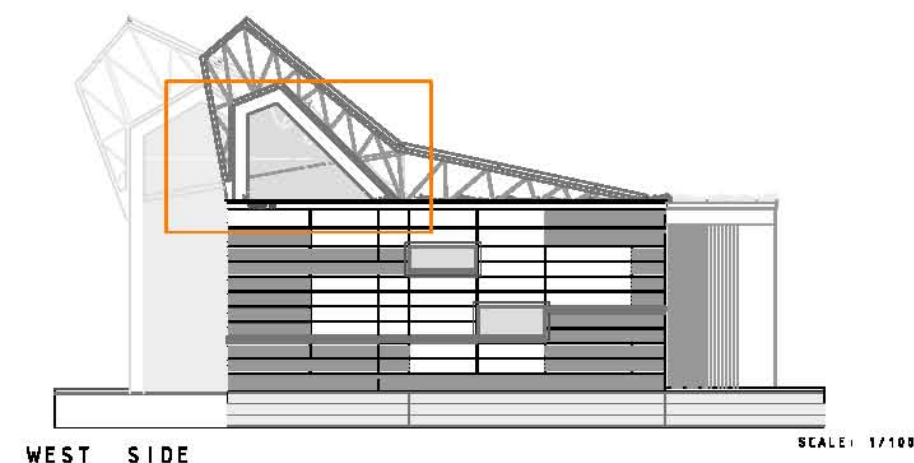


WEST SIDE

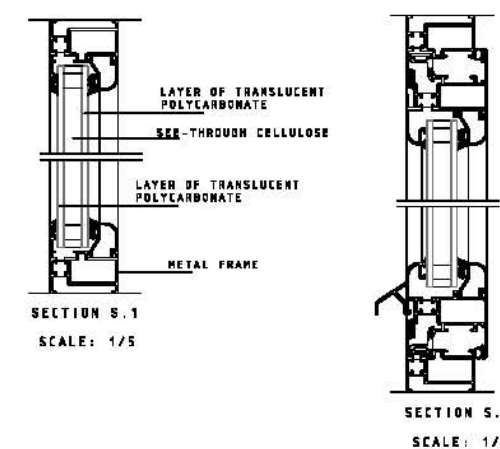


SECTION S.1
SCALE: 1/5


SECTION S.2
SCALE: 1/5

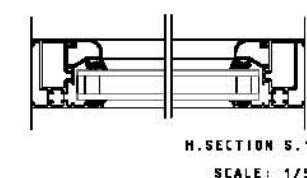

H. SECTION S.1
SCALE: 1/5

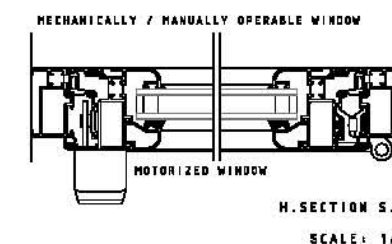

H. SECTION S.2
SCALE: 1/5

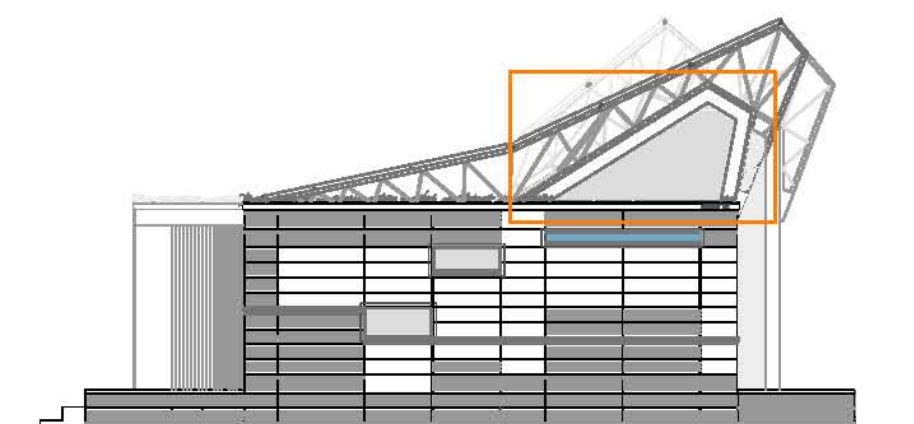


EAST SIDE



BC-47

DATE: 08.04.2005

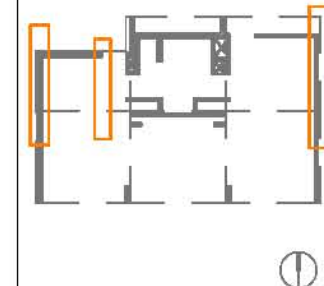

BC-47 07/07

SEVERAL SCALES

1:100

1:20

1:5

SEVERAL
SCALES

Jose Luis
Perez-Griffa
plan designer

CARLOS BERMEJO
design coordinator

MIGUEL GOMEZ
general coordinator

COORDINATORS SUPERVISORS DECAHLETES
ALFONSO GARCIA-SANTOS
construction manager
JAVIER NEILA
architecture manager
ESTEFANIA CAAMAÑO
general coordinator

GLAZING AND FRAMING



unfolding under the sun
Universidad Politécnica de Madrid (UPM)