

ADA-58

DATE: 08.04.2005




01/03

ADA-58



SCALE 1:50

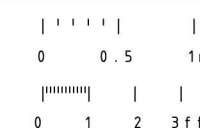

1:50

COORDINATORS SUPERVISORS DECATHLETES

RAFAEL PALOMARES
plan designer

CARLOS BERMEJO
design coordinator

MIGUEL GOMEZ
general coordinator



ROSA REGATOS
CEAPAT Centro Estatal de
Autonomía Personal y Ayudas
Técnicas.

ALFONSO GARCIA-SANTOS
construction manager

JAVIER NEILA
architecture manager

ESTEFANIA CAAMAÑO
general coordinator

ACCESSIBILITY: FOLDED LAYOUT



unfolding under the sun
Universidad Politécnica de Madrid (UPM)