


DAY 3 to 5


ASSEMBLED ELEMENT
FURNITURE & FINISHES & MOVABLE WALLS
PACKING LIST REFERENCE
2.1, 1.6.3, 1.6.4, 1.6.5
ESTIMATED TIME OF ASSEMBLY
13 HOURS




WEST ELEVATION

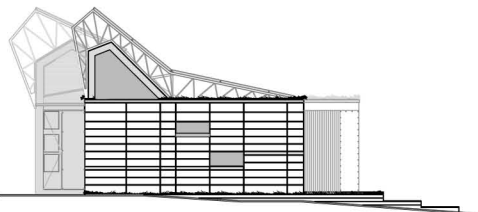

NORTH ELEVATION

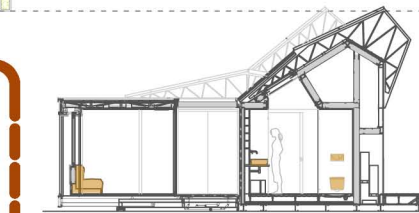

CROSS SECTION

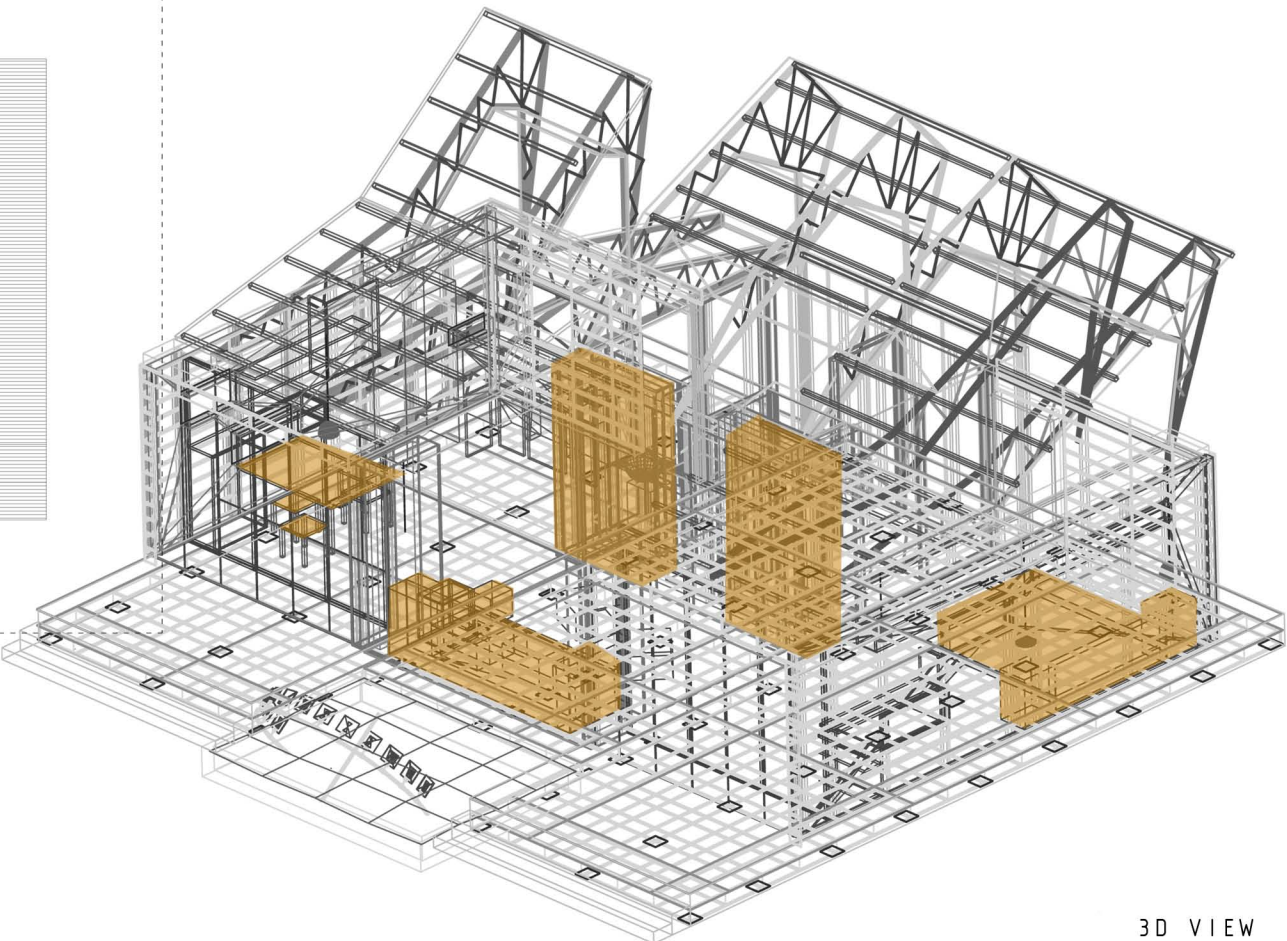

3D VIEW




AD-59

DATE: 08.04.2005



SCALE 1:200

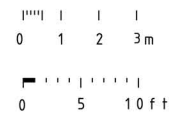

IVÁN ALCANTARILLA
plan designer
CARLOS BERMEJO
design coordinator
MIGUEL GOMEZ
general coordinator

ALFONSO GARCIA-SANTOS
construction manager
JAVIER NEILA
architecture manager
ESTEFANIA CAAMAÑO
general coordinator



unfolding under the sun
Universidad Politécnica de Madrid (UPM)



09/10

AD-59

1:200

ASSEMBLY

