


A - 16

DATE: 08.04.2005



SCALE_1:40

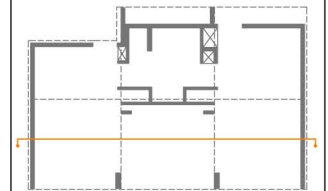

01/01

A - 16

1:40

COORDINATORS SUPERVISORS DESIGNERS	MONICA ALMAGRO plan designer
	CARLOS BERMEJO design coordinator
	MIGUEL GOMEZ general coordinator
COORDINATORS SUPERVISORS ARCHITECTS	ALFONSO GARCIA-SANTOS construction manager
	JAVIER NEILA architecture manager
	ESTEFANIA CAAMAÑO general coordinator

SOUTH-FACING LONGITUDINAL SECTION



Universidad Politécnica de Madrid (UPM)