



CONNECTION OF PHOTOVOLTAIC MODULES

S 1 / 4 0

Photovoltaic areas

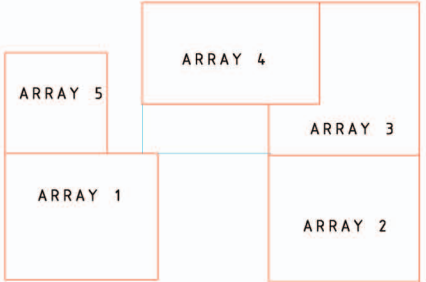

S 1 / 2 0 0

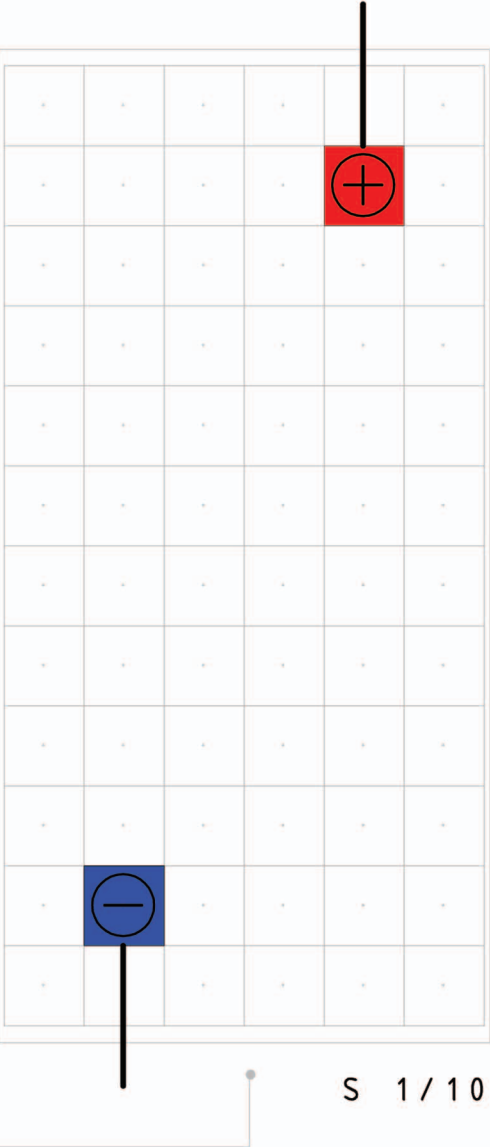

S 1 / 1 0

E - 5 1

DATE: 08.04.2005

02/05

SEVERAL SCALES

SCALE_1: 10
SCALE_1: 40
SCALE_1: 200

SEVERAL SCALES

COORDINATORS SUPERVISORS DECATHLETES

MARCOS CALVO
plan designer

MONICA ALMAGRO
graphic designer

MIGUEL GOMEZ
general coordinator

ENGINEERING, ARCHITECTURE AND CONSULTING

ANTONIO VILLANUEVA
IDOM industrial engineer

ALFONSO GARCIA-SANTOS
construction manager

JAVIER NEILA
architecture manager

ESTEFANIA CAAMAÑO
general coordinator

PHOTOVOLTAIC SYSTEM: CONNECTIONS

unfolding under the sun
Universidad Politécnica de Madrid (UPM)