




WEST ELEVATION

SOUTH ELEVATION

EAST ELEVATION


NORTH ELEVATION



UPM Madrid
2005 SOLAR DECATHLON

A - 06

DATE : 08.04.2005

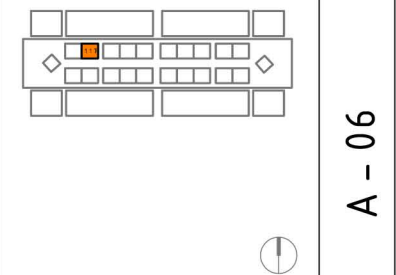

01/01

A - 06

SCALE_1 : 100

0 0.5 1 2 3m

0 1 5 10ft

1 : 100

COORDINATORS

ALFONSO GARCIA-SANTOS
construction manager

JAVIER NEILA
architecture manager

ESTEFANIA CAAMAÑO
general coordinator

SUPERVISORS


DECATHLETES

IVÁN ALCANTARILLA
plan designer

CARLOS BERMEJO
design coordinator

MIGUEL GOMEZ
general coordinator

SITE ELEVATIONS



magic BOX

unfolding under the sun

Universidad Politécnica de Madrid (UPM)