


A - 15

DATE: 08.04.2005



SCALE\_1:40

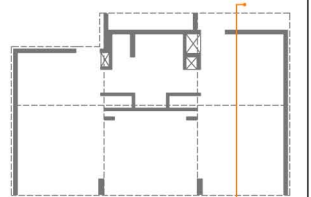

MONICA ALMAGRO  
plan designer

CARLOS BERMEJO  
design coordinator

MIGUEL GOMEZ  
general coordinator

COORDINATORS

ALFONSO GARCIA-SANTOS  
construction manager

JAVIER NEILA  
architecture manager

ESTEFANIA CAAMAÑO  
general coordinator



Universidad Politécnica de Madrid (UPM)

01/01

A - 15

1:40

BEDROOM + OFFICE SECTION