



PUSH-FIT system PB. (polybutilene)
Plumbing assembly is made with PB straight flexibles pipes and PB parts.

NUEVA TERRAIN MODELS AND DIMENSIONS. PB PARTS.

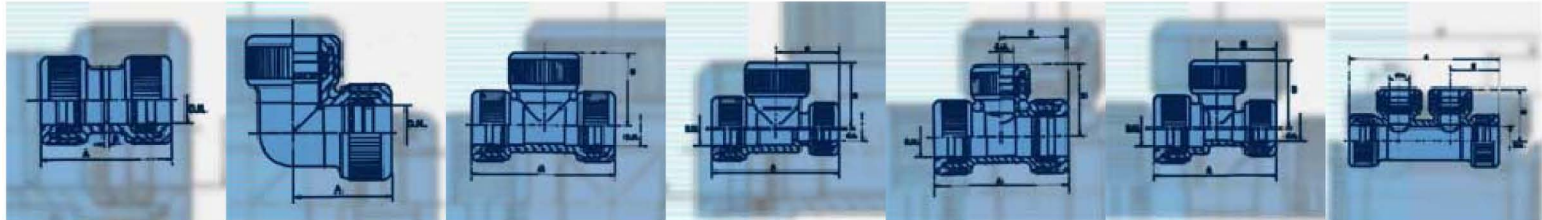

RANGE AND DIMENSIONS. TRANSITION PARTS.

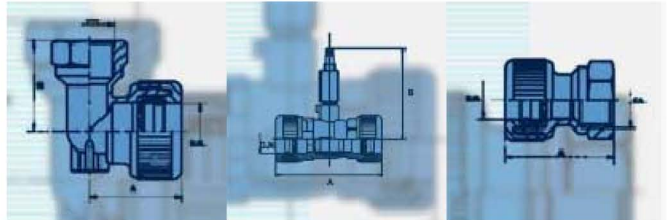


DOMESTIC COLD WATER SUPPLY SYSTEM IN DETAIL.




P - 55

DATE: 08.04.2005

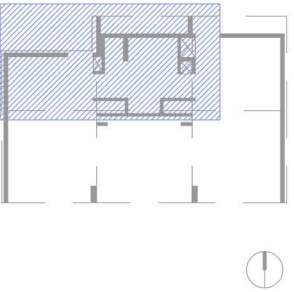

SCALE_1:25

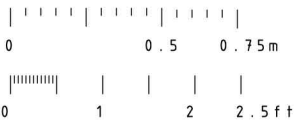

SOFIA MELERO
GONZALO USED
plan designer

CARLOS BERMEJO
design coordinator

MIGUEL GOMEZ
general coordinator



ANTONIO VILLANUEVA
IDOM/professional supervisor

ALFONSO GARCIA-SANTOS
construction manager

JAVIER NEILA
architecture manager

ESTEFANIA CAAMAÑO
general coordinator



unfolding under the sun
Universidad Politécnica de Madrid (UPM)

02/07

P - 55

1:25

PLUMBING DRAWINGS. DCW.