


# SYMBOLS

- D** DATALOGGER
- T** TURBINE
- P** PELTIER
- M** MOTOR
- M<sub>P</sub>** MOBILE WALLS MOTOR
- M<sub>L</sub>** LOCKGATES MOTOR
- M<sub>M</sub>** MOBILE BOX MOTOR
- W** WATER PUMP
- CABLE
- ▨ RACEWAYS (FLOOR)
- ▨ VENTILATION GRILLE
- ▭ LOCKGATE

M-56


DATE: 08.04.2005

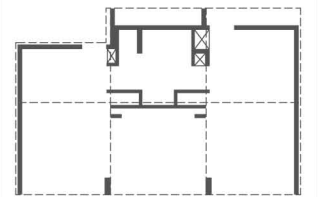

01/01

M-56

SCALE 1:40

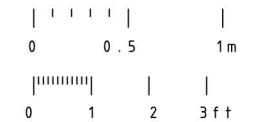

1:40

SUPERVISORS	ALVARO GUTIERREZ plan designer
	RAFAEL PALOMARES graphic designer
	MIGUEL GOMEZ general coordinator
	<b>idom</b> ENGINEERING, ARCHITECTURE AND CONSULTING
COORDINATORS	ANTONIO VILLANUEVA IDOM industrial engineer
	ALFONSO GARCIA-SANTOS construction manager
	JAVIER NEILA architecture manager
	ESTEFANIA CAAMAÑO general coordinator

GENERAL MECHANICAL SYSTEM