



Detail A

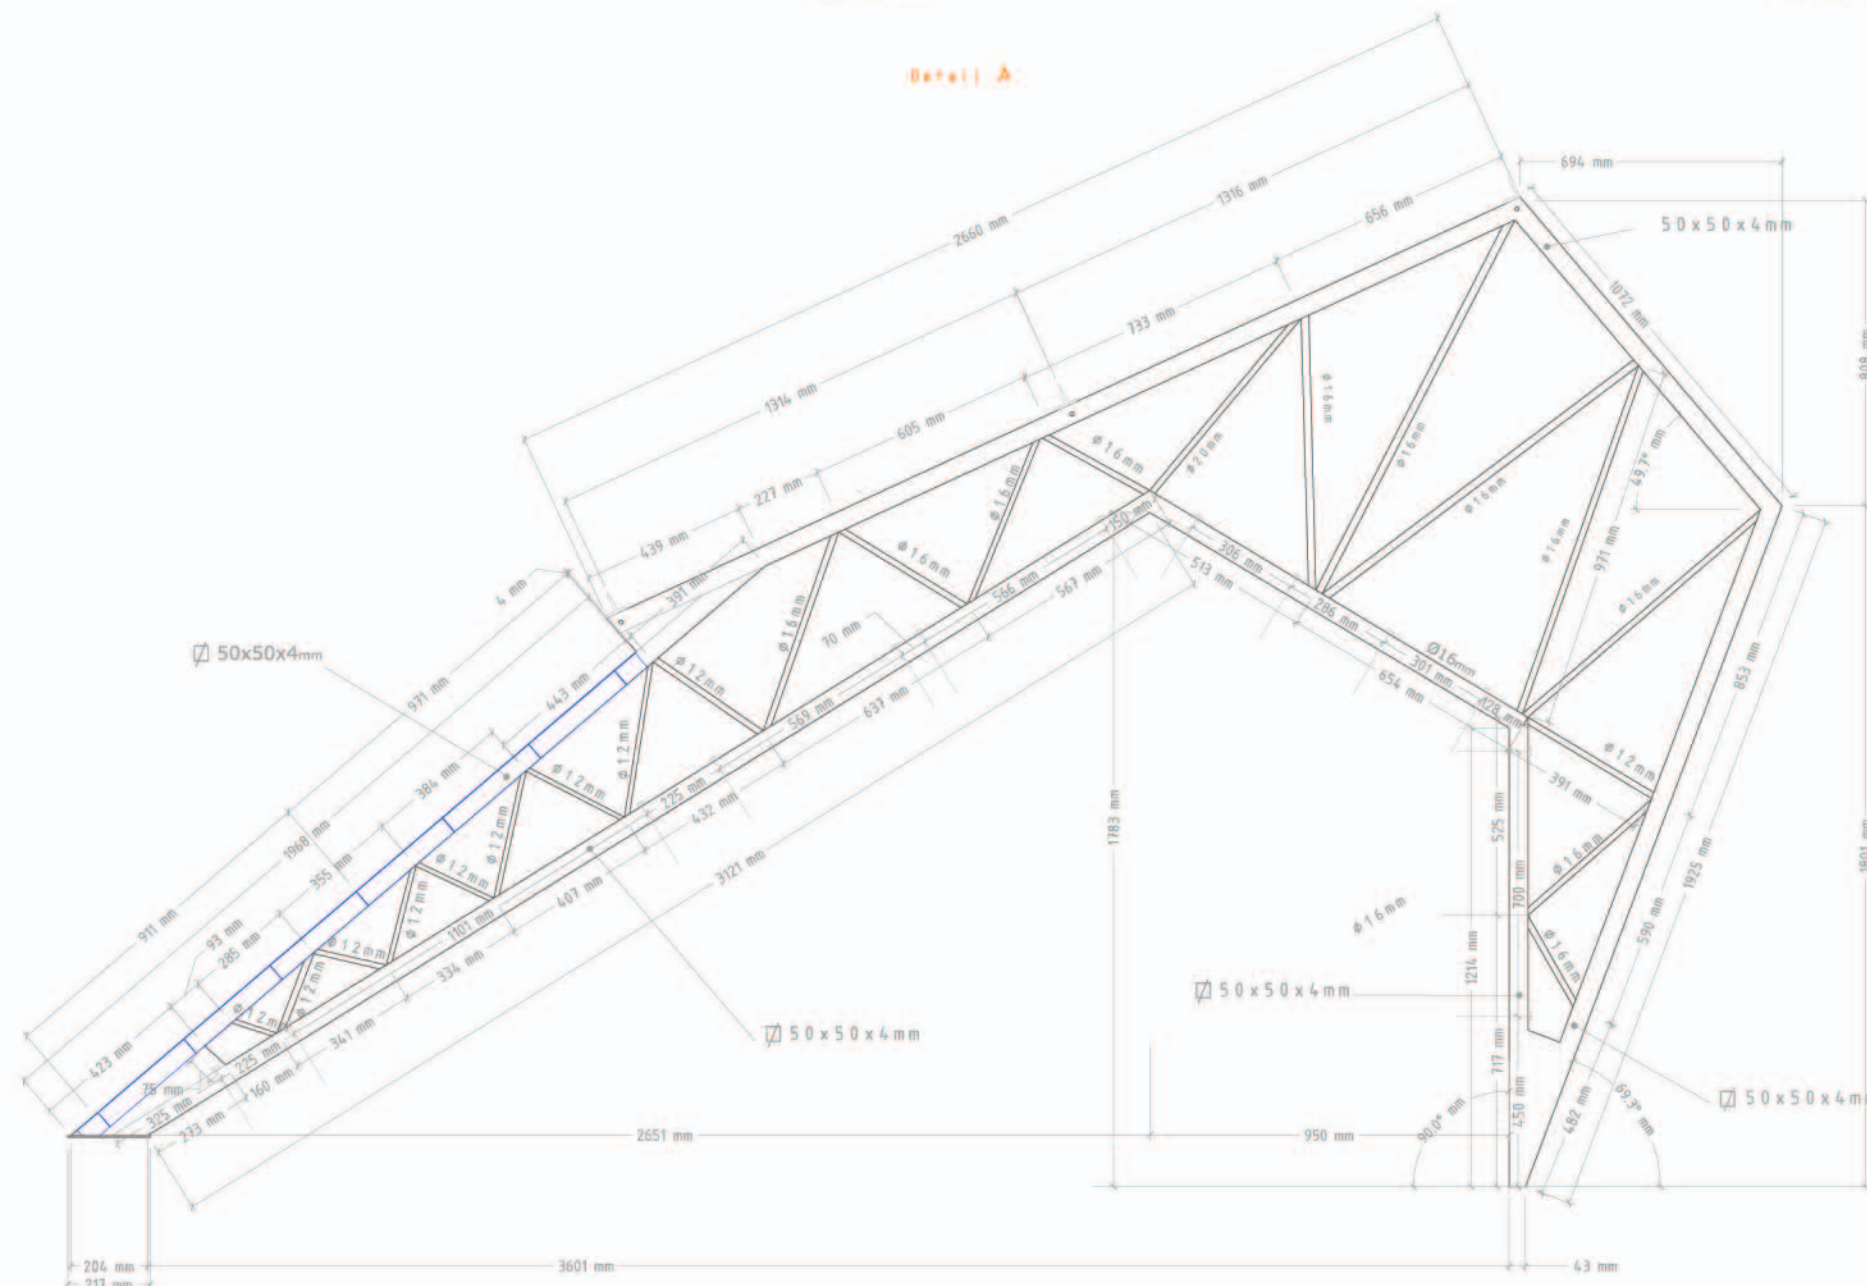

S - 21


DATE: 08.04.2005

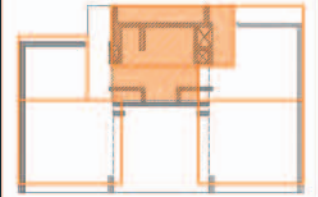

04/07

S - 21

SCALE_1:20

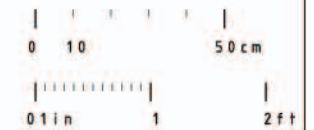

1:20

DECATHLETES

LUIS CLIMENT
plan designer

CARLOS BERMEJO
design coordinator

MIGUEL GOMEZ
general coordinator

COORDINATORS SUPERVISORS

JOE WORCESTER
professional engineer

ESTEFANIA CAAMAÑO
general coordinator

JAVIER NEILA
architecture manager

ALFONSO GARCIA-SANTOS
construction manager

ROOF FRAMING: TRUSS C



unfolding under the sun
Universidad Politécnica de Madrid (UPM)