


DAY 2



ASSEMBLED ELEMENT
CERAMIC FLOORING
PACKING LIST REFERENCE
1.6.2
ESTIMATED TIME OF ASSEMBLY
8 HOURS




WEST ELEVATION

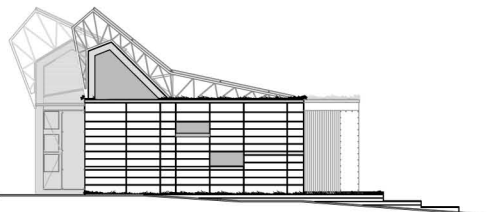


NORTH ELEVATION

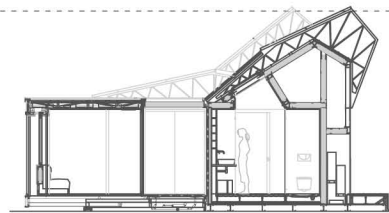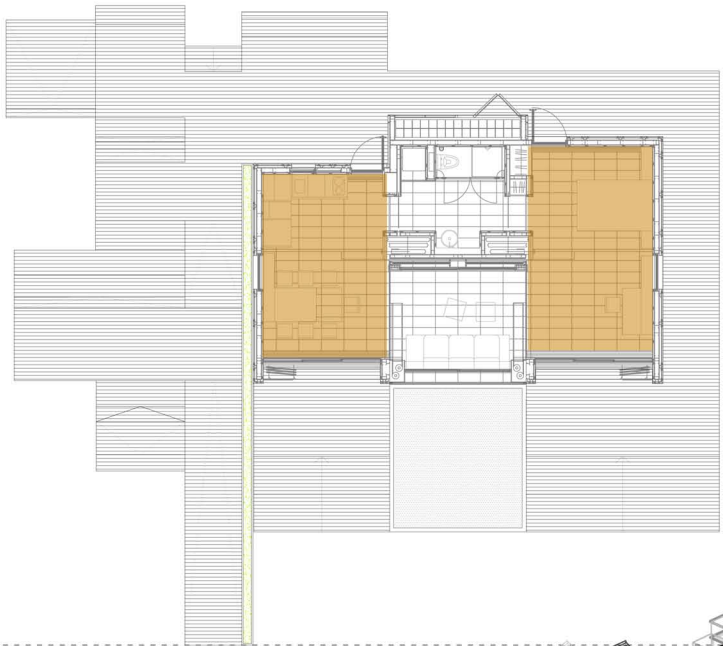

CROSS SECTION

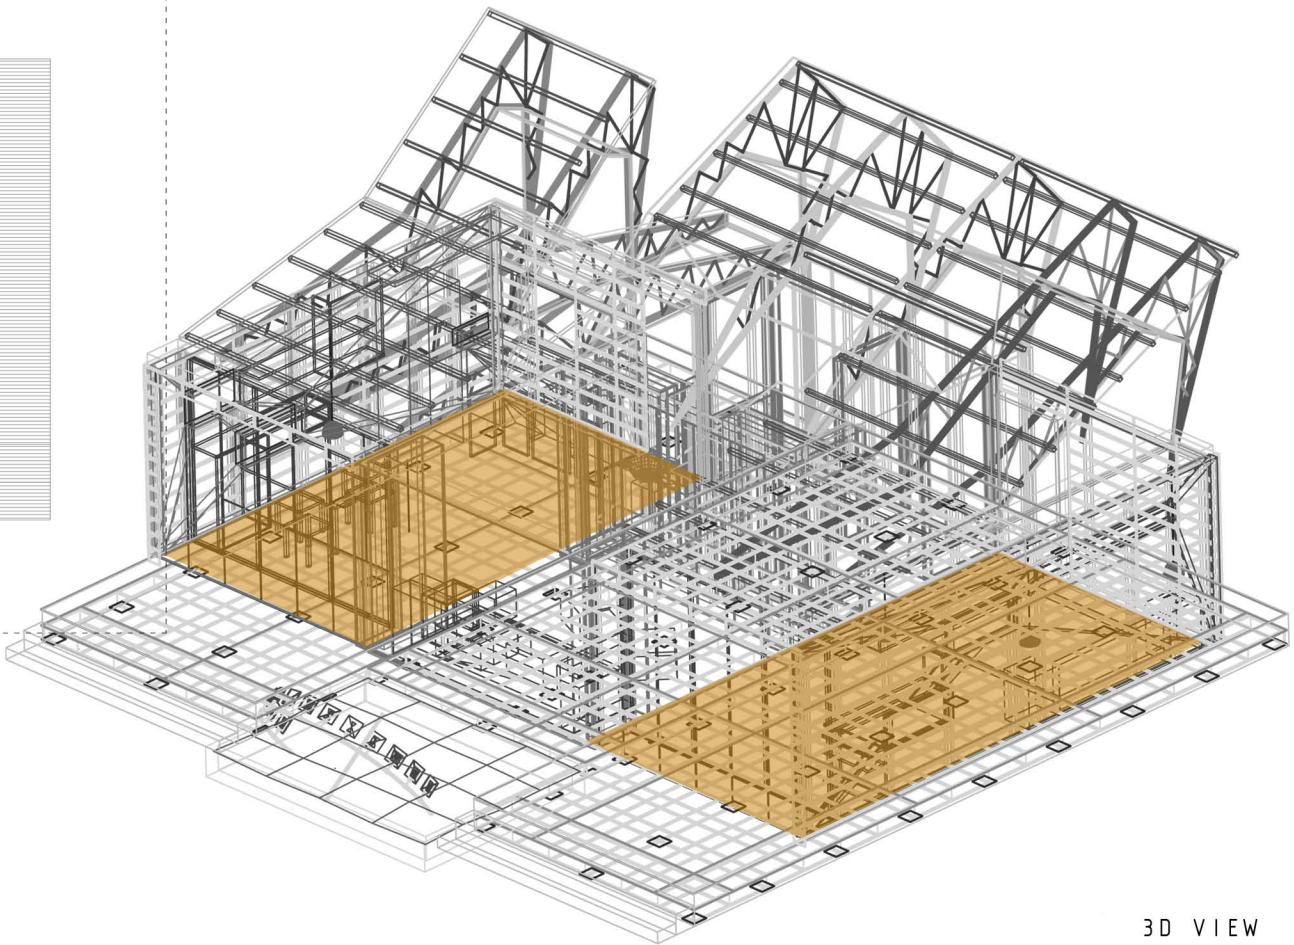


3D VIEW

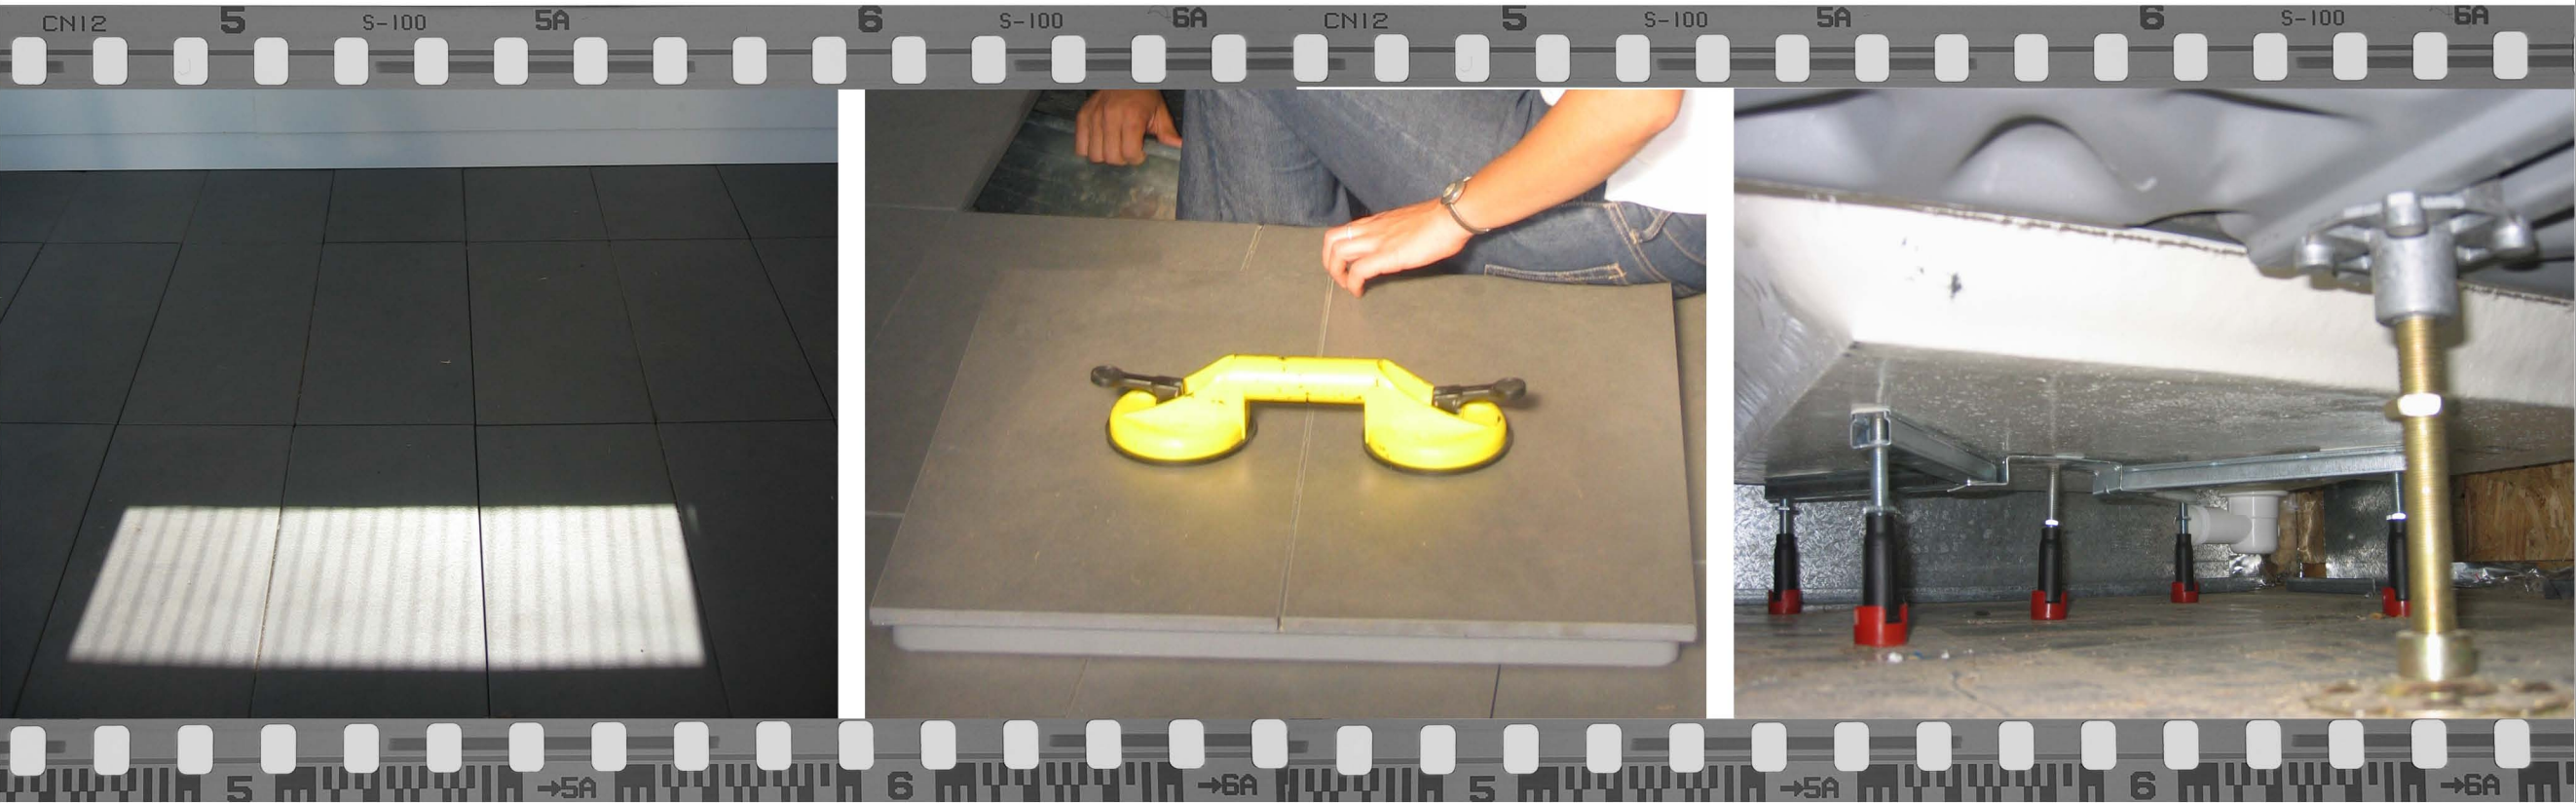


AD-59

DATE: 08.04.2005

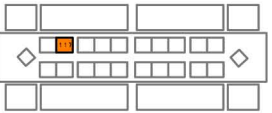

SCALE_1:200

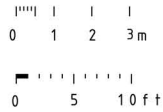

DEKATHLETES
IVÁN ALCANTARILLA
plan designer
CARLOS BERMEJO
design coordinator
MIGUEL GOMEZ
general coordinator

COORDINATORS
ALFONSO GARCIA-SANTOS
construction manager
JAVIER NEILA
architecture manager
ESTEFANIA CAAMAÑO
general coordinator



unfolding under the sun
Universidad Politécnica de Madrid (UPM)



07/10

AD-59

1:200

ASSEMBLY