



BATHROOM plan

BATHROOM FURNITURE


gala
"MINIMAL"
STORAGE BOX.
MATERIALS: POLYLAMINATE WITH WOOD FINISH.
(REF.----- / CATALOGUE 2005)

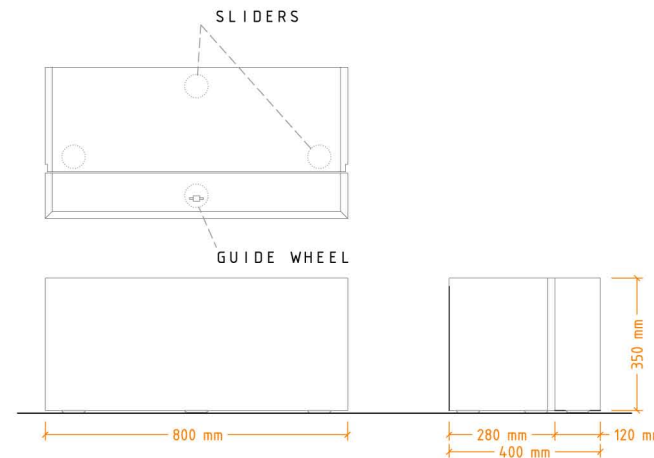

FAUCETS AND ACCESSORIES

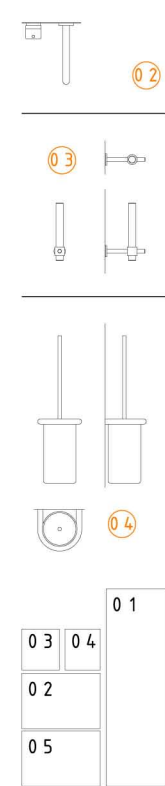

- 01 SHOWER shower mixer set and hand shower flange.
- 02 BASIN "ARQ.", mural washbasin mixer. [catalogue p.159]
- 03 Toilet roll holder.
- 04 Toilet brush holder for wall mounting.

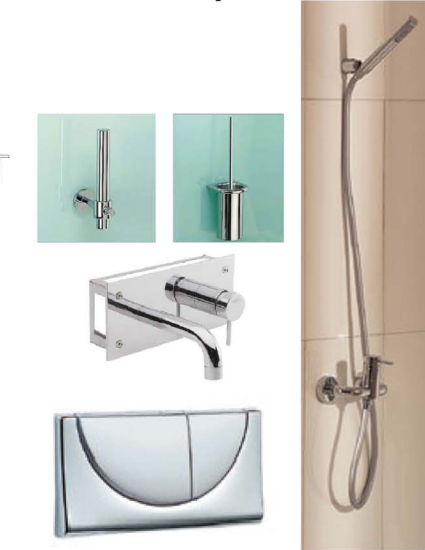

WASHBASIN

gala
"CUBO"
CIRCULAR WASHBASIN. 450X450mm. ϕ 45 mm.
MATERIALS: WHITE PORCELAIN
(REF. 13040 / CATALOGUE 2005).




WALL-MOUNTED TOILET

gala
"ARQ."
WASHDOWN TOILET WITH A TOILET SEAT AND COVER.
MATERIALS: WHITE PORCELAIN
(REF.22172 / CATALOGUE 2004 PG.19)





SHOWER PLATE

gala
"SIRTE"
ACRYLIC SHOWER PLATE. 900X900 MM.
[CATALOGUE 2004 PG.79]
SHOWER PLATFORM: SILESTONE 13MM. WHITE.
FLOOR FINISH: SILESTONE 13 MM. WHITE.

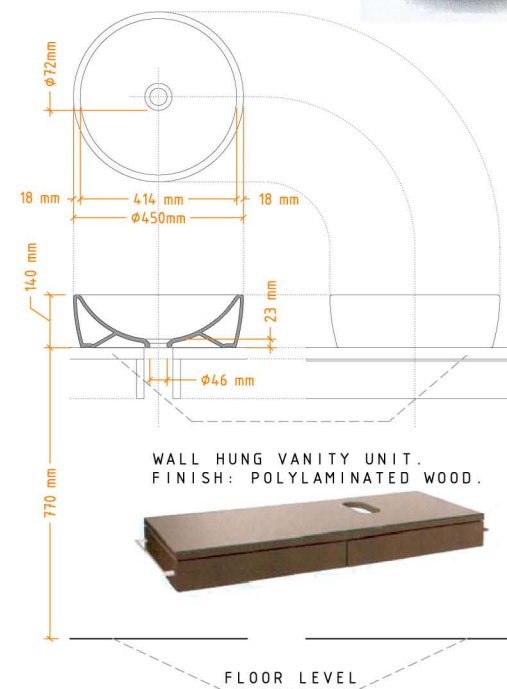


WALL HUNG VANITY UNIT.
FINISH: POLYLAMINATED WOOD.

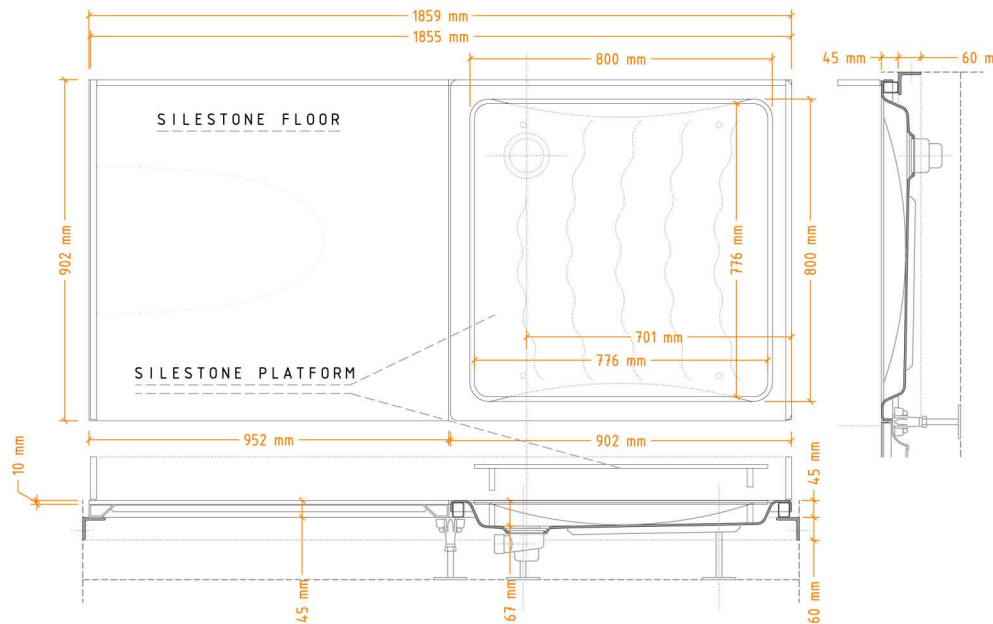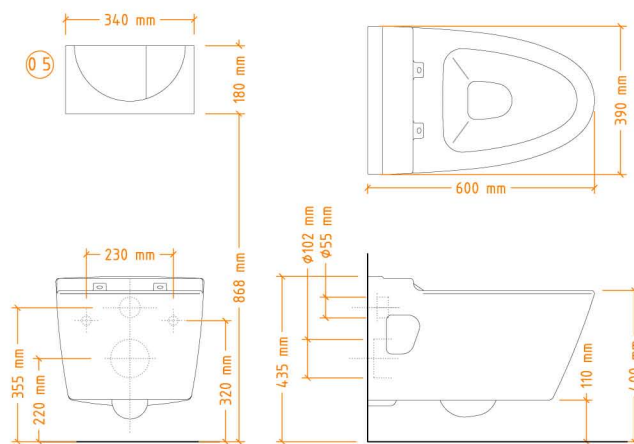


BC - 4 2

DATE: 08.04.2005

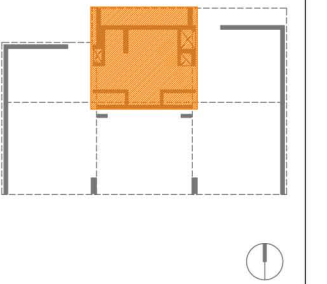

SCALE_1:20

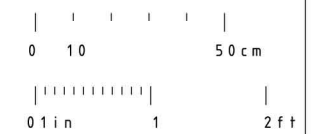

COORDINATORS SUPERVISORS DECATHLETES	SOFIA MELERO GONZALO USED plan designer
	CARLOS BERMEJO design coordinator
	MIGUEL GOMEZ general coordinator
COORDINATORS SUPERVISORS DECATHLETES	ALFONSO GARCIA-SANTOS construction manager
	JAVIER NEILA architecture manager
	ESTEFANIA CAAMAÑO general coordinator



02/02

BC - 4 2

1:20

BATHROOM FURNITURE