


SYMBOLS

- D** DATALOGGER
- W** WATT NODES BOX
- X** TEMPERATURE/HUMIDITY SENSOR
- L_s** LIGHT SENSOR
- T** THERMOCOUPLE
- CABLE
- ▨ RACEWAYS




E - 53

DATE : 08.04.2005

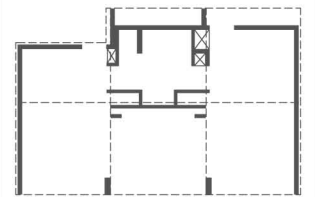

SCALE_1:40

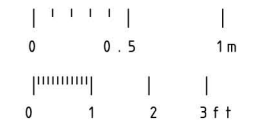

COORDINATORS SUPERVISORS DECATHLETES

ALVARO GUTIERREZ
plan designer

RAFAEL PALOMARES
graphic designer

MIGUEL GOMEZ
general coordinator



ANTONIO VILLANUEVA
IDOM industrial engineer

ALFONSO GARCIA-SANTOS
construction manager

JAVIER NEILA
architecture manager

ESTEFANIA CAAMAÑO
general coordinator



02/02

E - 53

1:40

MONITORING EQUIPMENT