


DAY 5


ASSEMBLED ELEMENT  
DECKING  
PACKING LIST REFERENCE  
1.8.1  
ESTIMATED TIME OF ASSEMBLY  
4 HOURS




WEST ELEVATION

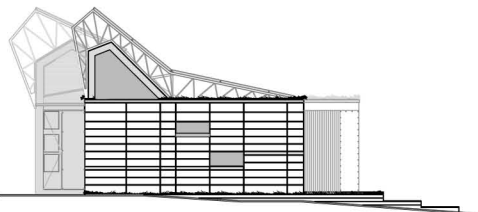


NORTH ELEVATION

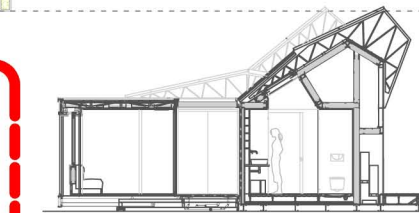

CROSS SECTION

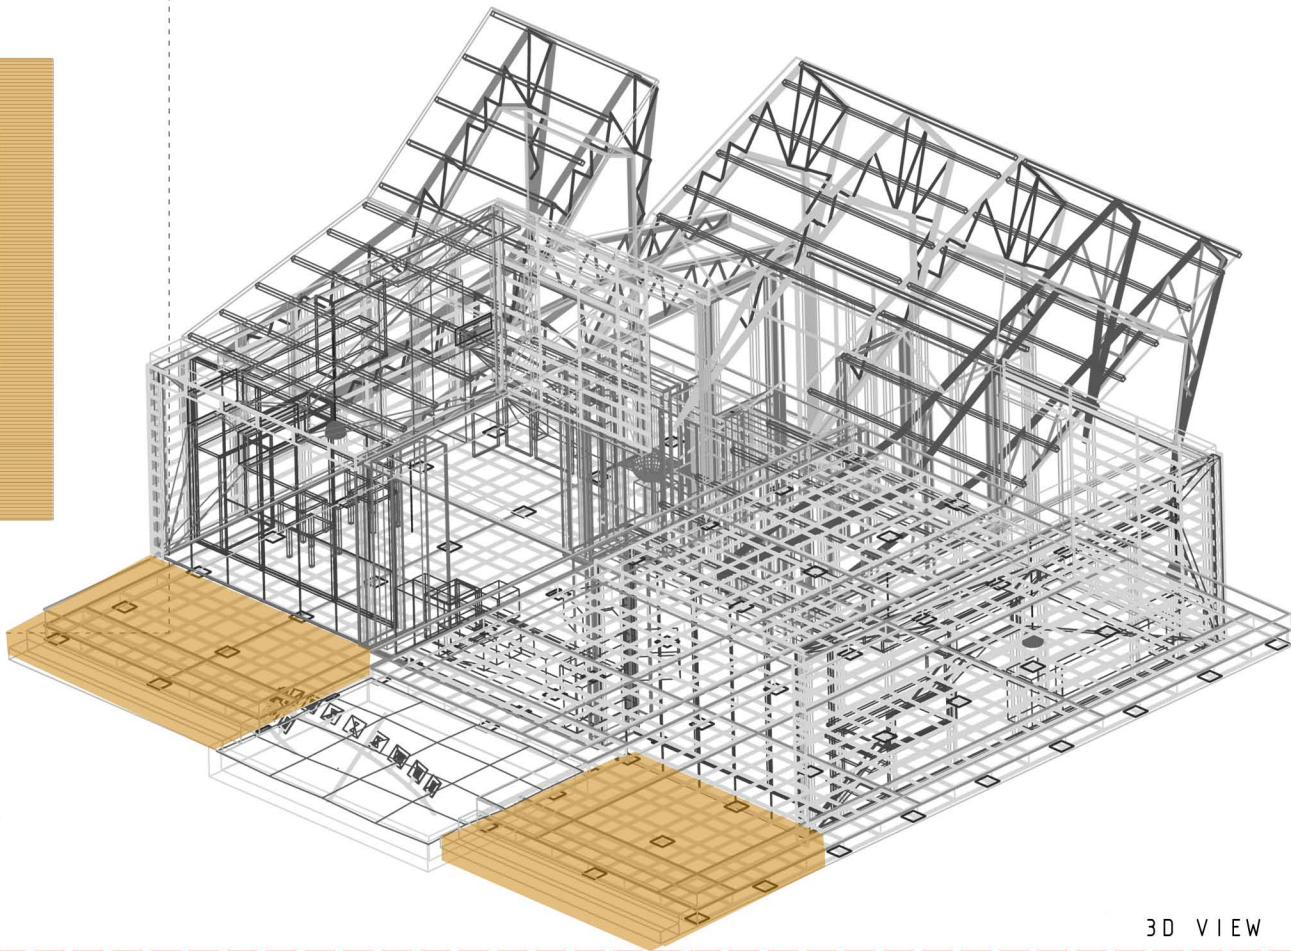

3D VIEW

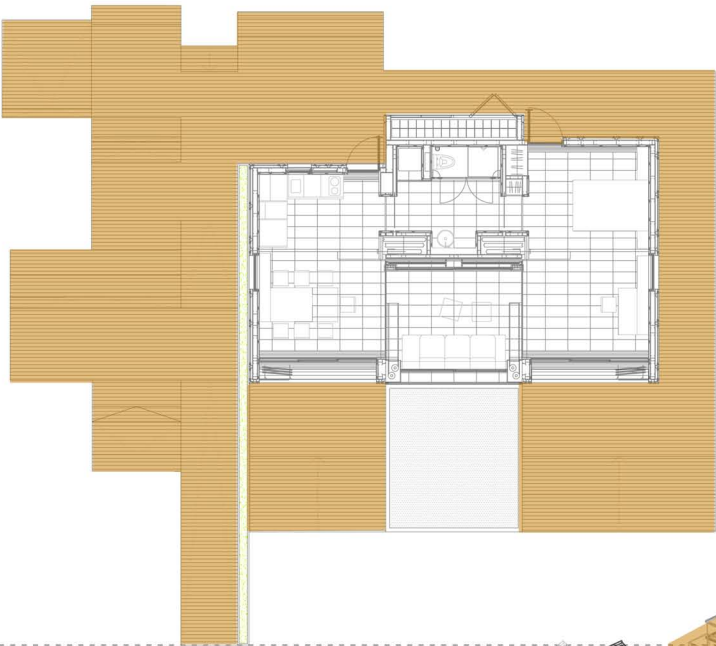


AD-59

DATE: 08.04.2005



SCALE\_1:200

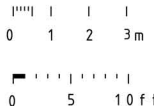

IVÁN ALCANTARILLA  
plan designer  
CARLOS BERMEJO  
design coordinator  
MIGUEL GOMEZ  
general coordinator

ALFONSO GARCIA-SANTOS  
construction manager  
JAVIER NEILA  
architecture manager  
ESTEFANIA CAAMAÑO  
general coordinator



unfolding under the sun  
Universidad Politécnica de Madrid (UPM)



10/10

AD-59

1:200

ASSEMBLY



sd-upm salon inmobiliario - cam2 Thu.Jan.1,1970 00:50:31



sd-upm salon inmobiliario - cam2 Thu.Jan.1,1970 00:35:18



sd-upm salon inmobiliario - cam2 Thu.Jan.1,1970 00:20:00

