



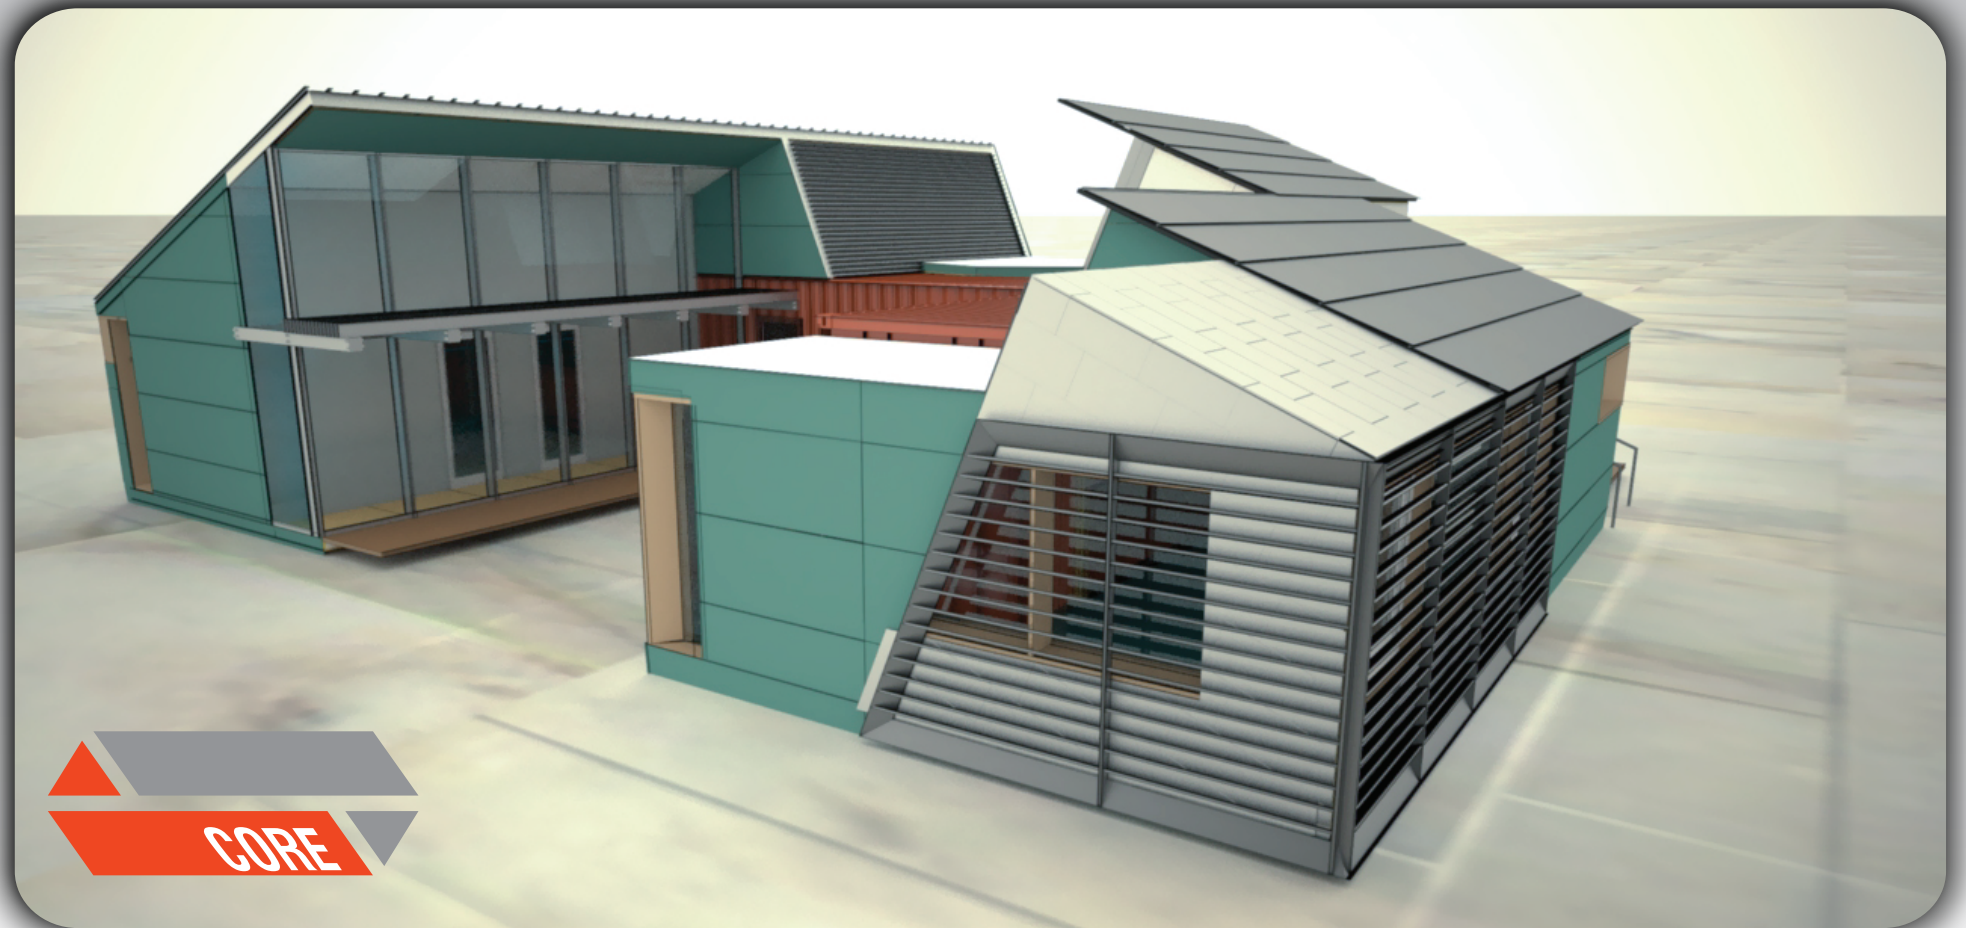

# University of Colorado Solar Decathlon **2007**

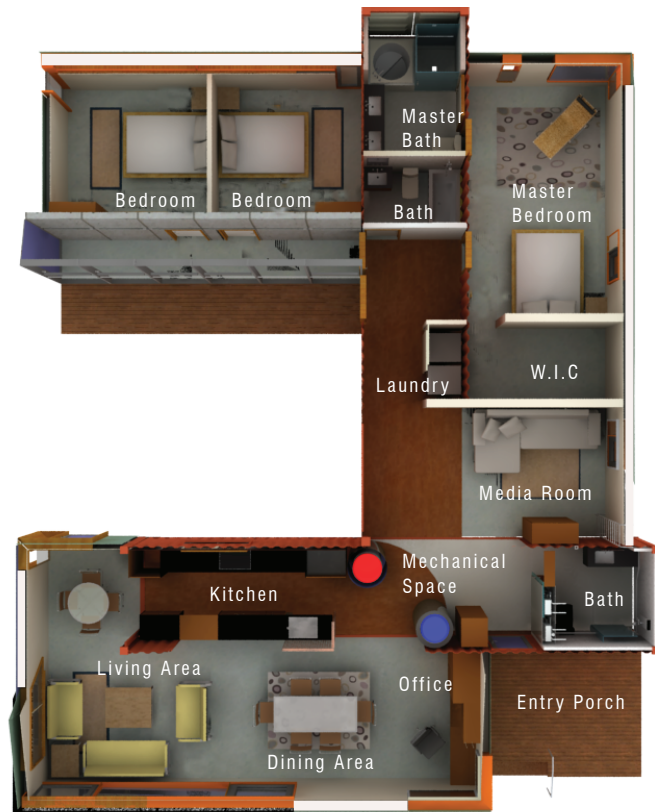

January 9, 2008  
**As-Built Submittal**

G0.01	INDEX
G1.01	SITE PLAN
G2.01	NORTH/EAST ELEVATIONS
G2.02	SOUTH/WEST ELEVATIONS
A1.01	GROUND LEVEL FLOORPLAN
A1.02	ATTIC LEVEL FLOORPLAN
A1.03	ROOF PLAN
A1.11	GROUND LEVEL REFLECTED CEILING PLAN
A1.21	KITCHEN ENLARGED PLAN
A1.22	MECHANICAL SPACE ENLARGED PLAN
A1.23	BATH ENLARGED PLAN
A2.01	LONGITUDINAL BUILDING SECTION
A2.02	TRANSVERSE BUILDING SECTION
A2.03	TRANSVERSE BUILDING SECTION
A2.04	TRANSVERSE BUILDING SECTION
A3.01	NORTH EXTERIOR ELEVATION
A3.02	EAST EXTERIOR ELEVATION
A3.03	SOUTH EXTERIOR ELEVATION
A3.04	WEST EXTERIOR ELEVATION
A4.01	KITCHEN NORTH/SOUTH INTERIOR ELEVATION
A4.02	MECH/BATH NORTH/SOUTH INTERIOR ELEVATIONS
A4.03	MECH/BATH EAST/WEST INTERIOR ELEVATIONS
A4.04	BEDROOM/LOFT NORTH/SOUTH INTERIOR ELEVATIONS
A4.05	BEDROOM/LOFT EAST INTERIOR ELEVATIONS
A4.06	BEDROOM/LOFT WEST INTERIOR ELEVATIONS
A4.07	OFFICE/LIVING NORTH INTERIOR ELEVATIONS
A4.08	OFFICE/LIVING SOUTH INTERIOR ELEVATIONS
A4.09	OFFICE/LIVING EAST/WEST INTERIOR ELEVATIONS
A5.01	ROOF DETAILS
A5.02	ROOF DETAILS
A5.03	ROOF DETAILS
A5.04	ROOF DETAILS
A5.05	ROOF DETAILS
A5.06	WALL DETAILS
A5.07	WALL DETAILS
A5.08	WALL DETAILS
A5.09	SIP/SITE GLAZING DETAILS
A5.10	SIP/SITE GLAZING DETAILS
A5.11	SIP/SITE OPERABLE WINDOW DETAILS
A5.12	SIP/SITE OPERABLE WINDOW DETAILS
A5.13	LOUVER DETAILS @ MECH. ATTIC
A5.14	OPERABLE CLERESTORY DETAILS
A5.15	S.C. WINDOW DETAILS
A5.16	LOFT CLERESTORY WINDOW DETAILS

A6.01	KITCHEN CABINET SECTION A-A
A6.02	KITCHEN CABINET SECTION B-B
A6.03	KITCHEN CABINET SECTION C-C
A6.04	KITCHEN CABINET SECTION D-D
A6.05	KITCHEN CABINET SECTION E-E
A6.06	KITCHEN CABINET SECTION F-F
A6.07	KITCHEN CABINET SECTION G-G
A6.08	BATH CABINET SECTION H-H
A6.09	FAT WALL SECTION
A6.10	FAT WALL SECTION
A6.11	FATWALL PLAN DETAIL
A6.12	BEDROOM CLOSET SECTION
A6.13	OFFICE CLOSET SECTION
A6.14	OFFICE CLOSET SECTION
A6.15	OFFICE SECTION AT DESK
A6.16	SINK SECTIONS
A6.17	SINK ELEVATION DETAIL
A7.01	COMPLETE HOUSE FLOORPLAN
A7.02	COMPLETE HOUSE ROOF PLAN
A7.11	COMPLETE HOUSE REFLECTED CEILING PLAN
A7.21	COMPLETE HOUSE TRANSVERSE BUILDING SECTIONS
A7.31	NORTH/SOUTH ELEVATIONS
A7.32	EAST/WEST ELEVATIONS
A7.33	SOUTH EXTERIOR ELEVATION
A8.01	WINDOW/DOOR SCHEDULE
A8.02	PLUMBING FIXTURE SCHEDULE
A8.03	APPLIANCE SCHEDULE
A8.03	HARDWARE SCHEDULE
CC1.01	TOTAL FOOTPRINT PLAN
CC1.02	TOTAL CONDITIONED SPACE PLAN
CC1.03	TOUR ROUTE
CC1.04	TOUR ROUTE
CC1.05	ACCESSIBLE TOUR ROUTE
CC1.06	ACCESSIBLE TOUR ROUTE
CC1.07	GARAGE SCHEMATIC
CC1.08	FURNITURE PLAN
CC1.09	ARRIVAL
CC1.10	STEP 1: FOUNDATION PADS
CC1.11	STEP 2: CONTAINER PLACEMENT
CC1.12	STEP 3: SIP PLACEMENT
CC1.13	STEP 4: BIPV ROOF PLACEMENT
CC1.14	DISSASSEMBLY STEP 1
CC1.15	DISSASSEMBLY STEP 2
CC1.16	DISSASSEMBLY STEP 3
CC1.17	DISSASSEMBLY STEP 4
F1.01	EGRESS PLAN
F1.11	FIRE PROTECTION PLAN

M1.01	HVAC ZONING PLAN
M1.11	GROUND LEVEL HVAC DUCTWORK PLAN
M1.12	ATTIC LEVEL HVAC DUCTWORK PLAN
M1.21	GROUND LEVEL HVAC PIPING PLAN
M1.22	ATTIC LEVEL HVAC PIPING PLAN
M1.31	PV ROOF PLAN
M1.32	PV FRAME SUPPORT PLAN
M1.33	PV FRAME BLOCKING PLAN
M1.34	PVT ABSORBER PLAN
M2.01	MECHANICAL PIPING ONE-LINE DIAGRAM
M2.02	MECHANICAL DUCTWORK ONE-LINE DIAGRAM
M3.01	HEAT PUMP CABINET
M3.02	HEAT PUMP CABINET
M3.03	HEAT PUMP CABINET
M3.04	HEAT PUMP CABINET
M3.31	PVT ASSEMBLY SECTION
M4.01	CONTROL SCHEMATICS
M4.02	CONTROL DEVICES
M6.01	GENERAL MECHANICAL DETAILS
M6.02	RADIANT ELEMENT DETAILS
M6.03	RADIANT ELEMENT DETAILS
M6.04	RADIANT ELEMENT DETAILS
M6.05	FAN COIL DETAILS
M6.31	PVT ABSORBER DETAILS
M6.41	THERMAL STORAGE TANK
M6.42	THERMAL STORAGE TANK
M7.01	COMPLETE HOUSE HVAC ZONING PLAN
M7.11	COMPLETE HOUSE HVAC DUCTWORK PLAN
M7.21	COMPLETE HOUSE HVAC PIPING PLAN
M8.01	MECHANICAL LEGENDS AND NOTES
M8.02	MECHANICAL SCHEDULES
M8.03	MECHANICAL SCHEDULES
M8.04	MECHANICAL SCHEDULES
P1.01	GROUND LEVEL PLUMBING SUPPLY PLAN
P1.11	GROUND LEVEL PLUMBING DWV PLAN
P7.01	COMPLETE HOUSE PLUMBING SUPPLY PLAN
P7.02	COMPLETE HOUSE PLUMBING SUPPLY PLAN
P7.11	COMPLETE HOUSE PLUMBING DWV PLAN
P7.12	COMPLETE HOUSE PLUMBING DWV PLAN
P8.01	PLUMBING SCHEDULES
P8.02	PLUMBING COMPETITION REQUIREMENTS


Drawn by	Date
C. Corbin	August 7, 2007
Revised	Date





1

SITE PLAN

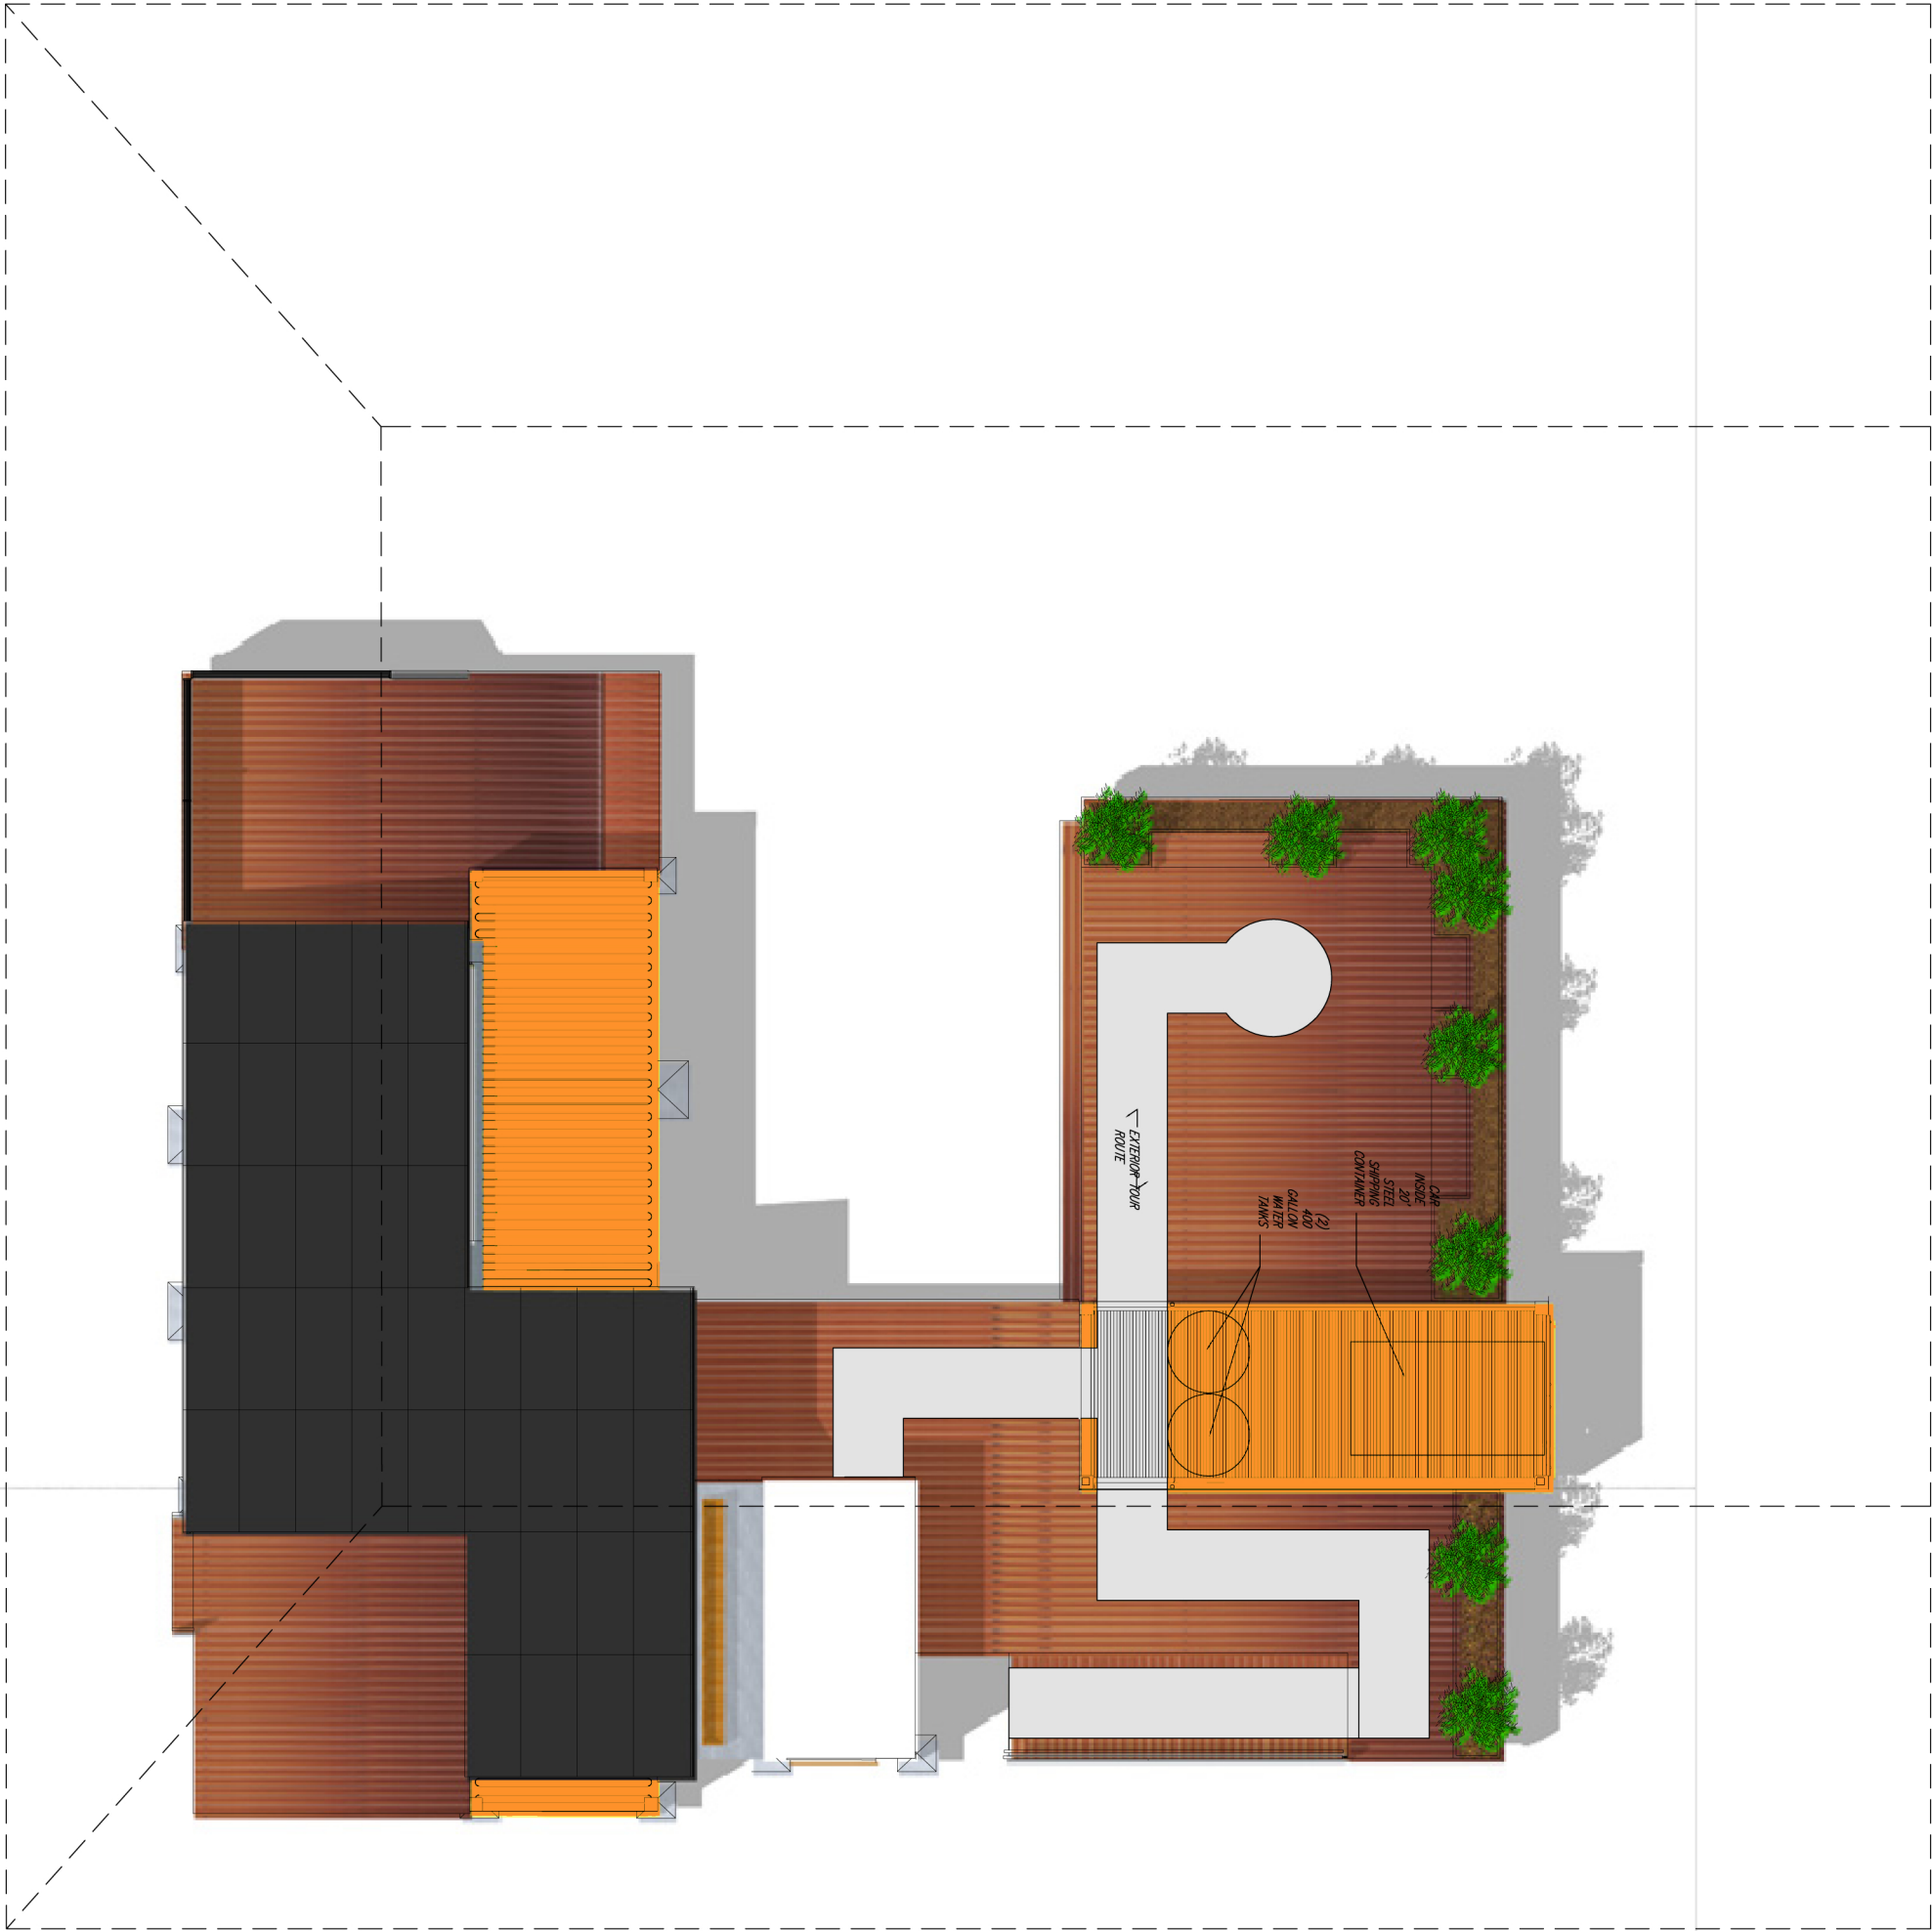

1/8" = 1'-0"



G1.01

Site Plan




2007 Solar Decathlon

University of Colorado at Boulder  
Civil, Environmental, and Architectural Engineering  
428 UCB, Room ECCE 441  
Boulder, CO 80309-0428

Drawn by	Date
S. Hauze	August 7, 2007
Revised	Date




① NORTH SITE ELEVATION 1/8" = 1'-0"

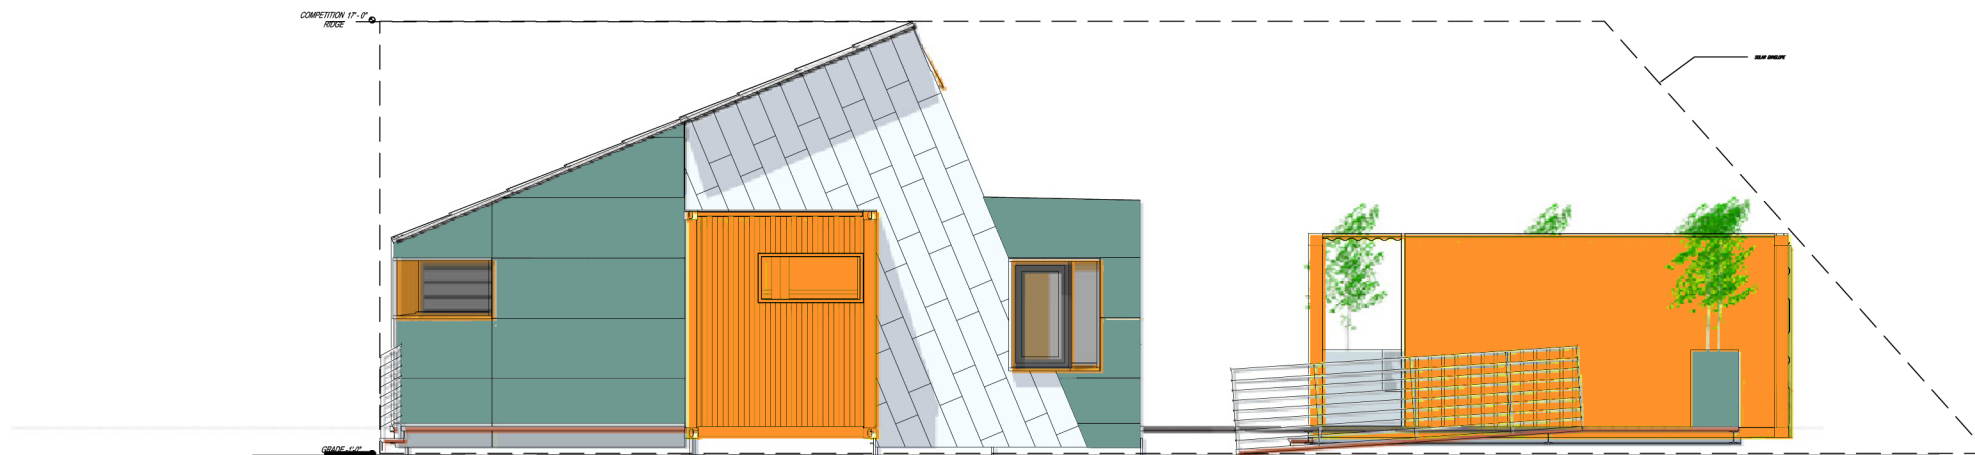

① EAST SITE ELEVATION 1/8" = 1'-0"


Drawn by	Date
S. Hauze	August 7, 2007
Revised	Date

2007 Solar Decathlon  
 University of Colorado at Boulder  
 Civil, Environmental, and Architectural Engineering  
 428 UCB, Room ECCE 441  
 Boulder, CO 80309-0428

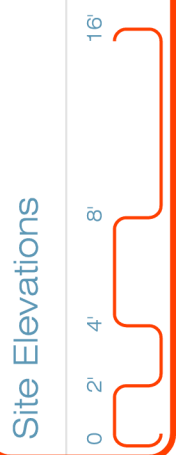


G2.01



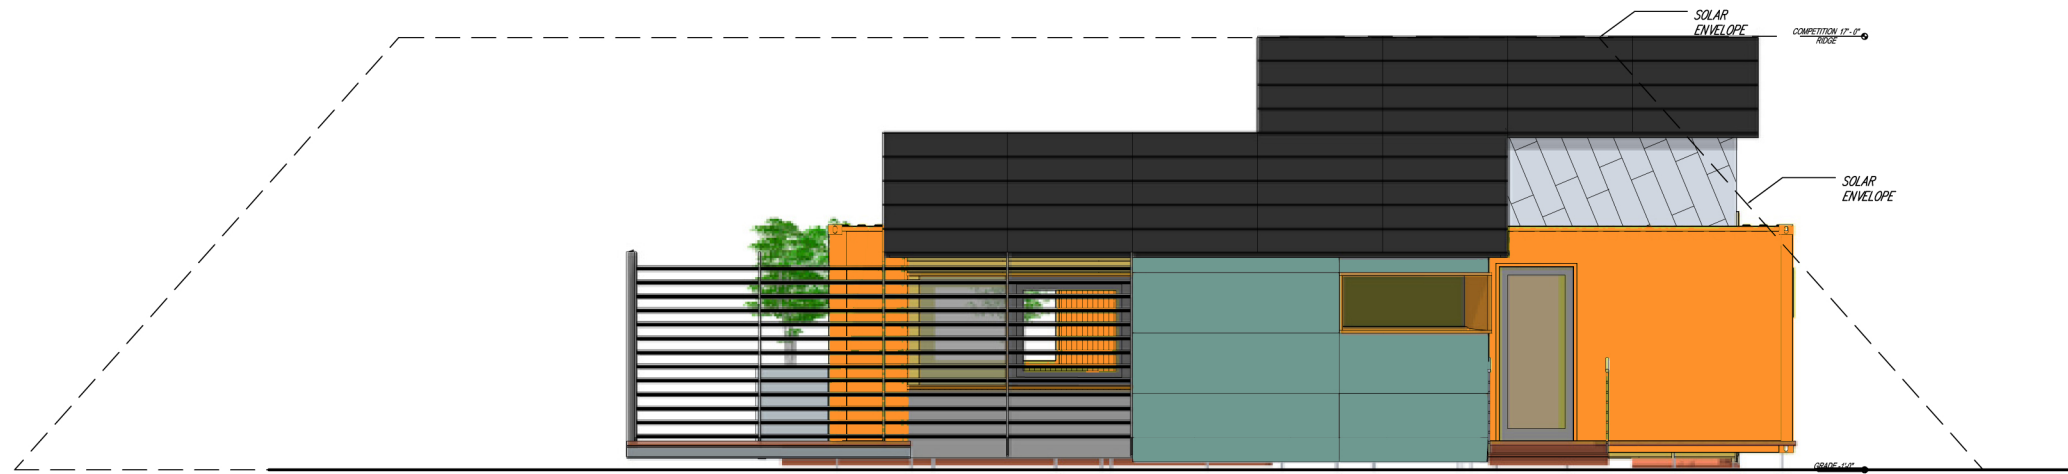

① SOUTH SITE ELEVATION

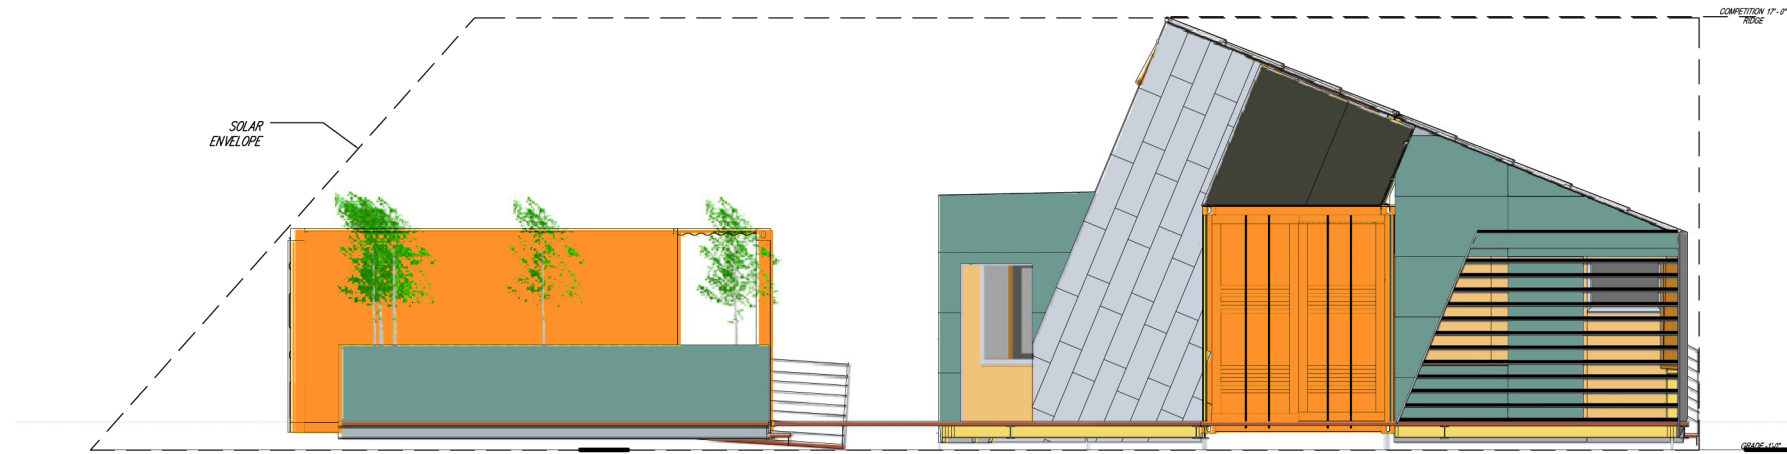

① WEST SITE ELEVATION

$1/8" = 1'-0"$

$1/8" = 1'-0"$

Drawn by	Date
S. Hauze	August 7, 2007
Revised	Date

2007 Solar Decathlon  
University of Colorado at Boulder  
Civil, Environmental, and Architectural Engineering  
428 UCB, Room EOCB 441  
Boulder, CO 80309-0428


Site Elevations

0 2' 4' 8' 16'



G2.02

NOTE: ALL DIMENSIONS ARE TO F.O. S.I.P. OR SHIPPING CONTAINER CORNER CASTING

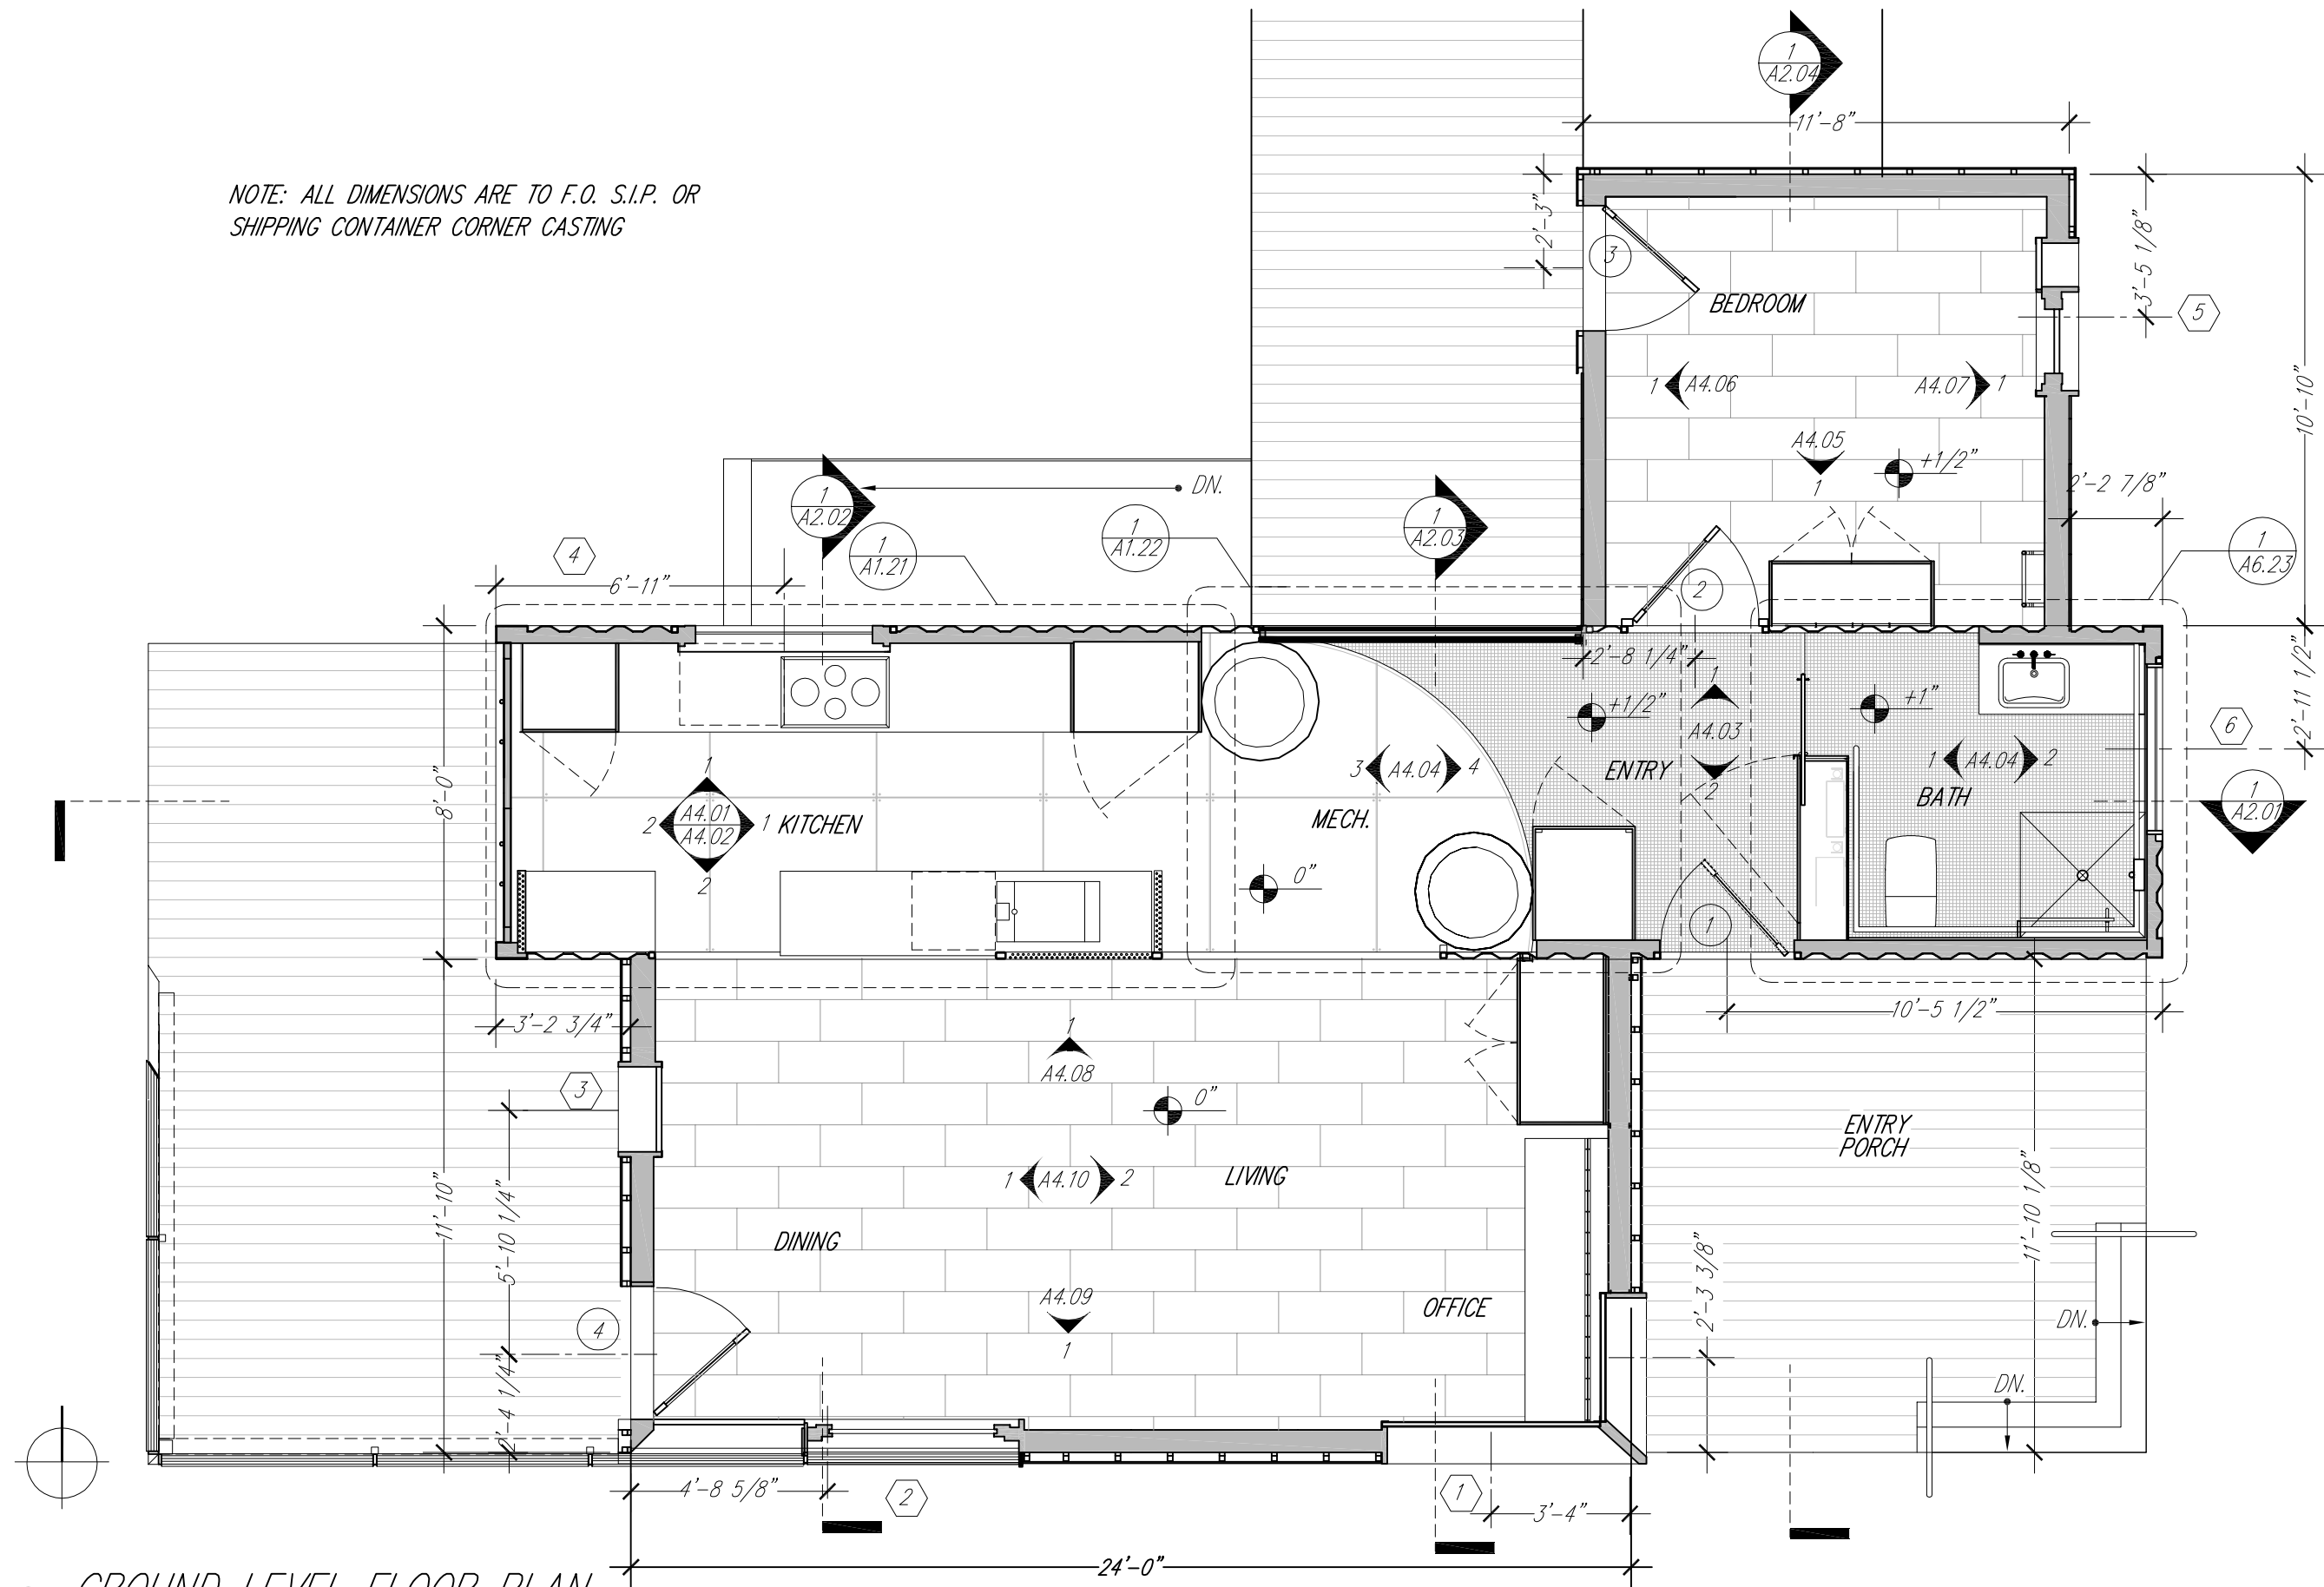


1 GROUND LEVEL FLOOR PLAN

1/4" = 1'-0"


Date	Drawn by
August 7, 2007	A. Rude
Date	Revised
January 9, 2008	A. Rude

2007 Solar Decathlon  
University of Colorado at Boulder  
Civil, Environmental, and Architectural Engineering  
428 UCB Room ECCE 441  
Boulder, CO 80309-0428

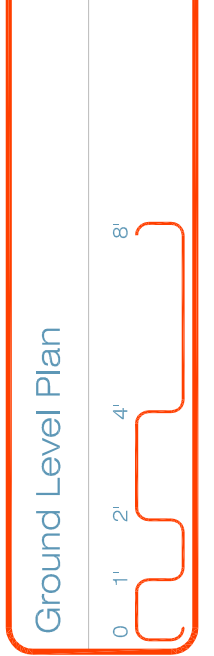

A1.01



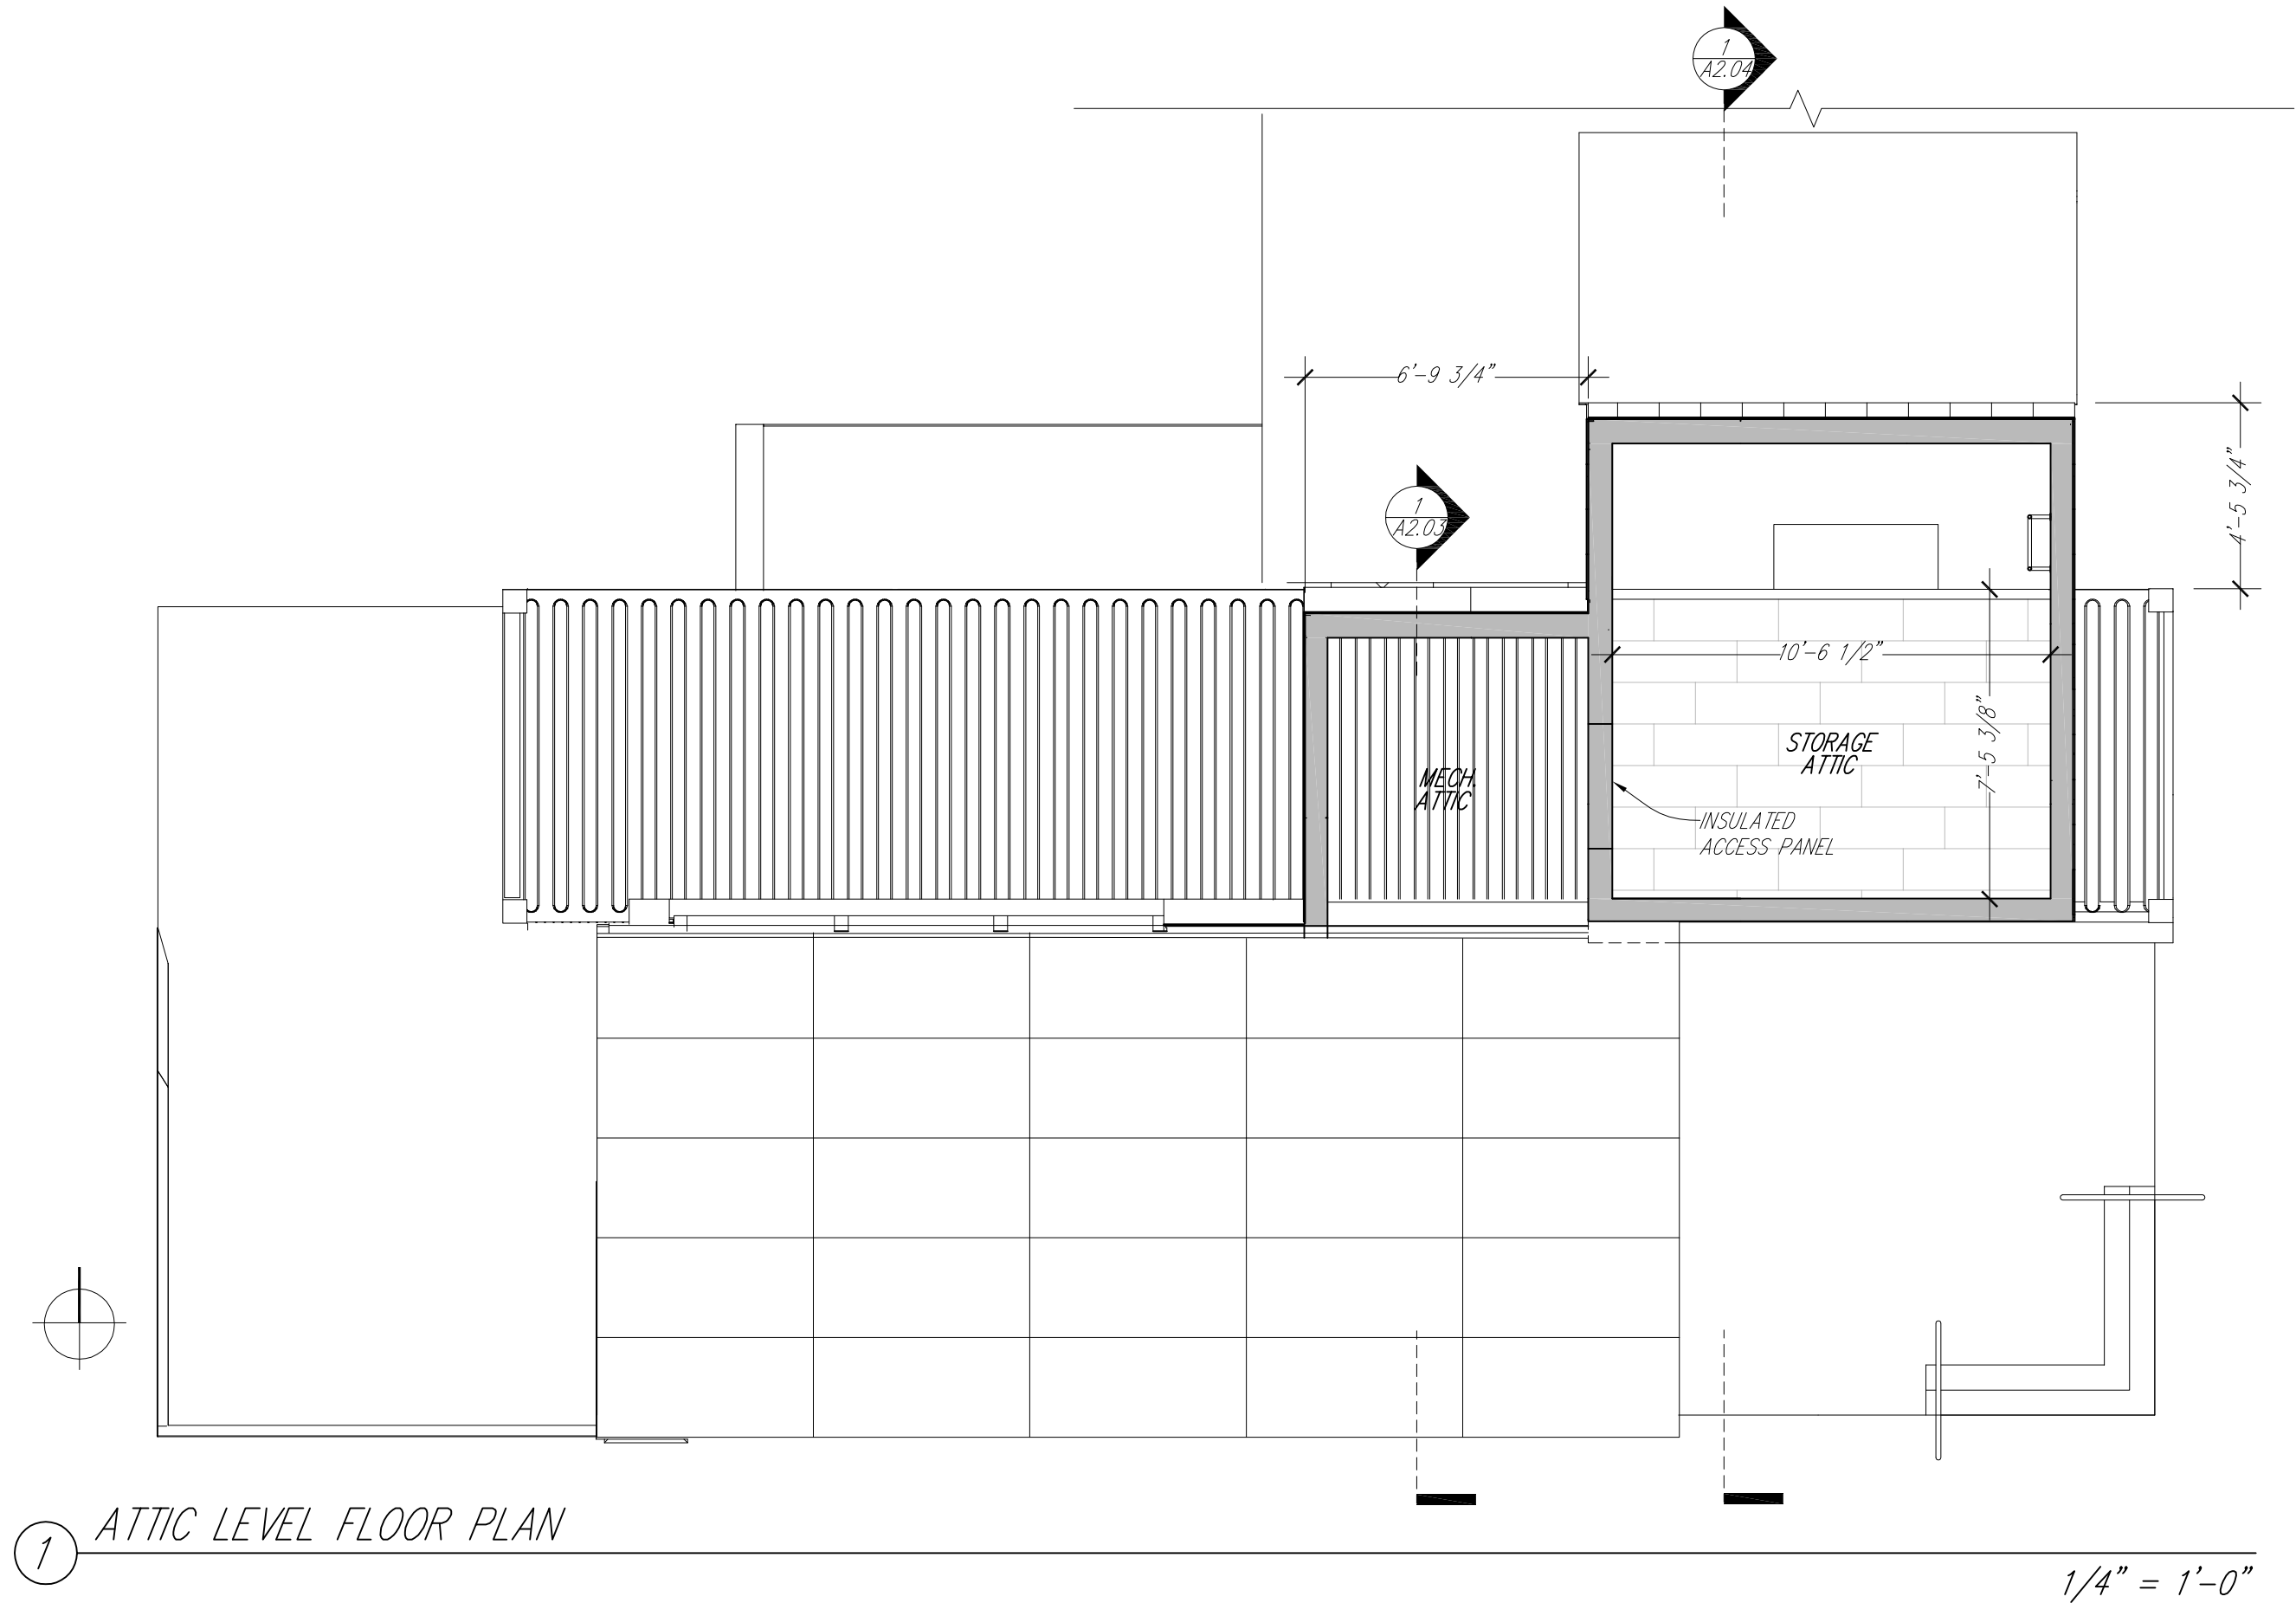

Drawn by	Date
A. Rude	August 7, 2007
Revised	Date
A. Rude	January 9, 2008

Attic Level Plan


0 1' 2' 4' 8'

2007 Solar Decathlon



University of Colorado at Boulder

Civil, Environmental, and Architectural Engineering  
428 UCB, Room ECCE 441  
Boulder, CO 80309-0428



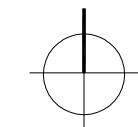


1 ROOF PLAN

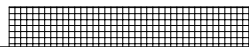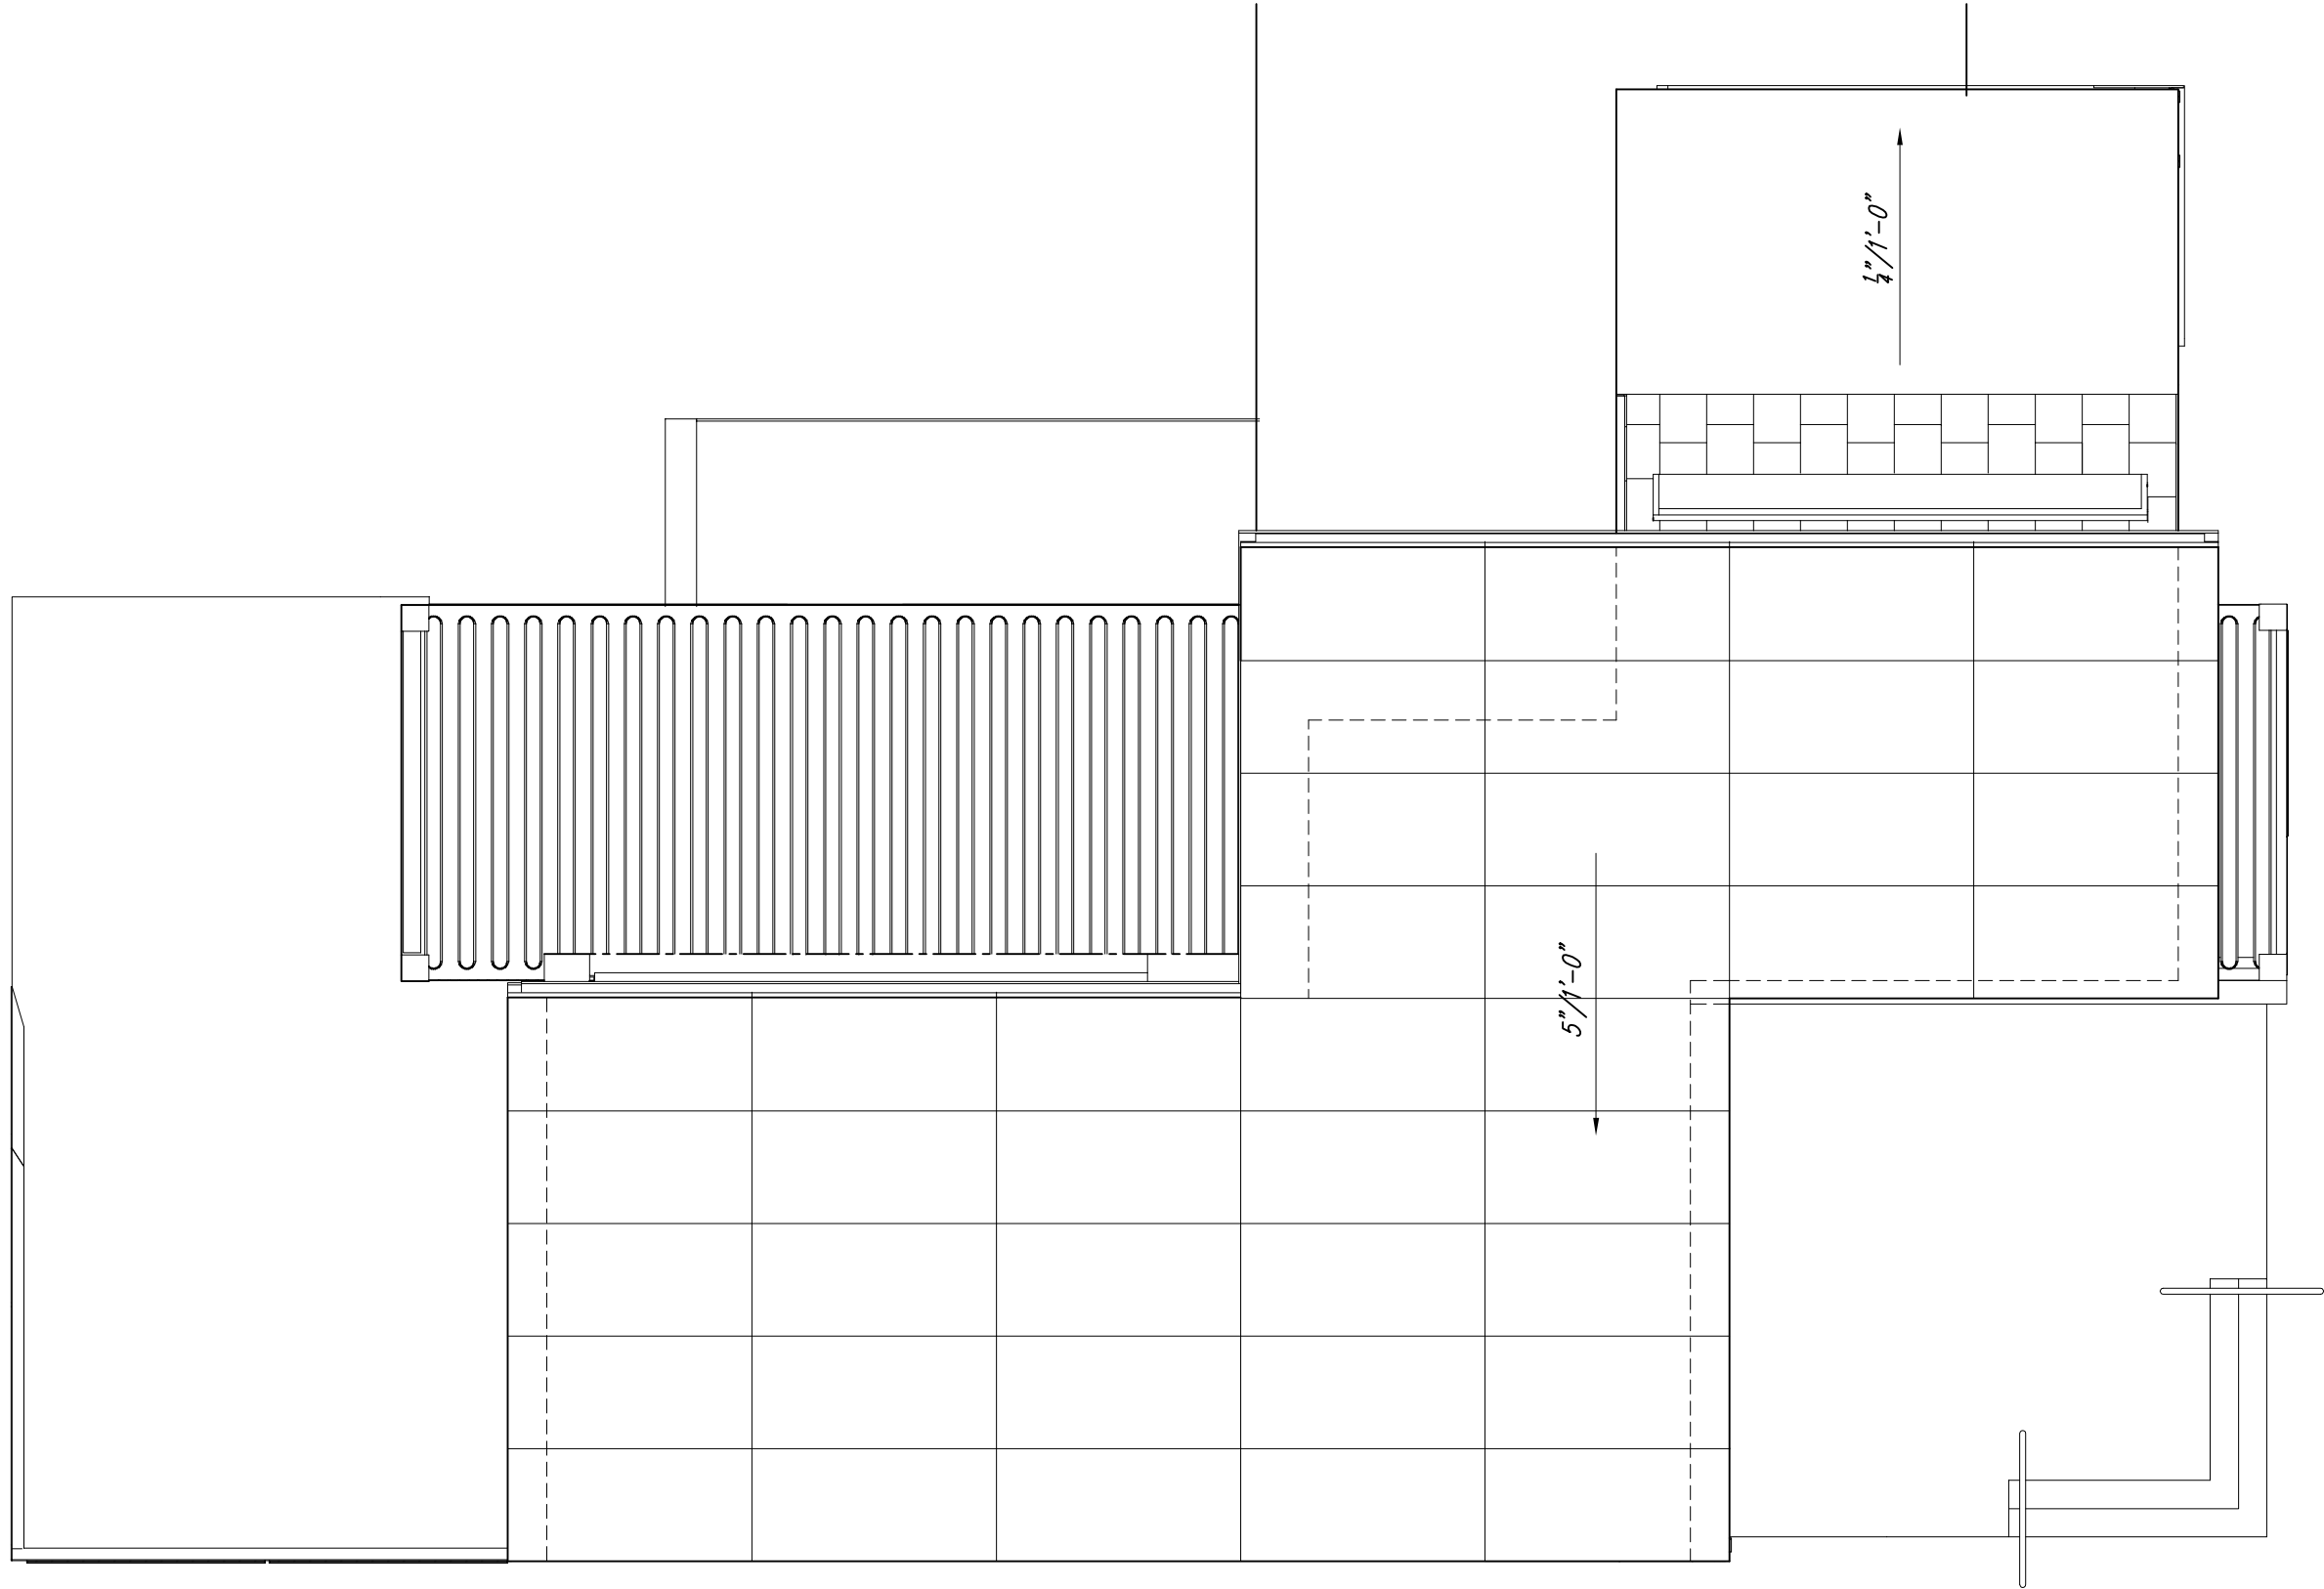

1/4" = 1'-0"



A1.03

Roof Plan

0 1' 2' 4' 8'


2007 Solar Decathlon

University of Colorado at Boulder

Civil, Environmental, and Architectural Engineering  
428 UCB, Room ECCE 441  
Boulder, CO 80309-0428

Drawn by	Date
A. Rude	August 7, 2007
Revised	Date
A. Rude	January 9, 2008



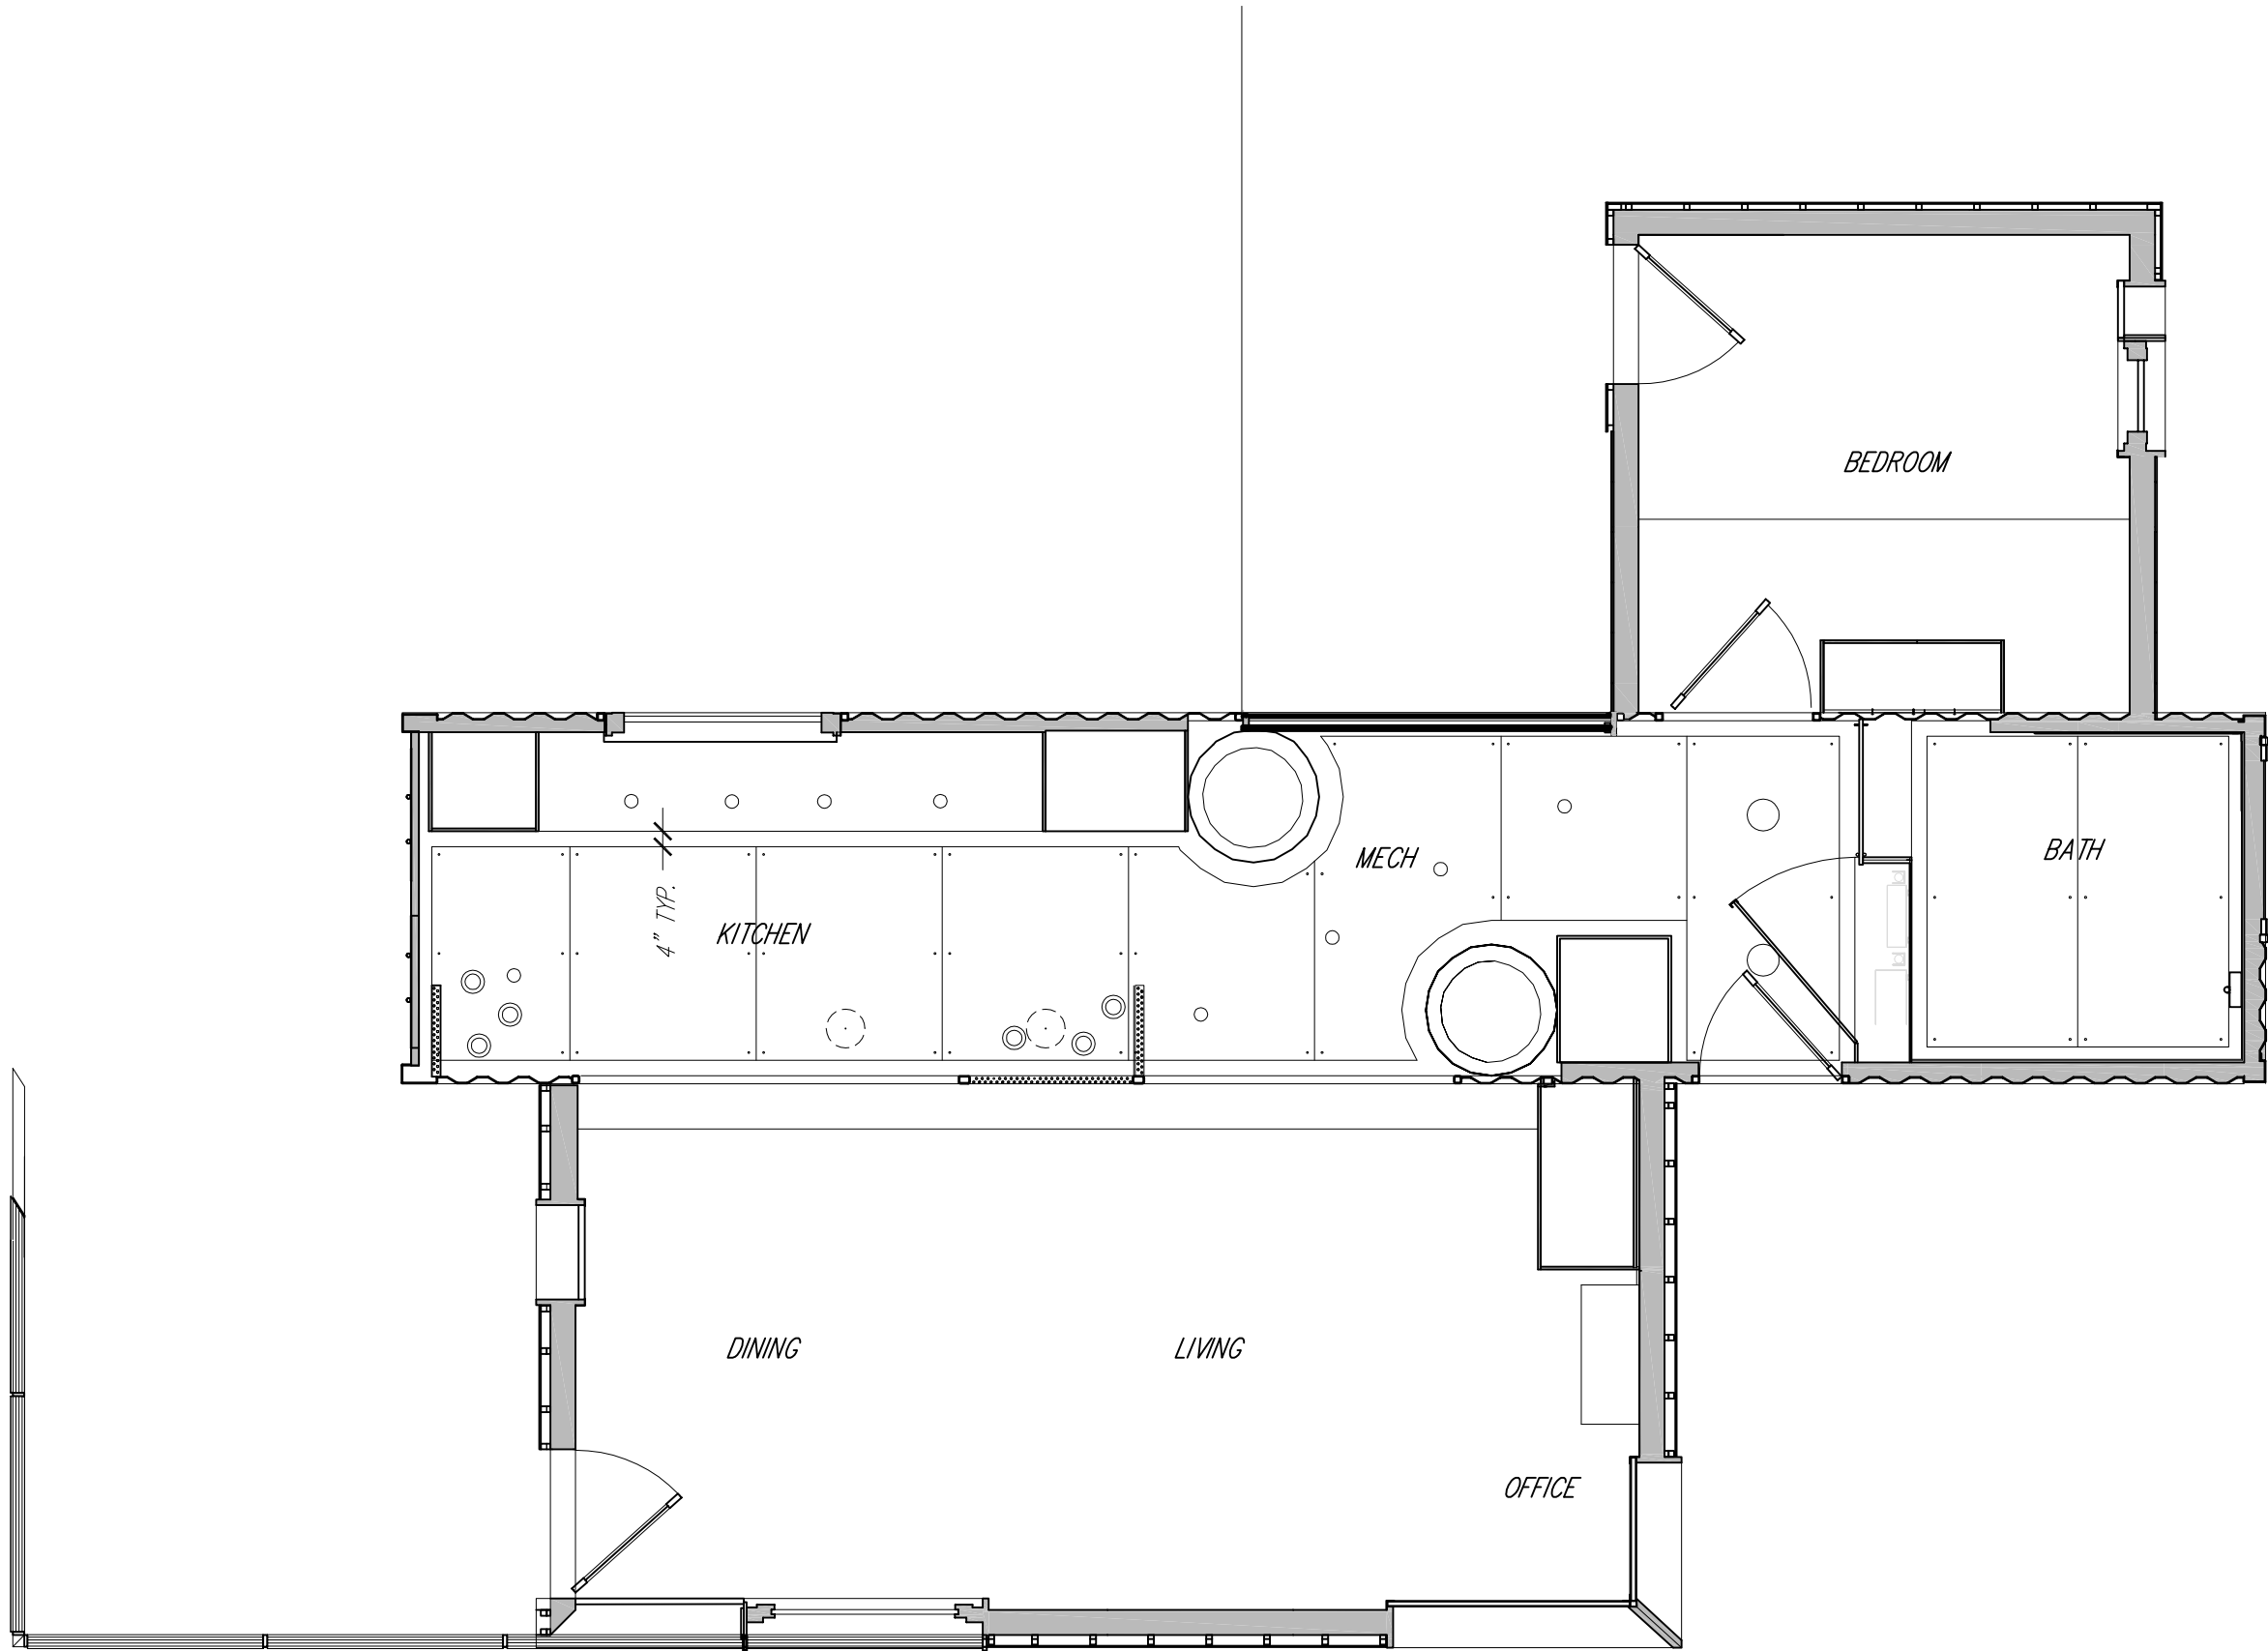


1 GROUND LEVEL REFLECTED CEILING PLAN  
1/4" = 1'-0"

Drawn by	Date
A. Rude	August 7, 2007
Revised	Date
A. Rude	January 9, 2008

2007 Solar Decathlon
University of Colorado at Boulder
Civil, Environmental, and Architectural Engineering
428 UCB, Room ECCE 441
Boulder, CO 80309-0428
Reflected Ceiling Plan
0 1' 2' 4' 8'



A1.11

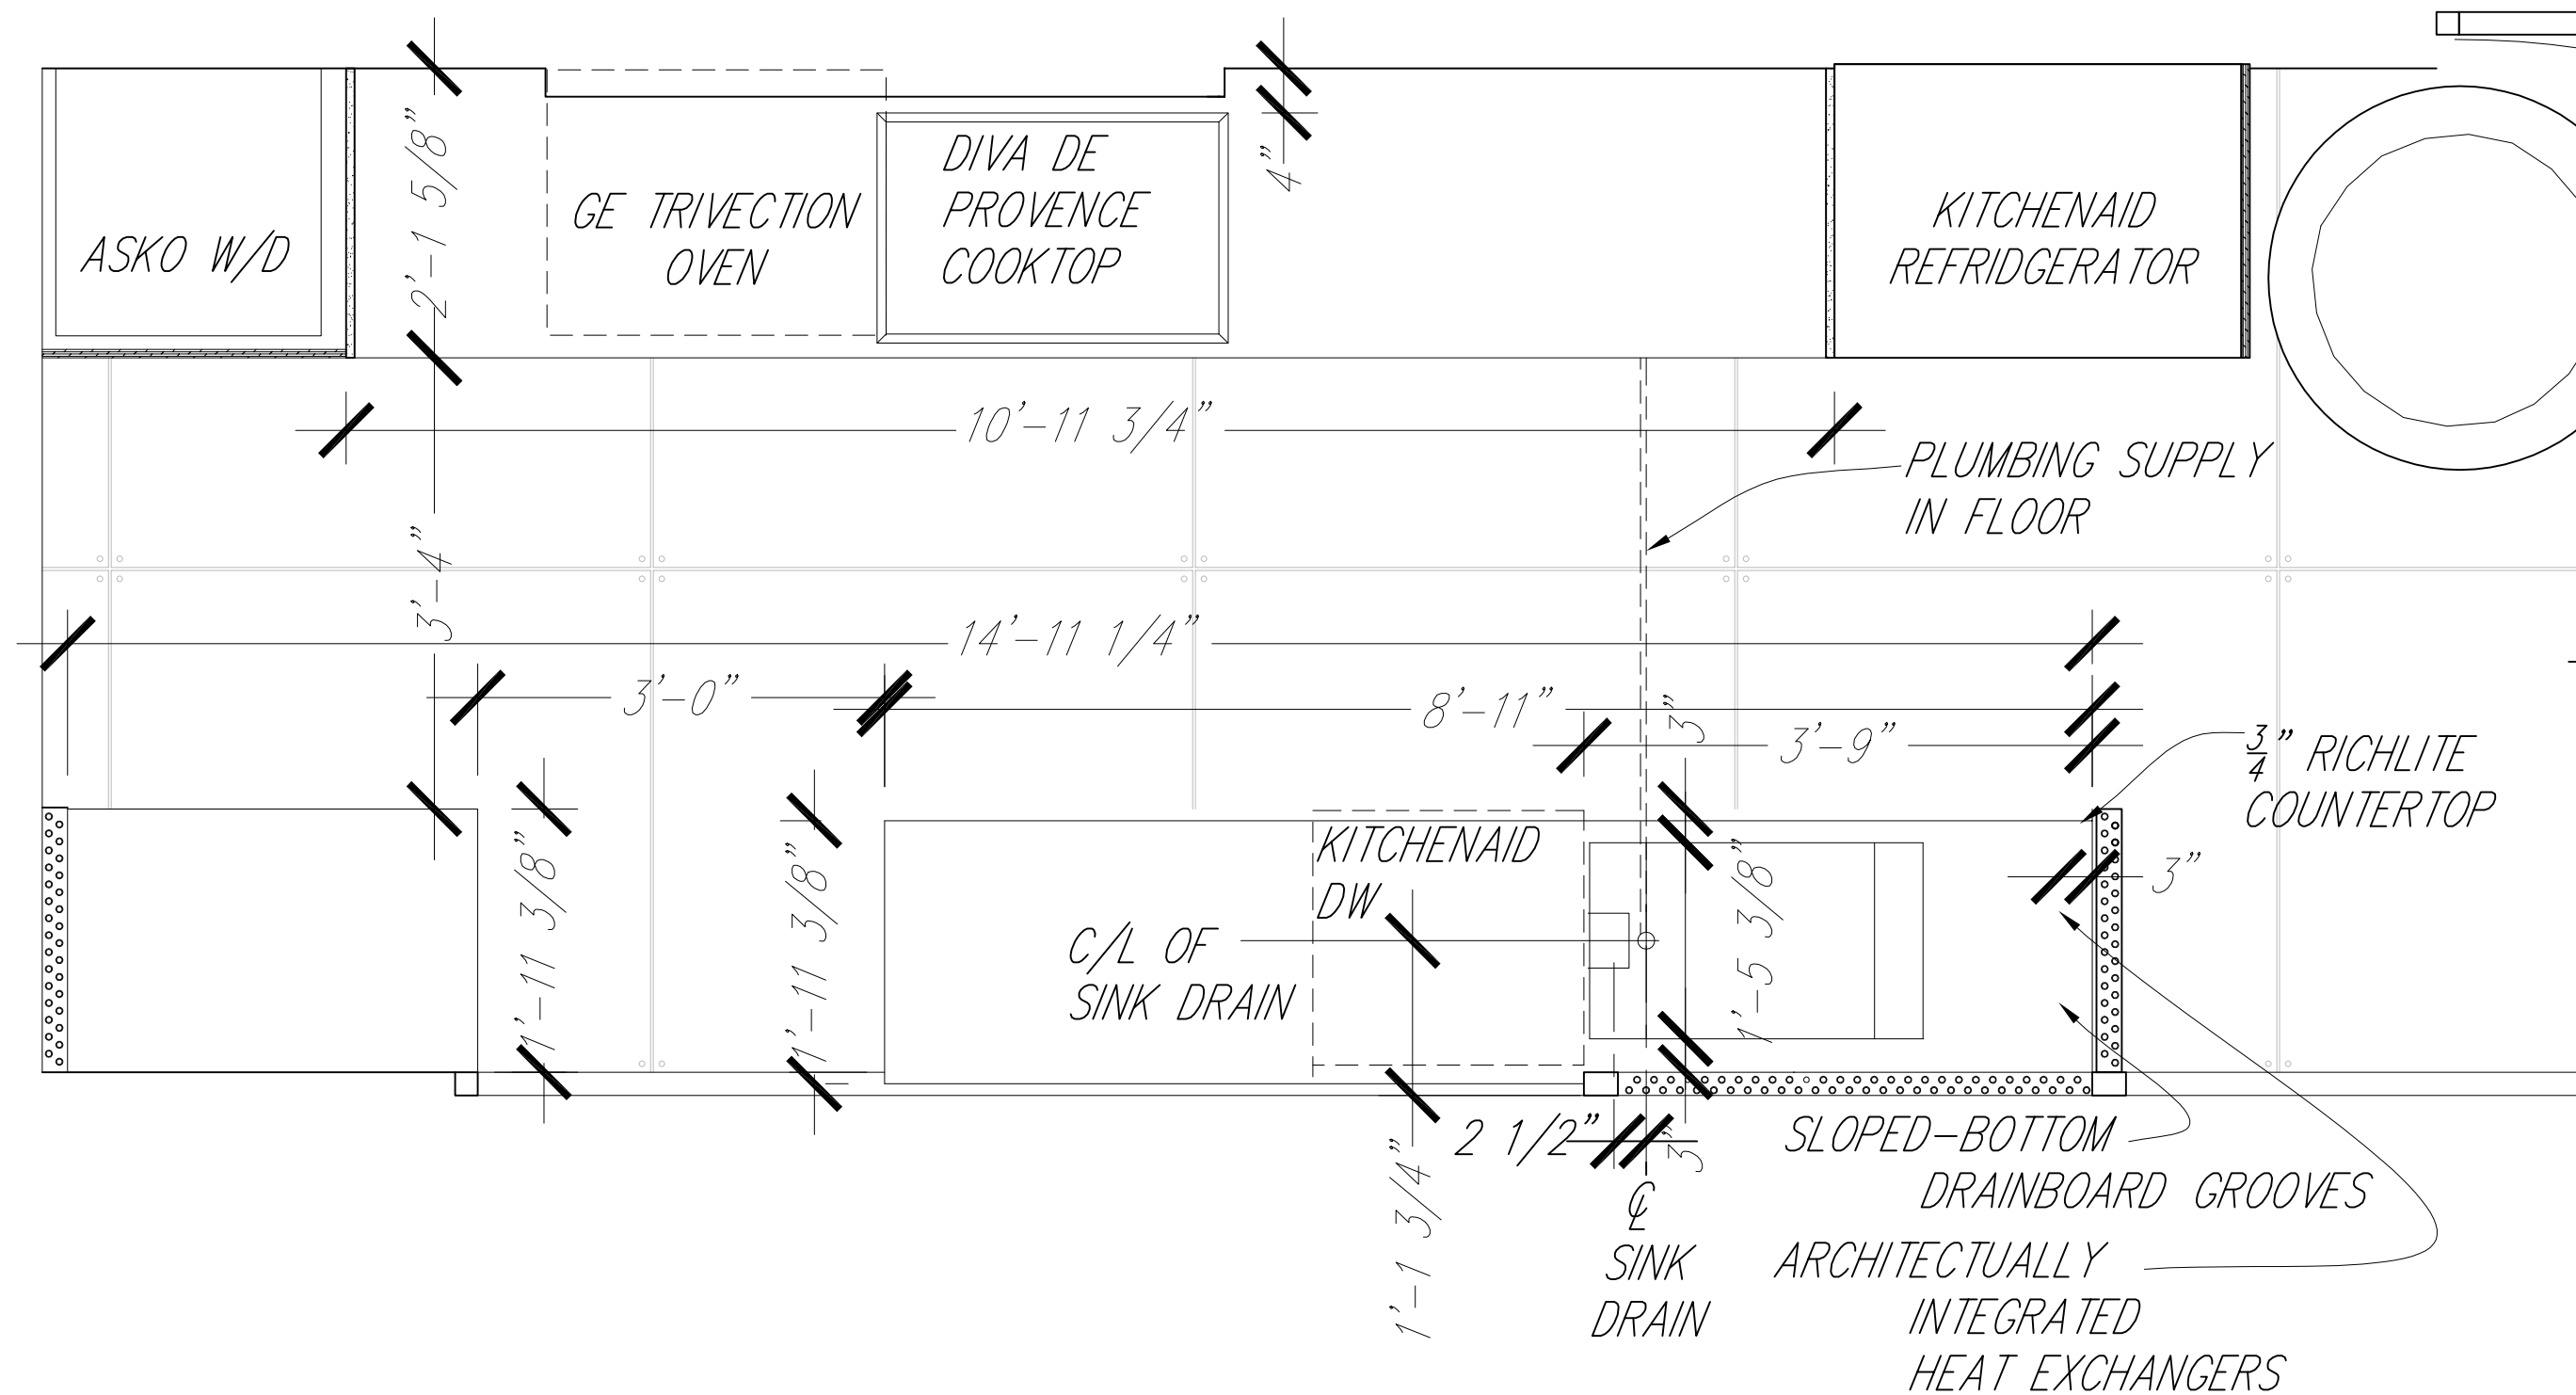

1 ENLARGED KITCHEN PLAN  
3/4" = 1'-0"

Drawn by	Date
A. Rude	August 7, 2007
Revised	Date
A. Rude	January 9, 2008

Enlarged Kitchen Plan

2007 Solar Decathlon

University of Colorado at Boulder


Civil, Environmental, and Architectural Engineering  
428 UCB, Room ECCE 441  
Boulder, CO 80309-0428

0 6" 1" 2' 4'






1 MECHANICAL SPACE ENLARGED PLAN  
 $\frac{3}{4}" = 1'-0"$

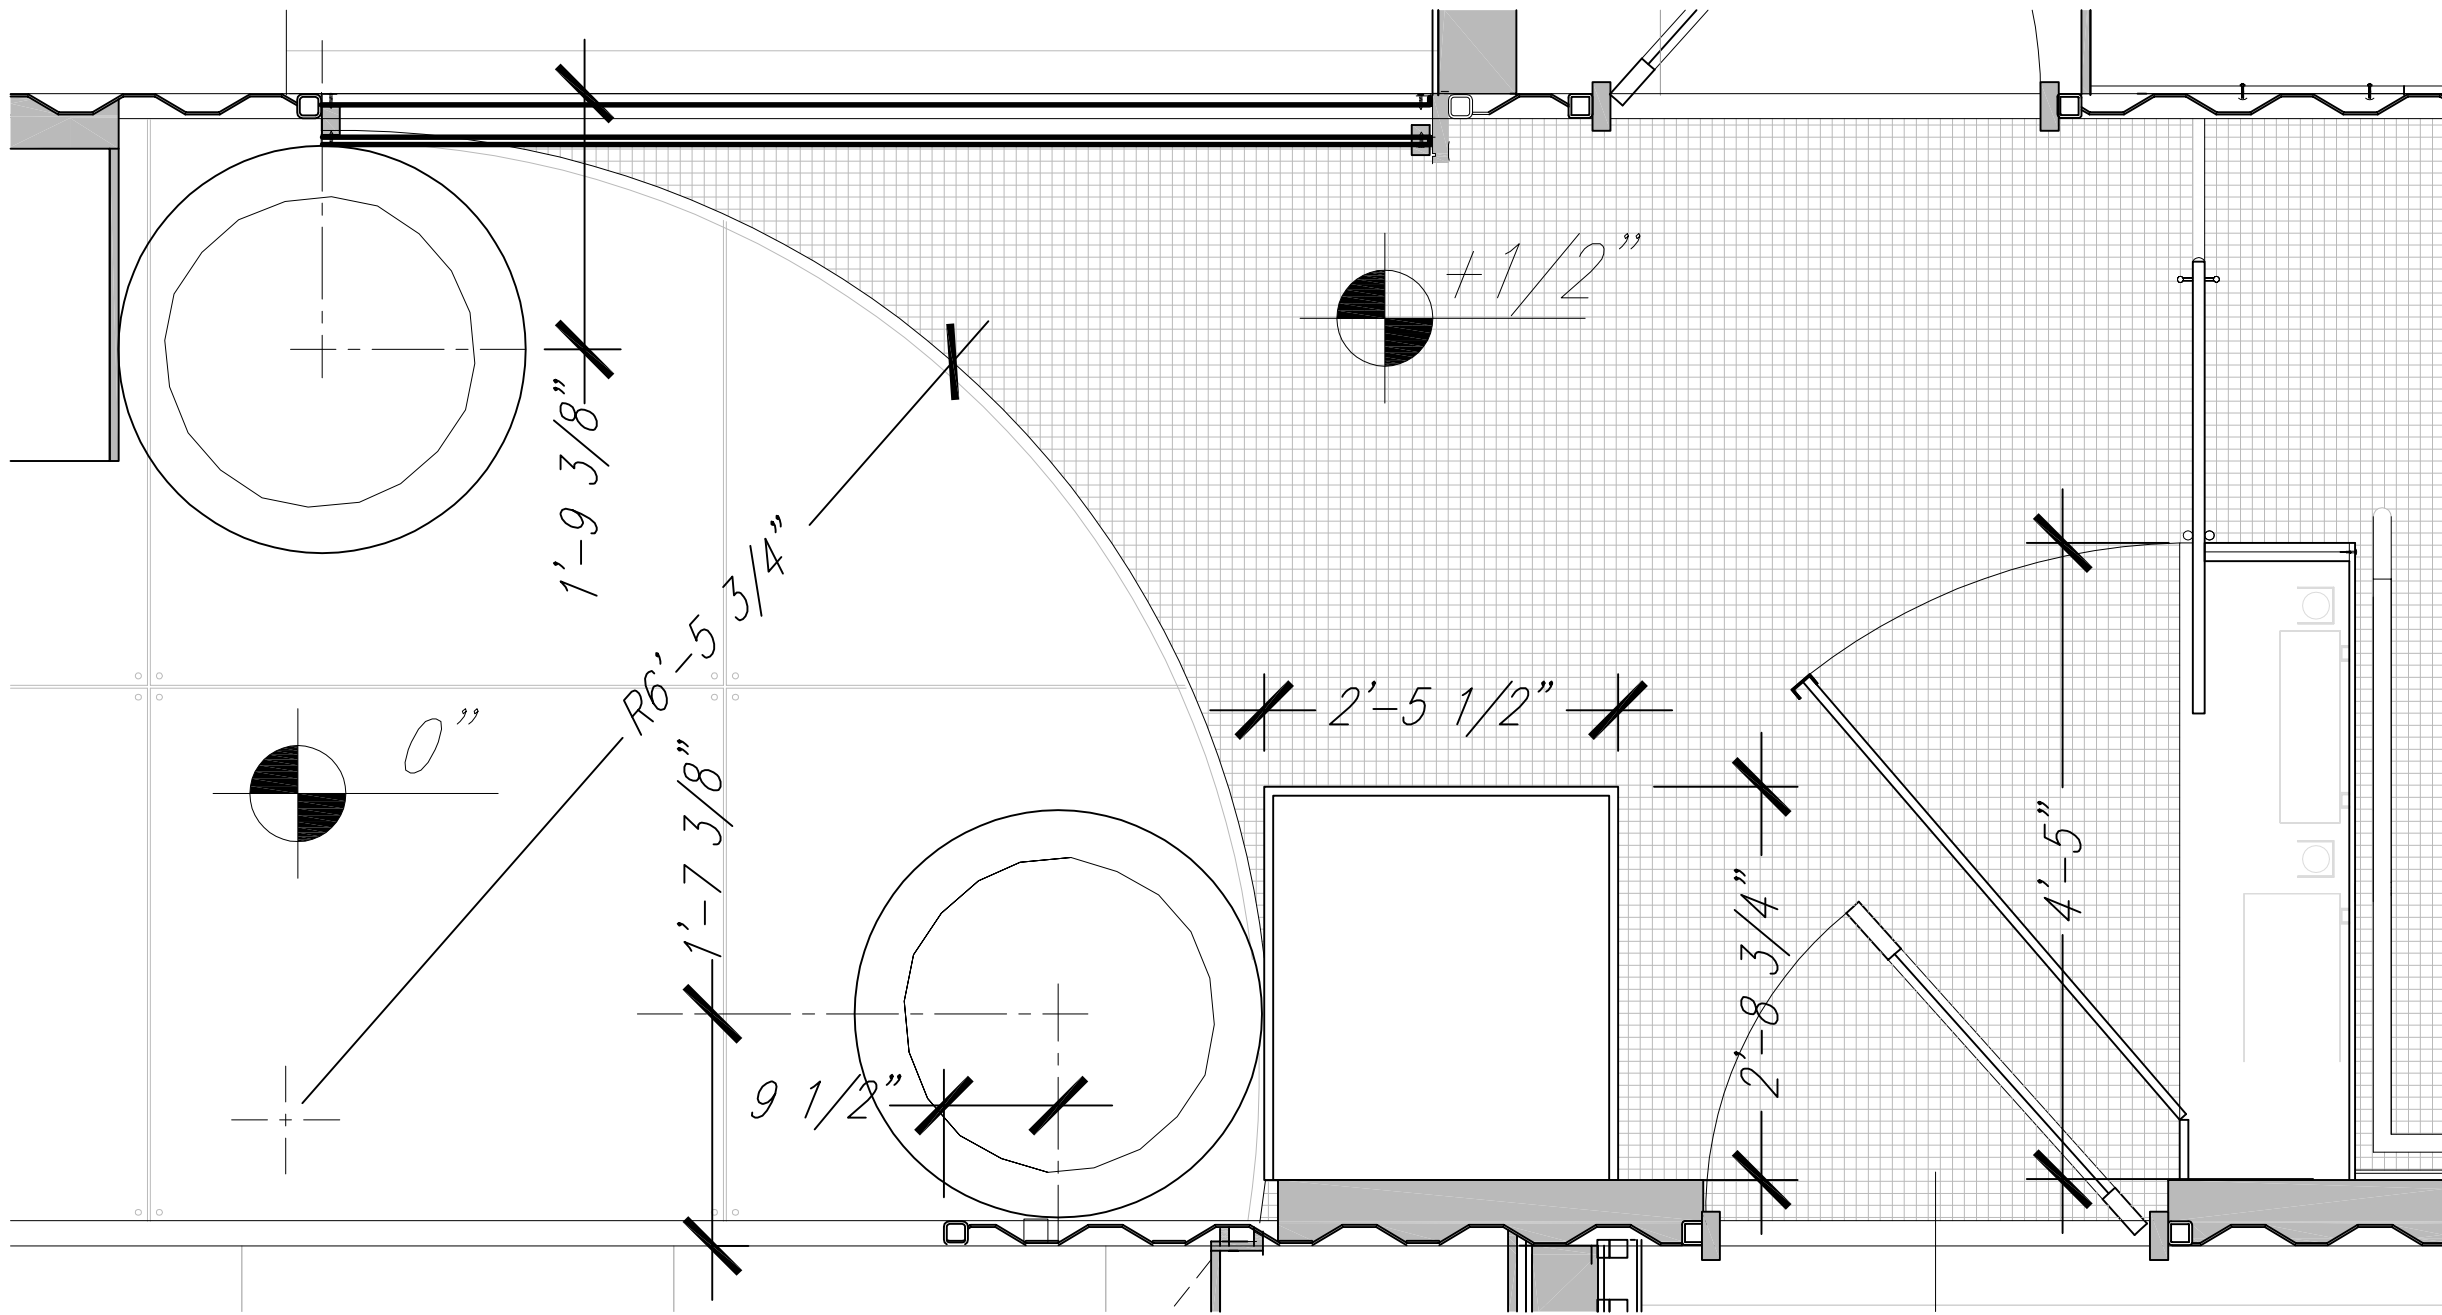

Drawn by	Date
A. Rude	August 7, 2007
Revised	Date
A. Rude	January 9, 2008

Mechanical Space Enlarged Plan	2007 Solar Decathlon
University of Colorado at Boulder	
Civil, Environmental, and Architectural Engineering	
428 UCB, Room ECCE 441	
Boulder, CO 80309-0428	



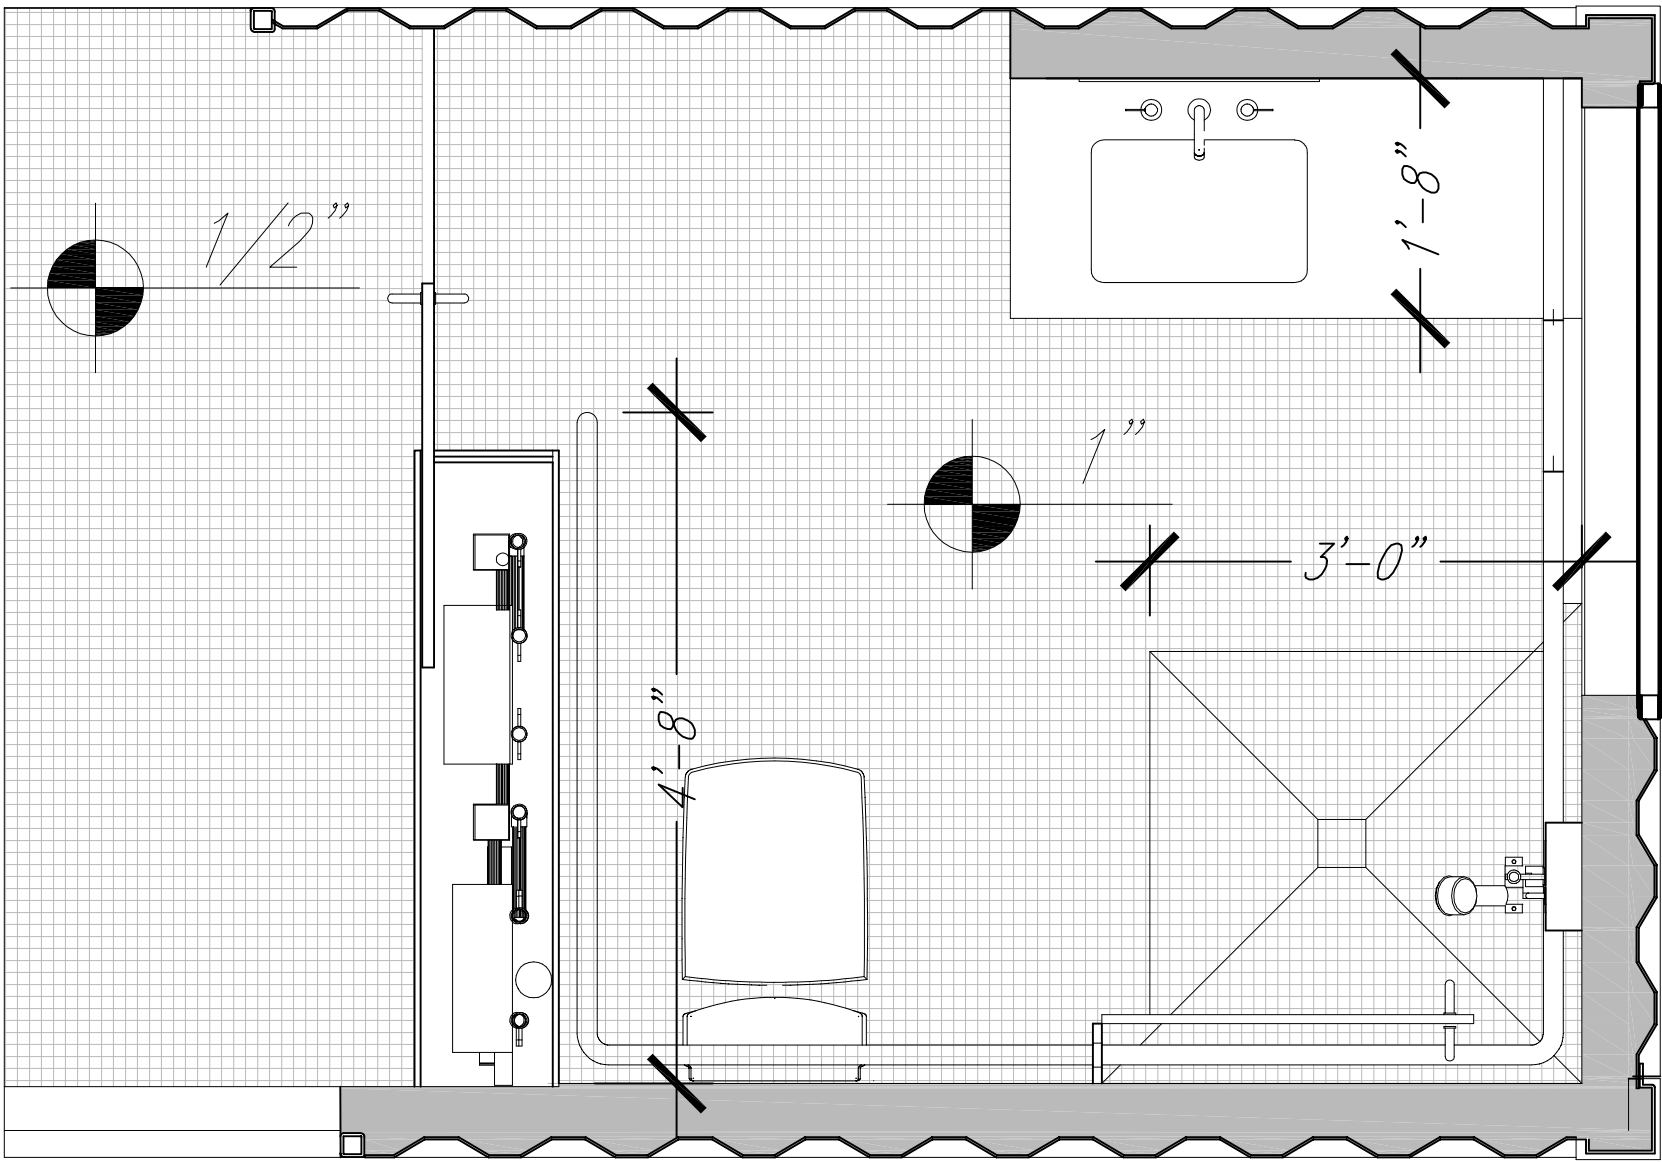

① BATH ENLARGED PLAN  
 $3/4" = 1'-0"$

Drawn by	Date
A. Rude	August 7, 2007
Revised	Date
A. Rude	January 9, 2008

Enlarged Bath Plan

2007 Solar Decathlon

University of Colorado at Boulder  
Civil, Environmental, and Architectural Engineering  
428 UCB, Room ECCE 441  
Boulder, CO 80309-0428


0 6" 1" 2" 4"



1"X1"X $\frac{1}{4}$ " ANGLES BOLTED  
TO 1X3 TUBE STEEL VERT  
SUPPORT

BEAM IN PLANE WITH  
EDGE OF LOUVER  
ASSEMBLY BENEATH DECK

COUNTER-SUNK BOLTED THROUGH  
TOP PLATE TO PV STEEL TUBE  
RACK SYSTEM

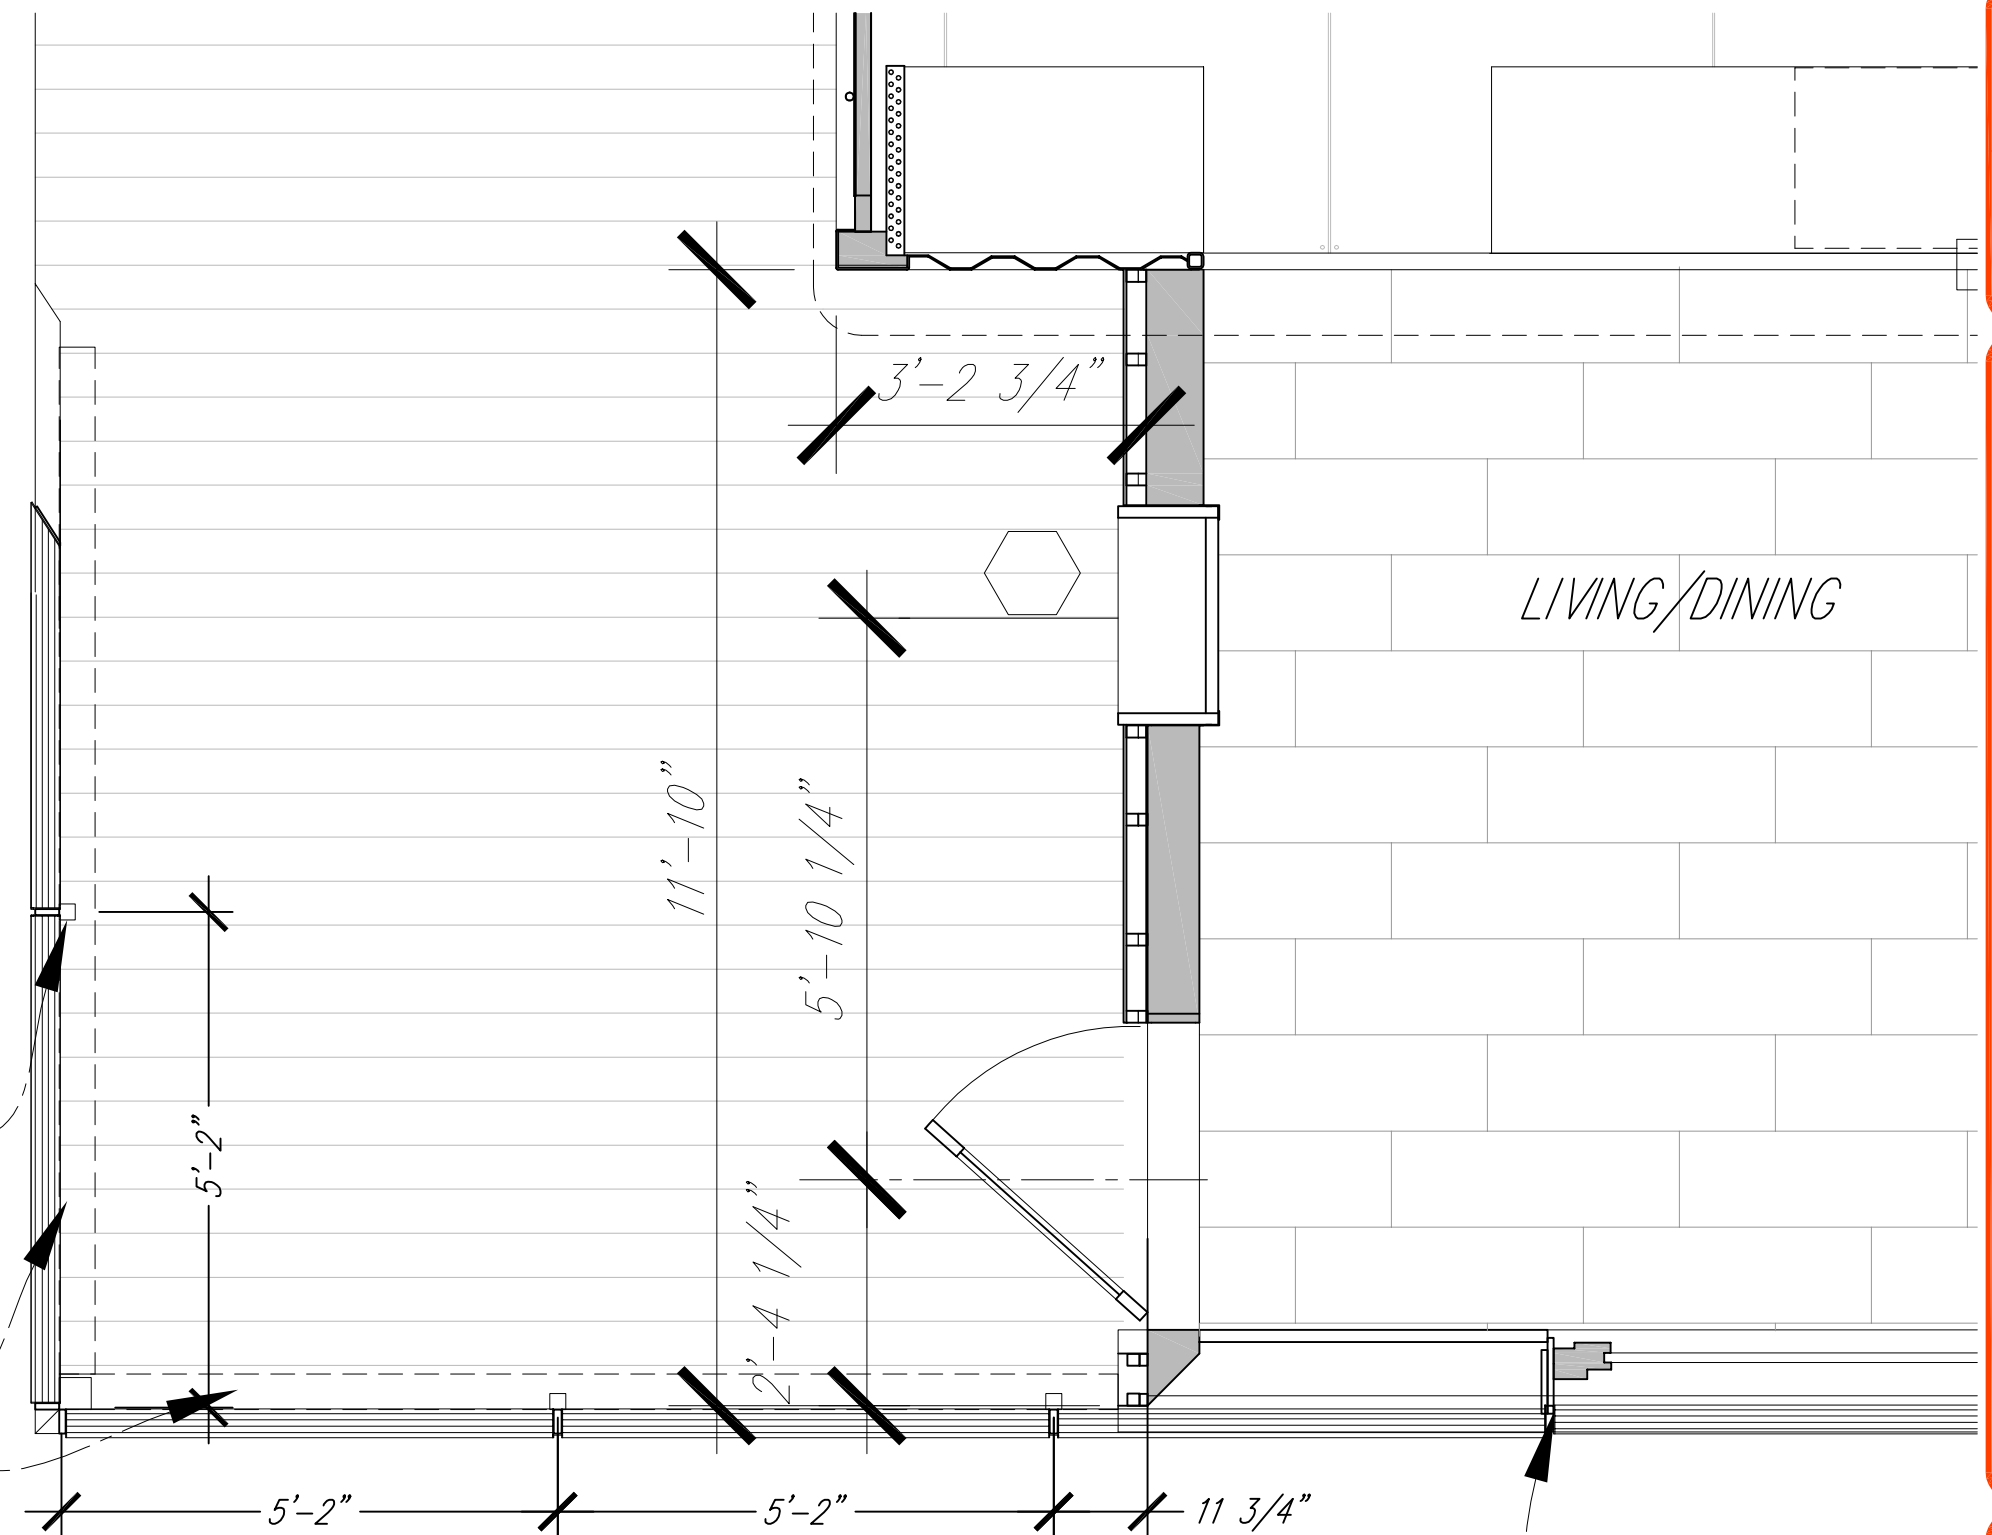

SW Louver Area Plan


2007 Solar Decathlon

University of Colorado at Boulder  
Civil, Environmental, and Architectural Engineering  
428 UCB, Room ECCE 441  
Boulder, CO 80309-0428



Drawn by	Date
A. Rude	August 7, 2007
Revised	Date
A. Rude	January 9, 2008

A1.24

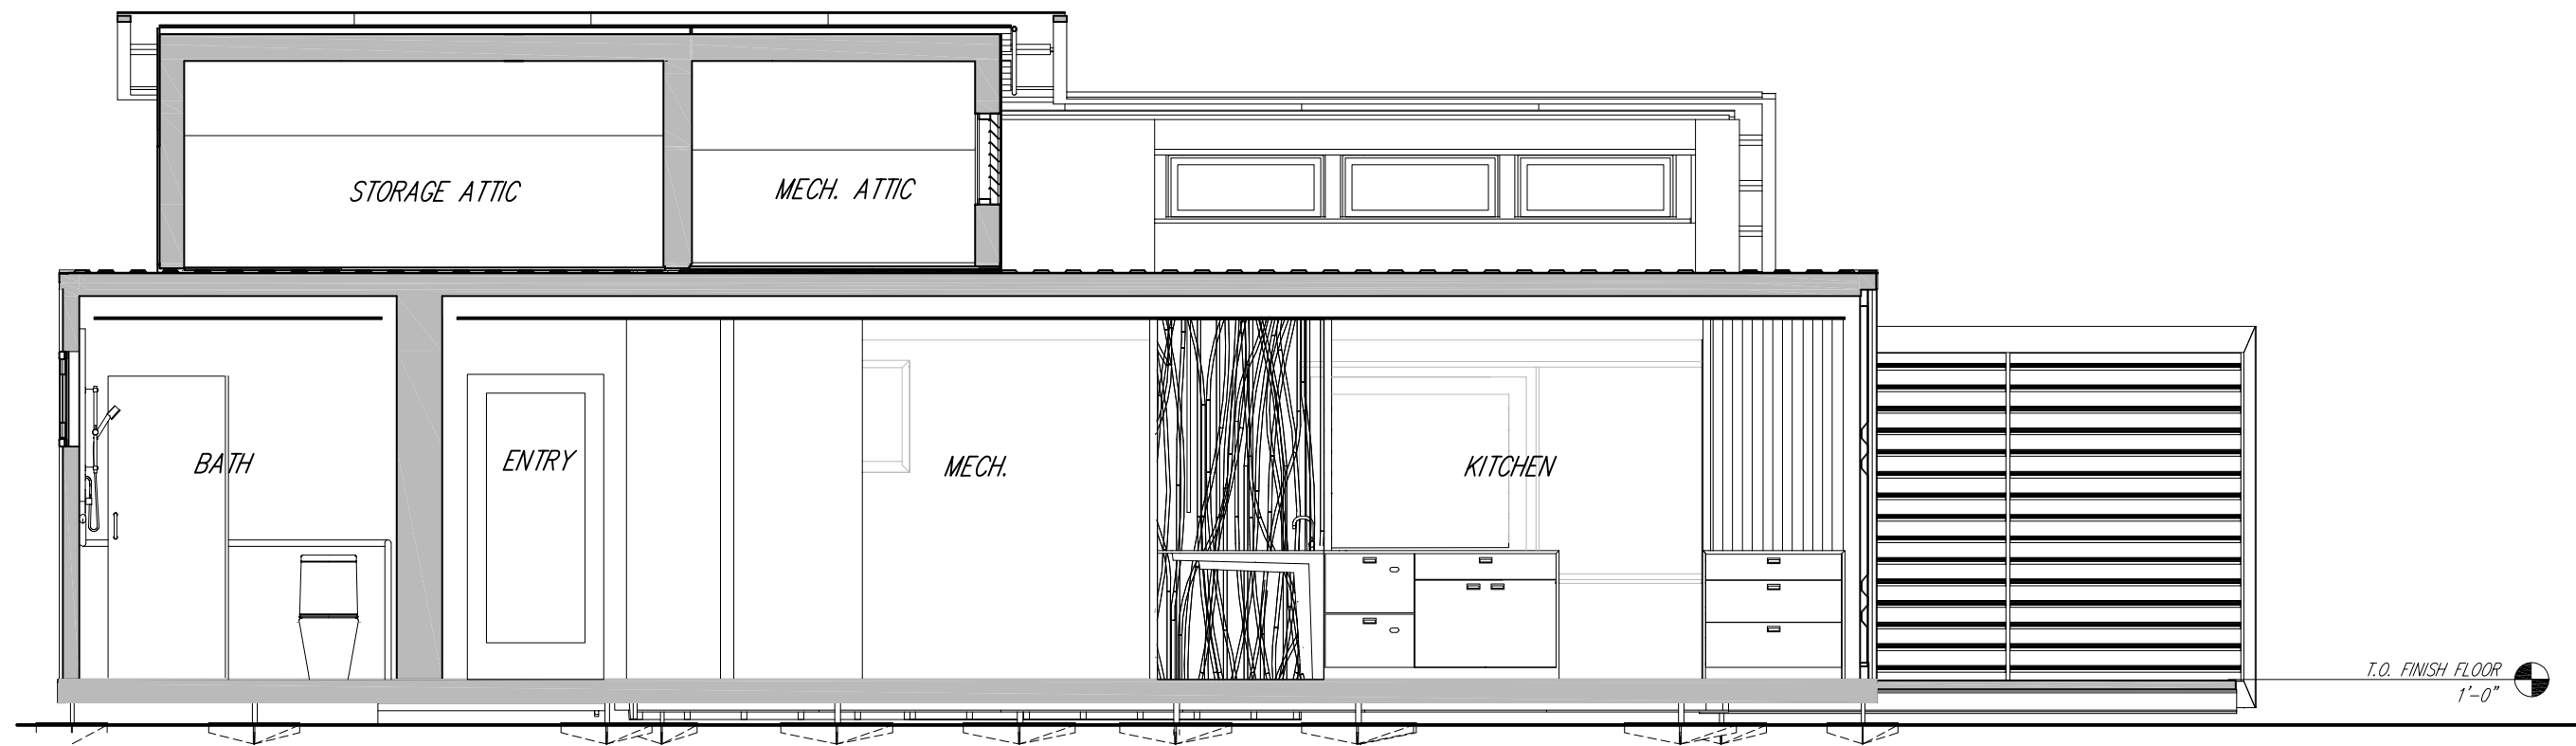

1 LONGITUDINAL BUILDING SECTION

1/4" = 1'-0"

Longitudinal Building Section

2007 Solar Decathlon

University of Colorado at Boulder


Civil, Environmental, and Architectural Engineering  
428 UCB, Room ECCE 441  
Boulder, CO 80309-0428



A2.01

Drawn by	Date
A. Rude	August 7, 2007
Revised	Date
A. Rude	January 9, 2008



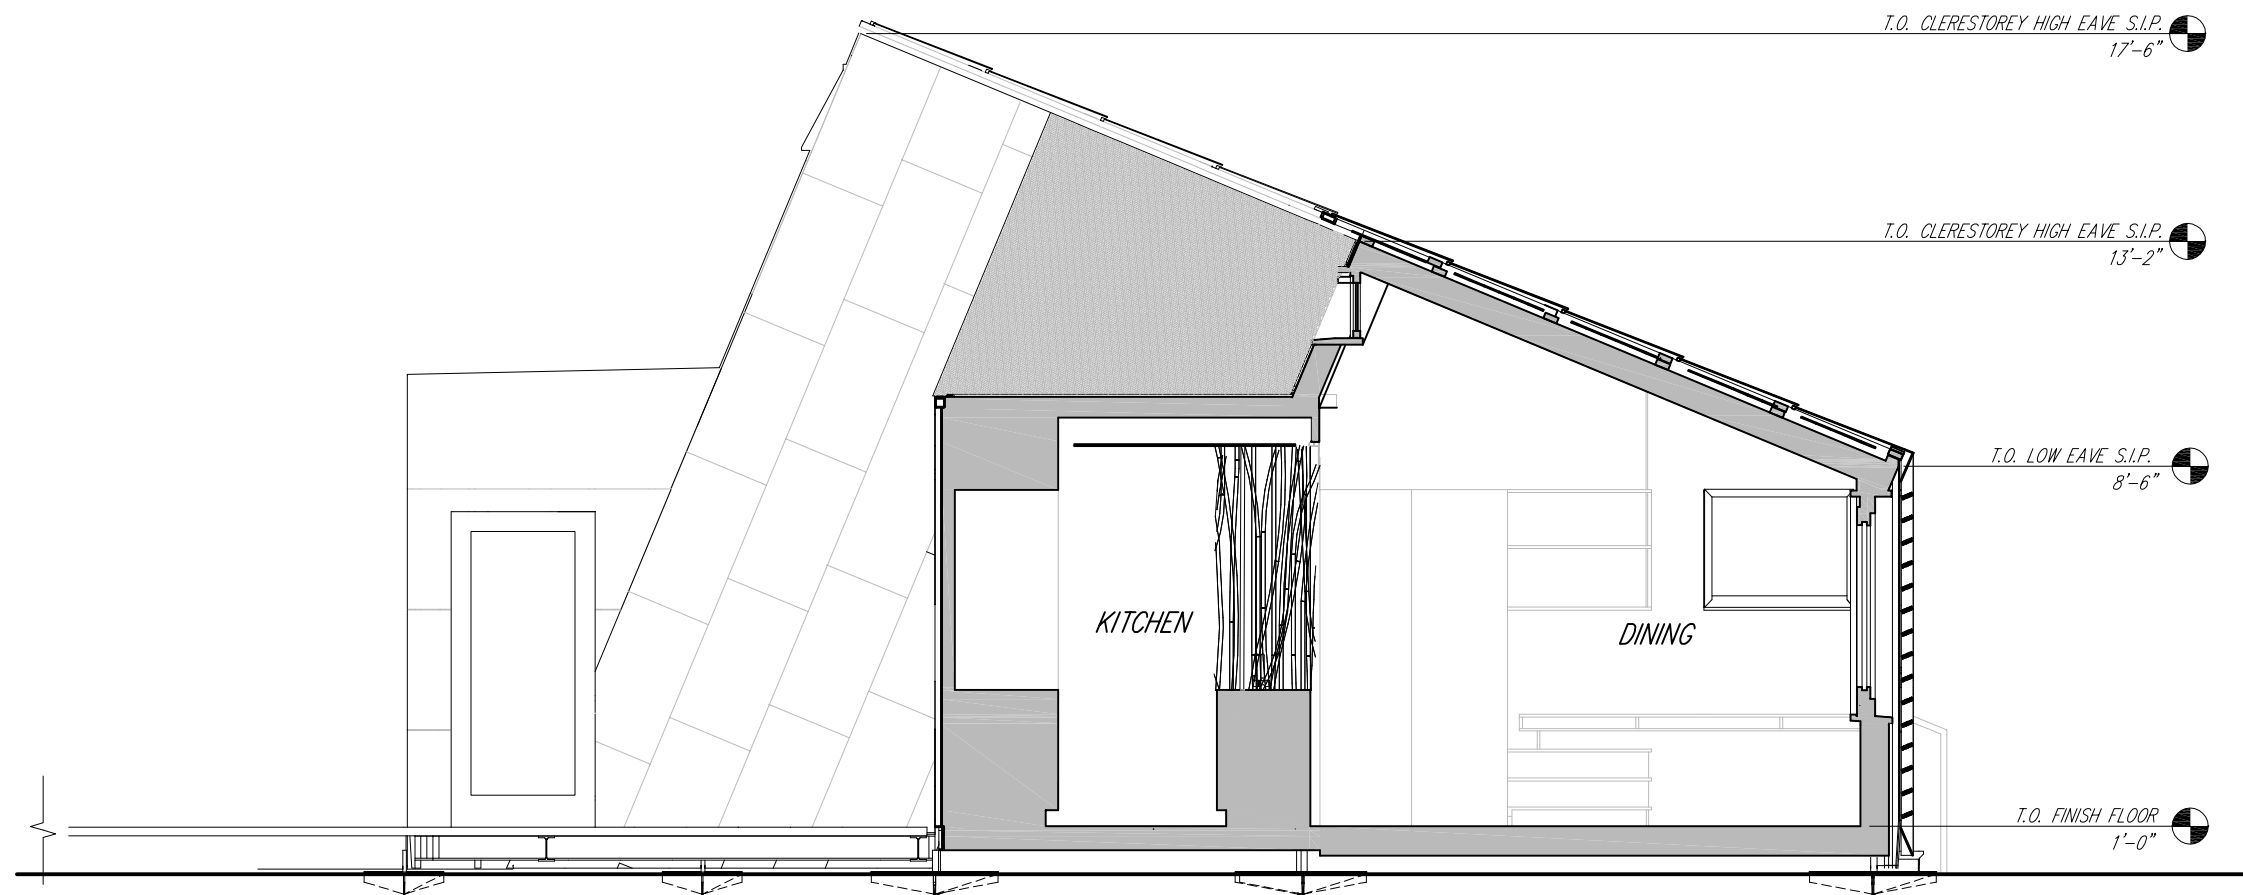

1 TRANSVERSE BUILDING SECTION AT LOWER CLERESTOREY


$1/4" = 1'-0"$

Drawn by	Date
A. Rude	August 7, 2007
Revised	Date
A. Rude	January 9, 2008

Transverse Building Section	2007 Solar Decathlon
University of Colorado at Boulder	
Civil, Environmental, and Architectural Engineering	
428 UCB, Room ECCE 441	
Boulder, CO 80309-0428	
0	8'
1'	
2'	
4'	



A2.02

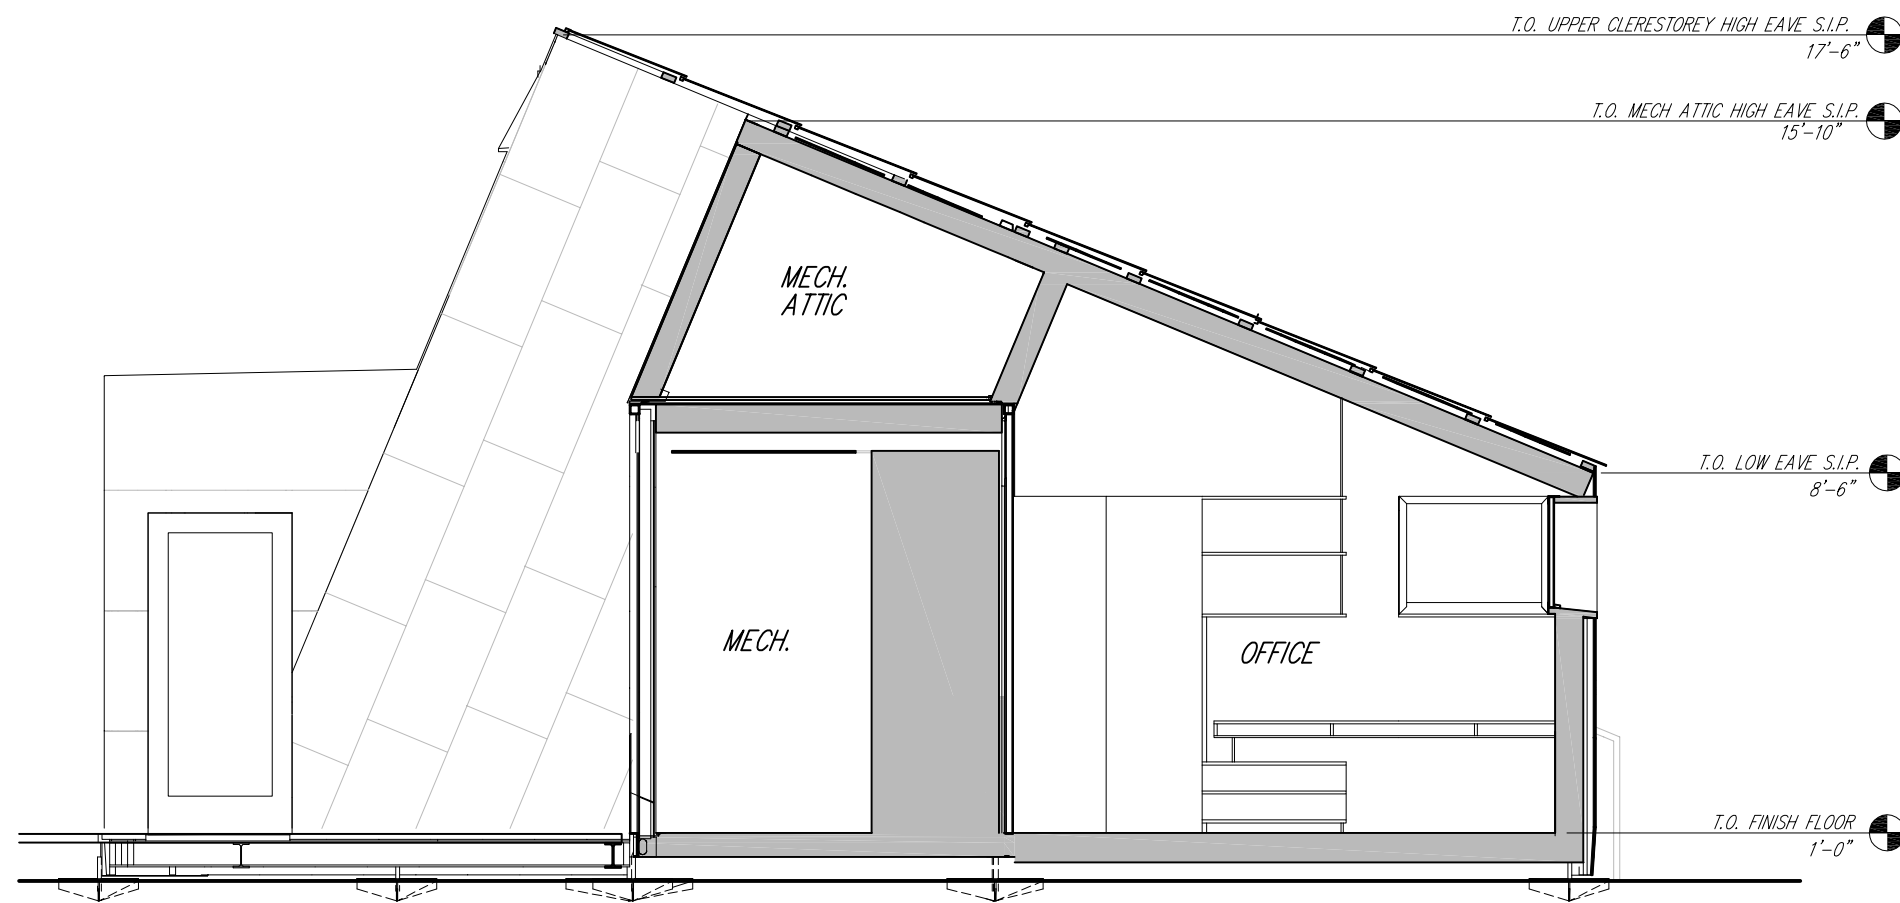

1 TRANSVERSE BUILDING SECTION AT MECHANICAL ATTIC


$1/4" = 1'-0"$

Drawn by	Date
A. Rude	August 7, 2007
Revised	Date
A. Rude	January 9, 2008

Transverse Building Section	2007 Solar Decathlon
University of Colorado at Boulder	
Civil, Environmental, and Architectural Engineering	
428 UCB, Room ECCE 441	
Boulder, CO 80309-0428	



A2.03

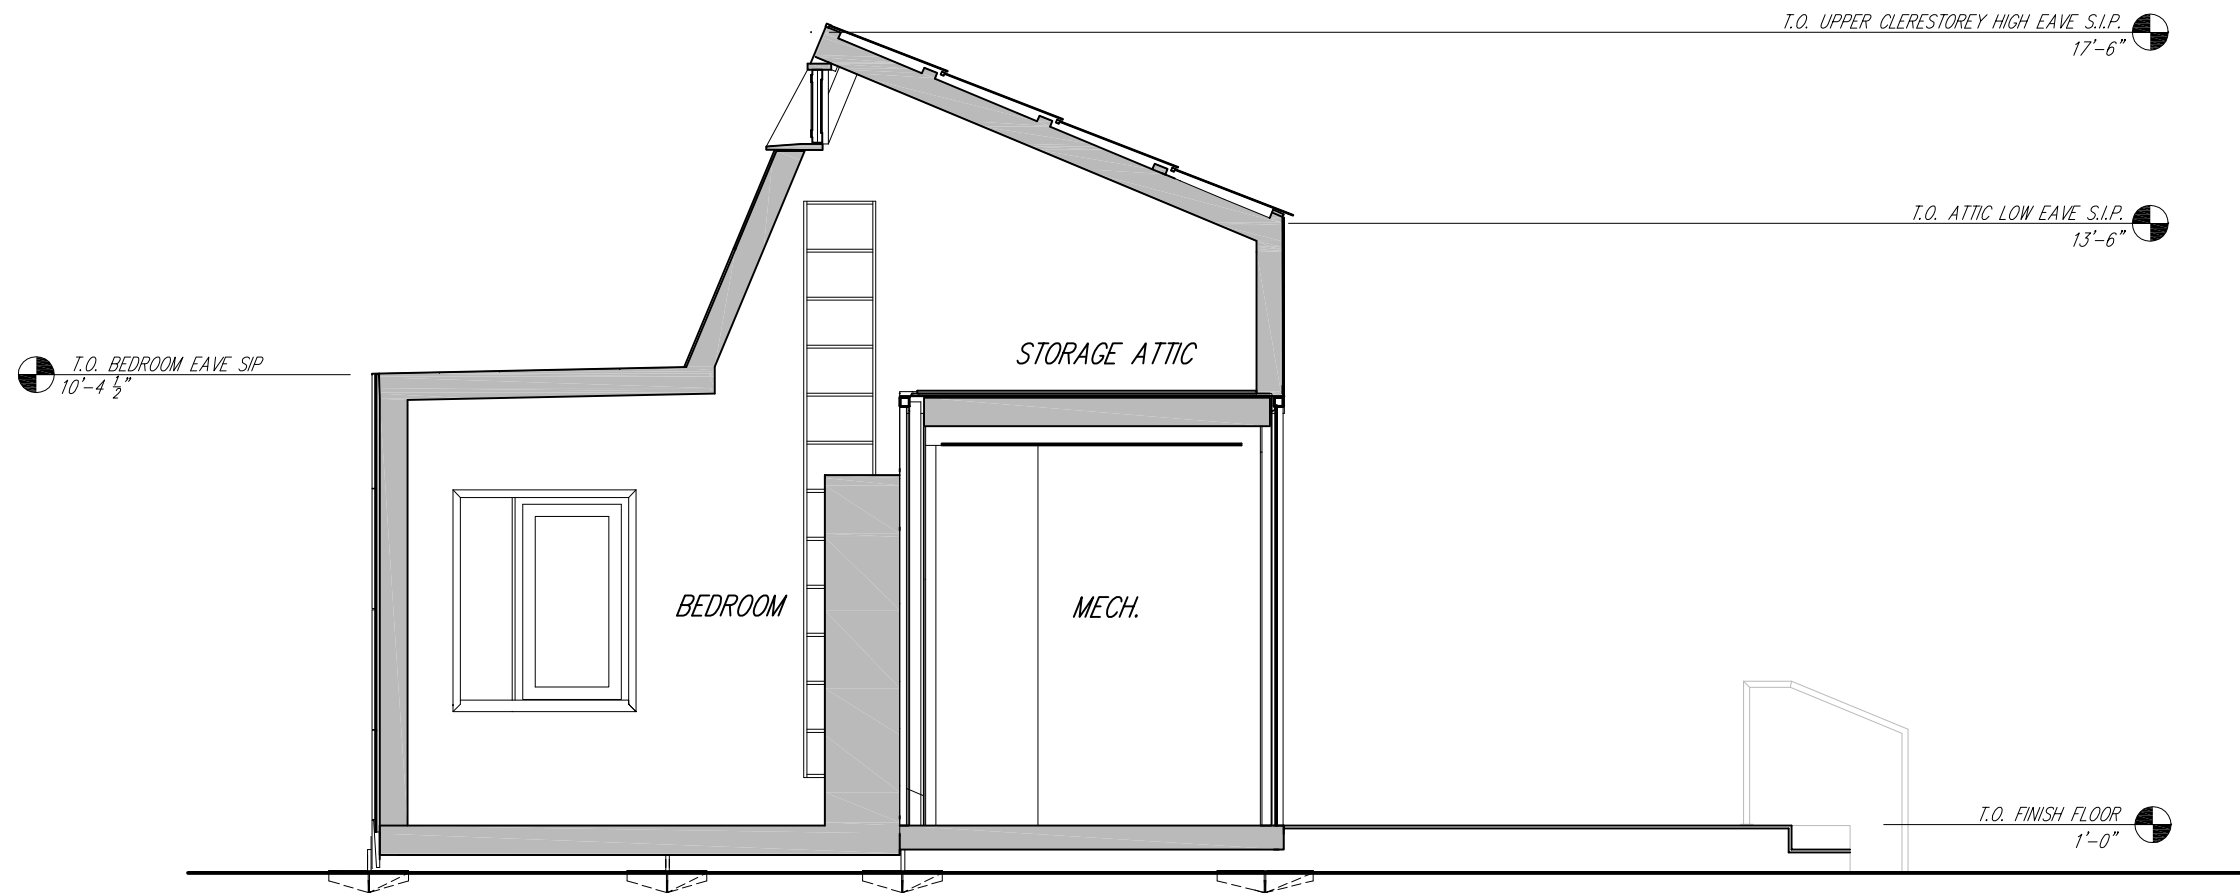

1 TRANSVERSE BUILDING SECTION AT UPPER CLERESTOREY


$1/4" = 1'-0"$

Drawn by	Date
A. Rude	August 7, 2007
Revised	Date
A. Rude	January 9, 2008

Transverse Building Section	2007 Solar Decathlon
University of Colorado at Boulder	
Civil, Environmental, and Architectural Engineering	
428 UCB, Room ECCE 441	
Boulder, CO 80309-0428	



A2.04

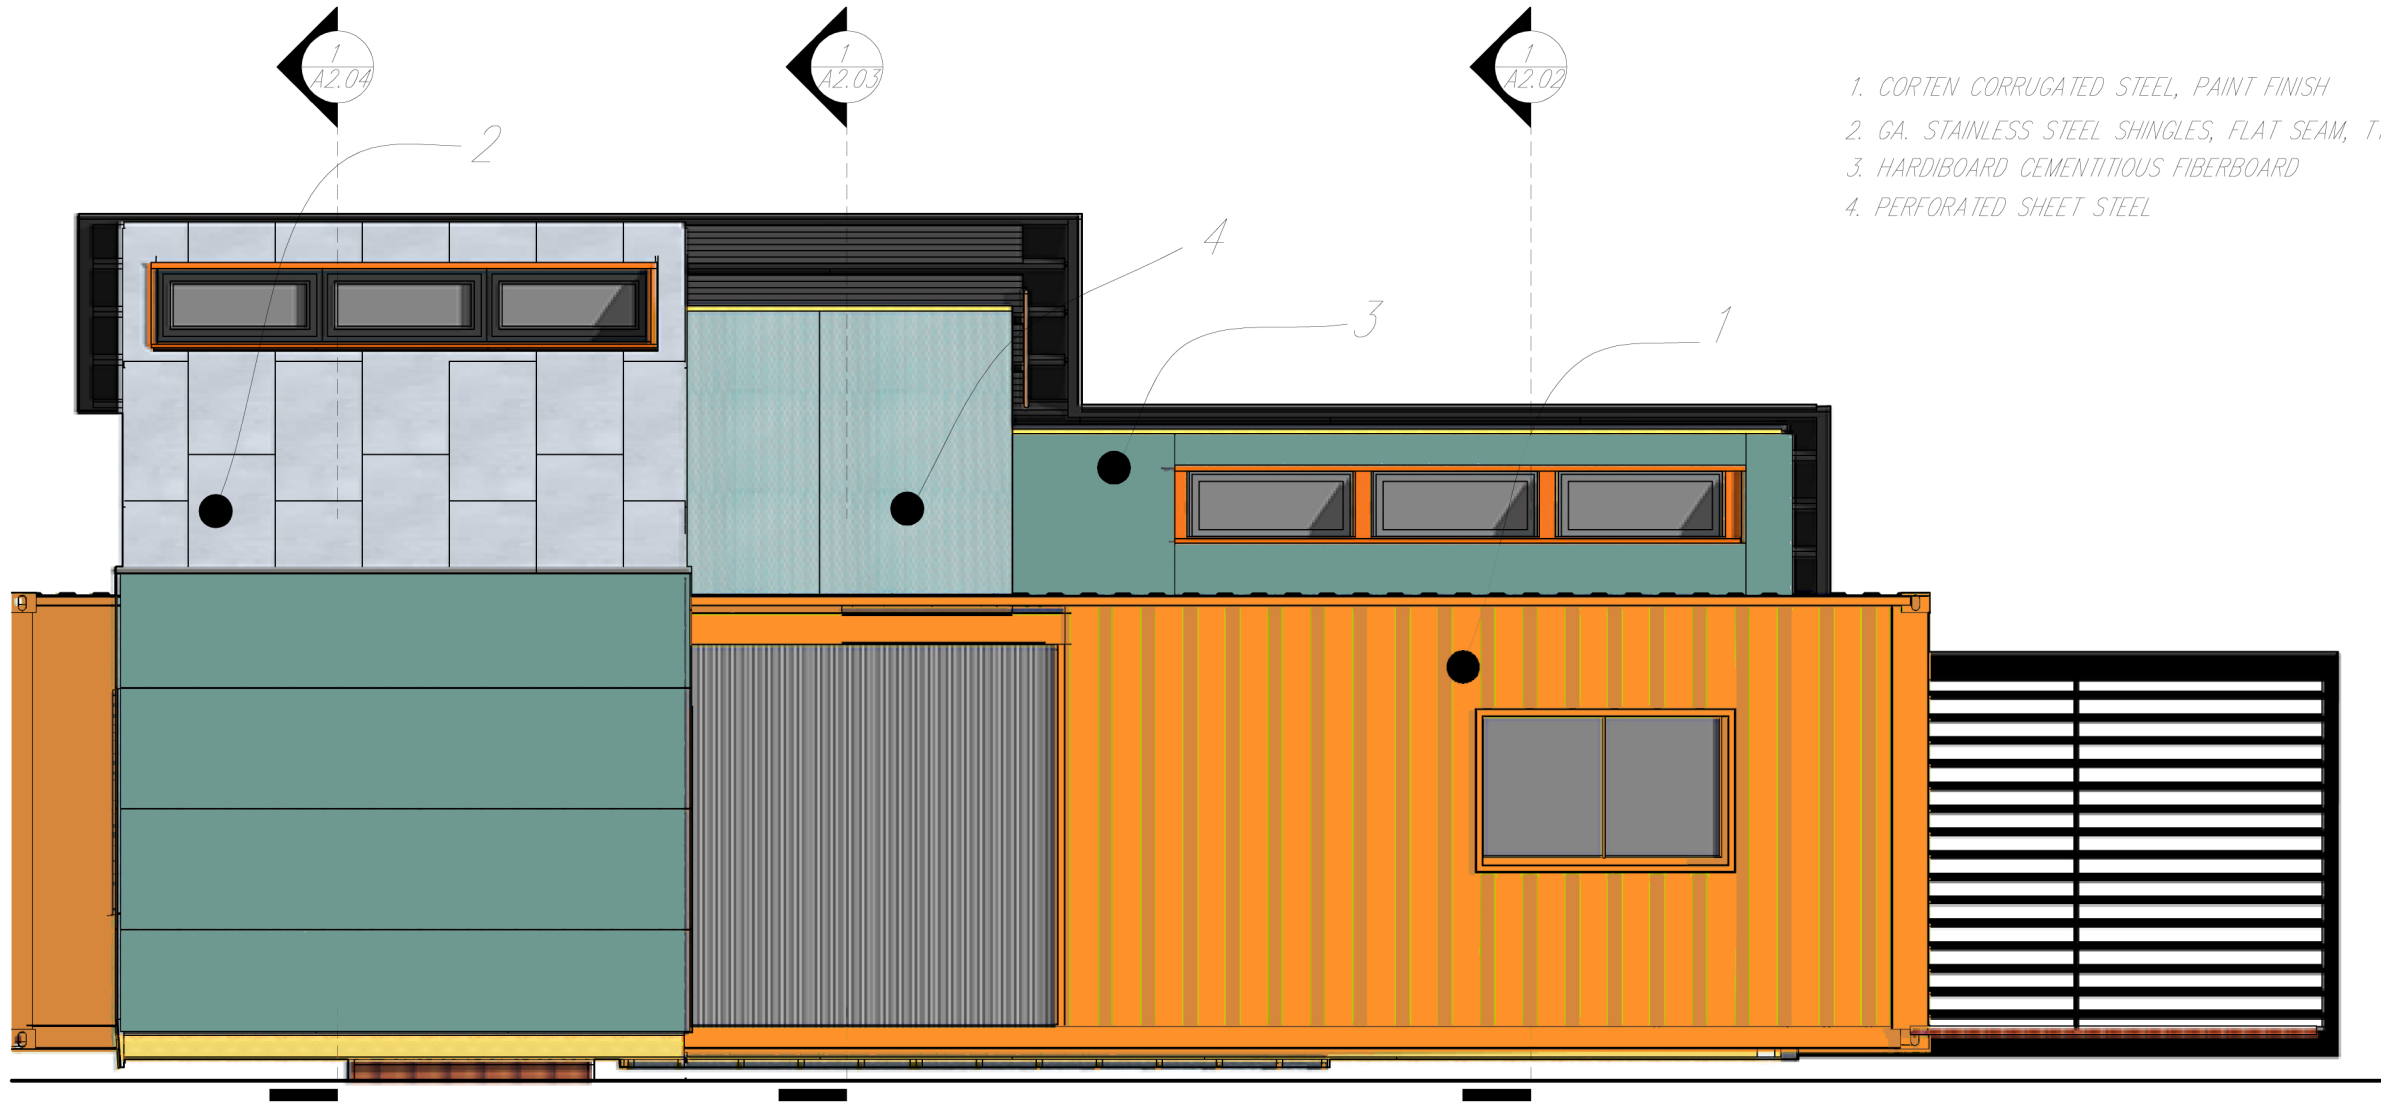

1 NORTH EXTERIOR ELEVATION

1/4" = 1'-0"

Drawn by	Date
S. Hauze	August 7, 2007
Revised	Date


2007 Solar Decathlon  
University of Colorado at Boulder  
Civil, Environmental, and Architectural Engineering  
428 UCB, Room ECCE 441  
Boulder, CO 80309-0428

North Exterior Elevation  
0 1' 2' 4' 8'



A3.01

1 EAST EXTERIOR ELEVATION

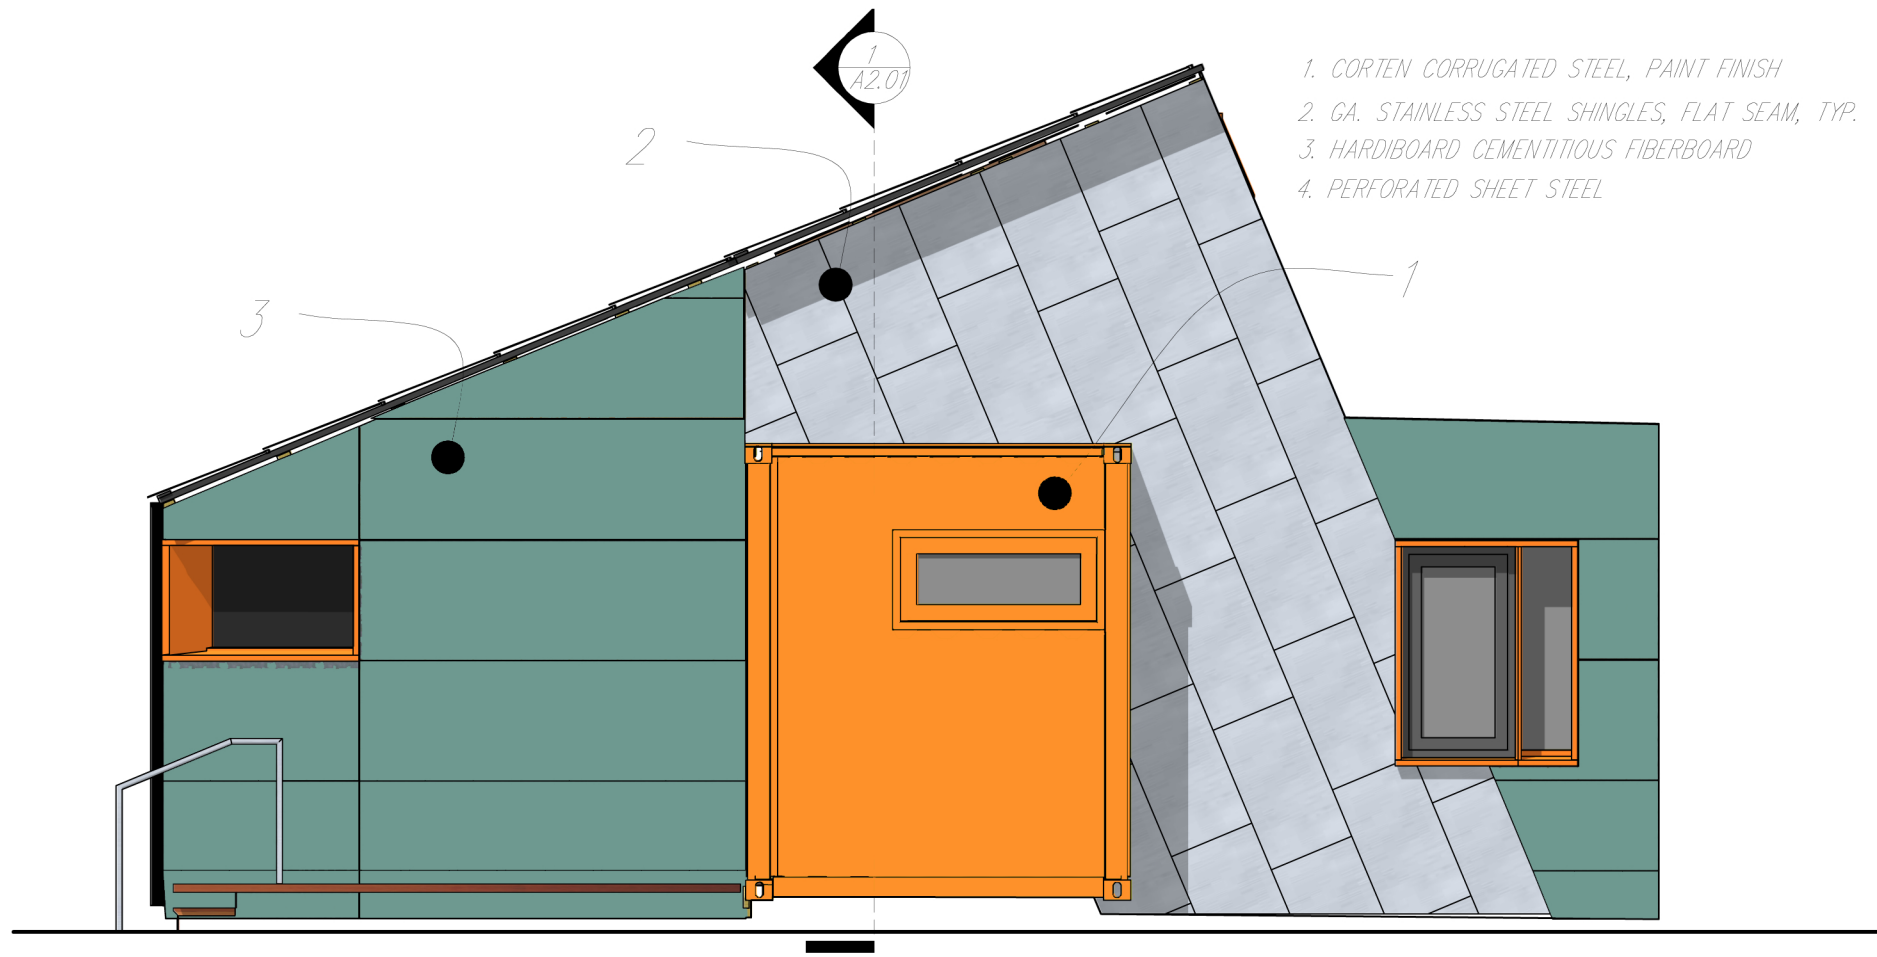

1/4" = 1'-0"

East Exterior Elevation



2007 Solar Decathlon

University of Colorado at Boulder  
Civil, Environmental, and Architectural Engineering  
428 UCB, Room ECCE 441  
Boulder, CO 80309-0428




A3.02

Drawn by	Date
S. Hauze	August 7, 2007
Revised	Date



- 1. CORTEN CORRUGATED STEEL, PAINT FINISH
- 2. GA. STAINLESS STEEL SHINGLES, FLAT SEAM, TYP.
- 3. HARDIBOARD CEMENTITIOUS FIBERBOARD
- 4. PERFORATED SHEET STEEL

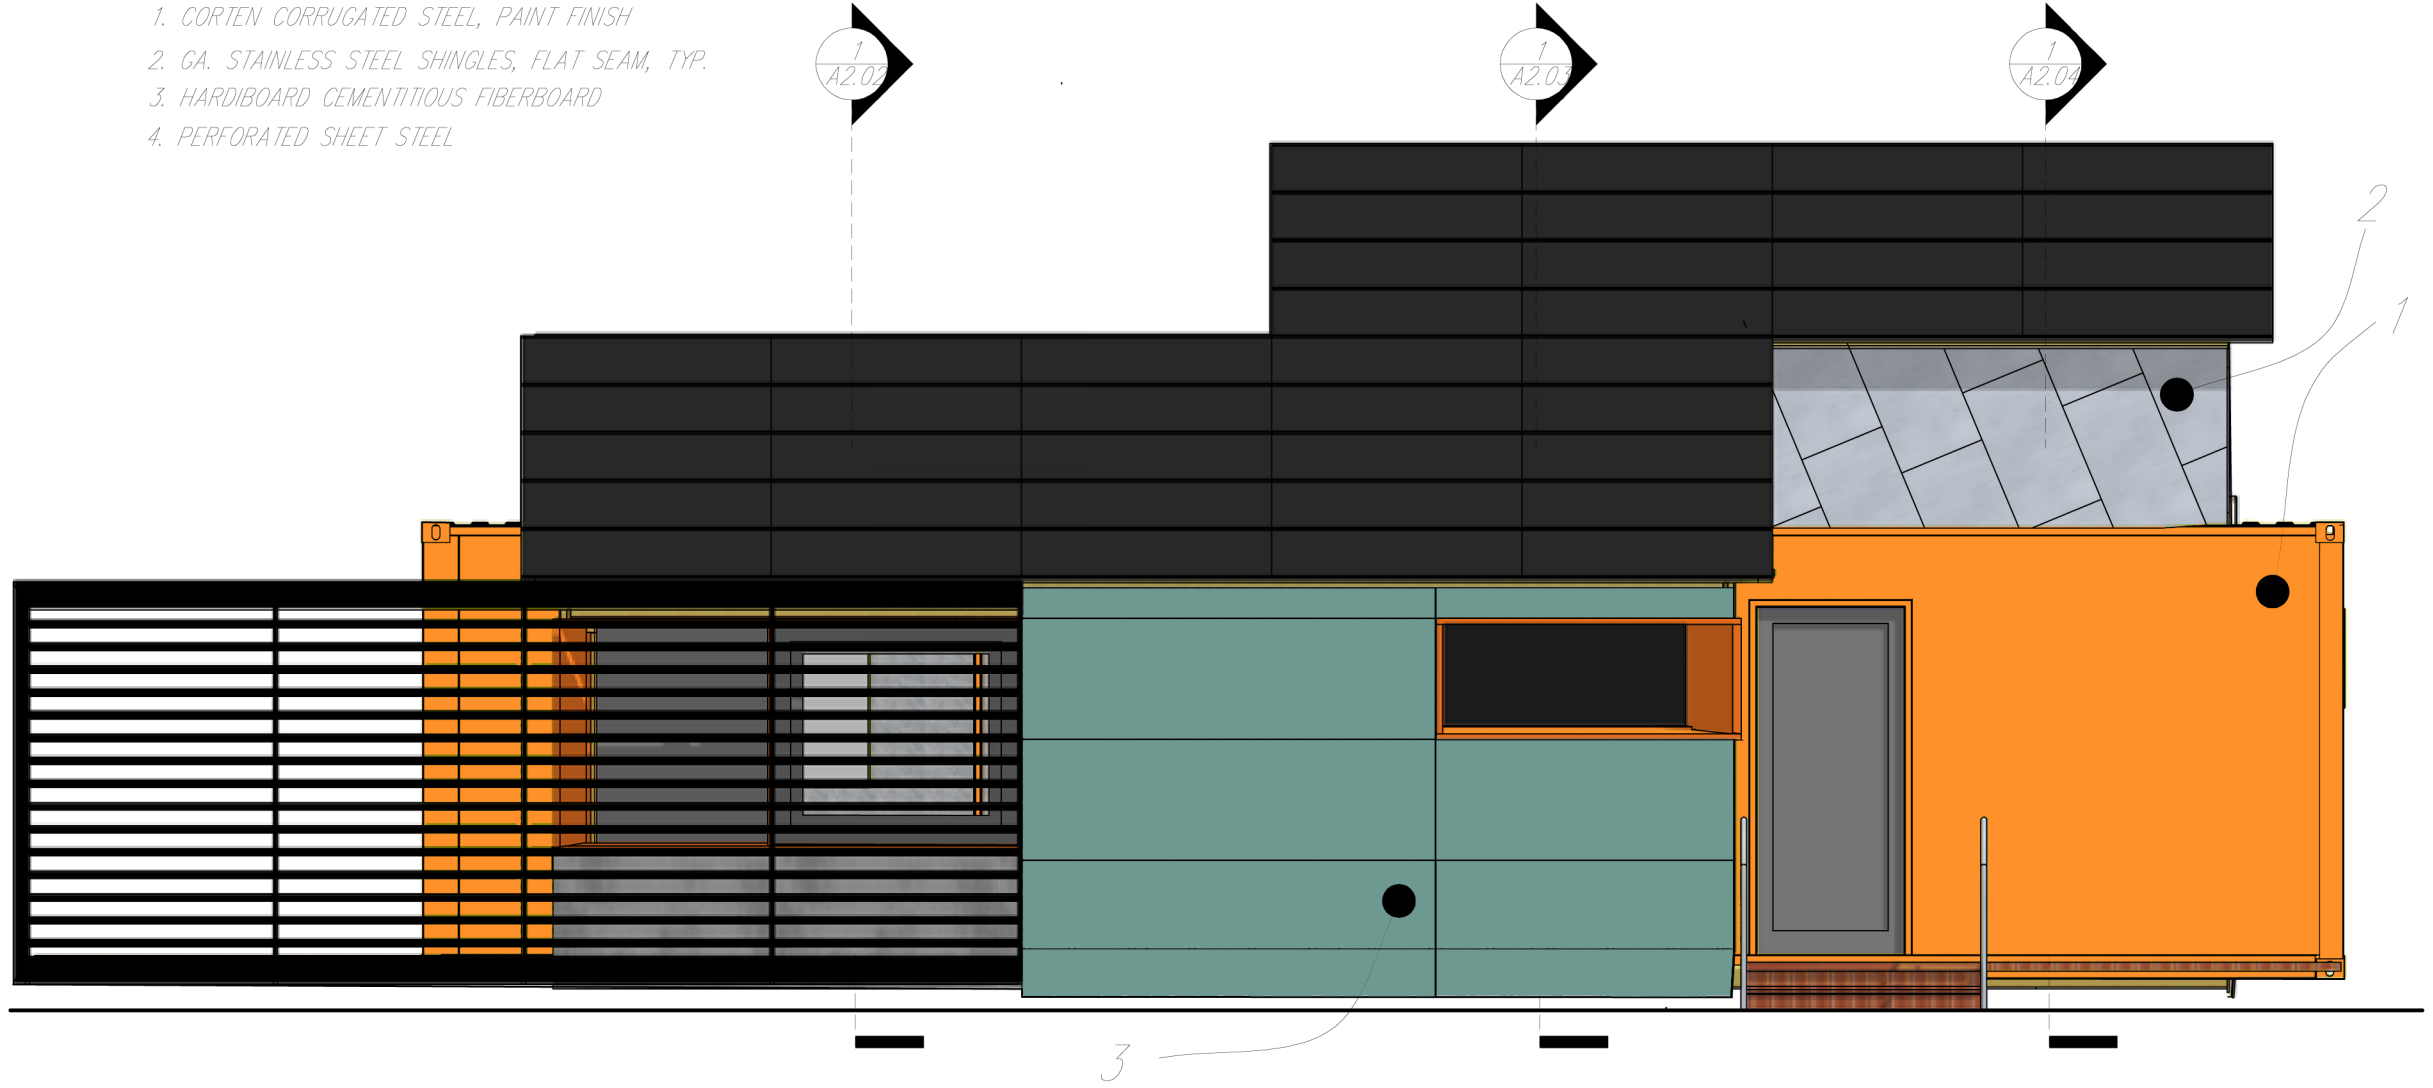

1 SOUTH EXTERIOR ELEVATION

1/4" = 1'-0"

Drawn by	Date
S. Hauze	August 7, 2007
Revised	Date

South Exterior Elevation

2007 Solar Decathlon

University of Colorado at Boulder

Civil, Environmental, and Architectural Engineering


428 UCB, Room ECCE 441

Boulder, CO 80309-0428

0 1' 2' 4' 8'



A3.03

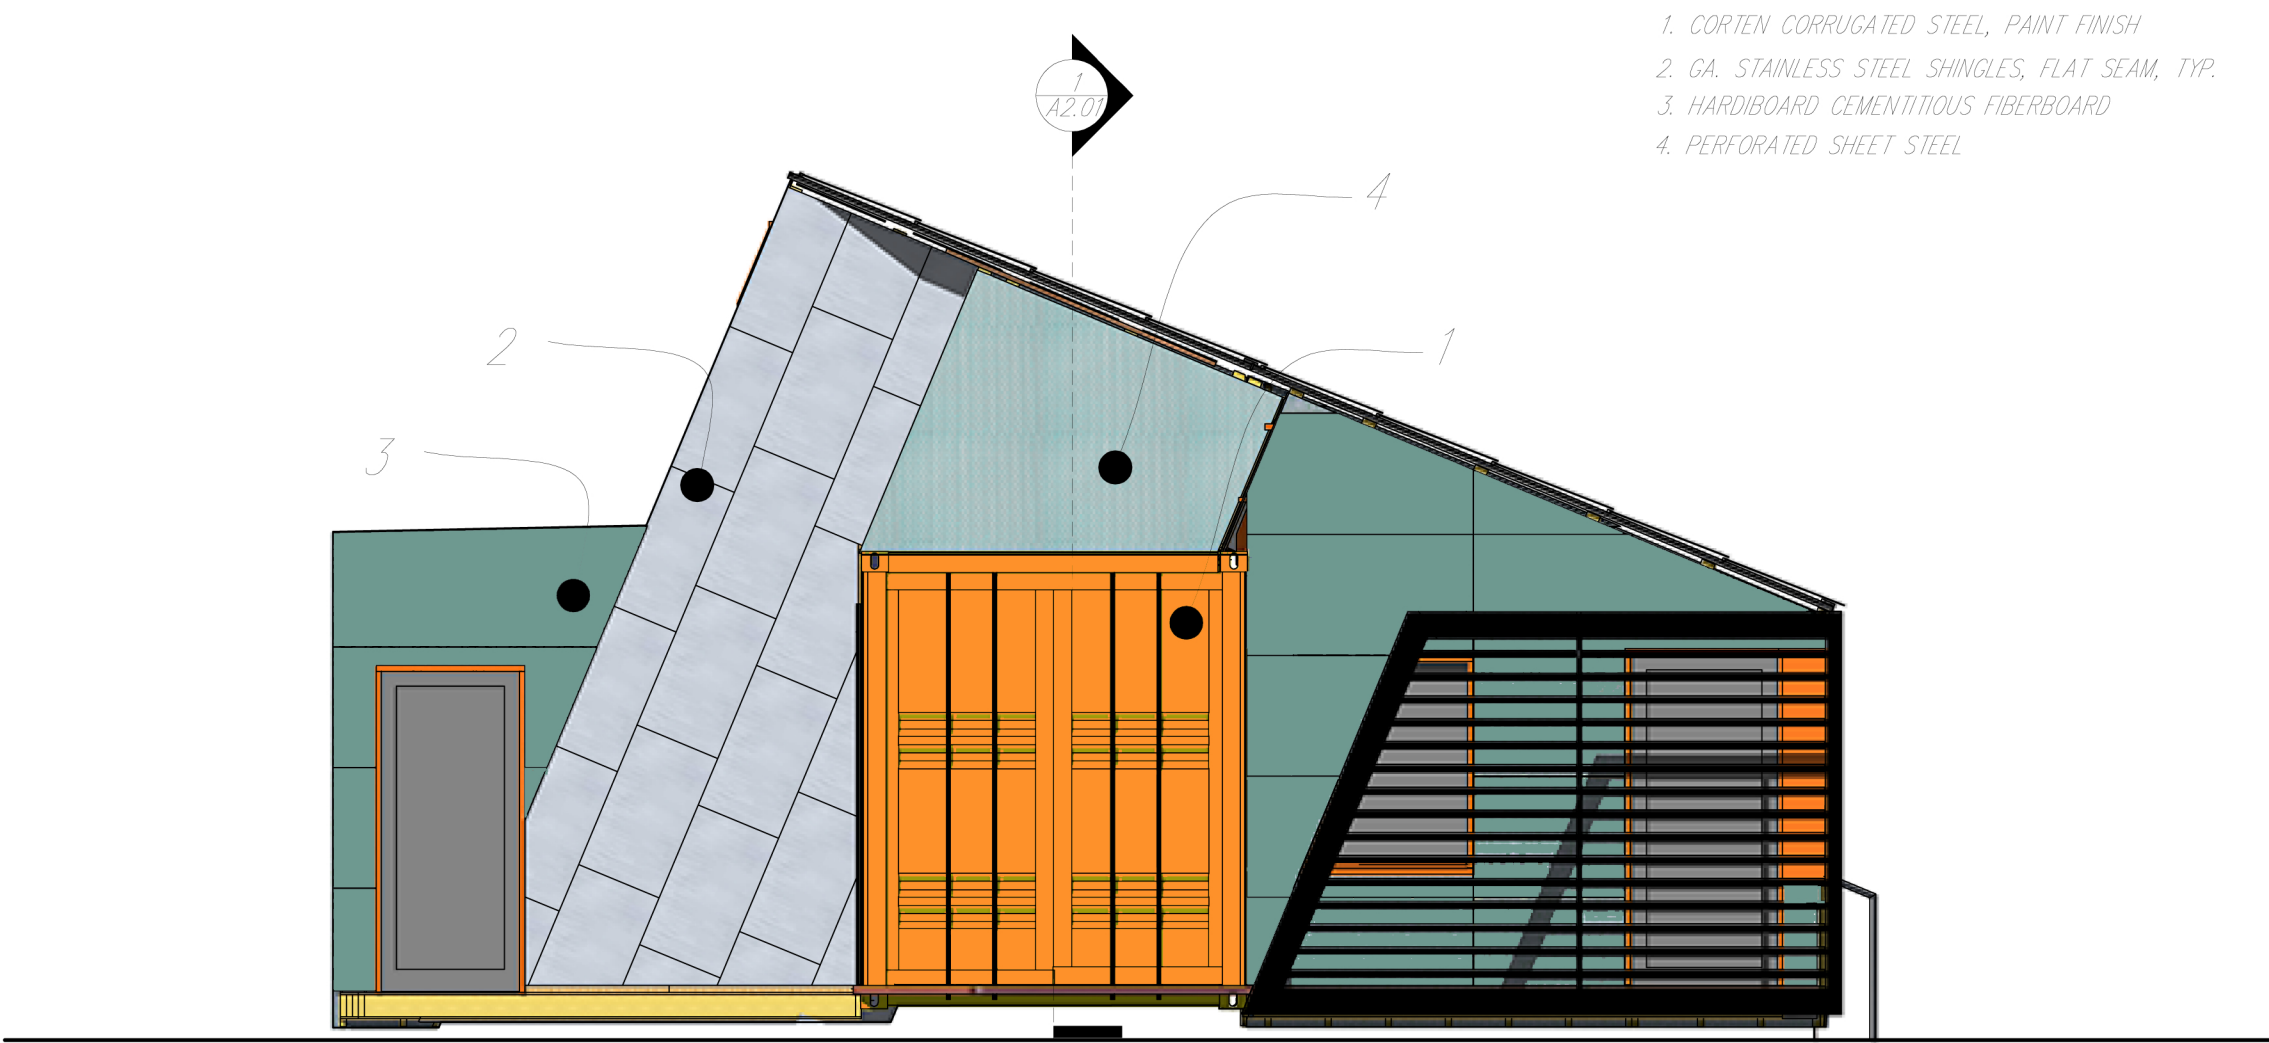

- 1. CORTEN CORRUGATED STEEL, PAINT FINISH
- 2. GA. STAINLESS STEEL SHINGLES, FLAT SEAM, TYP.
- 3. HARDIBOARD CEMENTITIOUS FIBERBOARD
- 4. PERFORATED SHEET STEEL

1 WEST EXTERIOR ELEVATION

1/4" = 1'-0"

West Exterior Elevation




2007 Solar Decathlon

University of Colorado at Boulder  
Civil, Environmental, and Architectural Engineering  
428 UCB, Room ECCE 441  
Boulder, CO 80309-0428




A3.04

Drawn by	Date
S. Hauze	August 7, 2007
Revised	Date

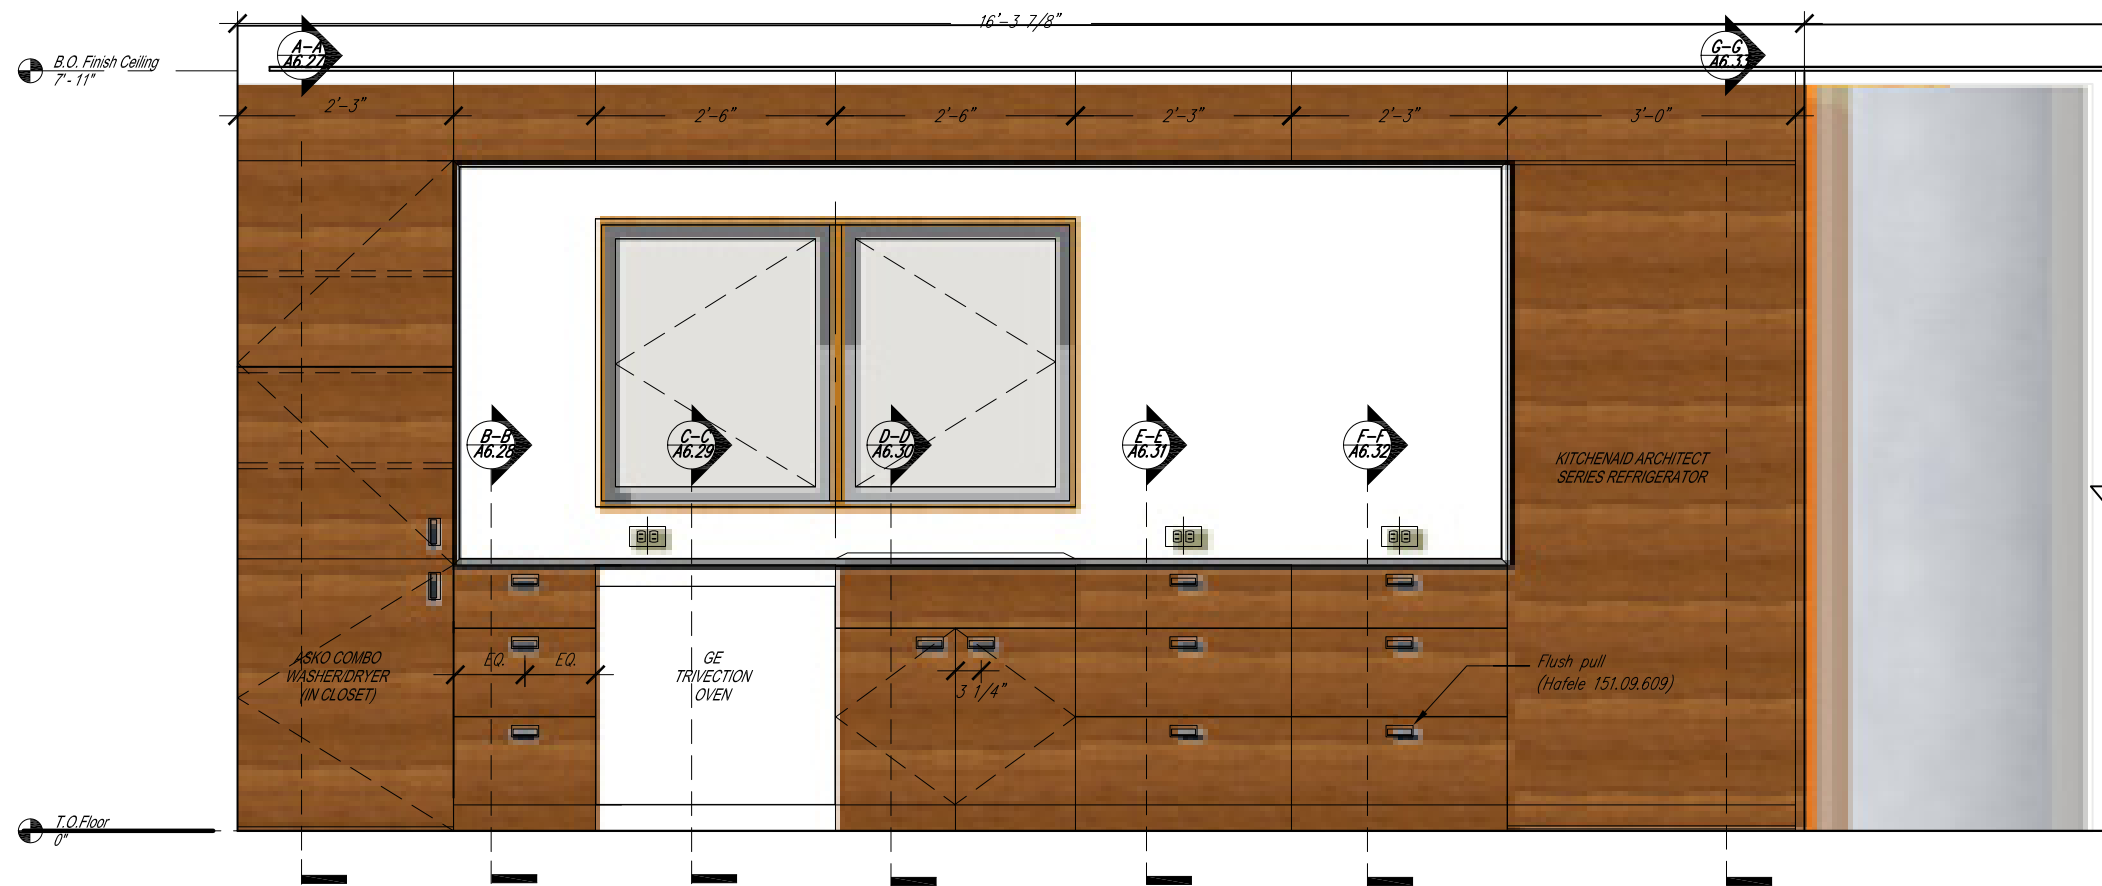

1 KITCHEN NORTH INTERIOR ELEVATION

1/2" = 1'-0"

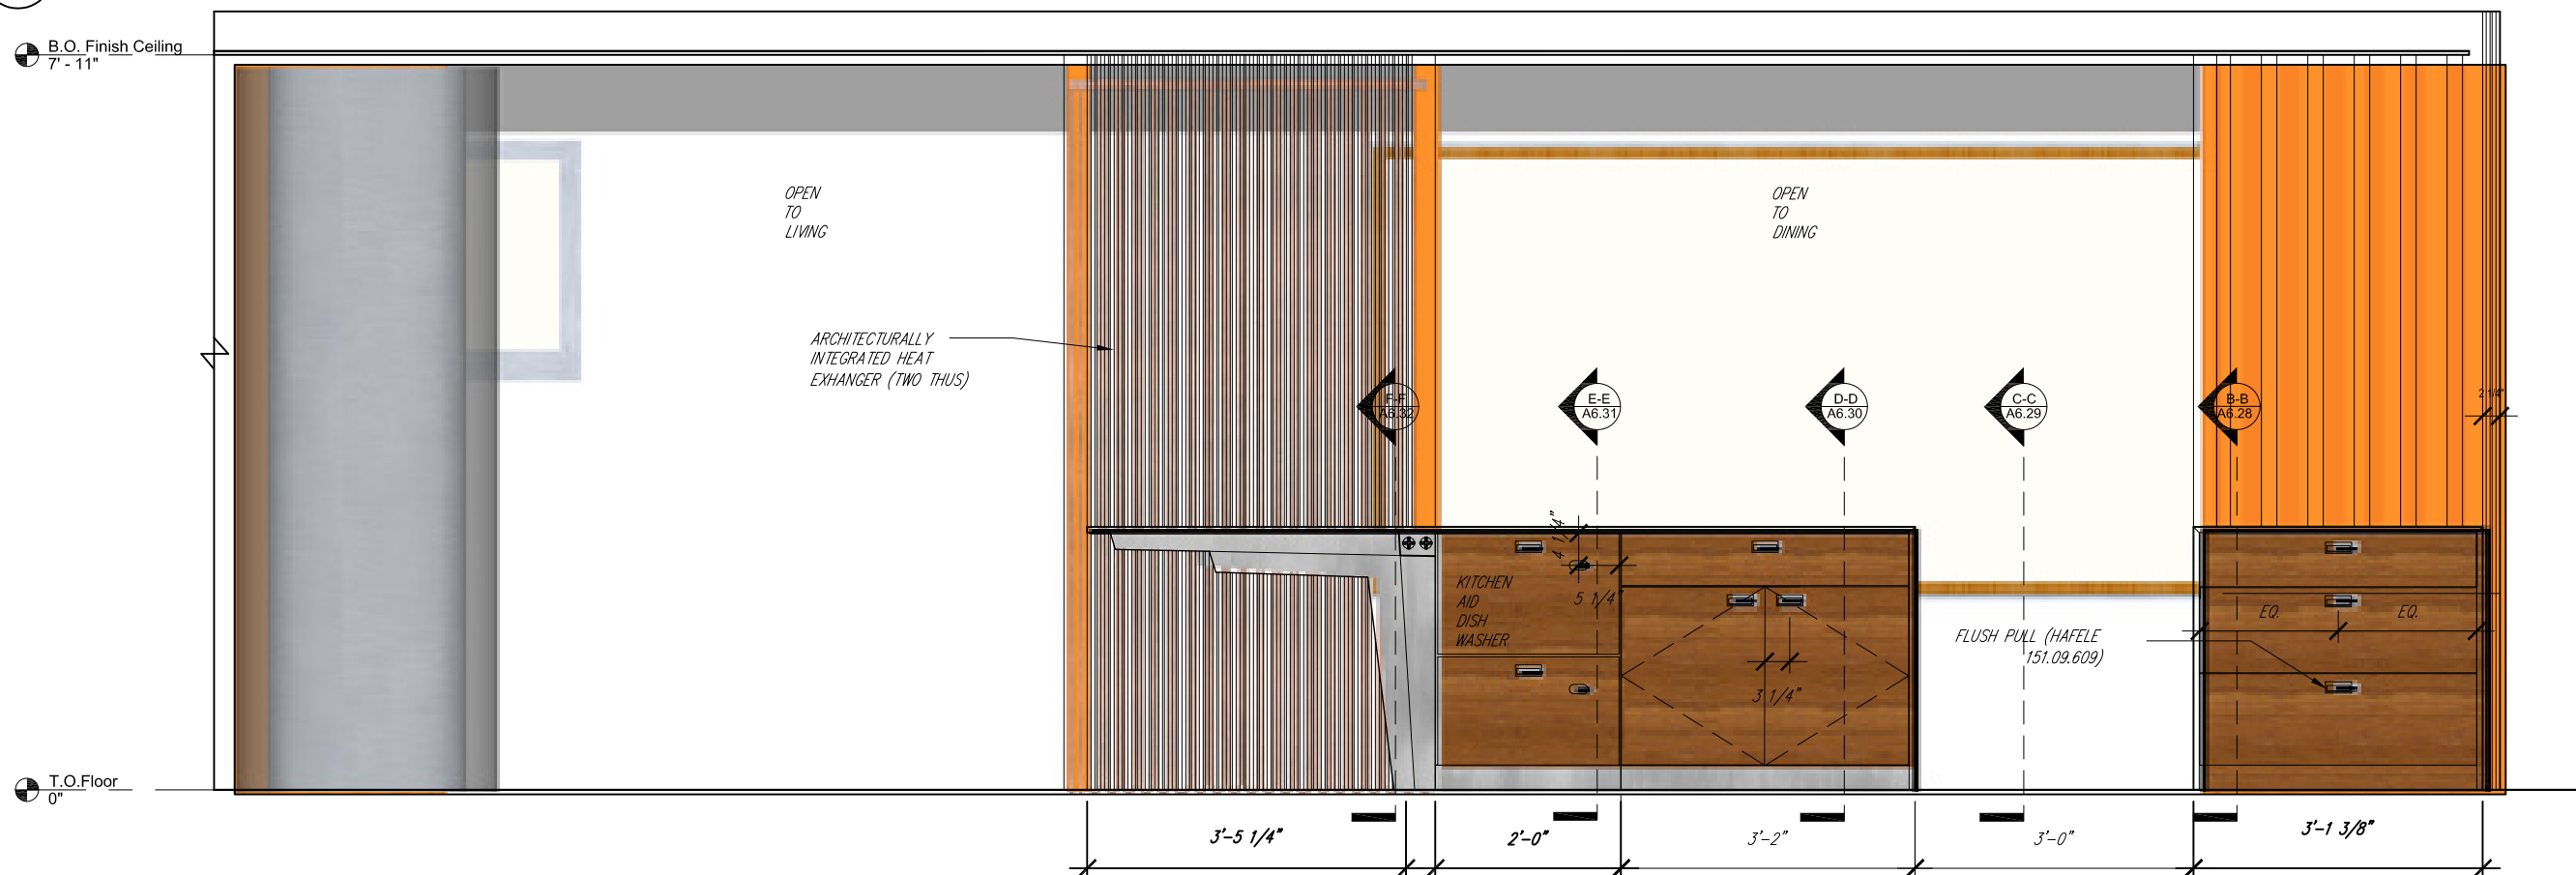


2 KITCHEN SOUTH INTERIOR ELEVATION

1/2" = 1'-0"

Drawn by	Date
S. Hauze	August 7, 2007
Revised	Date


2007 Solar Decathlon	University of Colorado at Boulder
Civil, Environmental, and Architectural Engineering	428 UCB, Room ECCE 441
Boulder, CO 80309-0428	



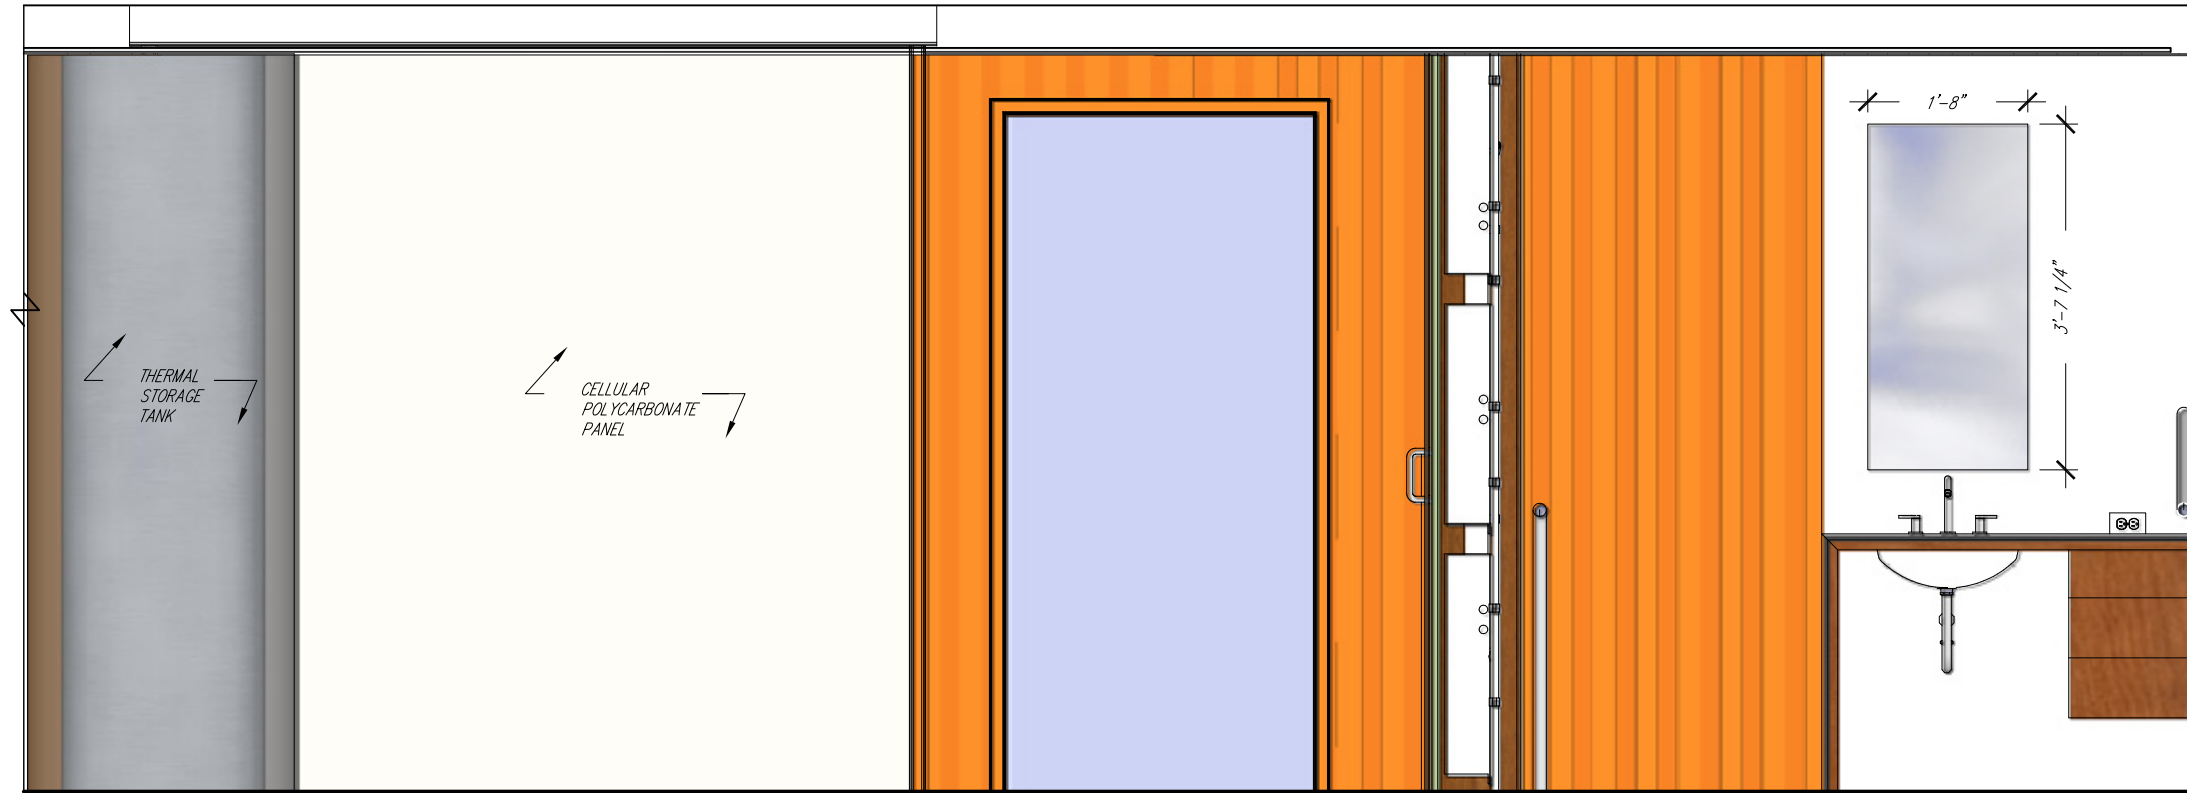

1 MECHANICAL/BATH NORTH INTERIOR ELEVATION

1/2" = 1'-0"

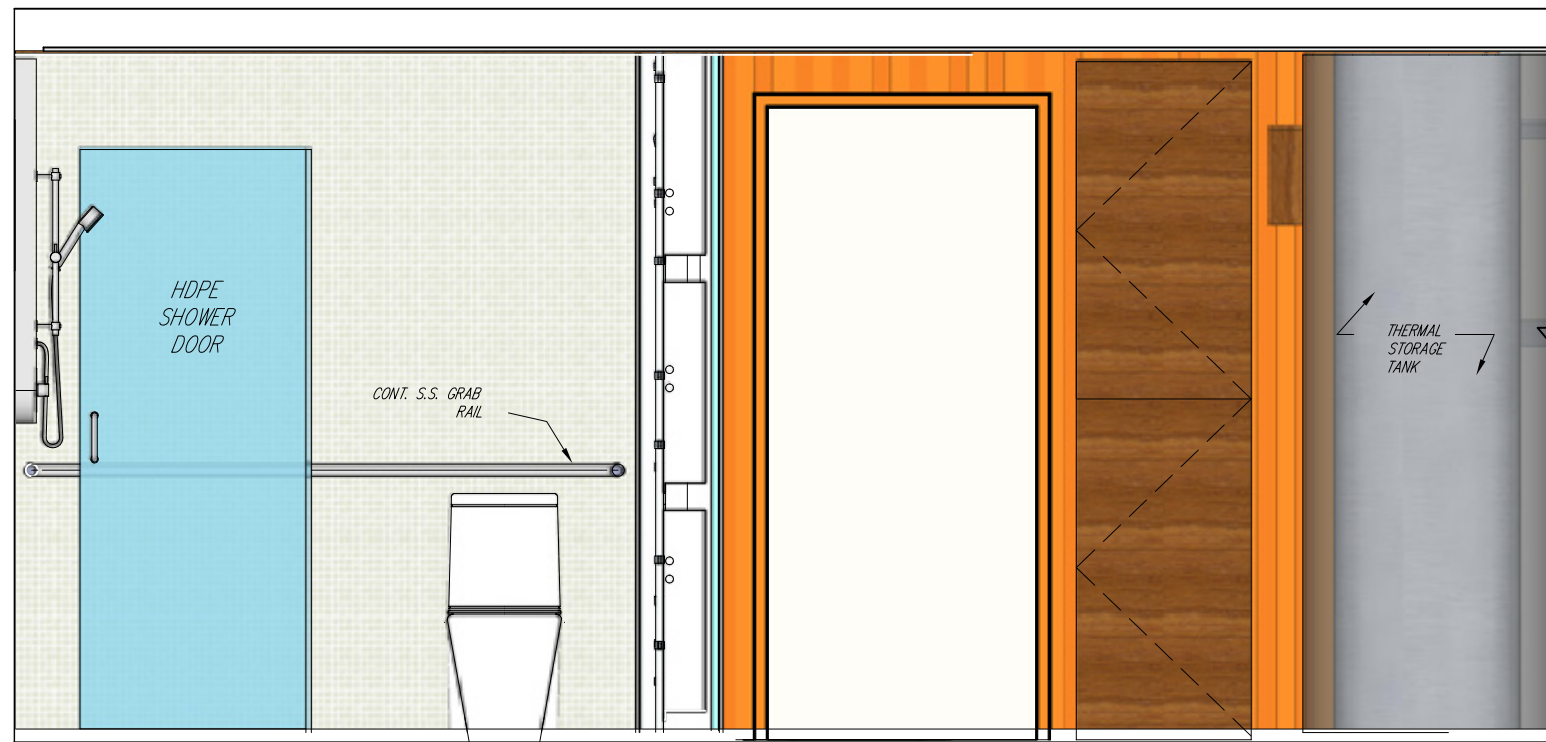

2 MECHANICAL/BATH SOUTH INTERIOR ELEVATION


1/2" = 1'-0"

Drawn by	Date
S. Hauze	August 7, 2007
Revised	Date


Mech./Bath North/South Int. Elevations 2007 Solar Decathlon	University of Colorado at Boulder
	Civil, Environmental, and Architectural Engineering
	428 UCB, Room ECCE 441
	Boulder, CO 80309-0428






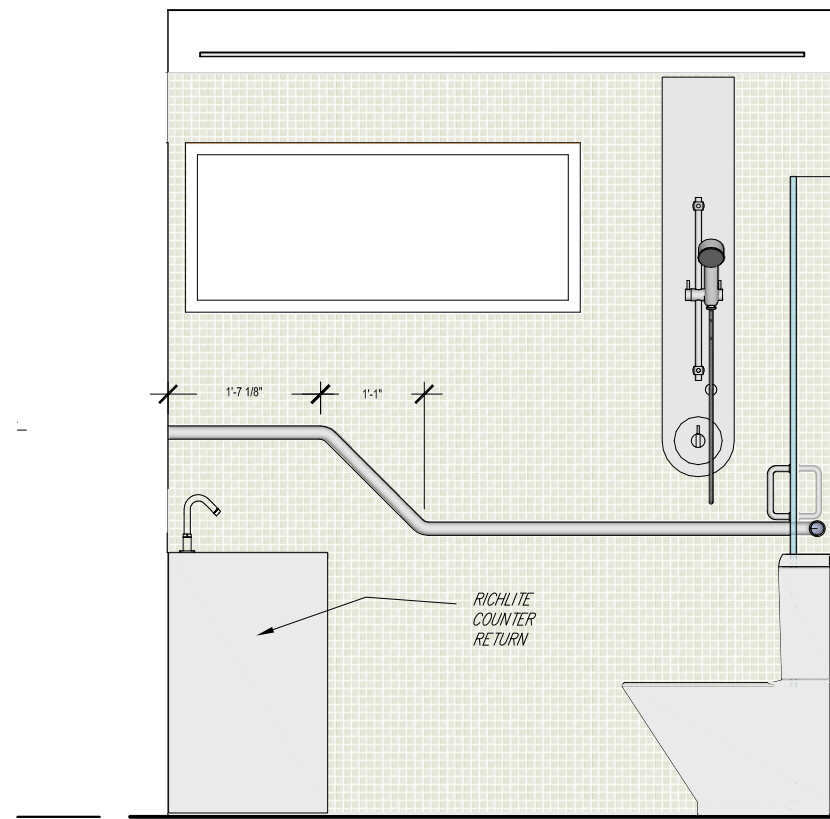


② BATH EAST INTERIOR ELEVATION  $1/2'' = 1'-0''$

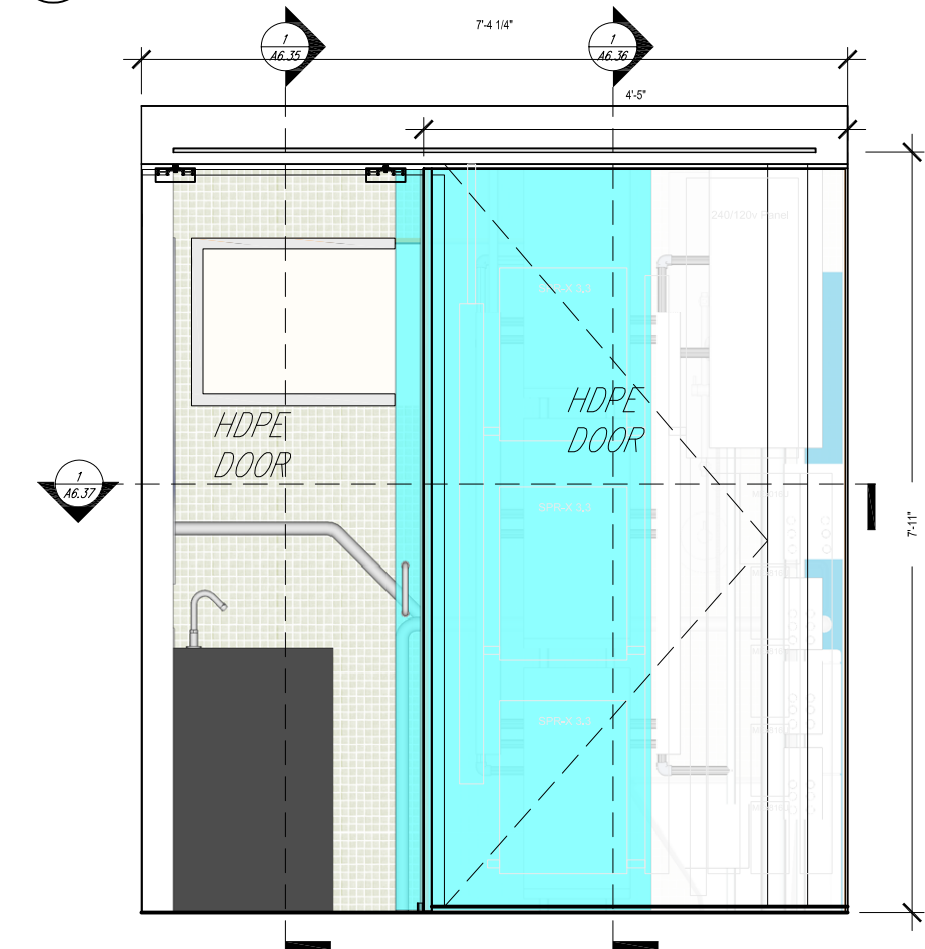

③ MECH. SPACE EAST INTERIOR ELEVATION  $1/2'' = 1'-0''$

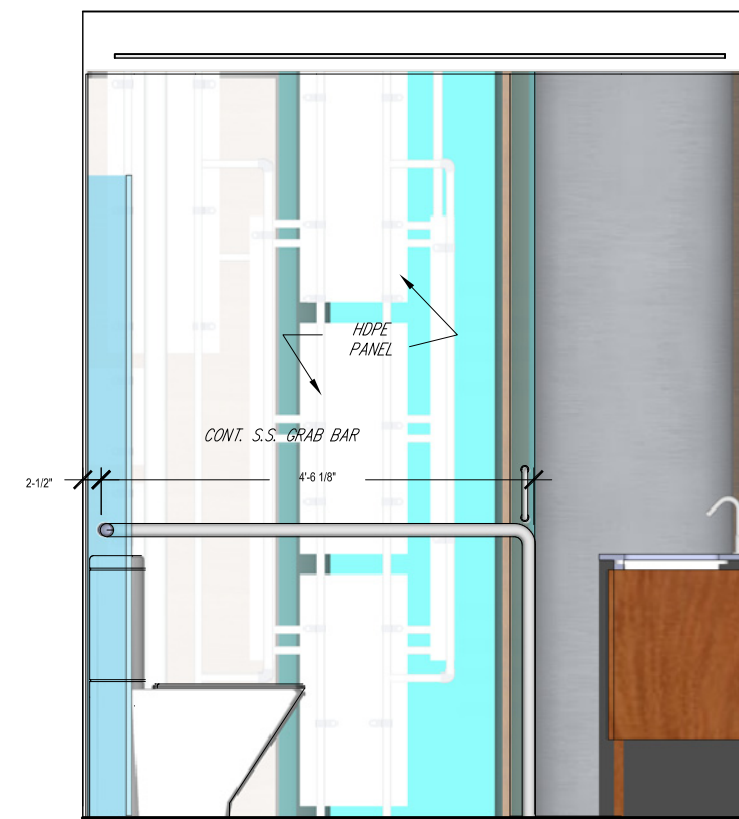

① BATH WEST INTERIOR ELEVATION  $1/2'' = 1'-0''$

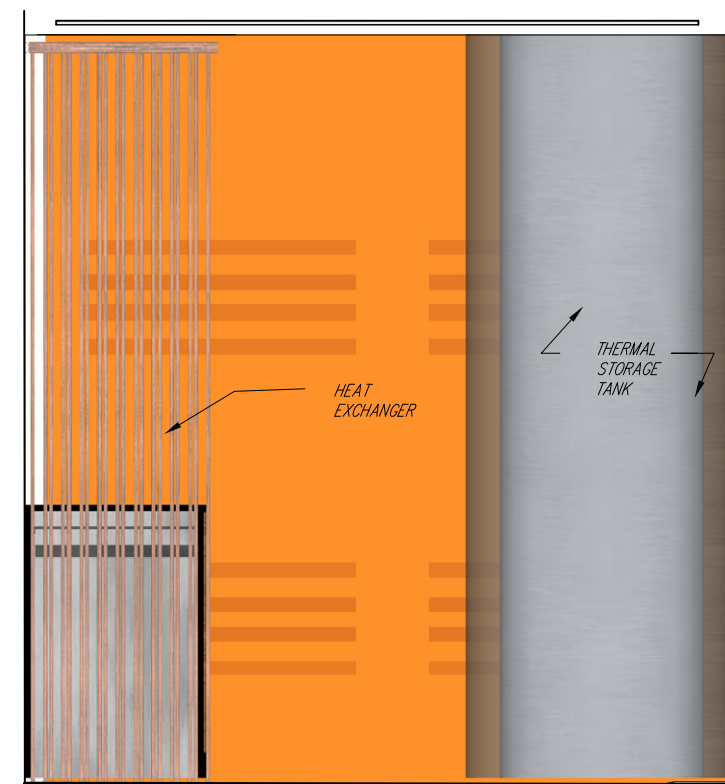

④ MECH. SPACE WEST INTERIOR ELEVATION  $1/2'' = 1'-0''$


Drawn by	Date
S. Hauze	August 7, 2007
Revised	Date

Mech./Bath East/West Int. Elevations	2007 Solar Decathlon
University of Colorado at Boulder	
Civil, Environmental, and Architectural Engineering	
428 UCB, Room ECCE 441	
Boulder, CO 80309-0428	



A4.03



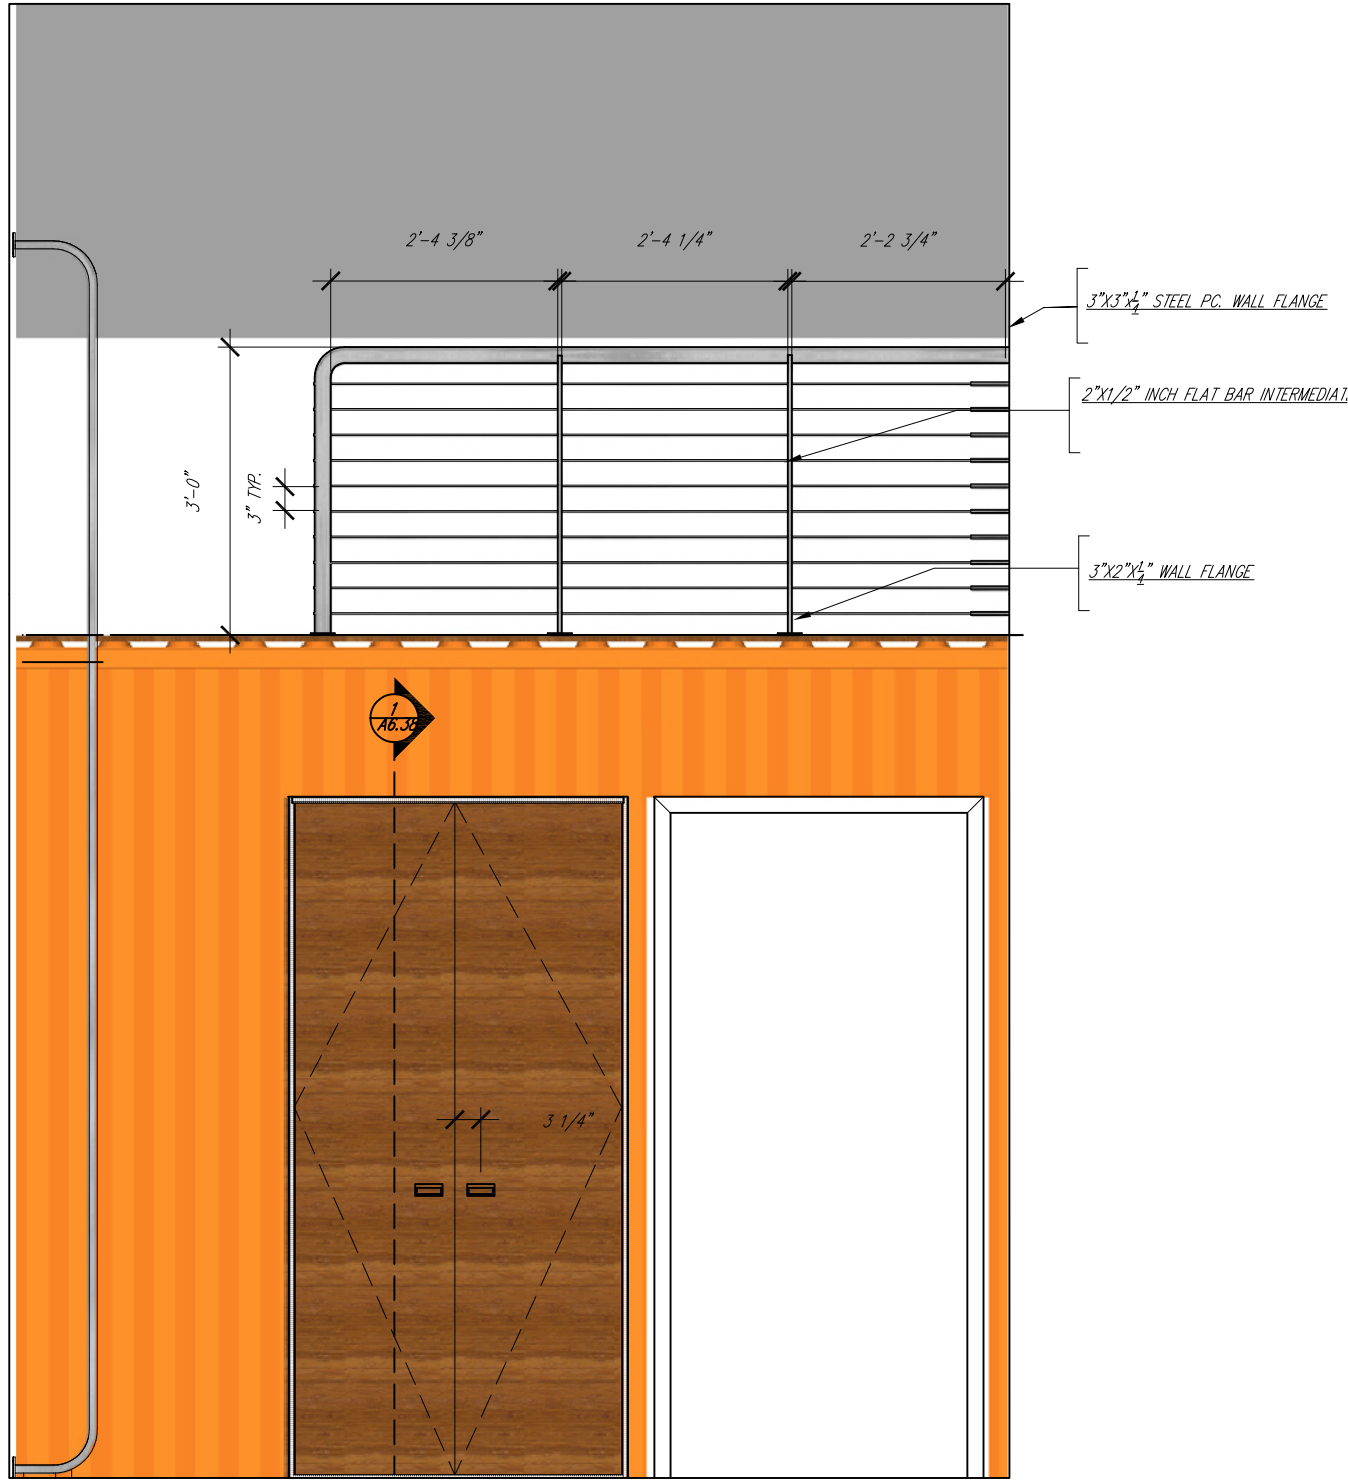

2 BEDROOM SOUTH INTERIOR ELEVATION  
1/2" = 1'-0"

Drawn by	Date
S. Hauze	August 7, 2007
Revised	Date


Bedroom North/South Int. Elevations2007 Solar Decathlon

University of Colorado at Boulder  
Civil, Environmental, and Architectural Engineering  
428 UCB, Room ECCE 441  
Boulder, CO 80309-0428

01'2'4'8"



1 BEDROOM/LOFT EAST INTERIOR ELEVATION  
1/2" = 1'-0"

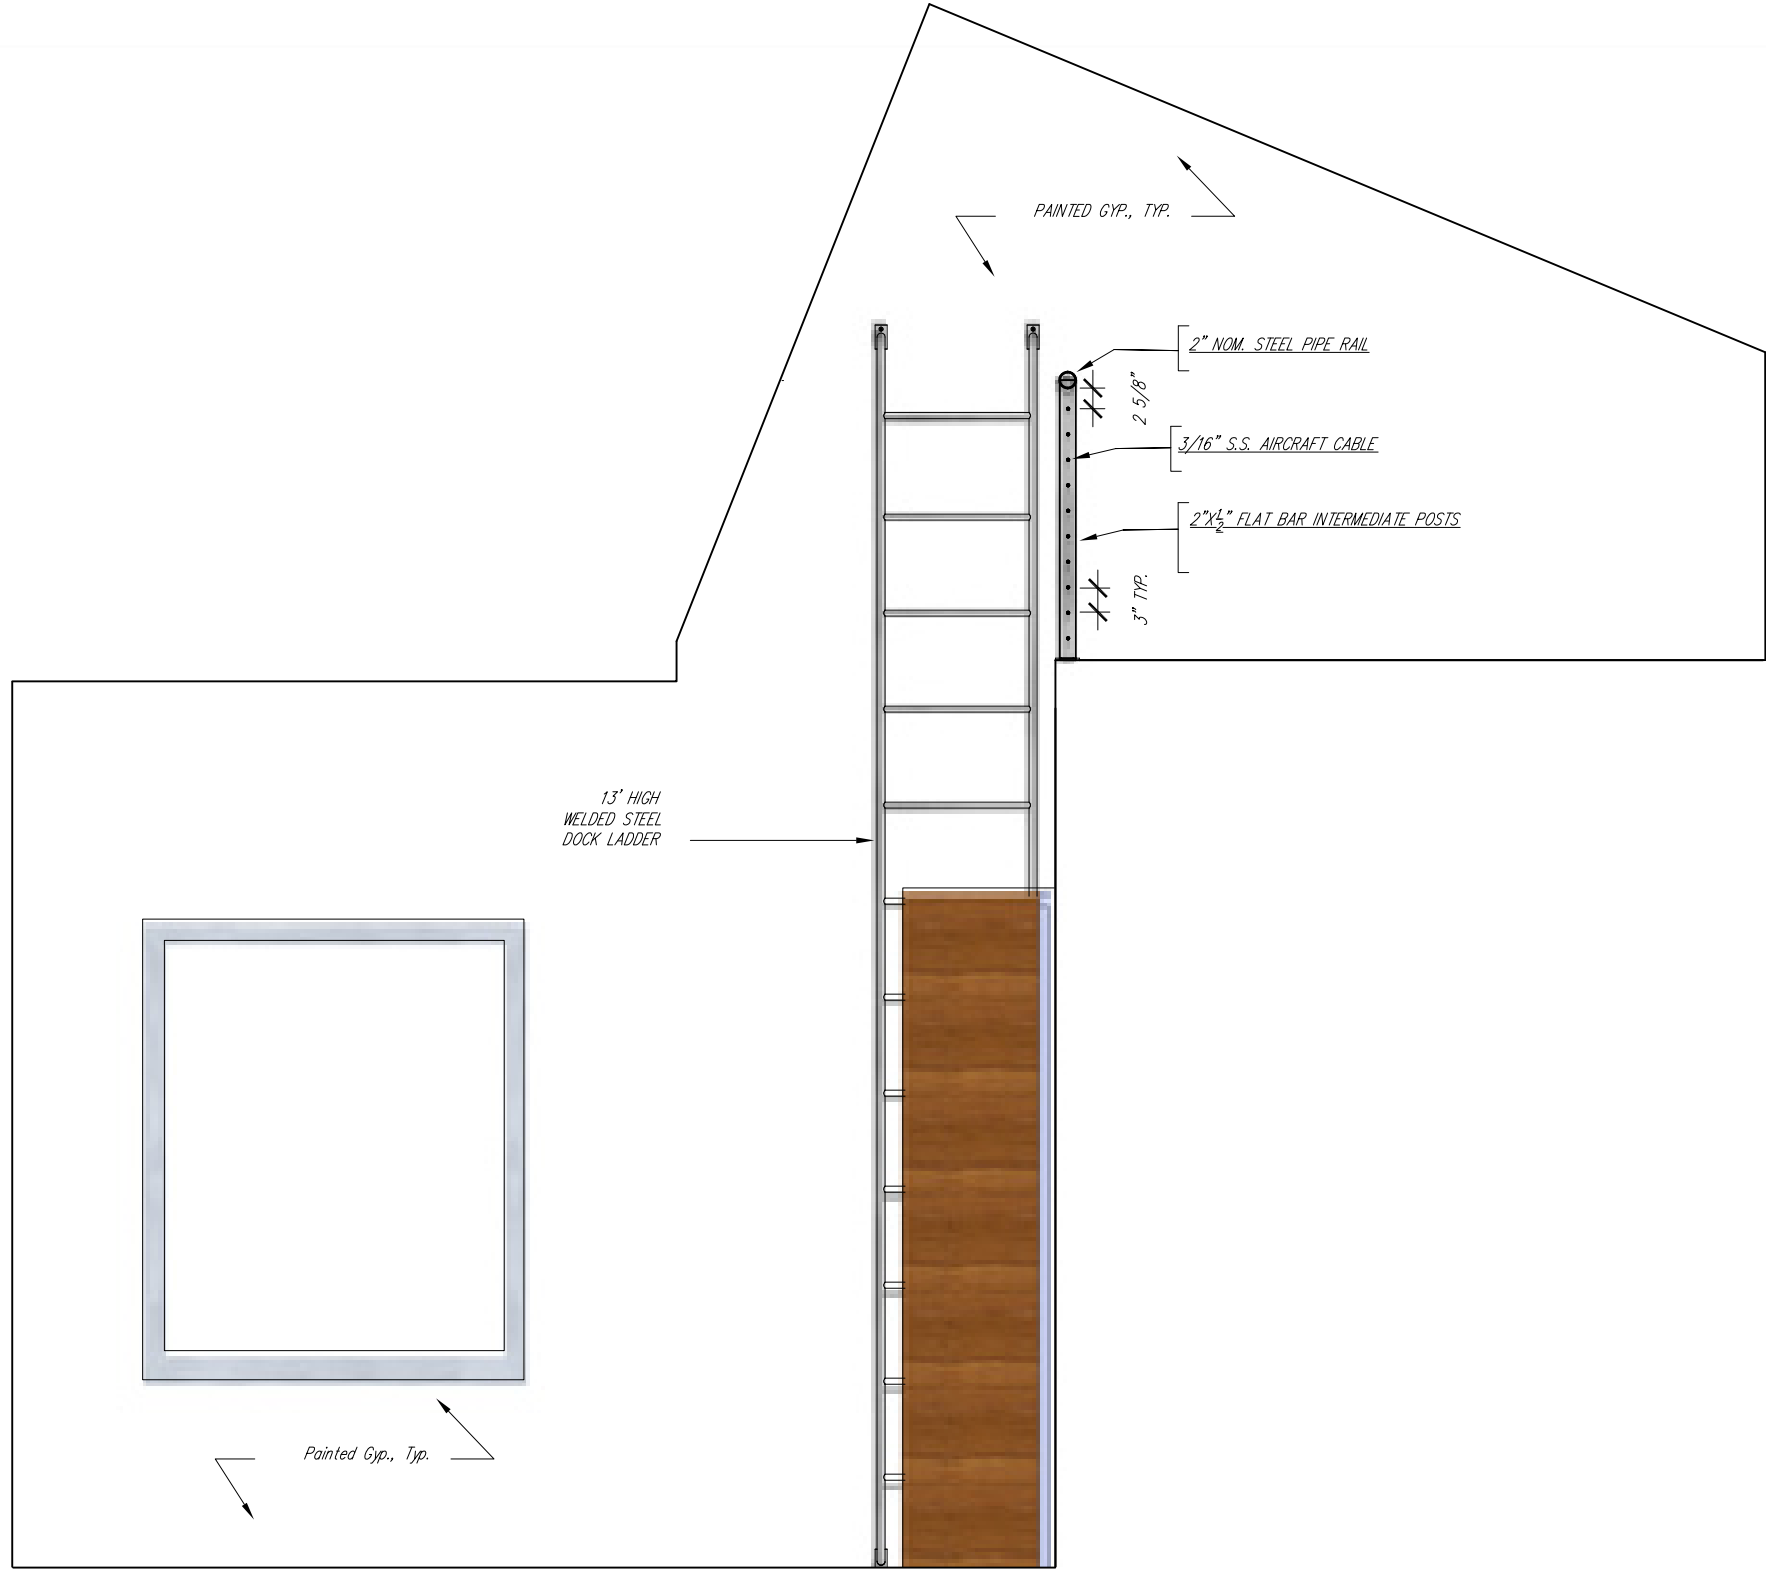

Bedroom East Int. Elevation


2007 Solar Decathlon

University of Colorado at Boulder  
Civil, Environmental, and Architectural Engineering  
428 UCB, Room ECCE 441  
Boulder, CO 80309-0428




A4.05

Drawn by	Date
S.Hauze	August 7, 2007
Revised	Date

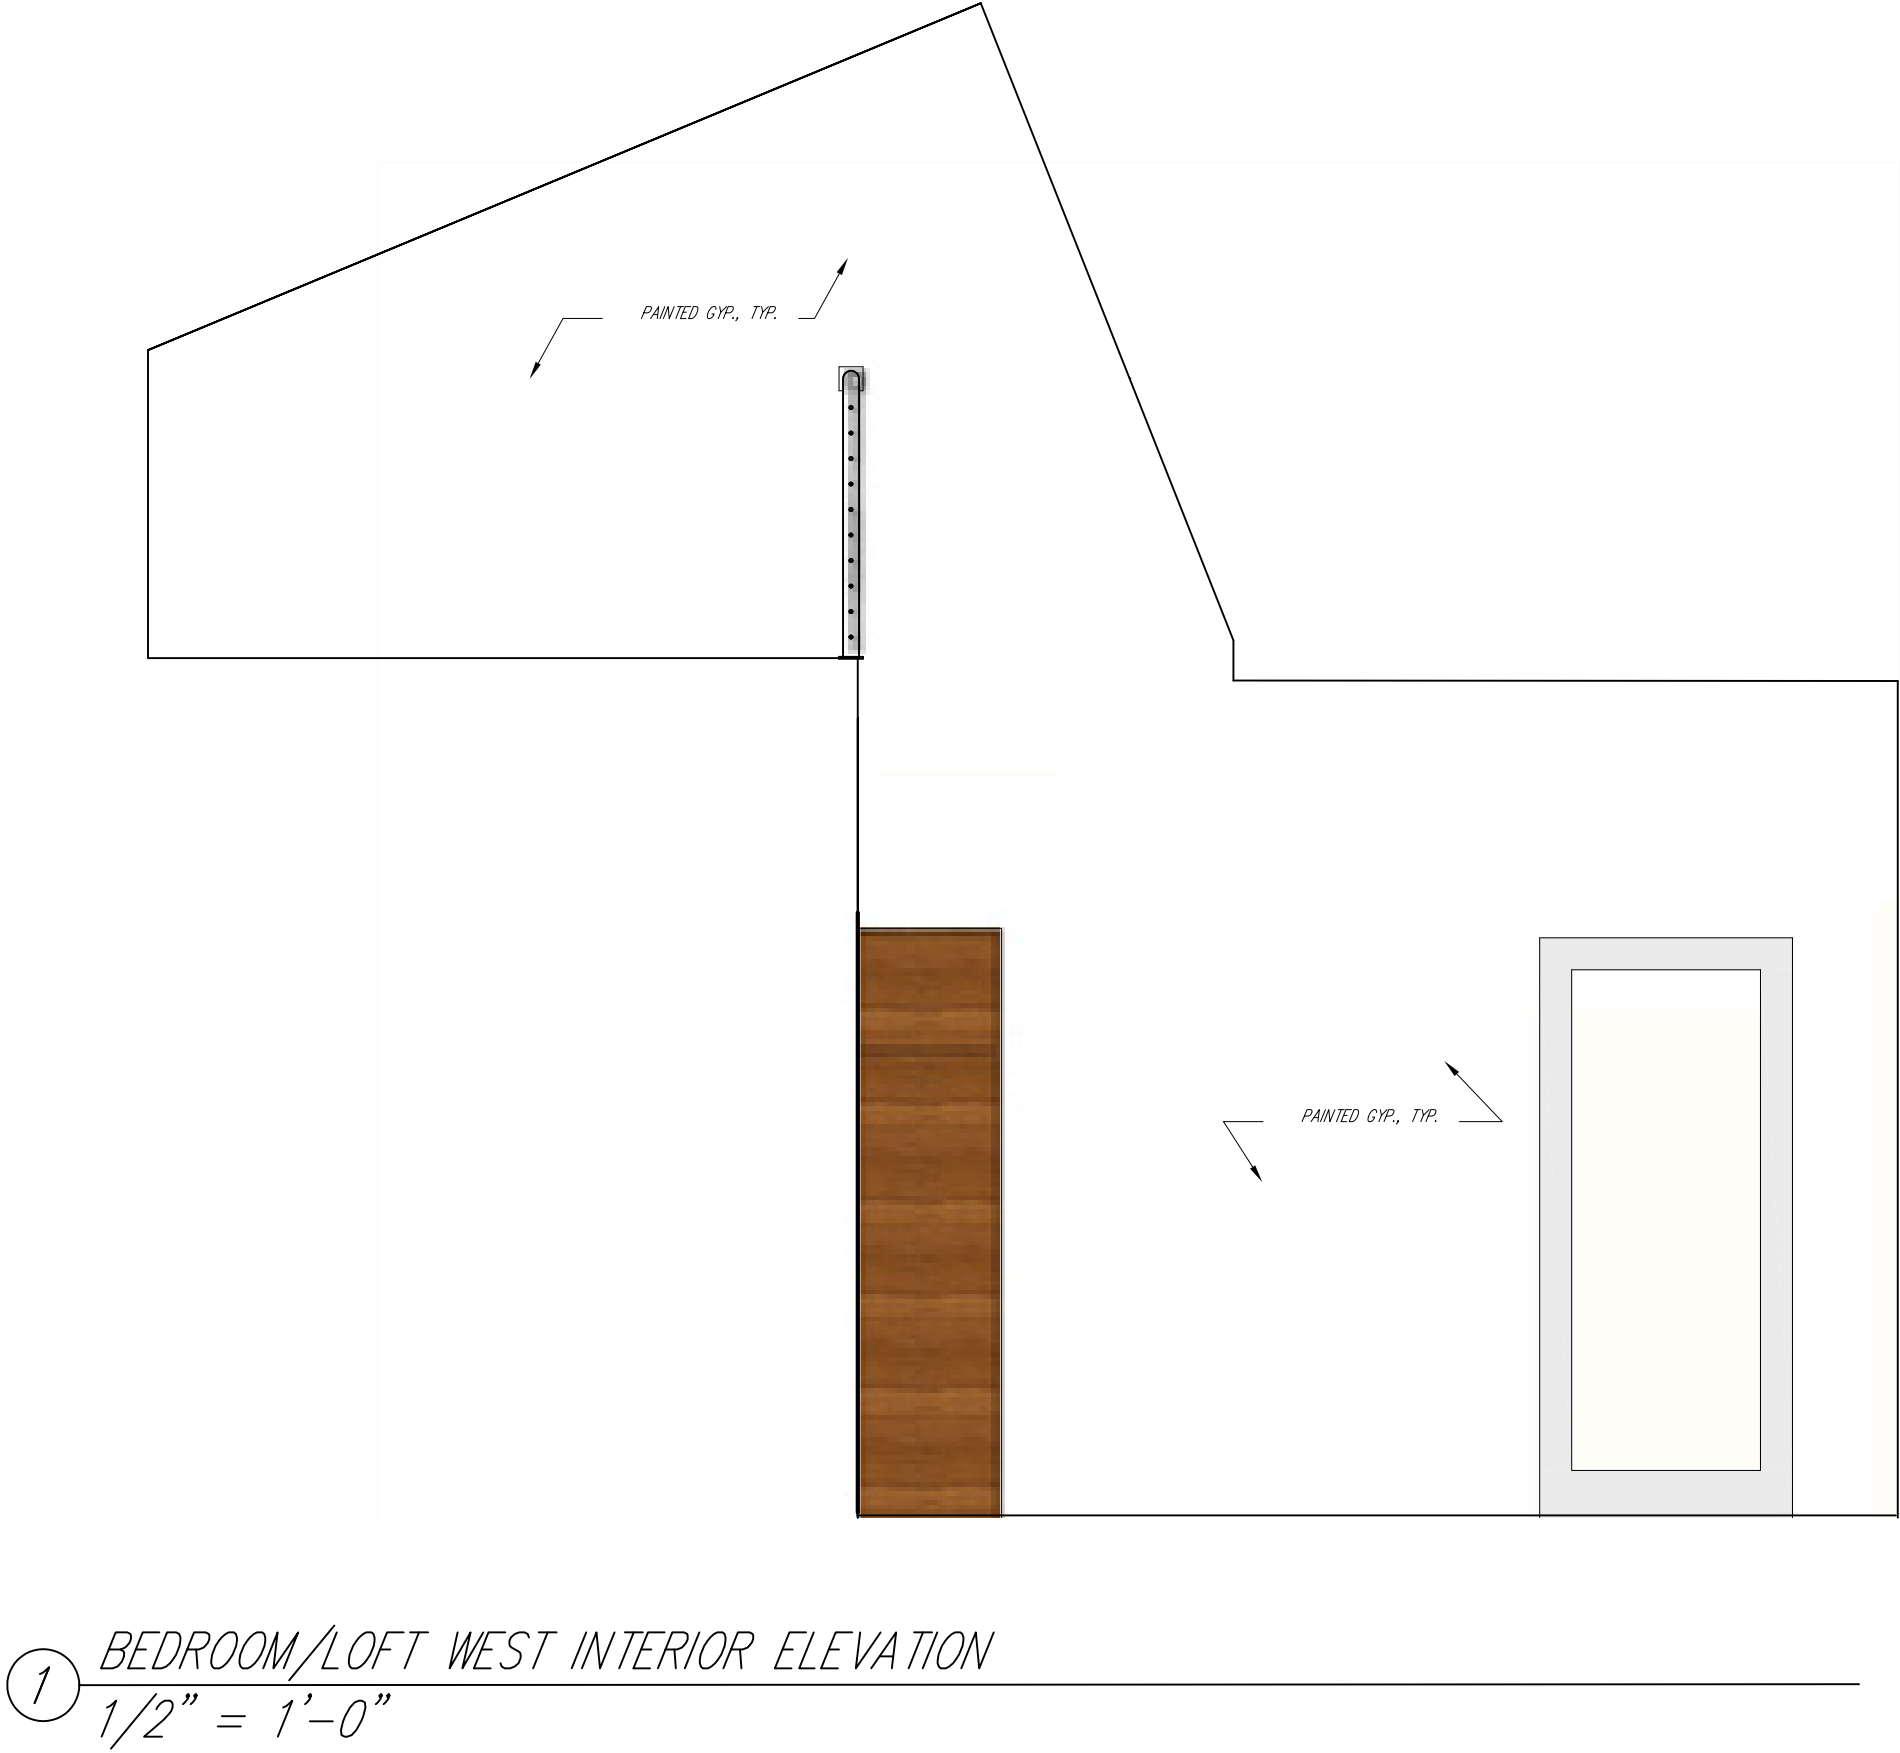

Drawn by	Date
S. Hauze	August 7, 2007
Revised	Date

1 LIVING NORTH INTERIOR ELEVATION  
1/2" = 1'-0"

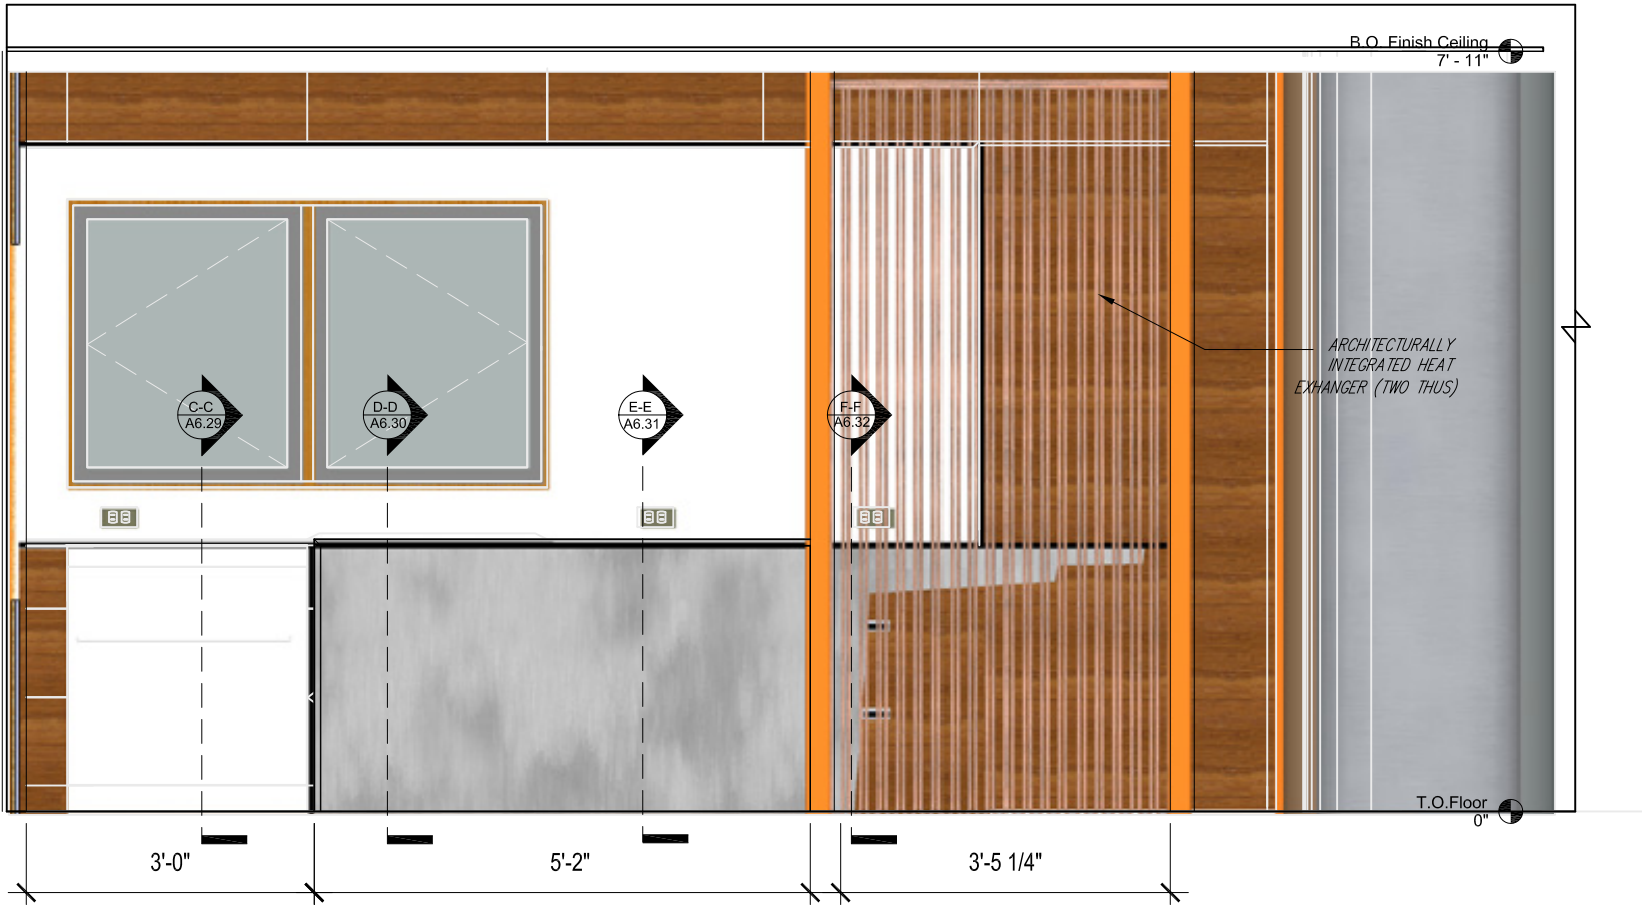

A4.07

Living North Int. Elevation


0 1' 2' 4' 8'

2007 Solar Decathlon

University of Colorado at Boulder  
Civil, Environmental, and Architectural Engineering  
428 UCB, Room ECCE 441  
Boulder, CO 80309-0428

Drawn by	Date
S. Hauze	August 7, 2007
Revised	Date

① *LIVING SOUTH INTERIOR ELEVATION*  
*1/2" = 1'-0"*

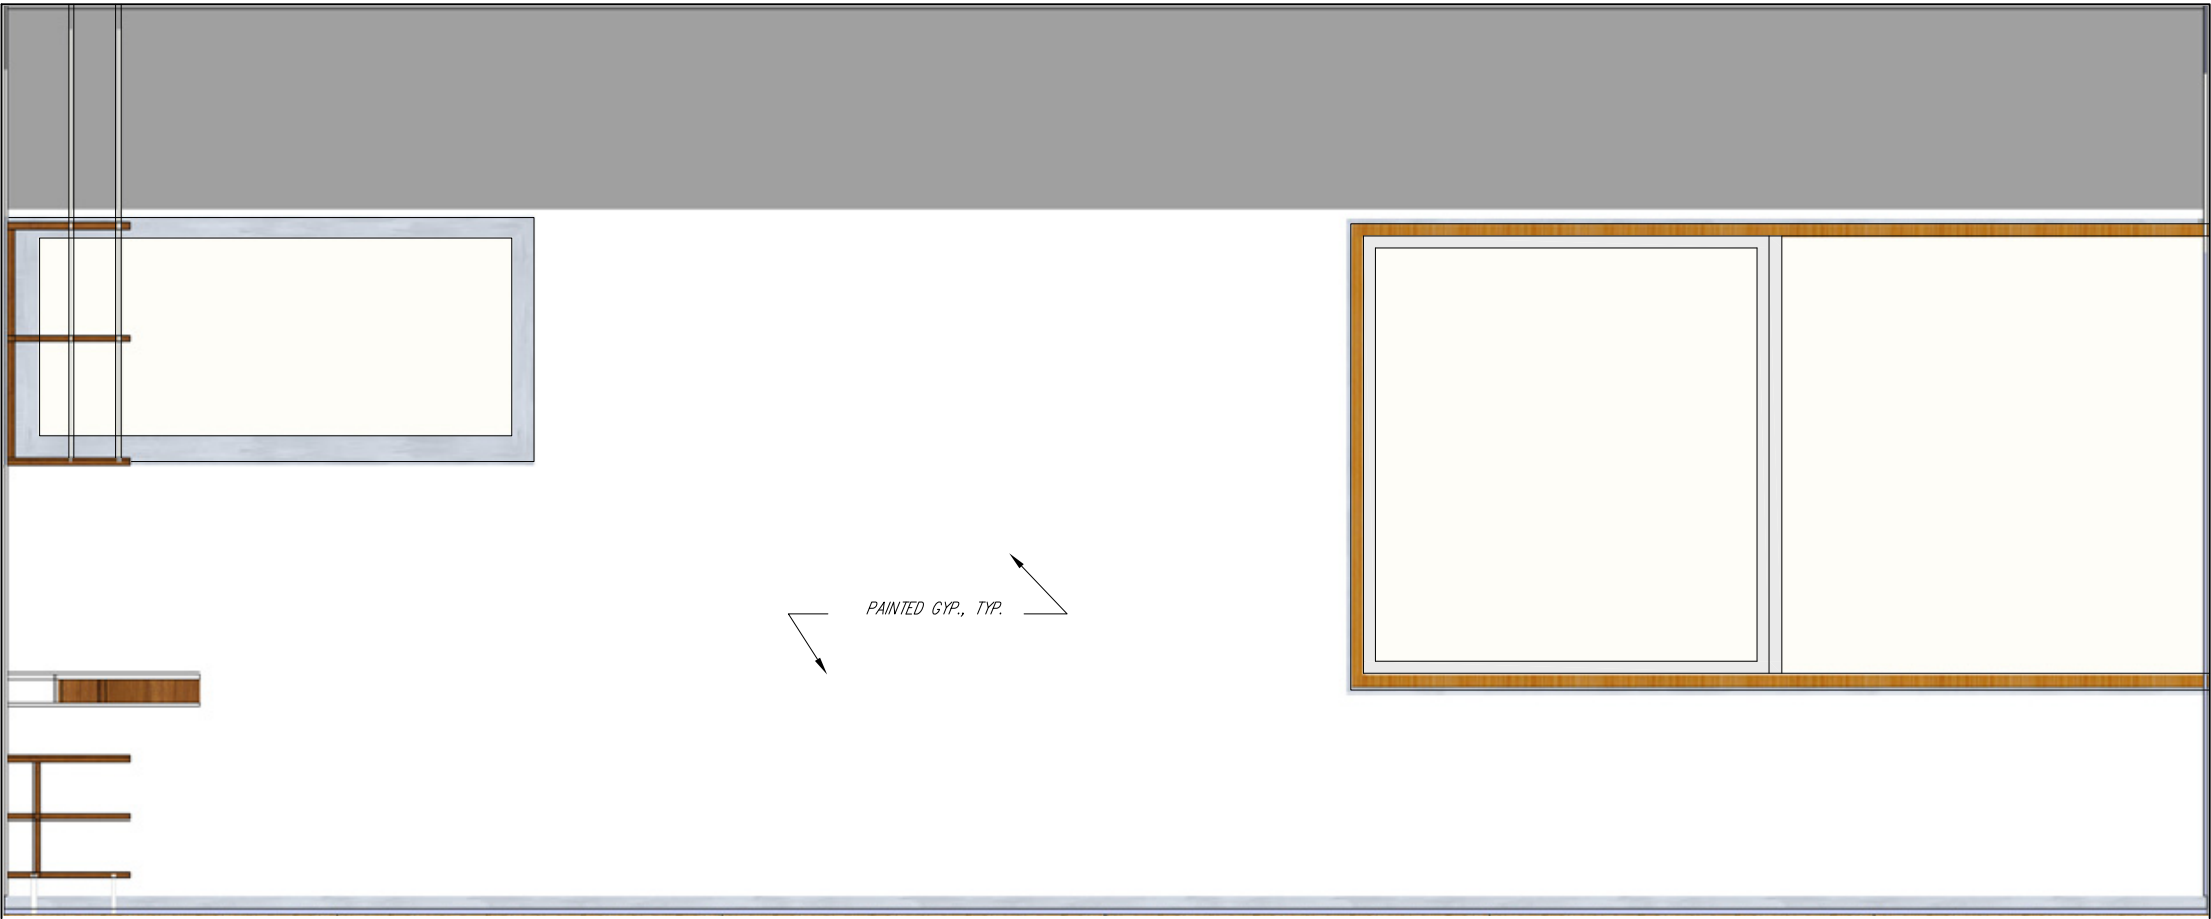

A4.08

Living South Int. Elevation

0 1' 2' 4' 8'


2007 Solar Decathlon

University of Colorado at Boulder


Civil, Environmental, and Architectural Engineering  
428 UCB, Room ECCE 441  
Boulder, CO 80309-0428

Drawn by	Date
S. Hauze	August 7, 2007
Revised	Date



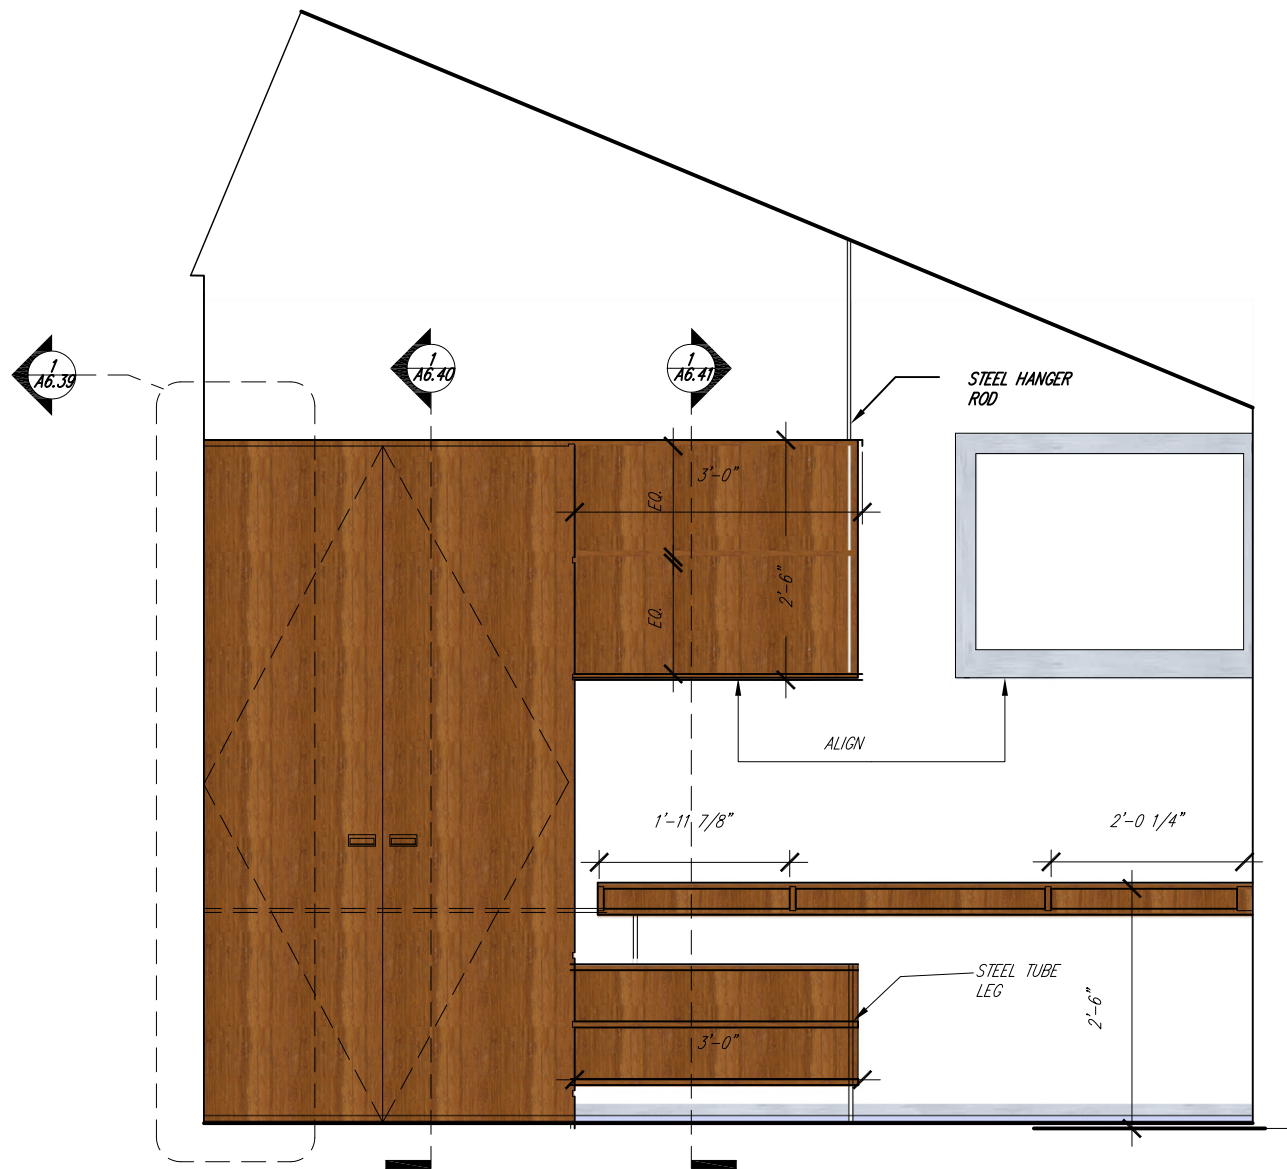

① LIVING EAST INTERIOR ELEVATION  
 $1/2'' = 1'-0''$

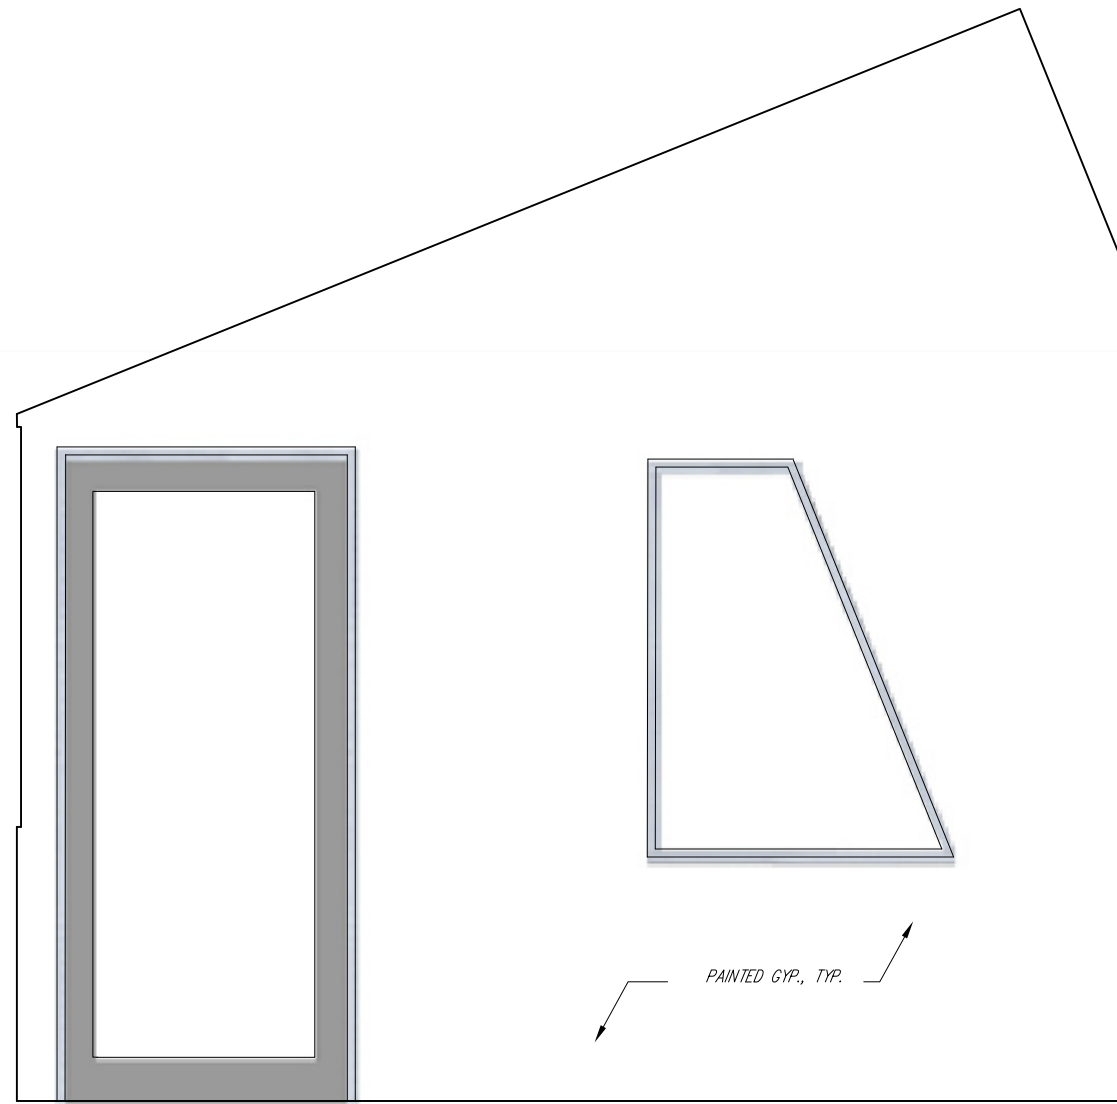


② LIVING WEST INTERIOR ELEVATION  
 $1/2'' = 1'-0''$

Drawn by	Date
S.Hauze	August 7, 2007
Revised	Date


Living East/West Int. Elevation	2007 Solar Decathlon
University of Colorado at Boulder	
Civil, Environmental, and Architectural Engineering	
428 UCB, Room ECCE 441	
Boulder, CO 80309-0428	



A4.09

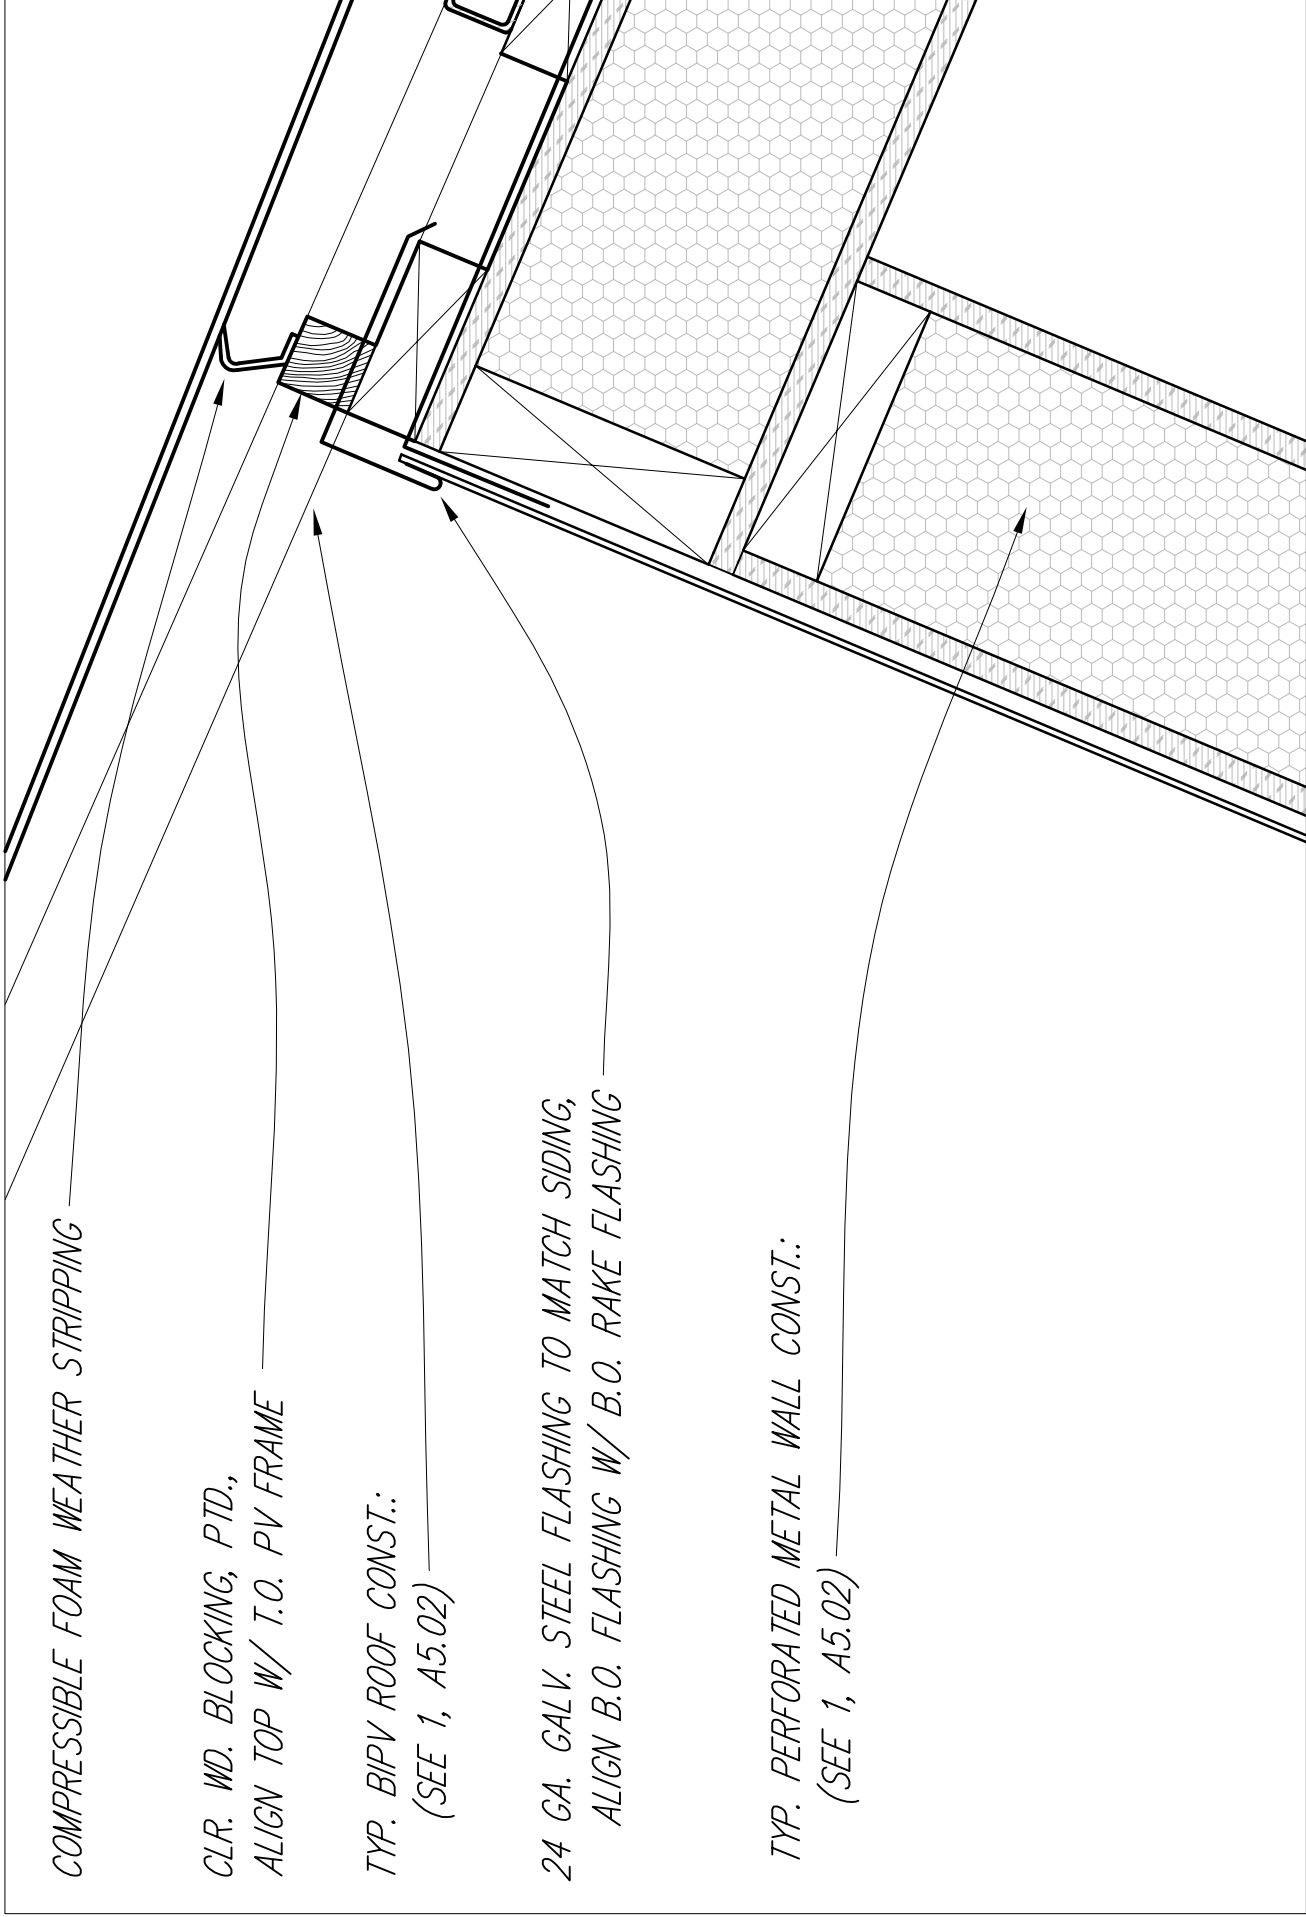

1 HIGH EAVE SECTION: PERF. METAL/METAL SHINGLE SIP WALL TO BIPV ROOF  
3" - 1'-0"

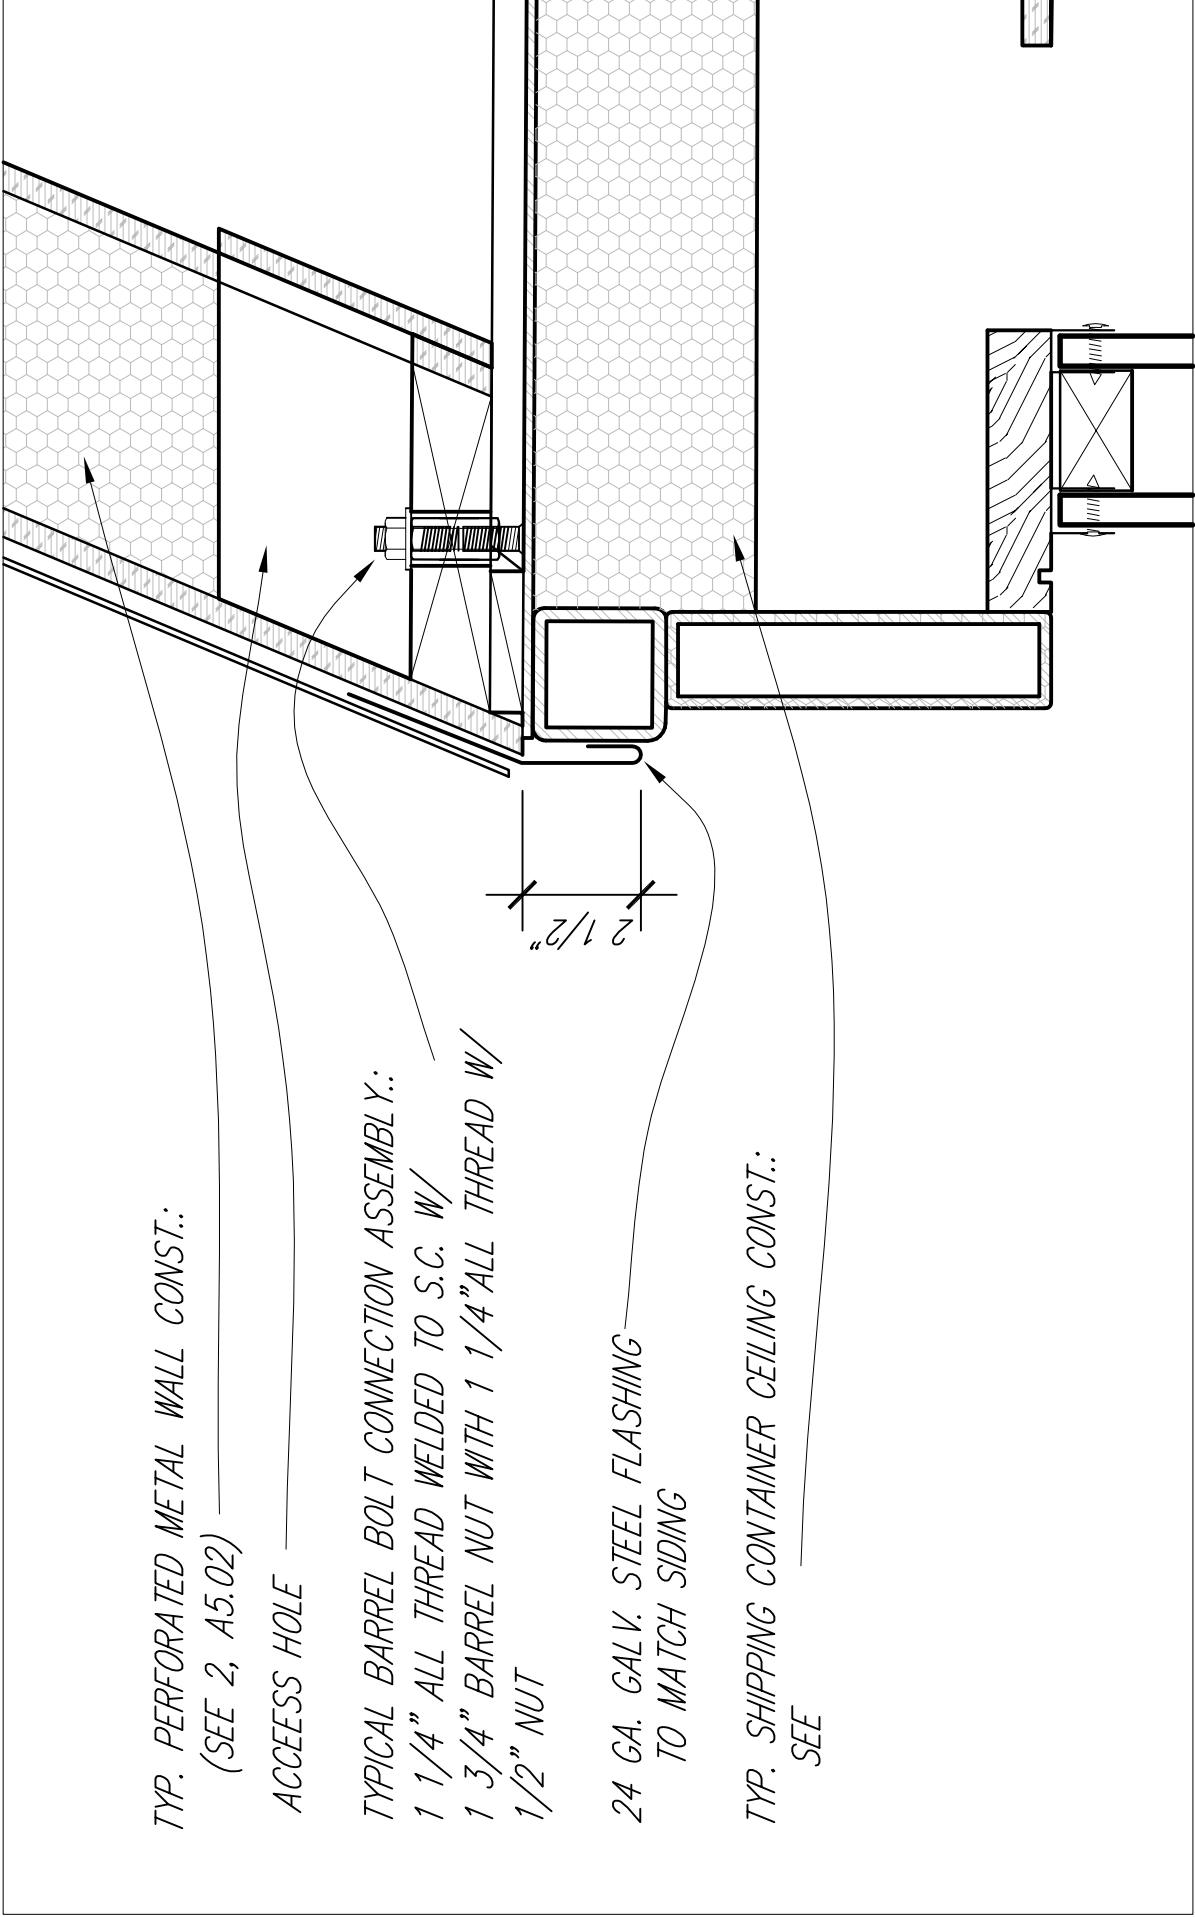


2 CONNECTION: PERFORATED METAL SIP WALL TO SHIPPING CONTAINER ROOF  
3" - 1'-0"








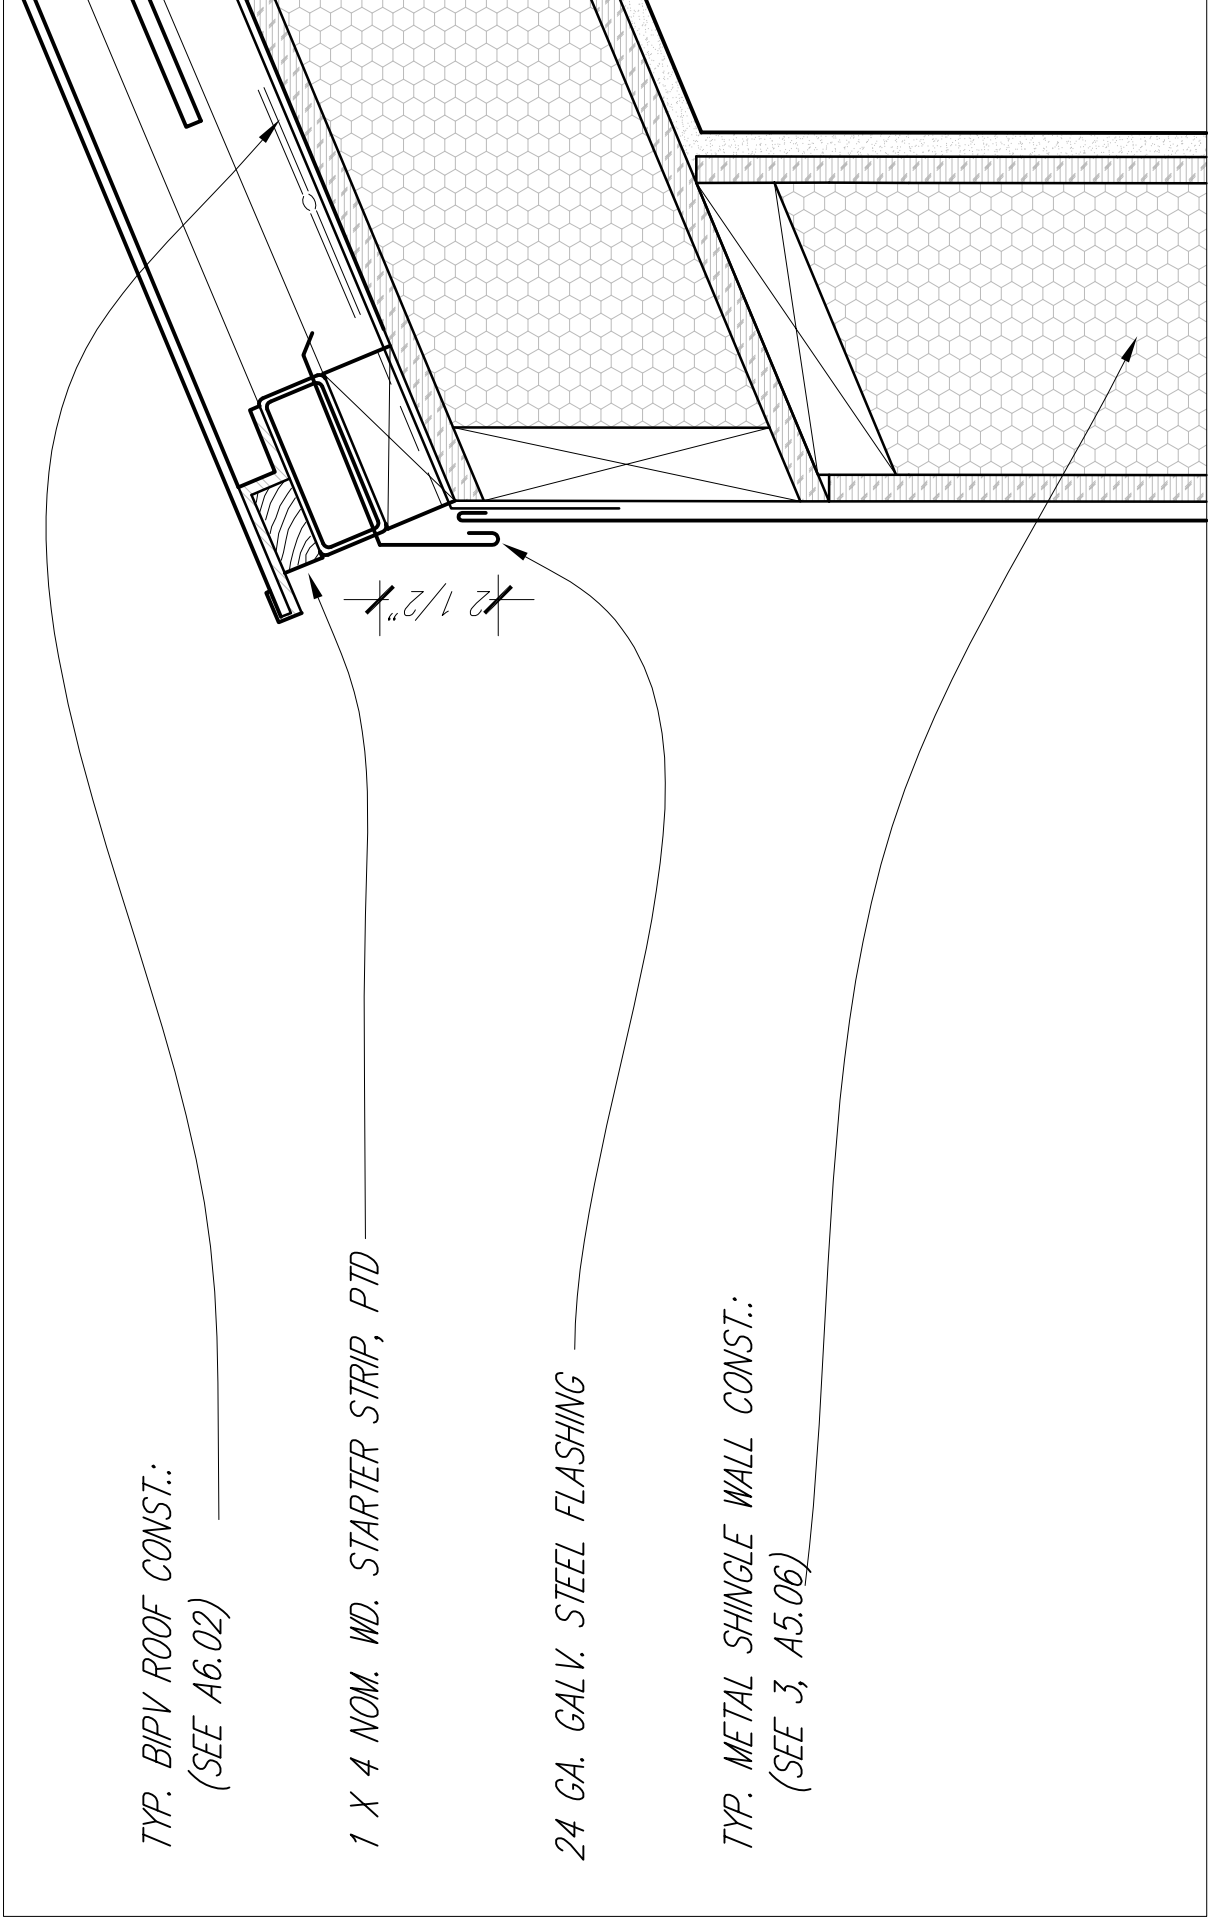

1 LOW EAVE SECTION: METAL SHINGLE SIP WALL TO BIPV ROOF

3" - 1'-0"

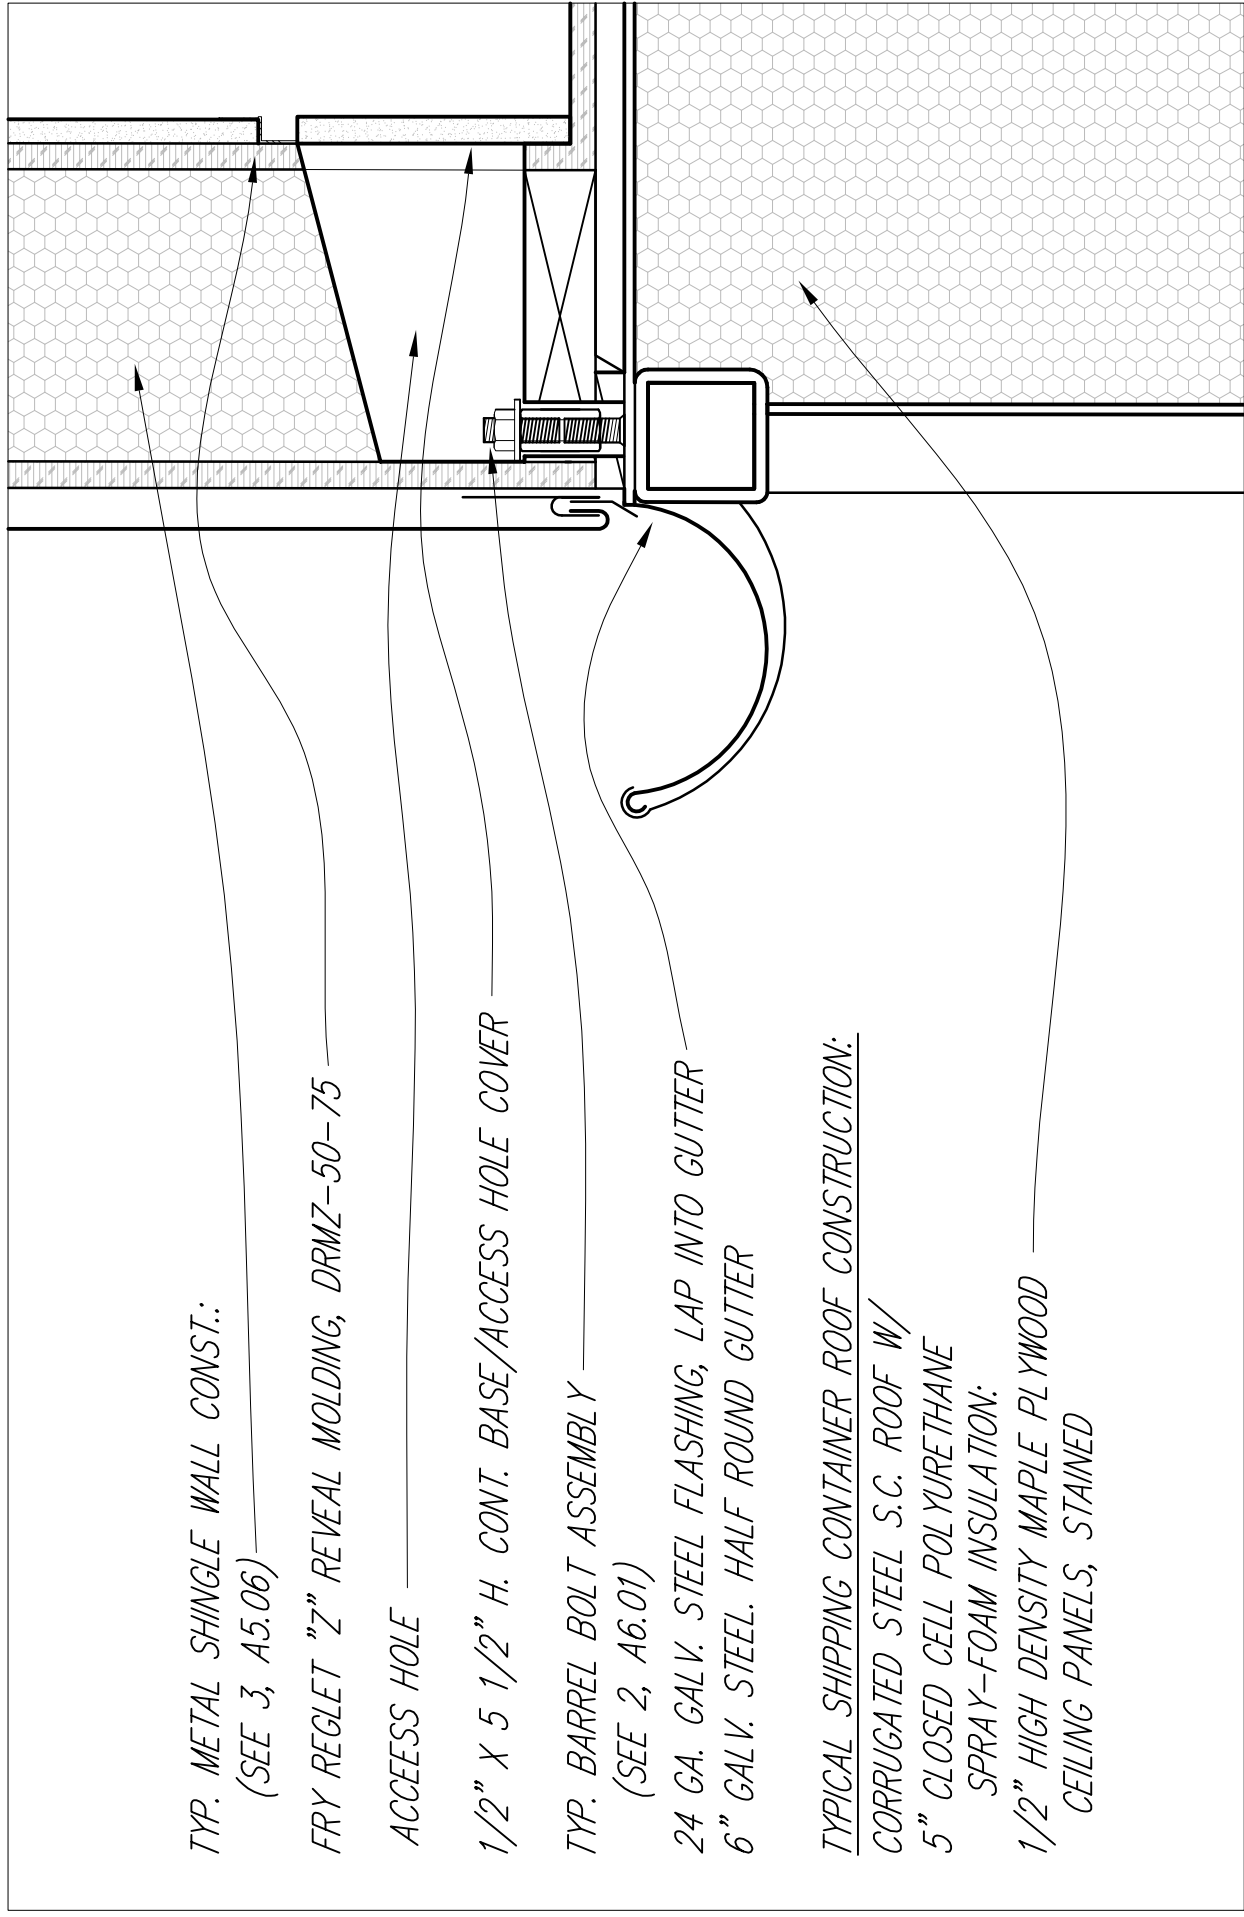

2 SIDEWALL CONNECTION: METAL SHINGLE SIP WALL TO SHIPPING CONTAINER ROOF

3" - 1'-0"



Drawn by	Date
N. Sanders	August 7, 2007
Revised	Date
N. Sanders	January 9, 2008

TYP. BIPV ROOF CONST.:  
(SEE 1, A5.02)

COMPRESSIBLE FOAM WEATHER STRIPPING

CLR. WD. BLOCKING, PTD.

ALIGN TOP W/ T.O. PV FRAME

5/8" TH. INTERMITTENT BLOCKING

24 GA. GALV. STEEL FLASHING ALIGN BOT. W/  
B.O. LOW EAVE FLASHING

2 X 6 NOM. TRANS. BATTEN, V-NOTCHED  
@ 12" O.C. FOR RAINSCREEN VENT

TYP. RAINSCREEN WALL CONSTRUCTION:  
(SEE 1, A5.06)

1 RAKE CONNECTION: RAINSCREEN SIP WALL TO BIPV ROOF

3" - 1'-0"

TYP. LOW SLOPE ROOF CONSTRUCTION:  
SINGLE PLY, FULLY ADHERED, MEMBRANE ROOFING ON  
SLIP SHEET OR COVER-BOARD AS REQ. ON  
6 5/8" SIP WALL PANEL:  
1/2" G.W.B. INTERIOR FINISH (LEVEL 5)


24 GA. GALV. STEEL EAVE FLASHING

TYP. RAINSCREEN WALL CONST.:  
(SEE 1, A5.06)

2 EAVE/RAKE: RAINSCREEN SIP WALL TO LOW SLOPE SIP ROOF


3" - 1'-0"



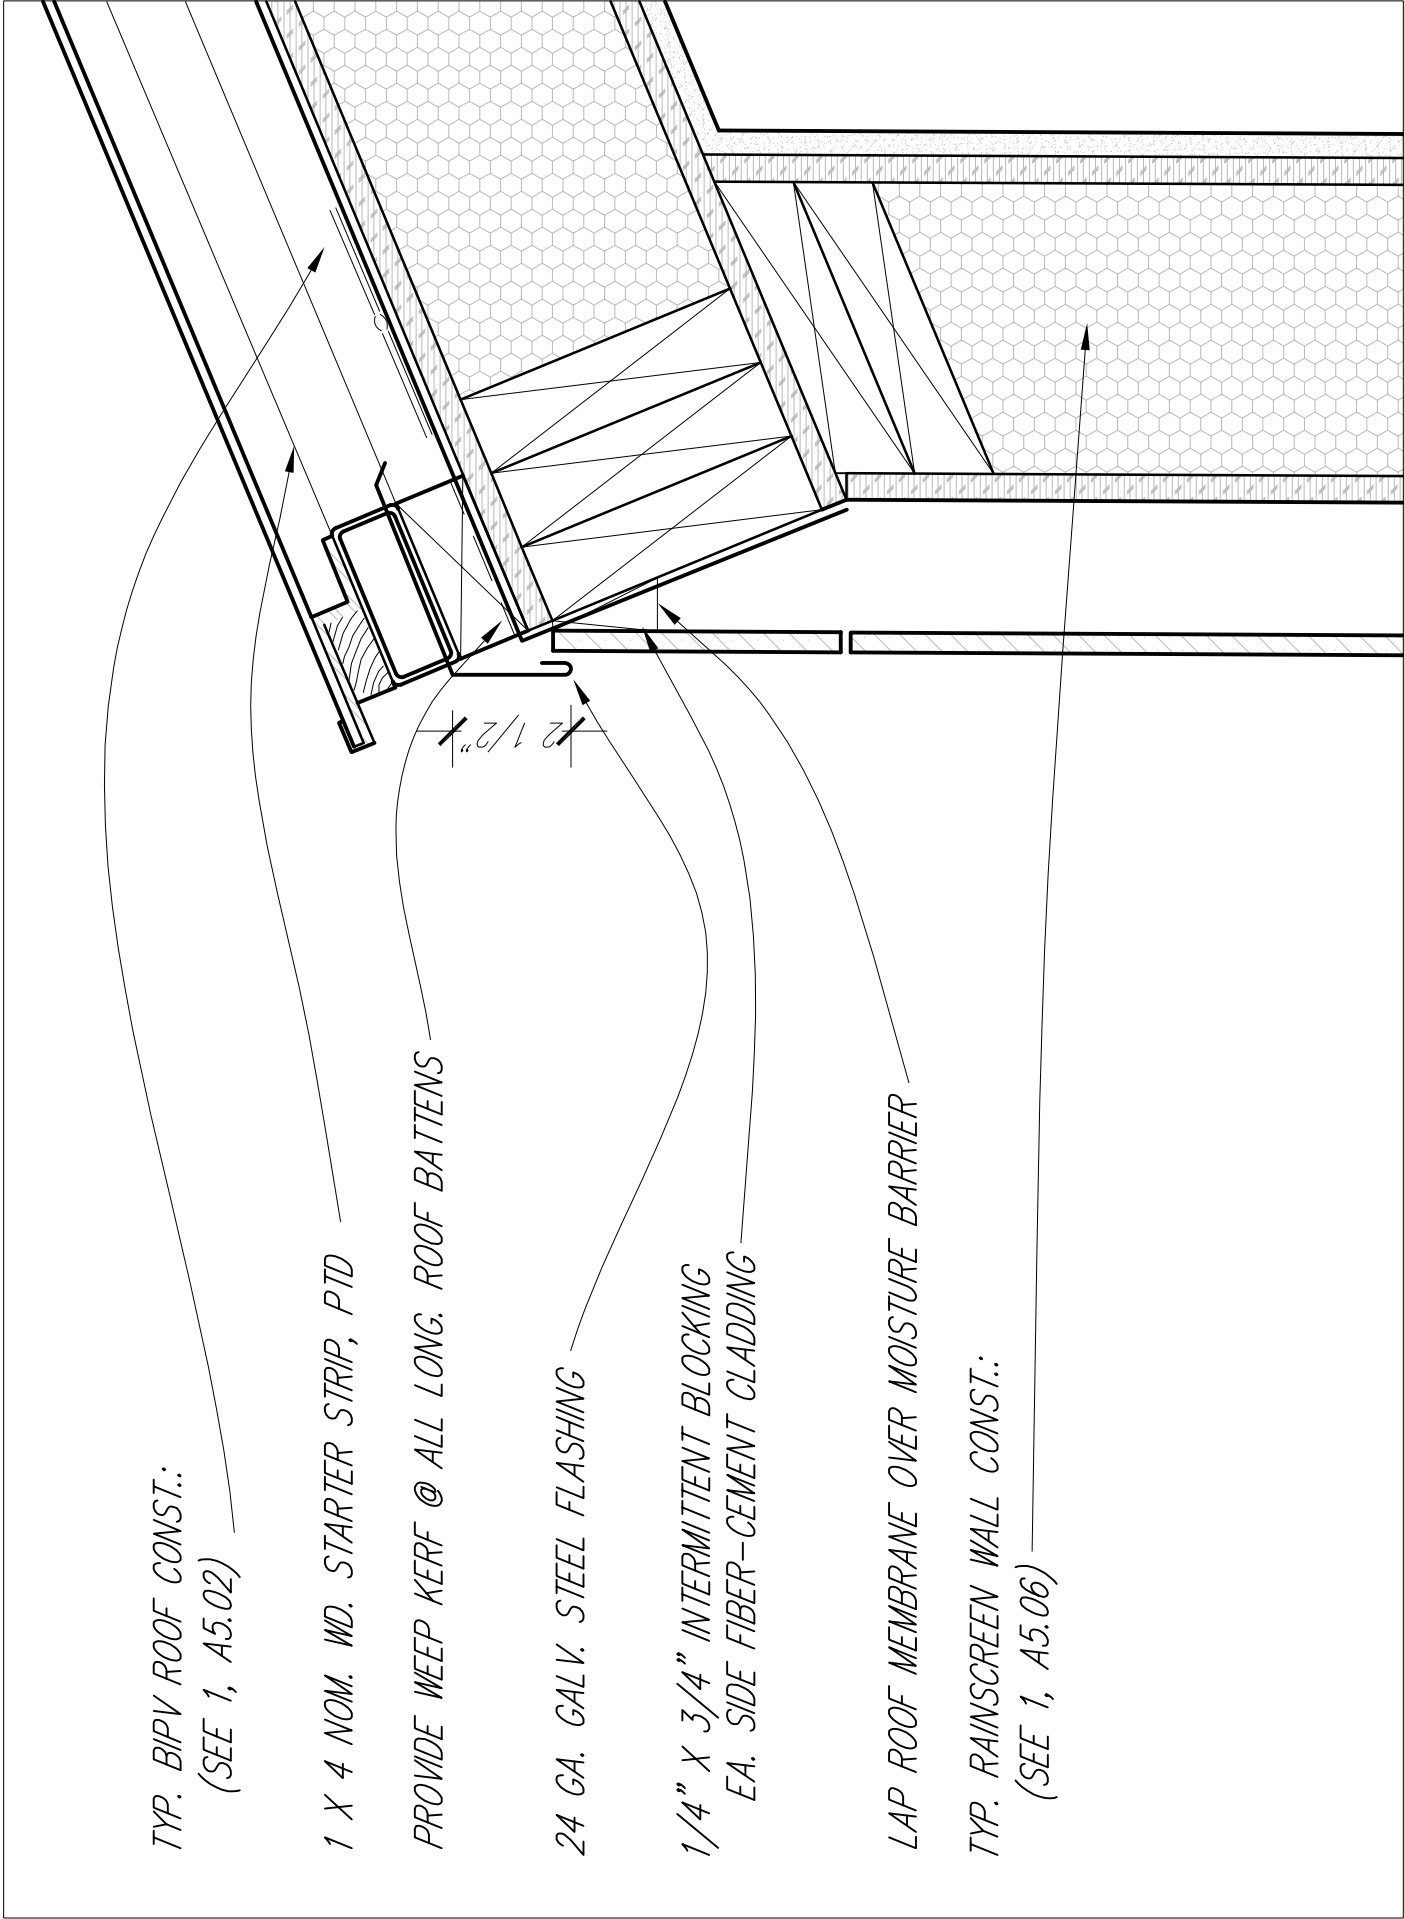

1 LOW EAVE: RAINSCREEN SIP WALL TO BIPV ROOF

3" - 1'-0"

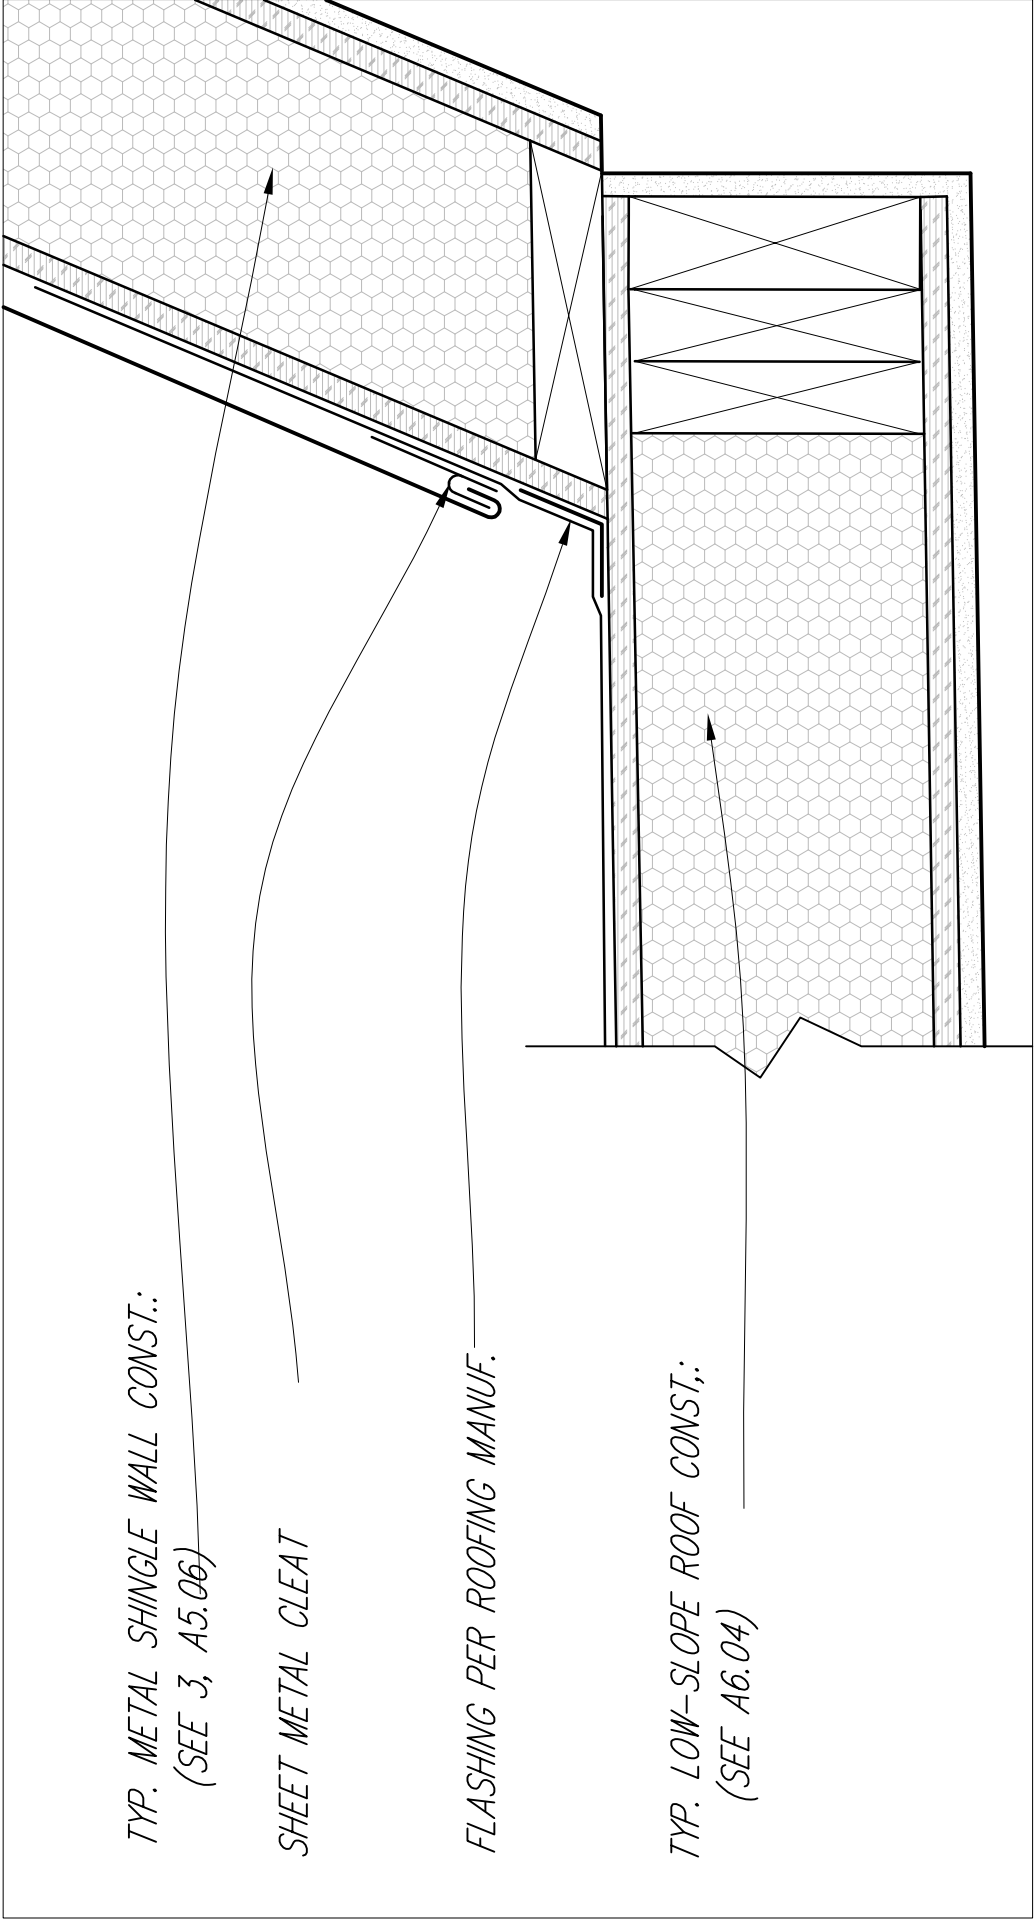


2 SIDEWALL CONNECTION: METAL SHINGLE SIP WALL TO LOW-SLOPE SIP ROOF


3" - 1'-0"






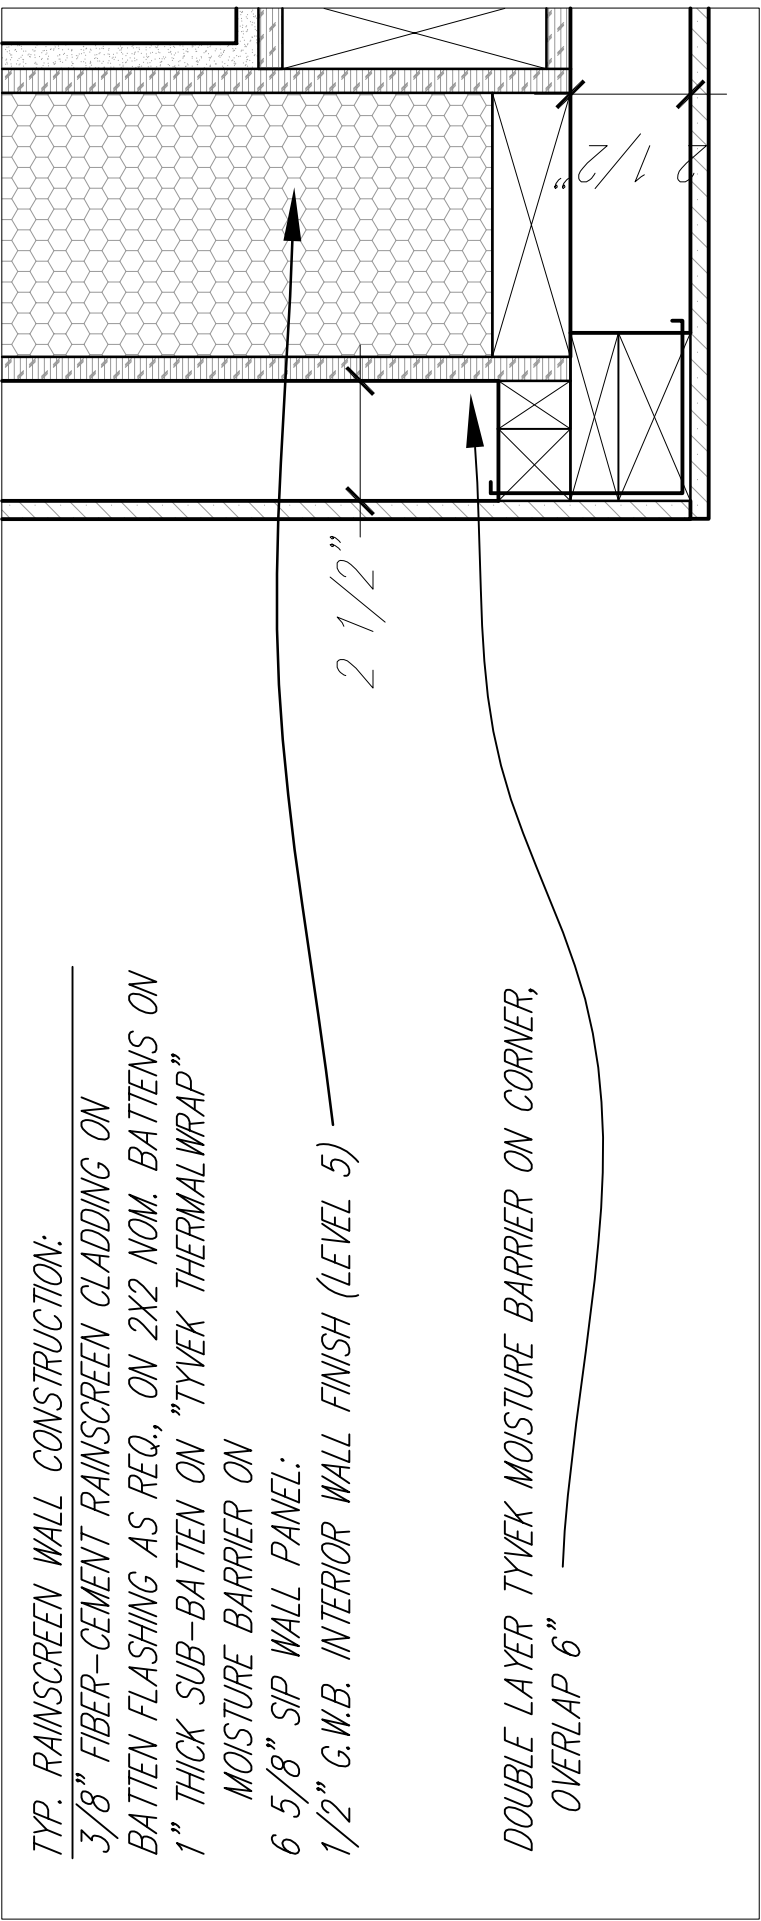

1 HORIZONTAL SECTION: RAINSCREEN SIP WALL CORNER

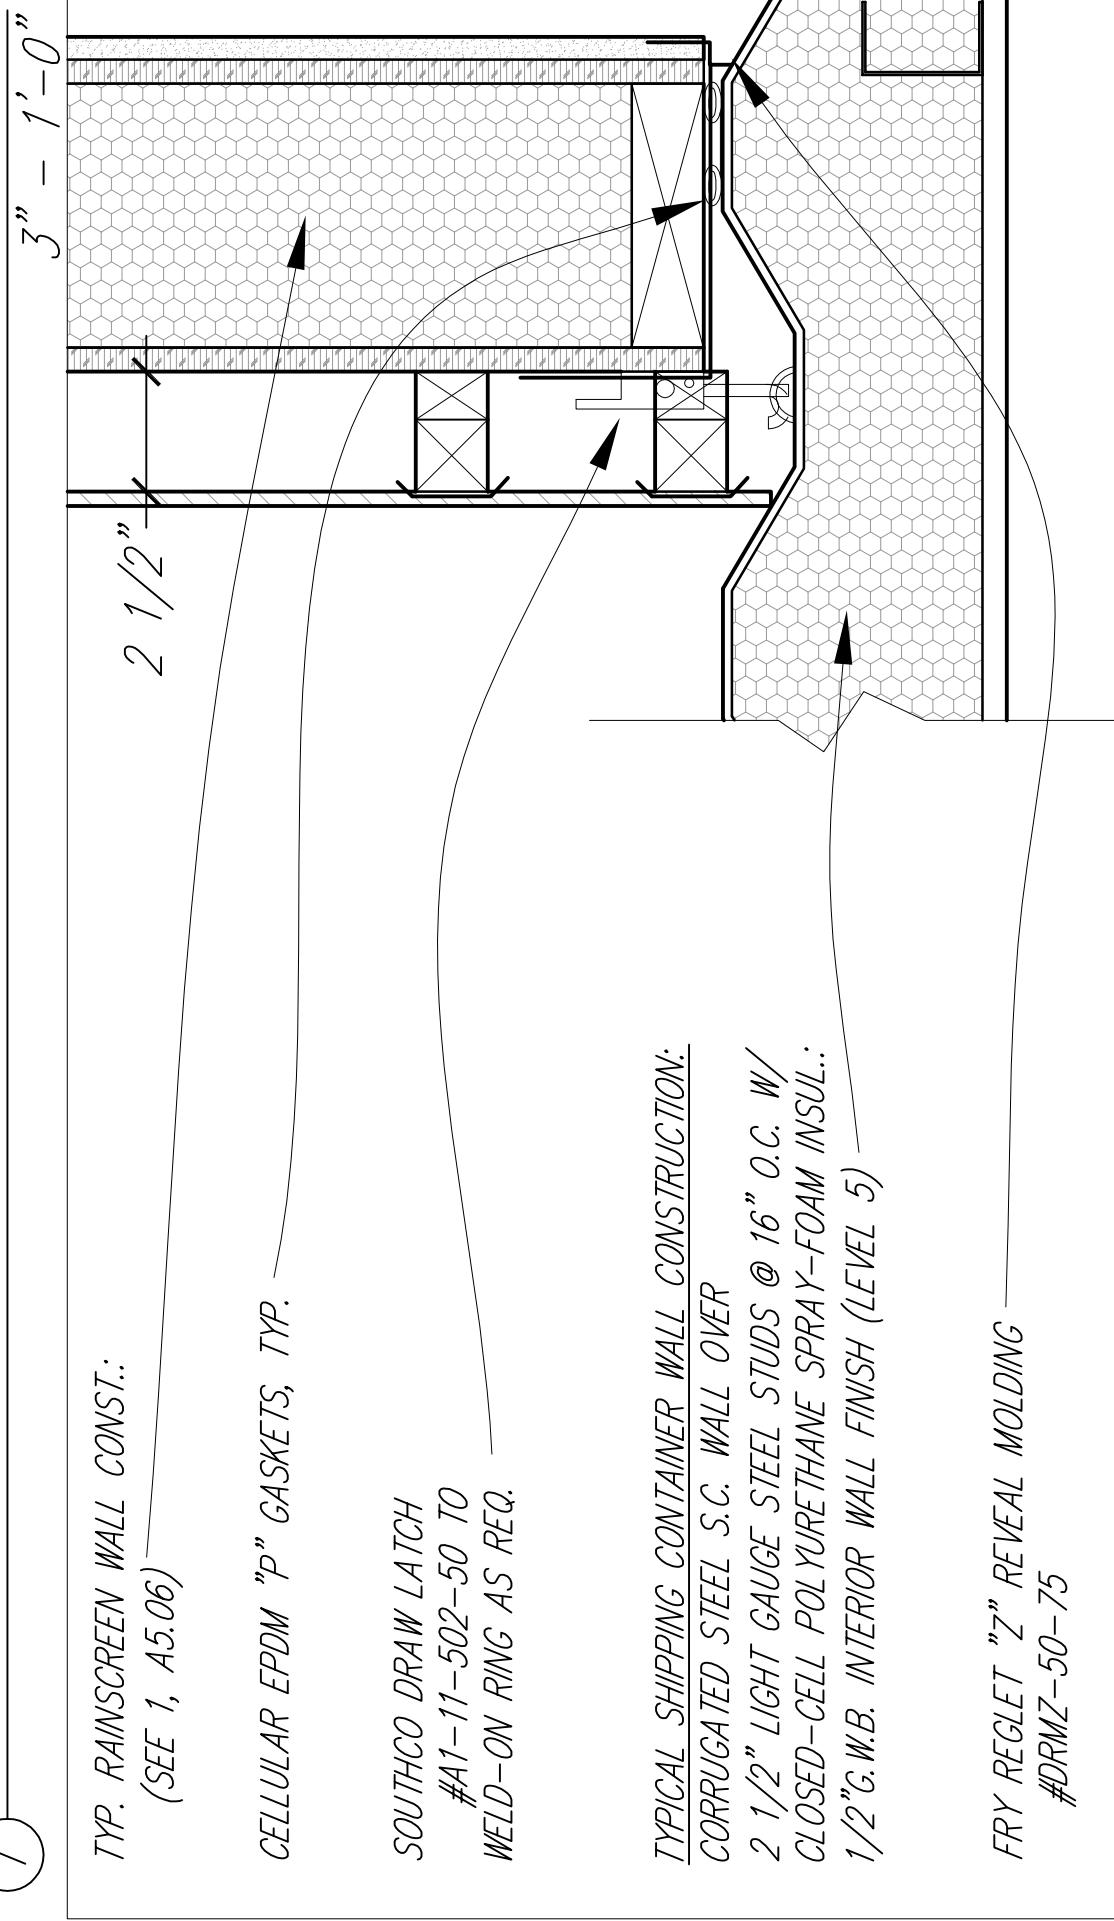


2 HORIZONTAL CONNECTION: RAINSCREEN SIP WALL TO CONTAINER

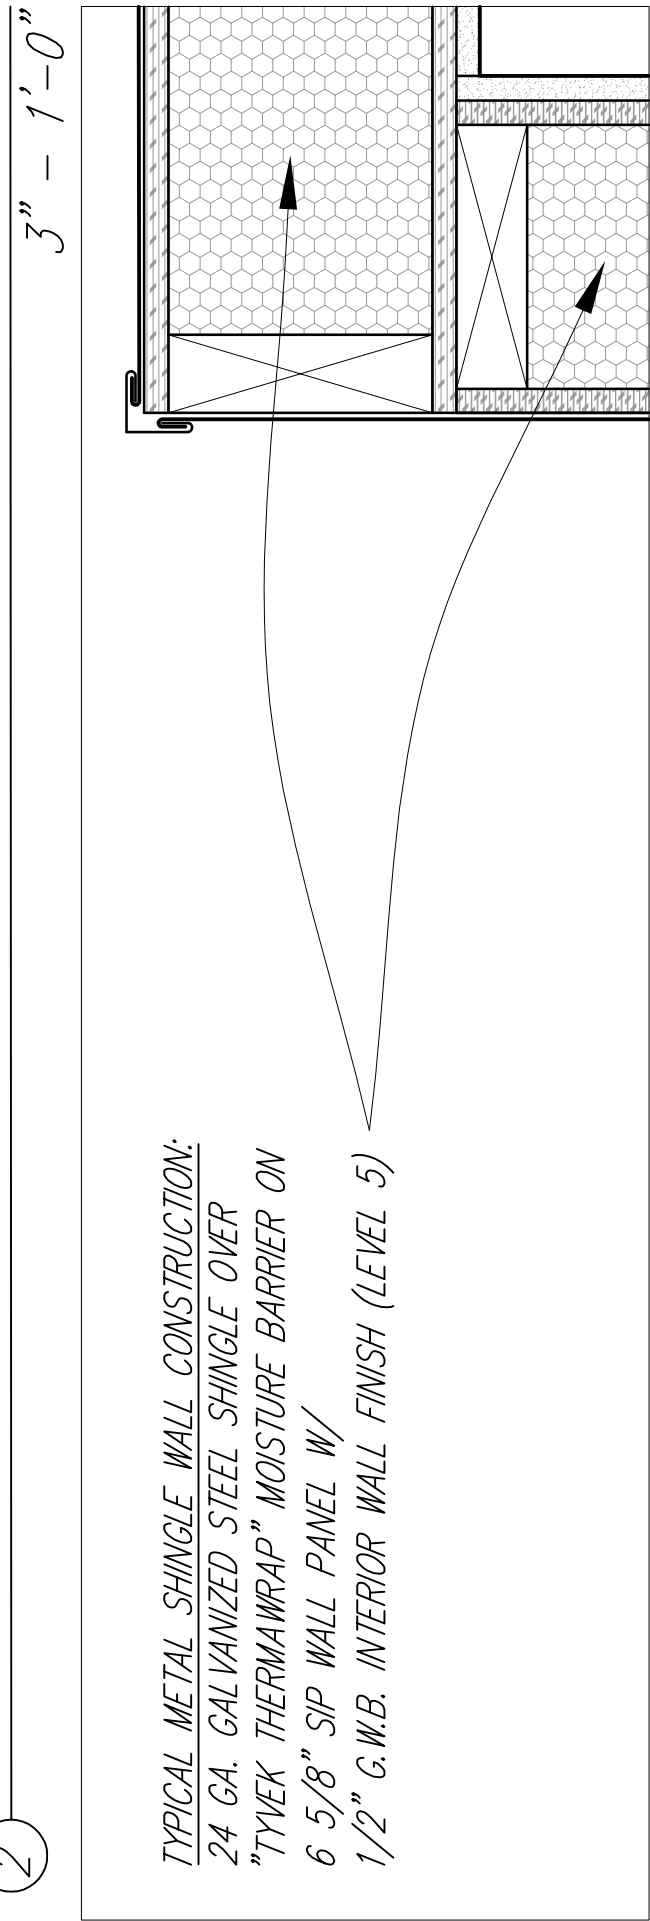


3 HORIZONTAL SECTION: METAL SHINGLE SIDING CORNER




Drawn by	Date
N. Sanders	August 7, 2007
Revised	Date
N. Sanders	January 9, 2008

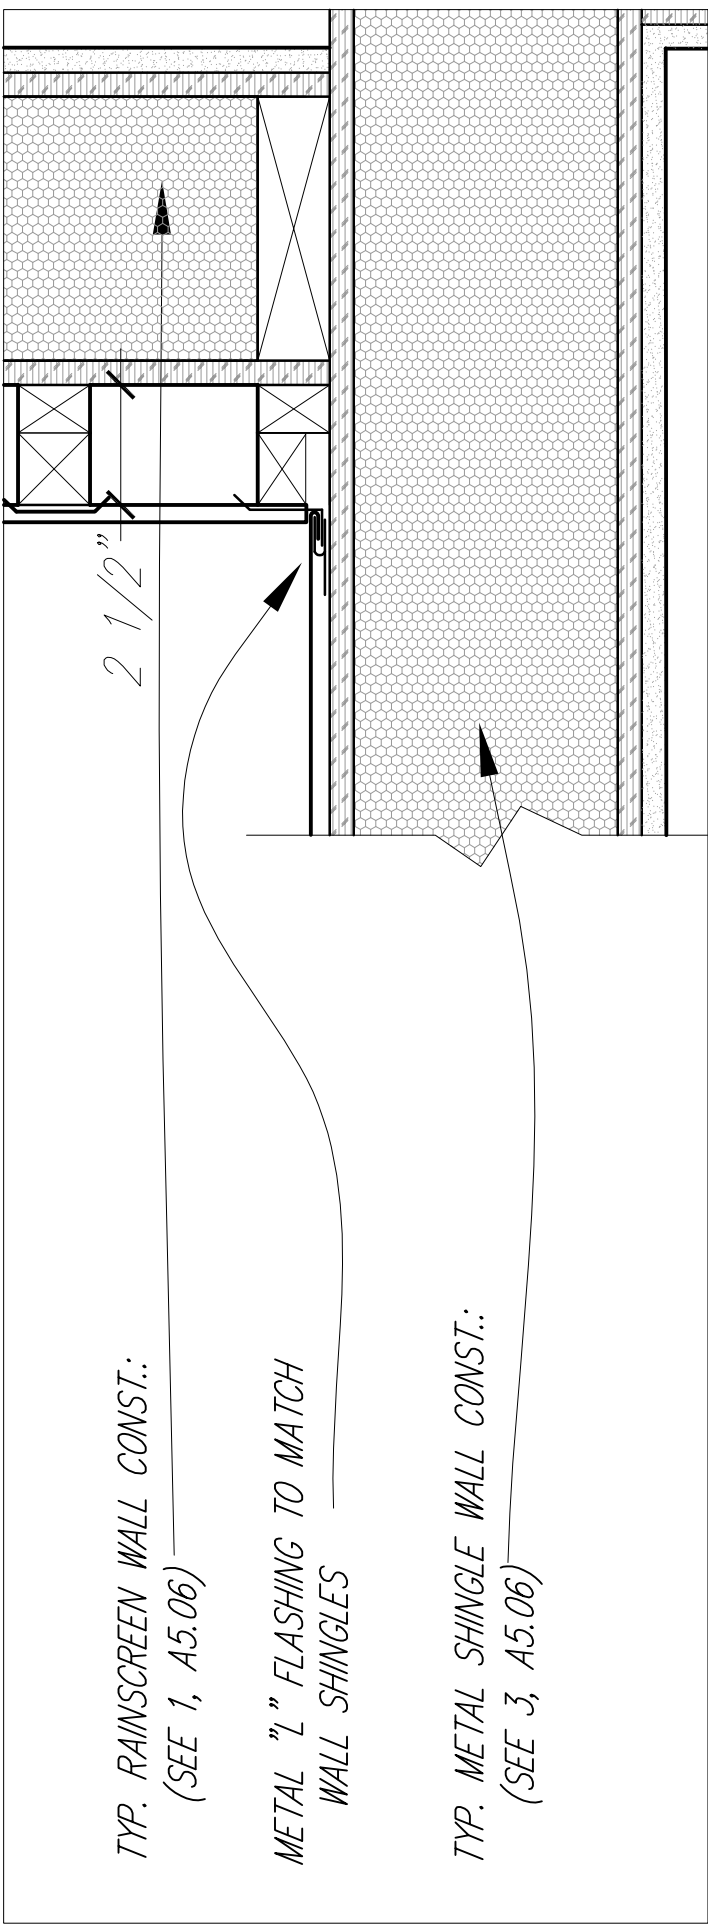


# 1 HORIZONTAL CONNECTION: STEEL SHINGLE SIP WALL TO RAINSCREEN SIP WALL

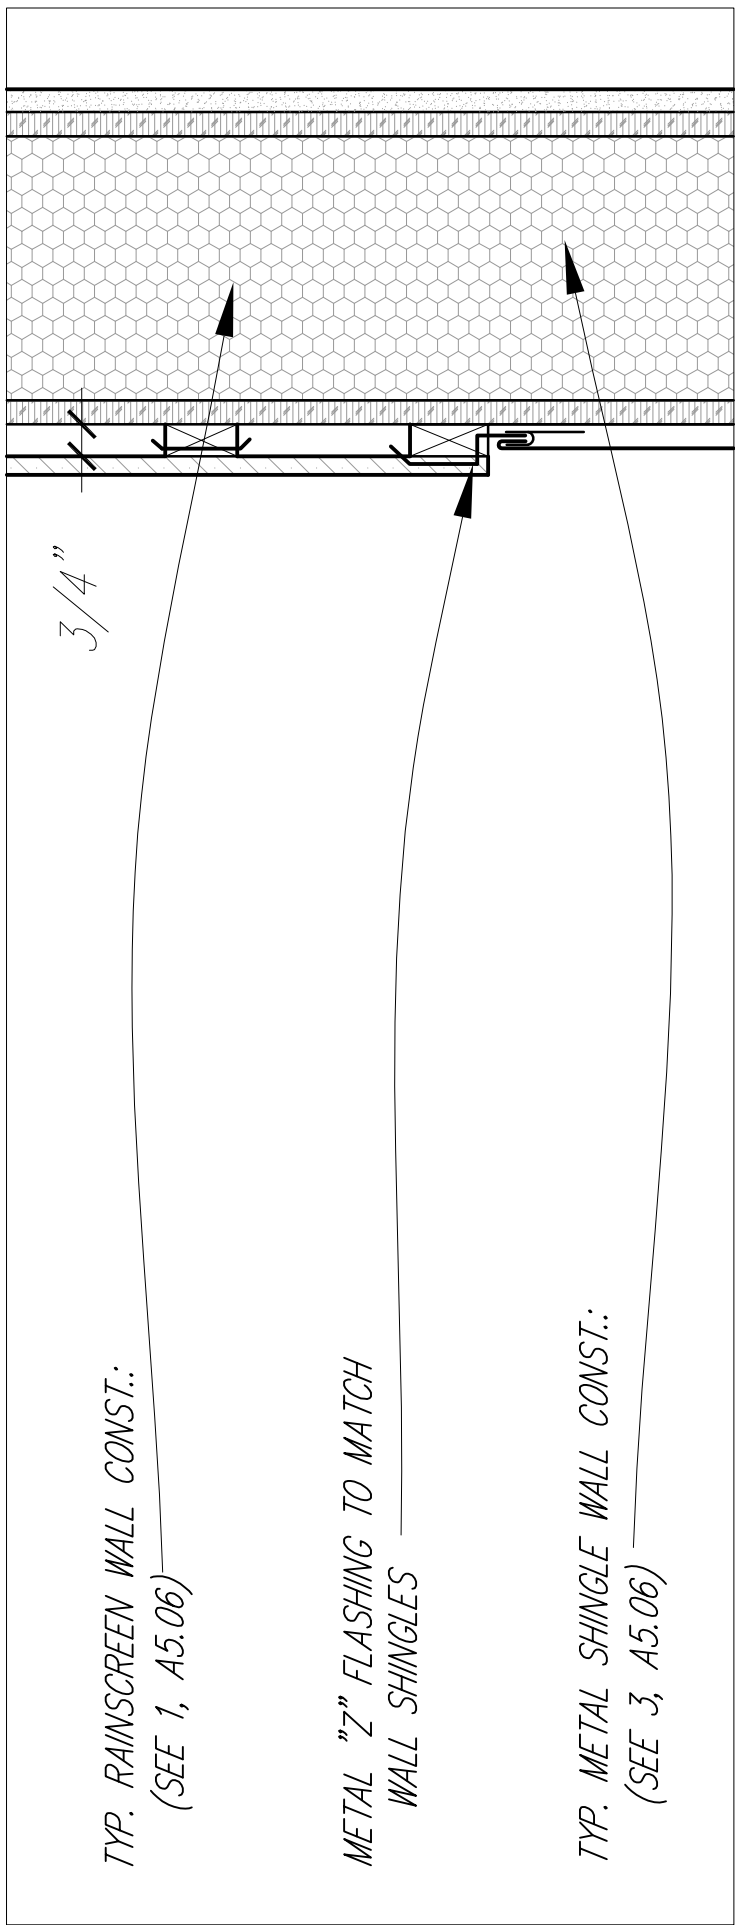


# 2 HORIZONTAL CONNECTION: METAL SHINGLE SIDING TO RAINSCREEN SIDING

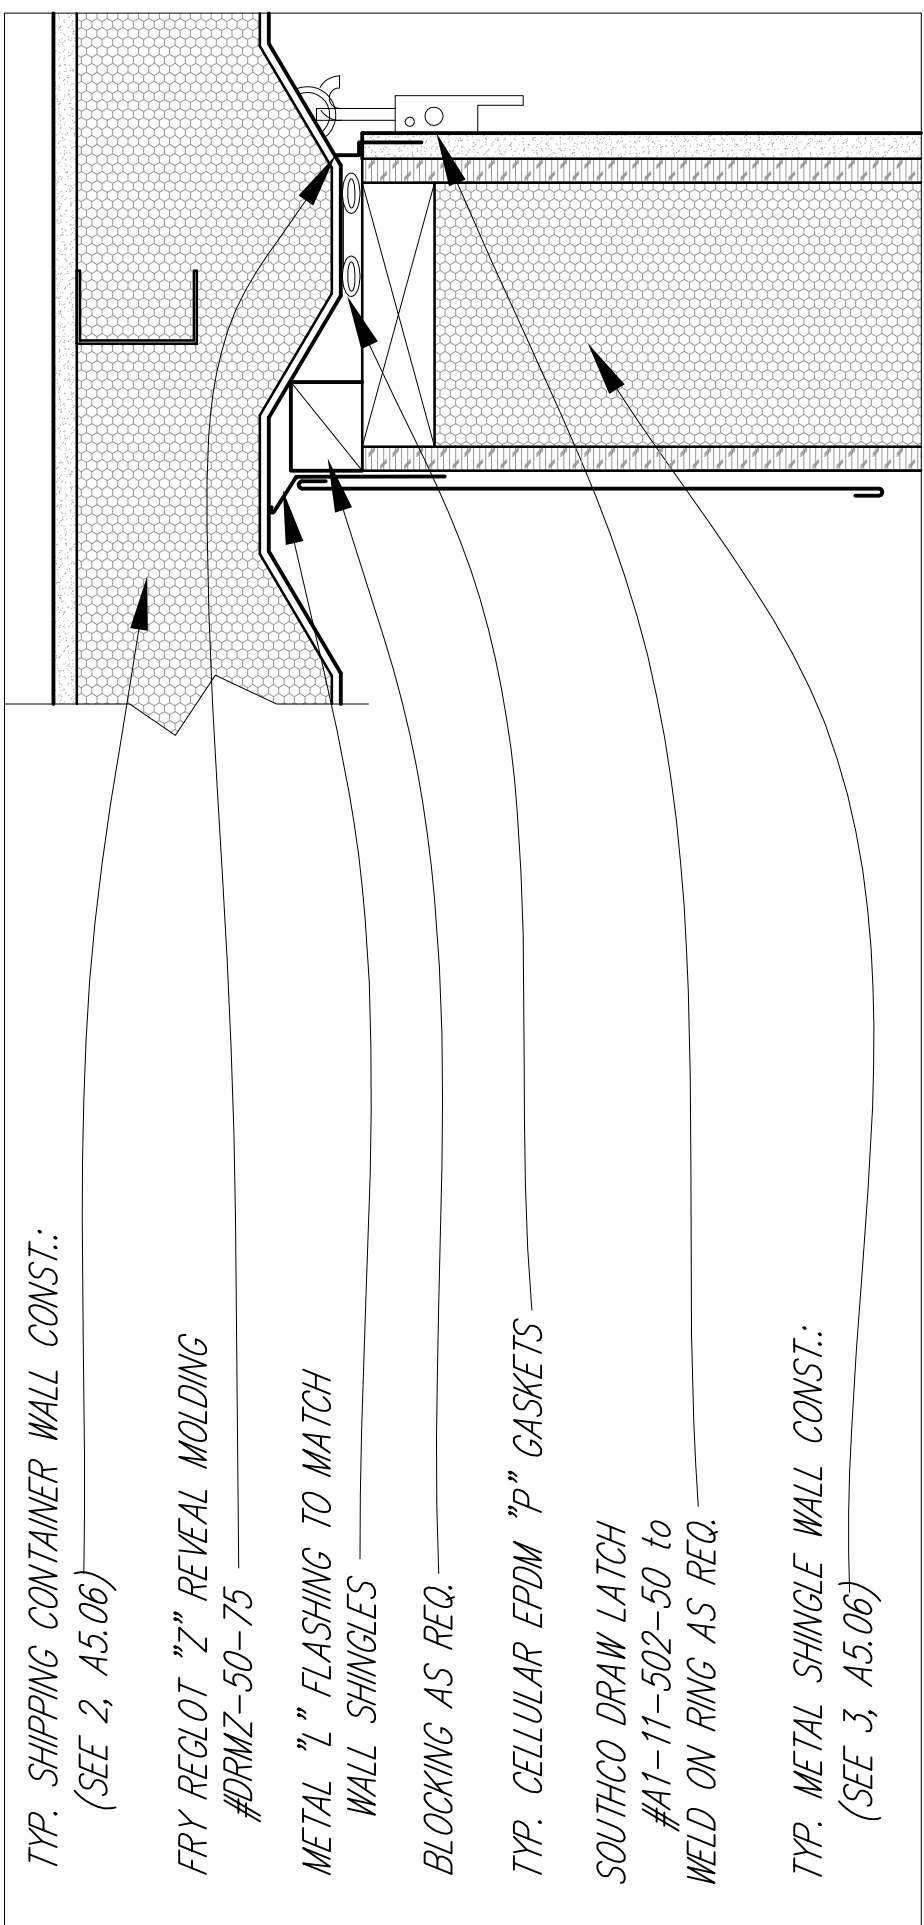

# 3 HORIZONTAL CONNECTION: METAL SHINGLE SIP WALL TO SHIPPING CONTAINER

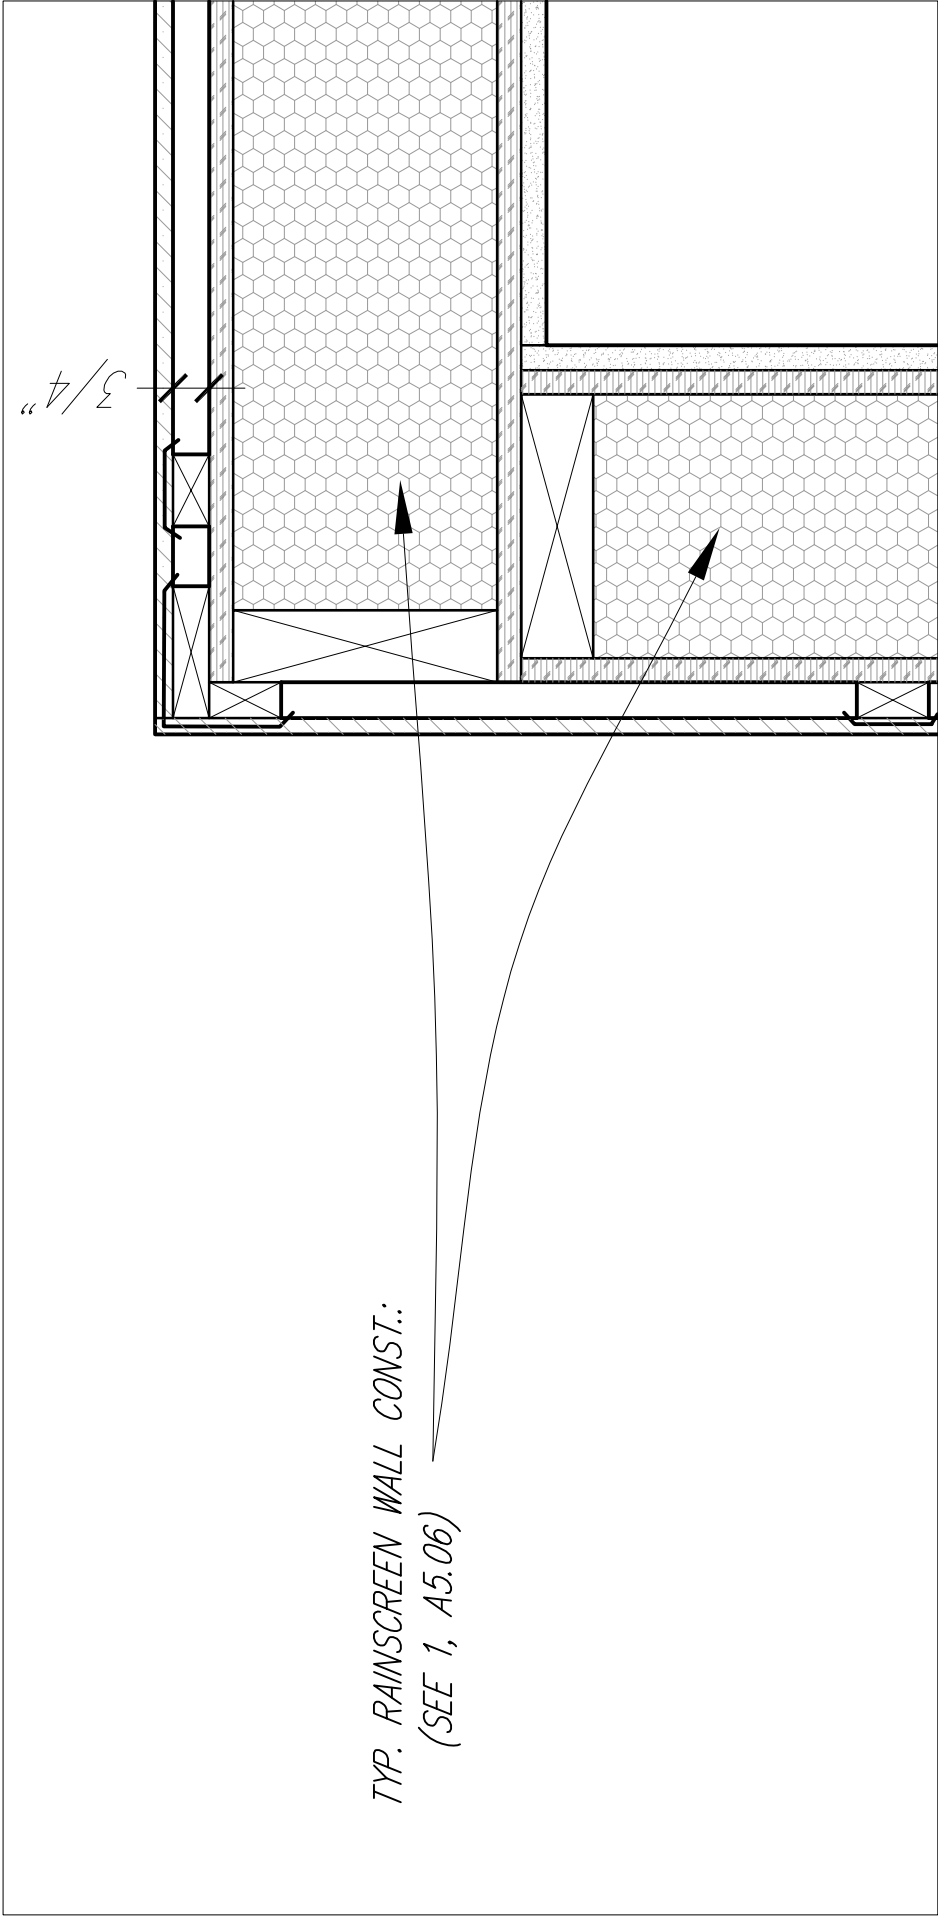


1 HORIZONTAL SECTION: PAPERSTONE SIP WALL (NORTH BEDROOM) 3" - 1'-0"

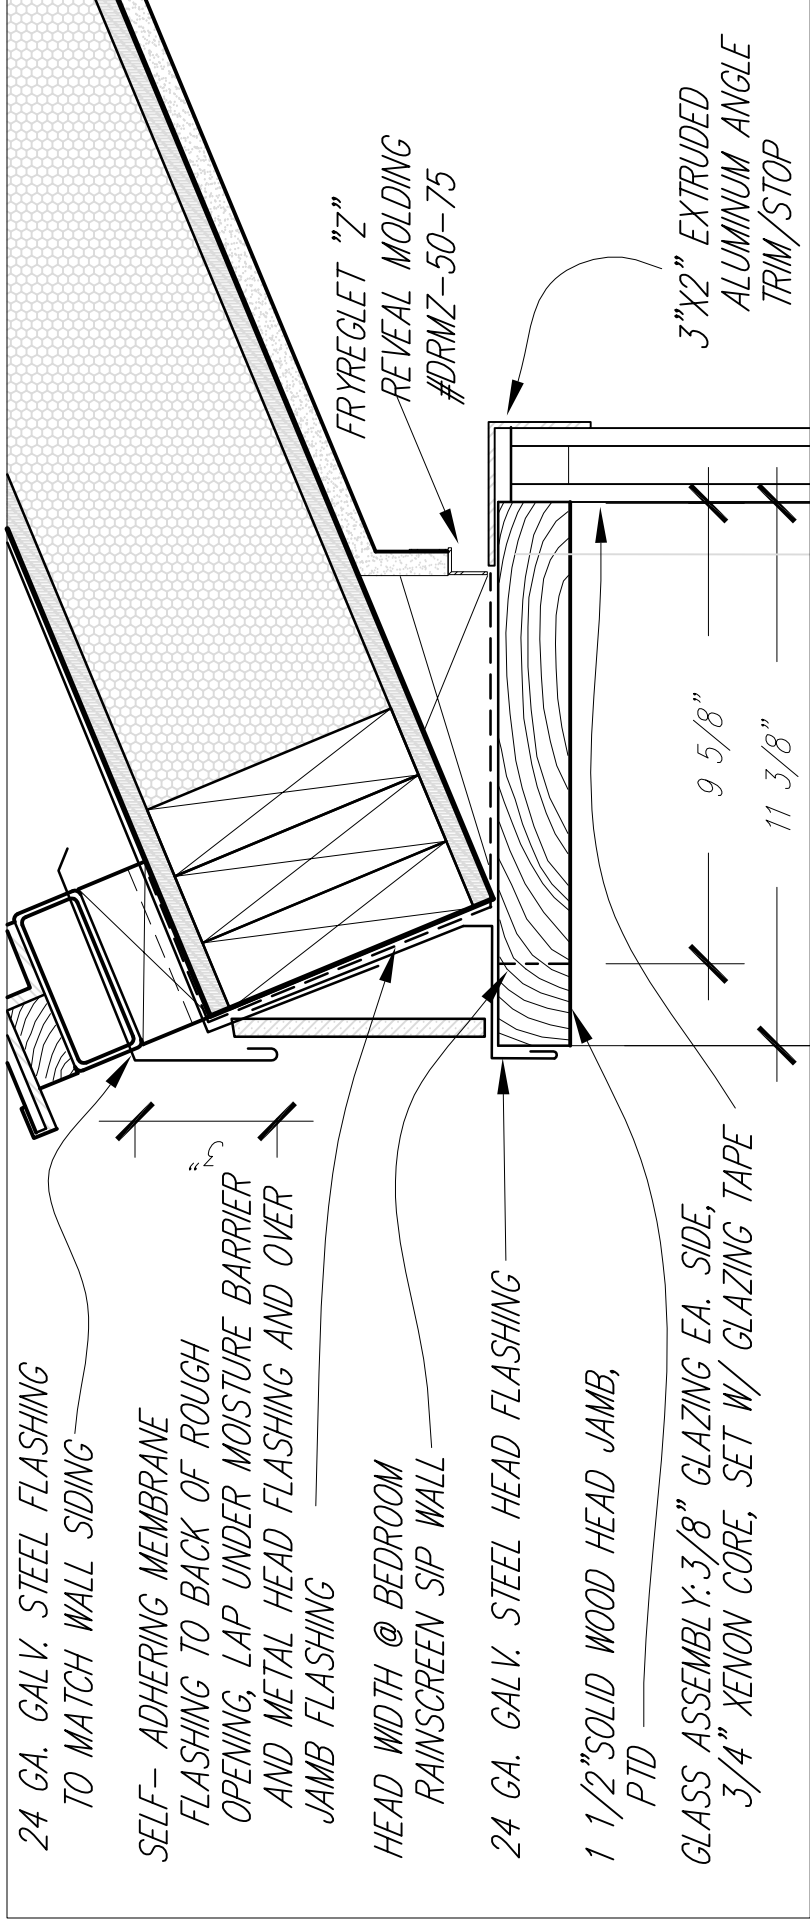


1 OFFICE WINDOW HEAD DETAIL

3" - 1'-0"

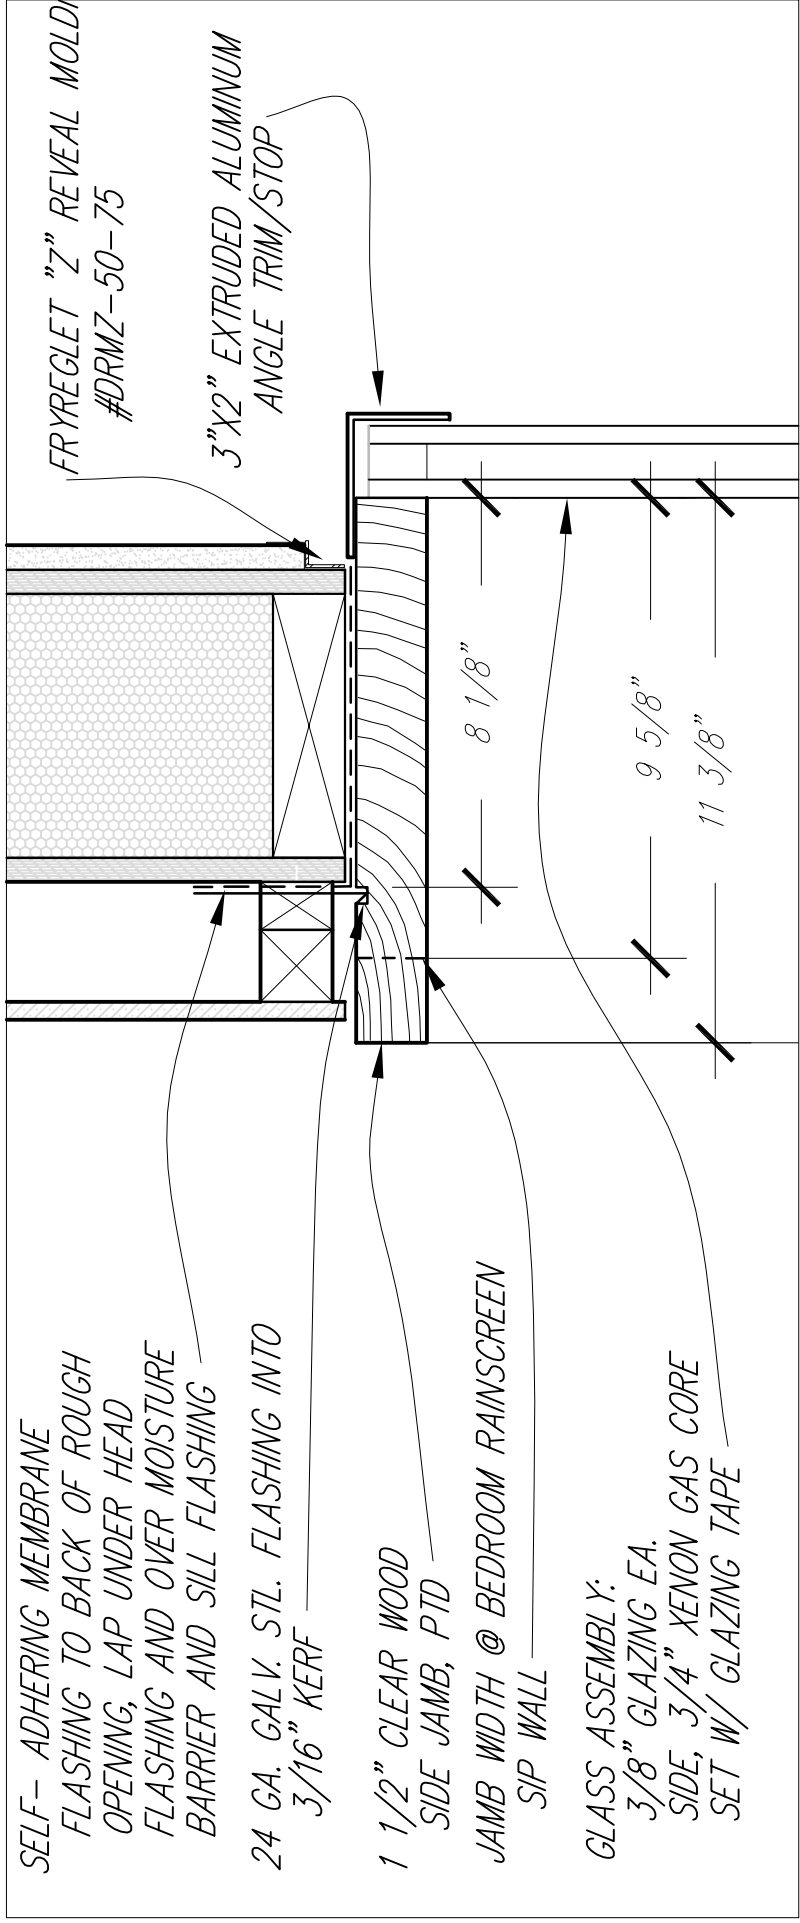

2 OFFICE WINDOW JAMB DETAIL


3" - 1'-0"

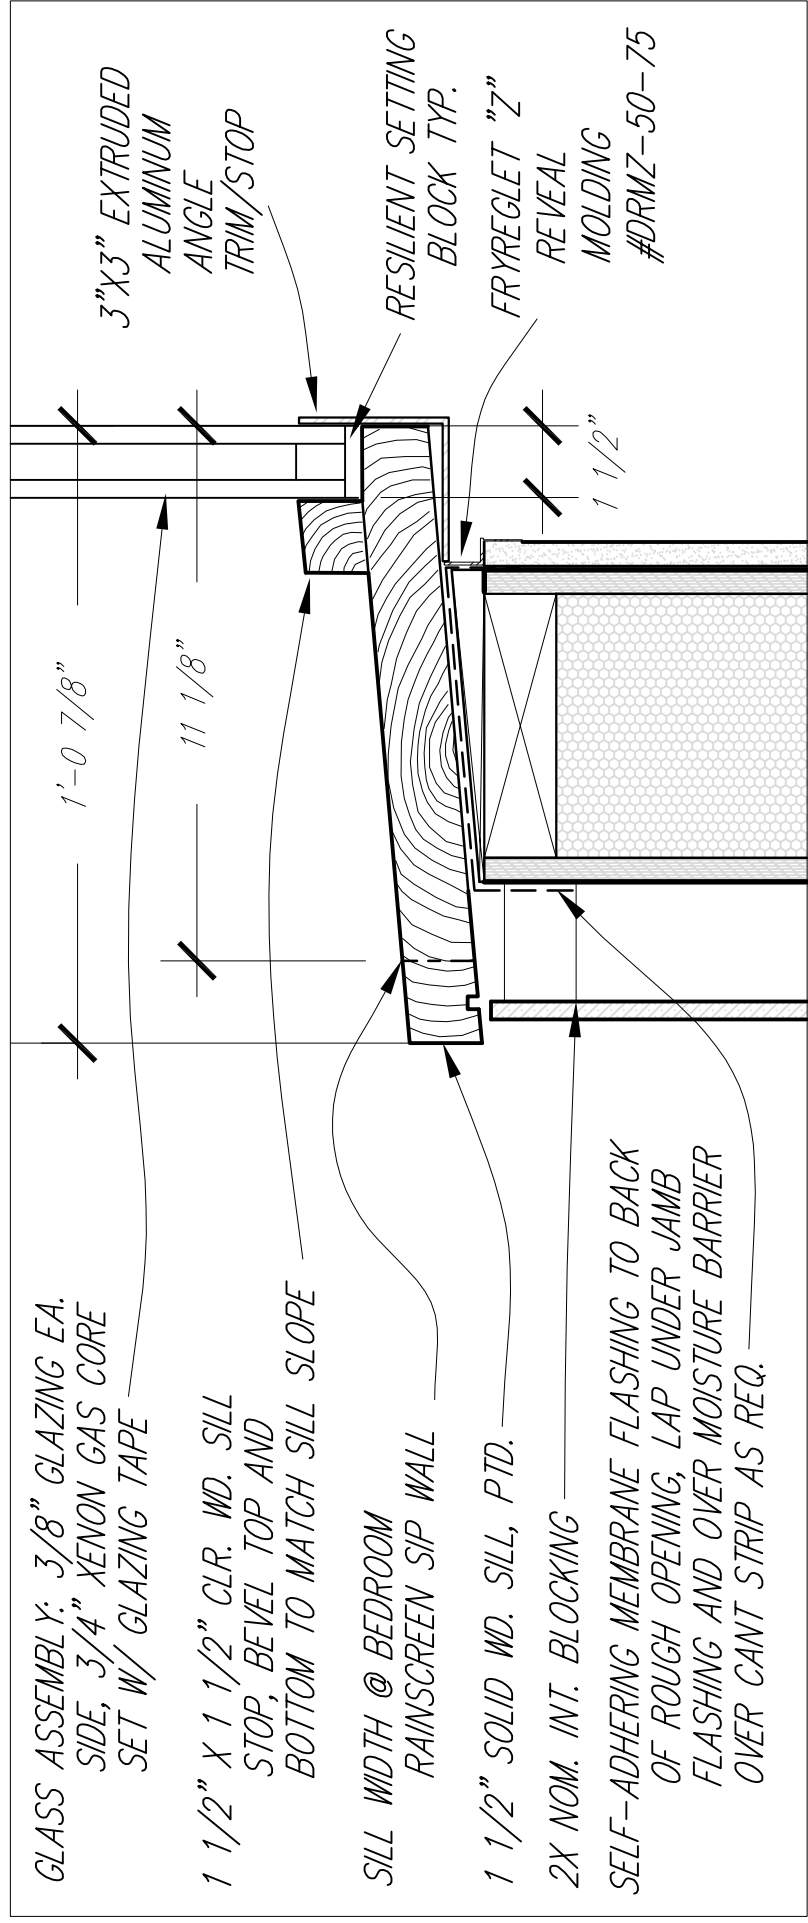


3 OFFICE WINDOW SILL DETAIL

3" - 1'-0"




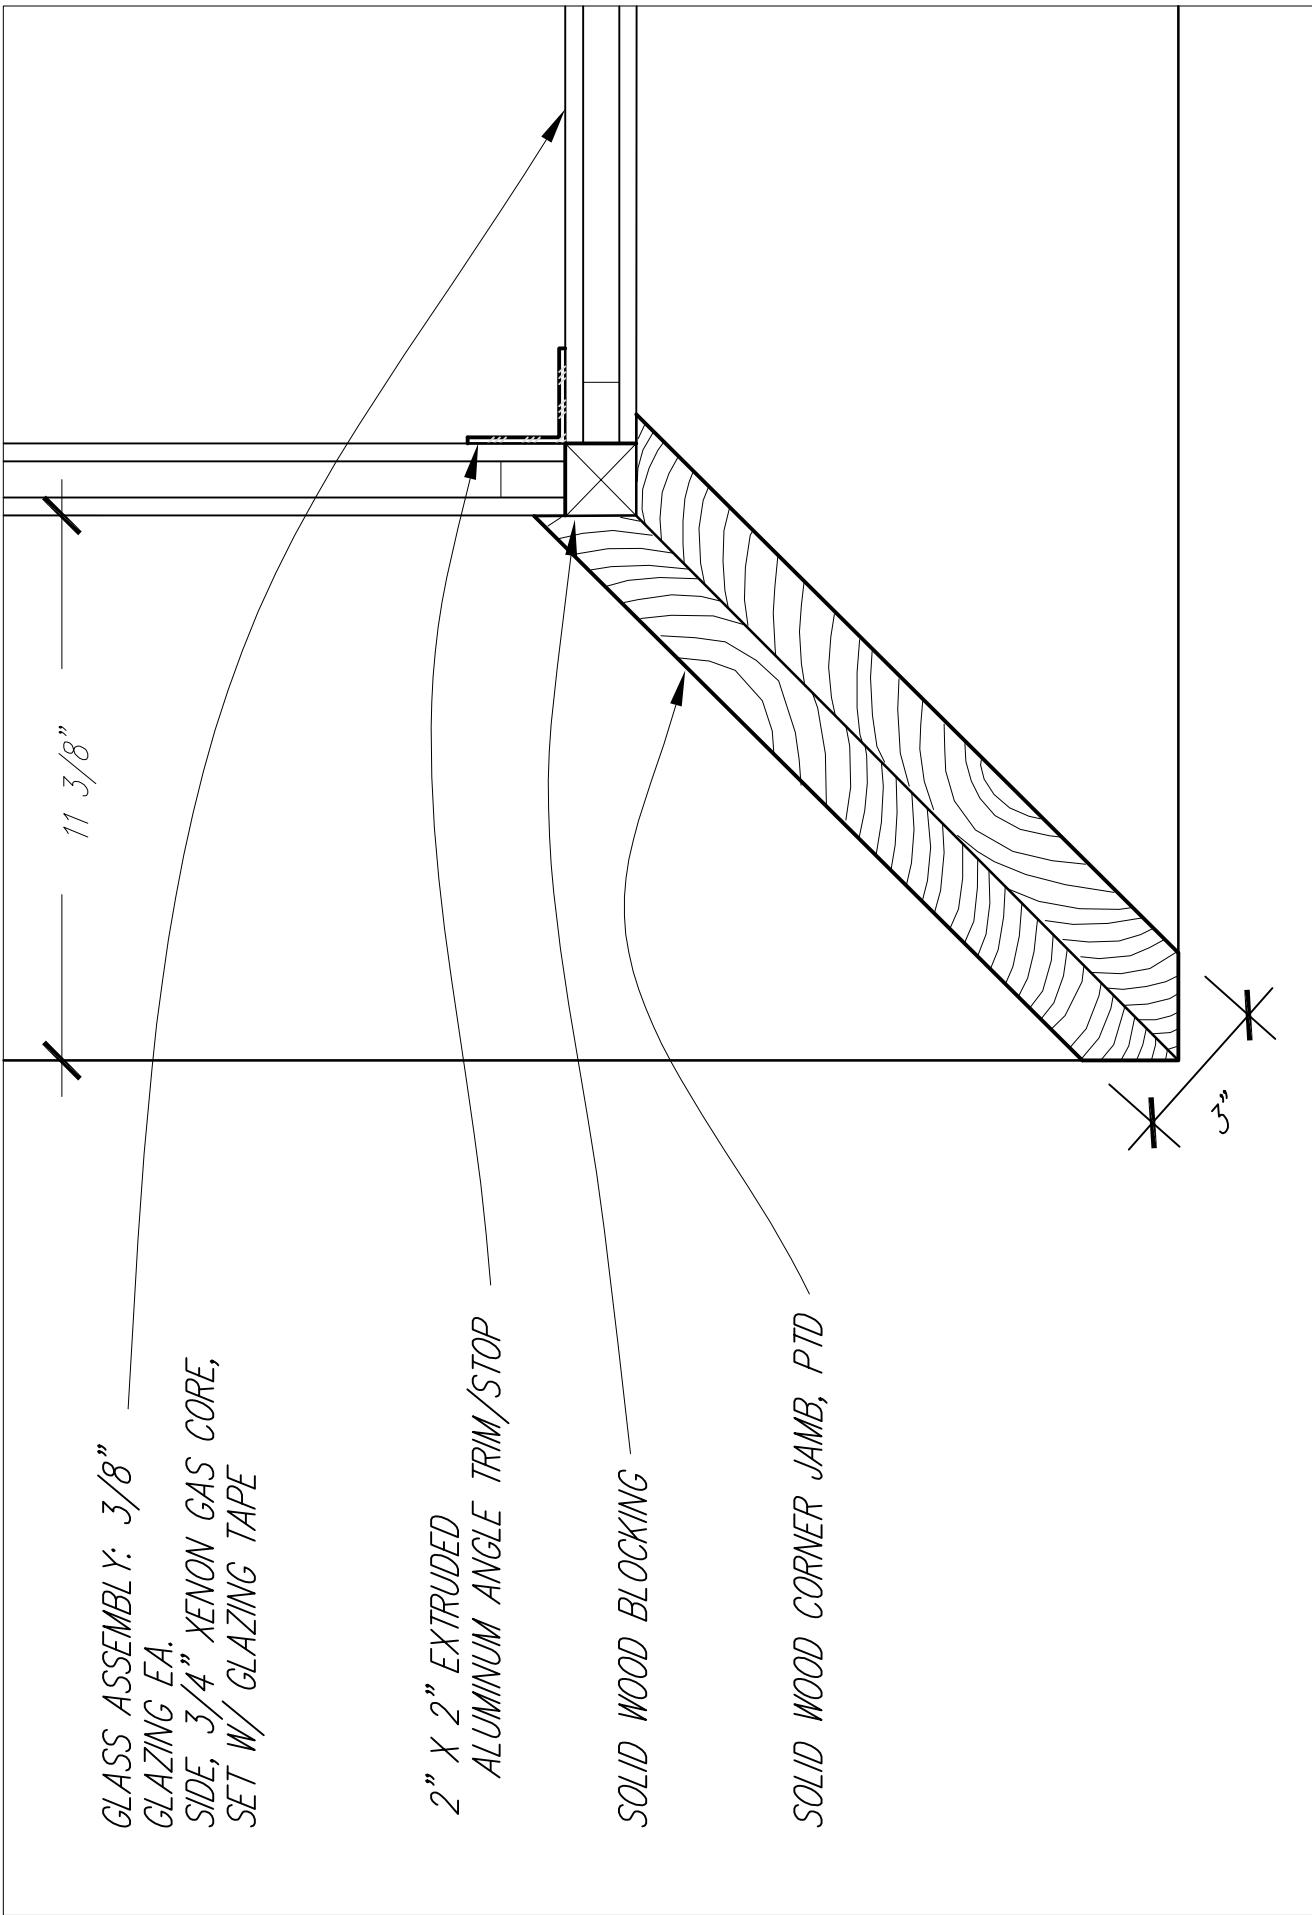


1 SE CORNER JAMB DETAIL 3" - 1'-0"

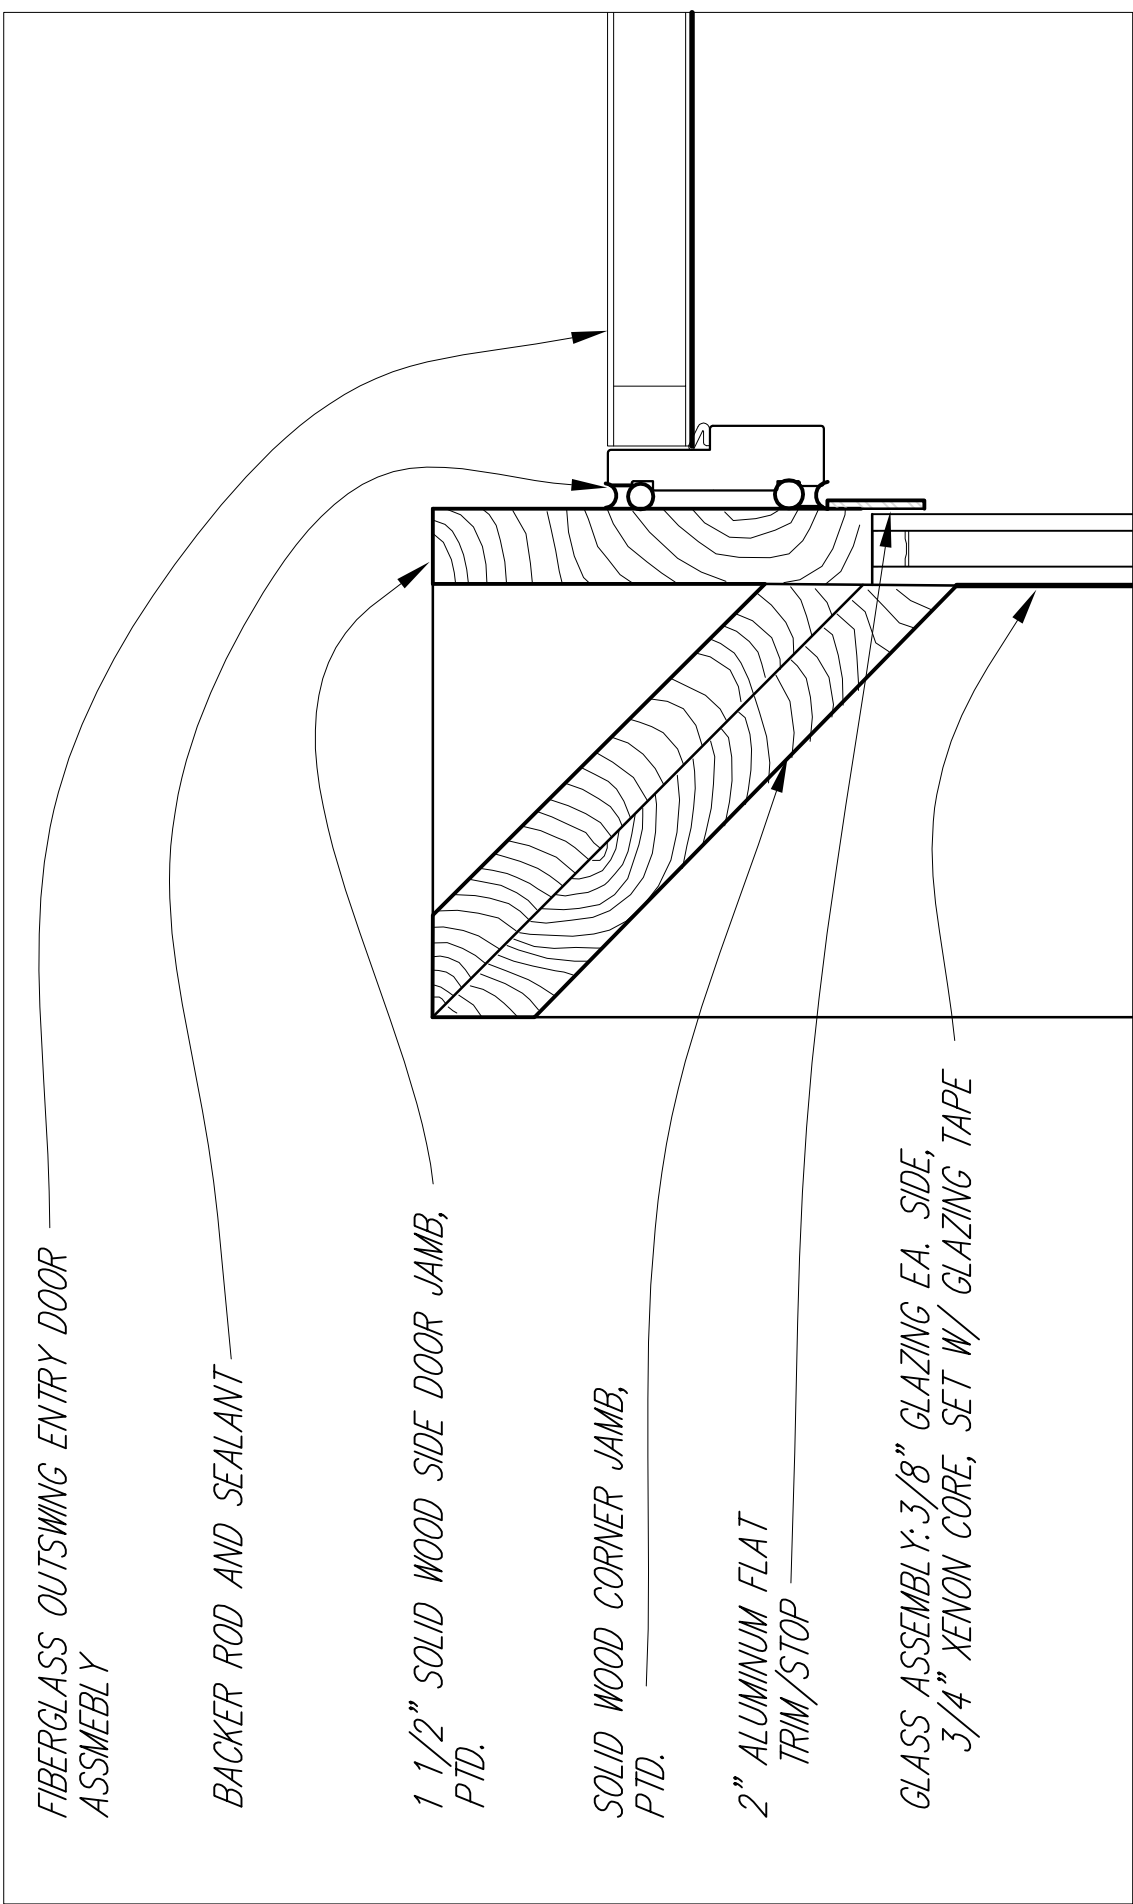


2 SW CORNER JAMB DETAIL 3" - 1'-0"

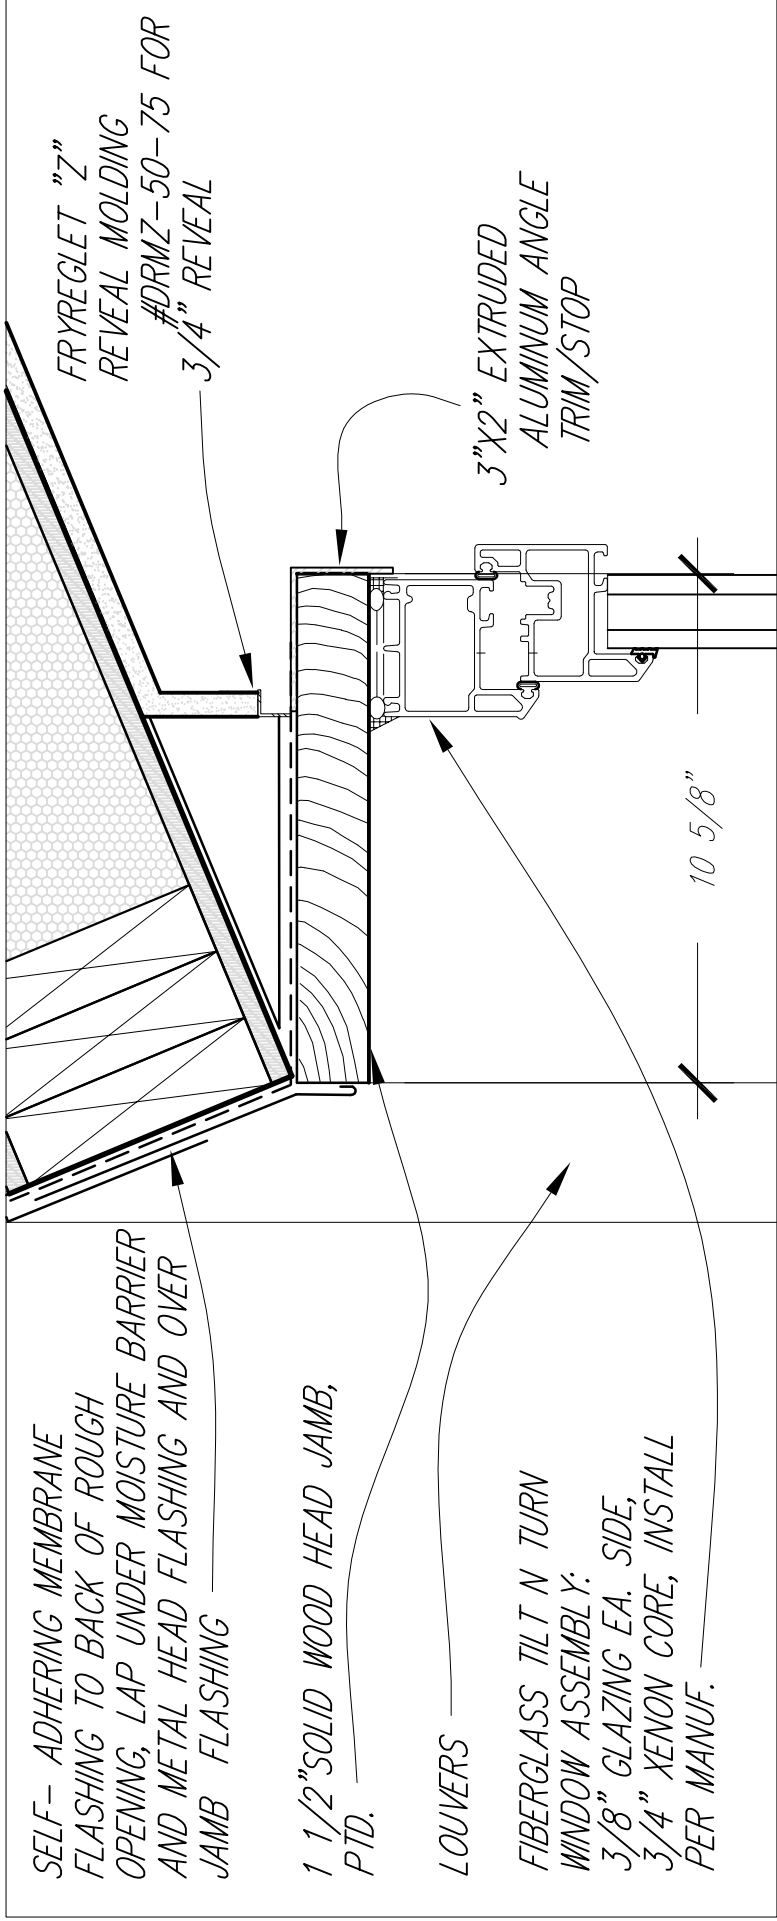

1 SW WINDOW HEAD DETAIL

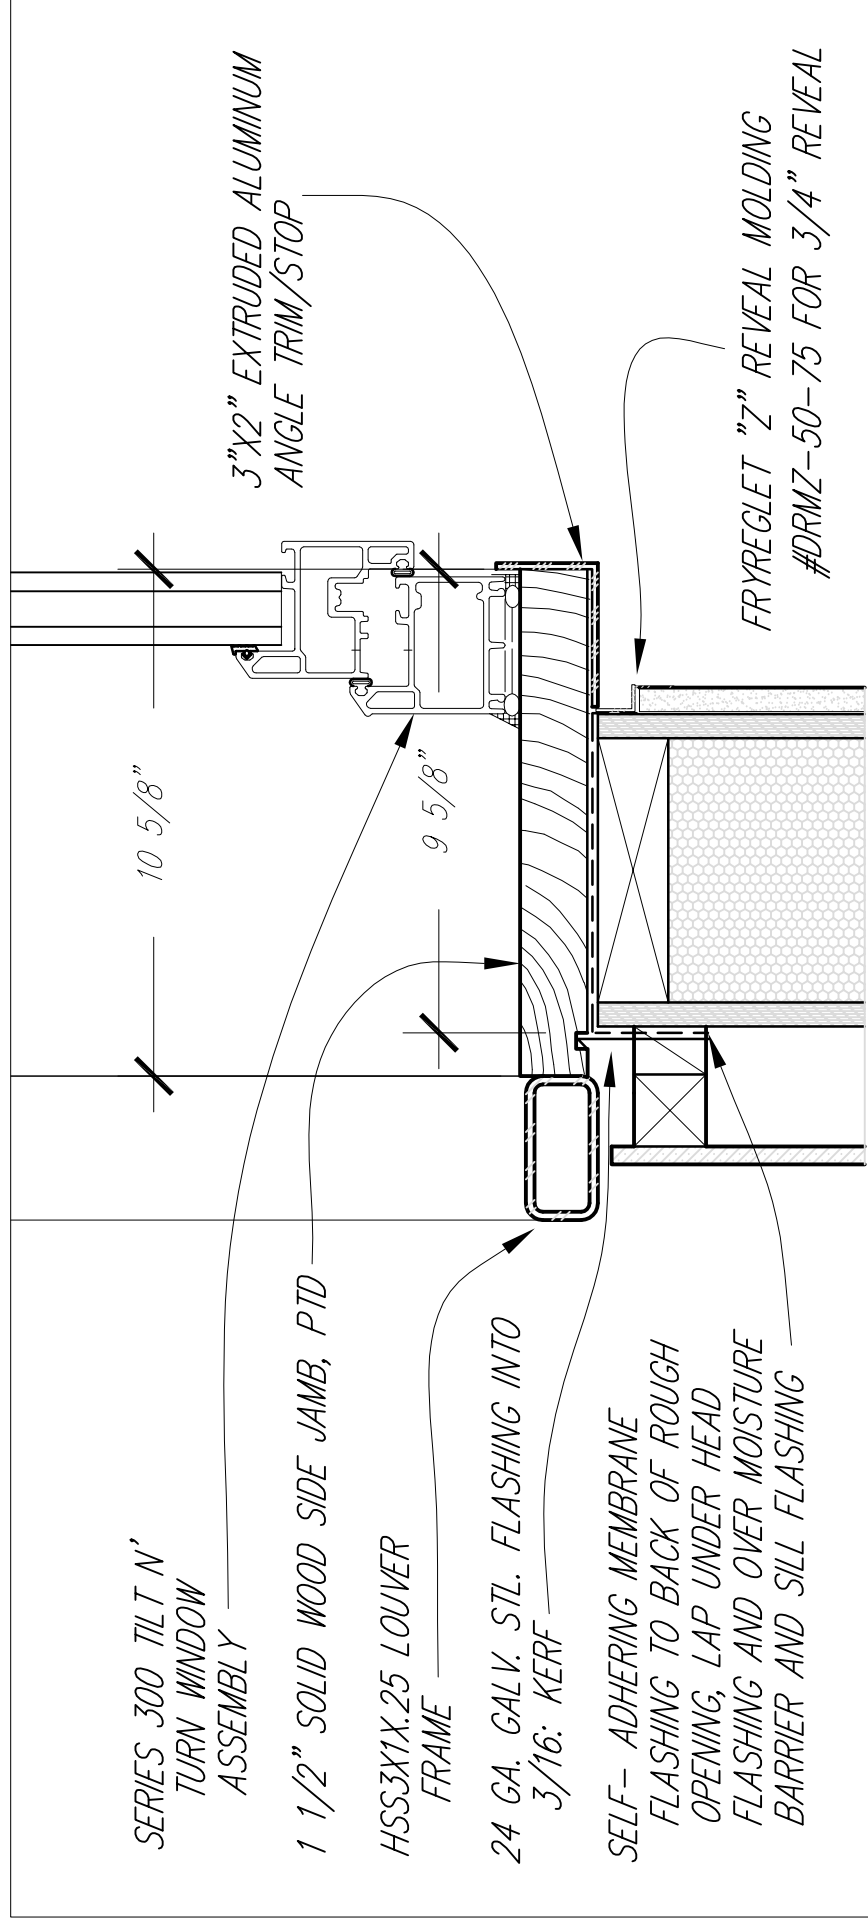


2 SW WINDOW JAMB DETAIL

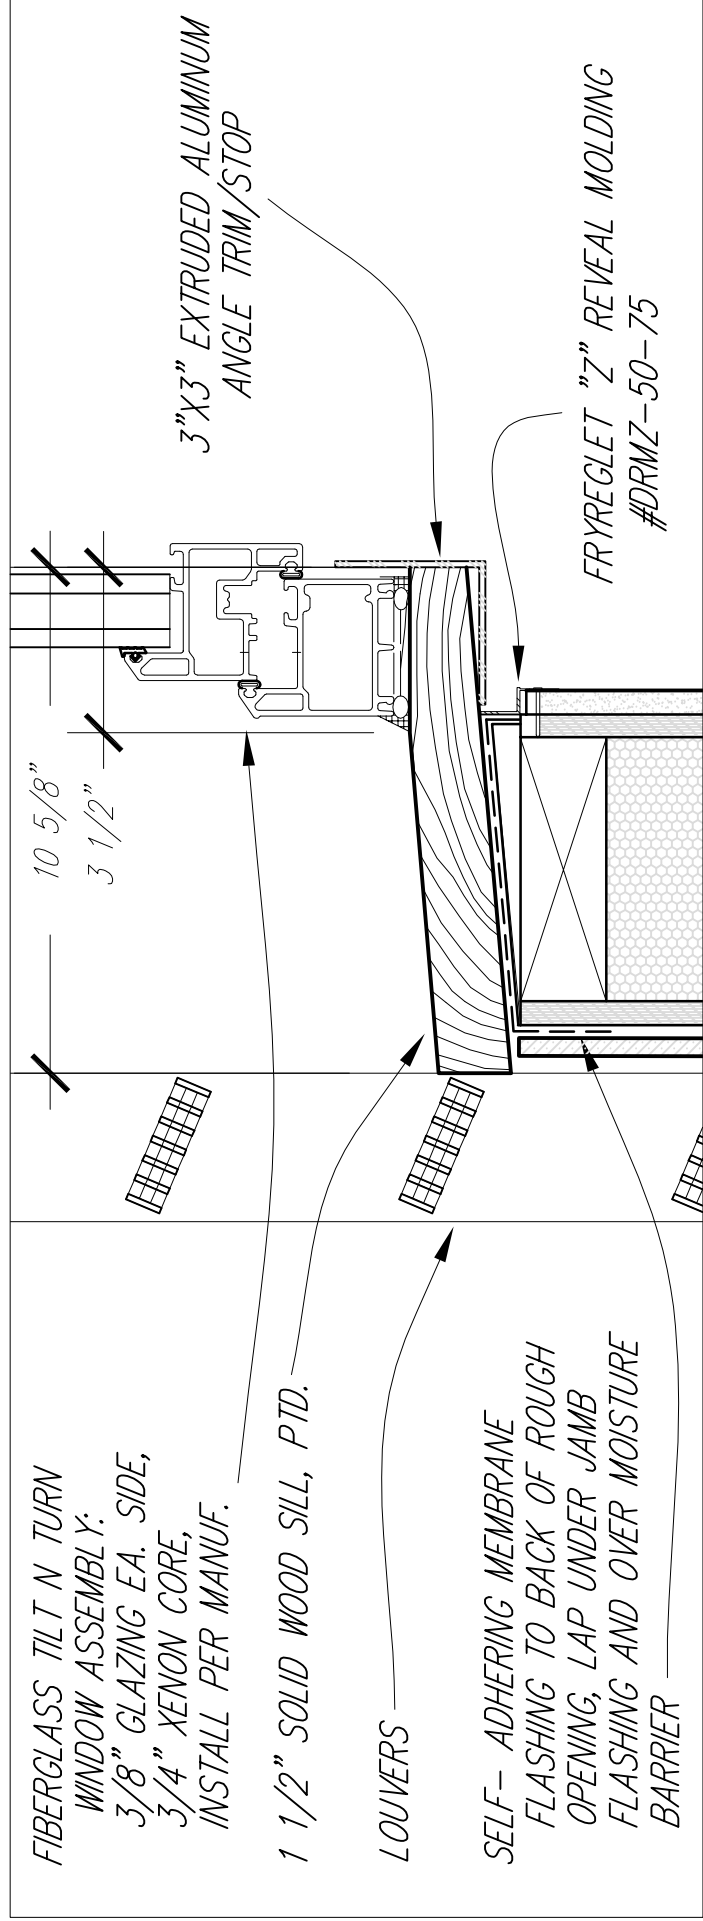

3 SW WINDOW SILL DETAIL




Drawn by	Date
N. Sanders	August 7, 2007
Revised	Date
N. Sanders	January 9, 2008

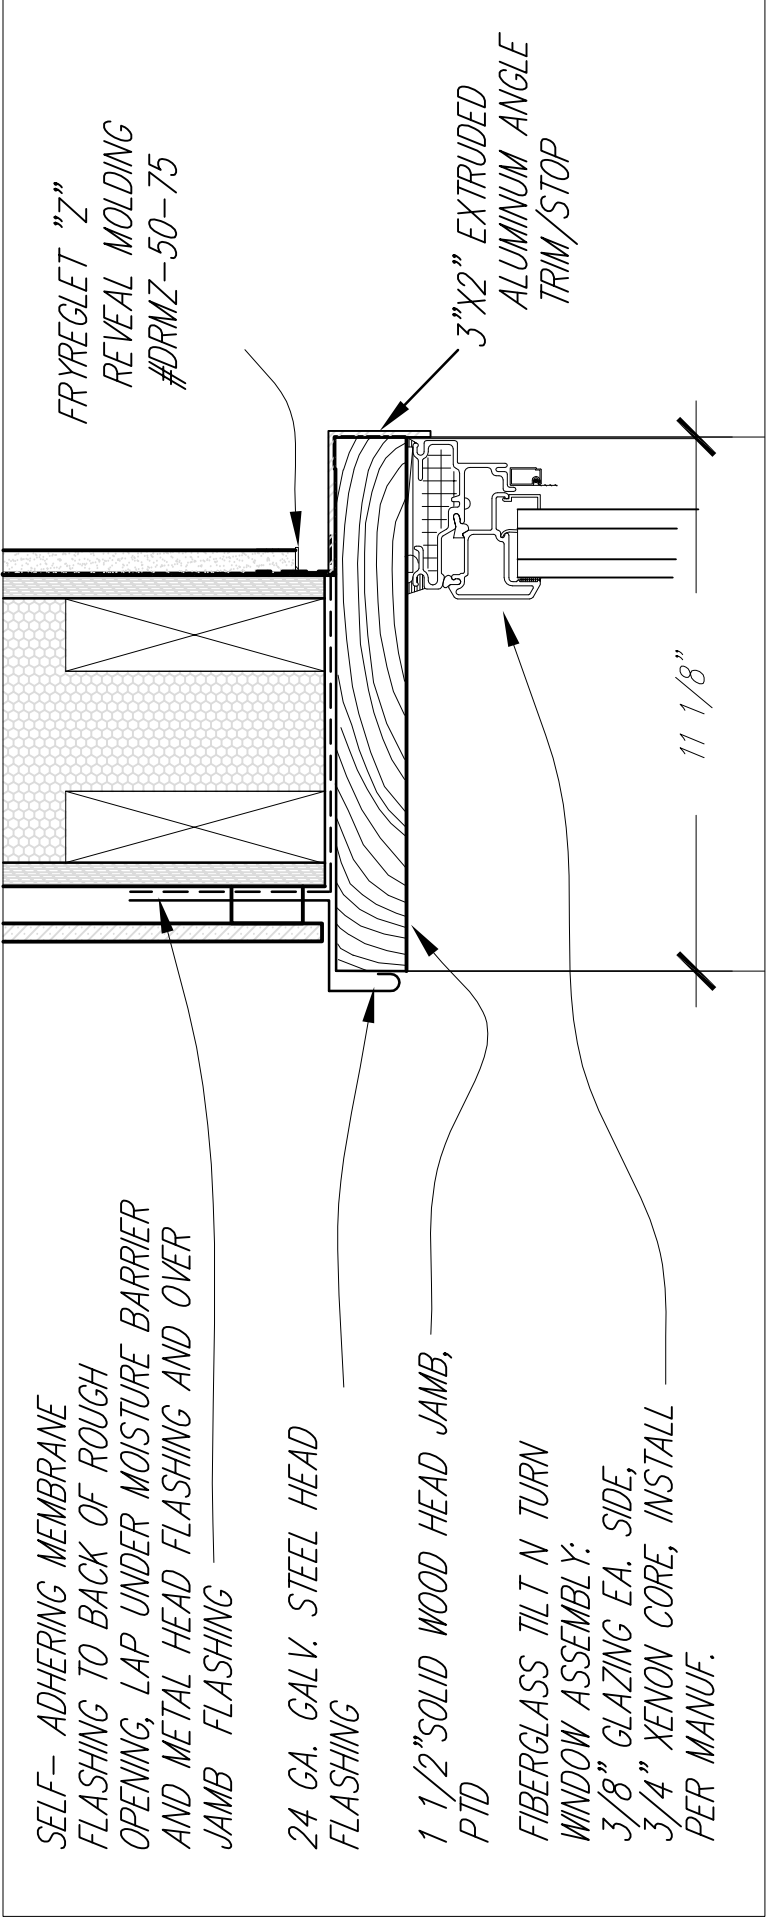


1 BEDROOM WINDOW HEAD DETAIL

3" - 1'-0"

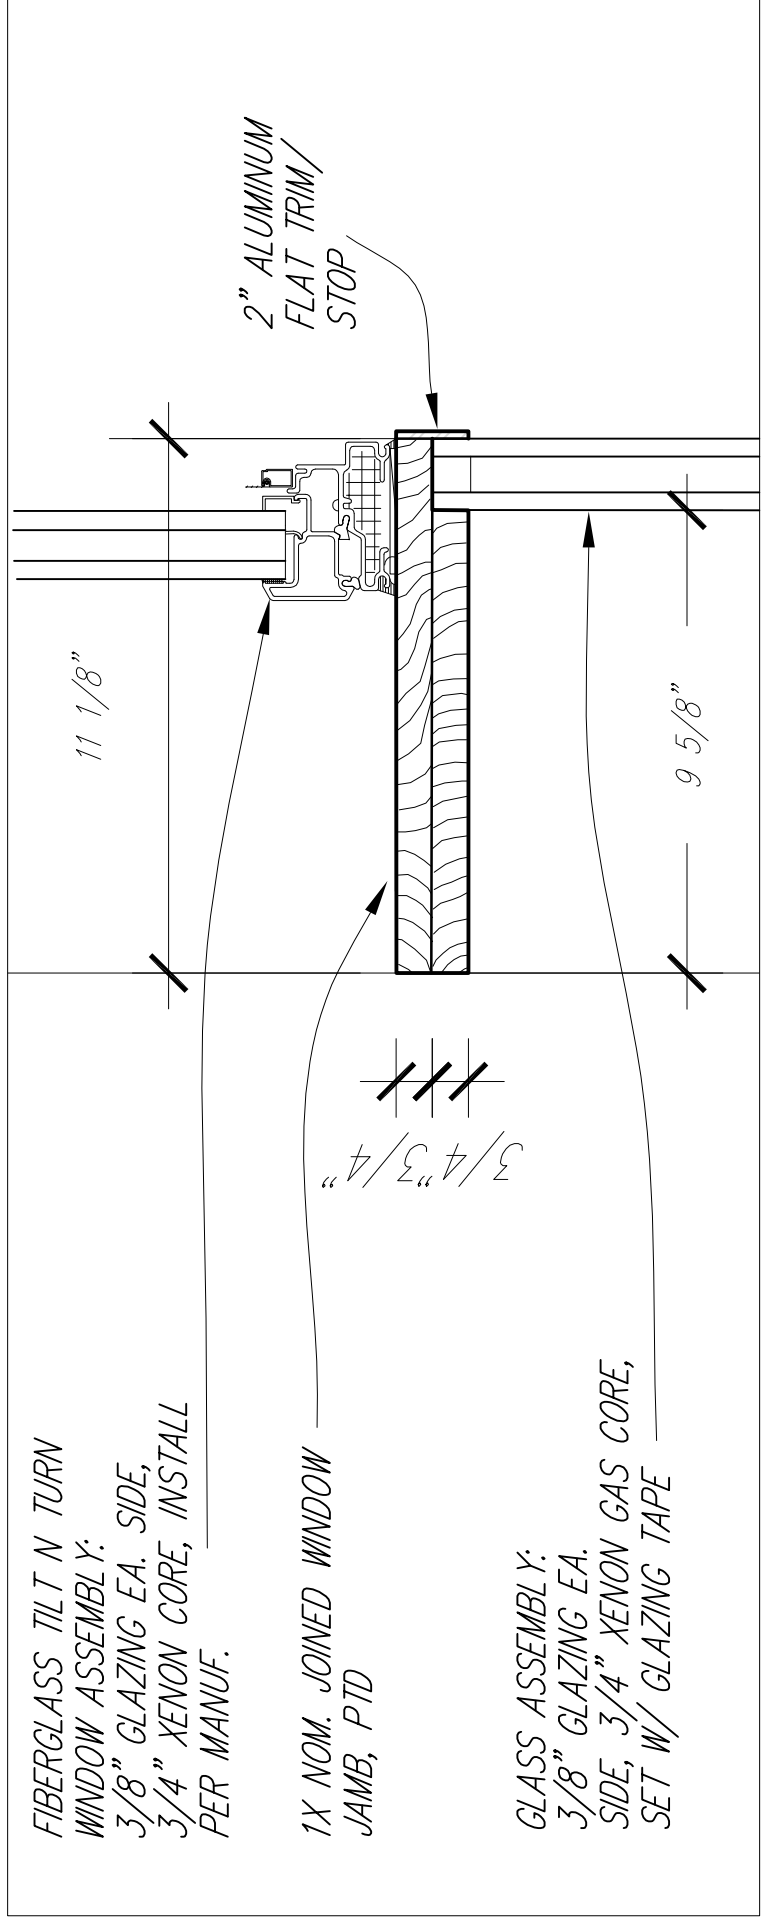

2 BEDROOM CENTER WINDOW JAMB DETAIL

3" - 1'-0"

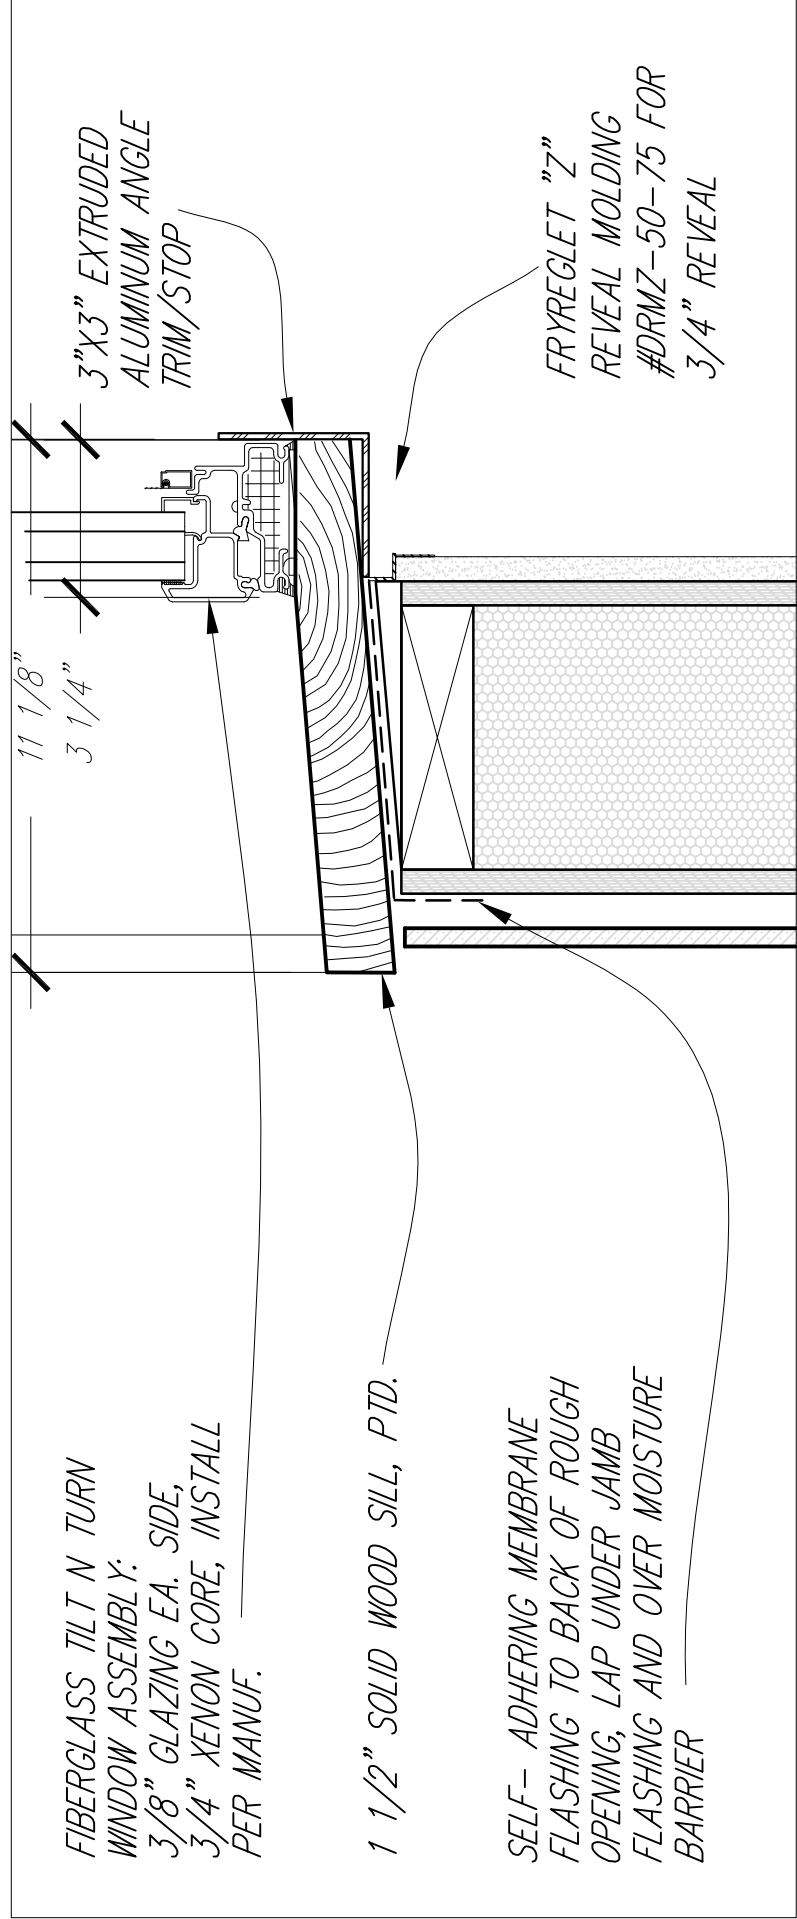


3 BEDROOM WINDOW SILL DETAIL

3" - 1'-0"




Drawn by	Date
N. Sanders	August 7, 2007
Revised	Date
N. Sanders	January 9, 2008



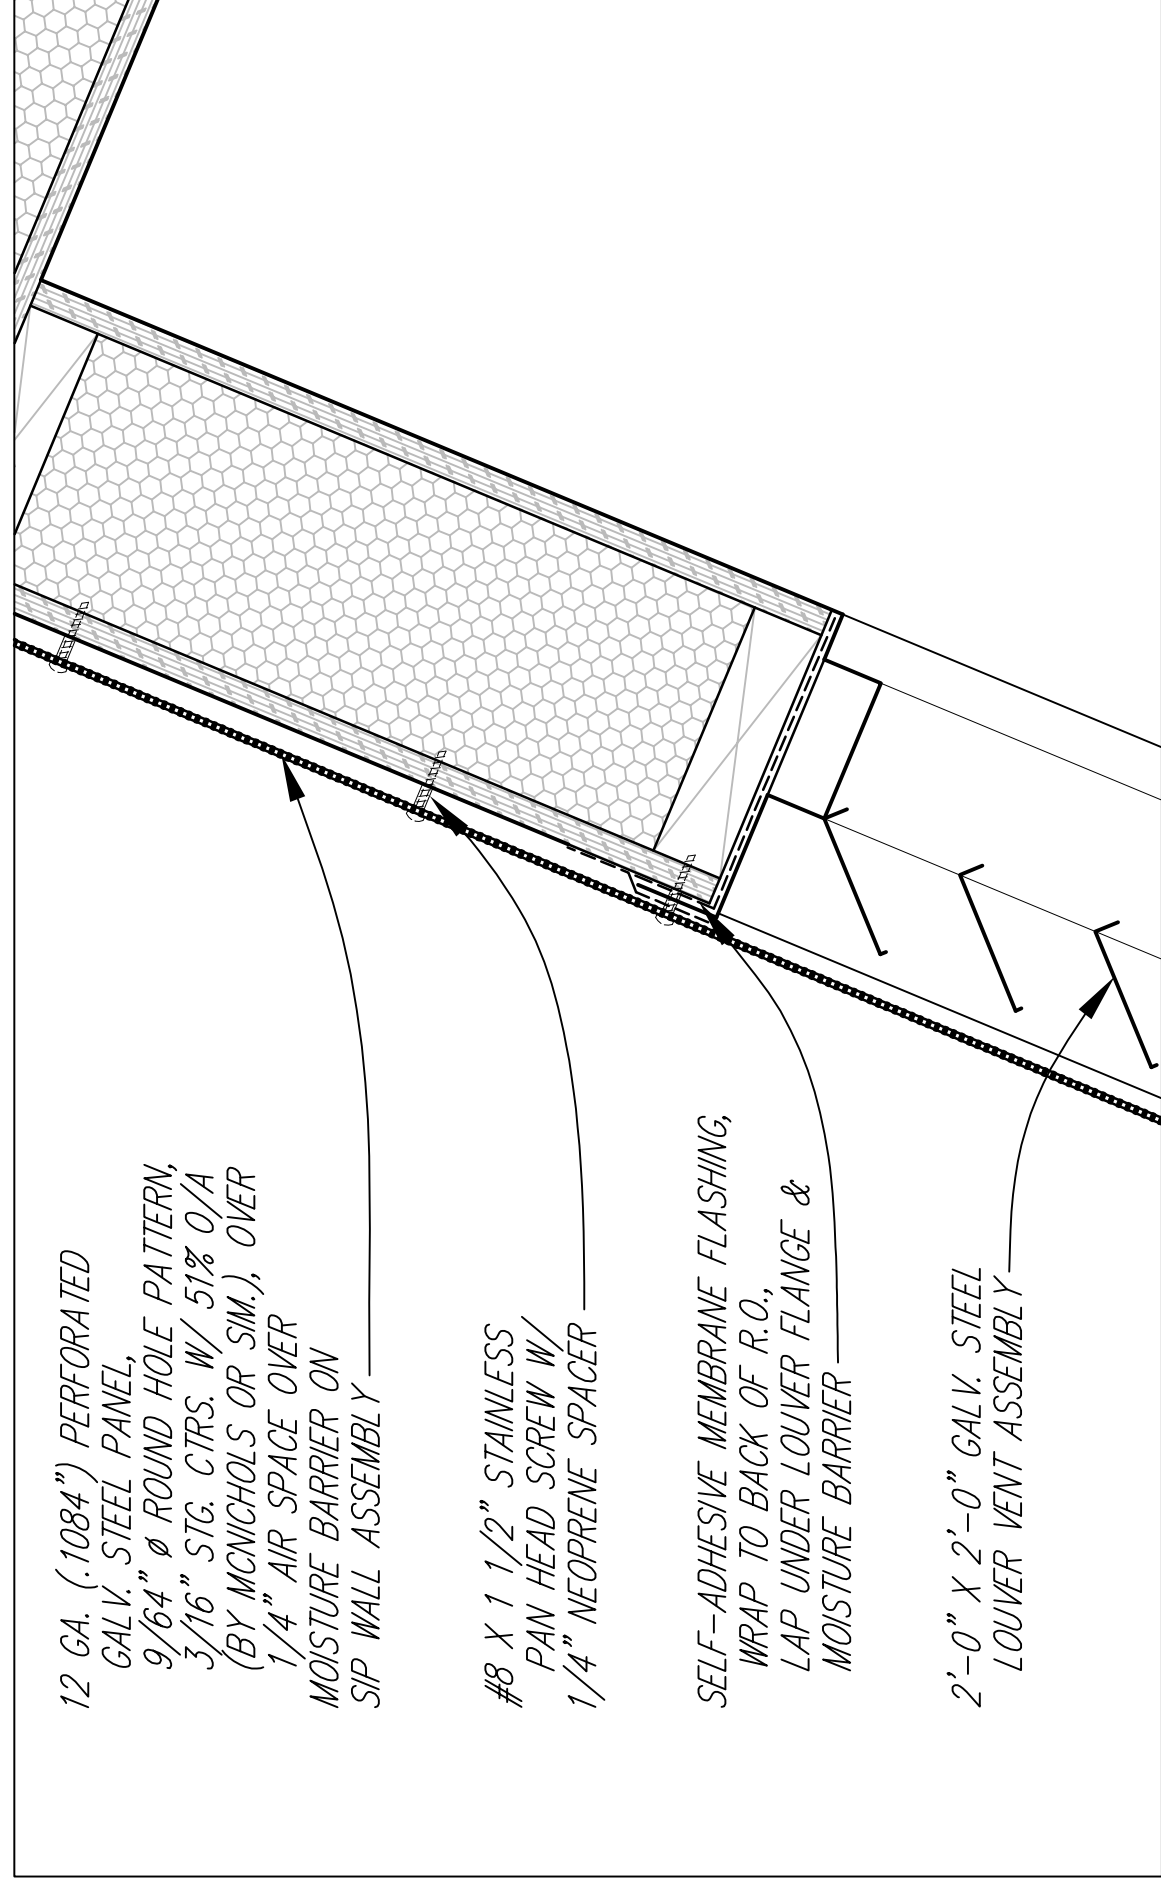

1 LOUVER HEAD @ MECH. ATTIC

3" = 1'-0"

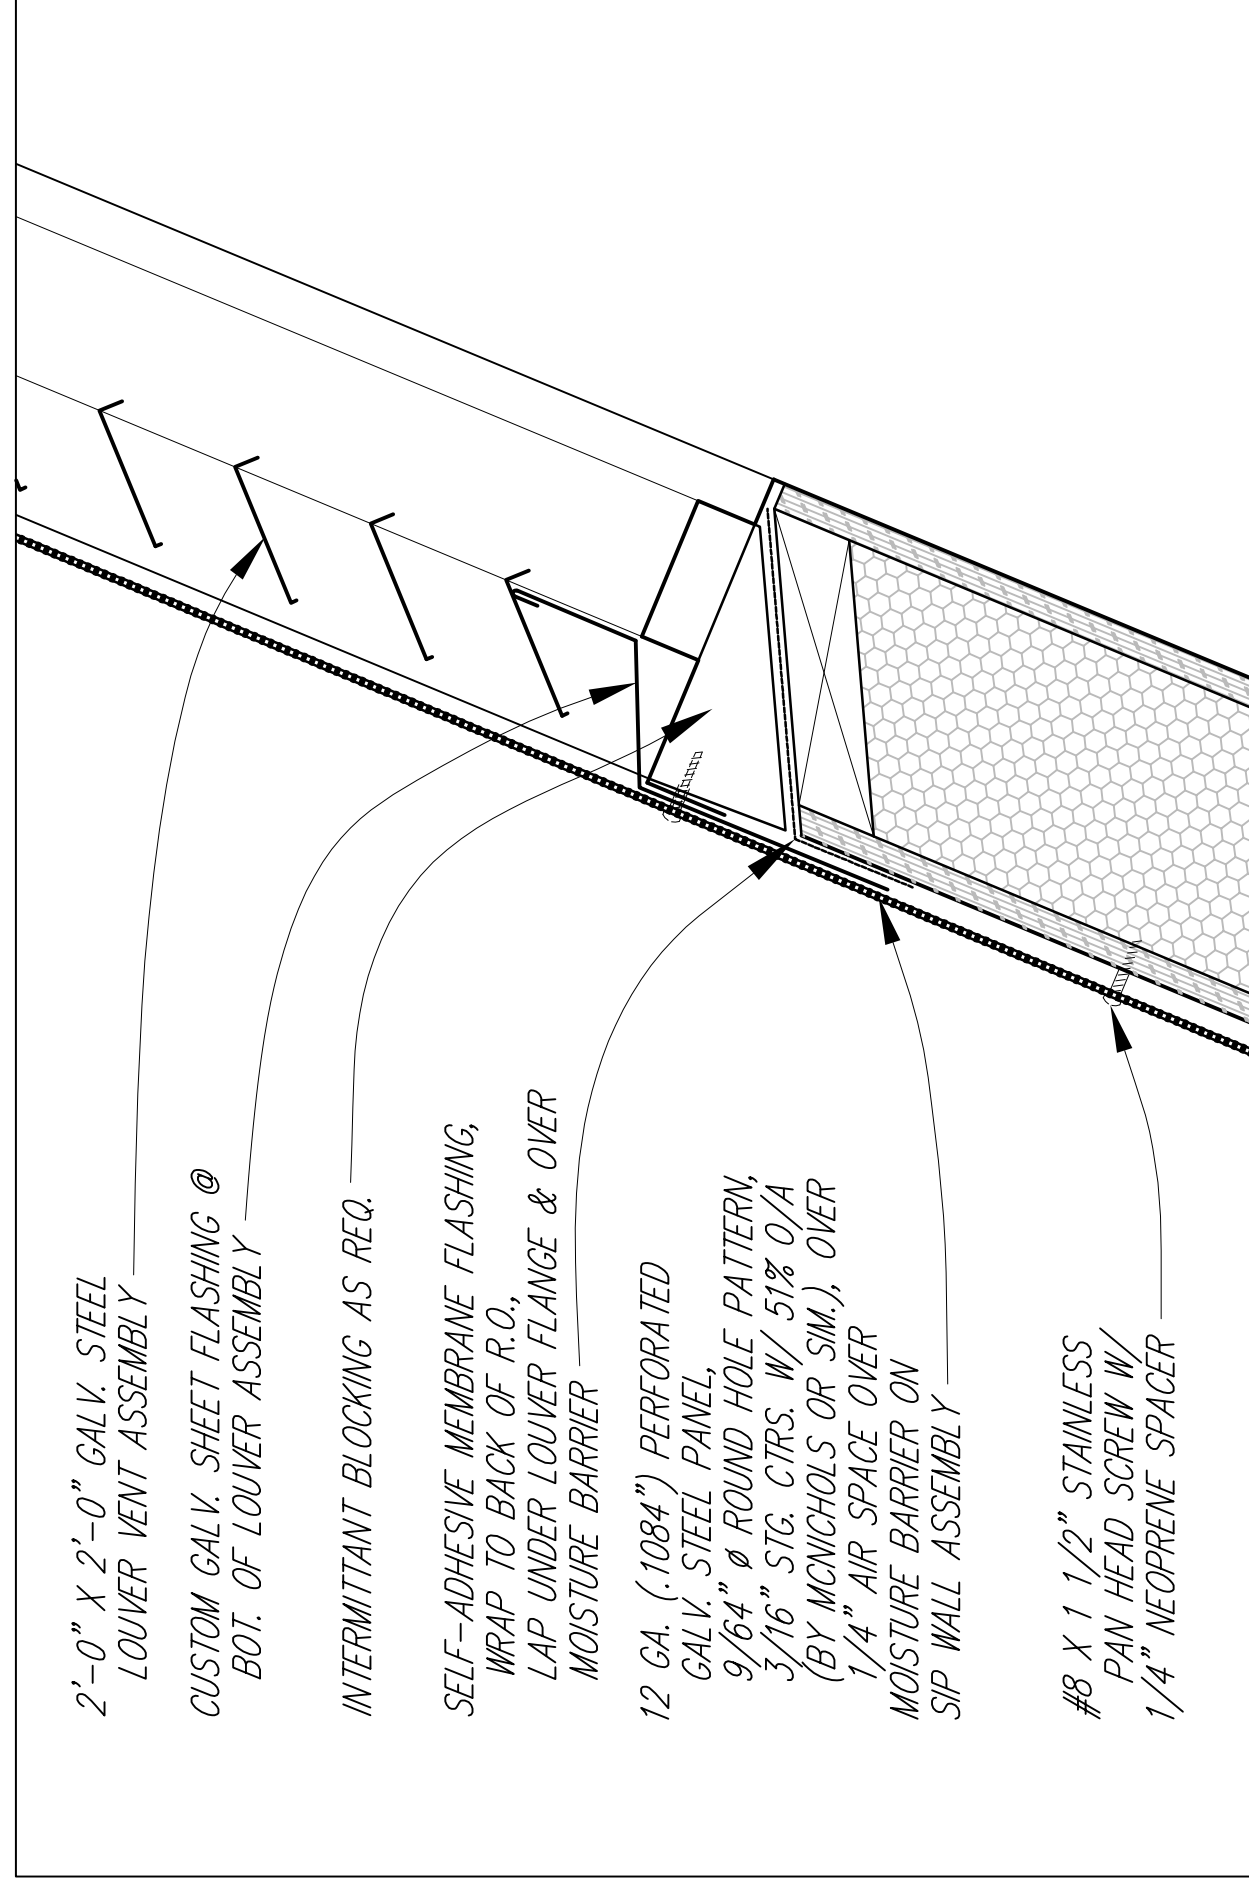


2 LOUVER SILL @ MECH. ATTIC

3" = 1'-0"



Drawn by	Date
J. Rely	August 7, 2007
Revised	Date
N. Sanders	January 9, 2008

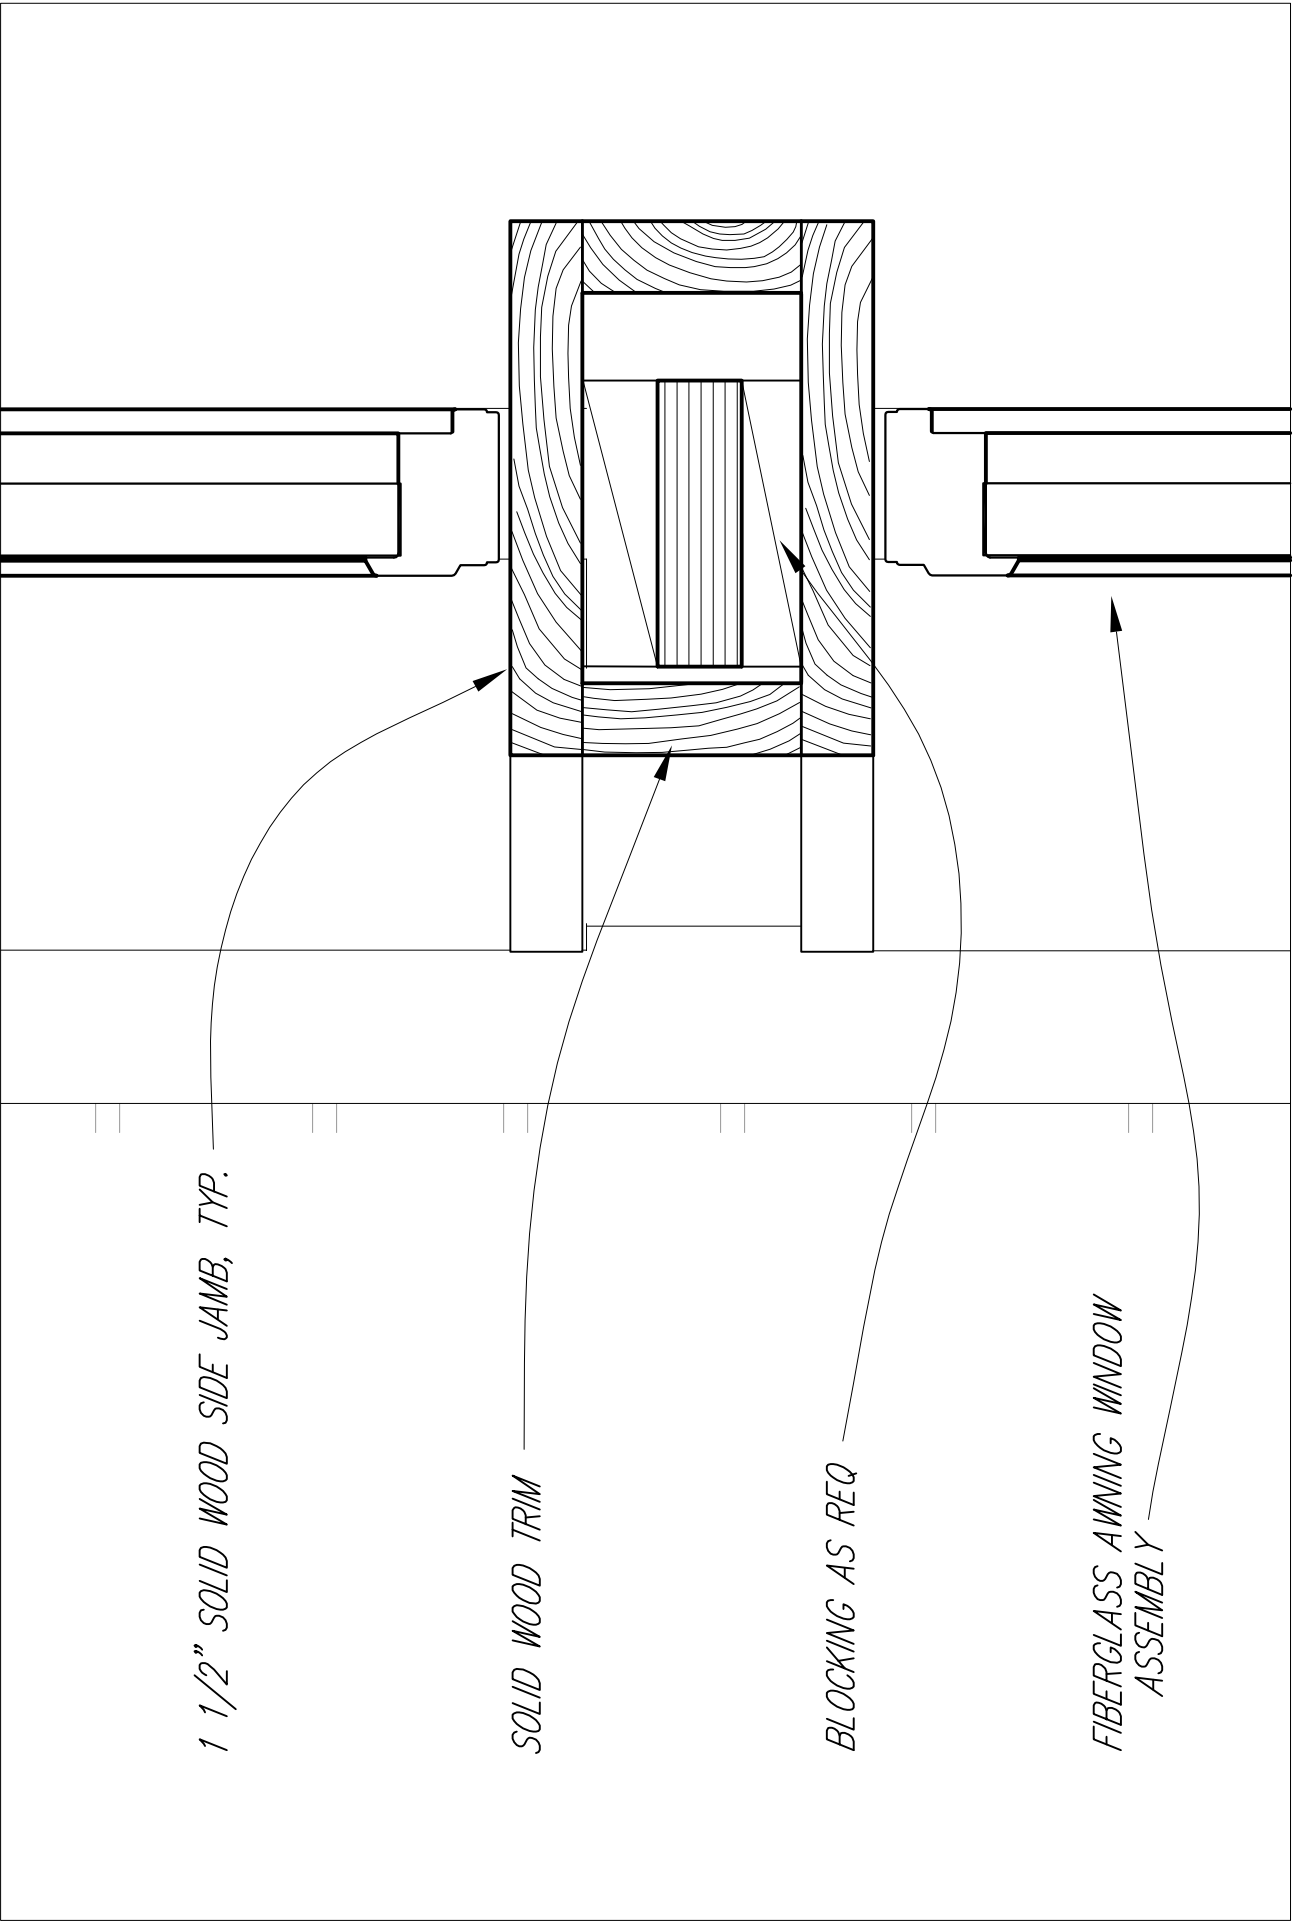


Lower Clerestory Window Jamb Detail


1 3" - 1'-0"




Drawn by	Date
N. Sanders	August 7, 2007
Revised	Date
N. Sanders	January 9, 2008

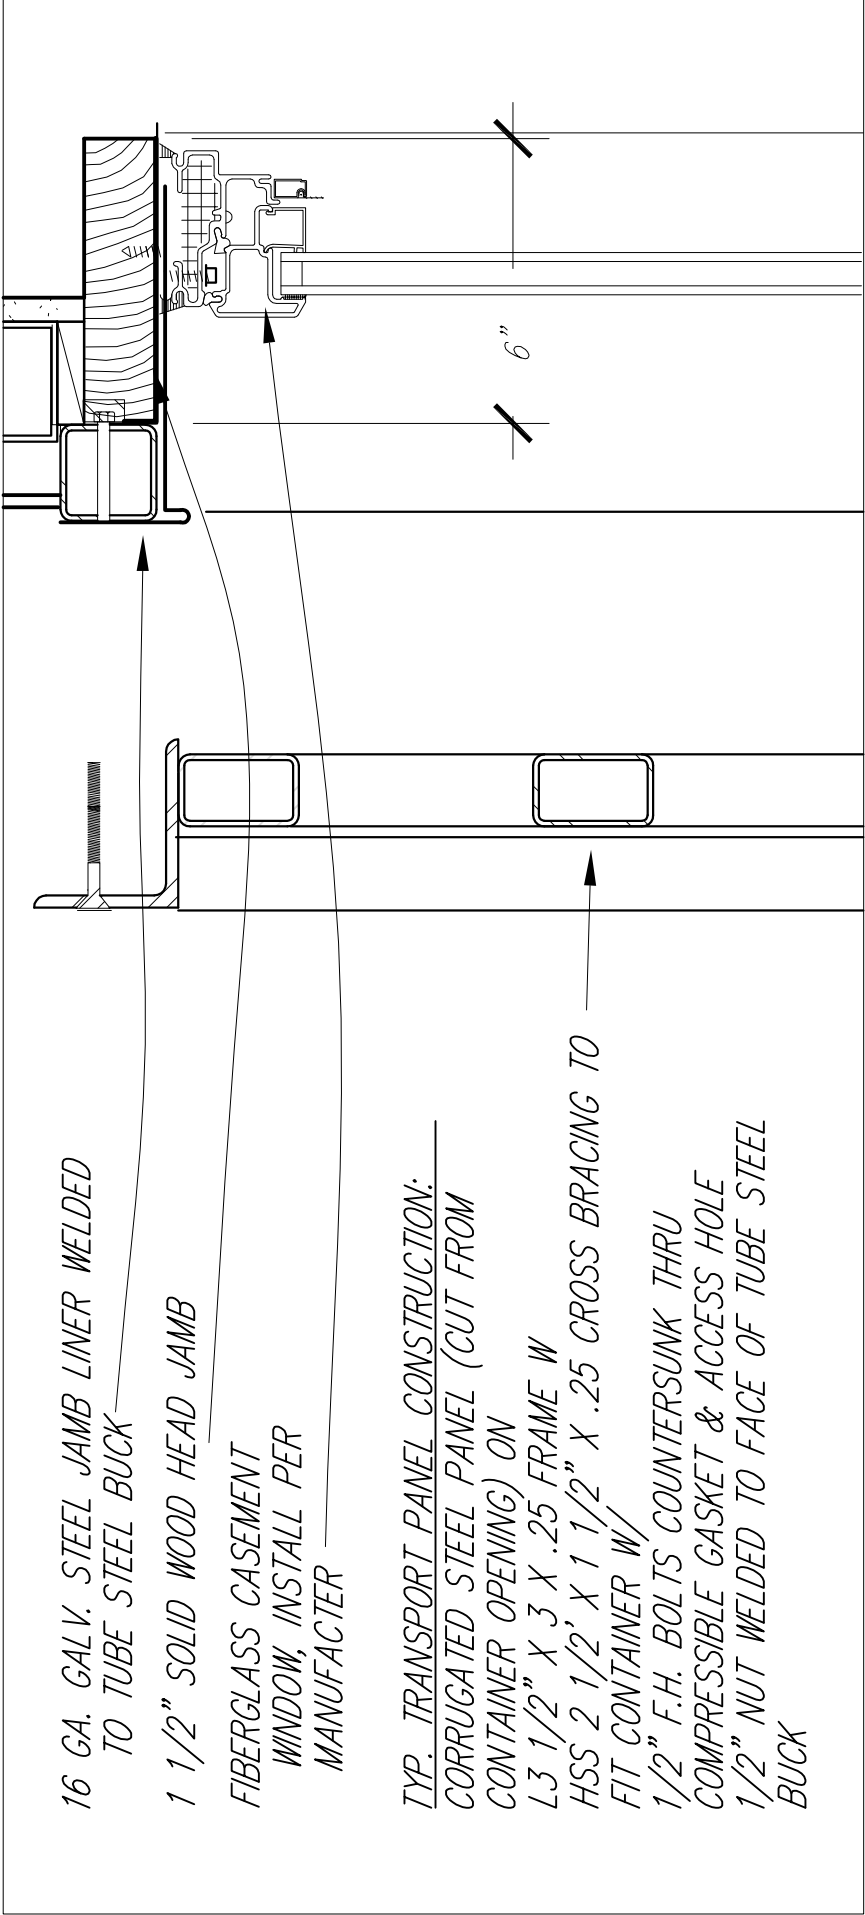

① S.C. Window Head Detail

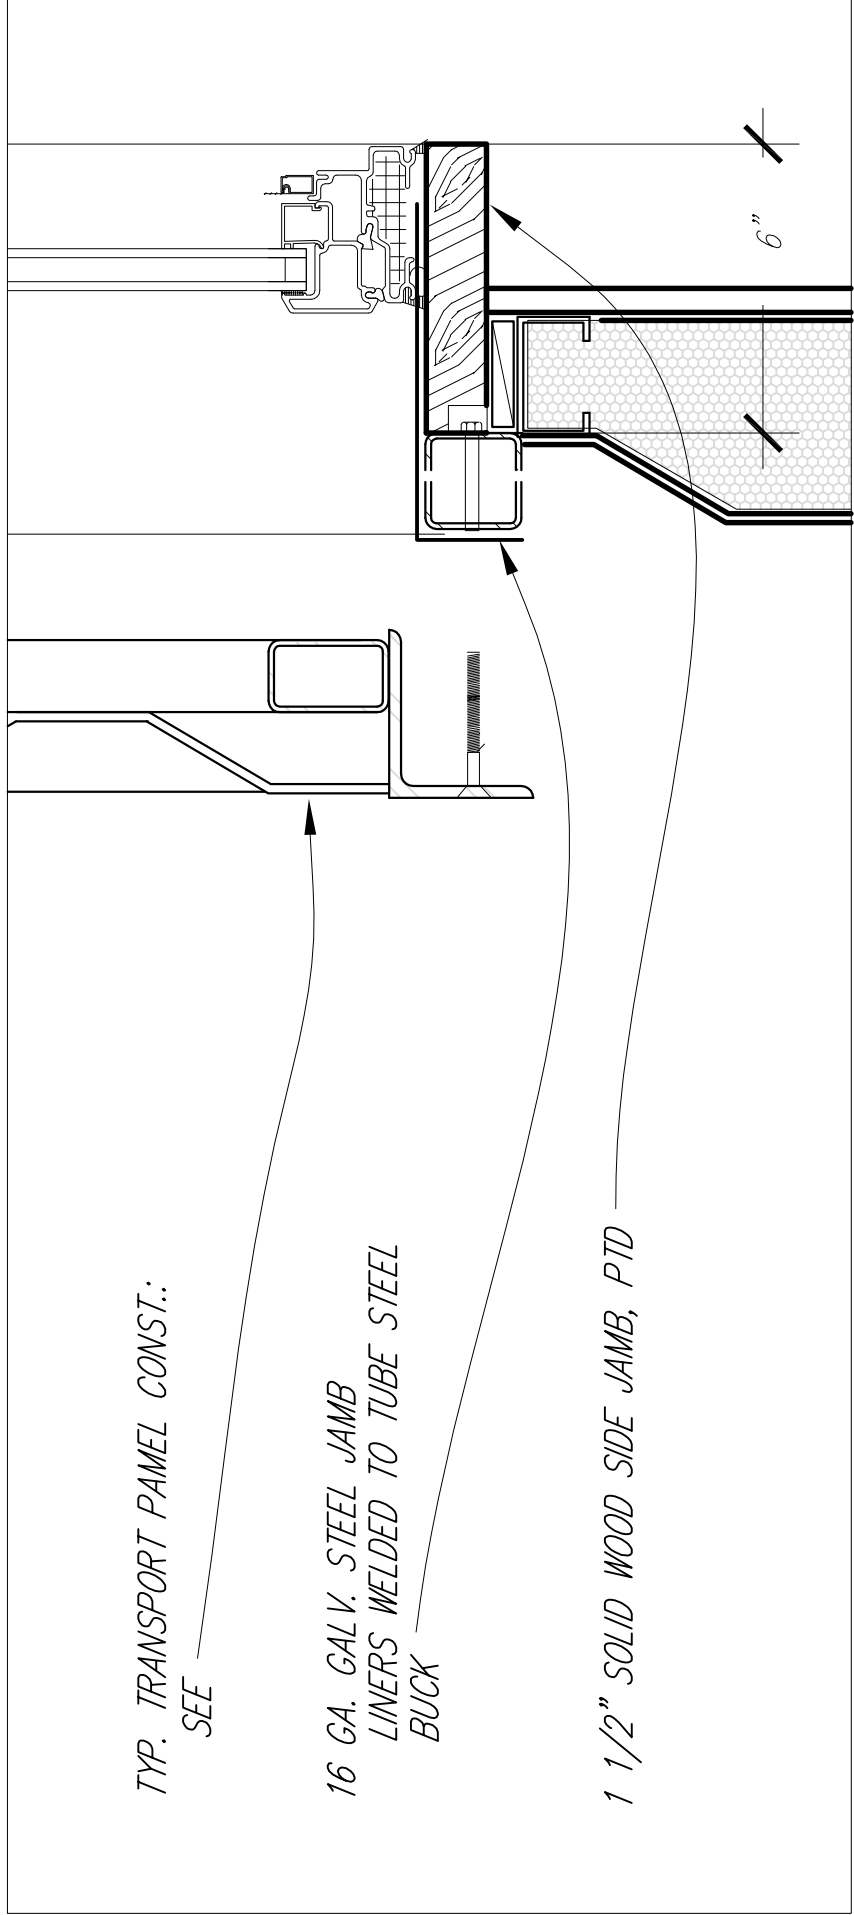


② S.C. Window Jamb Detail

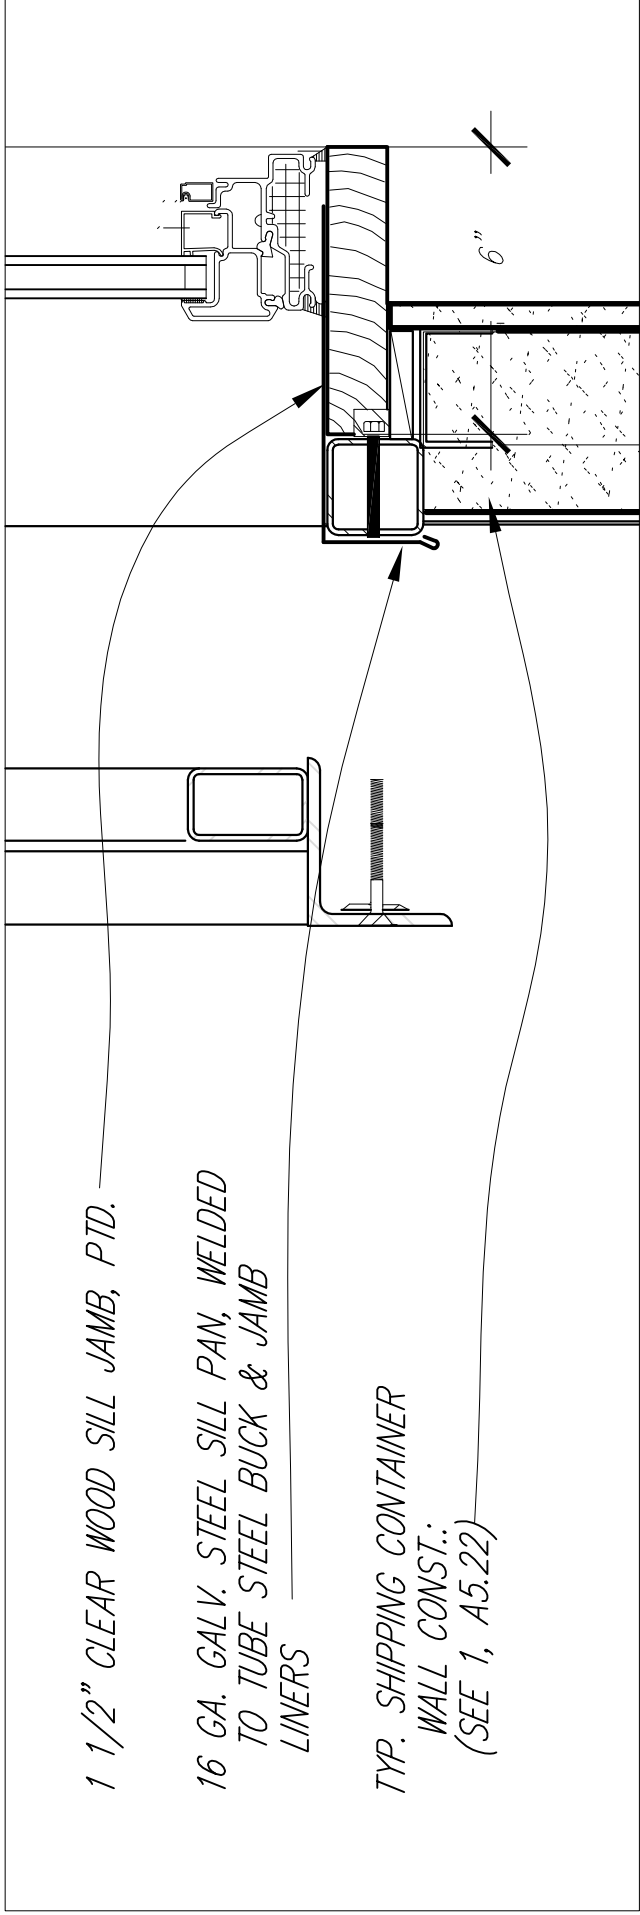


③ S.C. Window Jamb Detail



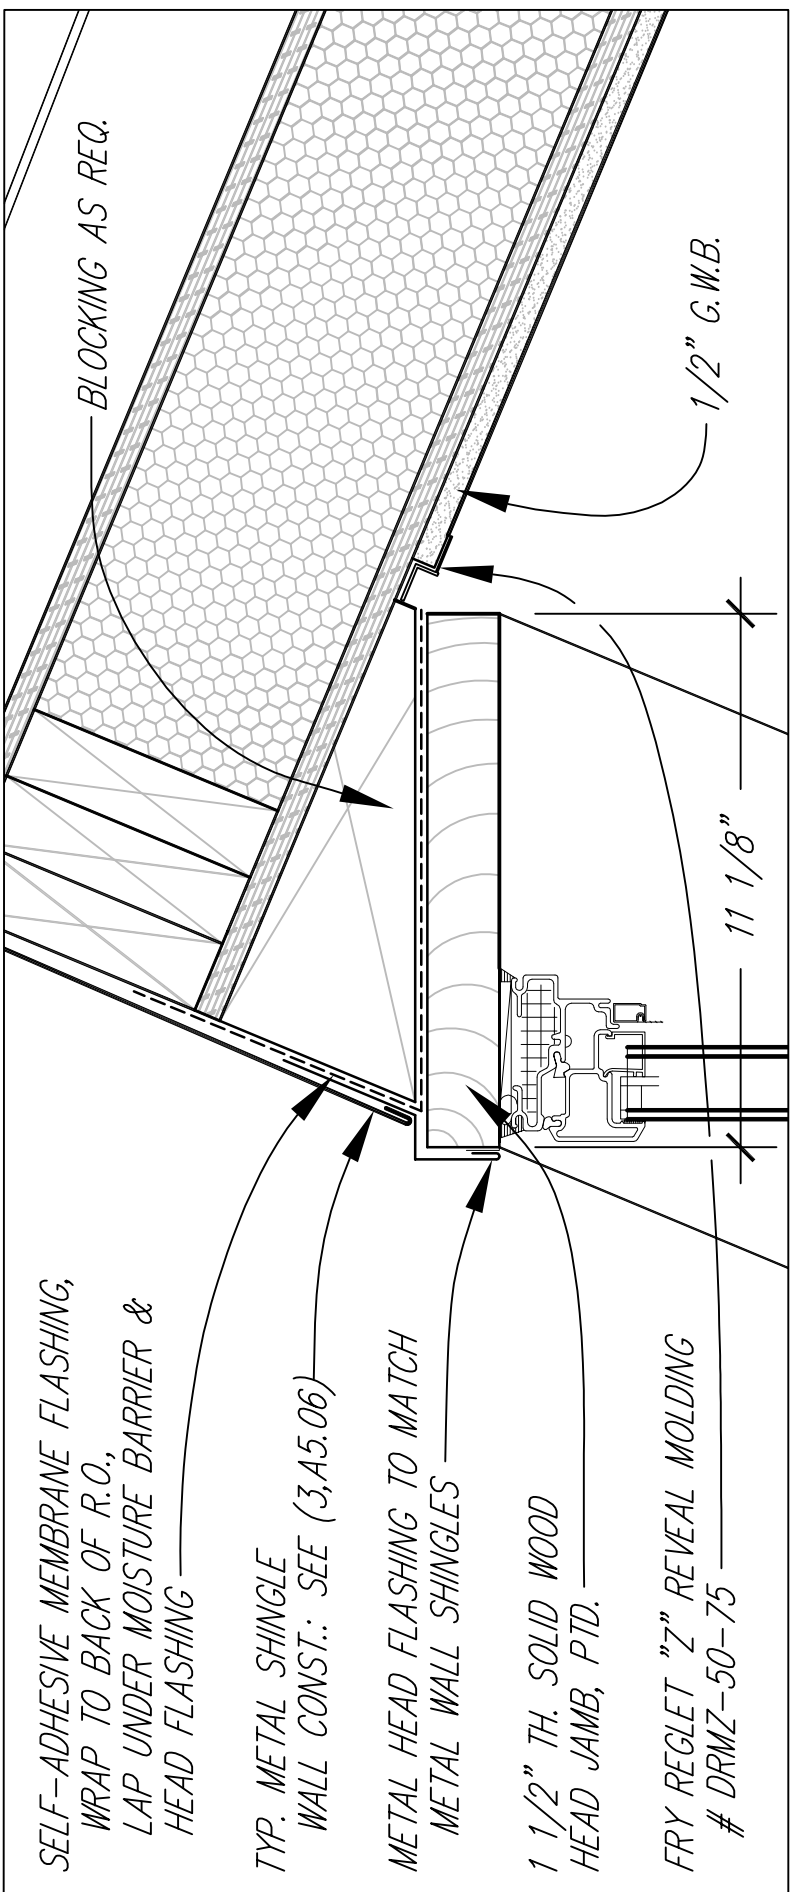


1 WINDOW HEAD @ LOFT CLERESTORY

3" = 1'-0"

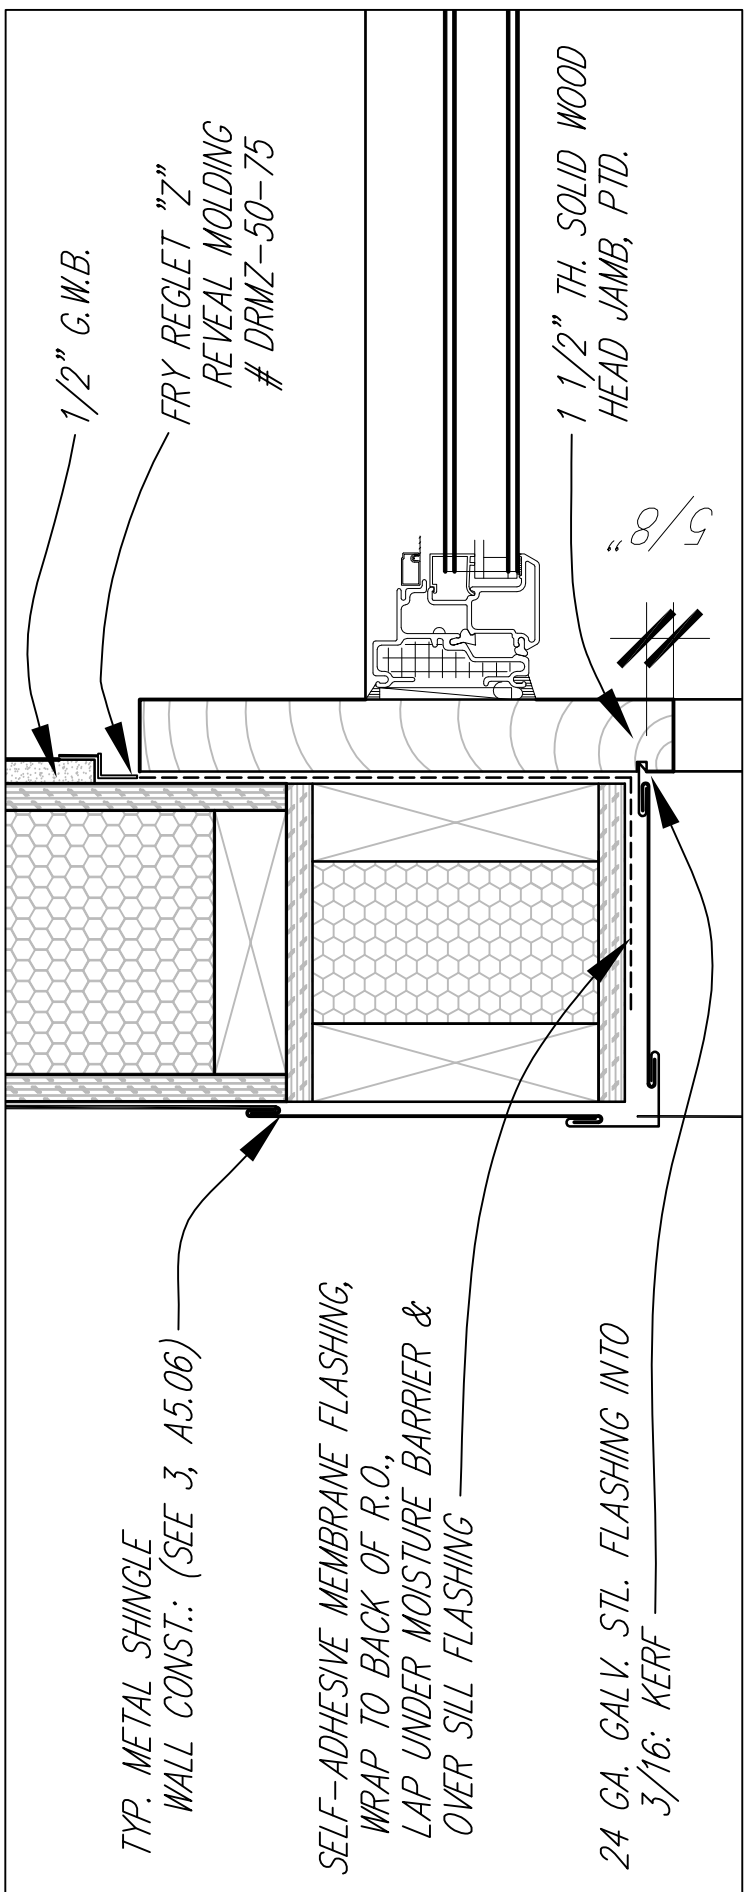

2 JAMB DETAIL @ LOFT CLERESTORY

3" = 1'-0"

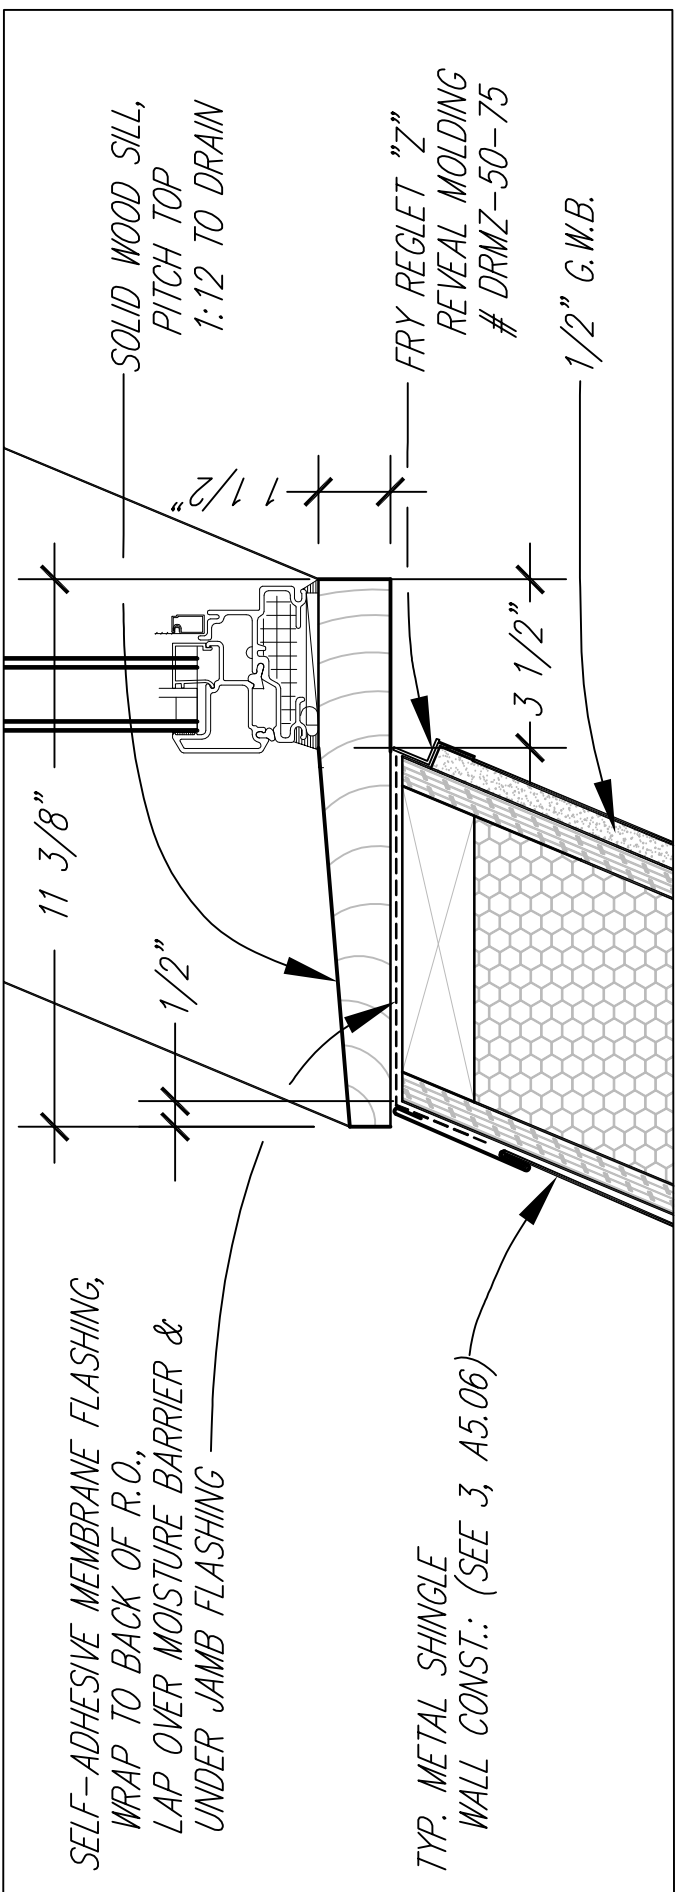


3 WINDOW SILL @ LOFT CLERESTORY

3" = 1'-0"






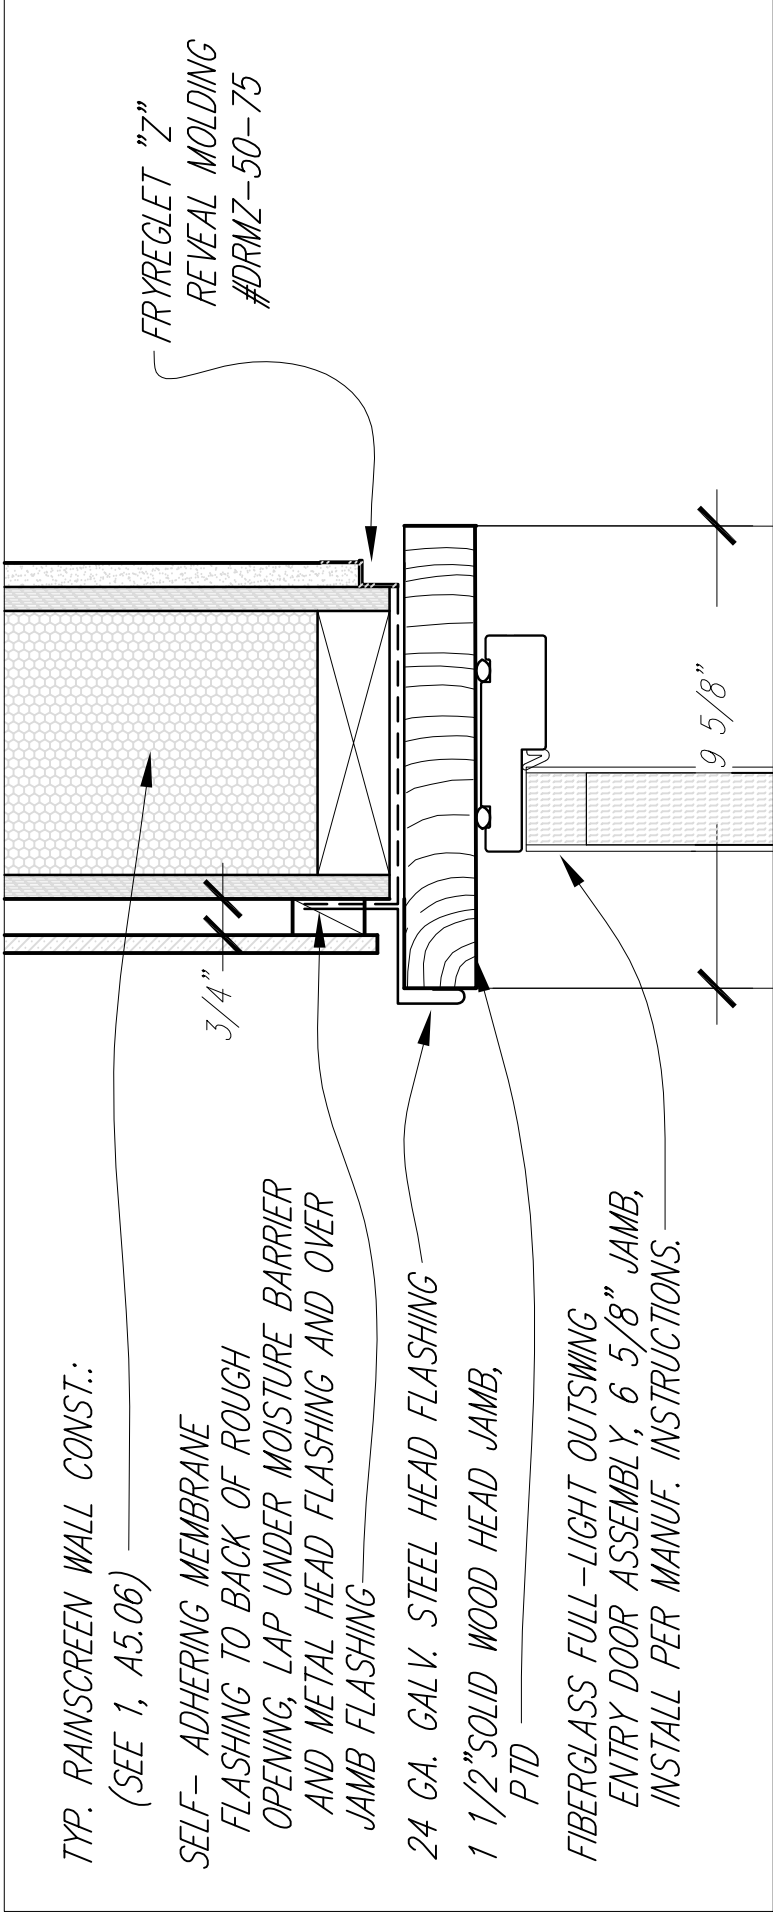


1 BEDROOM DOOR HEAD DETAIL

3" - 1'-0"

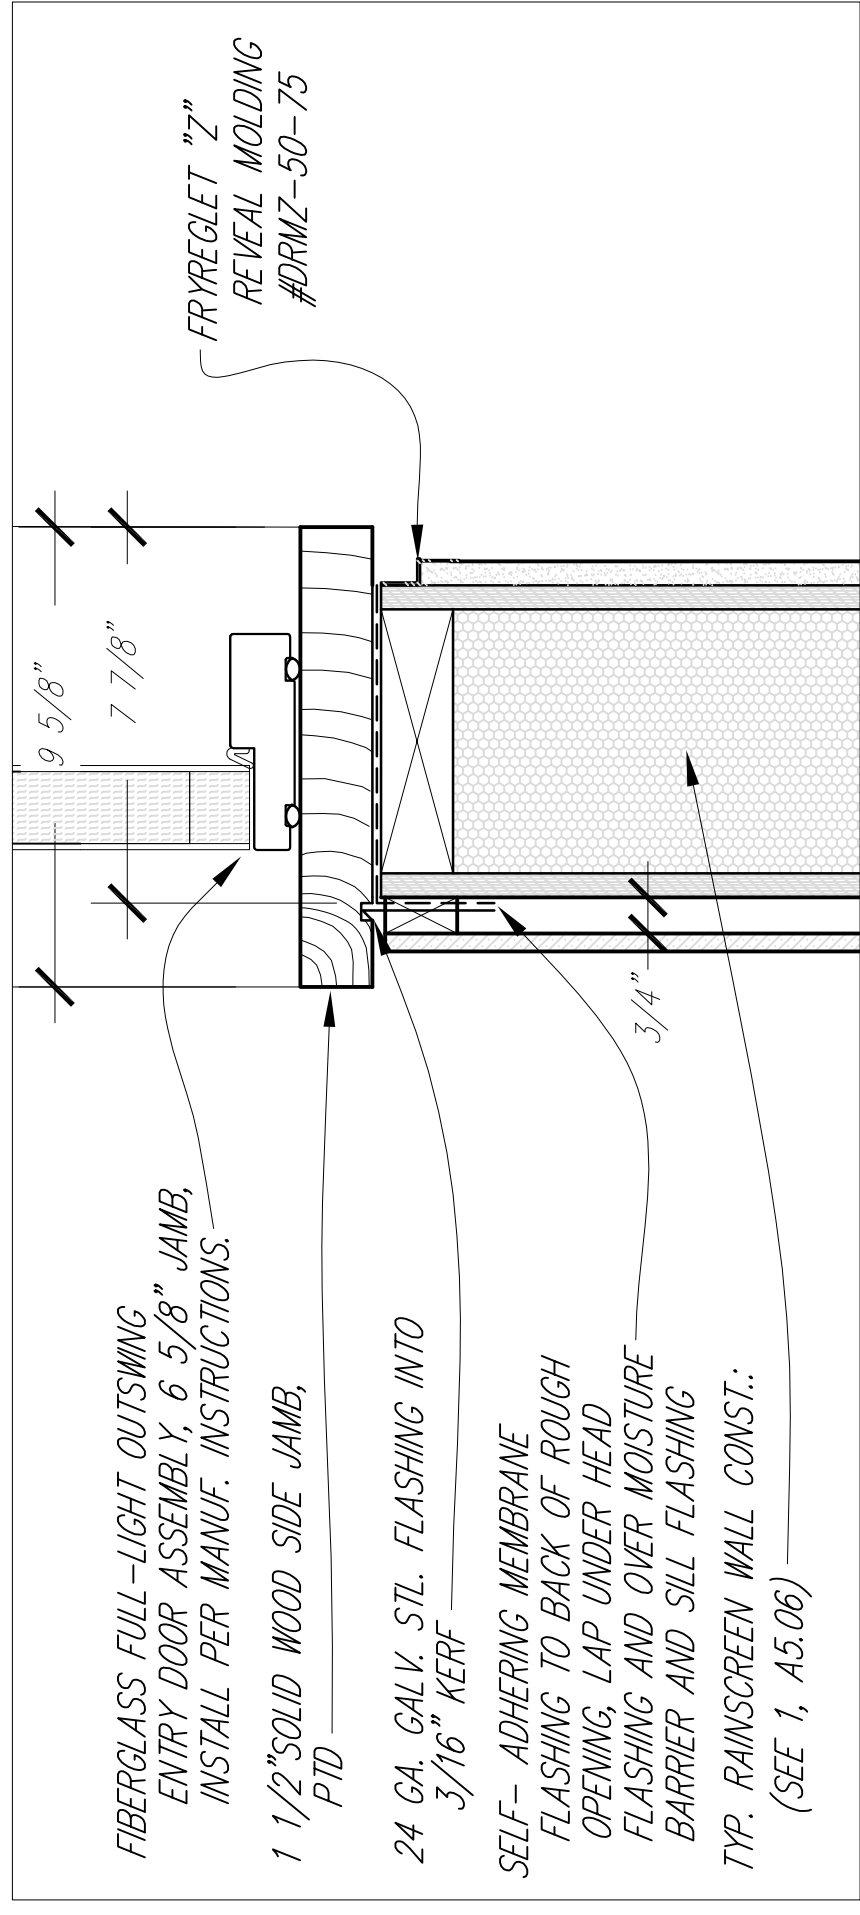

2 BEDROOM DOOR JAMB DETAIL

3" - 1'-0"

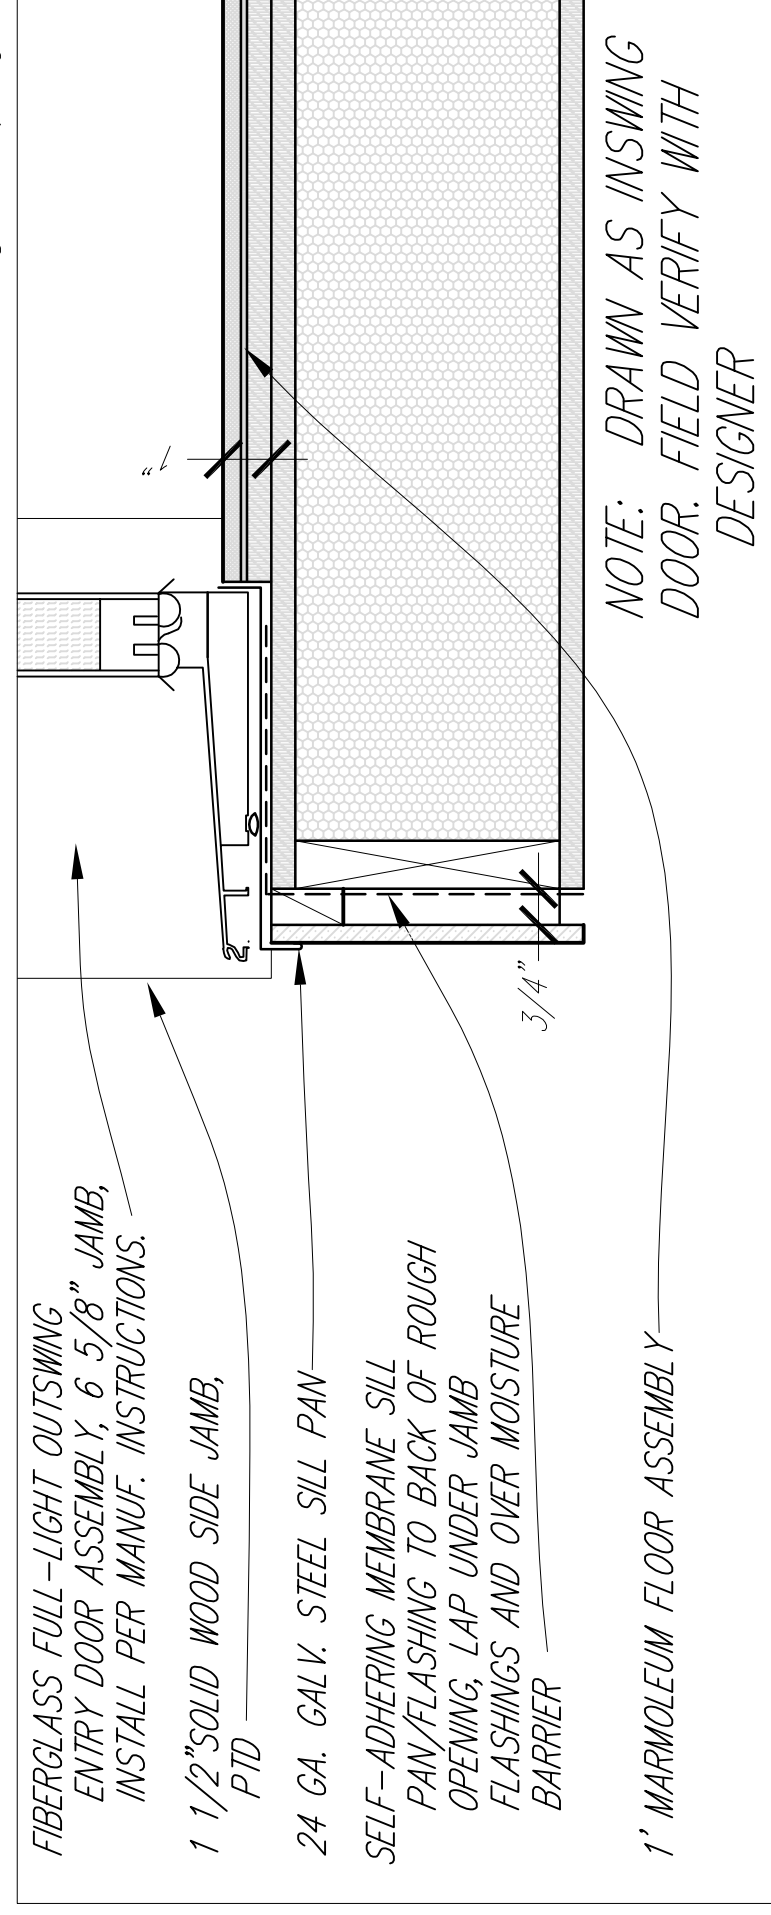


3 BEDROOM DOOR SILL DETAIL

3" - 1'-0"




Drawn by	Date
N. Sanders	August 7, 2007
Revised	Date
N. Sanders	January 9, 2008

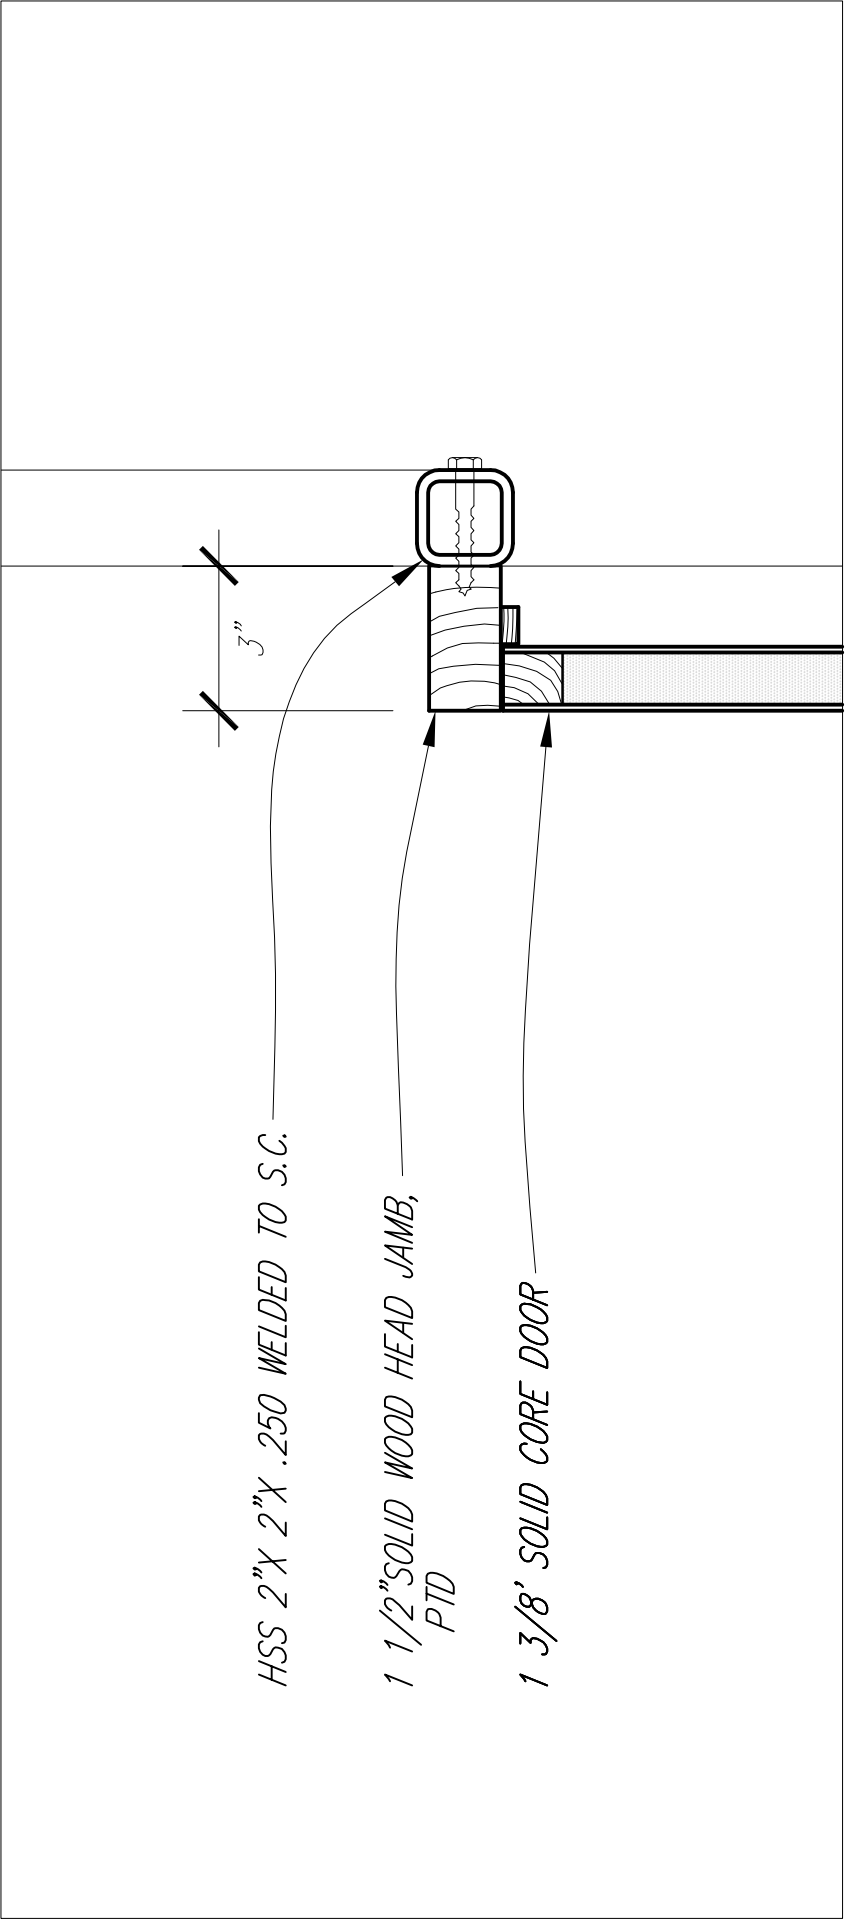

1 BEDROOM DOOR TO S.C. HEAD DETAIL

3" - 1'-0"

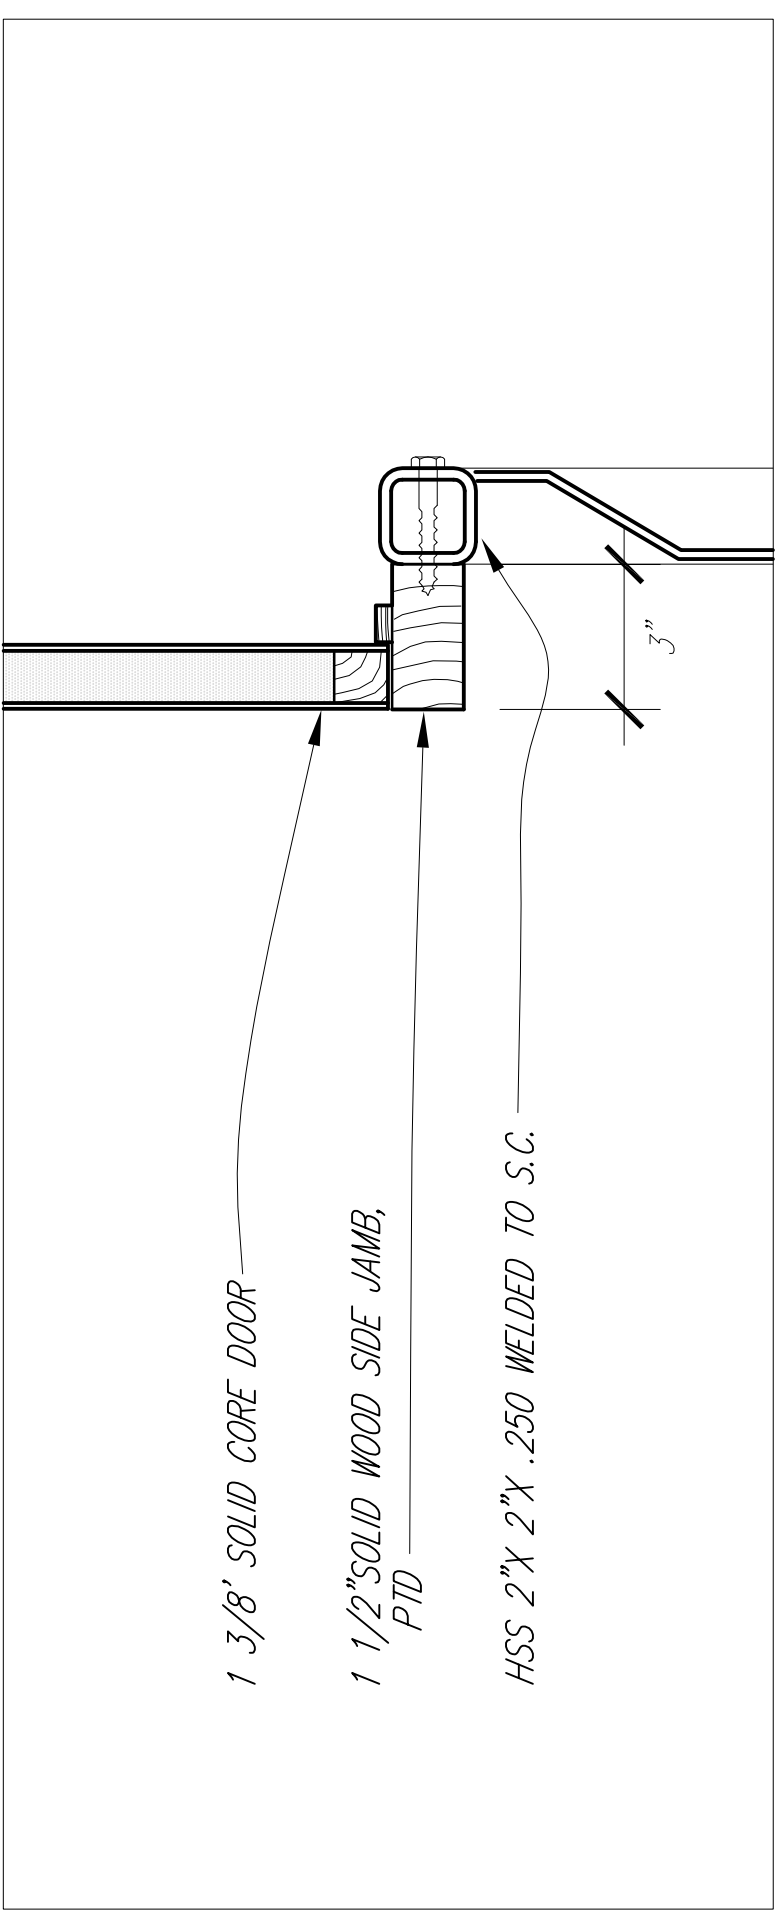


2 BEDROOM DOOR TO S.C. JAMB DETAIL

3" - 1'-0"




Drawn by	Date
N. Sanders	August 7, 2007
Revised	Date
N. Sanders	January 9, 2008



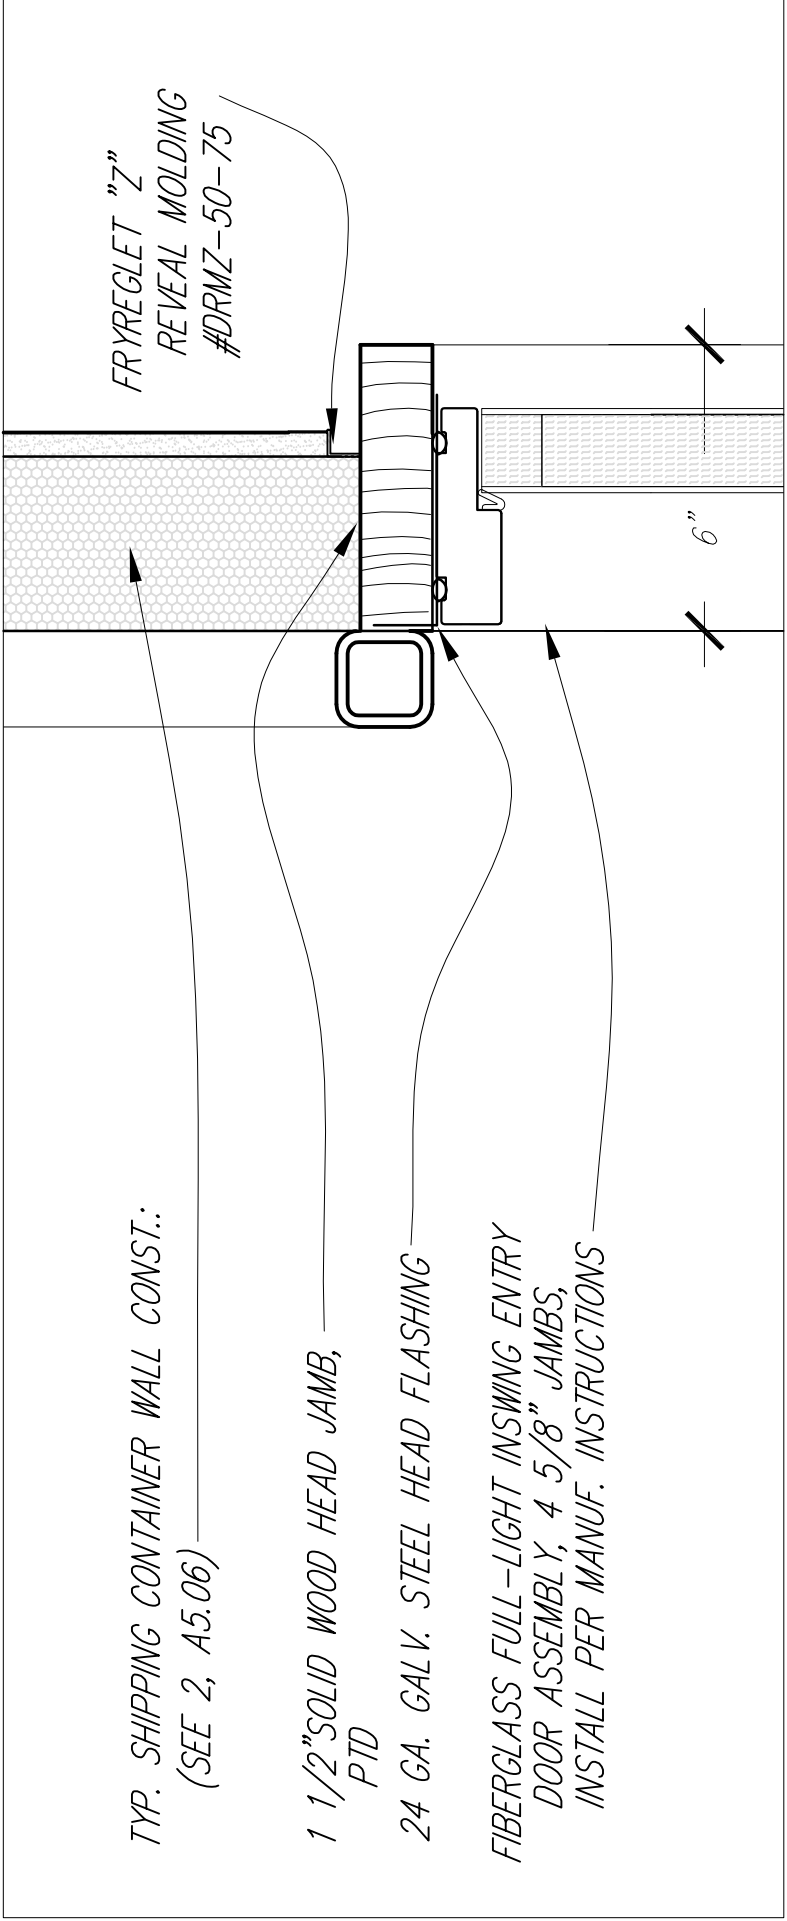


**1** FRONT DOOR HEAD DETAILS

3" - 1'-0"

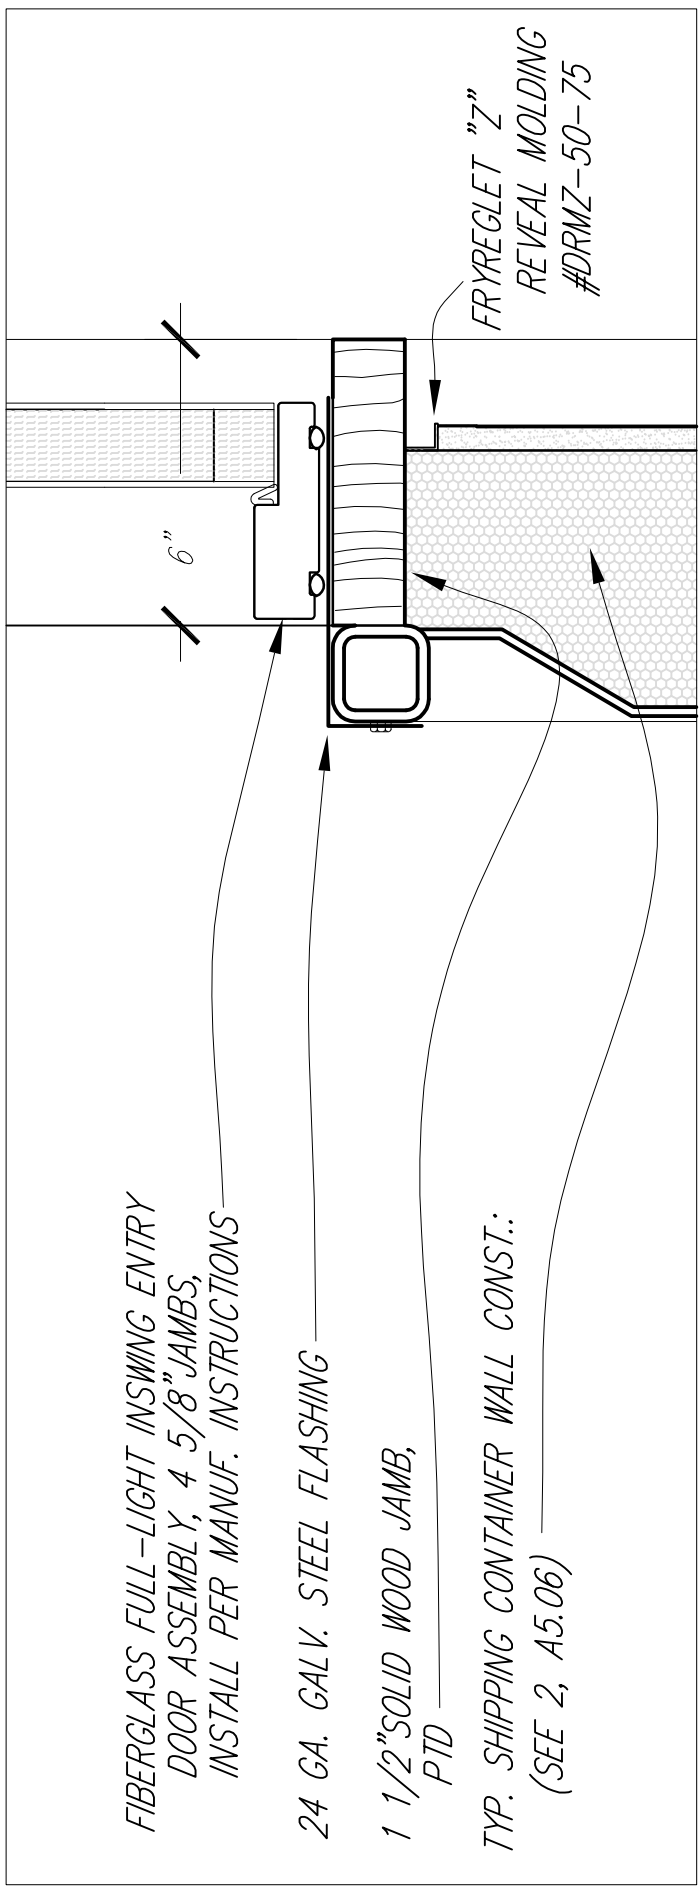


**2** FRONT DOOR JAMB DETAILS

3" - 1'-0"

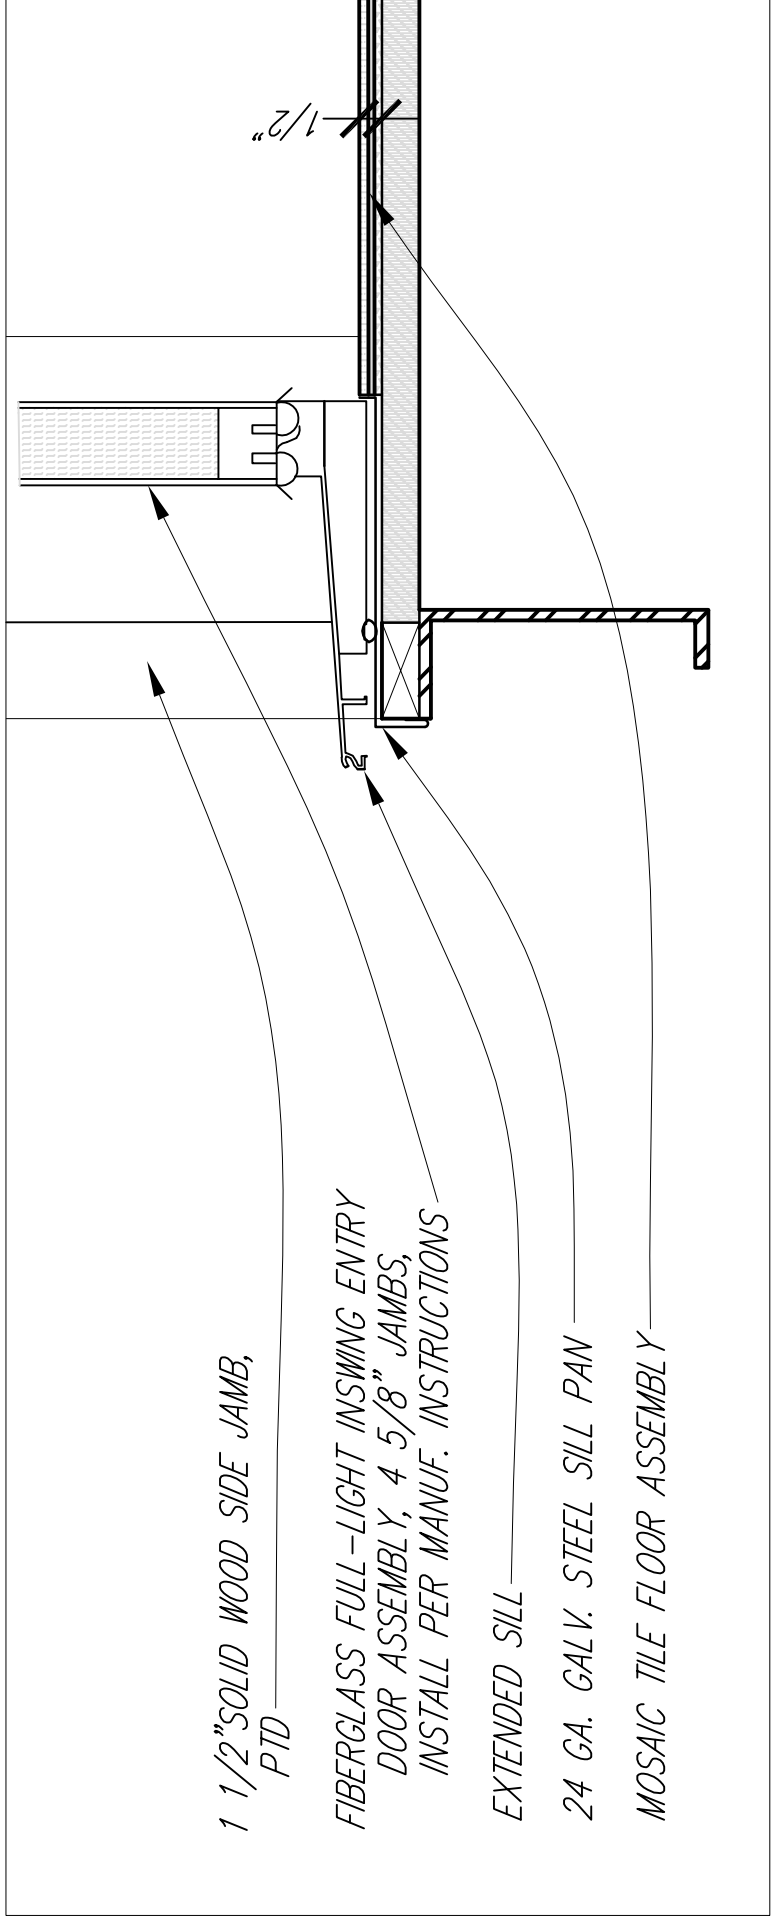


**3** FRONT DOOR SILL DETAILS

3" - 1'-0"

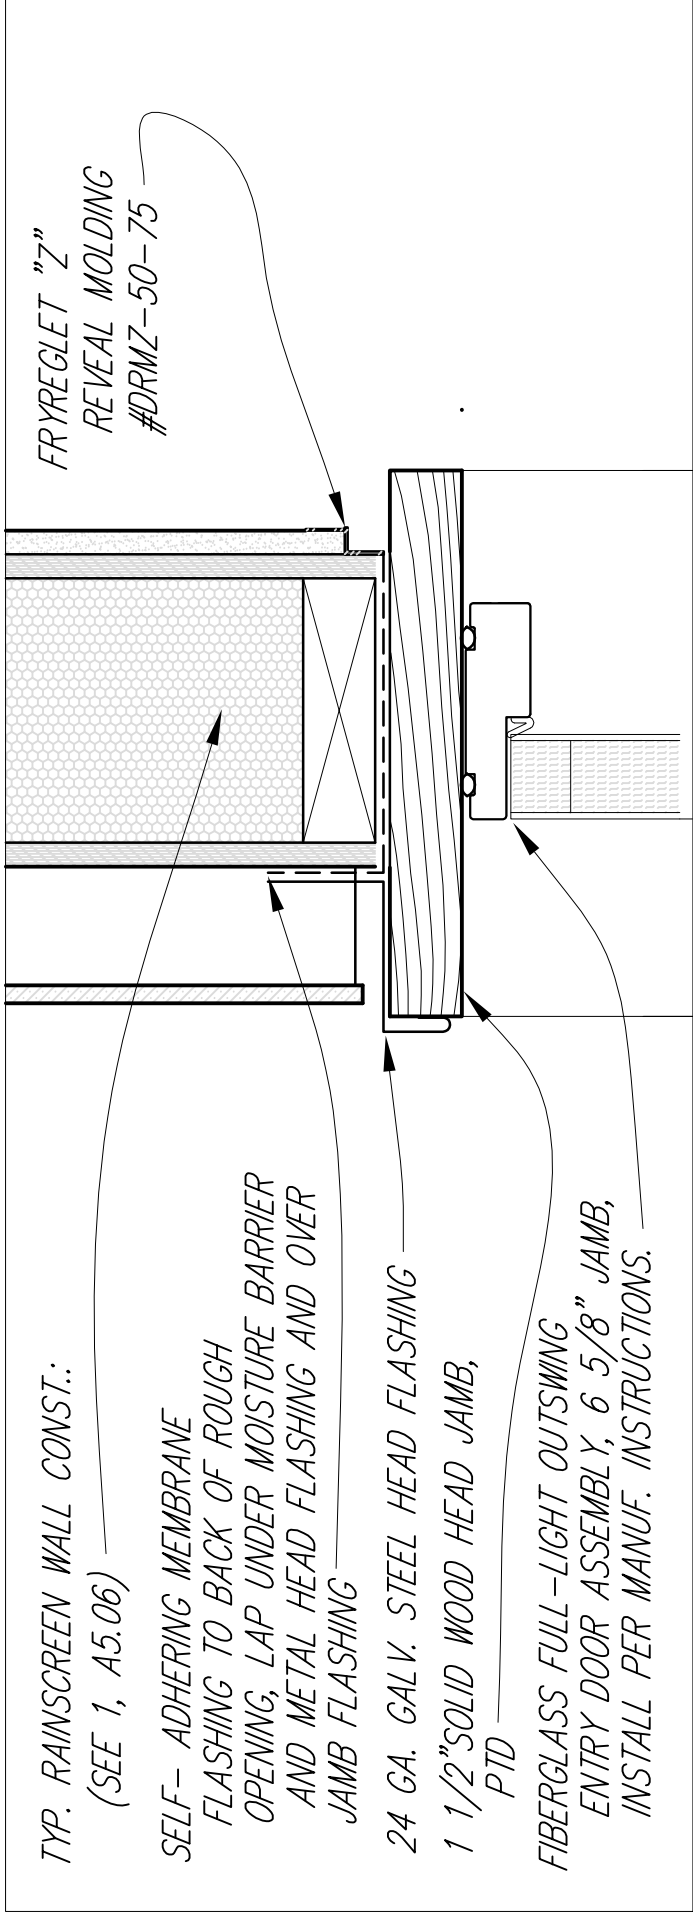


1 WEST DOOR HEAD DETAILS

3" - 1'-0"

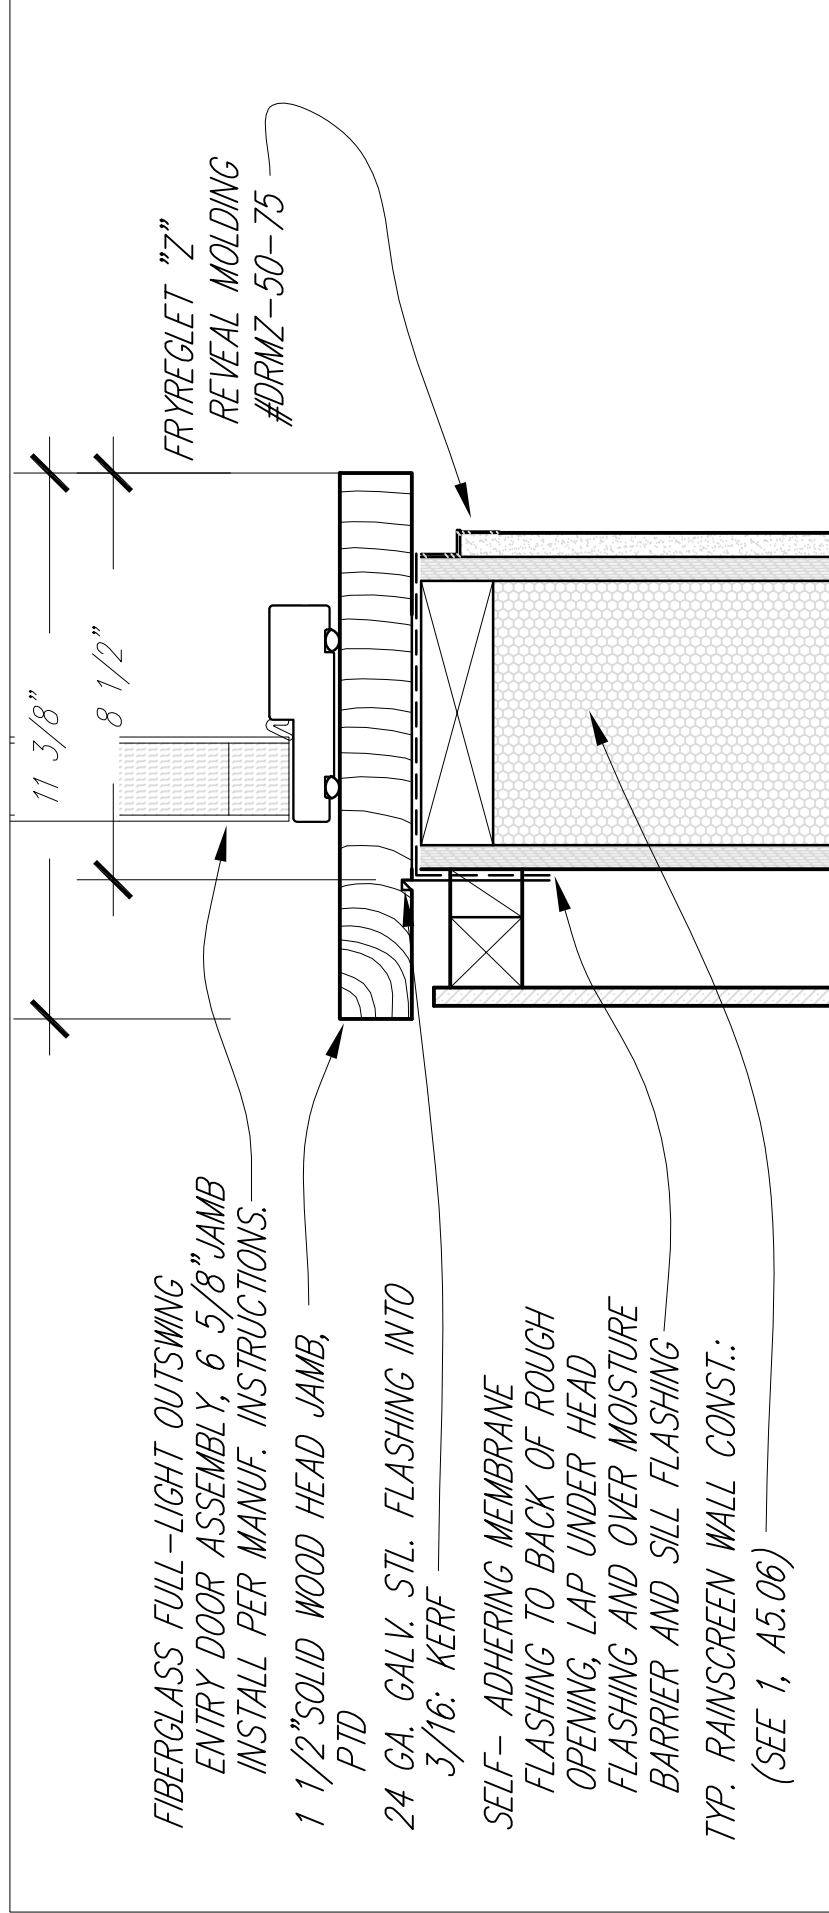


2 WEST DOOR JAMB DETAILS

3" - 1'-0"

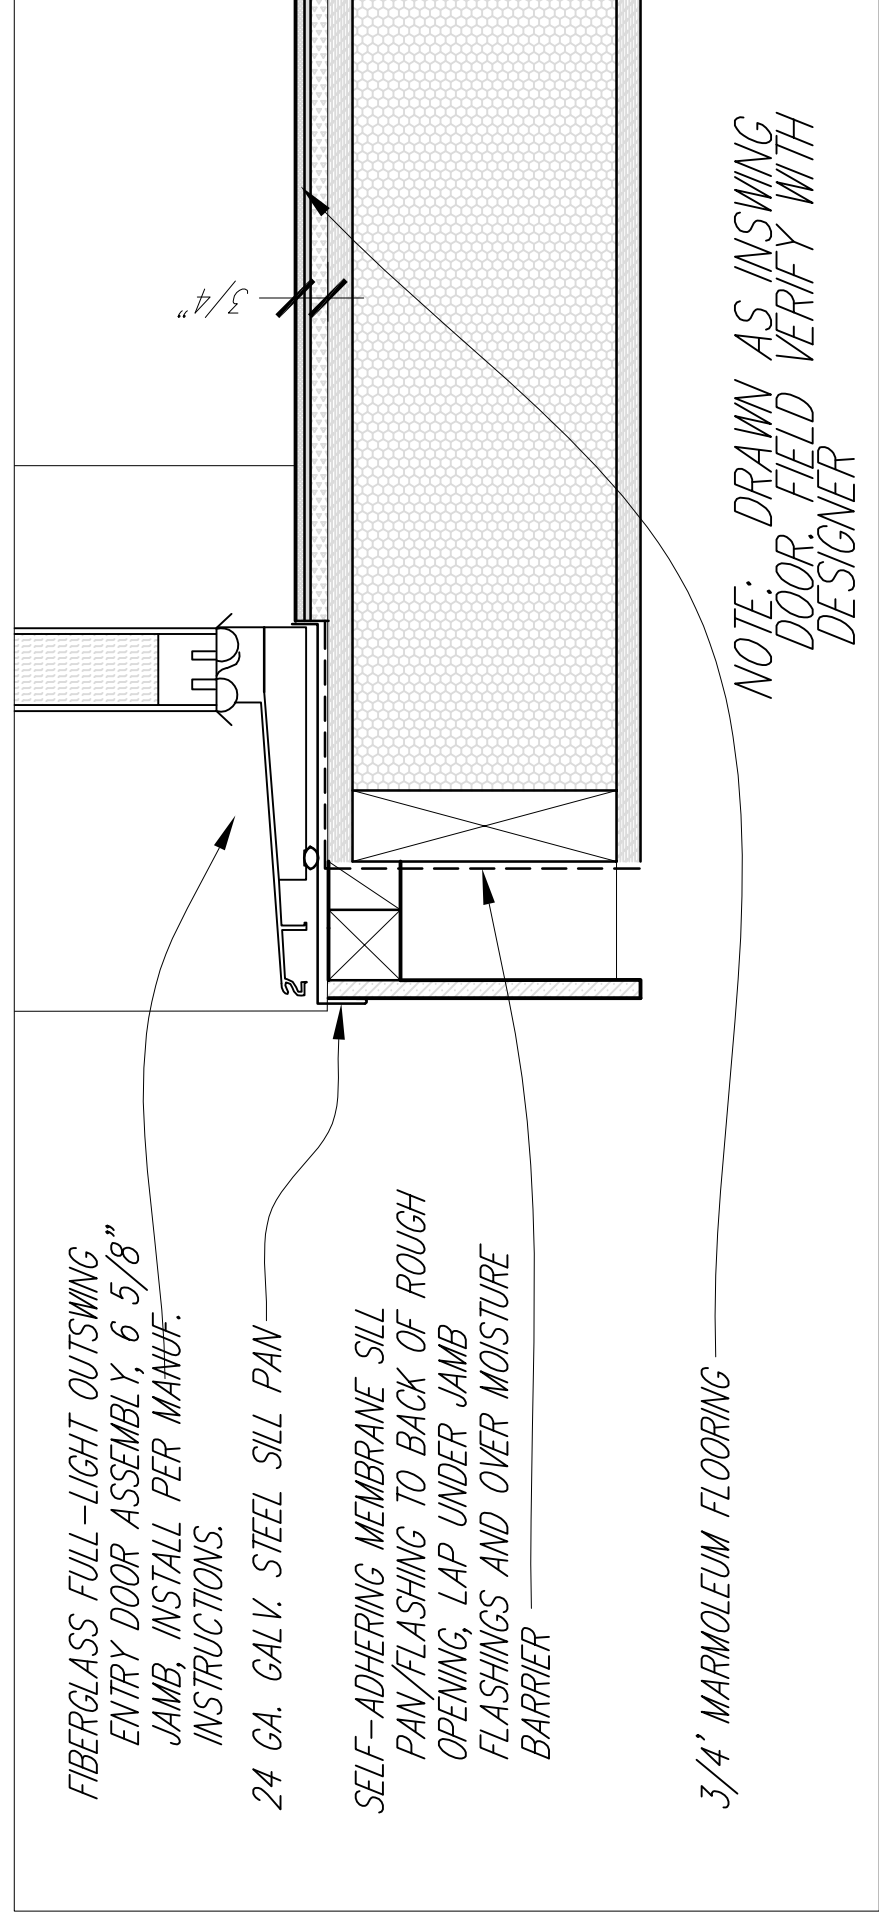


3 WEST DOOR SILL DETAILS

3" - 1'-0"

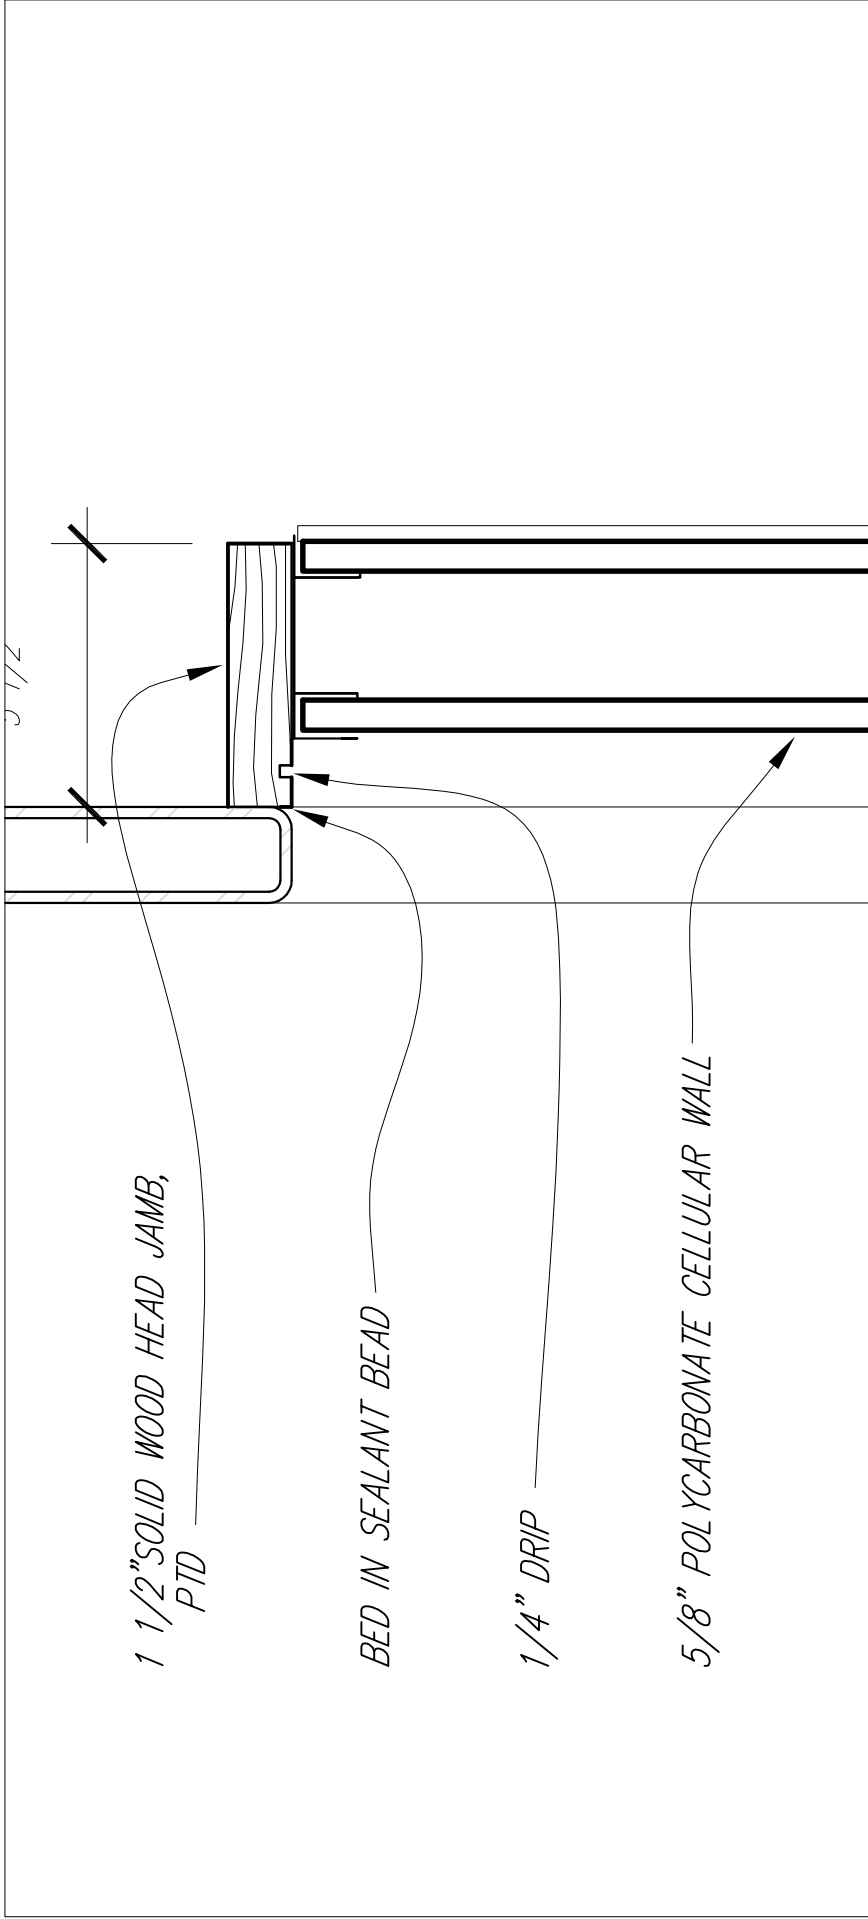


1 POLYGAL WALL HEAD DETAILS

3" - 1'-0"

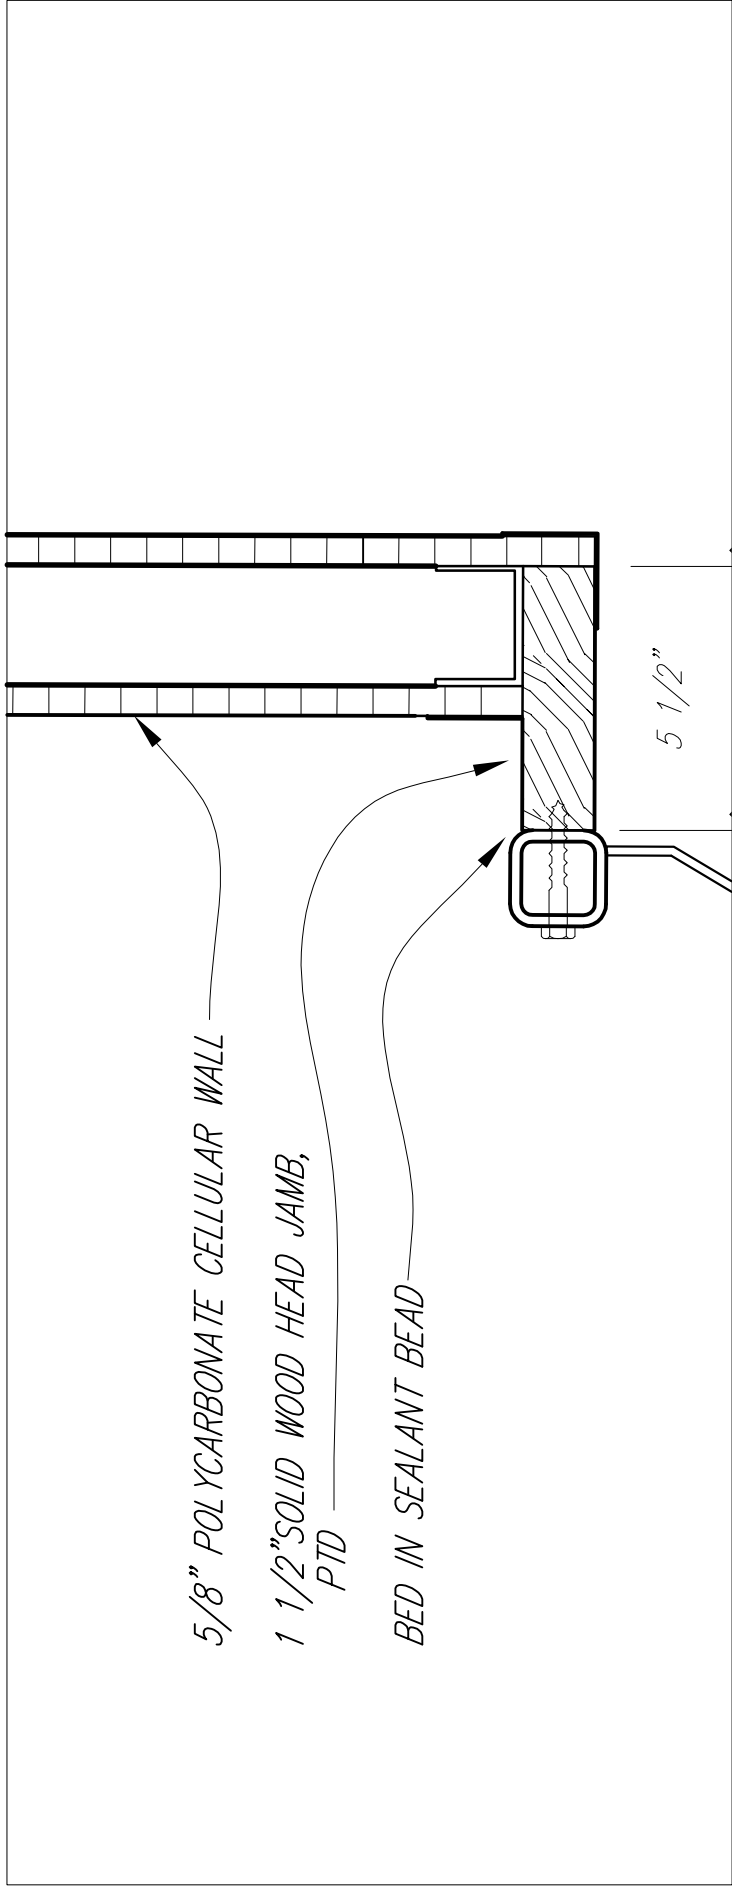


2 POLYGAL WALL JAMB DETAILS

3" - 1'-0"

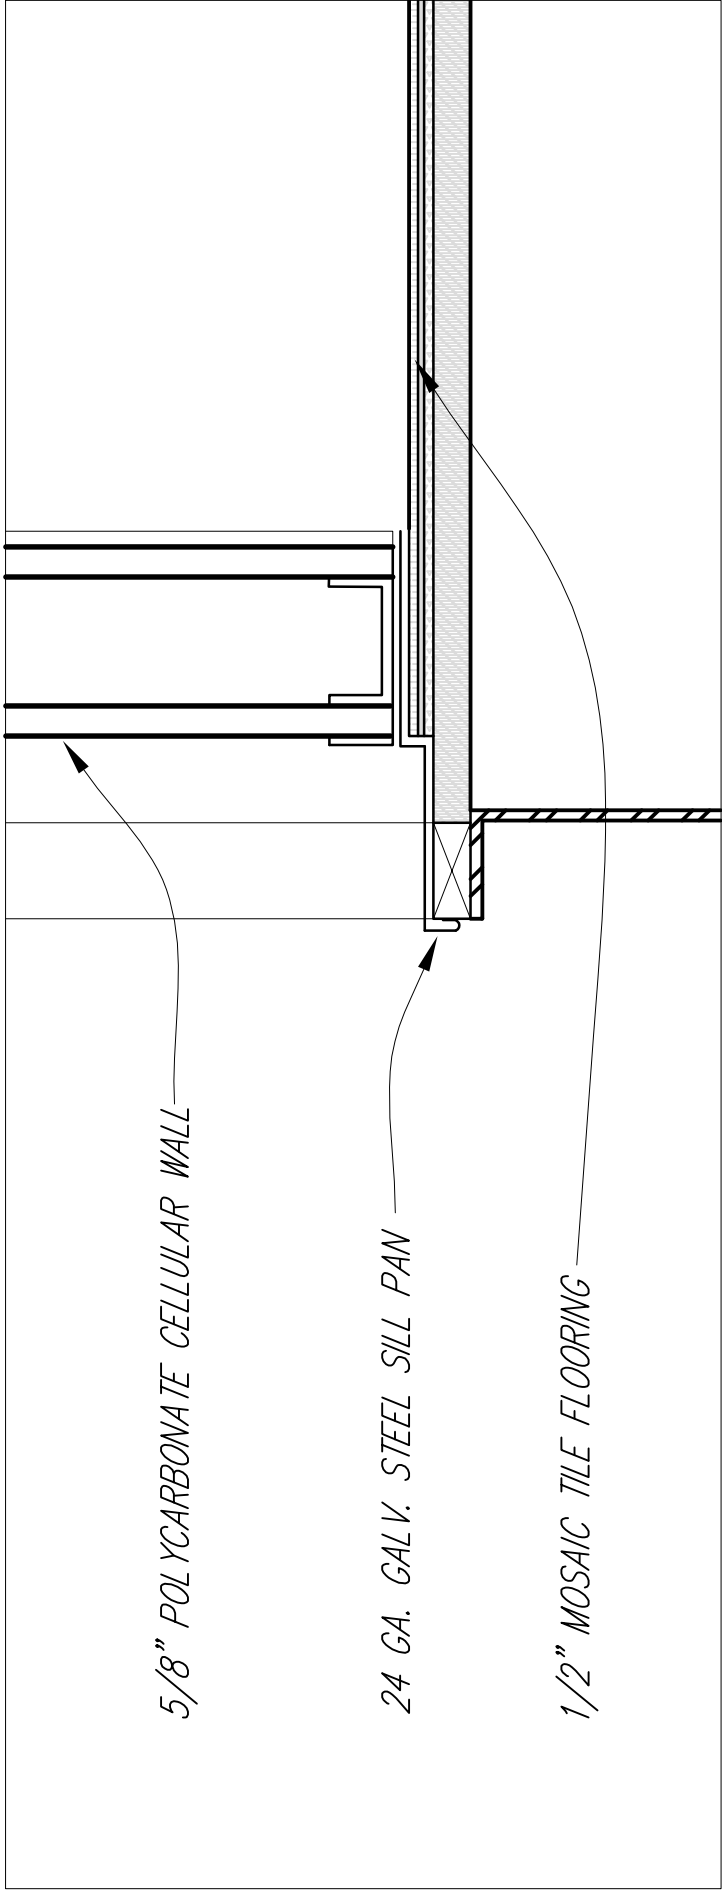

3 POLYGAL WALL SILL DETAILS

3" - 1'-0"

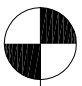B.O. FINISH CEILING 7'-11" 

1'-11"

MECHANICAL SOFFIT CONSTRUCTION:  
LIGHT-GAUGE STEEL-FRAMED  
SOFFIT W/

3/4" FLAT-GRAIN, 3-PLY VERTICAL CROSS  
CORE BAMBOO PLYWOOD, STAIN FINISH,  
LOW-VOC TYP. FLUSH FACE

TYP. FLUSH, FULL-OVERLAY  
DOOR/DRAWER FRONT CONSTRUCTION:  
3/4" FLAT-GRAIN, 3-PLY VERTICAL CROSS  
CORE BAMBOO PLYWOOD, STAIN  
FINISH, LOW-VOC TYP. W/  
HAFELE ZINC NICHEL-PLATED FLUSH  
HANDLE #151.09.609

ADJUSTABLE SHELF

7'-0"

2'-1 5/8"

3 1/4"

2'-10"


LOWER CASE CONSTRUCTION AT LAUNDRY  
CLOSET:  
FRAMELESS, BOTTOMLESS, 3/4"  
FORMALDEHYDE-FREE MDF CARCASE,  
PAINT FINISH (LOW VOC TYP.) W/  
1/4" FORMALDEHYDE-FREE MDF BACK, PAINT  
FINISH

I.O. FINISH FLOOR 0'-0" 

1 KITCHEN SECTION A-A  
1 1/2" = 1'-0"



Drawn by	Date
A.Rude	August 7, 2007
Revised	Date

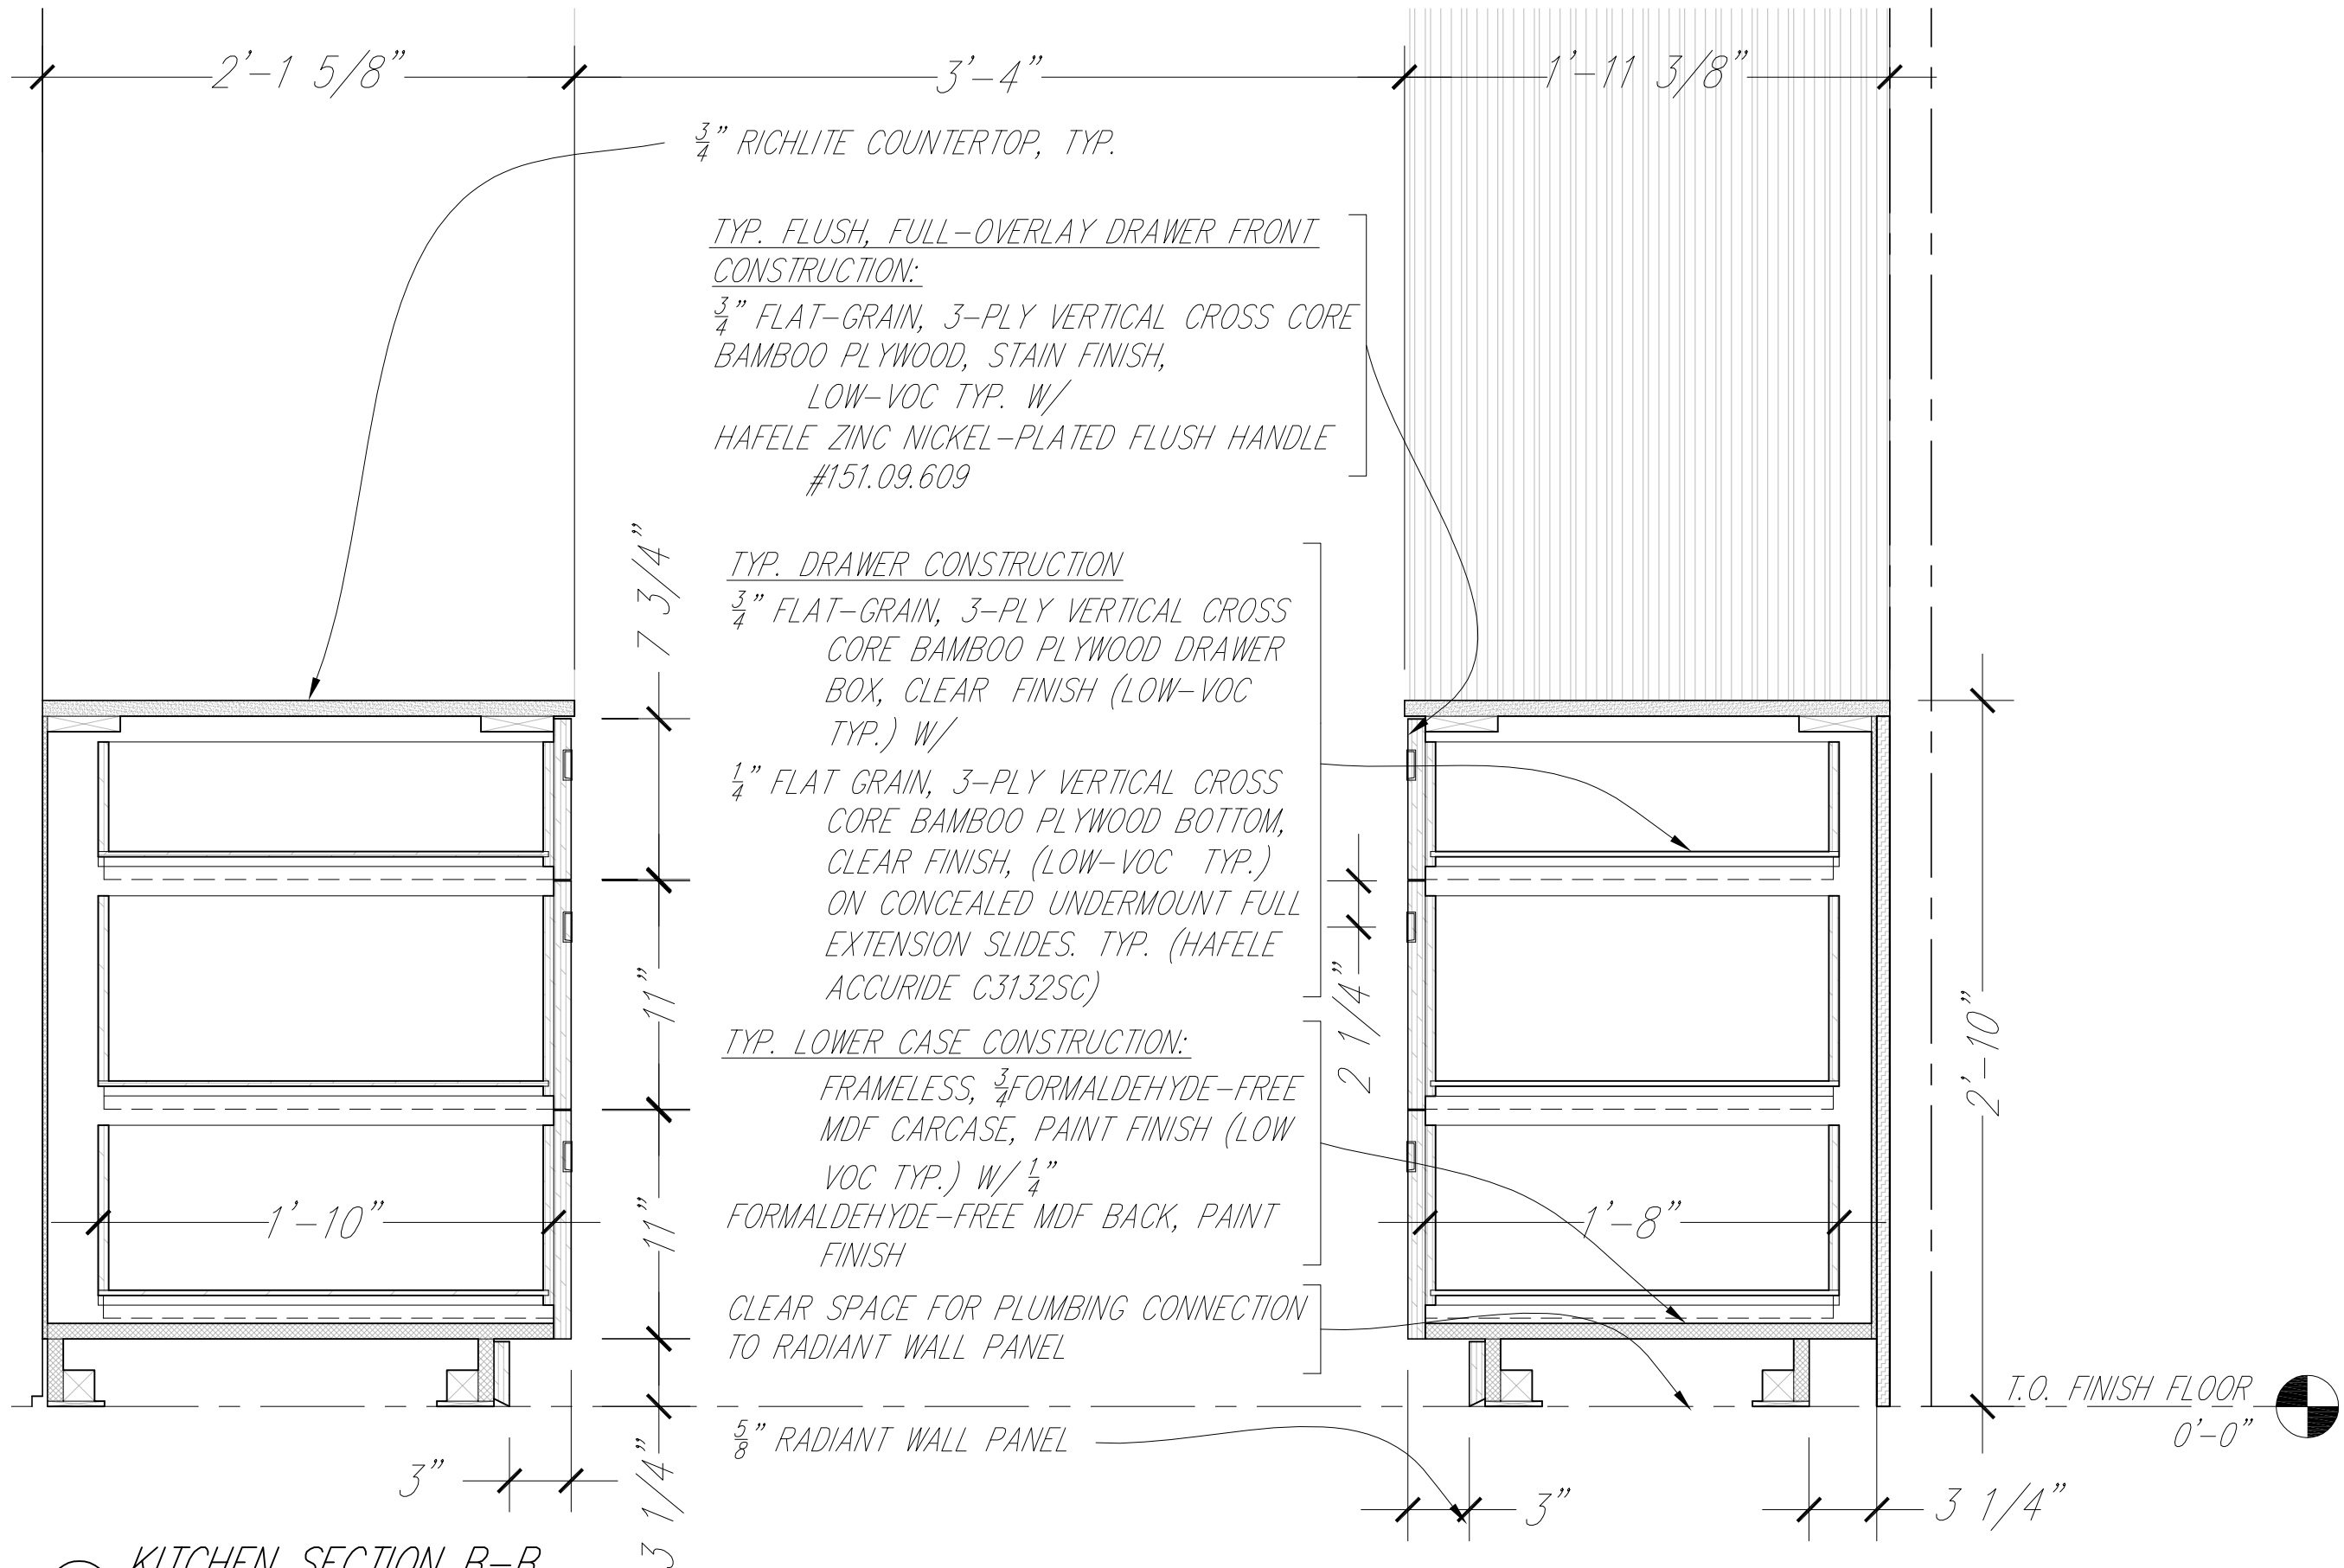


1 KITCHEN SECTION B-B  
 1 1/2" = 1'-0"

Drawn by	Date
A. Rude	August 7, 2007
Revised	Date


2007 Solar Decathlon	
University of Colorado at Boulder	
Civil, Environmental, and Architectural Engineering	
428 UCB, Room ECCE 441	
Boulder, CO 80309-0428	
Kitchen Cabinet Section B-B	2
0	1'
3'	6"



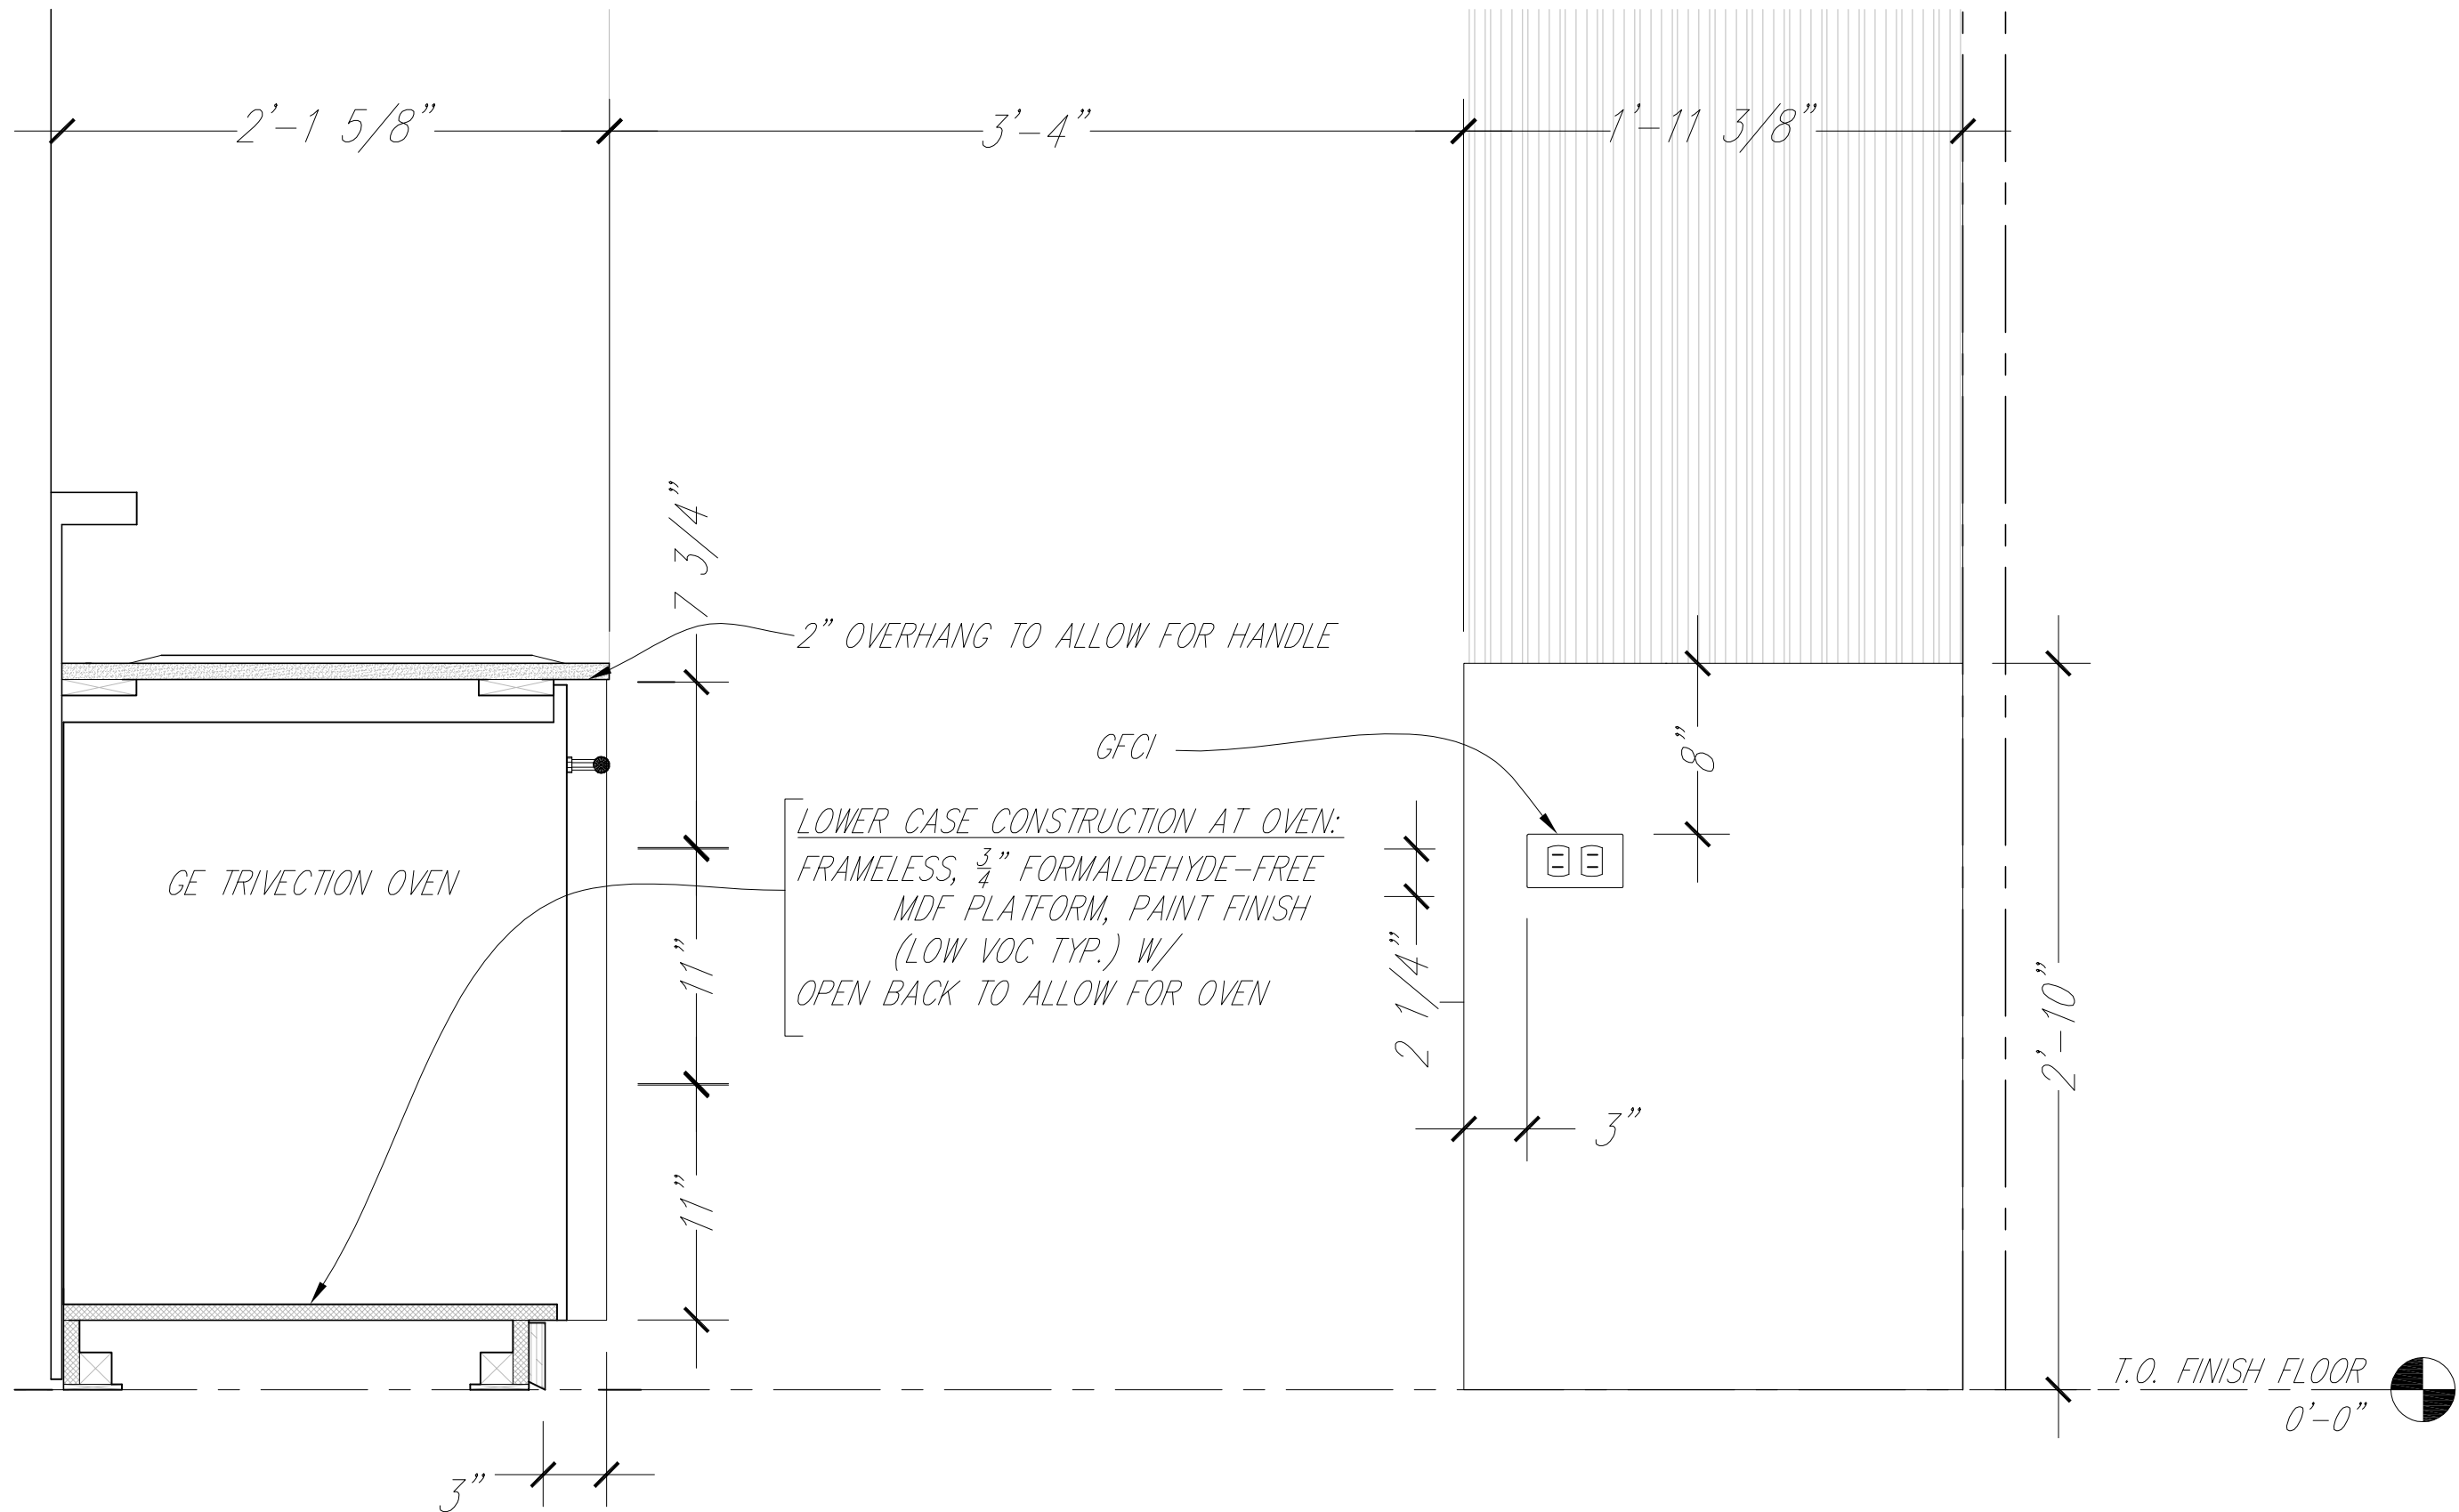

① KITCHEN SECTION C-C  
1 1/2" = 1'-0"


Drawn by	Date
A. Rude	August 7, 2007
Revised	Date

Kitchen Cabinet Section C-C	2007 Solar Decathlon	University of Colorado at Boulder Civil, Environmental, and Architectural Engineering 428 UCB, Room ECCE 441 Boulder, CO 80309-0428
		



A6.03



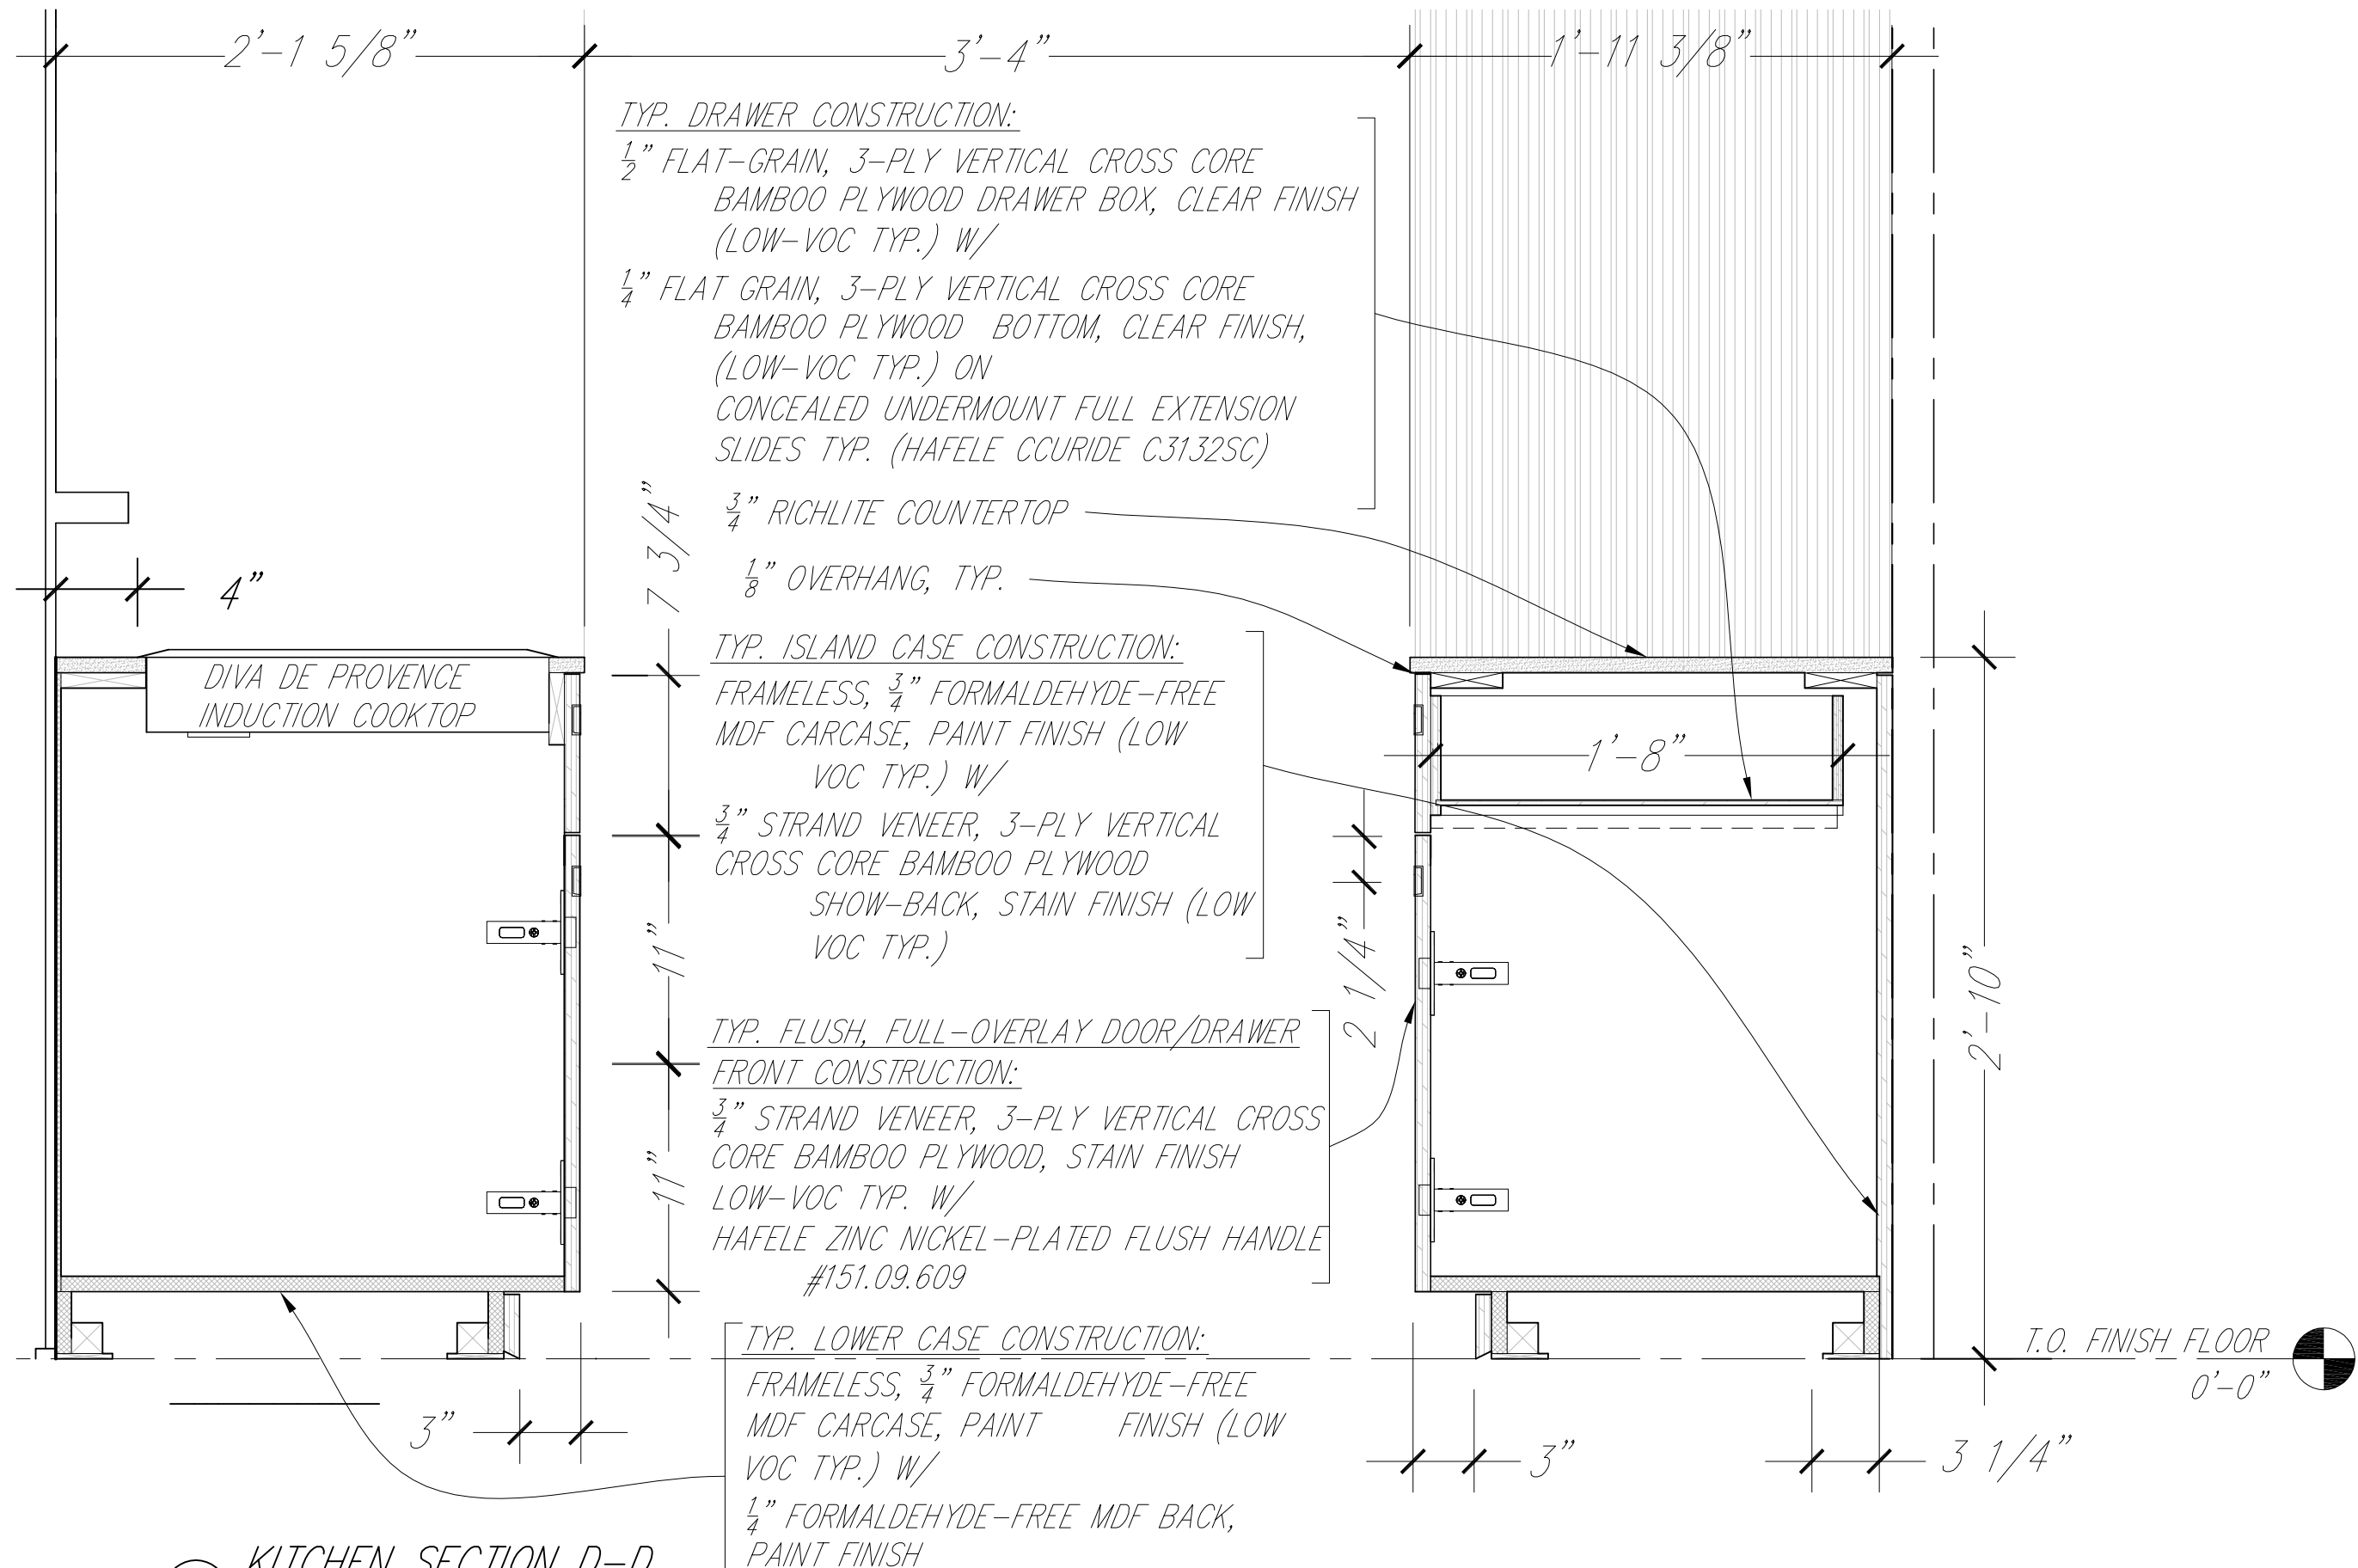


① *KITCHEN SECTION D-D*  
*1 1/2" = 1'-0"*

Drawn by	Date
A. Rude	August 7, 2007
Revised	Date

2007 Solar Decathlon	
University of Colorado at Boulder	
Civil, Environmental, and Architectural Engineering	
428 UCB, Room ECCE 441	
Boulder, CO 80309-0428	
Kitchen Cabinet Section D-D	2
	1'
	6"
	3"
	0



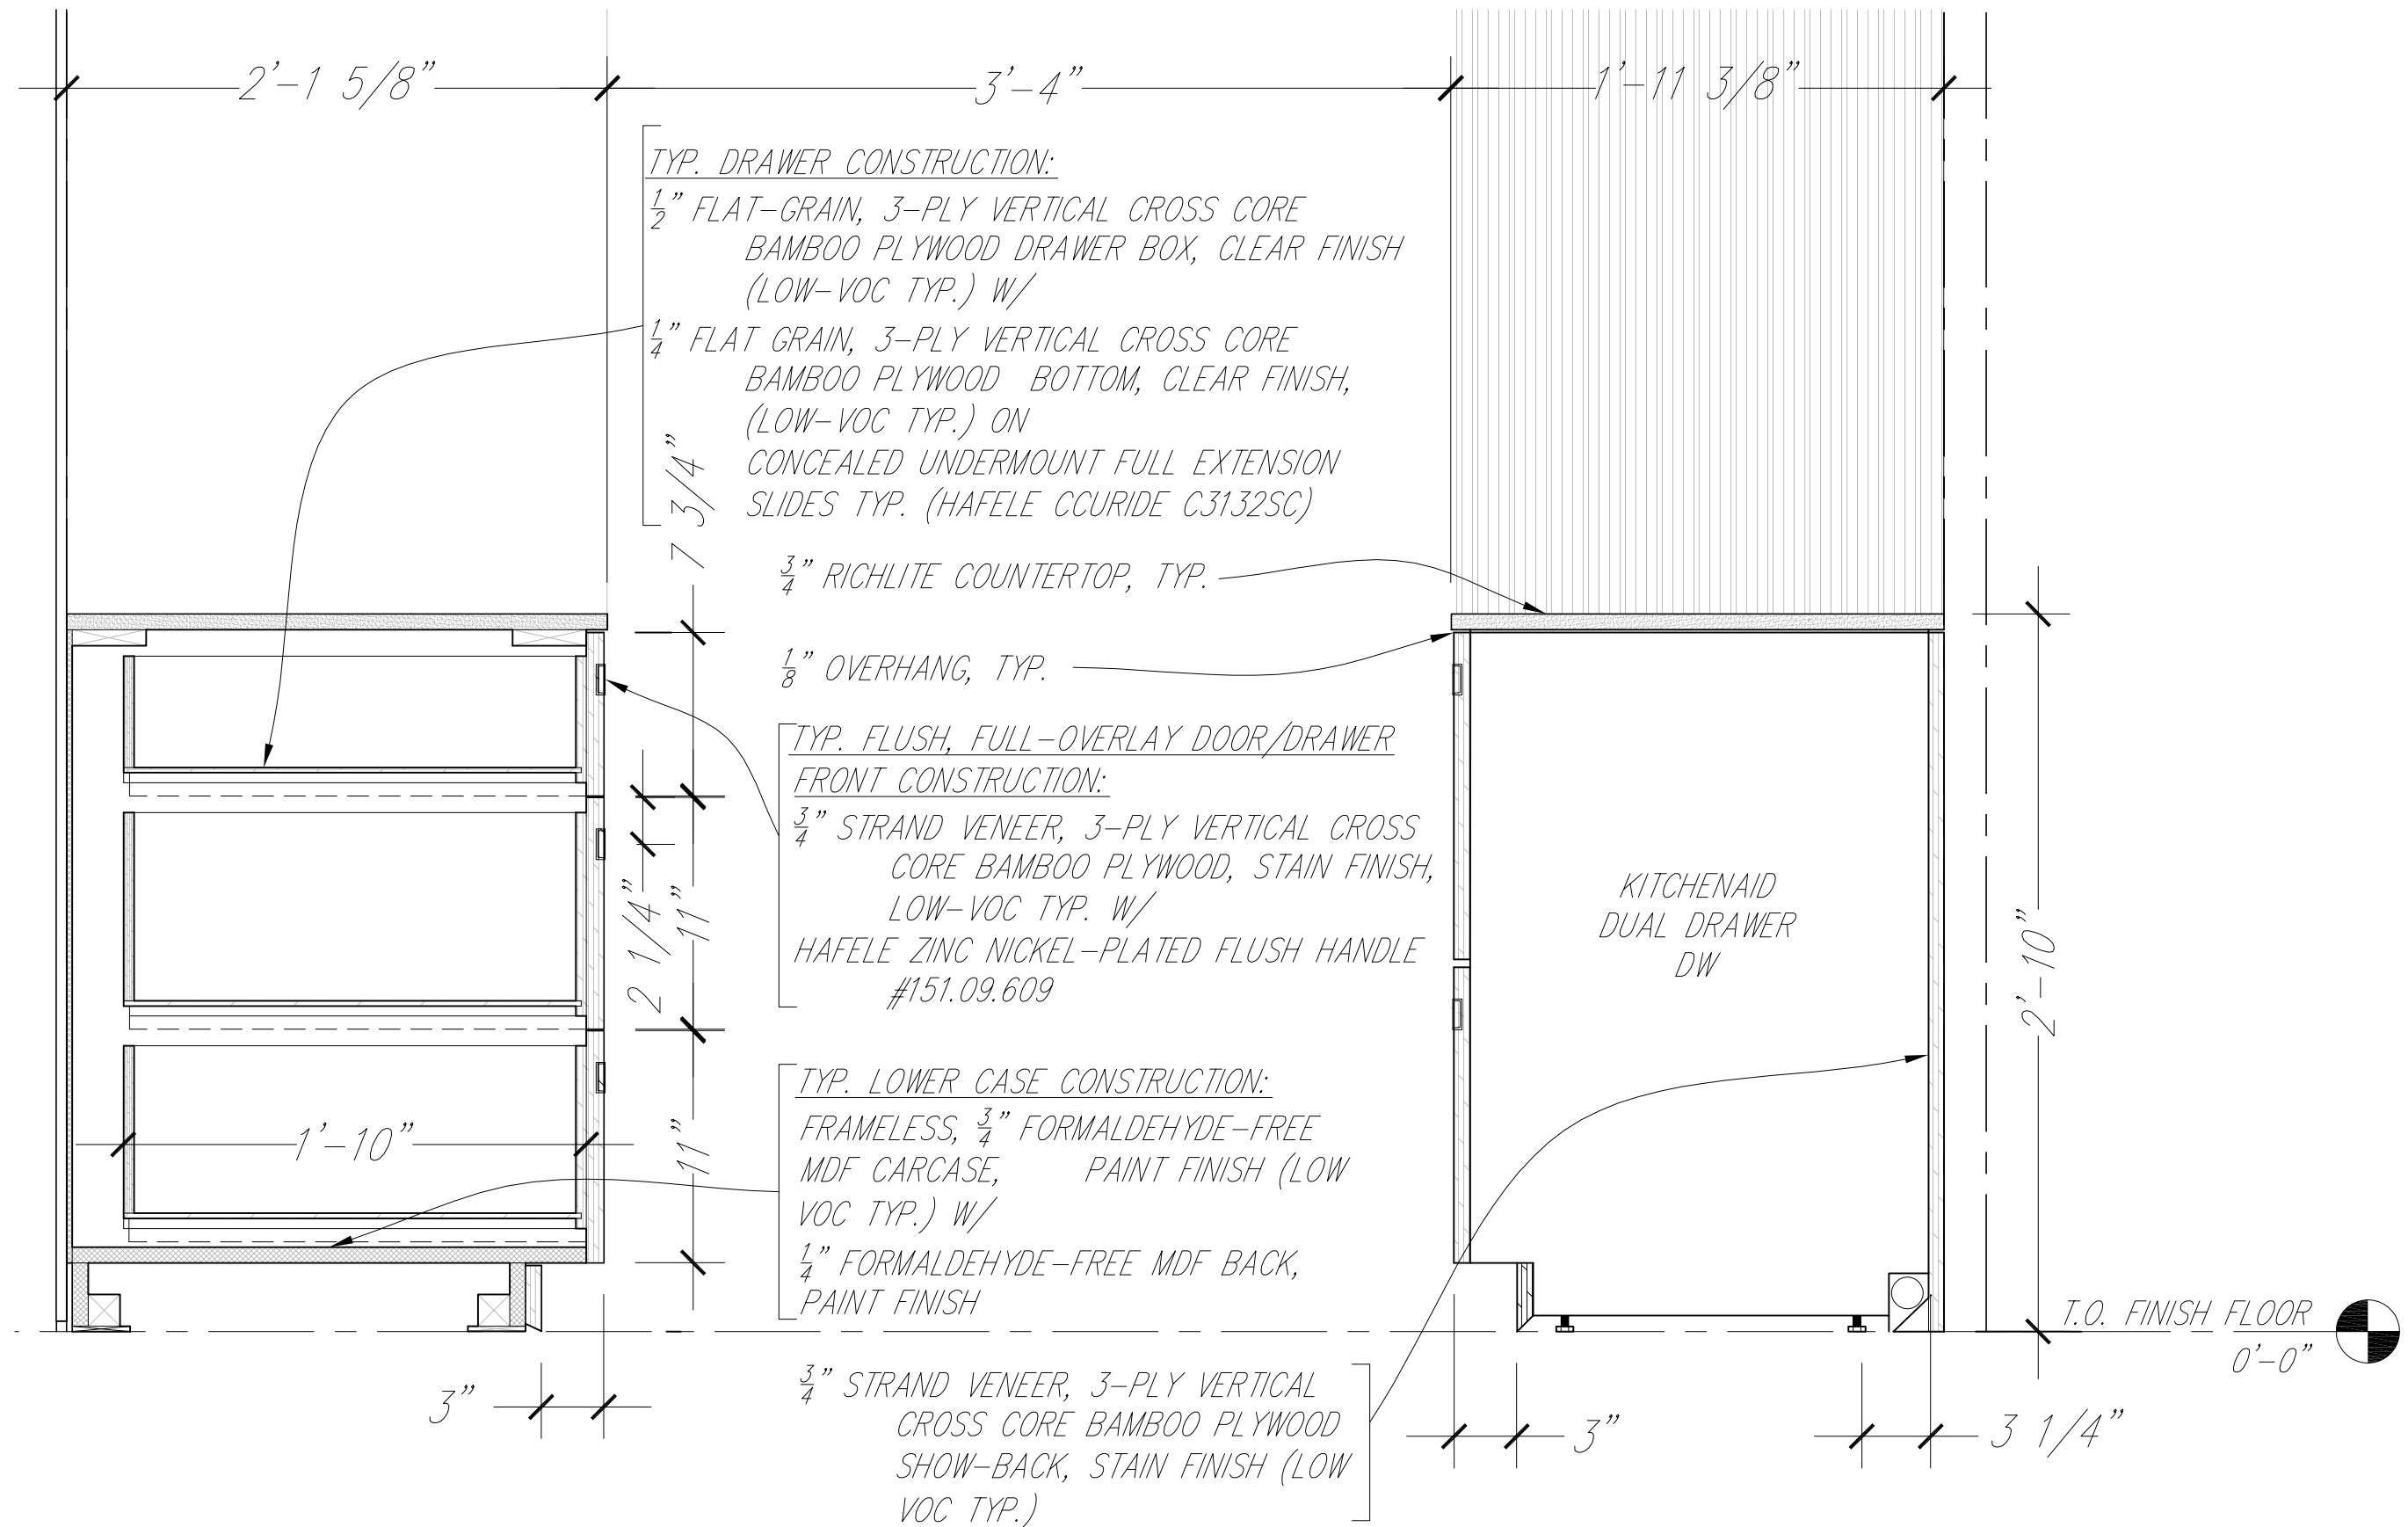


1 KITCHEN SECTION E-E  
 $1 \frac{1}{2}" = 1'-0"$

Drawn by	Date
A. Rude	August 7, 2007
Revised	Date

Kitchen Cabinet Section E-E	2007 Solar Decathlon	University of Colorado at Boulder
		Civil, Environmental, and Architectural Engineering
		428 UCB, Room ECCE 441
		Boulder, CO 80309-0428



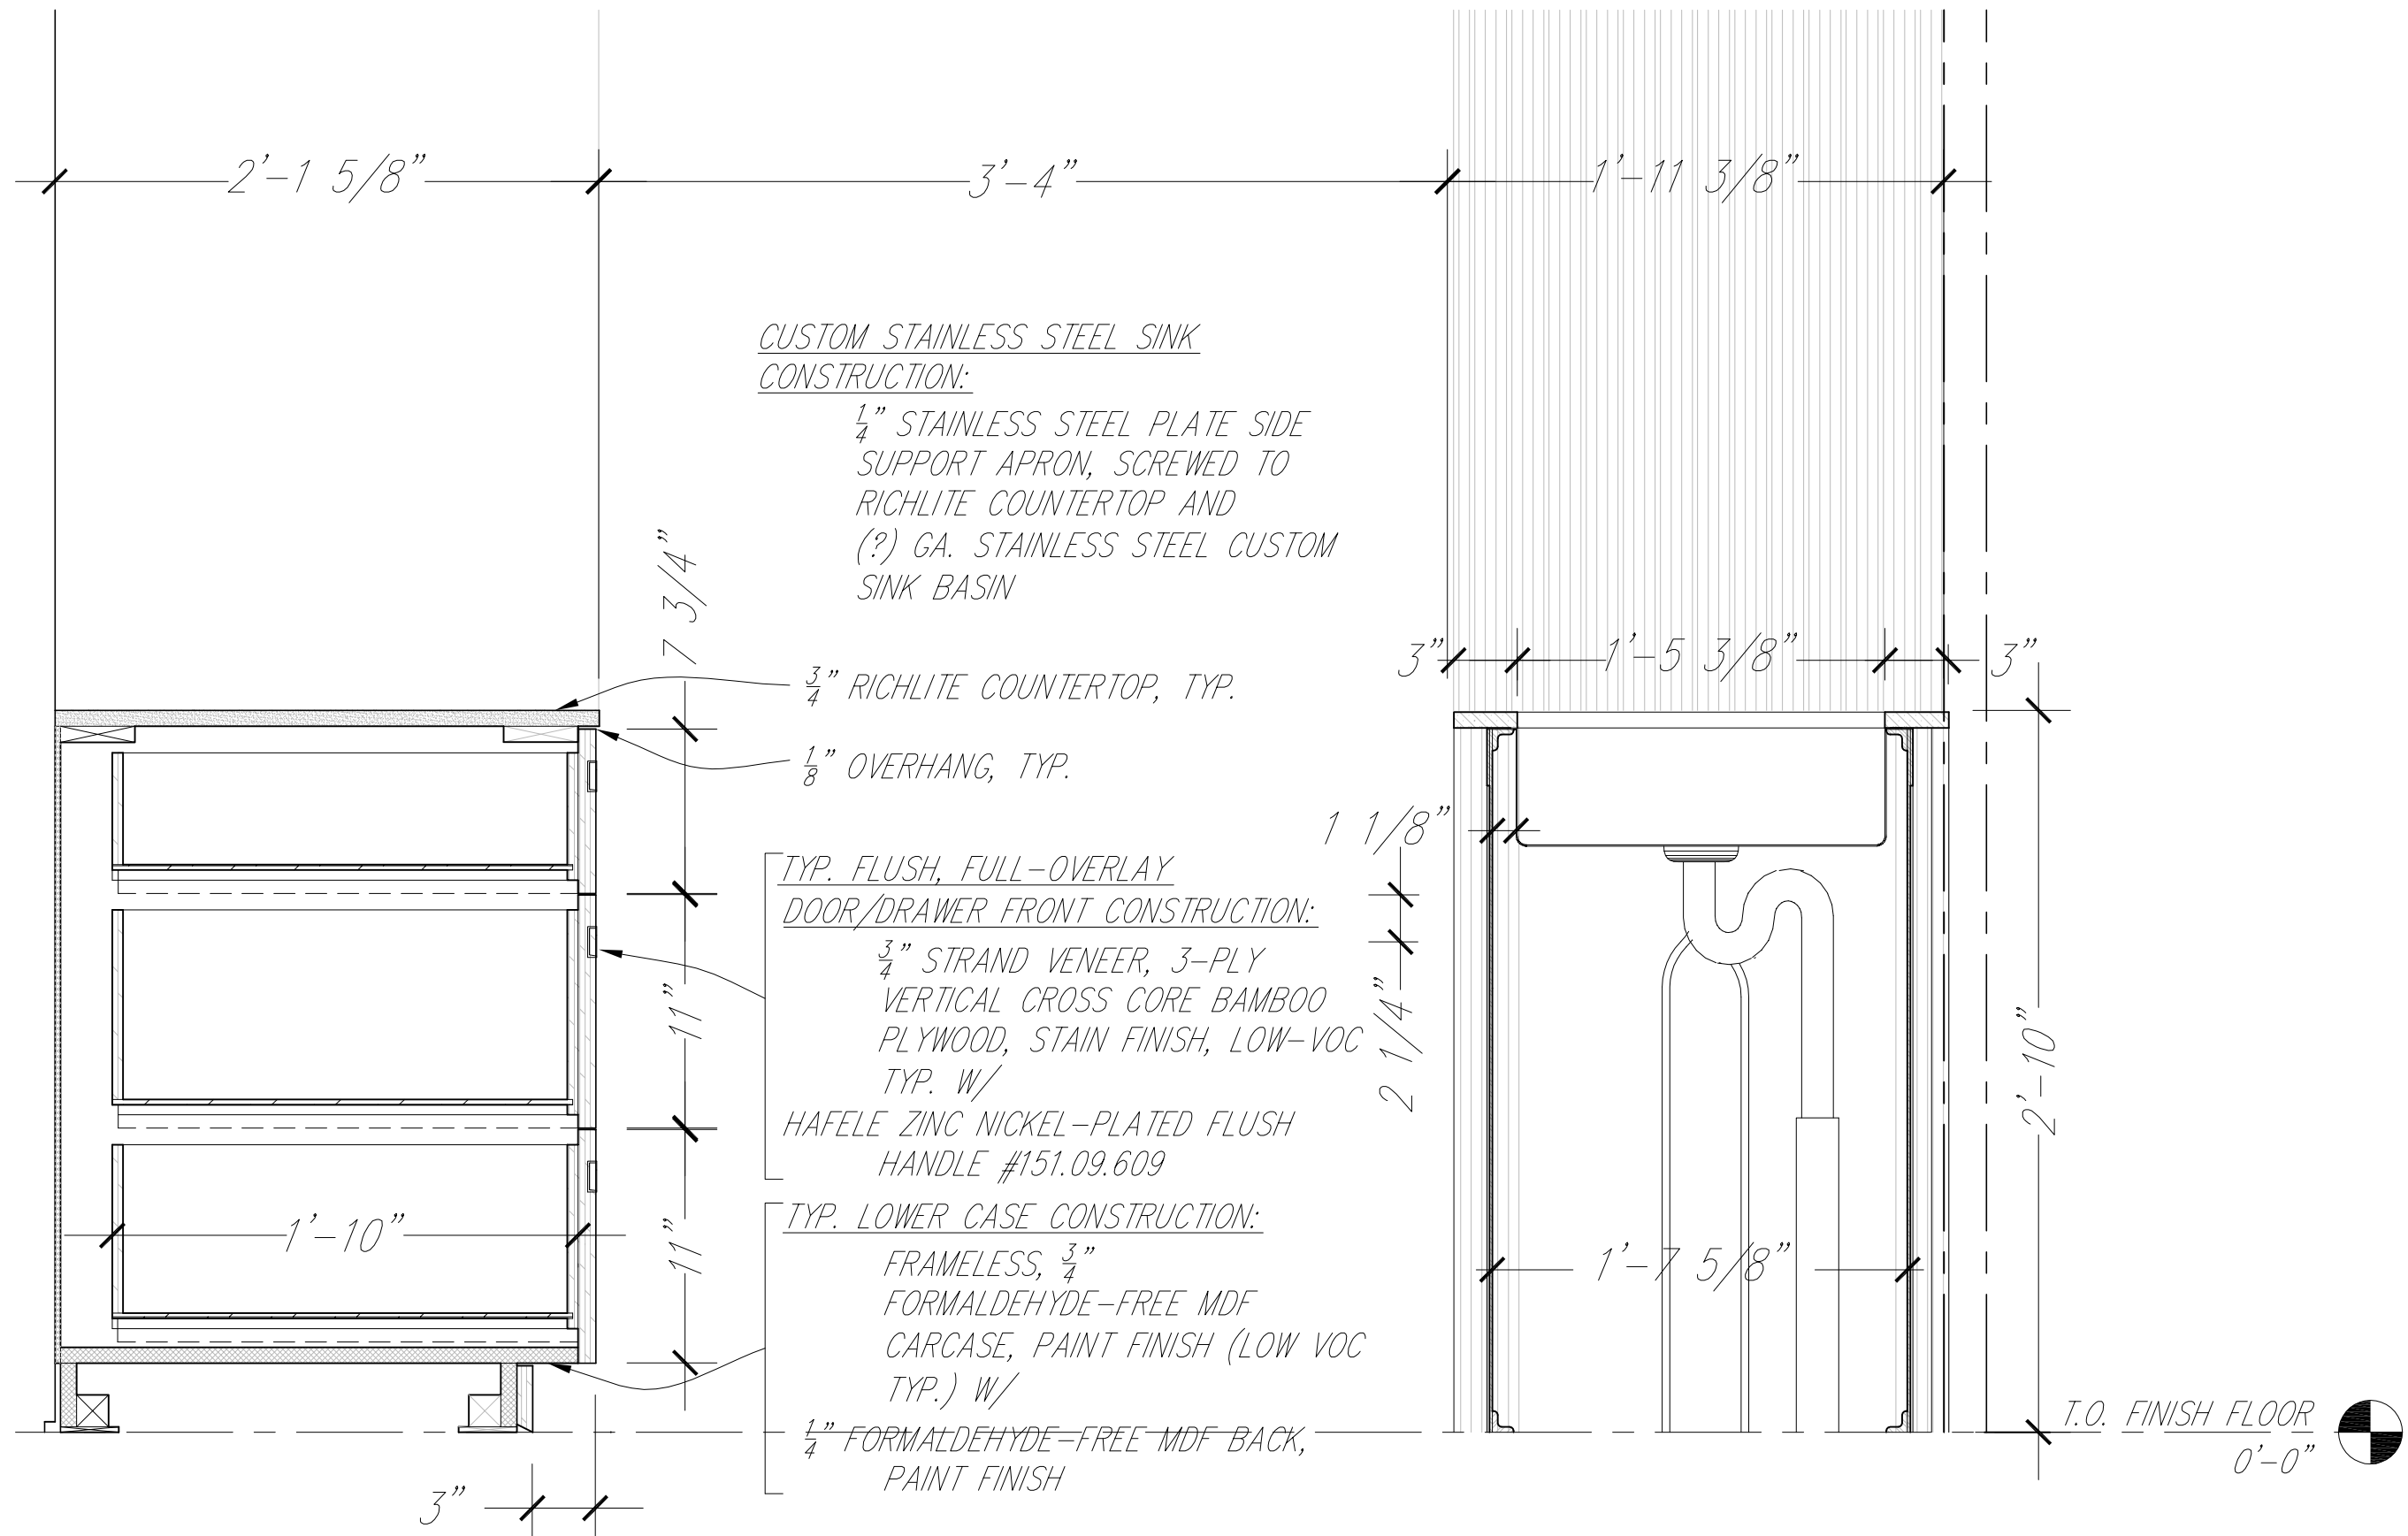


1 KITCHEN SECTION DETAILS F-F  
 $1 \frac{1}{2}" = 1'-0"$


Drawn by	Date
A. Rude	August 7, 2007
Revised	Date

2007 Solar Decathlon	University of Colorado at Boulder
Civil, Environmental, and Architectural Engineering	428 UCB, Room ECCE 441
Boulder, CO	80309-0428



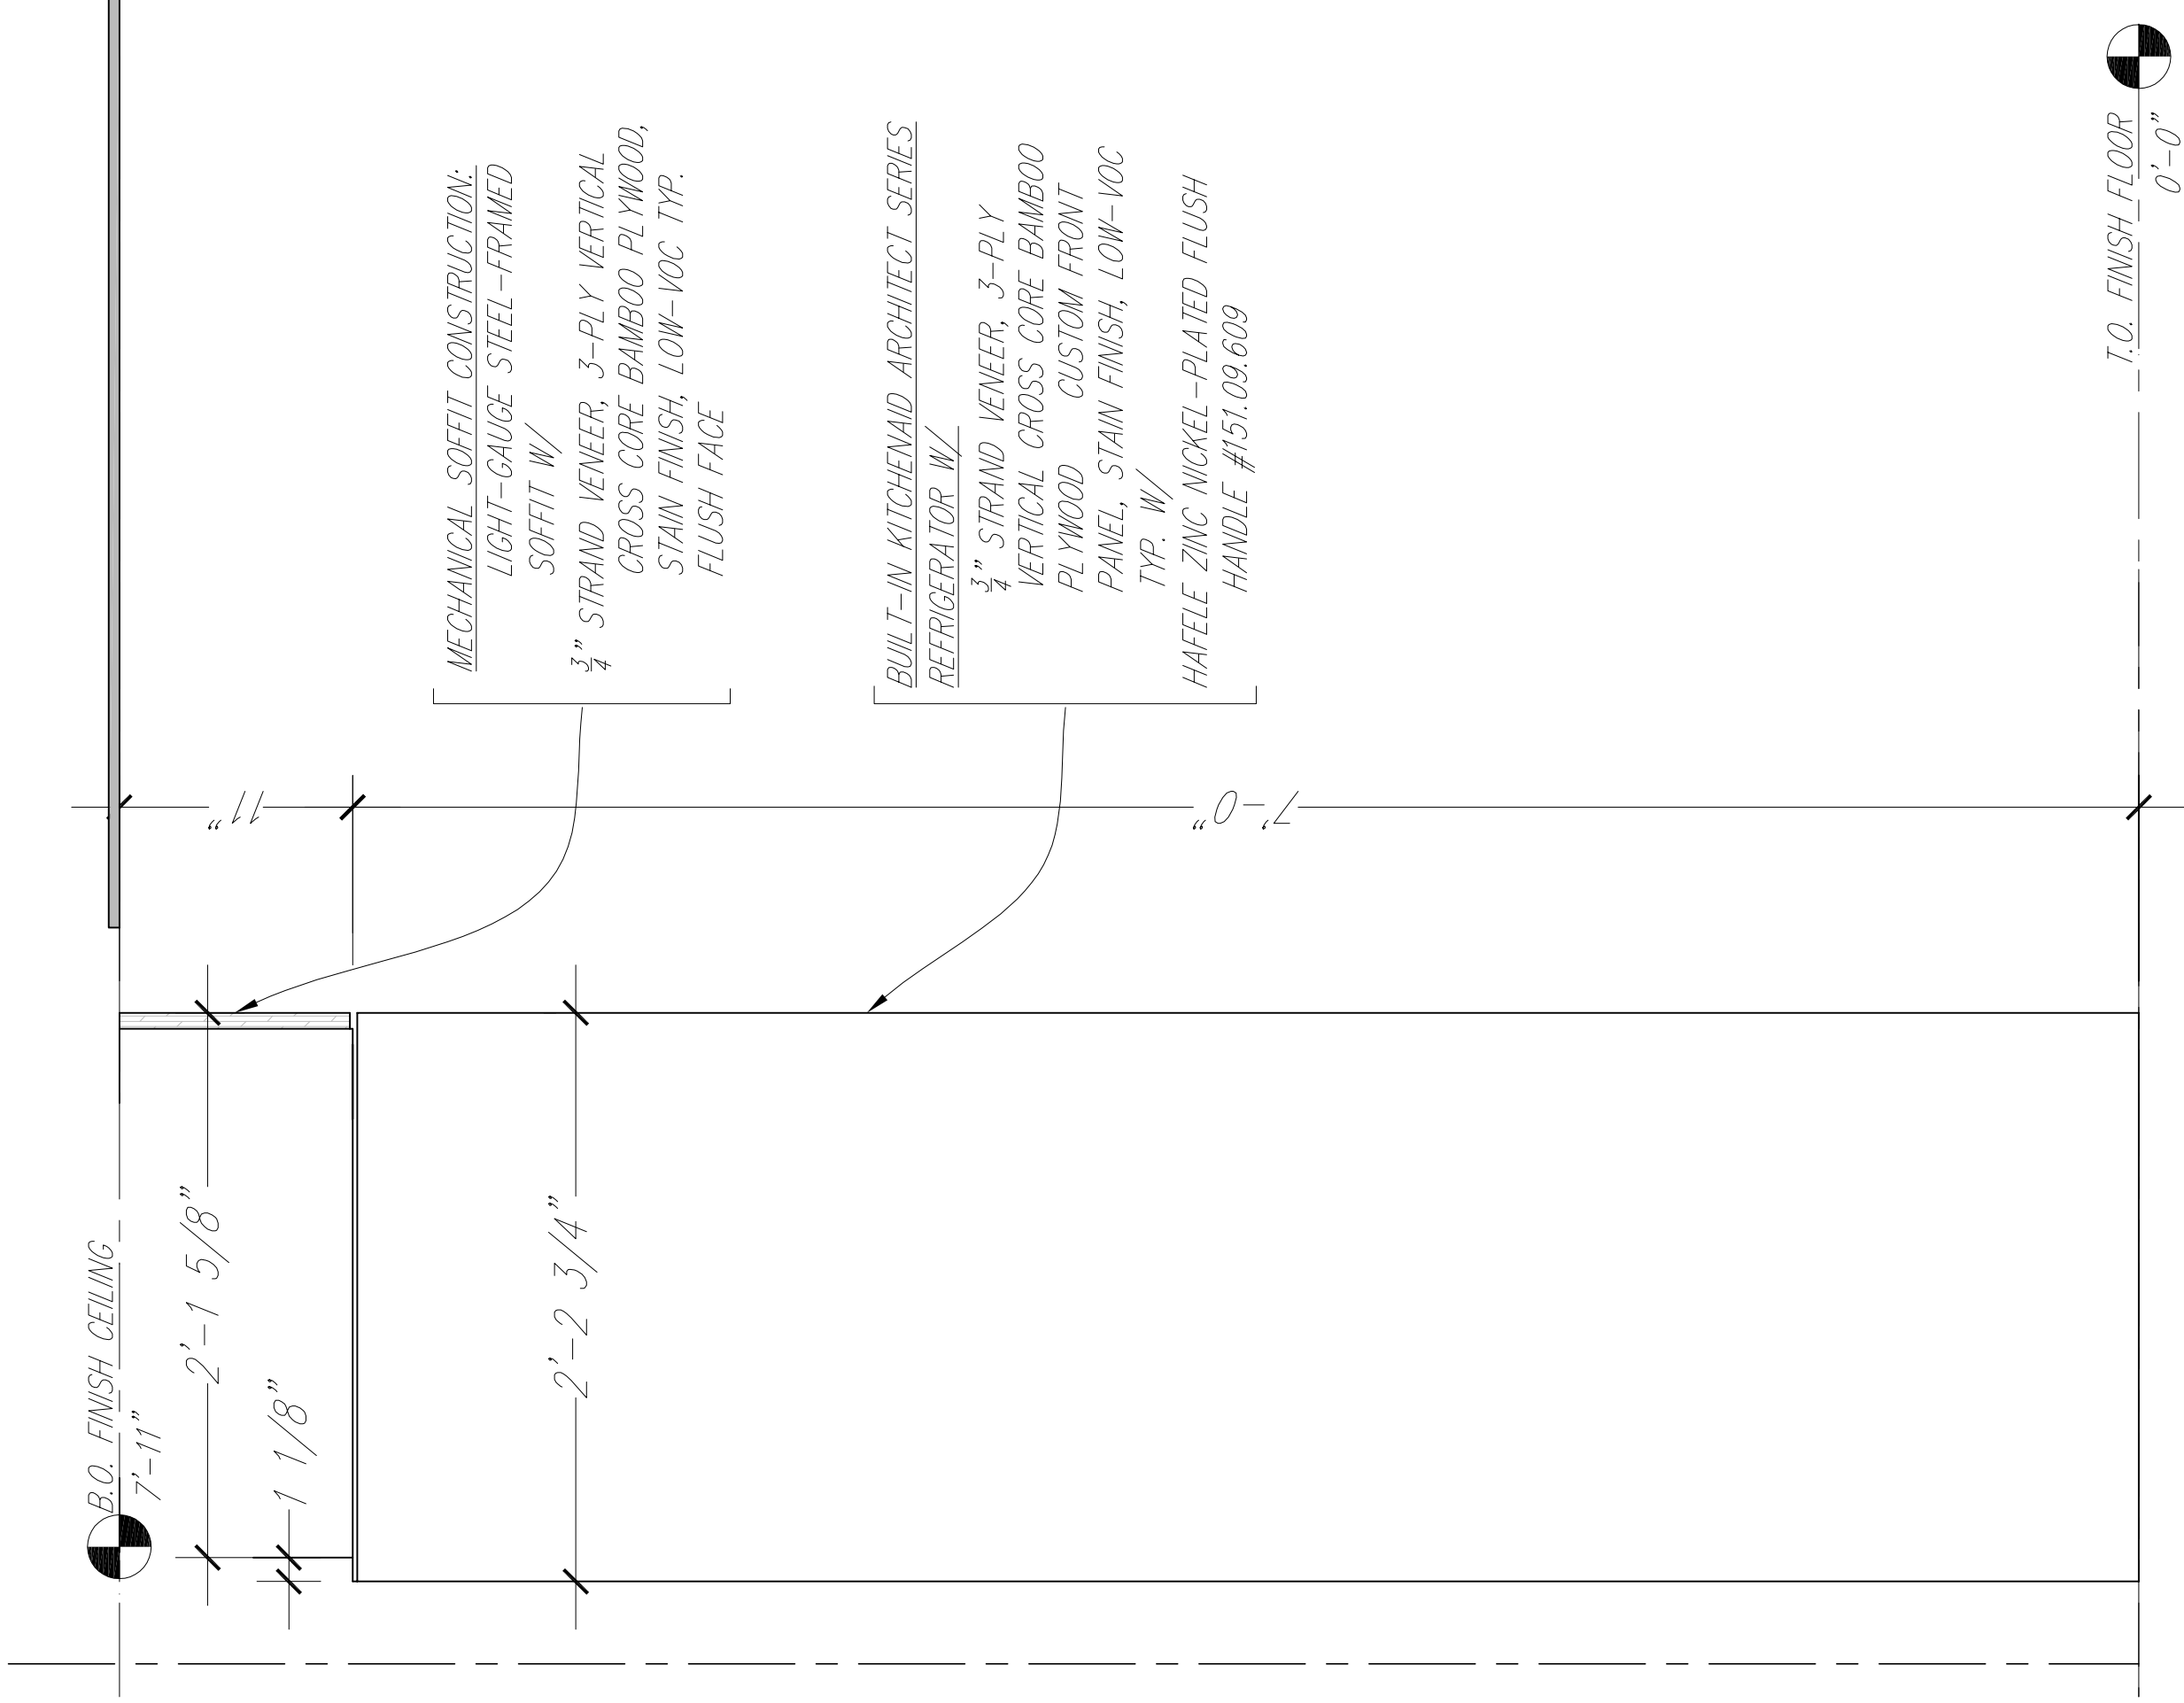

1 KITCHEN SECTION G-G  
1 1/2" = 1'-0"

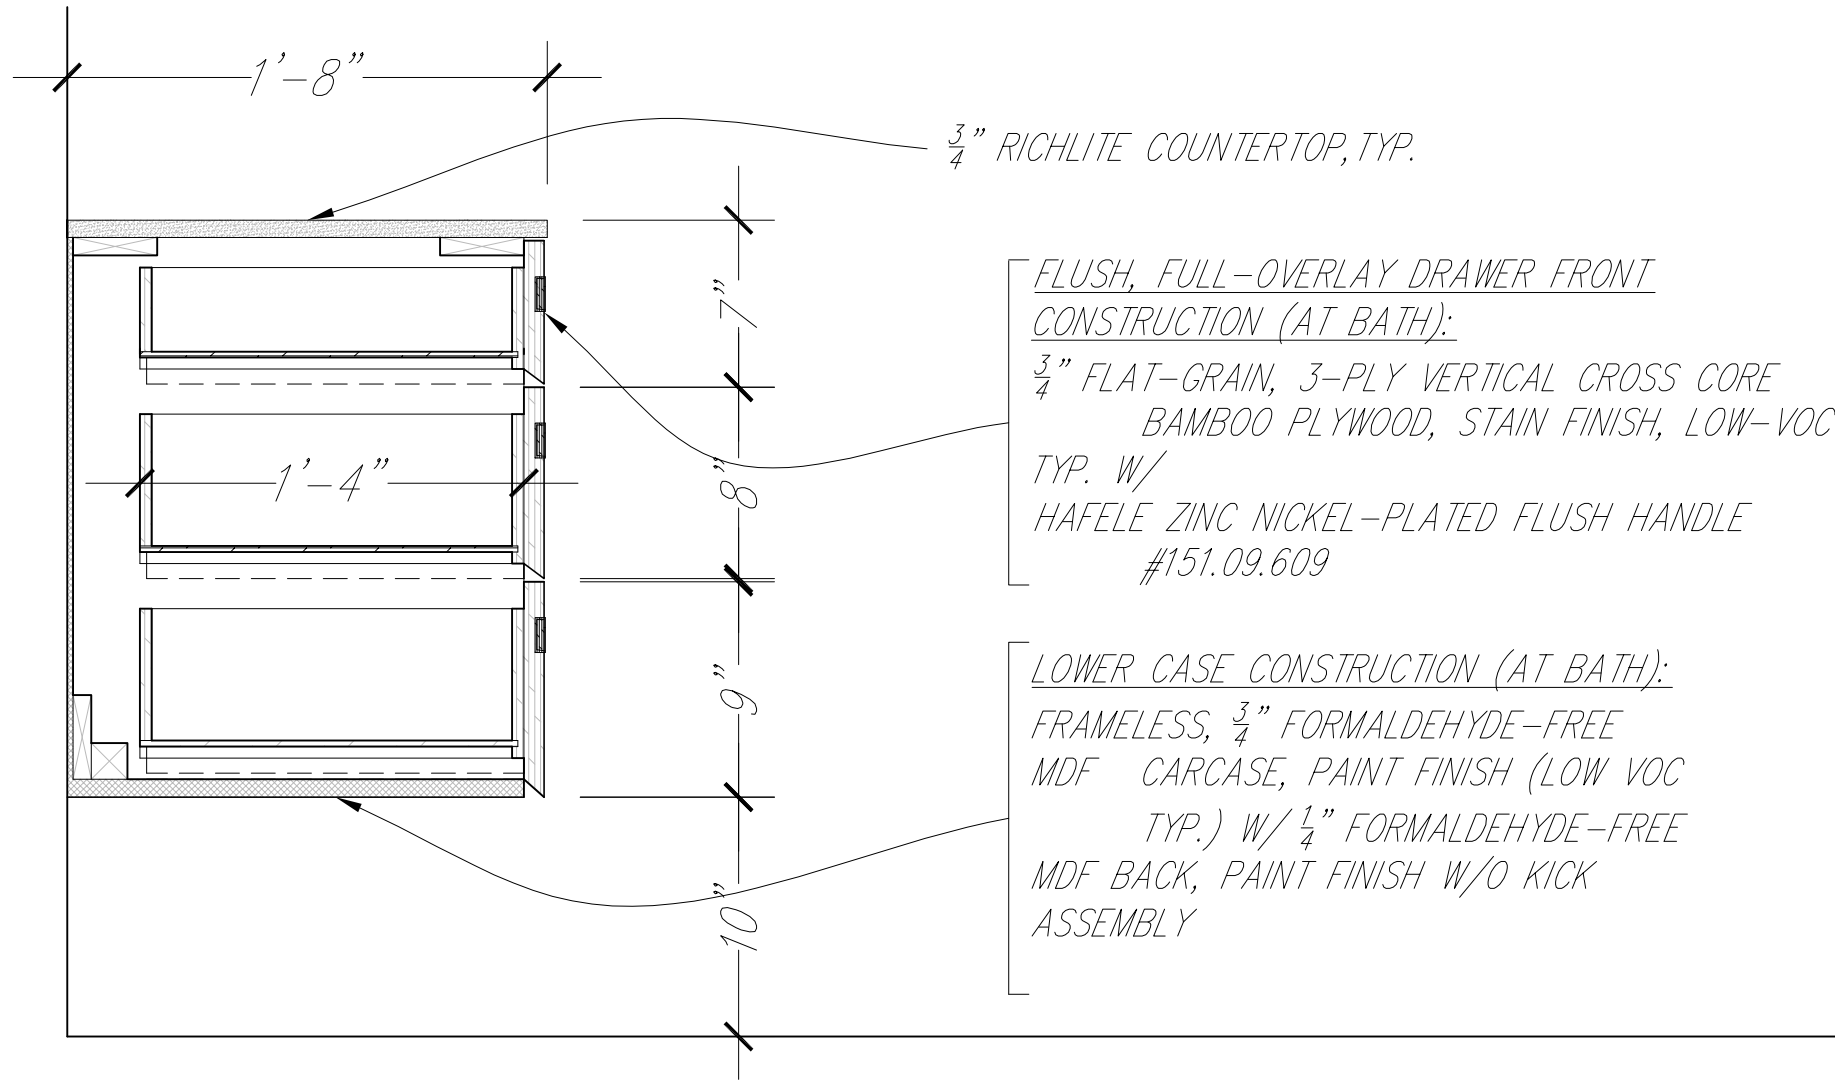


1 BATH SECTION H-H  
 $1 \frac{1}{2}" = 1'-0"$

Drawn by	Date
A. Rude	August 7, 2007
Revised	Date

Kitchen Cabinet Section H-H	2007 Solar Decathlon
University of Colorado at Boulder	
Civil, Environmental, and Architectural Engineering	
428 UCB, Room ECCE 441	
Boulder, CO 80309-0428	
0	2'
3"	
6"	
1'	





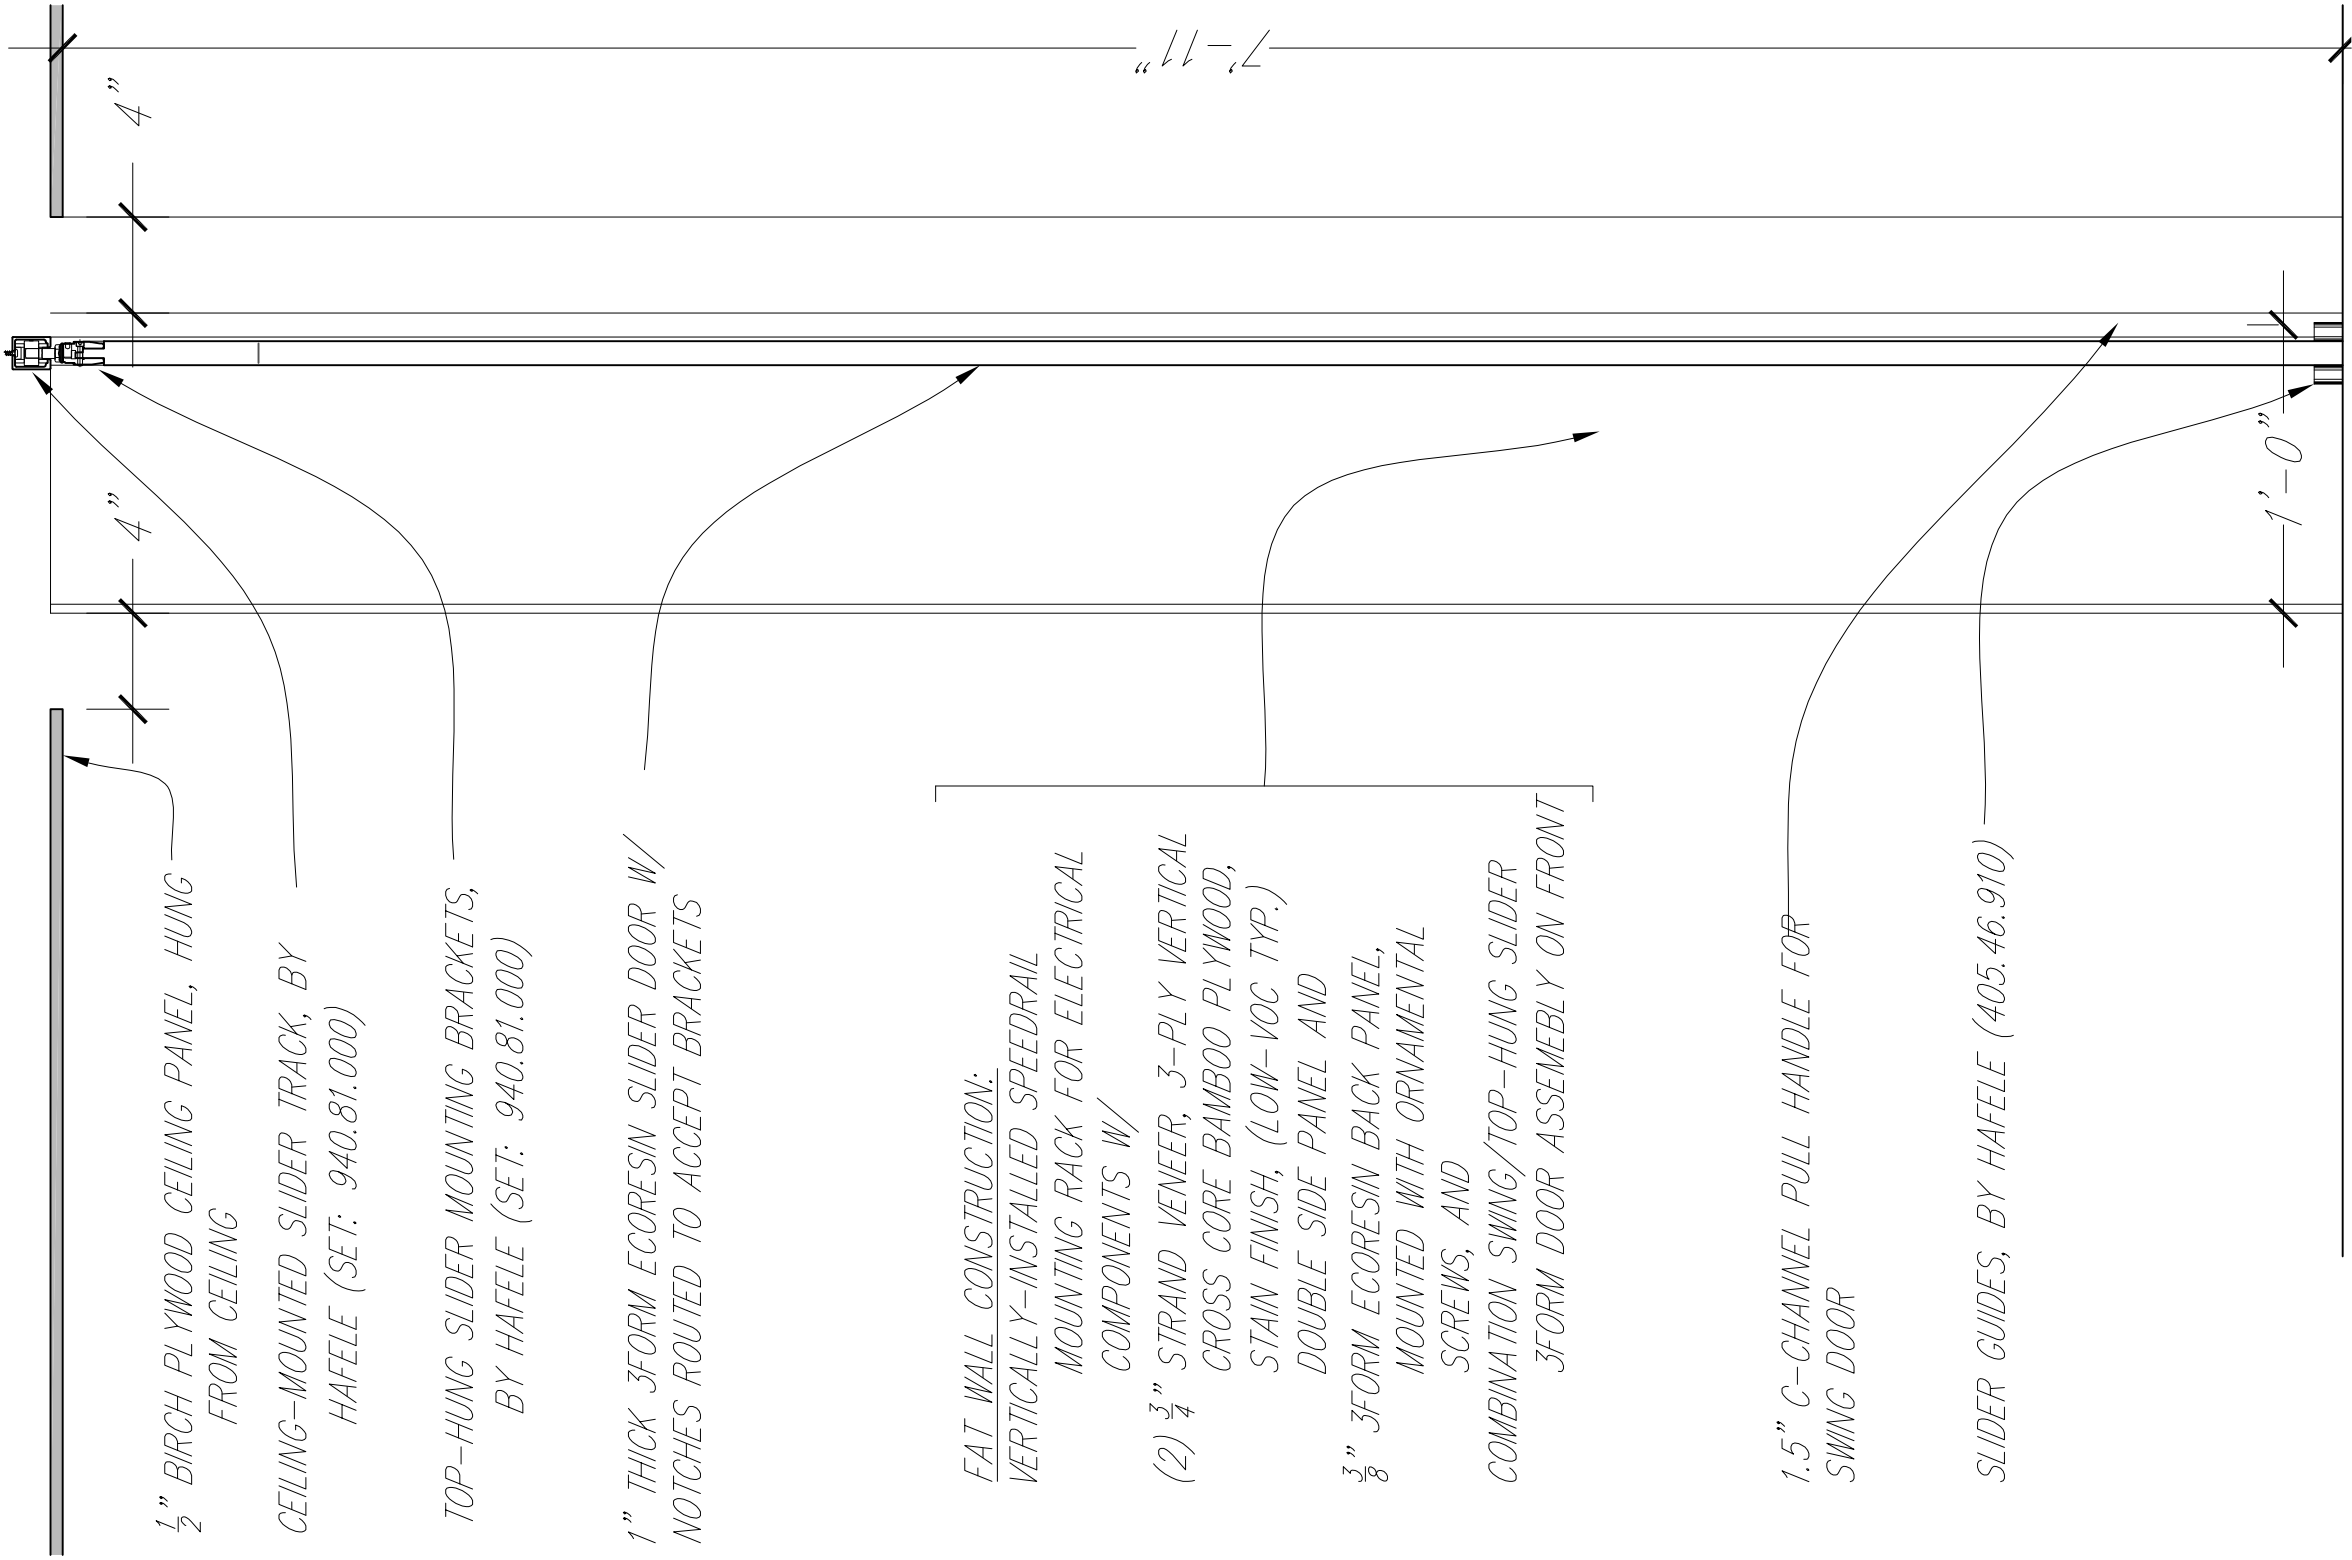

1 FAT WALL SECTION AT DOOR  
 $1\frac{1}{2}'' = 1'-0''$






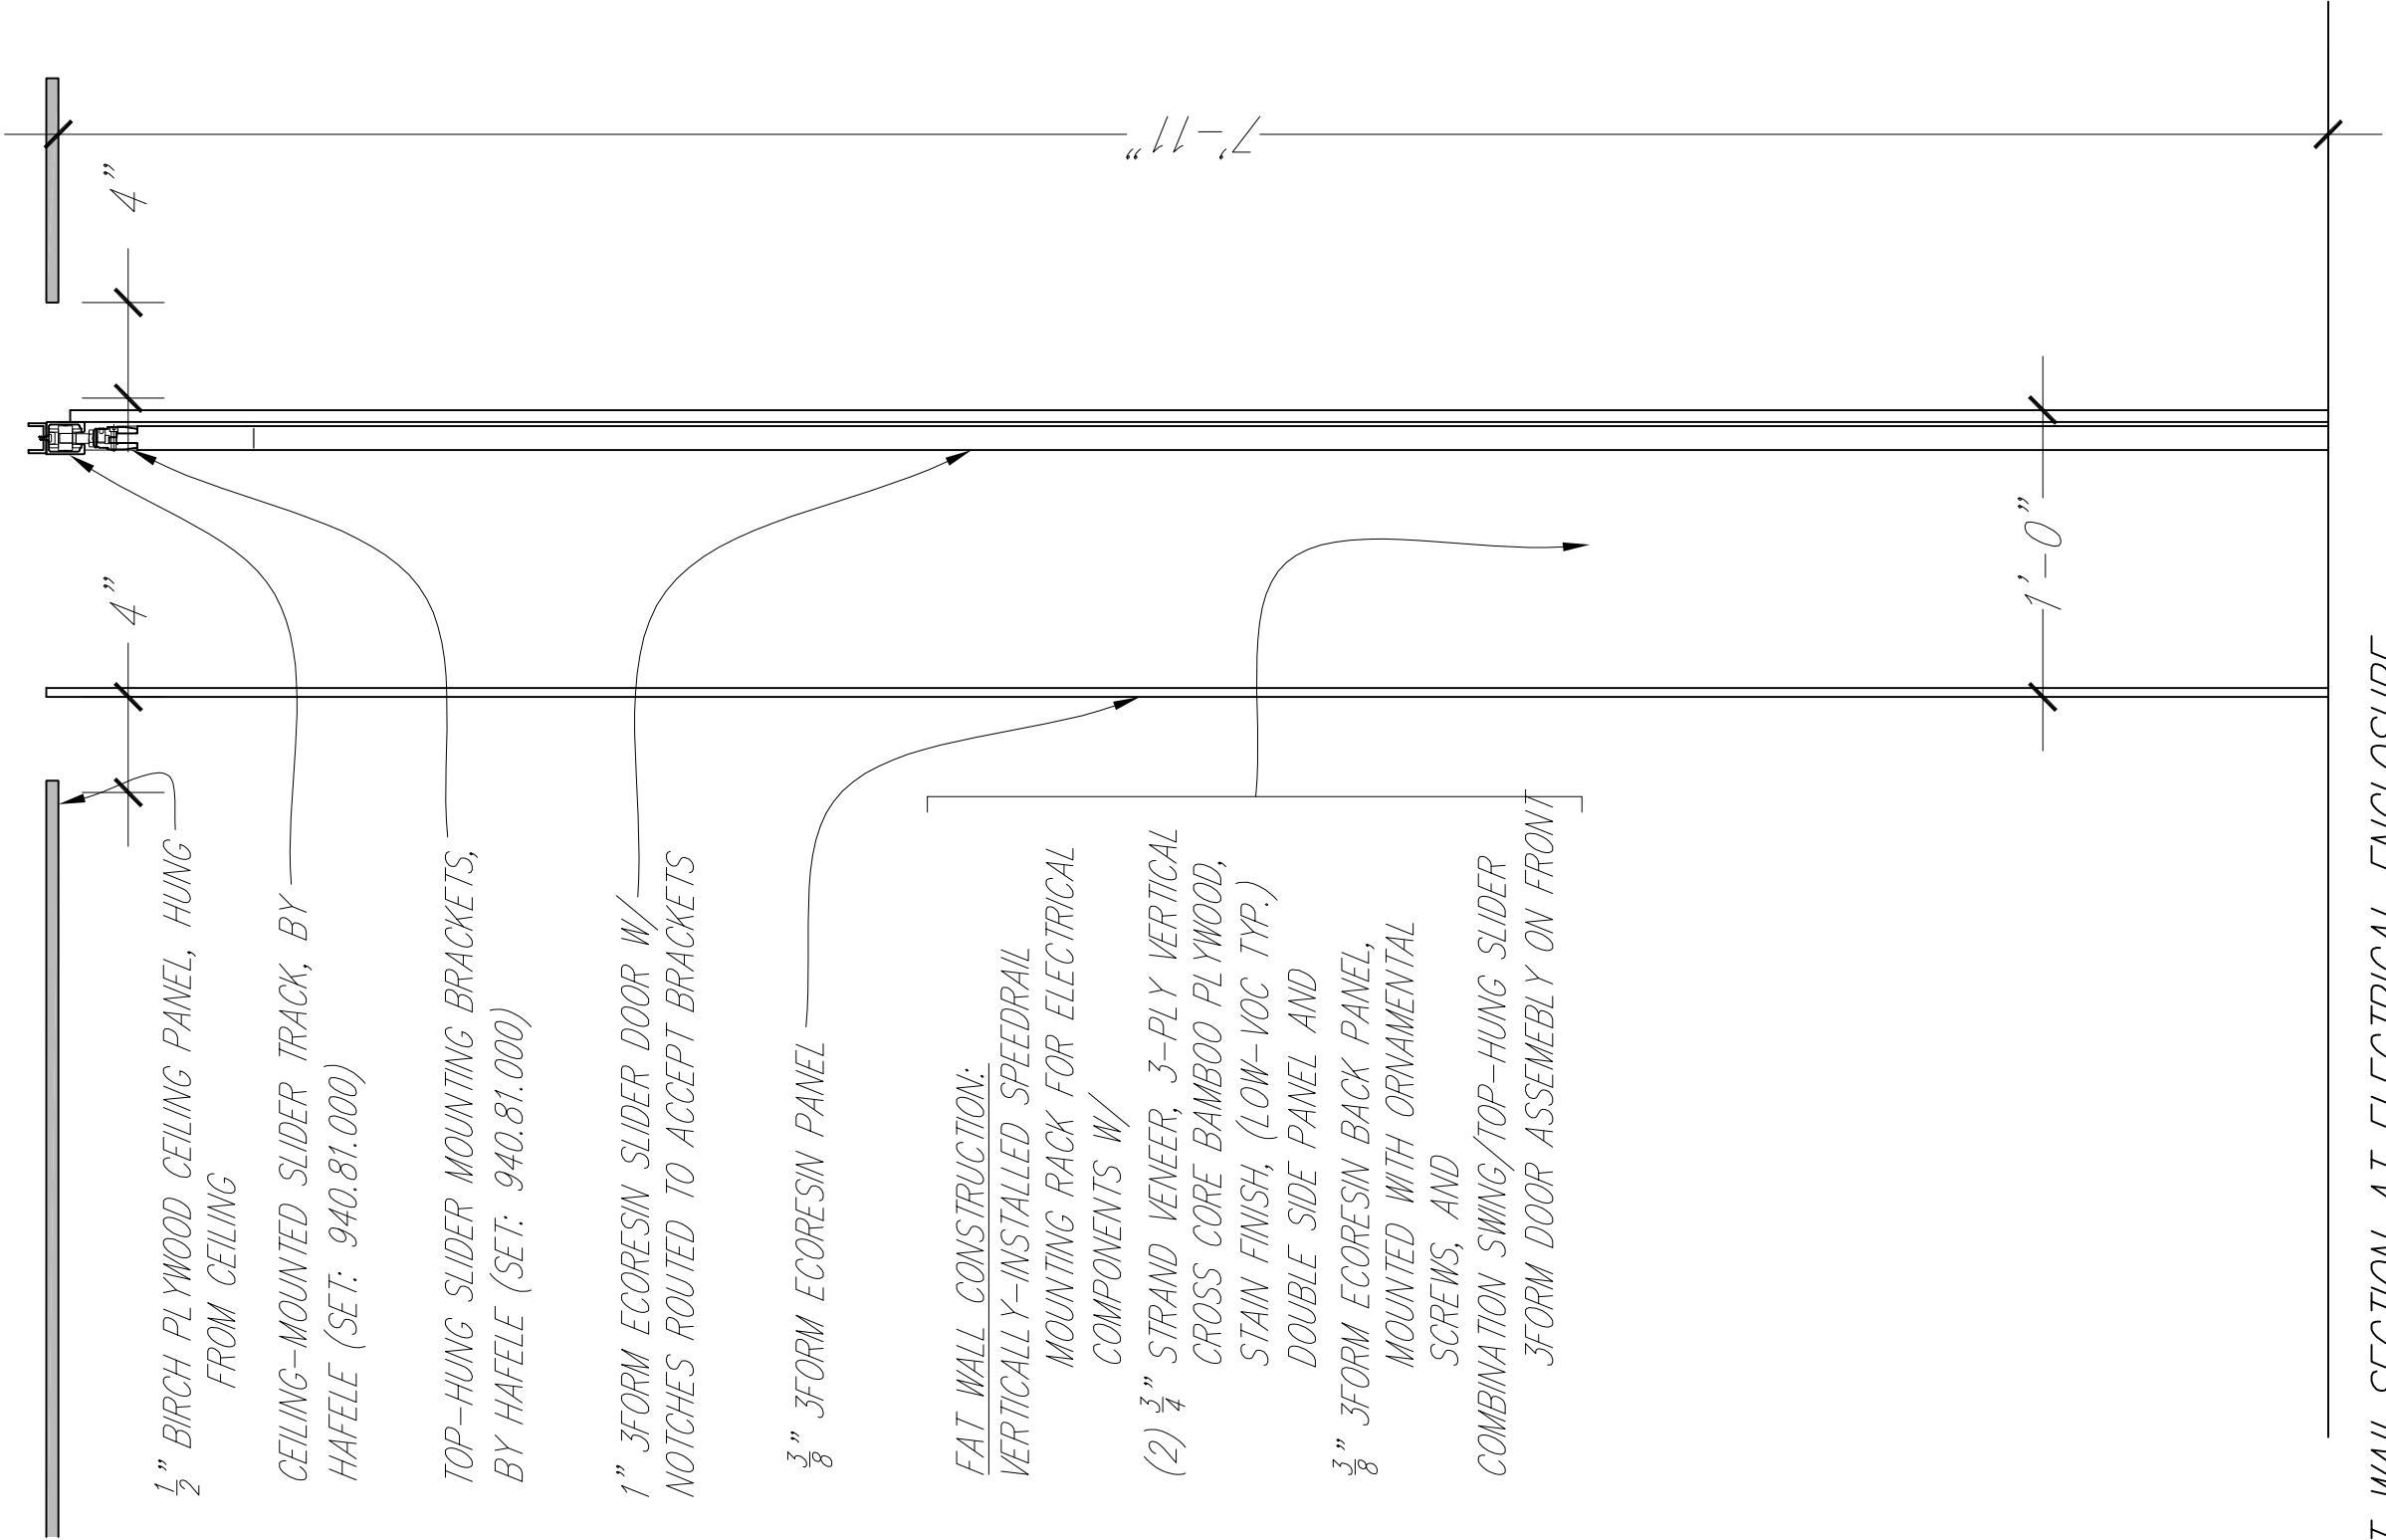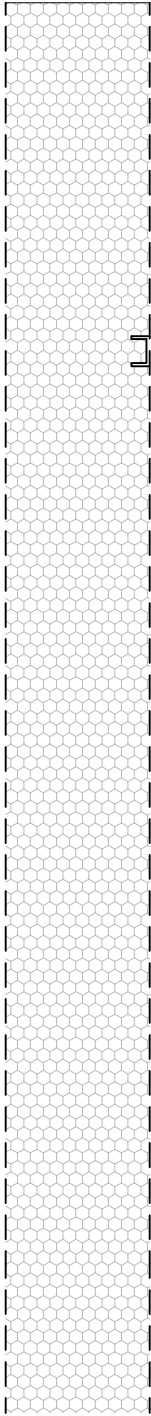

1 FAT WALL SECTION AT ELECTRICAL ENCLOSURE


1 1/2" = 1'-0"



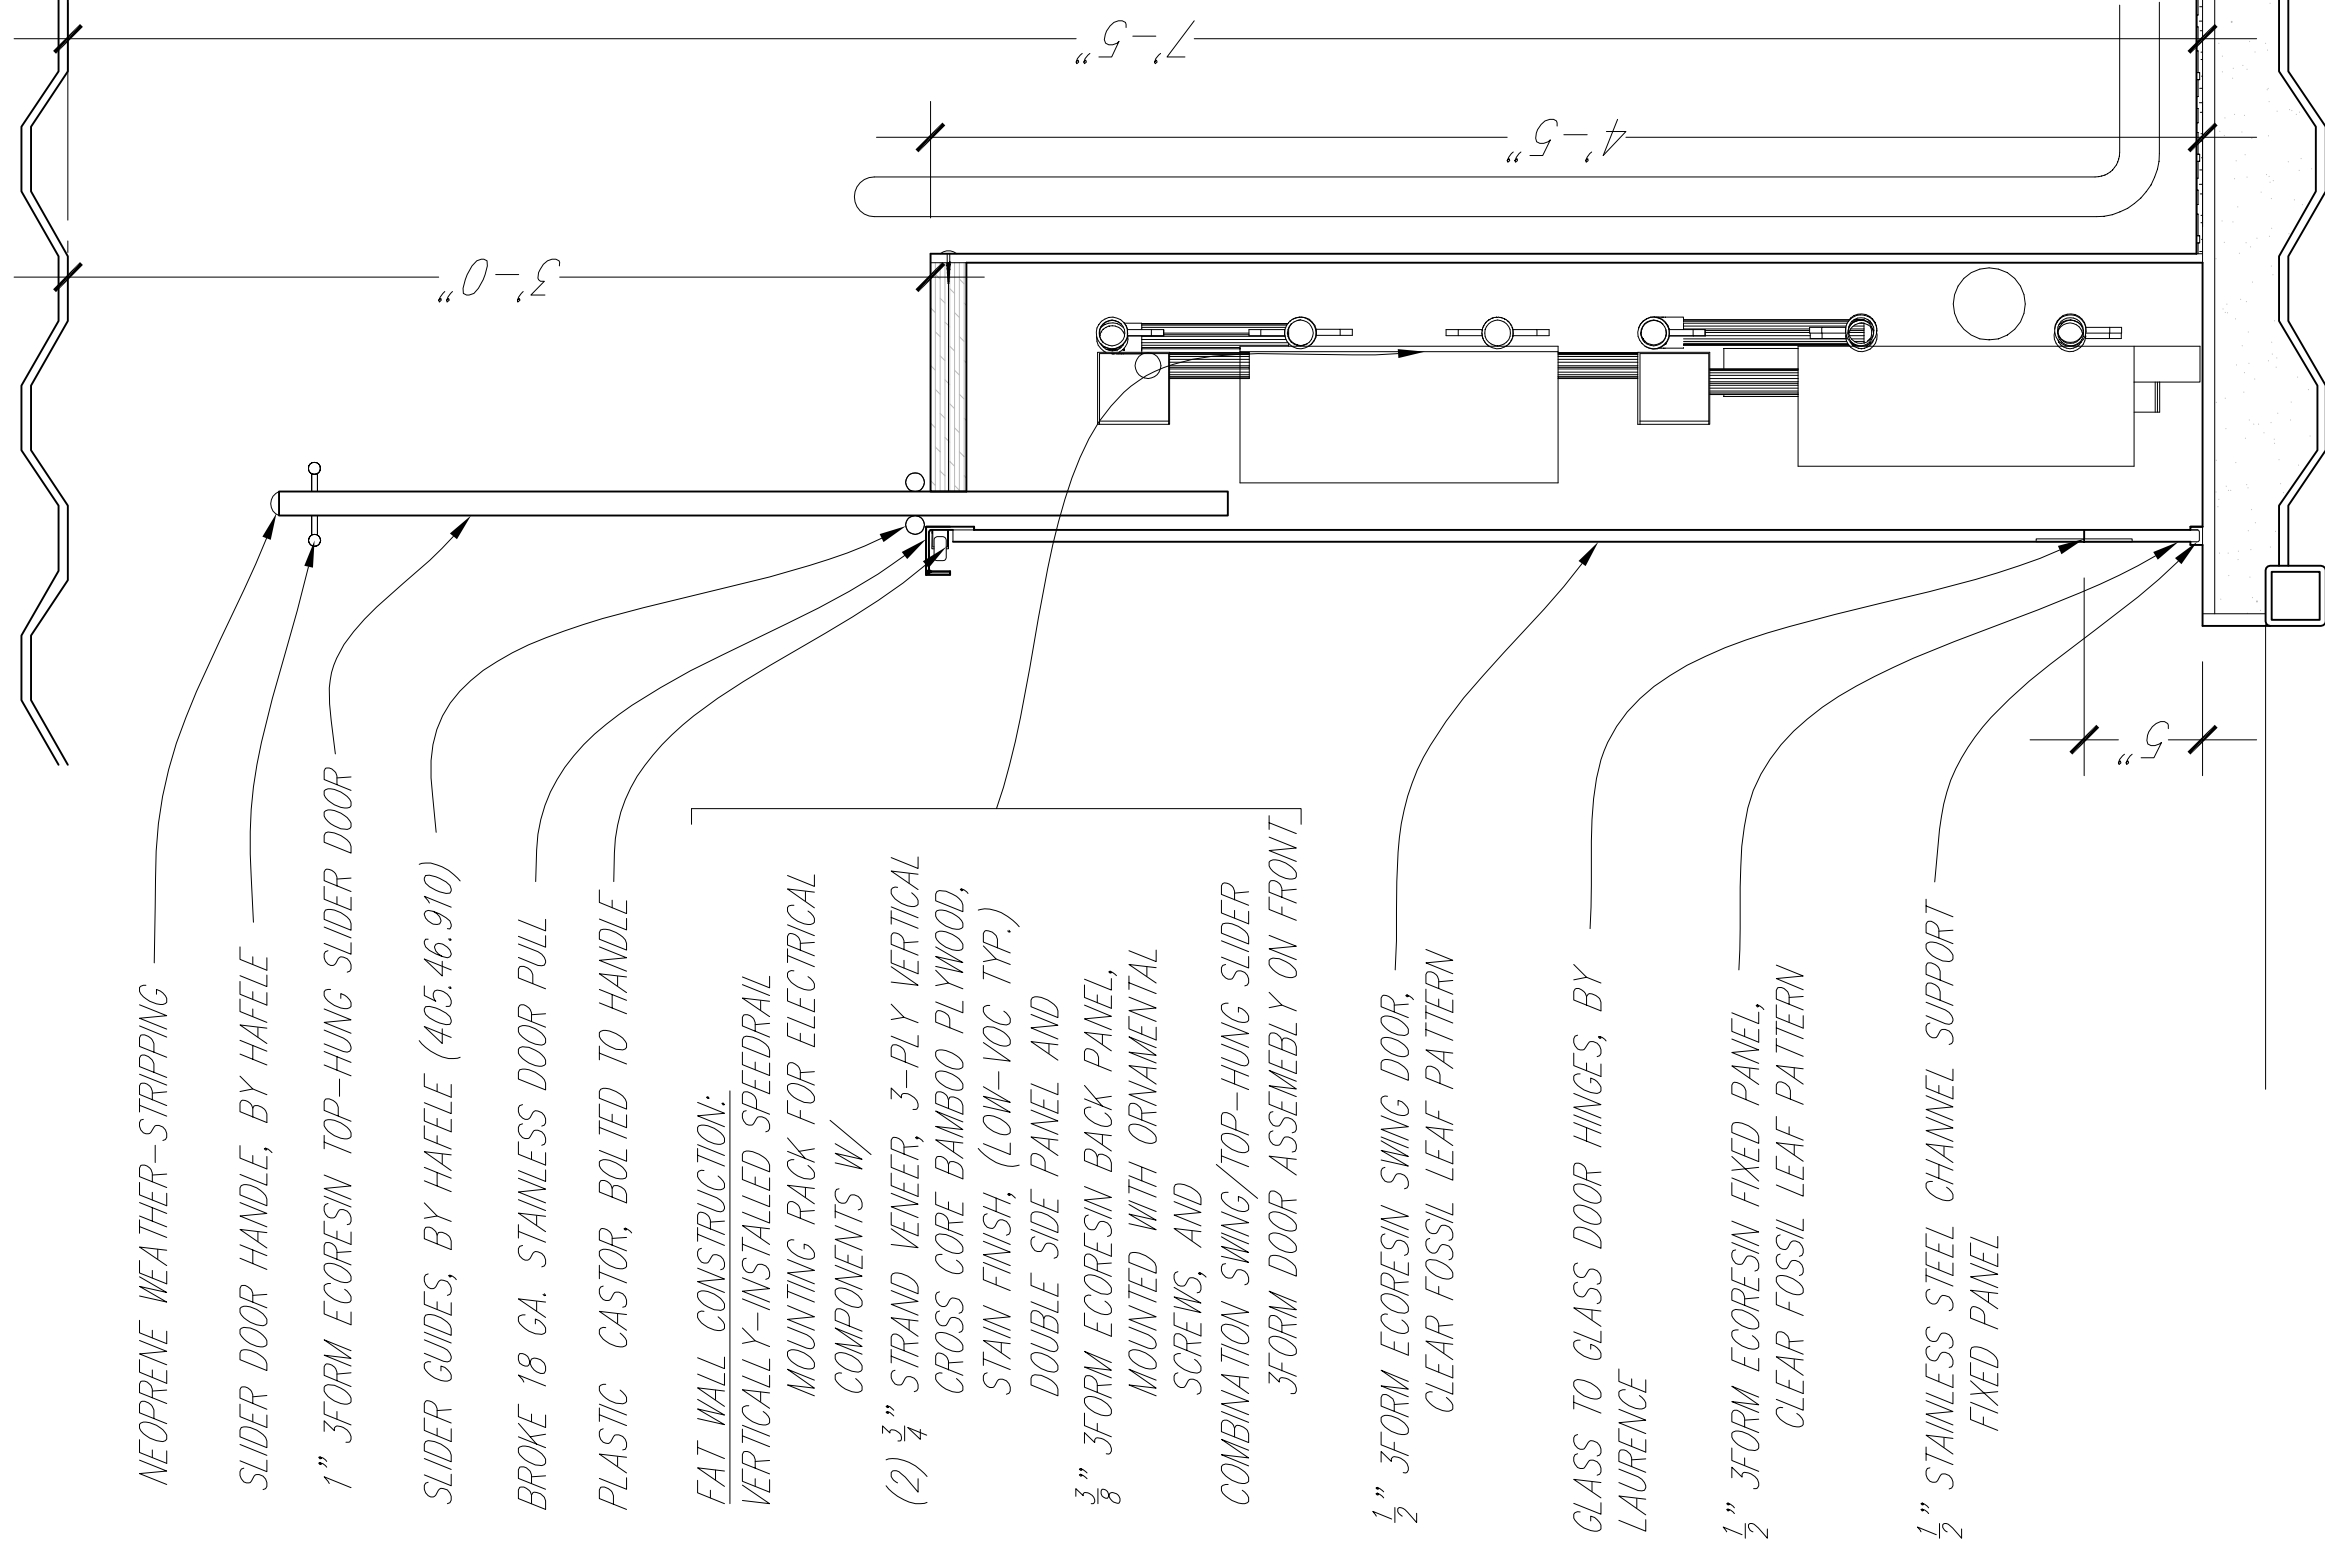

1 FAT WALL PLAN DETAIL  
1  $\frac{1}{2}$ " = 1'-0"




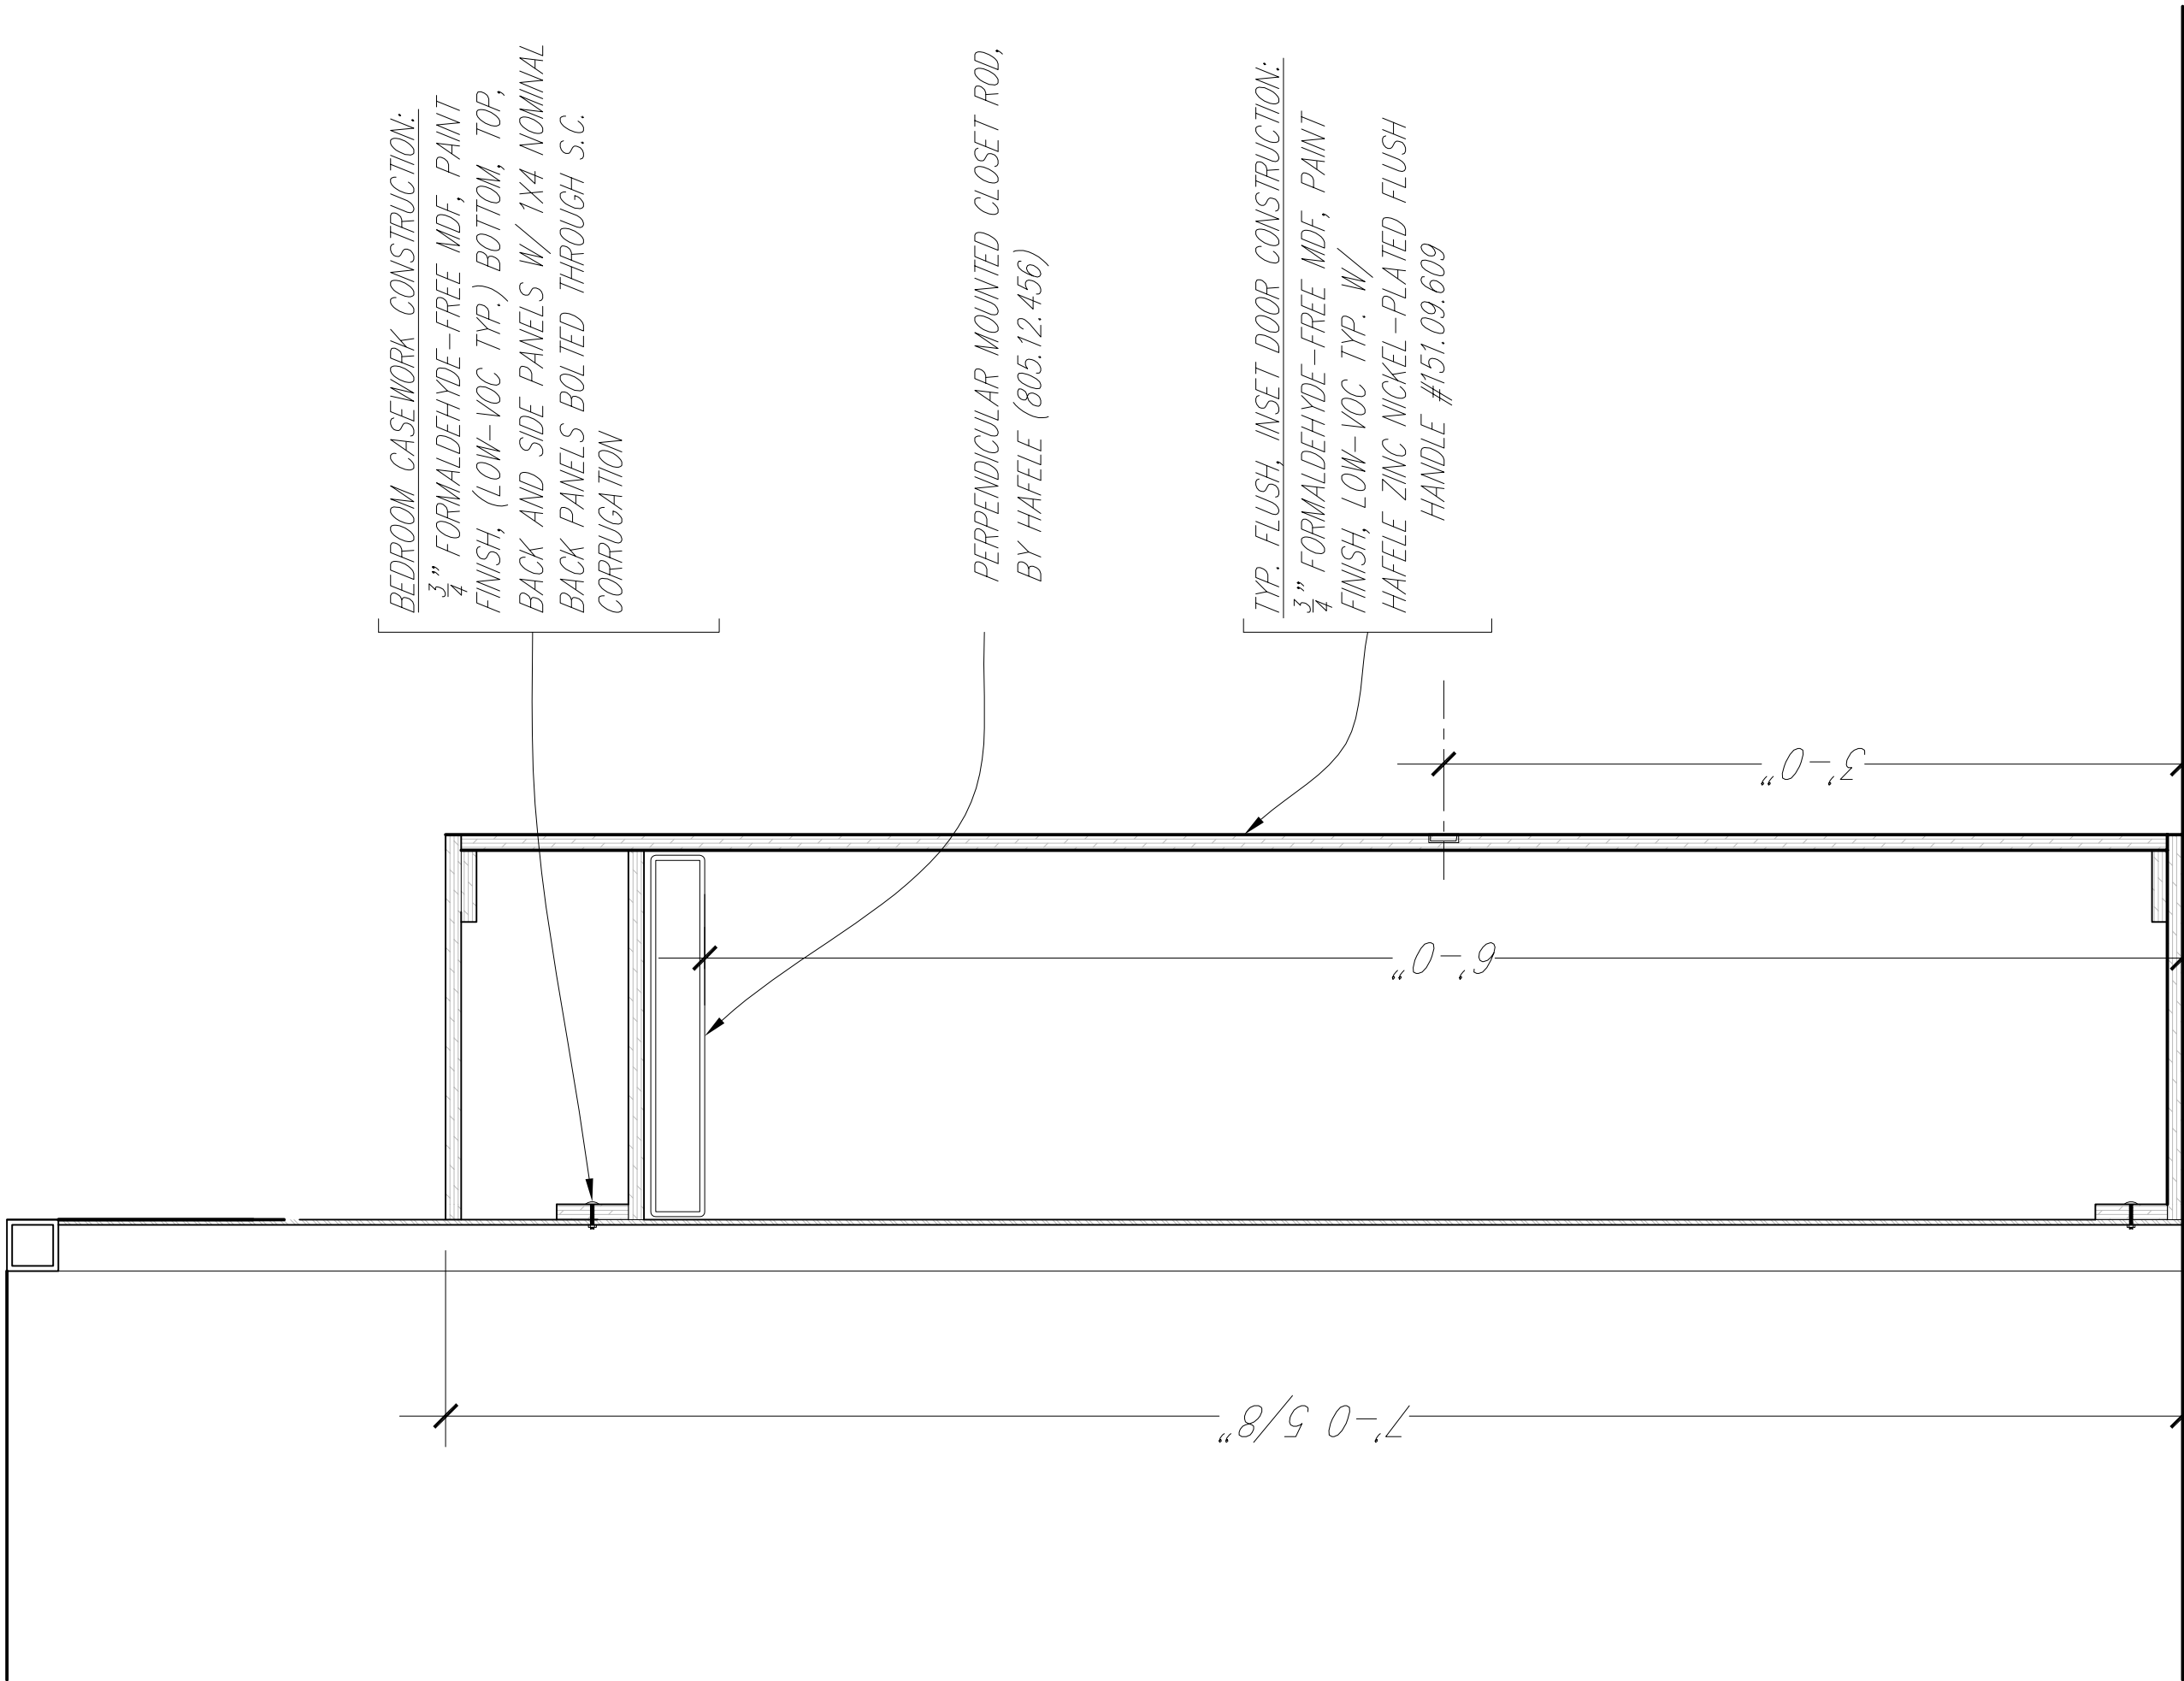

1 BEDROOM SECTION THROUGH CLOSET  
 $1\ 1/2" = 1'-0"$



Drawn by	Date
A.Rude	August 7, 2007
Revised	Date
A.Rude	January 9, 2008

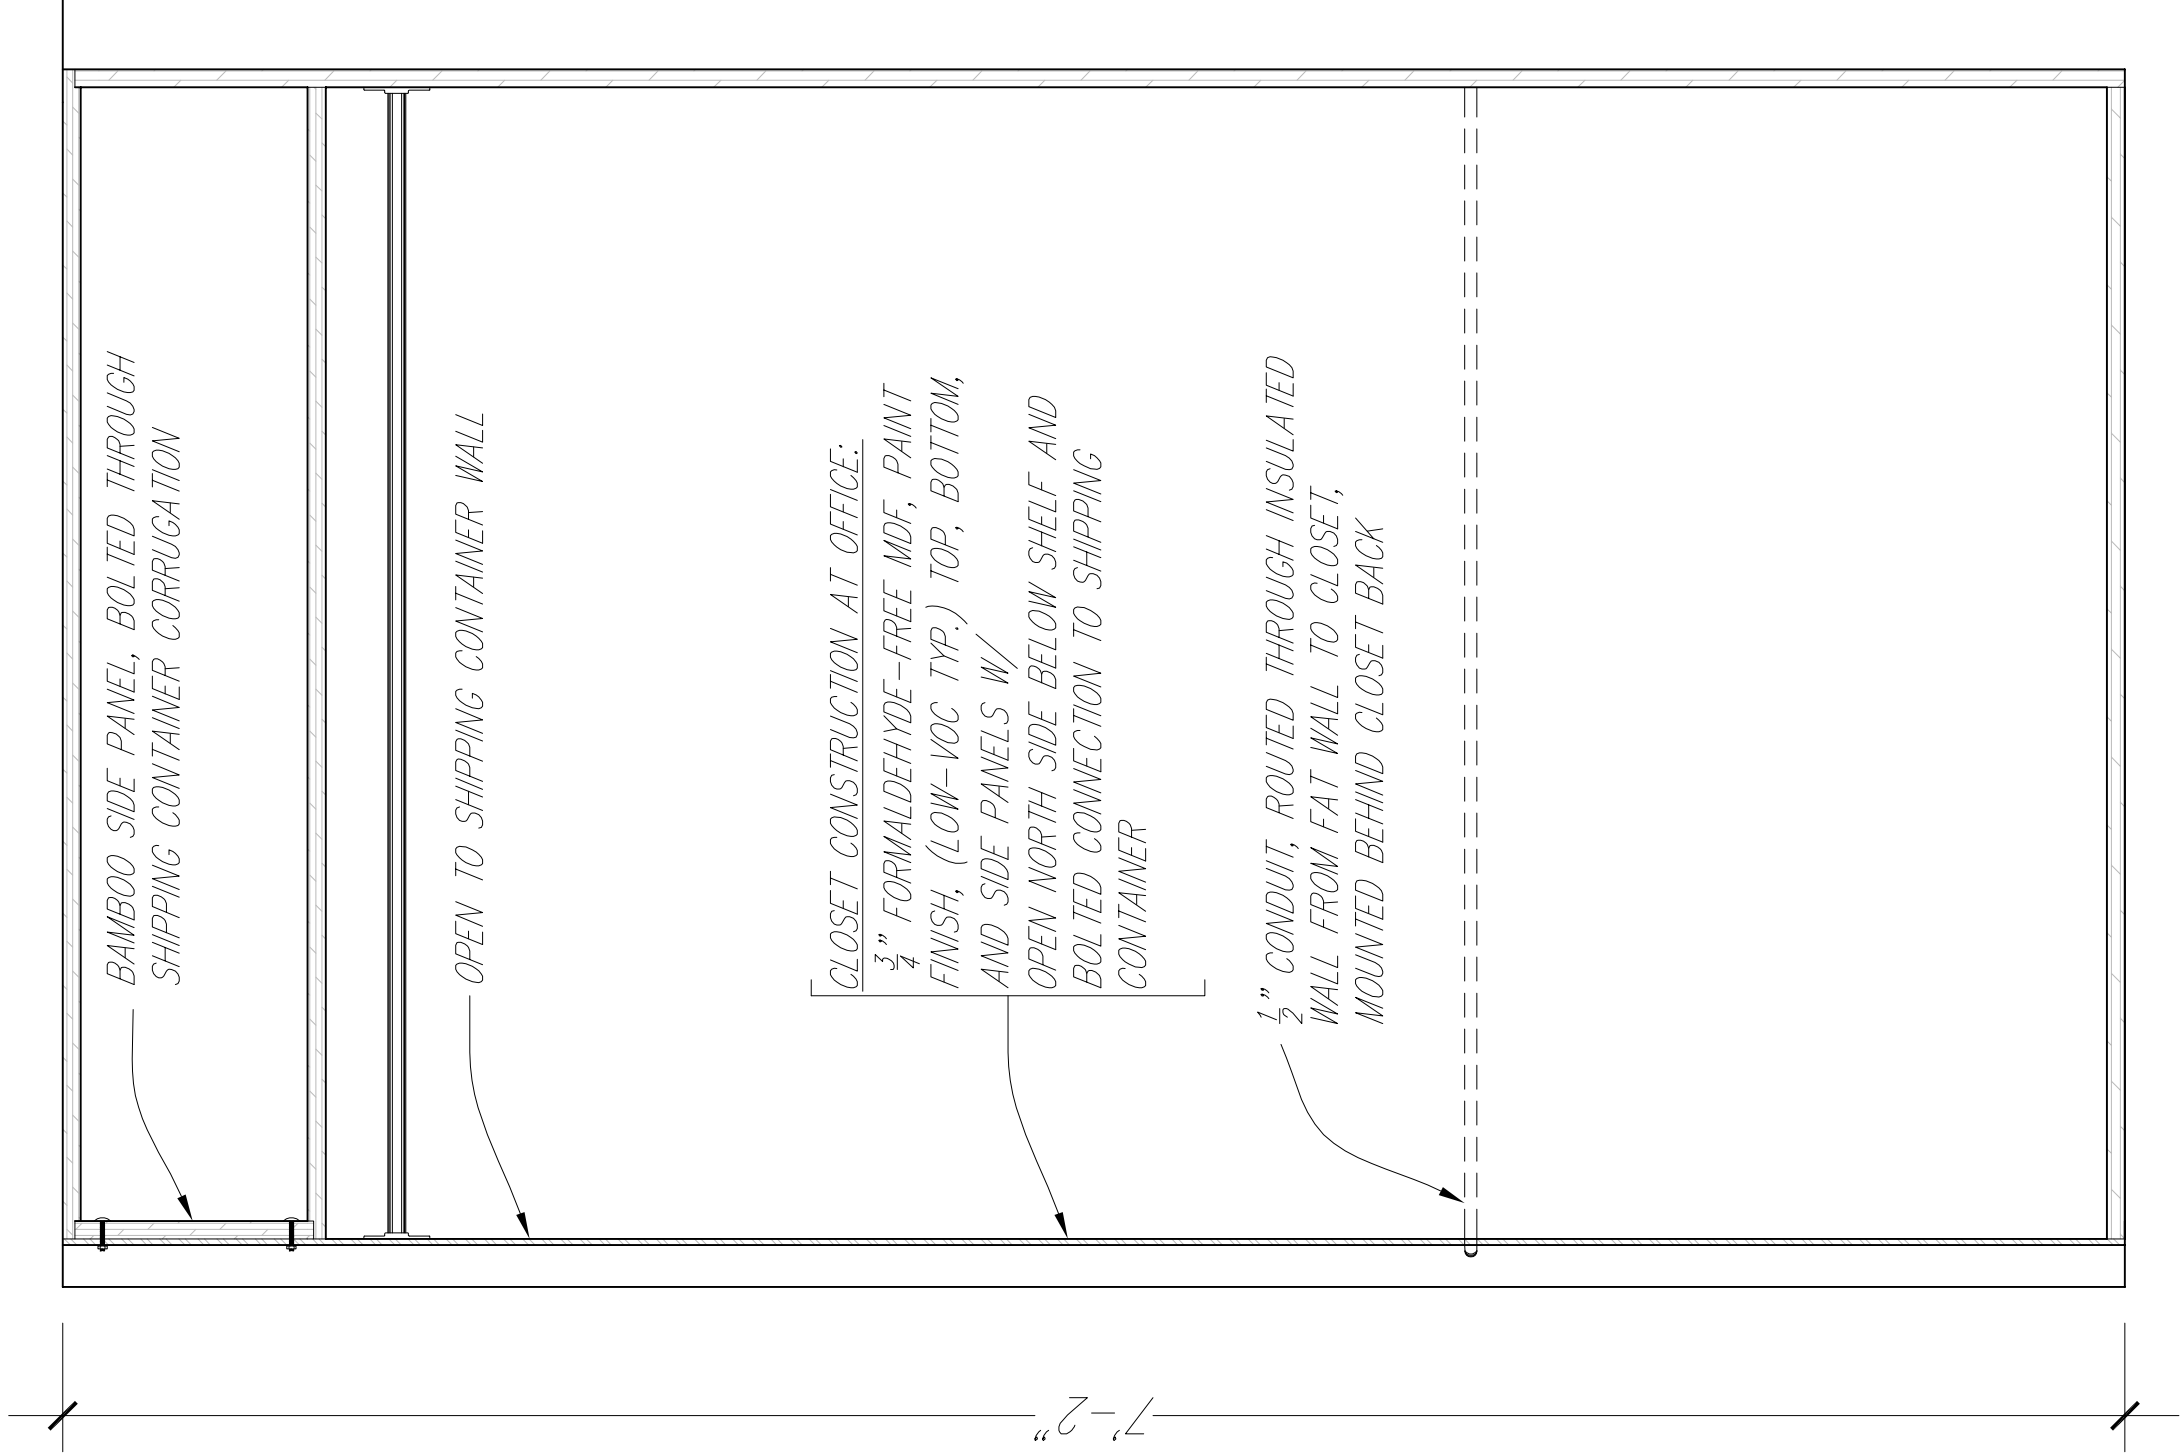

1 SECTION THROUGH S.C. WALL

1 1/2" = 1'-0"




A6.13


Office Closet Section

2007 Solar Decathlon

University of Colorado at Boulder  
Civil, Environmental, and Architectural Engineering  
428 UCB, Room ECCE 441  
Boulder, CO 80309-0428

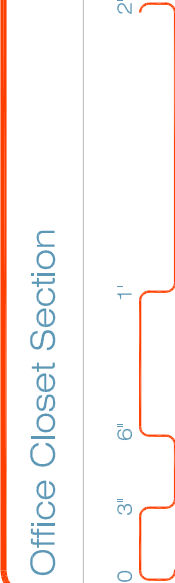

Drawn by	Date
A. Rude	August 7, 2007
Revised	Date
A. Rude	January 9, 2008

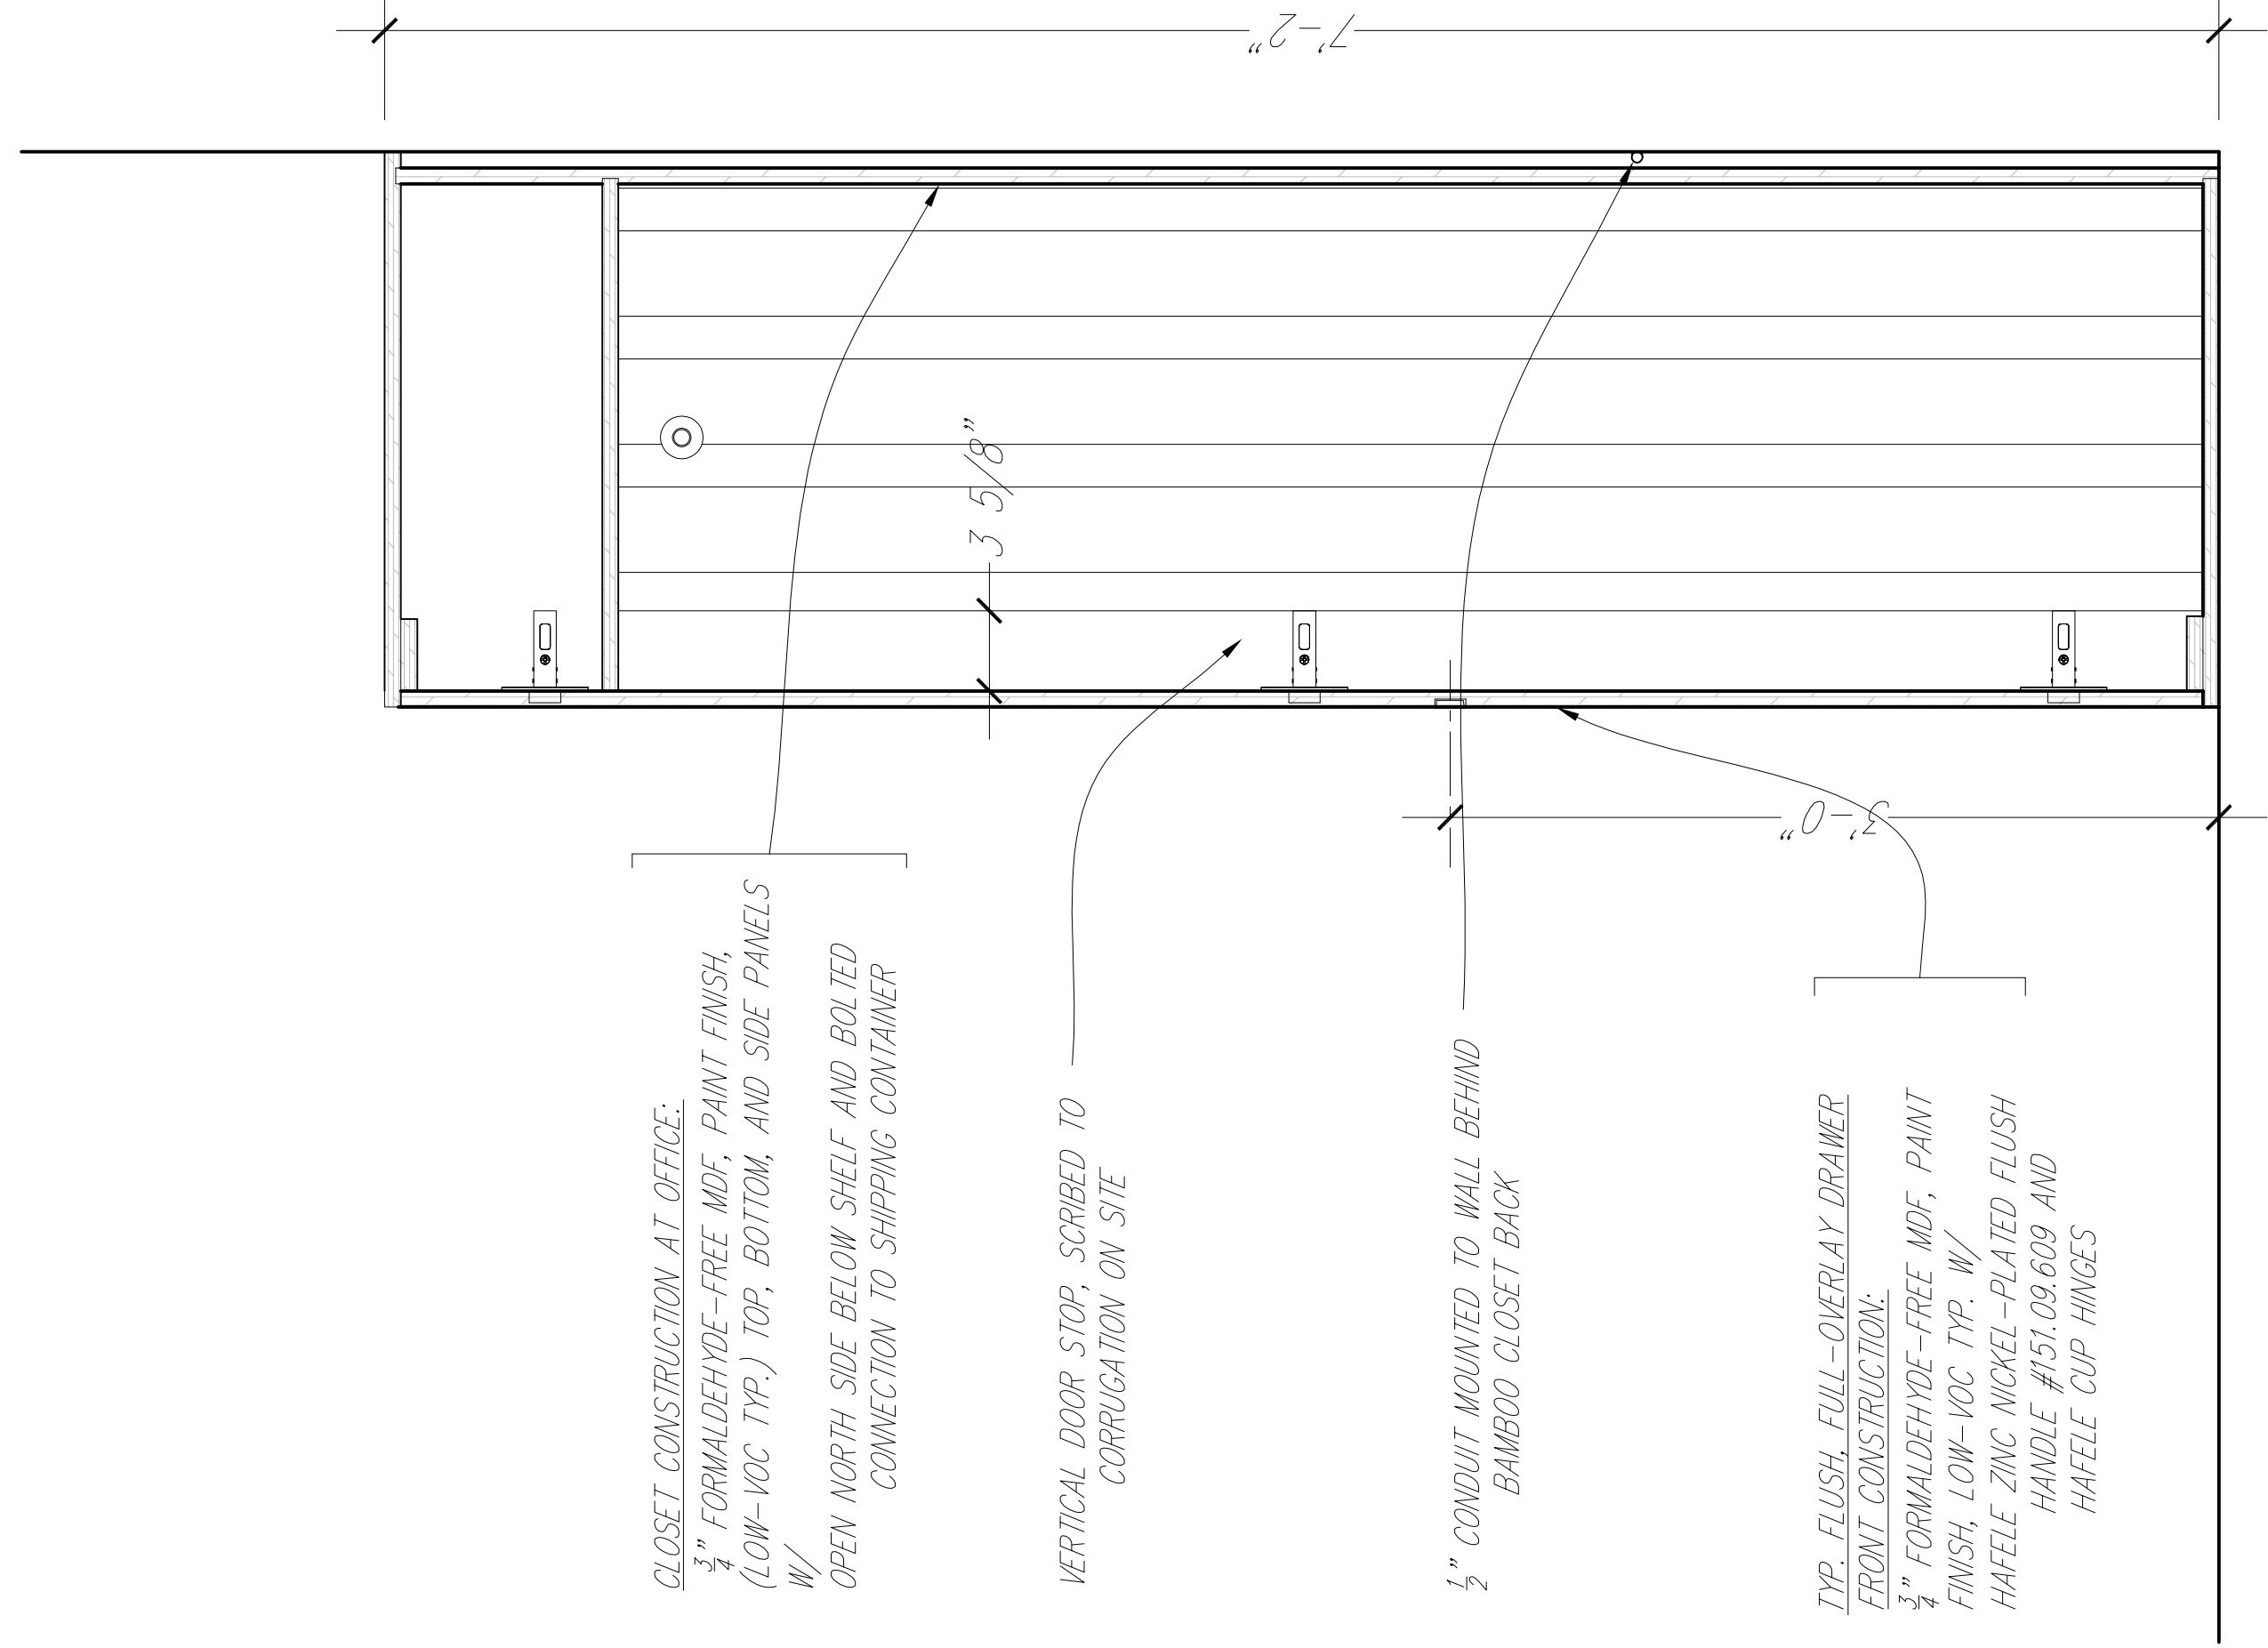


1 SECTION AT CLOSET

$$1 \frac{1}{2}'' = 1'-0''$$



Drawn by	Date
A. Rude	August 7, 2007
Revised	Date
A. Rude	January 9, 2008



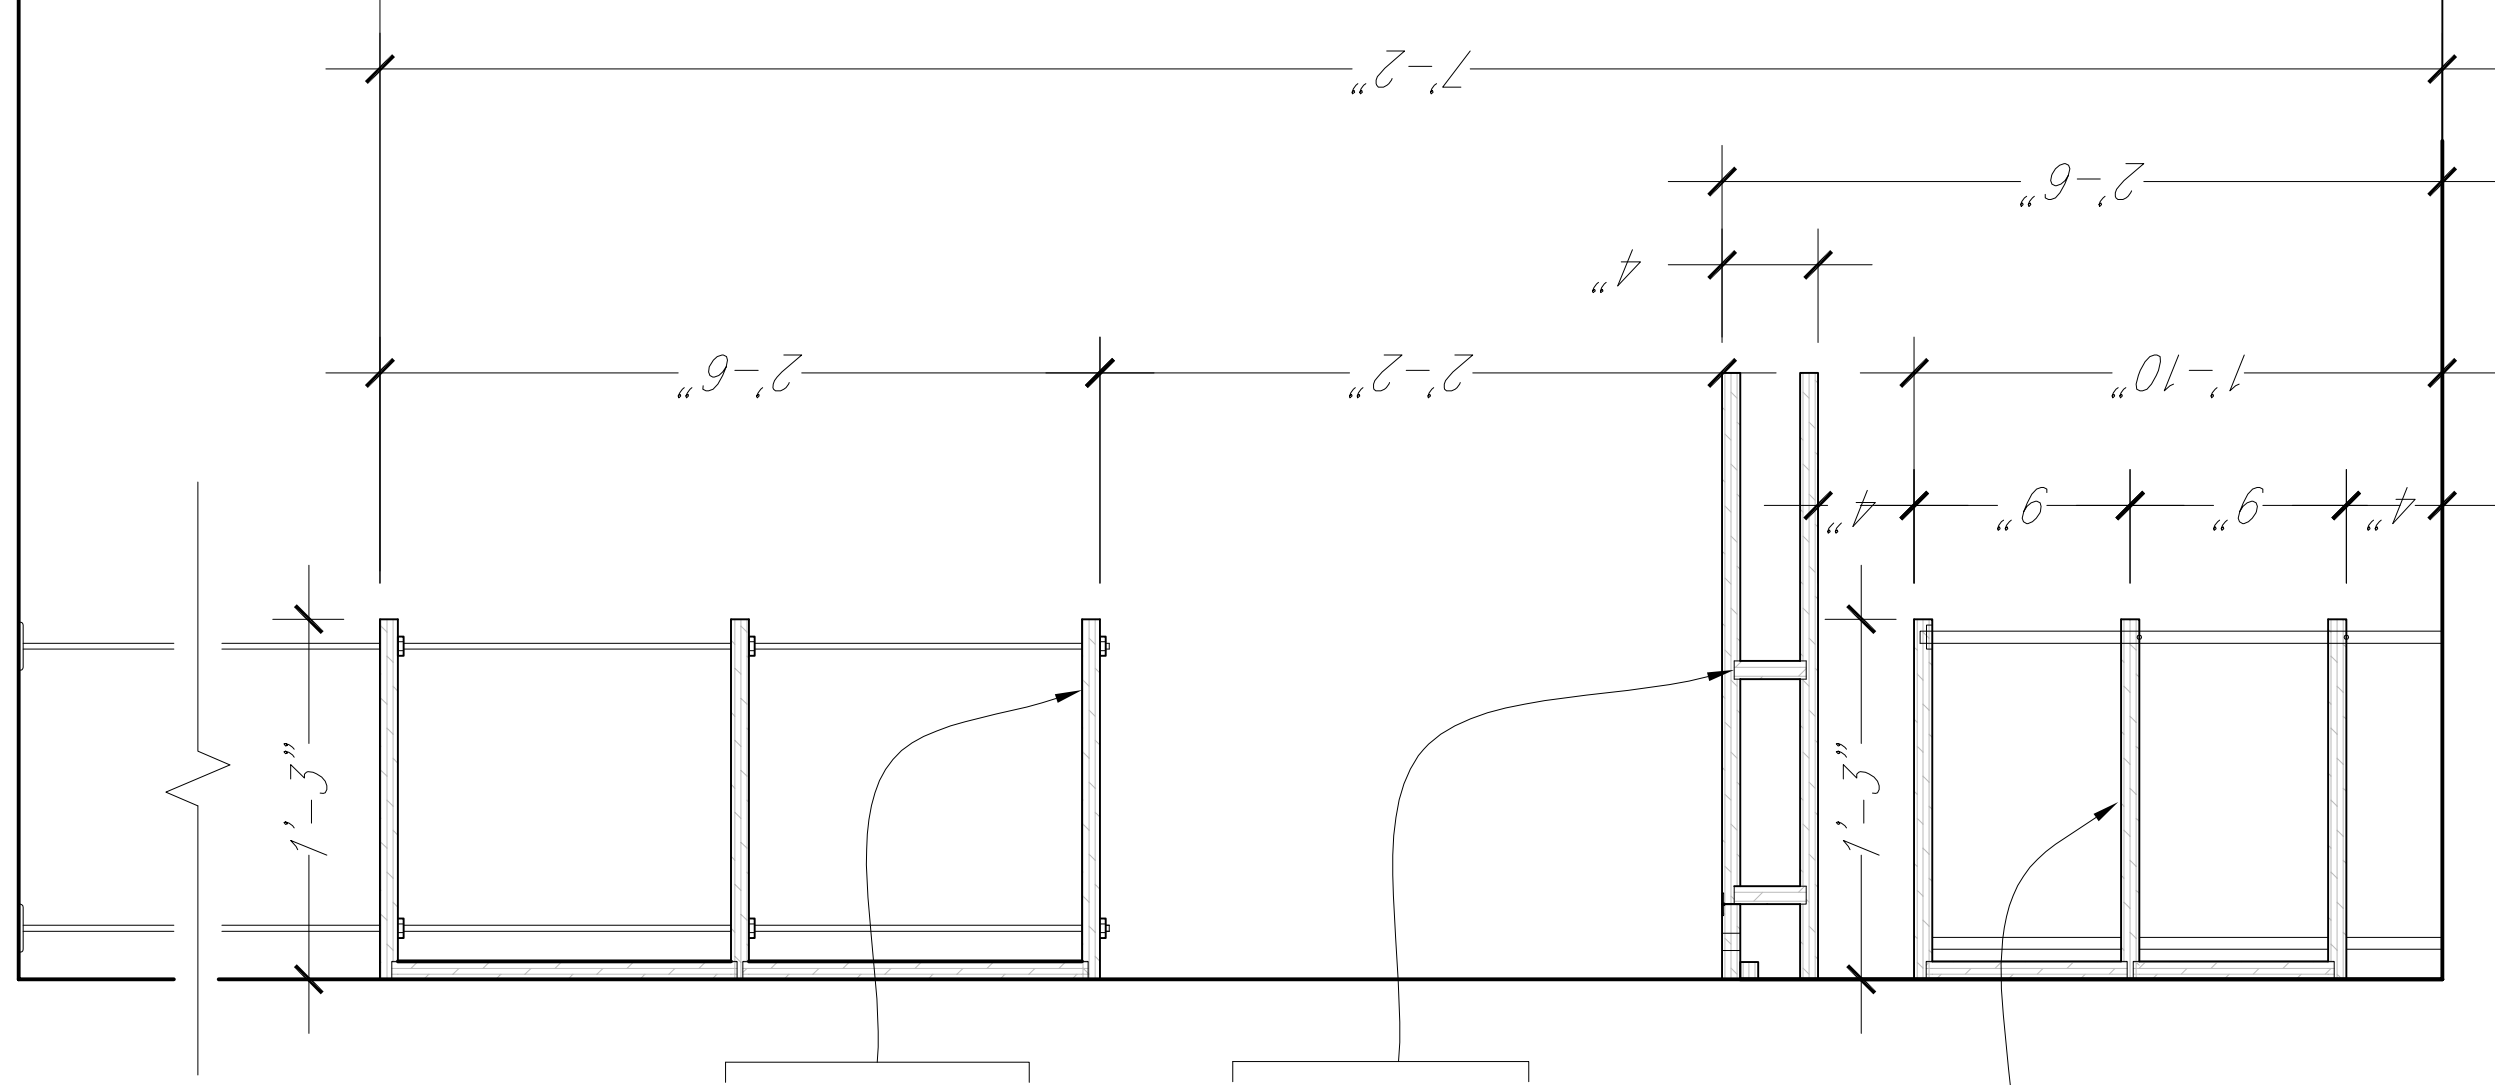

TOP SHELF ASSEMBLY CONSTRUCTION:  
3/4" FORMALDEHYDE-FREE MDF, PAINT FINISH,  
LOW-VOC TYP. SHELVES,  
HUNG FROM CEILING BY (2) 1/4" ALL-THREAD  
LENGTHS, BOLTED TO BOTTOM OF SHELF

DESK CONSTRUCTION:  
3/4" FORMALDEHYDE-FREE MDF, PAINT FINISH,  
LOW-VOC TYP. W/  
(2) 3/4" 3-PLY VERTICAL CROSS CORE BAMBOO  
PLYWOOD STIFFENERS AND 3" X 3/4" BUILT-IN  
WIRING TRAY FLAP, HINGED TO DESK



BOTTOM SHELF ASSEMBLY CONSTRUCTION:  
3/4" FORMALDEHYDE-FREE MDF, PAINT  
FINISH, LOW-VOC TYP. SHELVES,  
MOUNTED WITH 1/2" STAINLESS STEEL  
PIPING, SET ON 3/16" SET SCREWS

1 SECTION AT OFFICE DESK


1 1/2" = 1'-0"



Drawn by	Date
A. Rude	August 7, 2007
Revised	Date
A. Rude	January 9, 2008

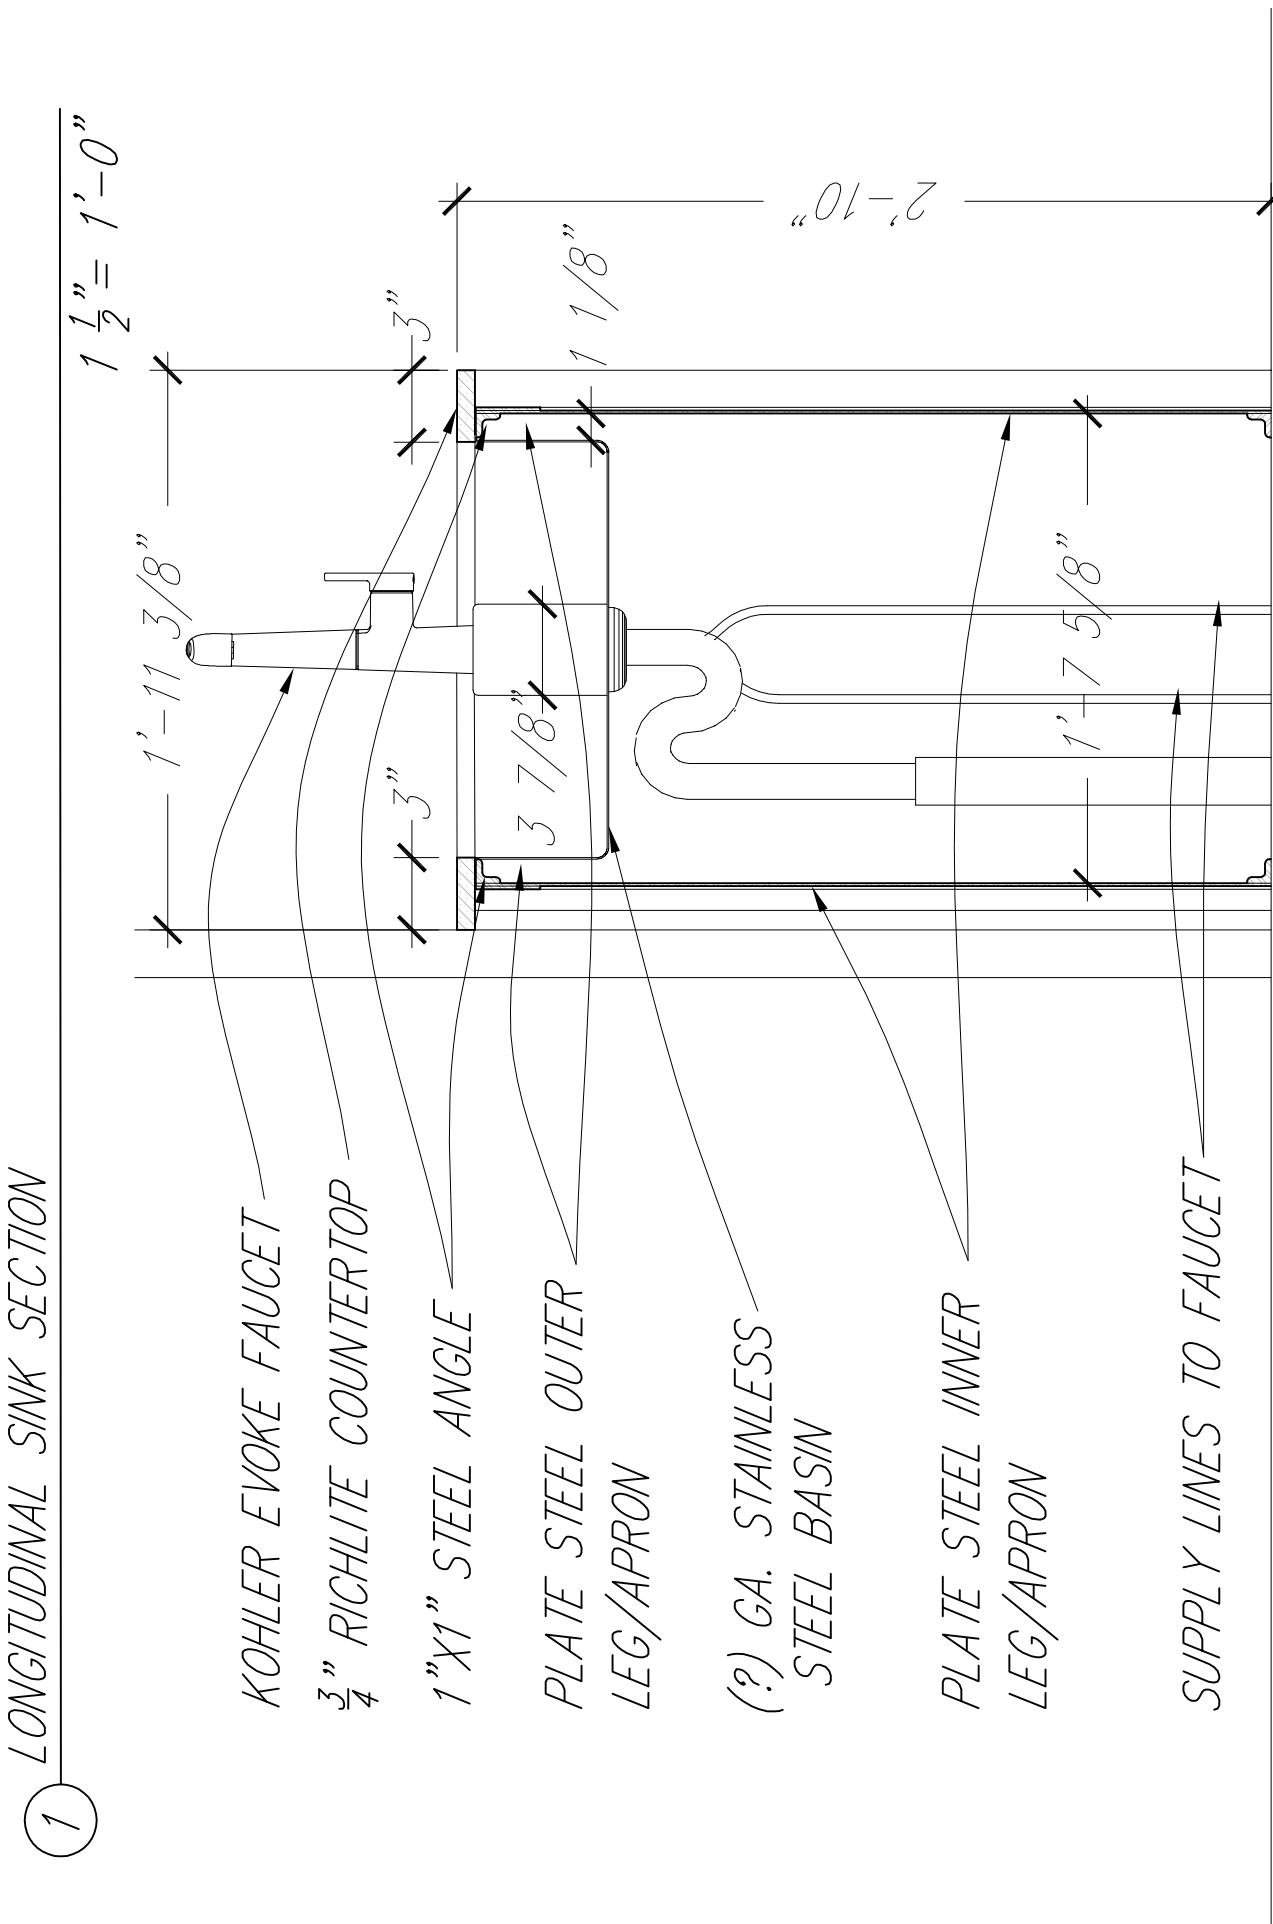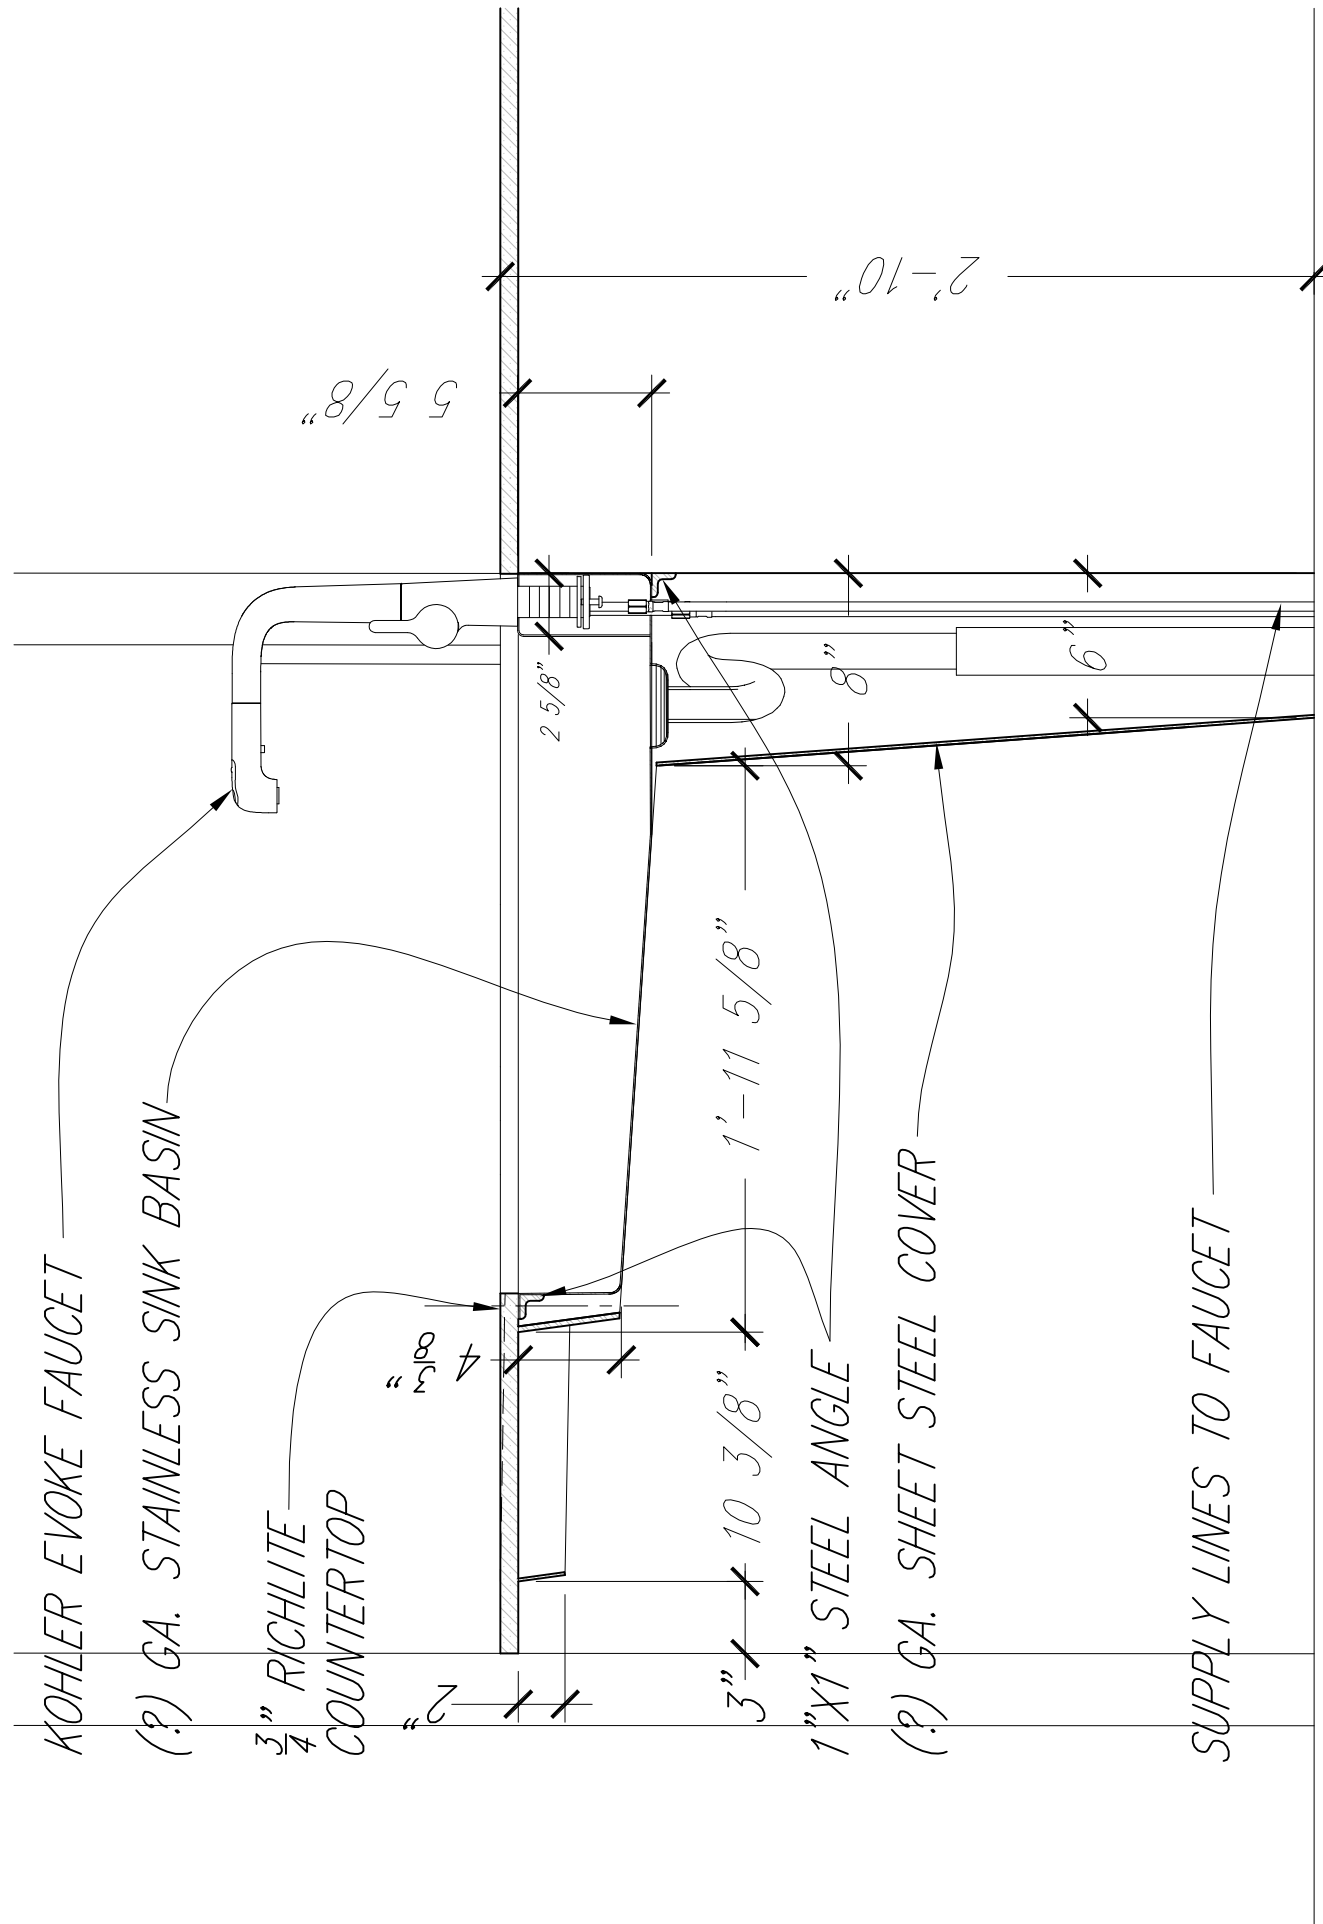

Drawn by	Date
A. Rude	August 7, 2007
Revised	Date

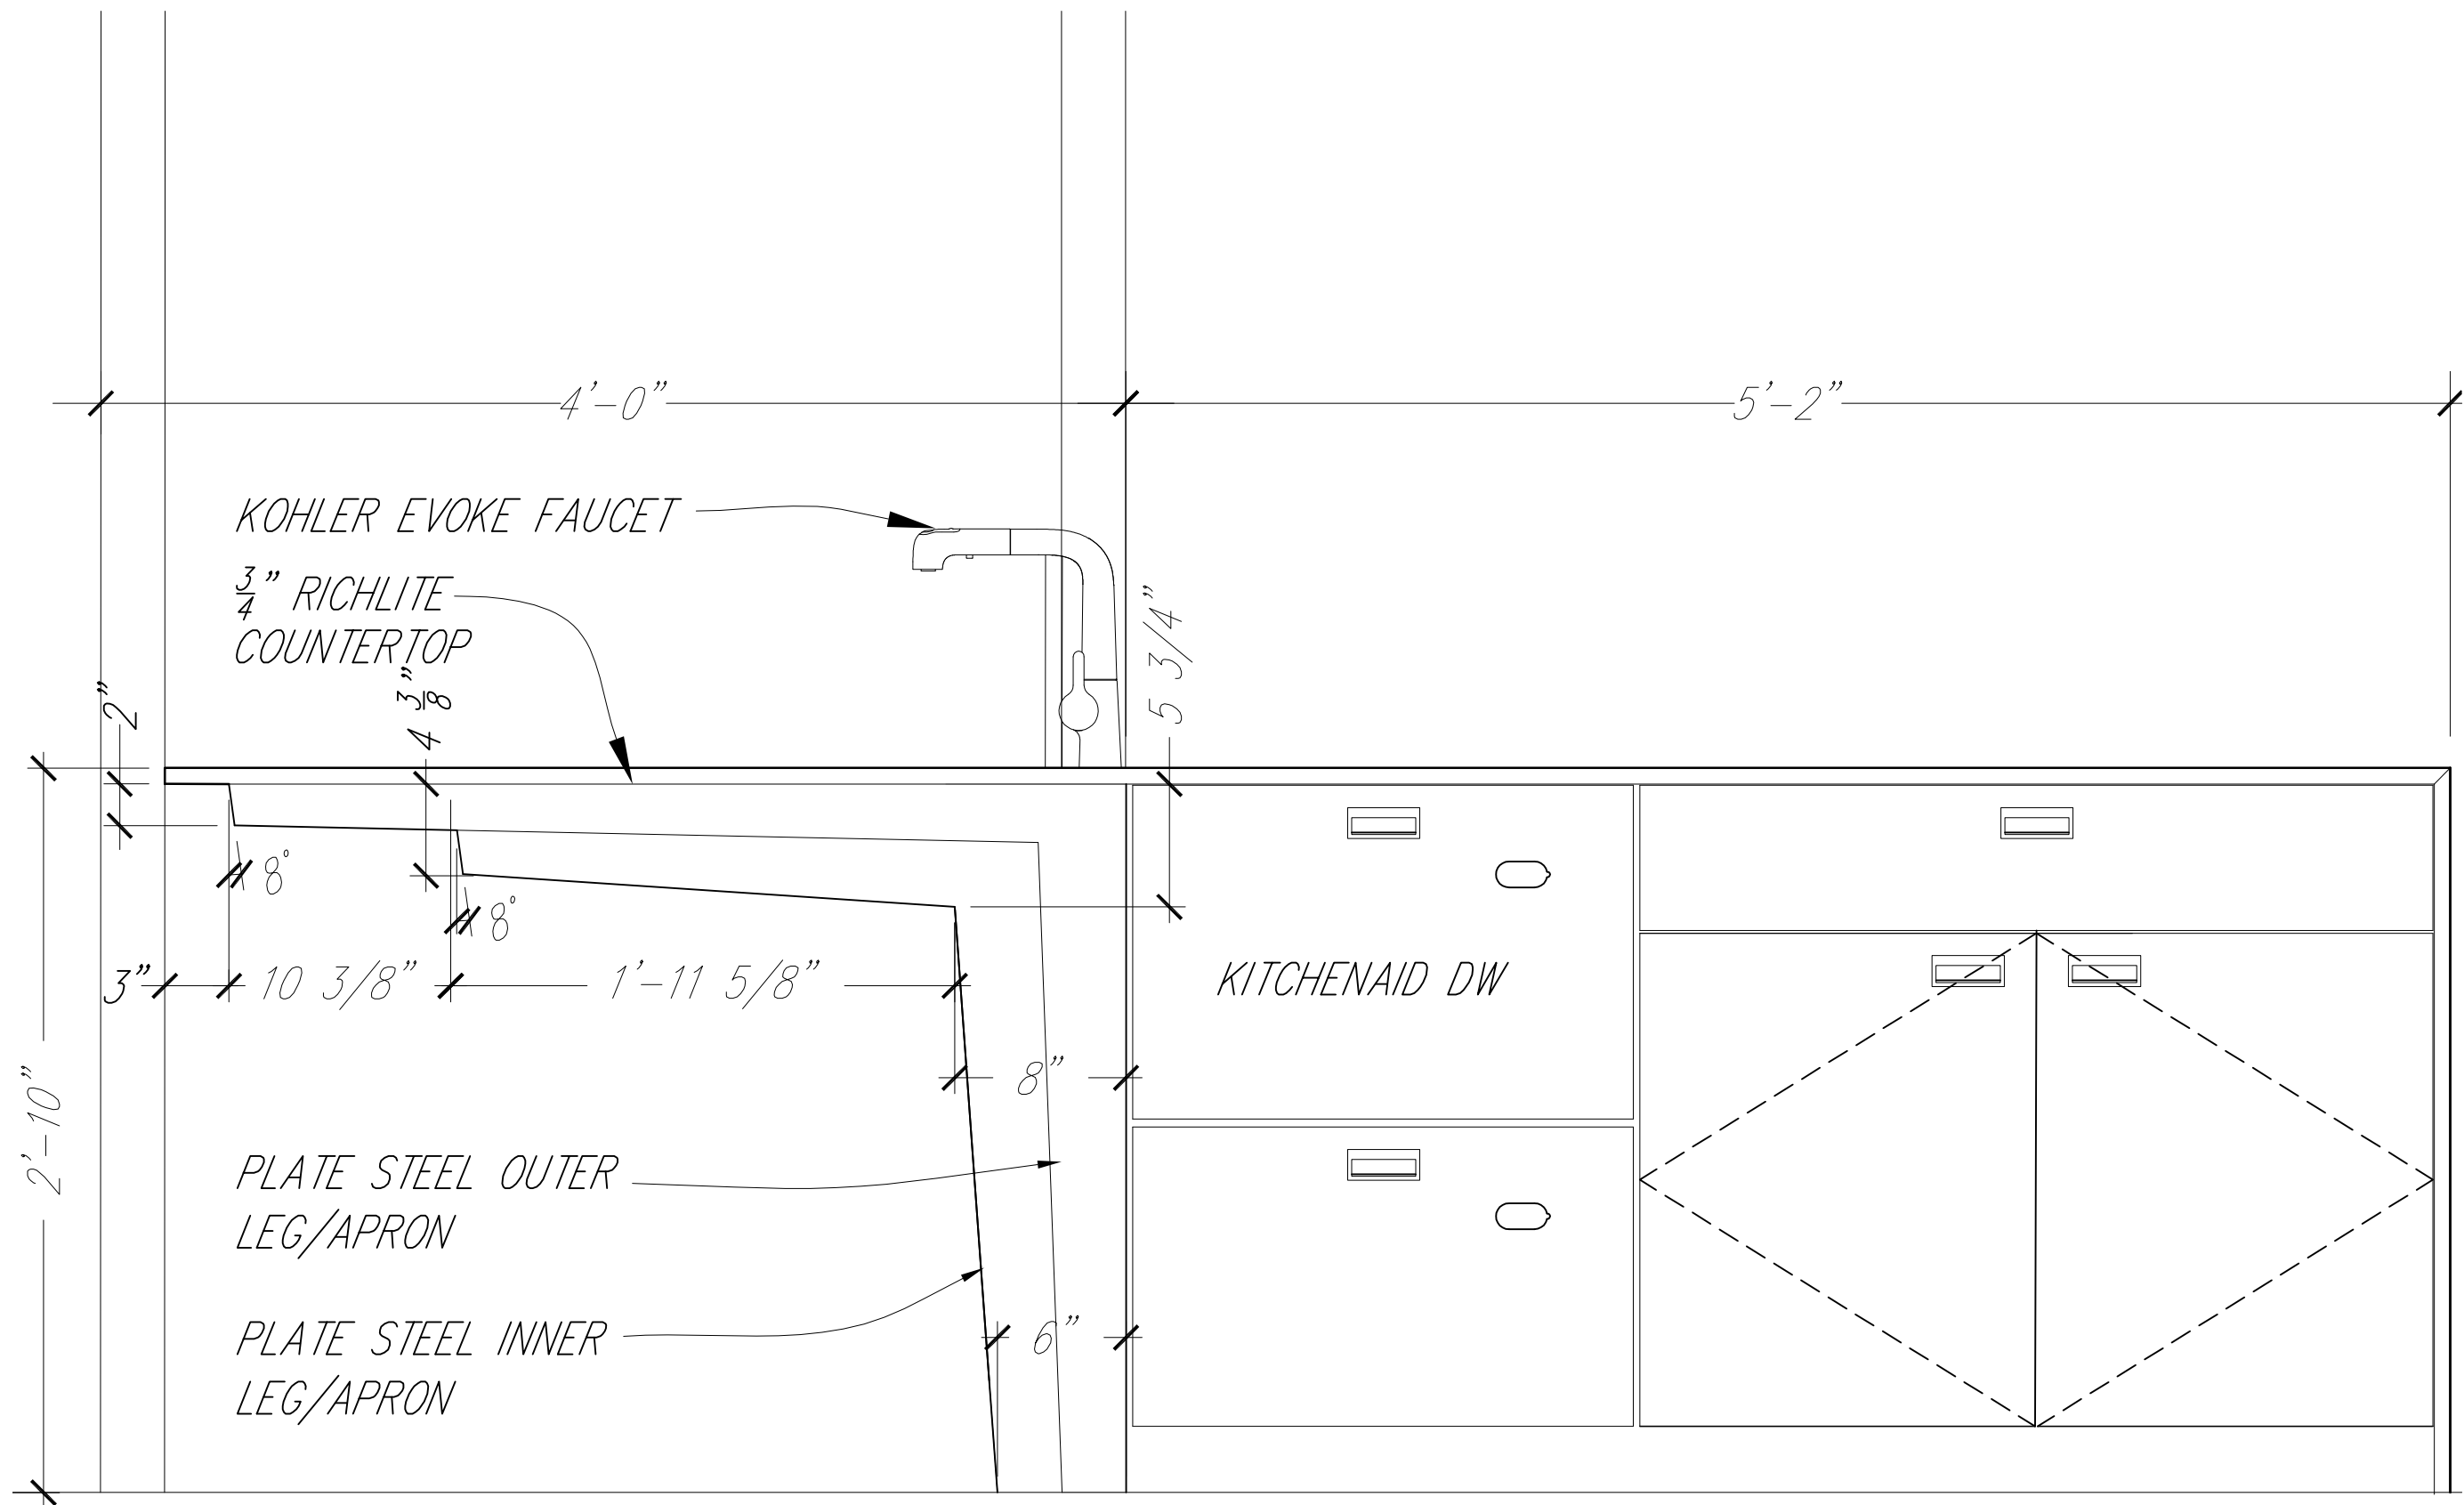



1 SINK ELEVATION DETAIL

1 1/2" = 1'-0"

Drawn by	Date
A. Rude	August 7, 2007
Revised	Date

Sink Elevation Detail	2007 Solar Decathlon
0	University of Colorado at Boulder
3'	Civil, Environmental, and Architectural Engineering
6'	428 UCB, Room ECCE 441
1'	Boulder, CO 80309-0428
2'	



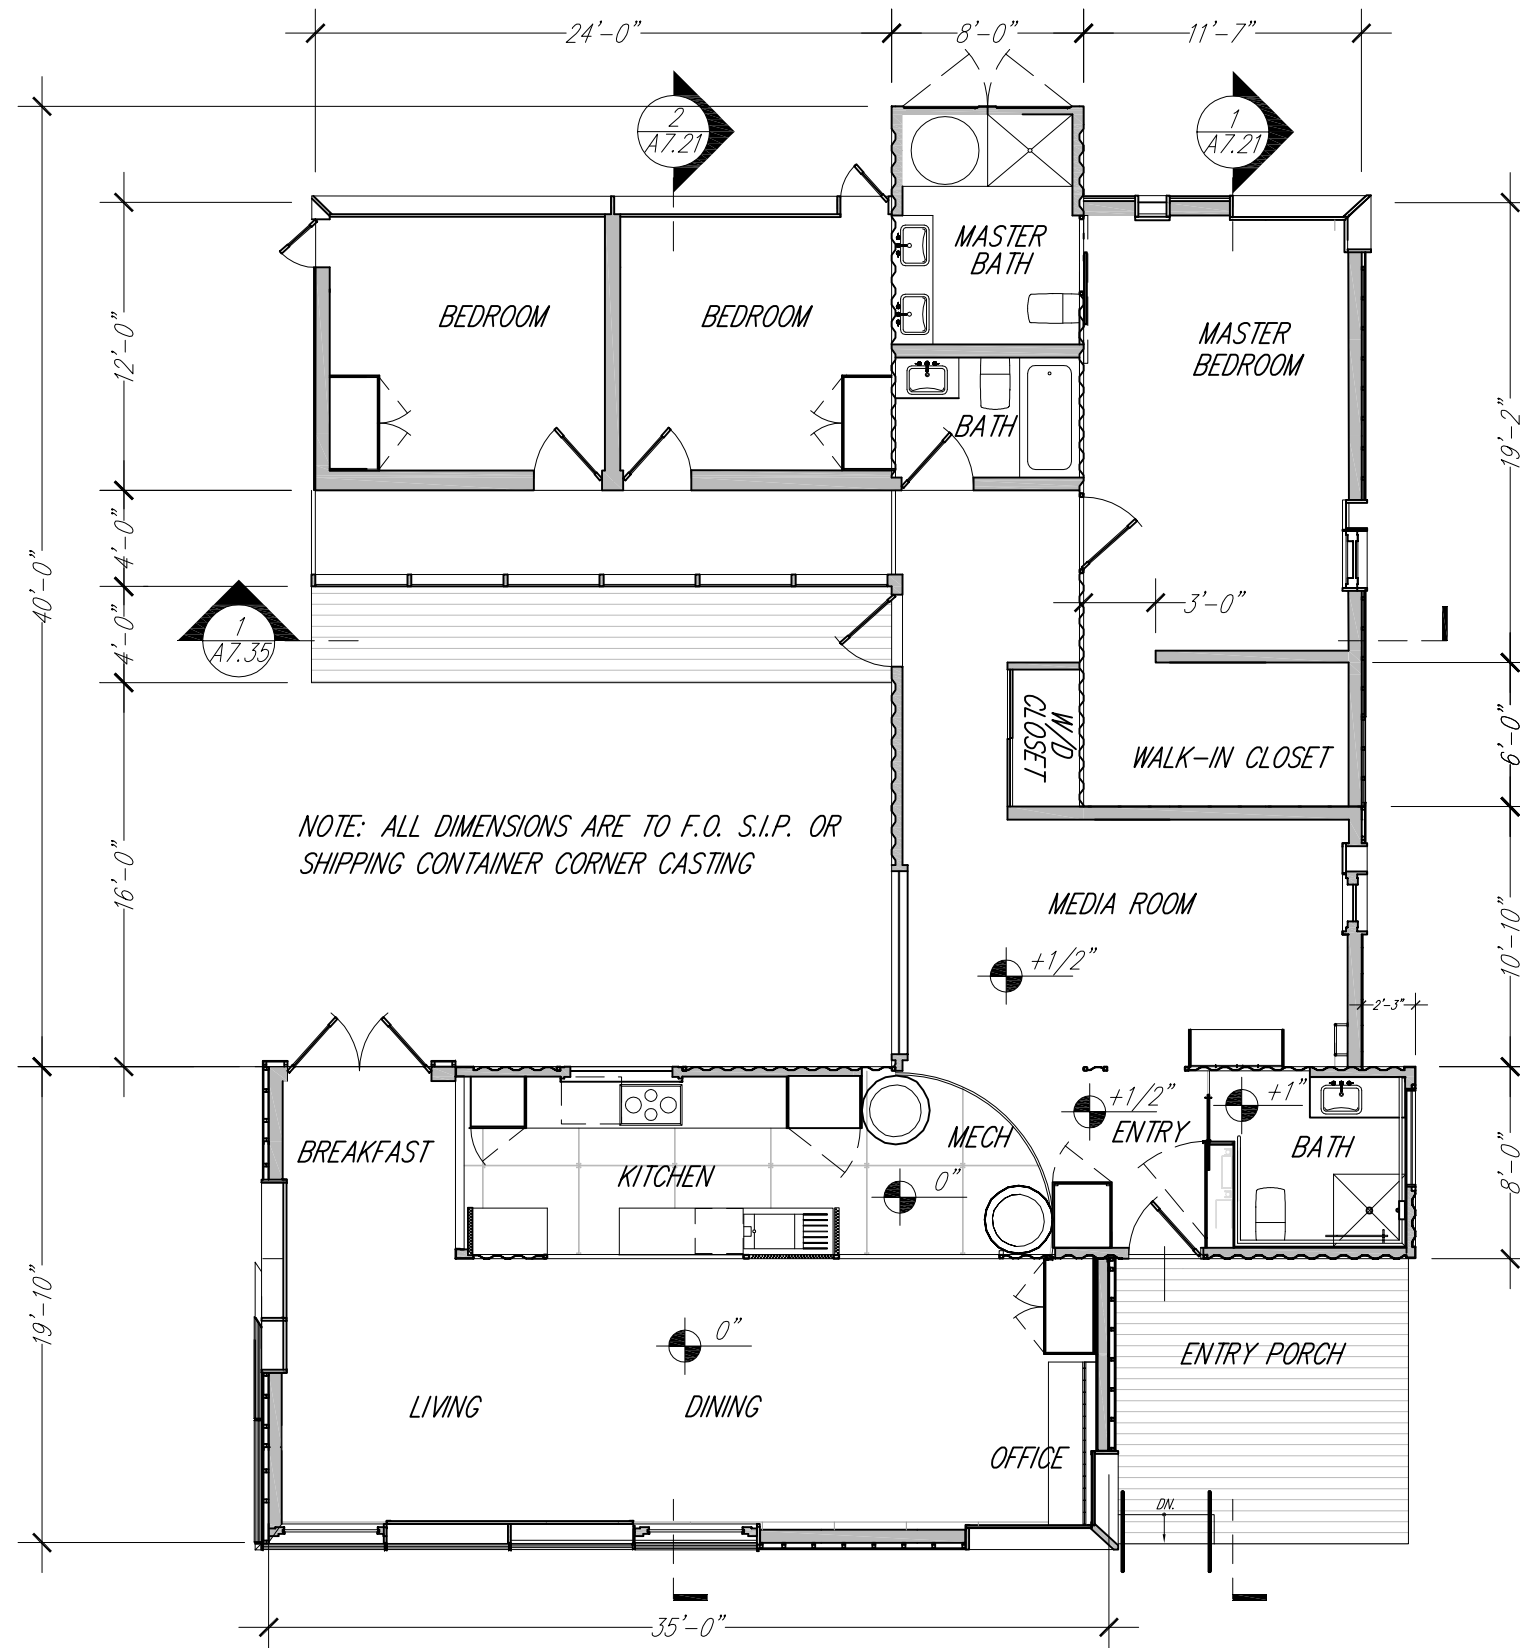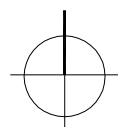

1 COMPLETE HOUSE GROUND LEVEL FLOOR PLAN

1/8" = 1'-0"

Drawn by	Date	Revised	Date
A. Rude	August 7, 2007		

Complete House Floor Plan


2007 Solar Decathlon

University of Colorado at Boulder

Civil, Environmental, and Architectural Engineering  
428 UCB, Room ECCE 441  
Boulder, CO 80309-0428


0 2' 4' 8' 16'



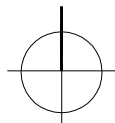

1

# COMPLETE HOUSE ROOF PLAN

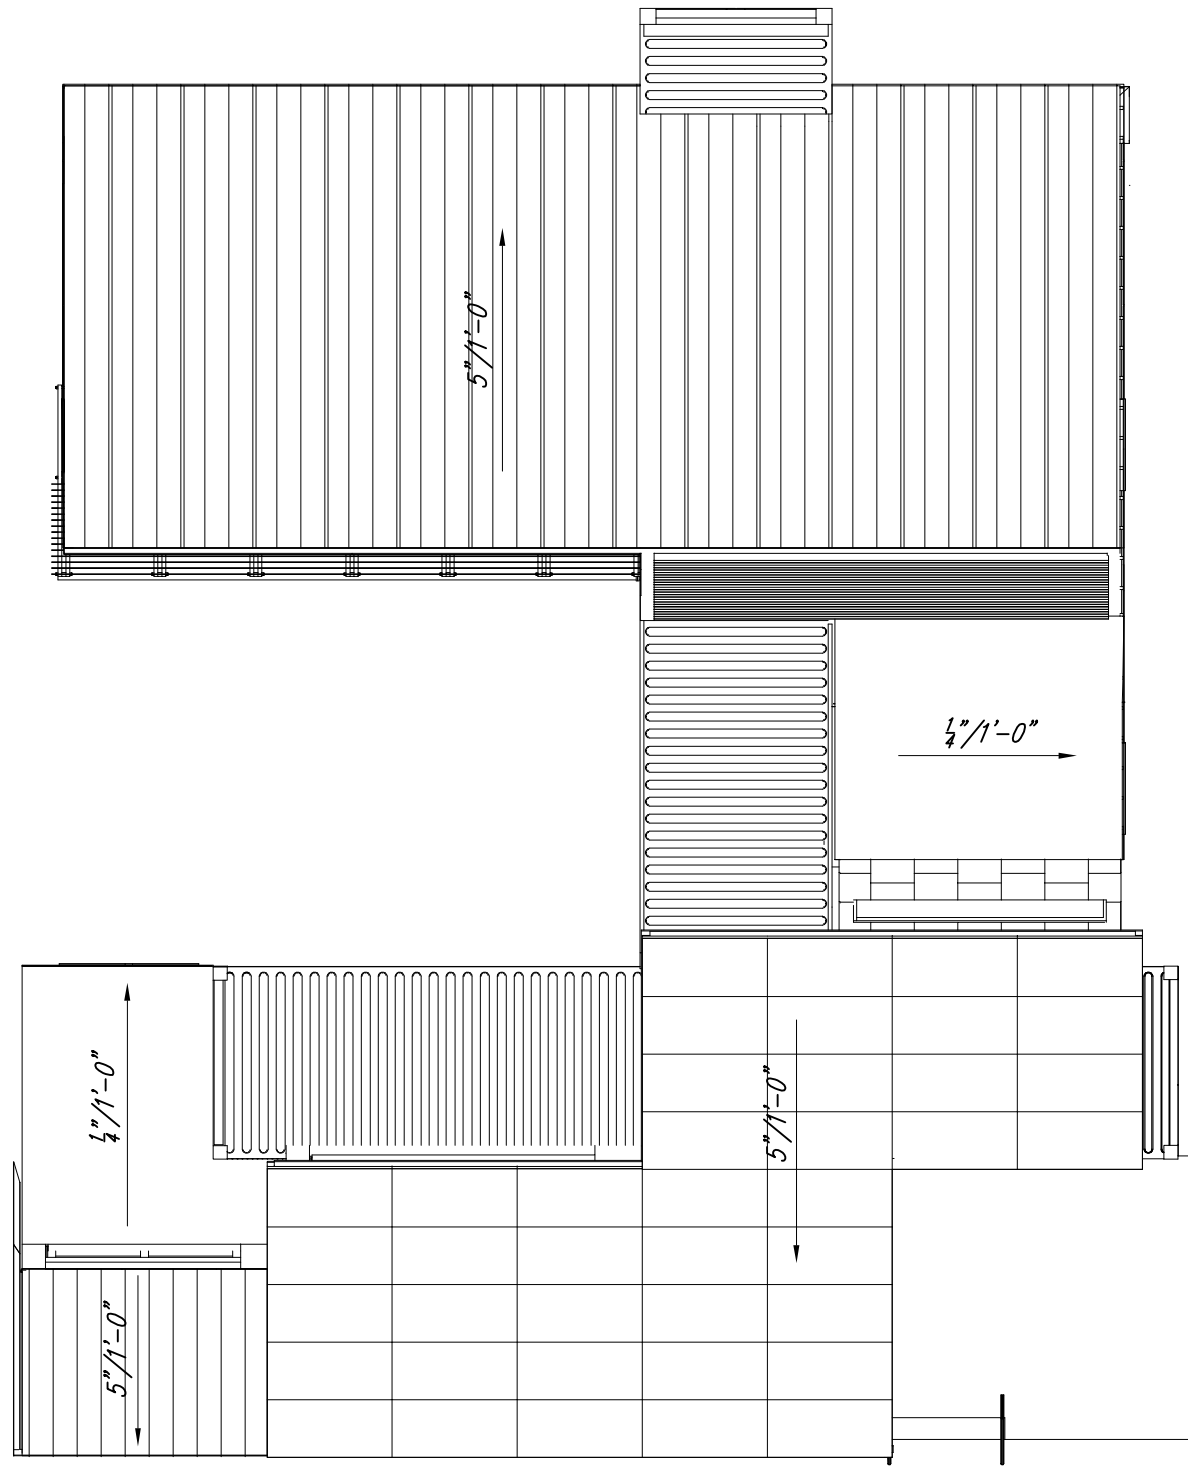

1/8" = 1'-0"



A7.02


Complete House Roof Plan

2007 Solar Decathlon


University of Colorado at Boulder  
Civil, Environmental, and Architectural Engineering  
428 UCB, Room ECCE 441  
Boulder, CO 80309-0428

Drawn by	Date
A. Rude	August 7, 2007
Revised	Date




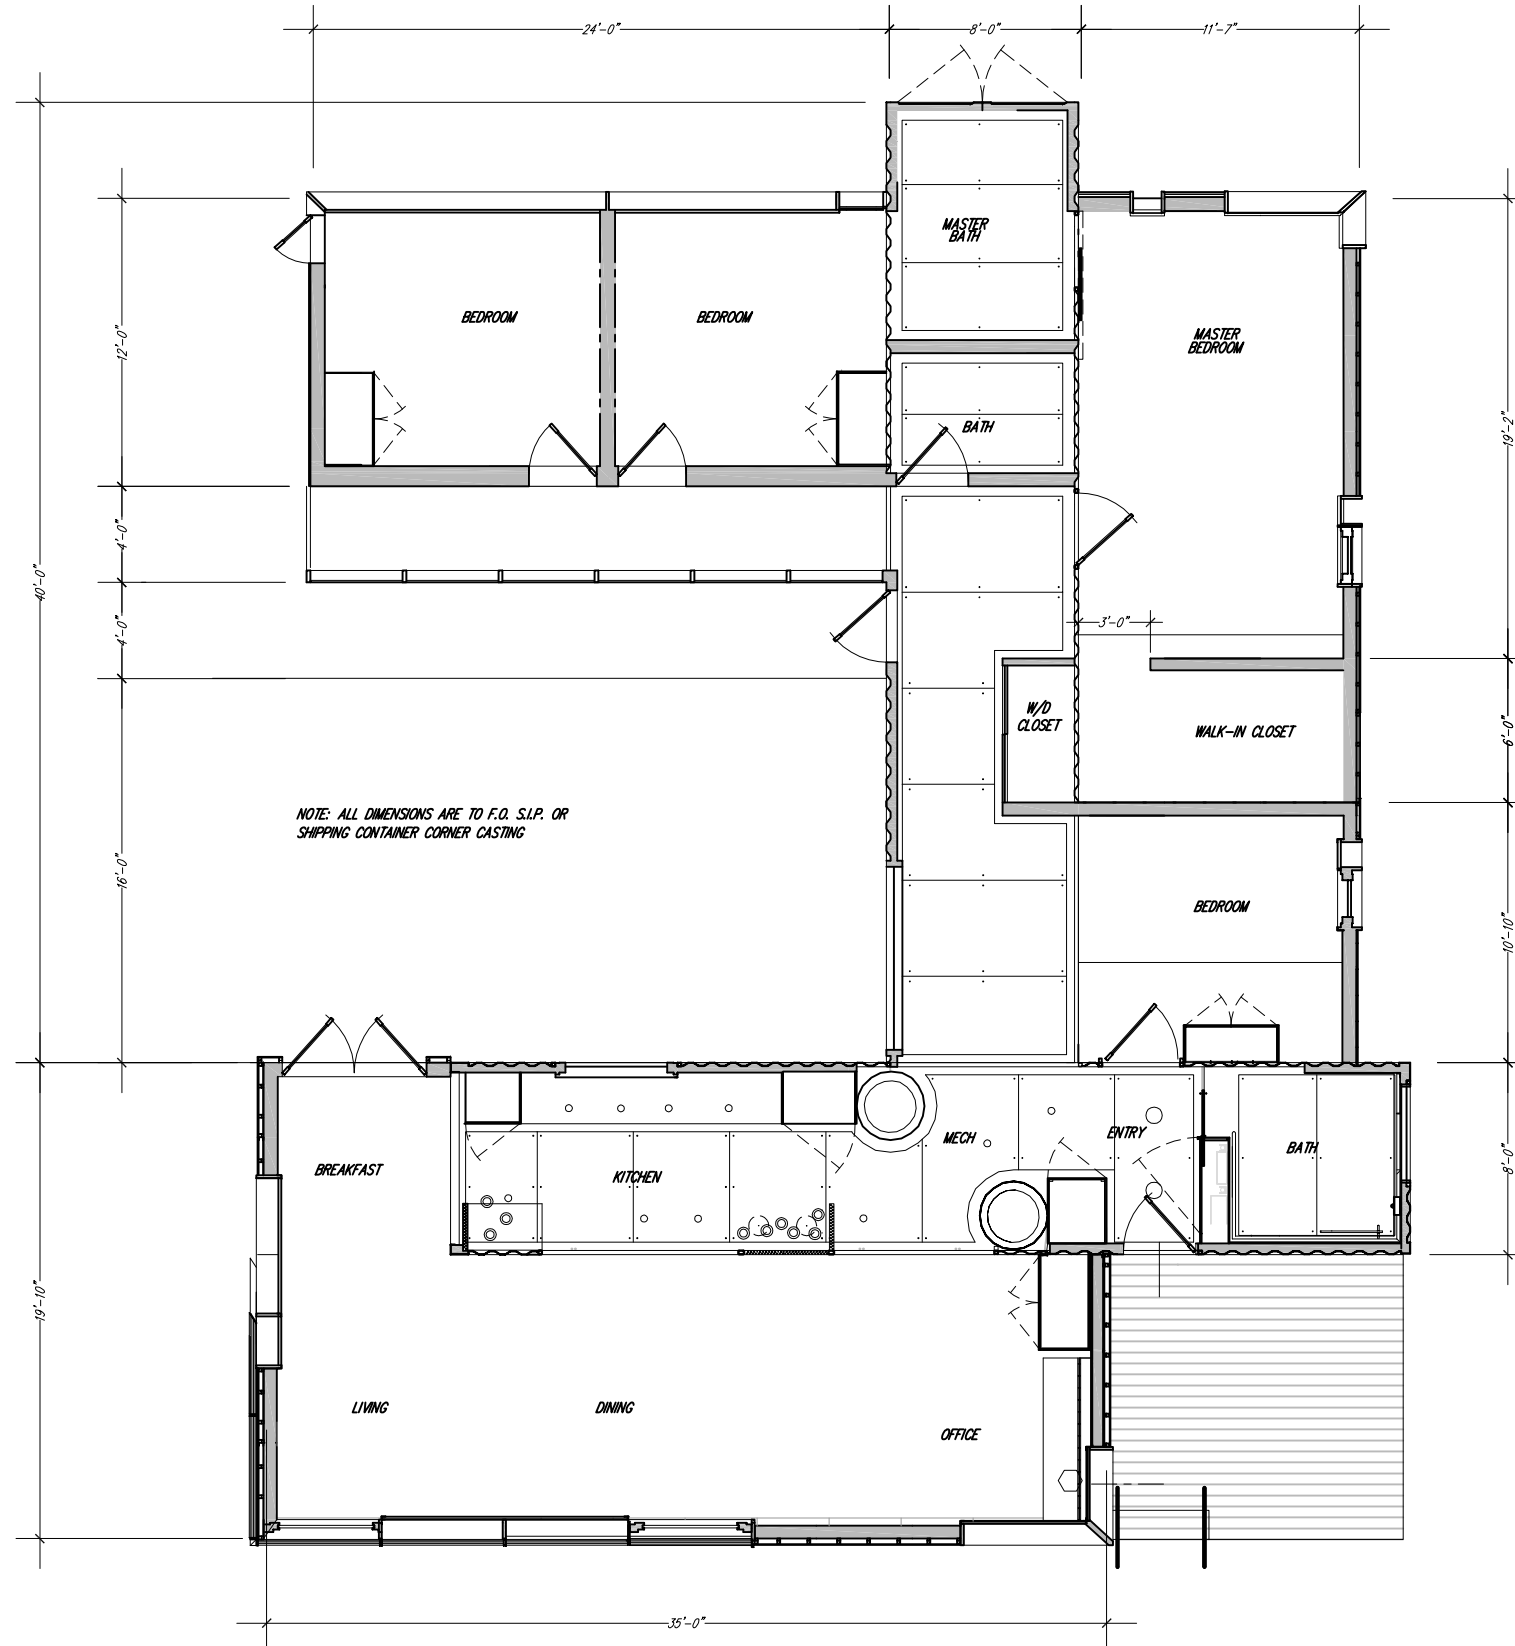

1 REFLECTED CEILING PLAN  
 $1/8" = 1'-0"$

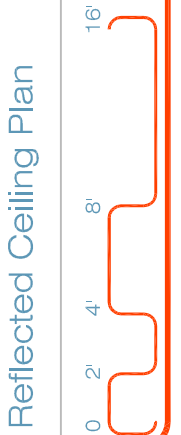


Drawn by	Date
A. Rude	August 7, 2007
Revised	Date

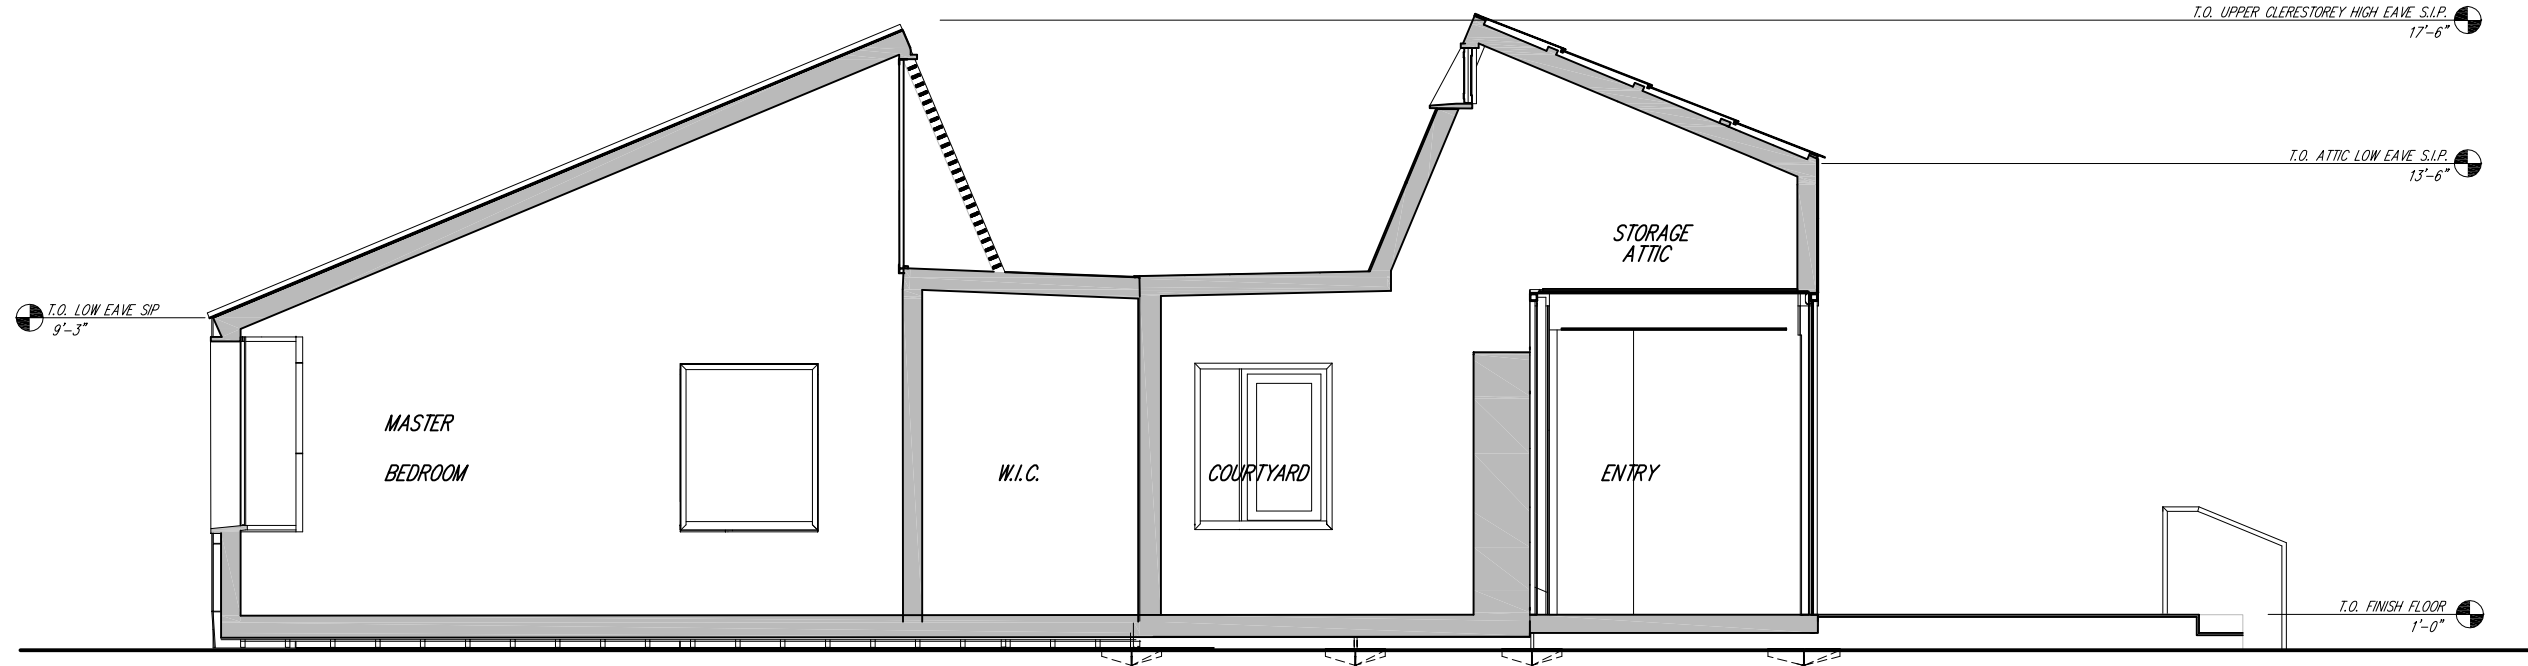

1 TRANSVERSE BUILDING SECTION AT MASTER BEDROOM

1/8" = 1'-0"

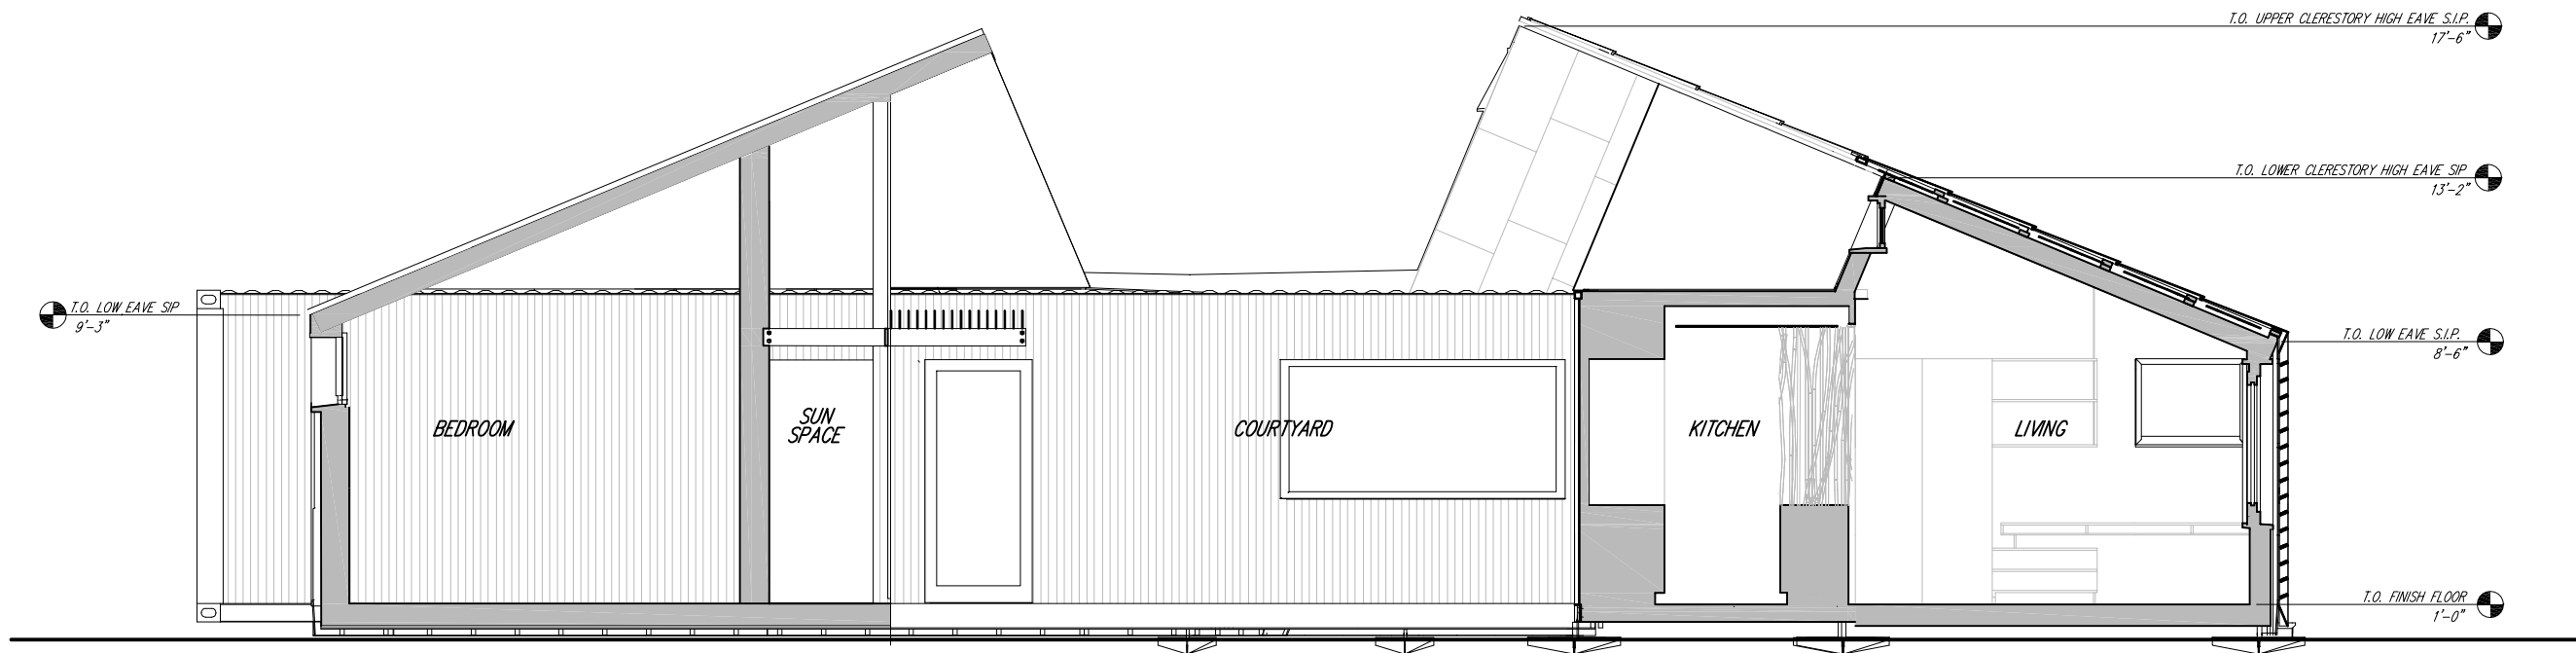

2 TRANSVERSE BUILDING SECTION AT COURTYARD

1/8" = 1'-0"



Drawn by	Date
A. Rude	August 7, 2007
Revised	Date

1 NORTH EXTERIOR ELEVATION



- 1. CORTEN CORRUGATED STEEL, PAINT FINISH
- 2. GA. STAINLESS STEEL SHINGLES, FLAT SEAM, TYP.
- 3. HARDBOARD CEMENTITIOUS FIBERBOARD
- 4. PERFORATED SHEET STEEL

1/8" = 1'-0"

1 SOUTH EXTERIOR ELEVATION



- 1. CORTEN CORRUGATED STEEL, PAINT FINISH
- 2. GA. STAINLESS STEEL SHINGLES, FLAT SEAM, TYP.
- 3. HARDBOARD CEMENTITIOUS FIBERBOARD
- 4. PERFORATED SHEET STEEL


1/8" = 1'-0"

Drawn by	Date
S. Hauze	August 7, 2007
Revised	Date

2007 Solar Decathlon
University of Colorado at Boulder
Civil, Environmental, and Architectural Engineering
428 UCB, Room ECCE 441
Boulder, CO 80309-0428




A7.31

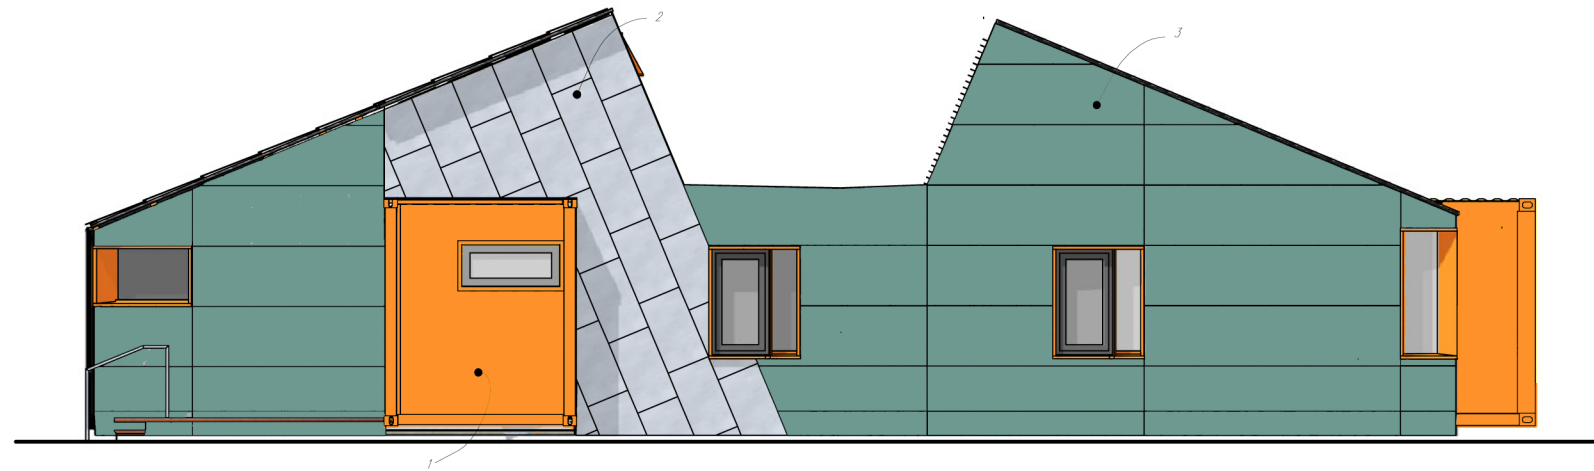

1. CORTEN CORRUGATED STEEL, PAINT FINISH
2. GA. STAINLESS STEEL SHINGLES, FLAT SEAM, TYP.
3. HARDBOARD CEMENTITIOUS FIBERBOARD
4. PERFORATED SHEET STEEL

1 EAST EXTERIOR ELEVATION

$1/8" = 1'-0"$

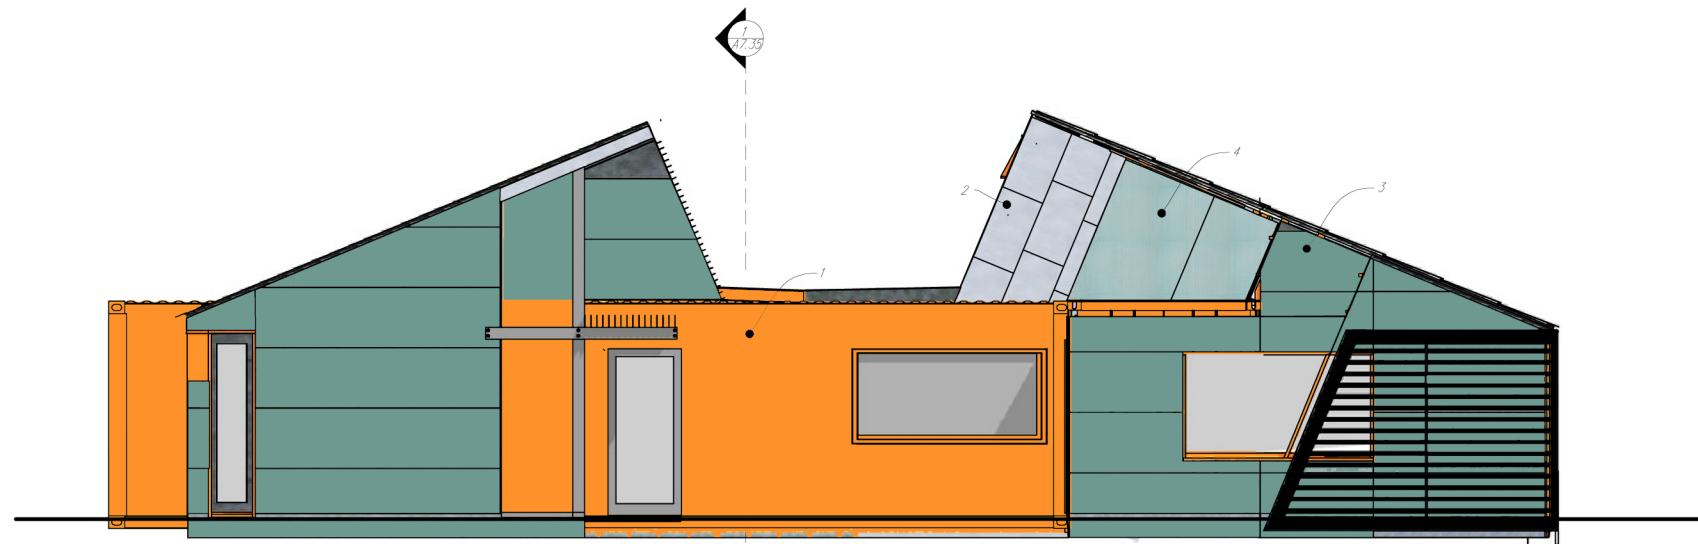

1. CORTEN CORRUGATED STEEL, PAINT FINISH
2. GA. STAINLESS STEEL SHINGLES, FLAT SEAM, TYP.
3. HARDBOARD CEMENTITIOUS FIBERBOARD
4. PERFORATED SHEET STEEL

1 WEST EXTERIOR ELEVATION

$1/8" = 1'-0"$


Drawn by	Date
S. Hauze	August 7, 2007
Revised	Date

2007 Solar Decathlon  
University of Colorado at Boulder  
Civil, Environmental, and Architectural Engineering  
428 UCB, Room ECCE 441  
Boulder, CO 80309-0428

Exterior Elevations



A7.32

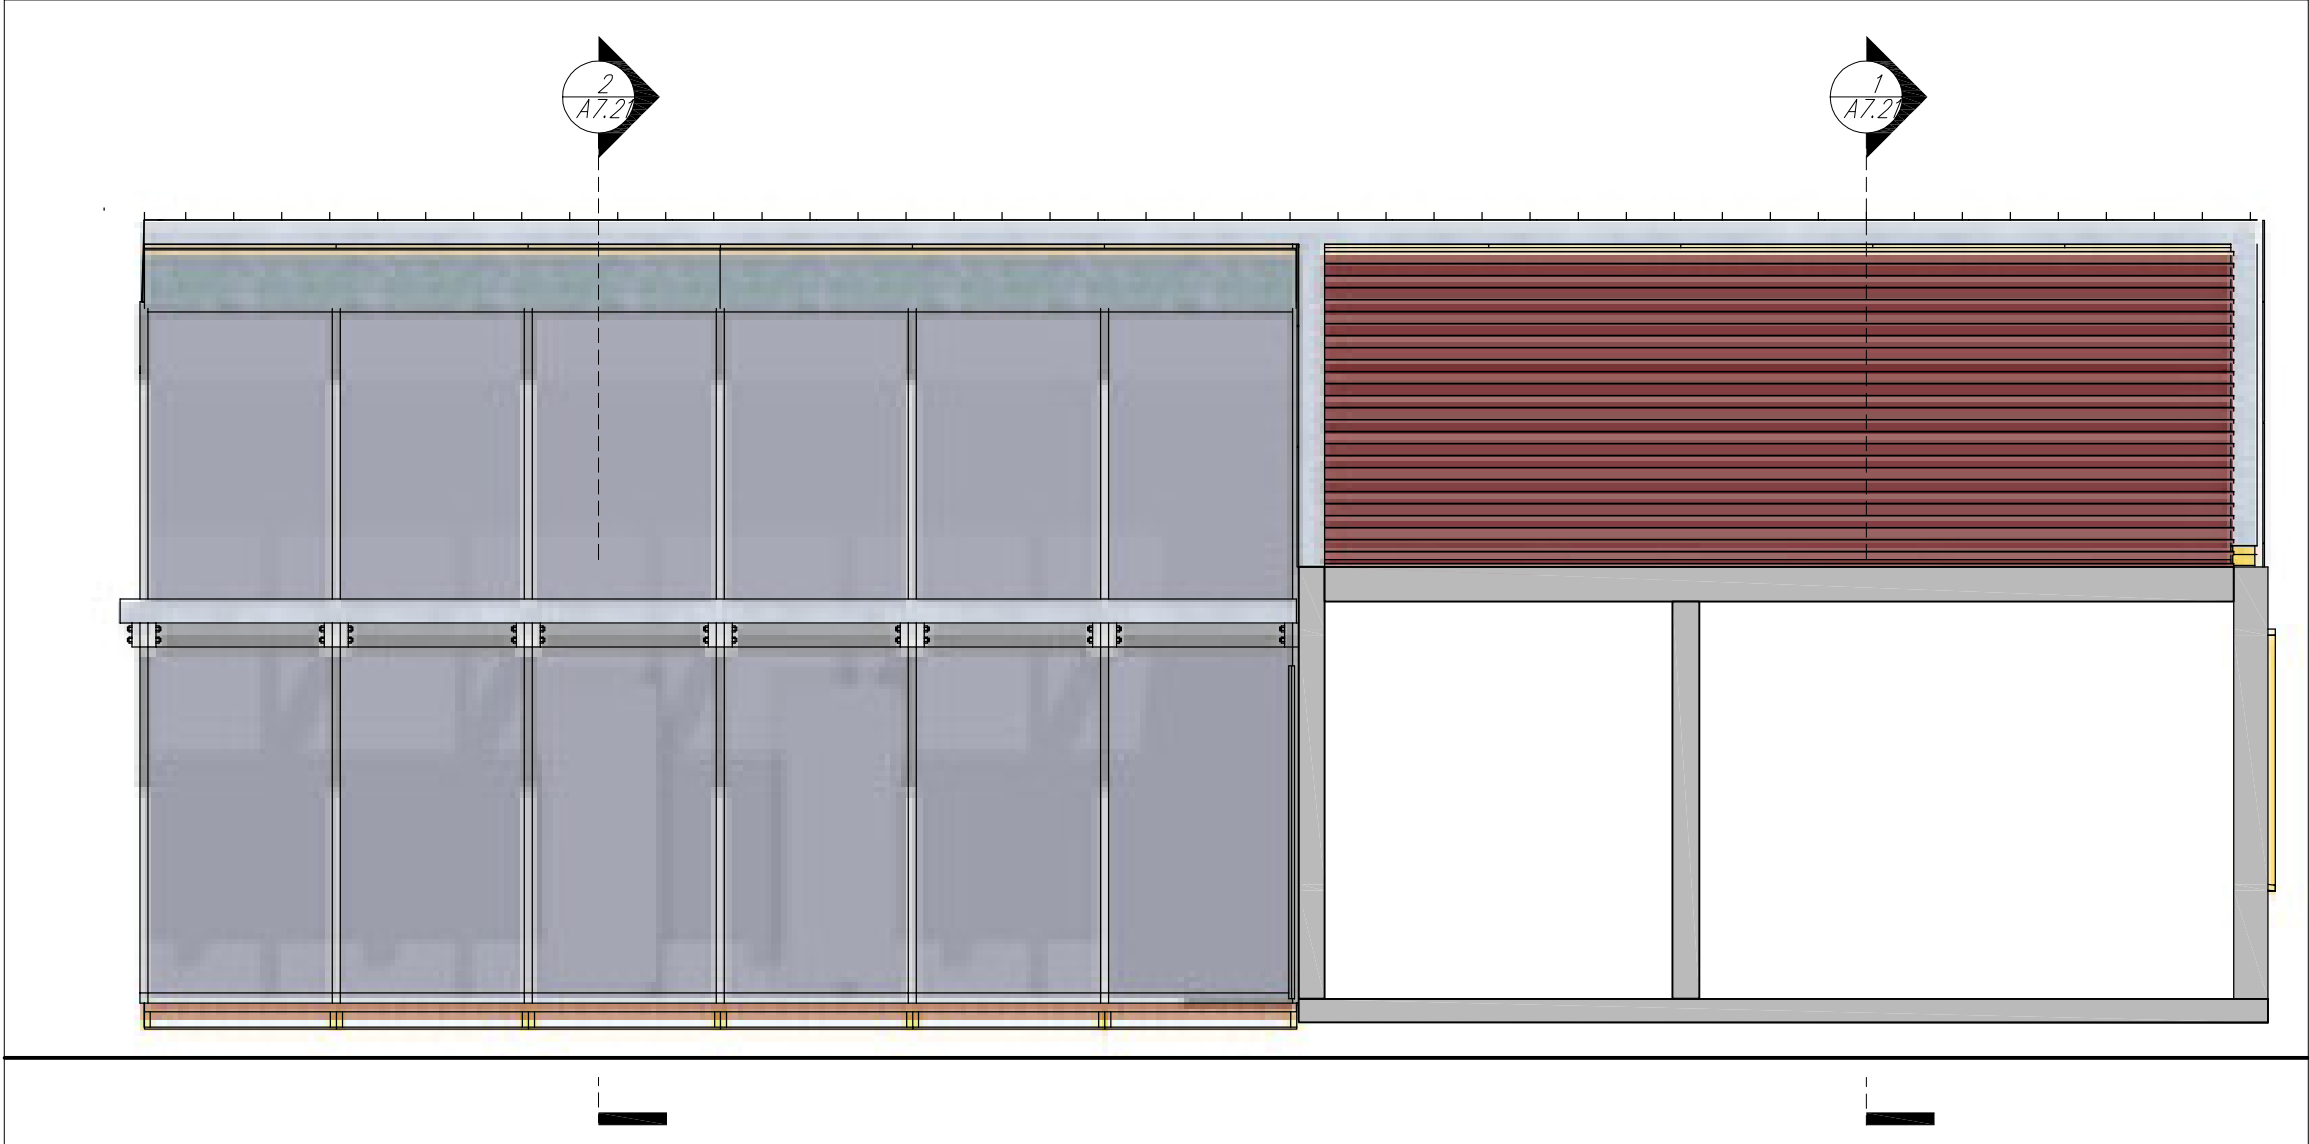

1 SOUTH EXTERIOR ELEVATION

1/8" = 1'-0"



Exterior Elevations



2007 Solar Decathlon

University of Colorado at Boulder  
Civil, Environmental, and Architectural Engineering  
428 UCB, Room ECCE 441  
Boulder, CO 80309-0428

Drawn by	Date
S. Hauze	August 7, 2007
Revised	Date

A7.33



Window	Type	Notes	Grids	Quantity	Frame		Unit SF	Total SF
					Width"	Height"		
1	Single Inswing Door	South, hinged right	No	1	36	80	20.0	20.0
2	Single Awning Window	East	No	1	48	20	6.7	6.7
3	Double Casement Window	North	No	1	60	36	15.0	15.0
4	Insulated Glass Unit/No Frame 1 1/2" oa	Trapezoid	No	1	B: 51 1/2 LL: 42 1/2 RL: 21		14.9	14.9
5	Single Inswing Door/no lite/full slab, SSD1	West, hinged right	No	1	36	80	20.0	20.0
6	Insulated Glass Unit/No Frame 1 1/2" oa	South	No	1	44 3/8	55 5/8	17.1	17.1
7	Tilt and Turn	hinged left	No	1	59 3/8	53 1/2	22.1	22.1
8	Single Awning Window	South	No	3	41	17	4.8	14.5
9	Insulated Glass Unit/No Frame 1 1/2" oa	South	No	1	63 5/8	26 1/8	11.5	11.5
10	Insulated Glass Unit/No Frame 1 1/2" oa	South	No	1	36 5/8	26 1/8	6.6	6.6
11	Single Casement	hinge left	No	1	28	48	9.3	9.3
12	Insulated Glass Unit/No Frame 1 1/2" oa	East	No	1	15 1/2	50	5.4	5.4
13	Awning/PW/Awning		No	1	123	17	14.5	14.5
14	Single Inswing Door	North, hinged left	No	1	36	80	20.0	20.0
Note: All door and window handing is from outside view.				16				177.7

① WINDOW/DOOR SCHEDULE  
N.T.S.

Drawn by	Date
C. Corbin	August 7, 2007
Revised	Date

Window/Door Schedule

2007 Solar Decathlon

University of Colorado at Boulder  
Civil, Environmental, and Architectural Engineering  
428 UCB, Room ECCE 441  
Boulder, CO 80309-0428



<i>FIXTURE TYPE</i>	<i>MANUFACTURER</i>	<i>FIXTURE NAME</i>	<i>ITEM #</i>	<i>QUANTITY</i>	<i>LOCATION</i>	<i>COLOR</i>	<i>FINISH</i>	<i>NOTES</i>
<i>Toilet</i>	<i>Kohler</i>	<i>Escale Dual Flush Toilet</i>	<i>K-19796</i>	<i>1</i>	<i>All Bathrooms</i>	<i>White</i>		<i>Installed On 1" Corrian Pedestal</i>
<i>Toilet Supply Elbow</i>	<i>Kohler</i>	<i>Angle Supply Elbow</i>	<i>K-7637</i>	<i>1</i>	<i>All Bathrooms</i>		<i>Polished Chrome</i>	
<i>Lavatory Faucet</i>	<i>Kohler</i>	<i>Stillness Widespread Lavatory Faucet</i>	<i>K-14410-4</i>	<i>1</i>	<i>All Bathrooms</i>			<i>W/ Aerator</i>
<i>Lavatory Sink</i>	<i>Kohler</i>	<i>Ladena Undermount Lavatory Sink 18x12</i>	<i>K-2214-G</i>	<i>1</i>	<i>All Bathrooms</i>	<i>White</i>		
<i>Shower Valve Trim</i>	<i>Kohler</i>	<i>Stillness Thermostatic Valve Trim W/ Lever Handle</i>	<i>K-T10940-4</i>	<i>1</i>	<i>All Bathrooms</i>		<i>Polished Chrome</i>	<i>Install On Valve Housing Front Panel</i>
<i>Thermostatic Shower Valve</i>	<i>Kohler</i>	<i>Rite-Temp Shower Valve</i>	<i>K-304-NA</i>	<i>1</i>	<i>All Bathrooms</i>		<i>N/A</i>	<i>Installed Inside Valve Housing</i>
<i>Shower Slidebar</i>	<i>Kohler</i>	<i>Mastershower Slidebar Kit</i>	<i>K-8516</i>	<i>1</i>	<i>All Bathrooms</i>		<i>Polished Chrome</i>	<i>Install On Valve Housing Front Panel</i>
<i>Shower Spray</i>	<i>Kohler</i>	<i>Ecoshower Handheld Spray</i>	<i>K-8543</i>	<i>1</i>	<i>All Bathrooms</i>		<i>Polished Chrome</i>	
<i>Shower Wall Supply</i>	<i>Kohler</i>	<i>Mastershower Wall Supply Elbow</i>	<i>K-9513</i>	<i>1</i>	<i>All Bathrooms</i>		<i>Polished Chrome</i>	<i>Install On Valve Housing Front Panel</i>
<i>Kitchen Faucet</i>	<i>Kohler</i>	<i>Evoke Kitchen Faucet</i>	<i>K-7637</i>	<i>1</i>	<i>Kitchen South Side</i>		<i>Vibrant Stainless</i>	

1

PLUMBING FIXTURE SCHEDULE



Drawn by	Date
S.R.H.	August 7, 2007
Revised	Date

APPLIANCE TYPE	MANUFACTURER	APPLIANCE NAME	ITEM #	QUANTITY	LOCATION	FINISH	COLOR	NOTES
Refrigerator	KitchenAid	Refrigerator ,Architect II Series, 36"	KBRC36FTS	1	Kitchen North Side	Bamboo Strand		Custom Finish Panel– Plyboo 3/4" Dark Strand. Unit Recessed into Insulation 1-1/8"
Dishwasher	KitchenAid	Double Drawer Dishwasher	KUDD01D	1	Kitchen South Side	Bamboo Strand		Custom Finish Panel– Plyboo 3/4" Dark Strand. Control Medalions Req'd
Dishwasher Control	KitchenAid	Drawer Dishwasher Control Medalions	KUDKBZSPA	2	Kitchen South Side	Stainless Steel		
Microwave/ Oven	GE Monogram	Convection Microwave/ Oven	ZET3038SH	1	Kitchen North Side	Stainless Steel		
Cooktop	Diva De Provence	4 Burner 30"	DDP-4	1	Kitchen North Side		Black	
Washer/ Dryer	Asko	Combination Washer/ Dryer	WCAM1812	1	Kitchen North Side		White	

1

APPLIANCE SCHEDULE



ITEM NAME	ITEM #	QUANTITY	LOCATION	NOTES
Zinc nickel-plated Matt Flush Pulls	151.09.609	28	All Drawer/Door/DW Fronts	
Accuride C3132SC, 22"	420.02.956	9	Kitchen North Side Drawers	Full Extension, Self-Close
Accuride C3132SC, 20"	420.02.951	4	Kitchen South Side Drawers	Full Extension, Self-Close
Accuride C3132SC, 16"	420.02.941	3	Bath Cabinet Drawers	Full Extension, Self-Close
Concealed Hinges A-Series	311.93.570	14	Overlay Doors	Opening angle 165°, Press Fit
Concealed Hinges Baseplates	311.98.510	14	Overlay Doors	
Concealed Hinges A-Series	311.93.573	20	Inset Doors	Opening angle 165°, Press Fit
Concealed Hinges Baseplates	311.98.512	20	Inset Doors	
Matt Stainless Steel Pull Handle	903.00.853	2	Bath Slider Door (Fat Wall)	
Top-Hung Slider Mounting Set	940.00.007	1	Bath Slider Door (Fat Wall)	INC: Double Roller Running Gear, Suspension Bolt-M8X35, Set Nut-M8, Track Stopper
Top-Hung Slider Track	941.00.253	1	Bath Slider Door (Fat Wall)	2.5 m
Slider Guides	405.46.910	2	Bath Slider Door (Fat Wall)	
Easy Cargo 50 Trash Management	502.70.522	1	Kitchen Island	
Wardrobe Rail, Bedroom	805.12.456	2	Bedroom Closet	Top-mounted, 17.5" Length
Wardrobe Rail, Living Room	801.42.200	1	Living Room Closet	Side-mounted
Wardrobe Rail Supports	803.56.200	2	Living Room Closet	
Piano Hinges	351.09.613	2	Heat Pump Closet	
Magnetic Catches	246.26.300	2	Heat Pump Closet	


Drawn by	Date
A. Rude	August 7, 2007
Revised	Date

Hardware Schedule

2007 Solar Decathlon

University of Colorado at Boulder  
Civil, Environmental, and Architectural Engineering  
428 UCB, Room ECCE 441  
Boulder, CO 80309-0428



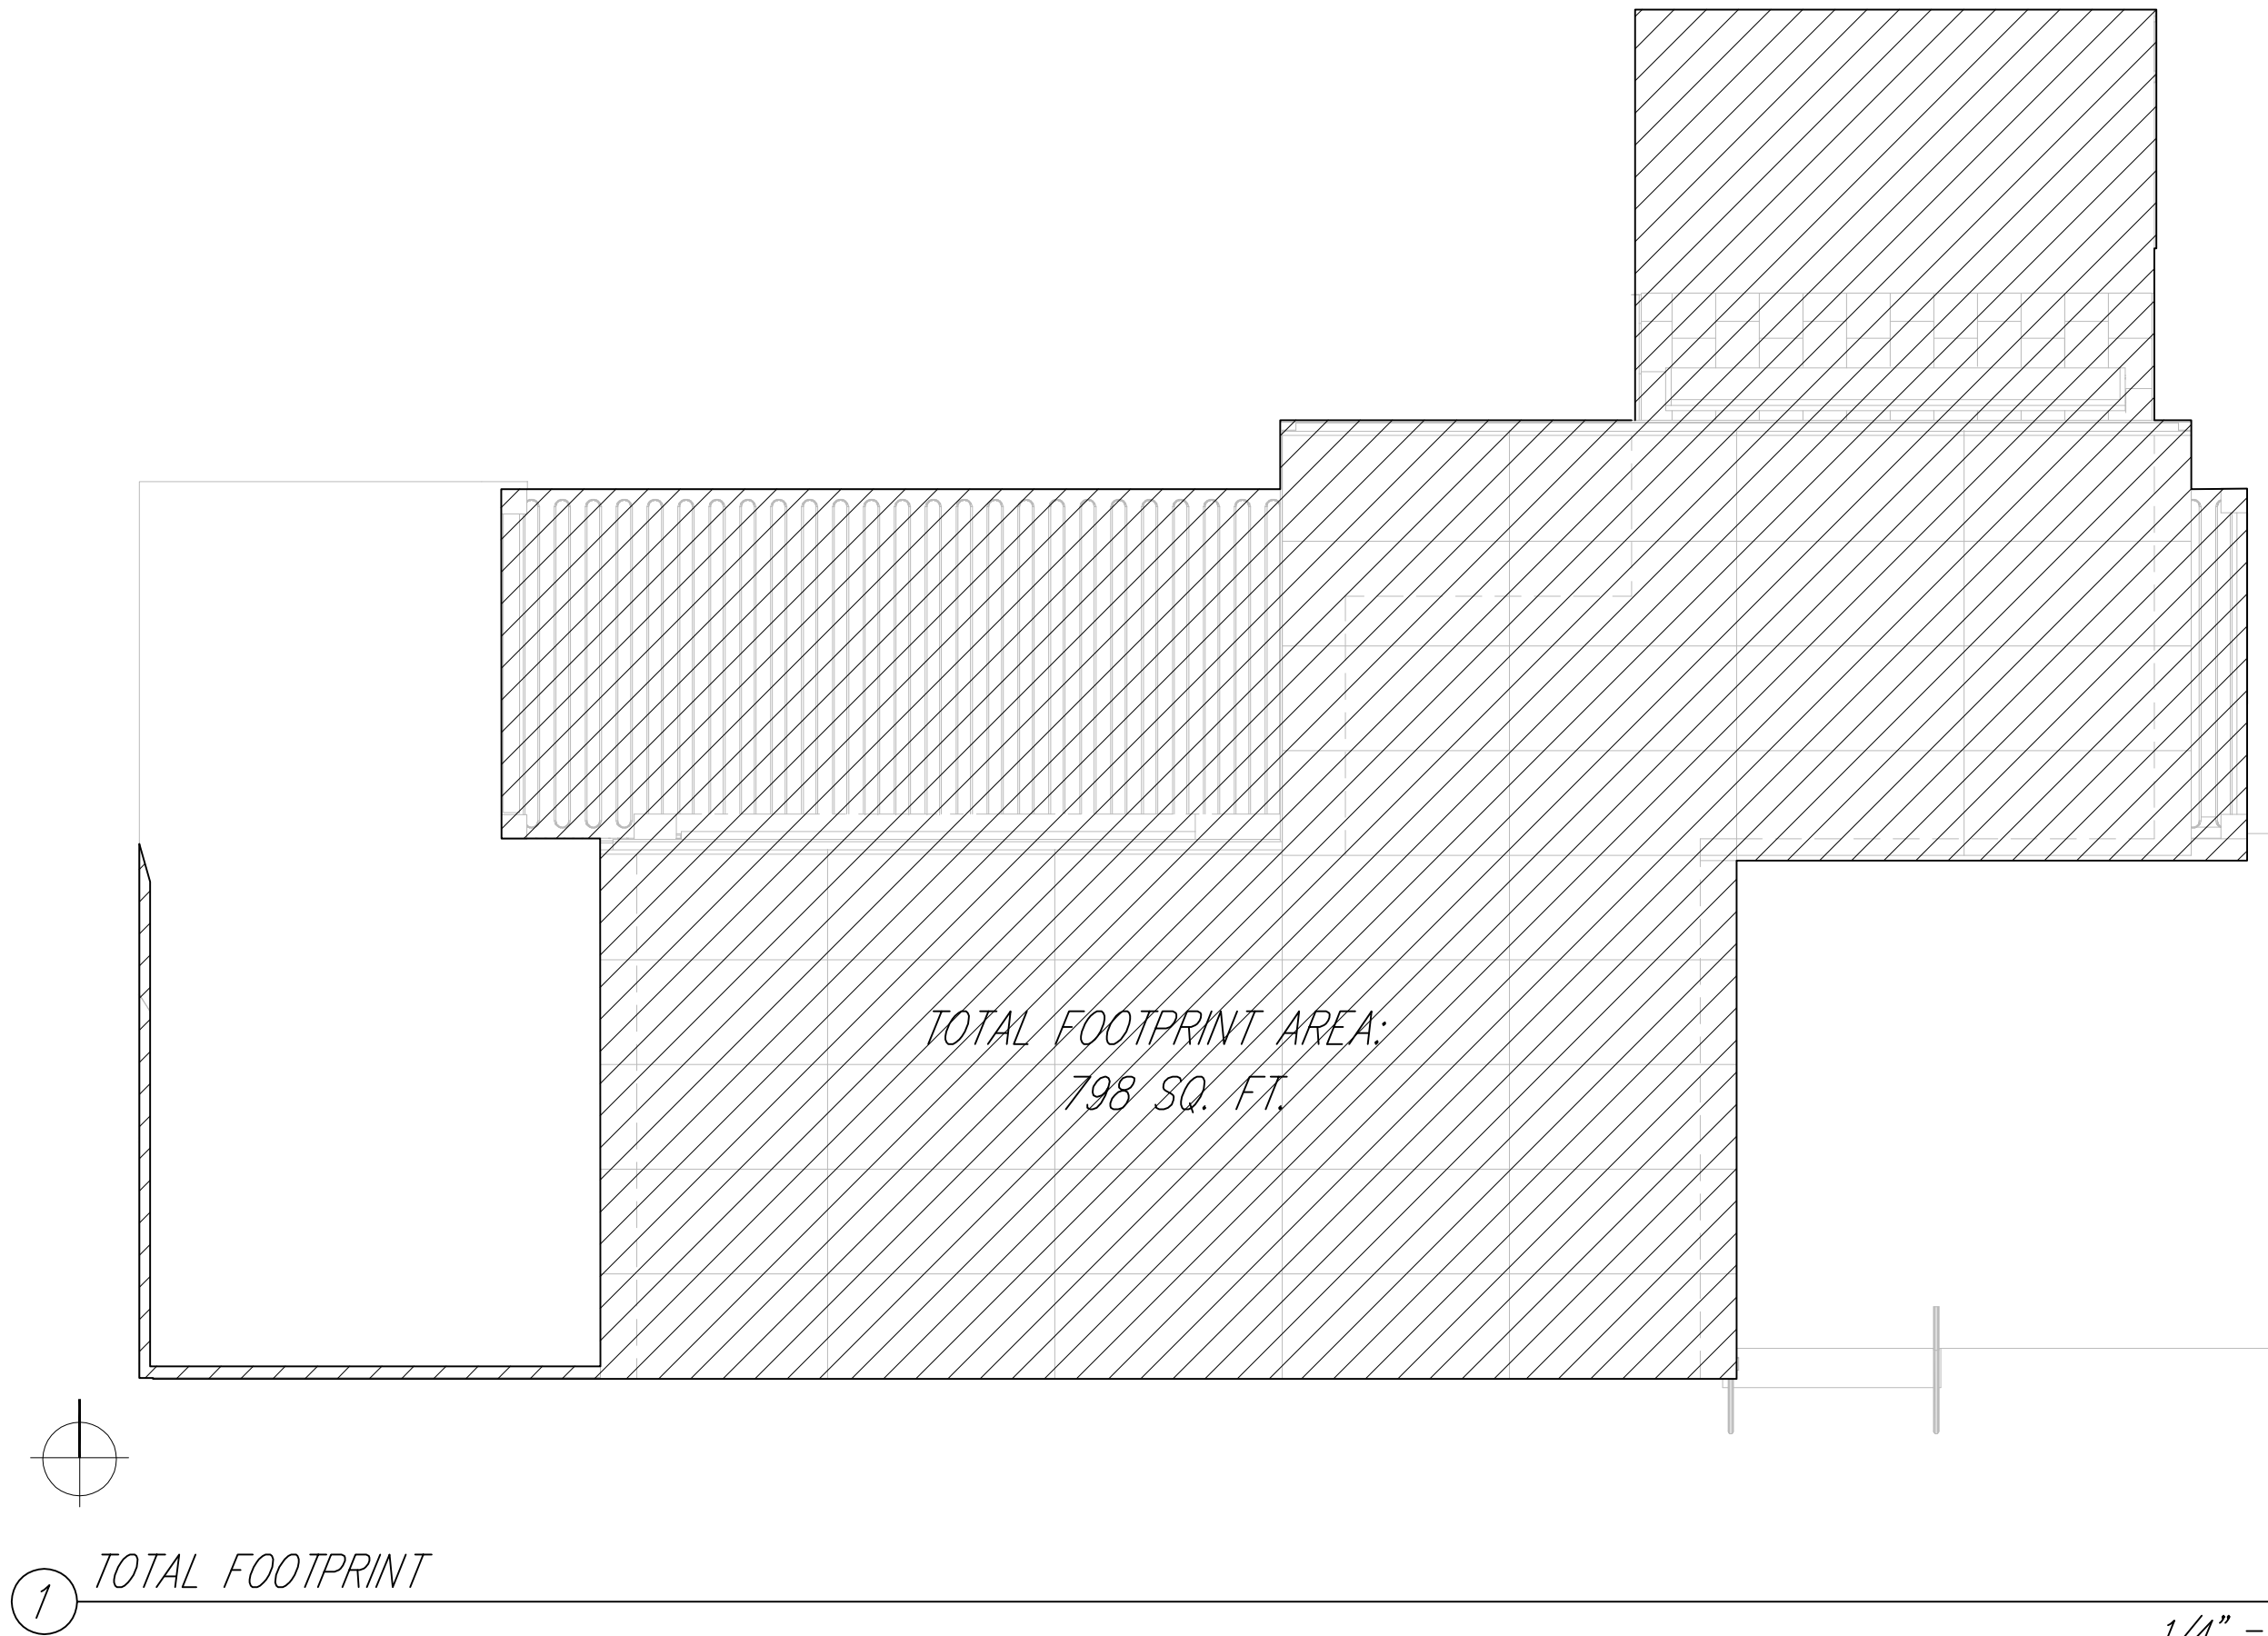

Drawn by	Date
A. Rude	August 7, 2007
Revised	Date

Total Footprint Plan


0 1' 2' 4' 8'

2007 Solar Decathlon


University of Colorado at Boulder  
Civil, Environmental, and Architectural Engineering  
428 UCB, Room ECCE 441  
Boulder, CO 80309-0428





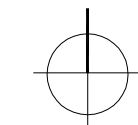

1 *CONDITIONED AREA*

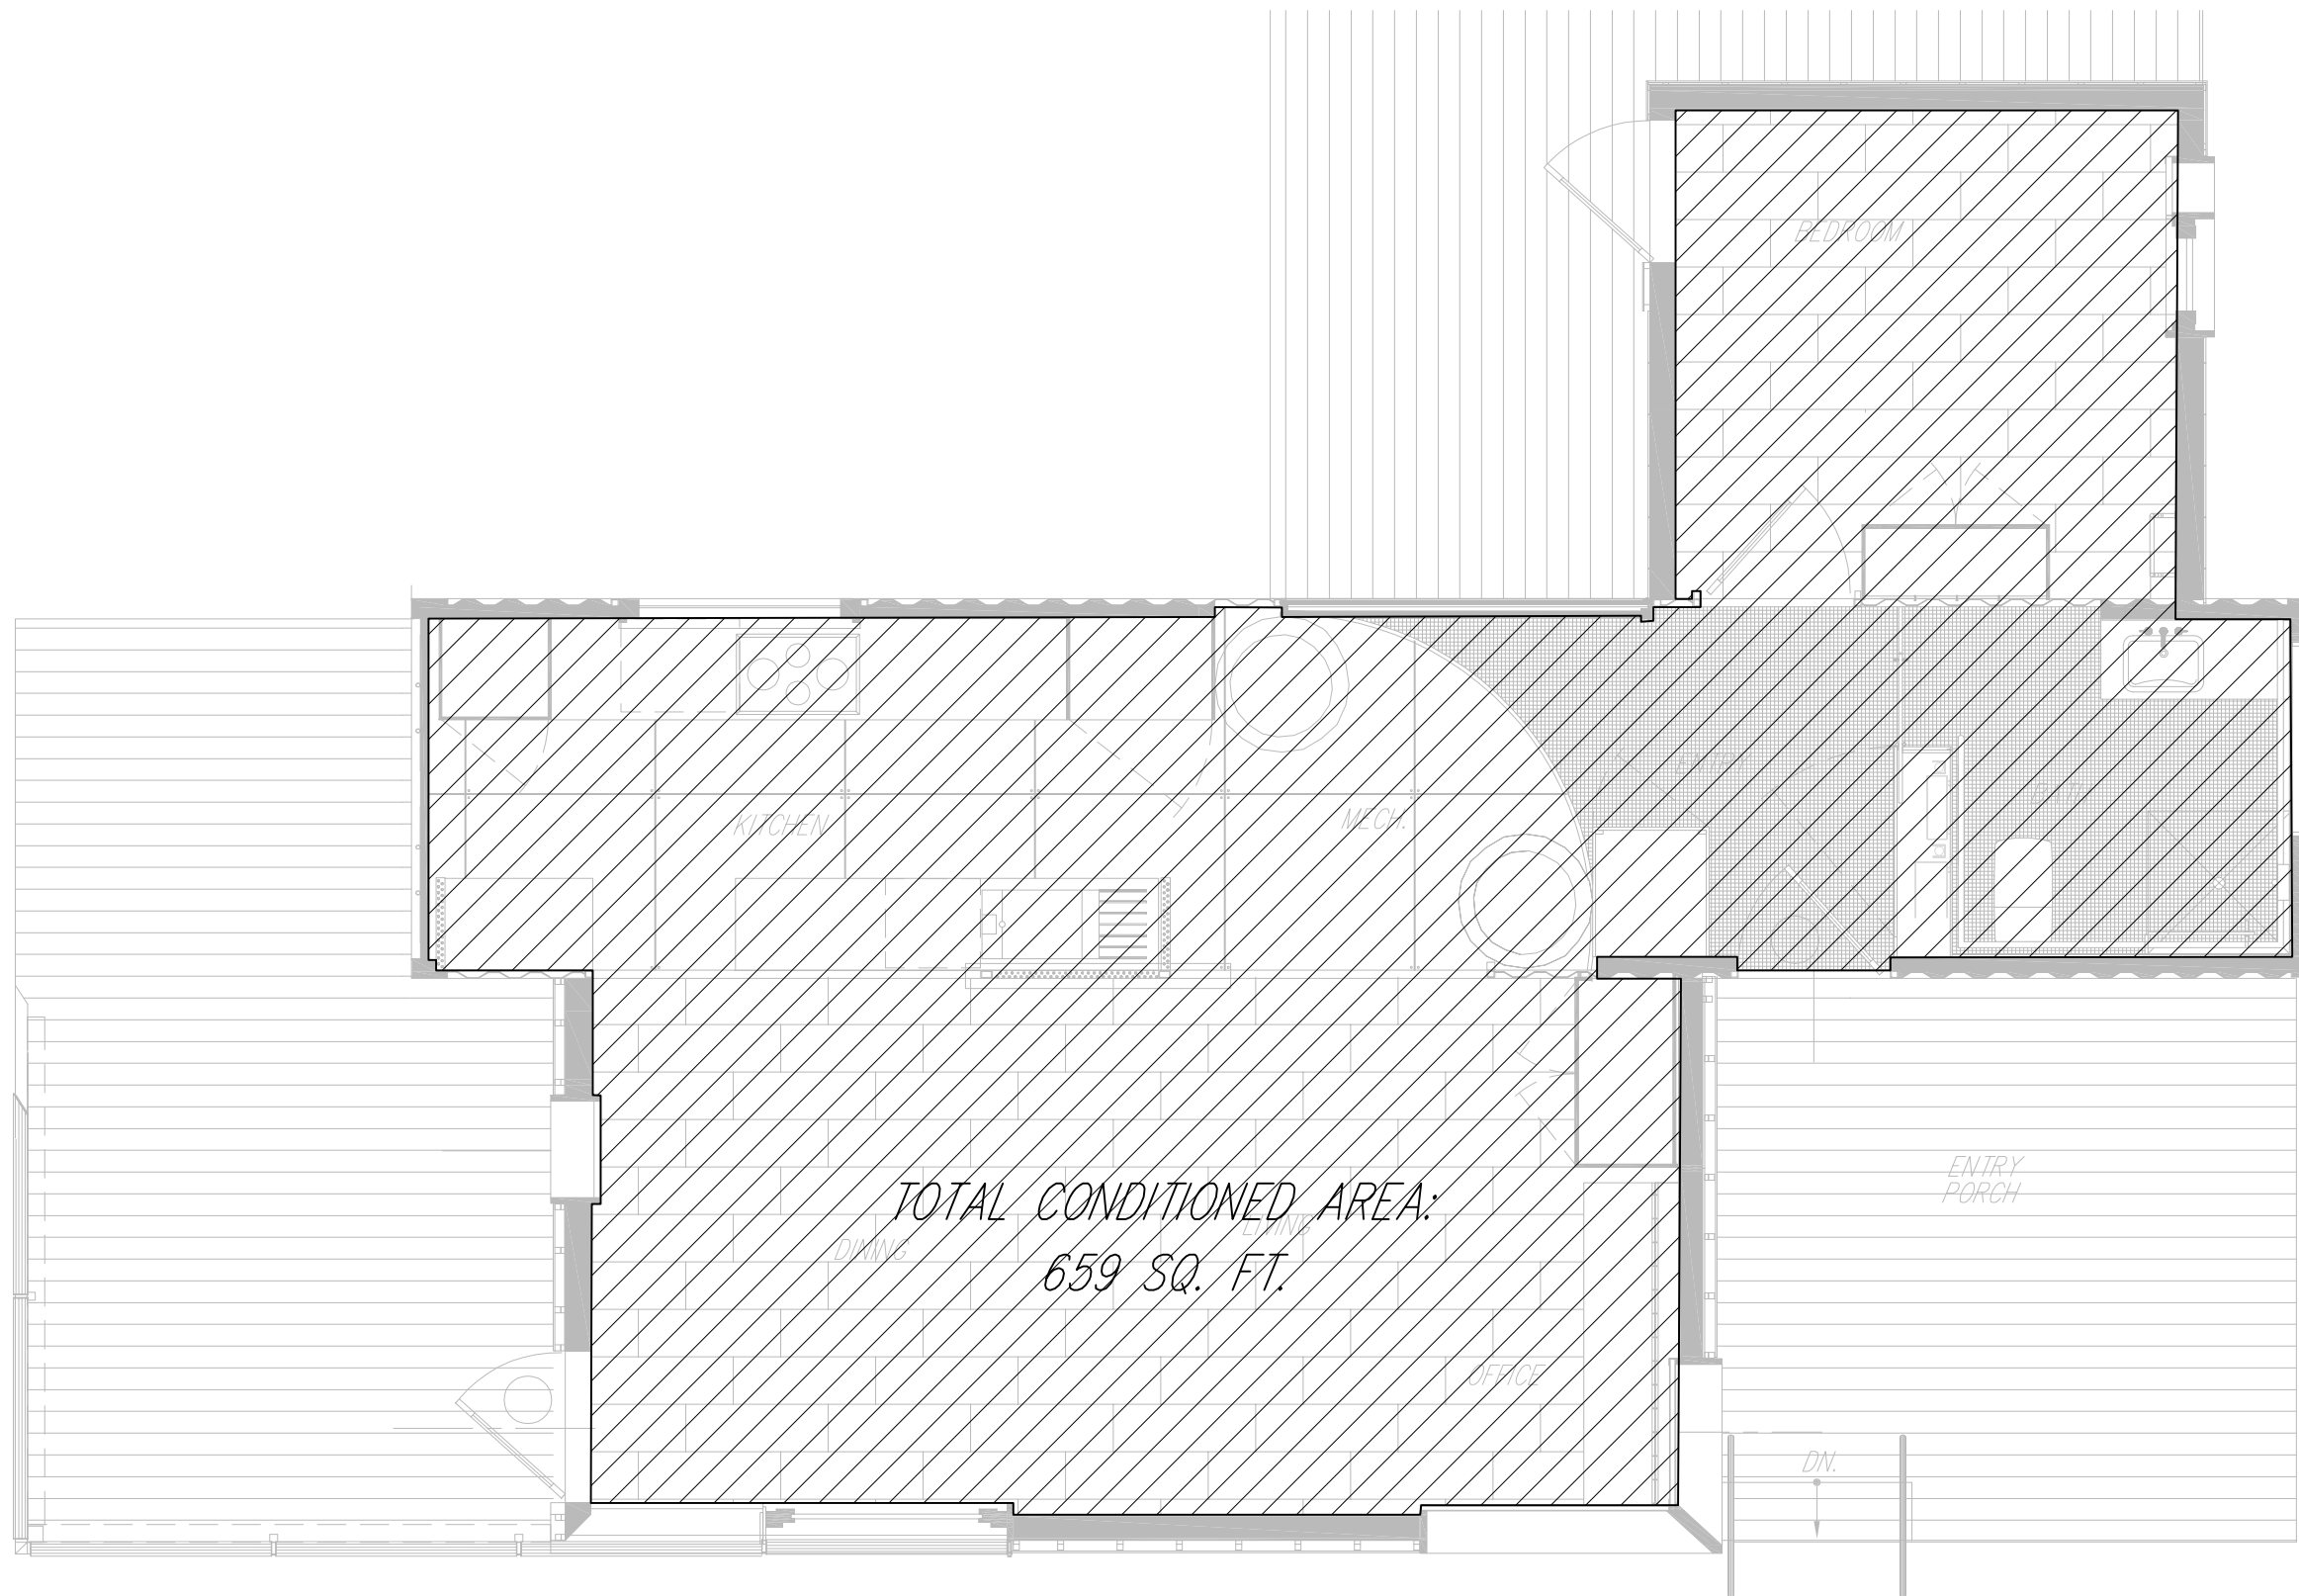

$1/4" = 1'-0"$




CC  
1.02

Total Conditioned Space Plan

2007 Solar Decathlon

University of Colorado at Boulder  
Civil, Environmental, and Architectural Engineering  
428 UCB Room ECCE 441  
Boulder, CO 80309-0428

Drawn by	Date
A. Rude	August 7, 2007
Revised	Date

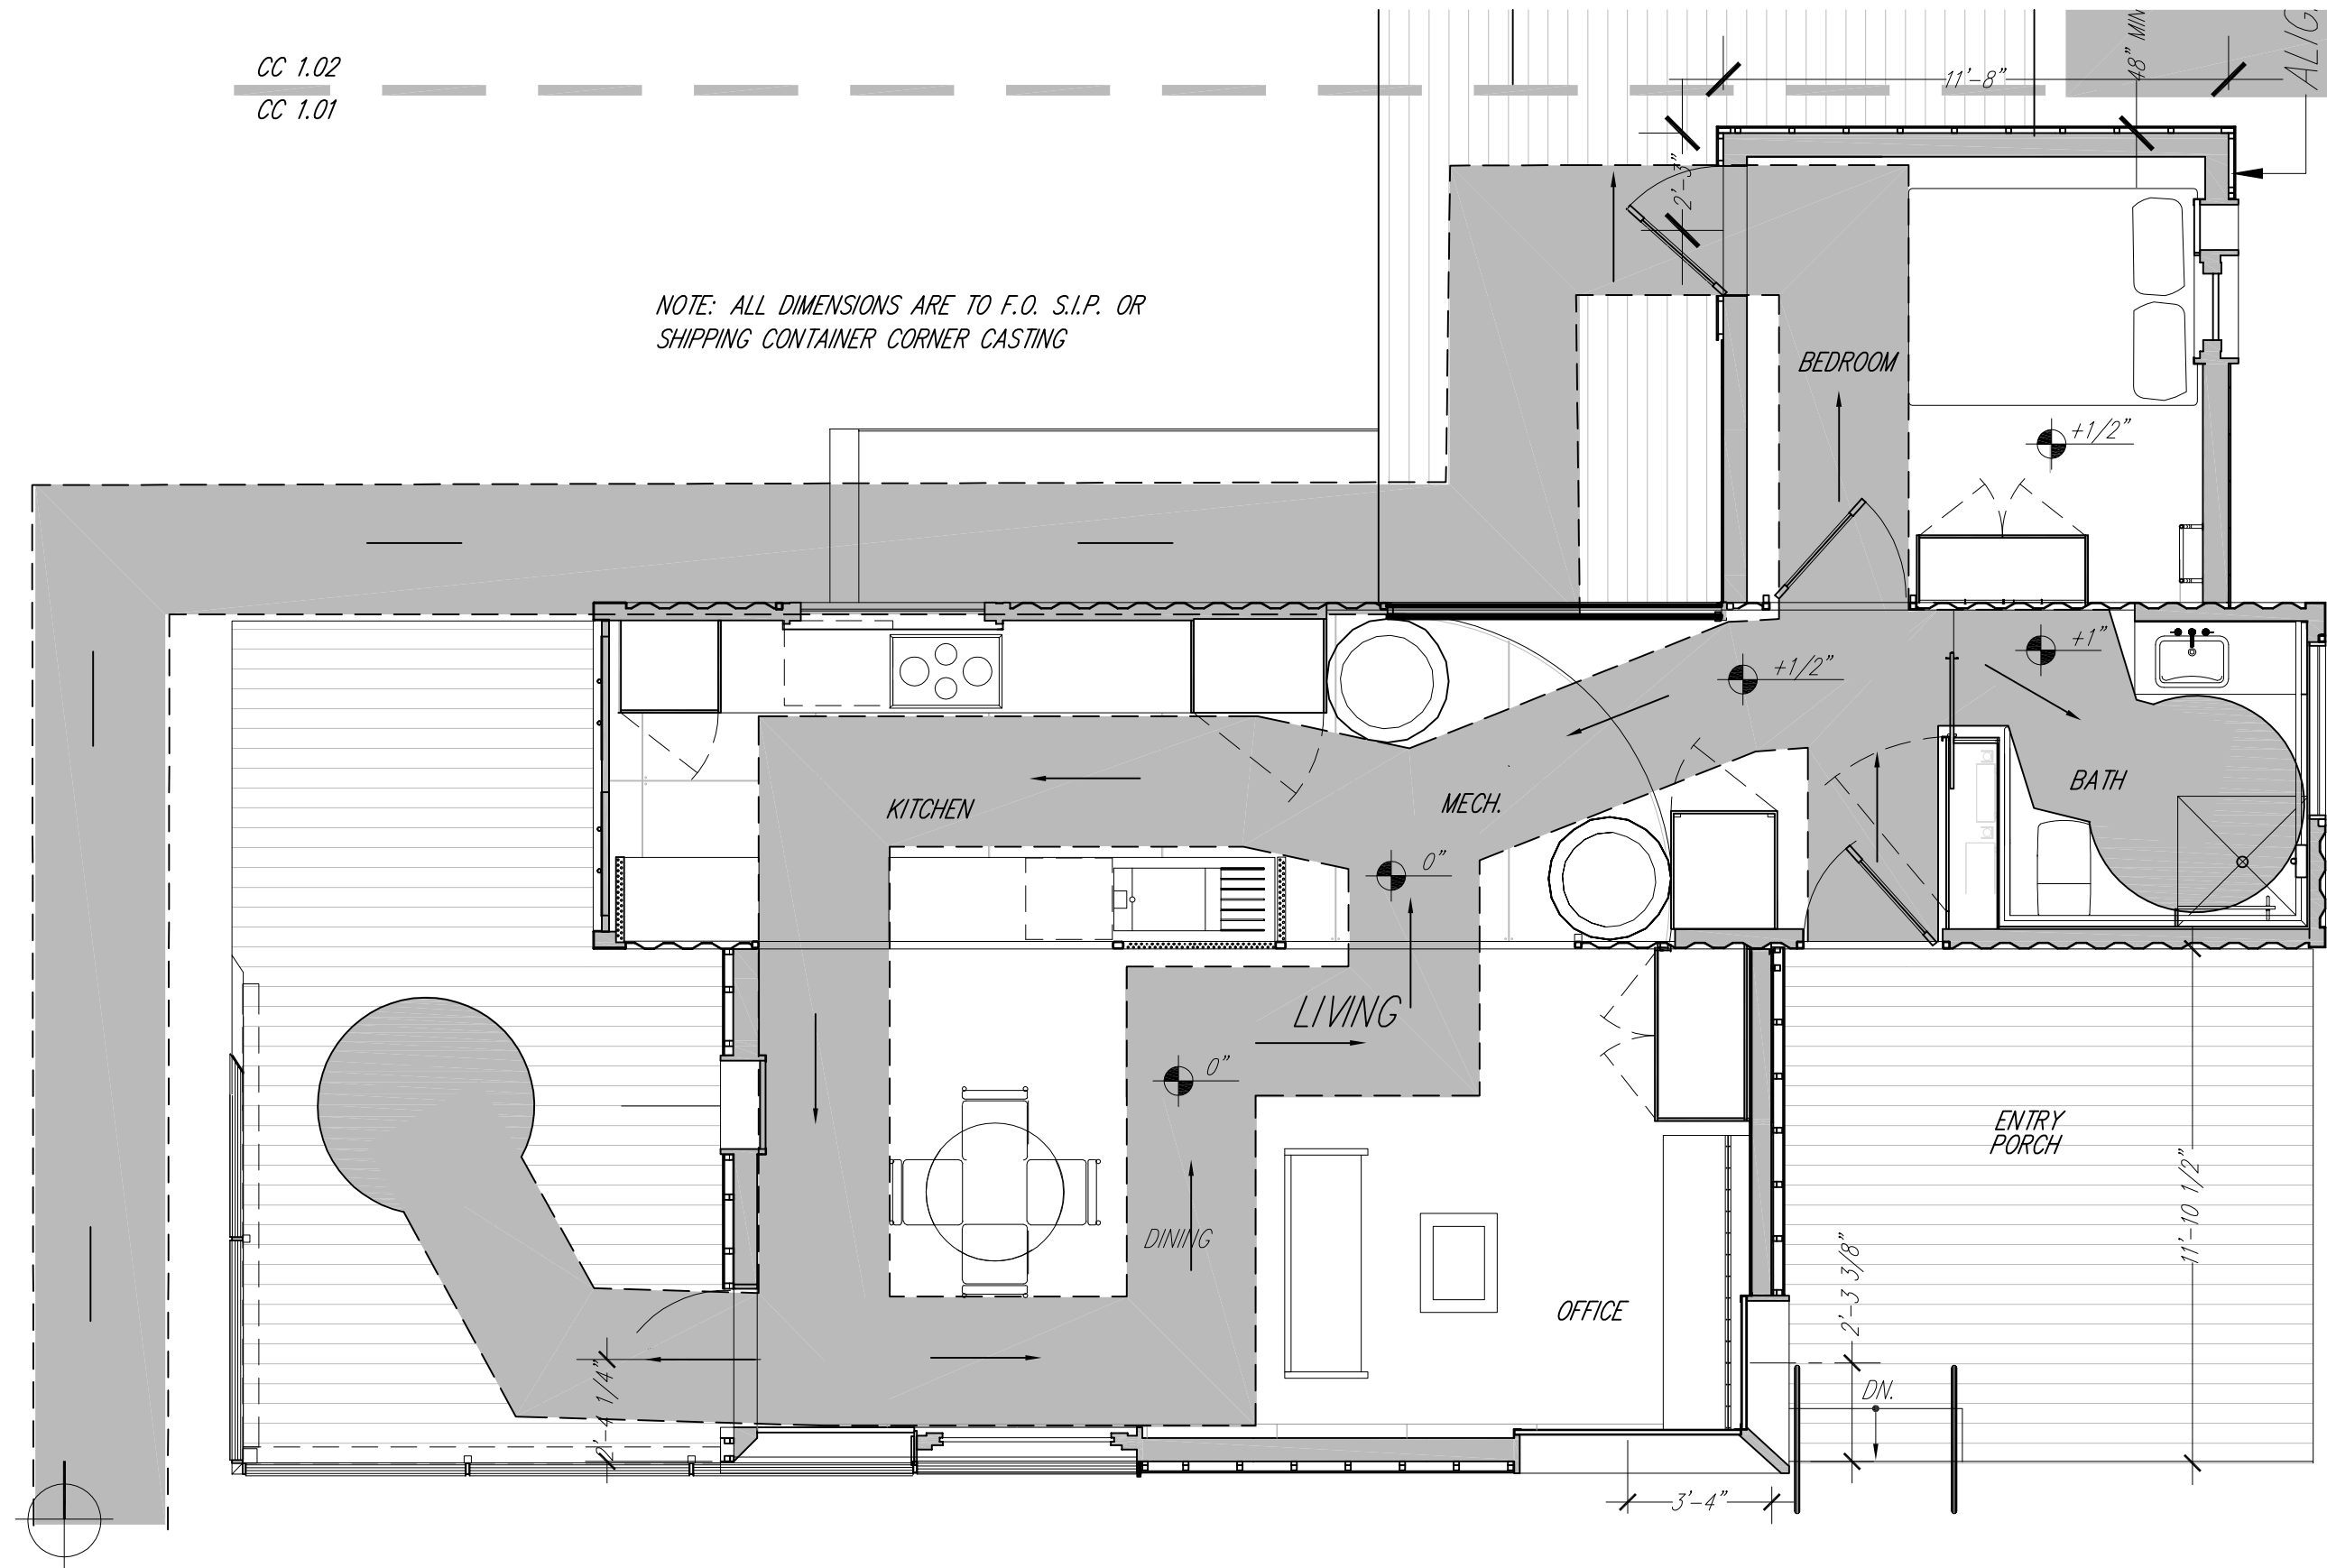

1 GROUND LEVEL FLOORPLAN

1/4" = 1'-0"

Drawn by	Date
A. Rude	August 7, 2007
Revised	Date

Ground Level Plan

2007 Solar Decathlon

University of Colorado at Boulder

Civil, Environmental, and Architectural Engineering


428 UCB, Room ECCE 441

Boulder, CO 80309-0428


0 1' 2' 4' 8'




CC  
1.01

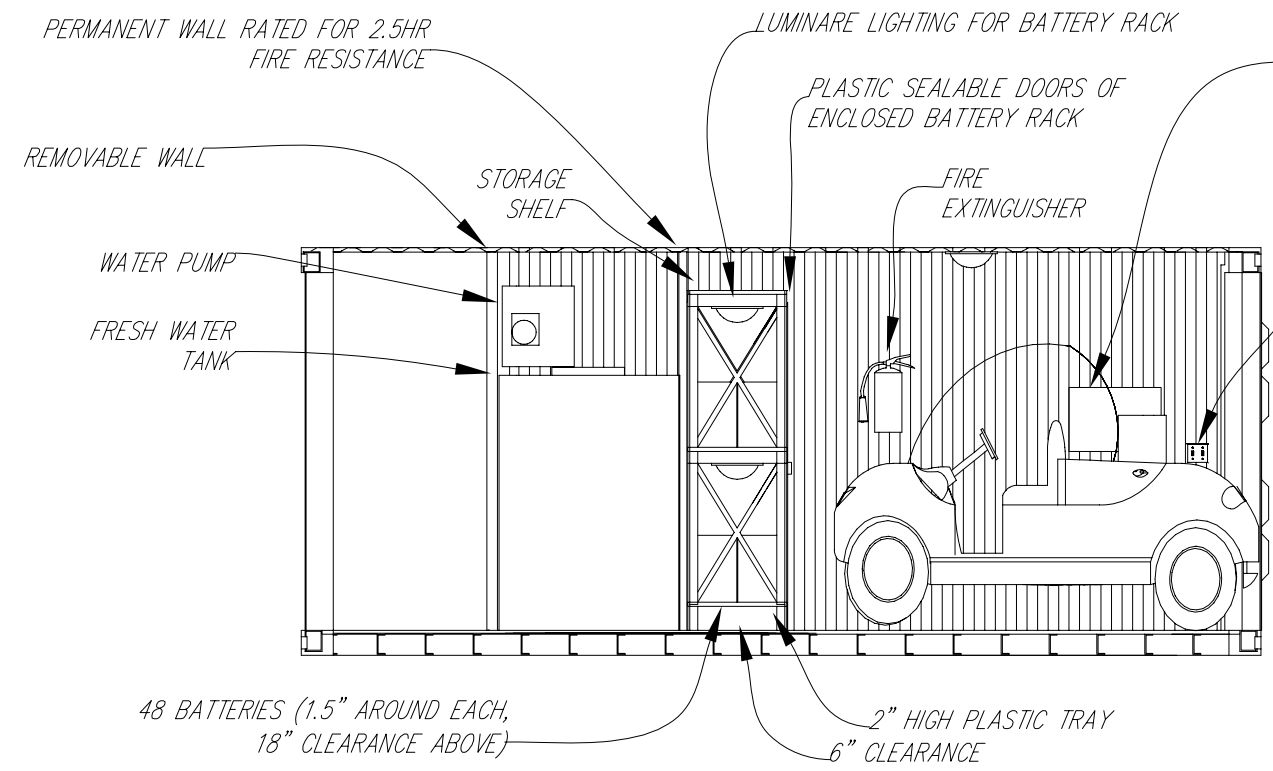

① LONGITUDINAL SECTION  
1/4" - 1'-0"

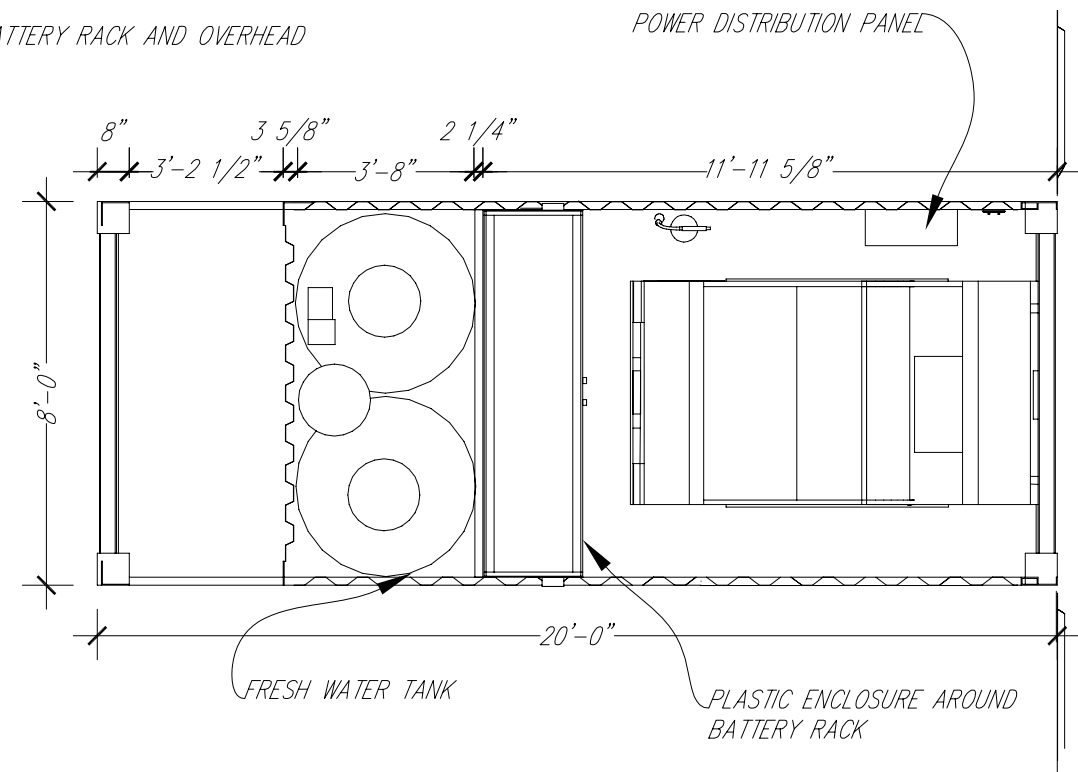

② GARAGE PLAN  
1/4" - 1'-0"

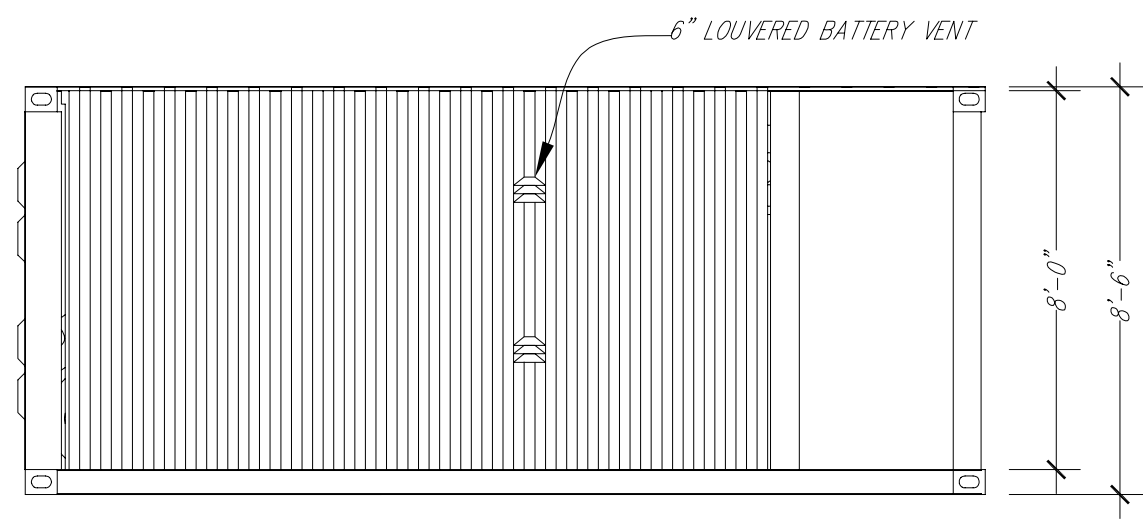

① WEST ELEVATION  
1/4" - 1'-0"

Date	August 7, 2007
Drawn by	C. Corbin
Revised	
Date	


Garage Schematic
2007 Solar Decathlon

University of Colorado at Boulder  
Civil, Environmental, and Architectural Engineering  
428 UCB, Room ECCE 441  
Boulder, CO 80309-0428

0 1' 2' 4' 8'



1 FURNITURE PLAN  
1/4" = 1'-0"

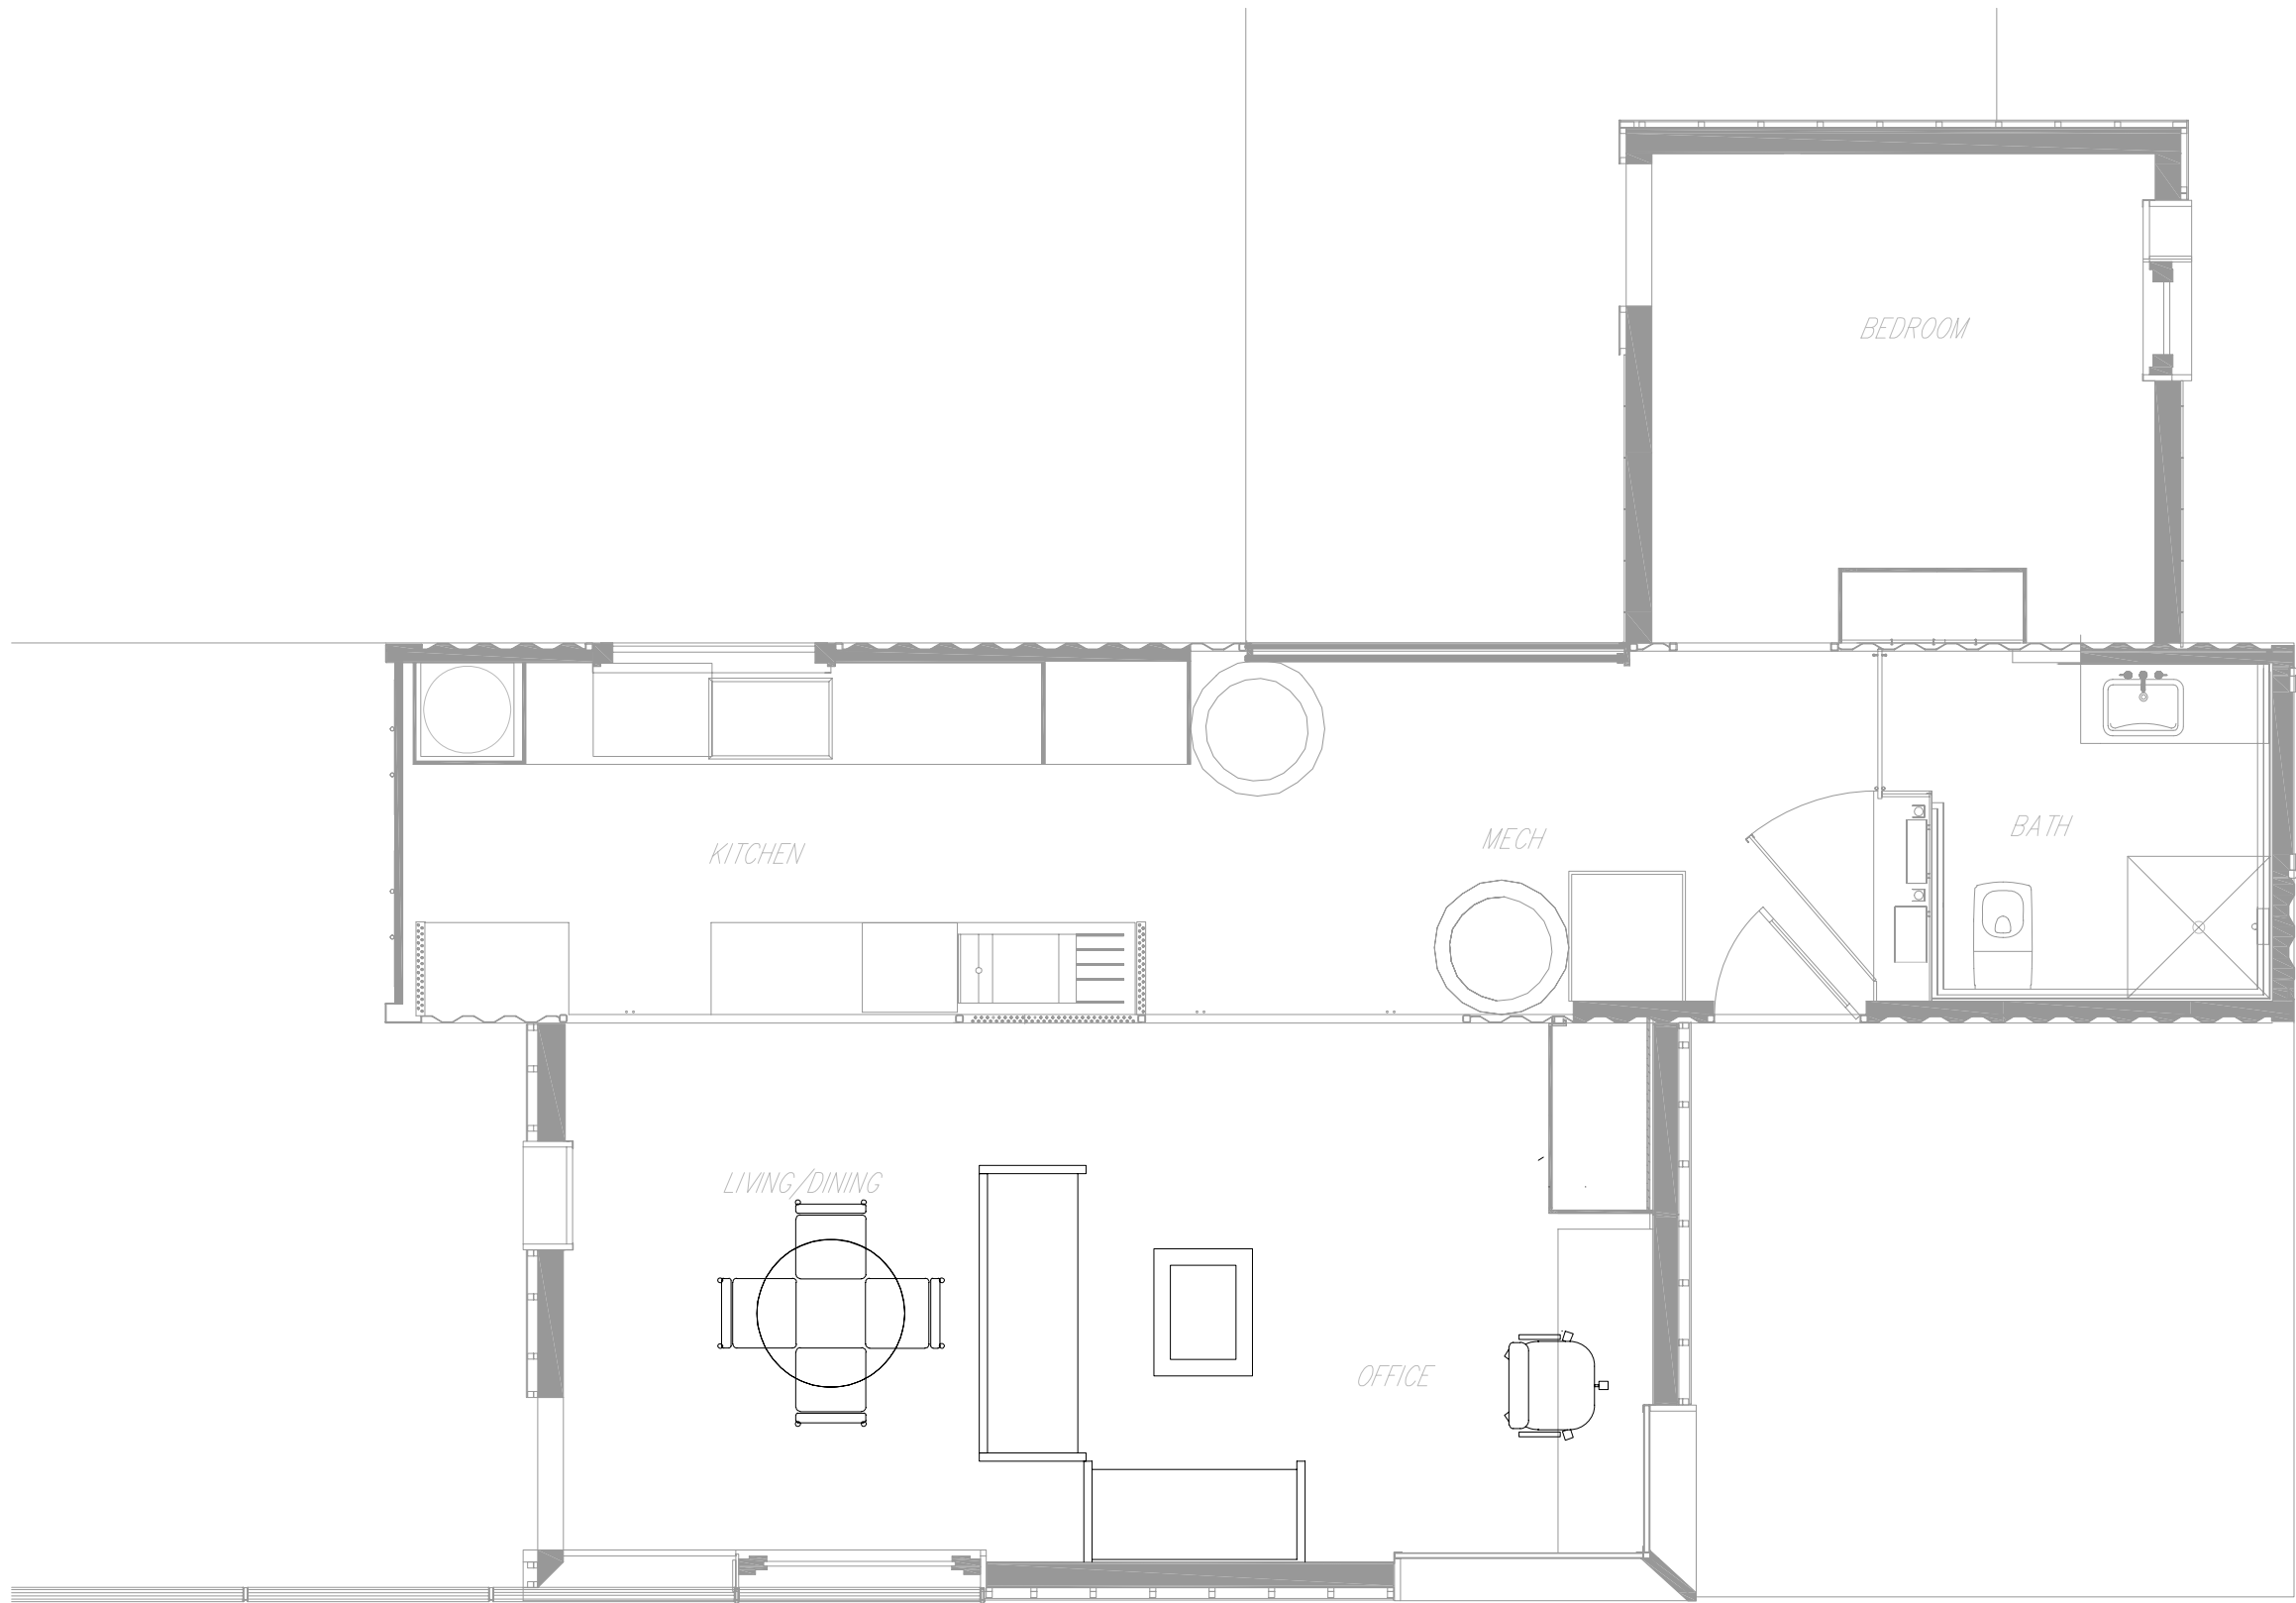

CC  
1.08

Furniture Plan

0 1' 2' 4' 8'

2007 Solar Decathlon

University of Colorado at Boulder  
Civil, Environmental, and Architectural Engineering  
428 UCB, Room ECCE 441  
Boulder, CO 80309-0428


Drawn by  
C. Corbin

Date  
August 7, 2007


Revised

Date



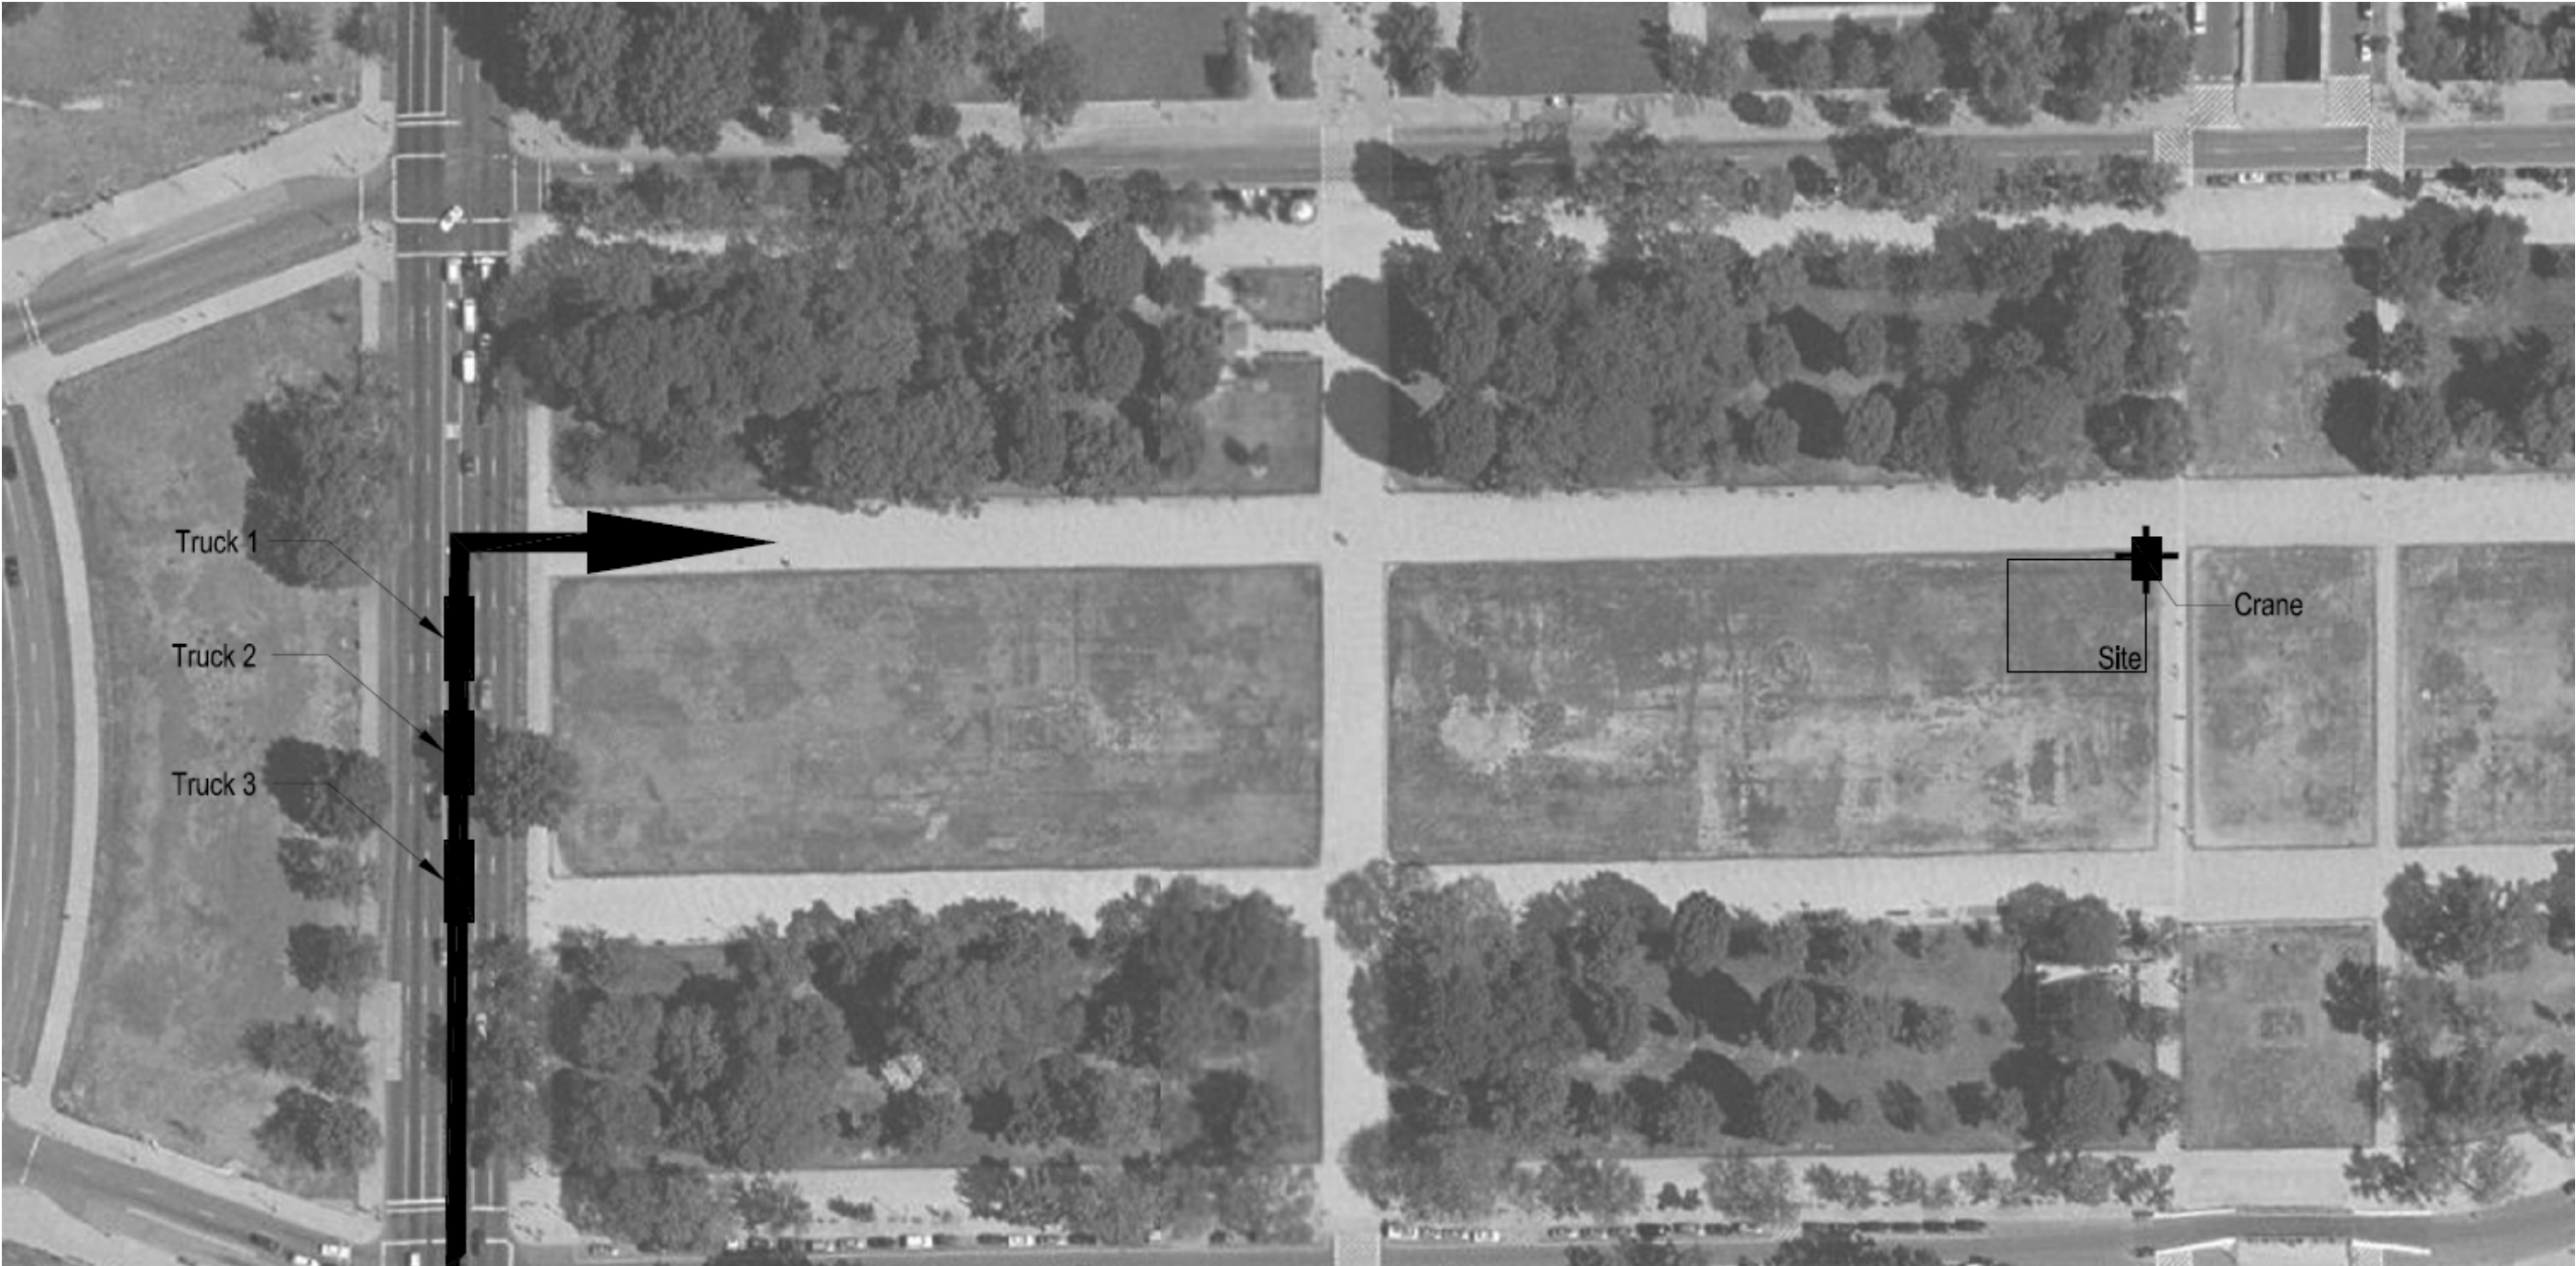



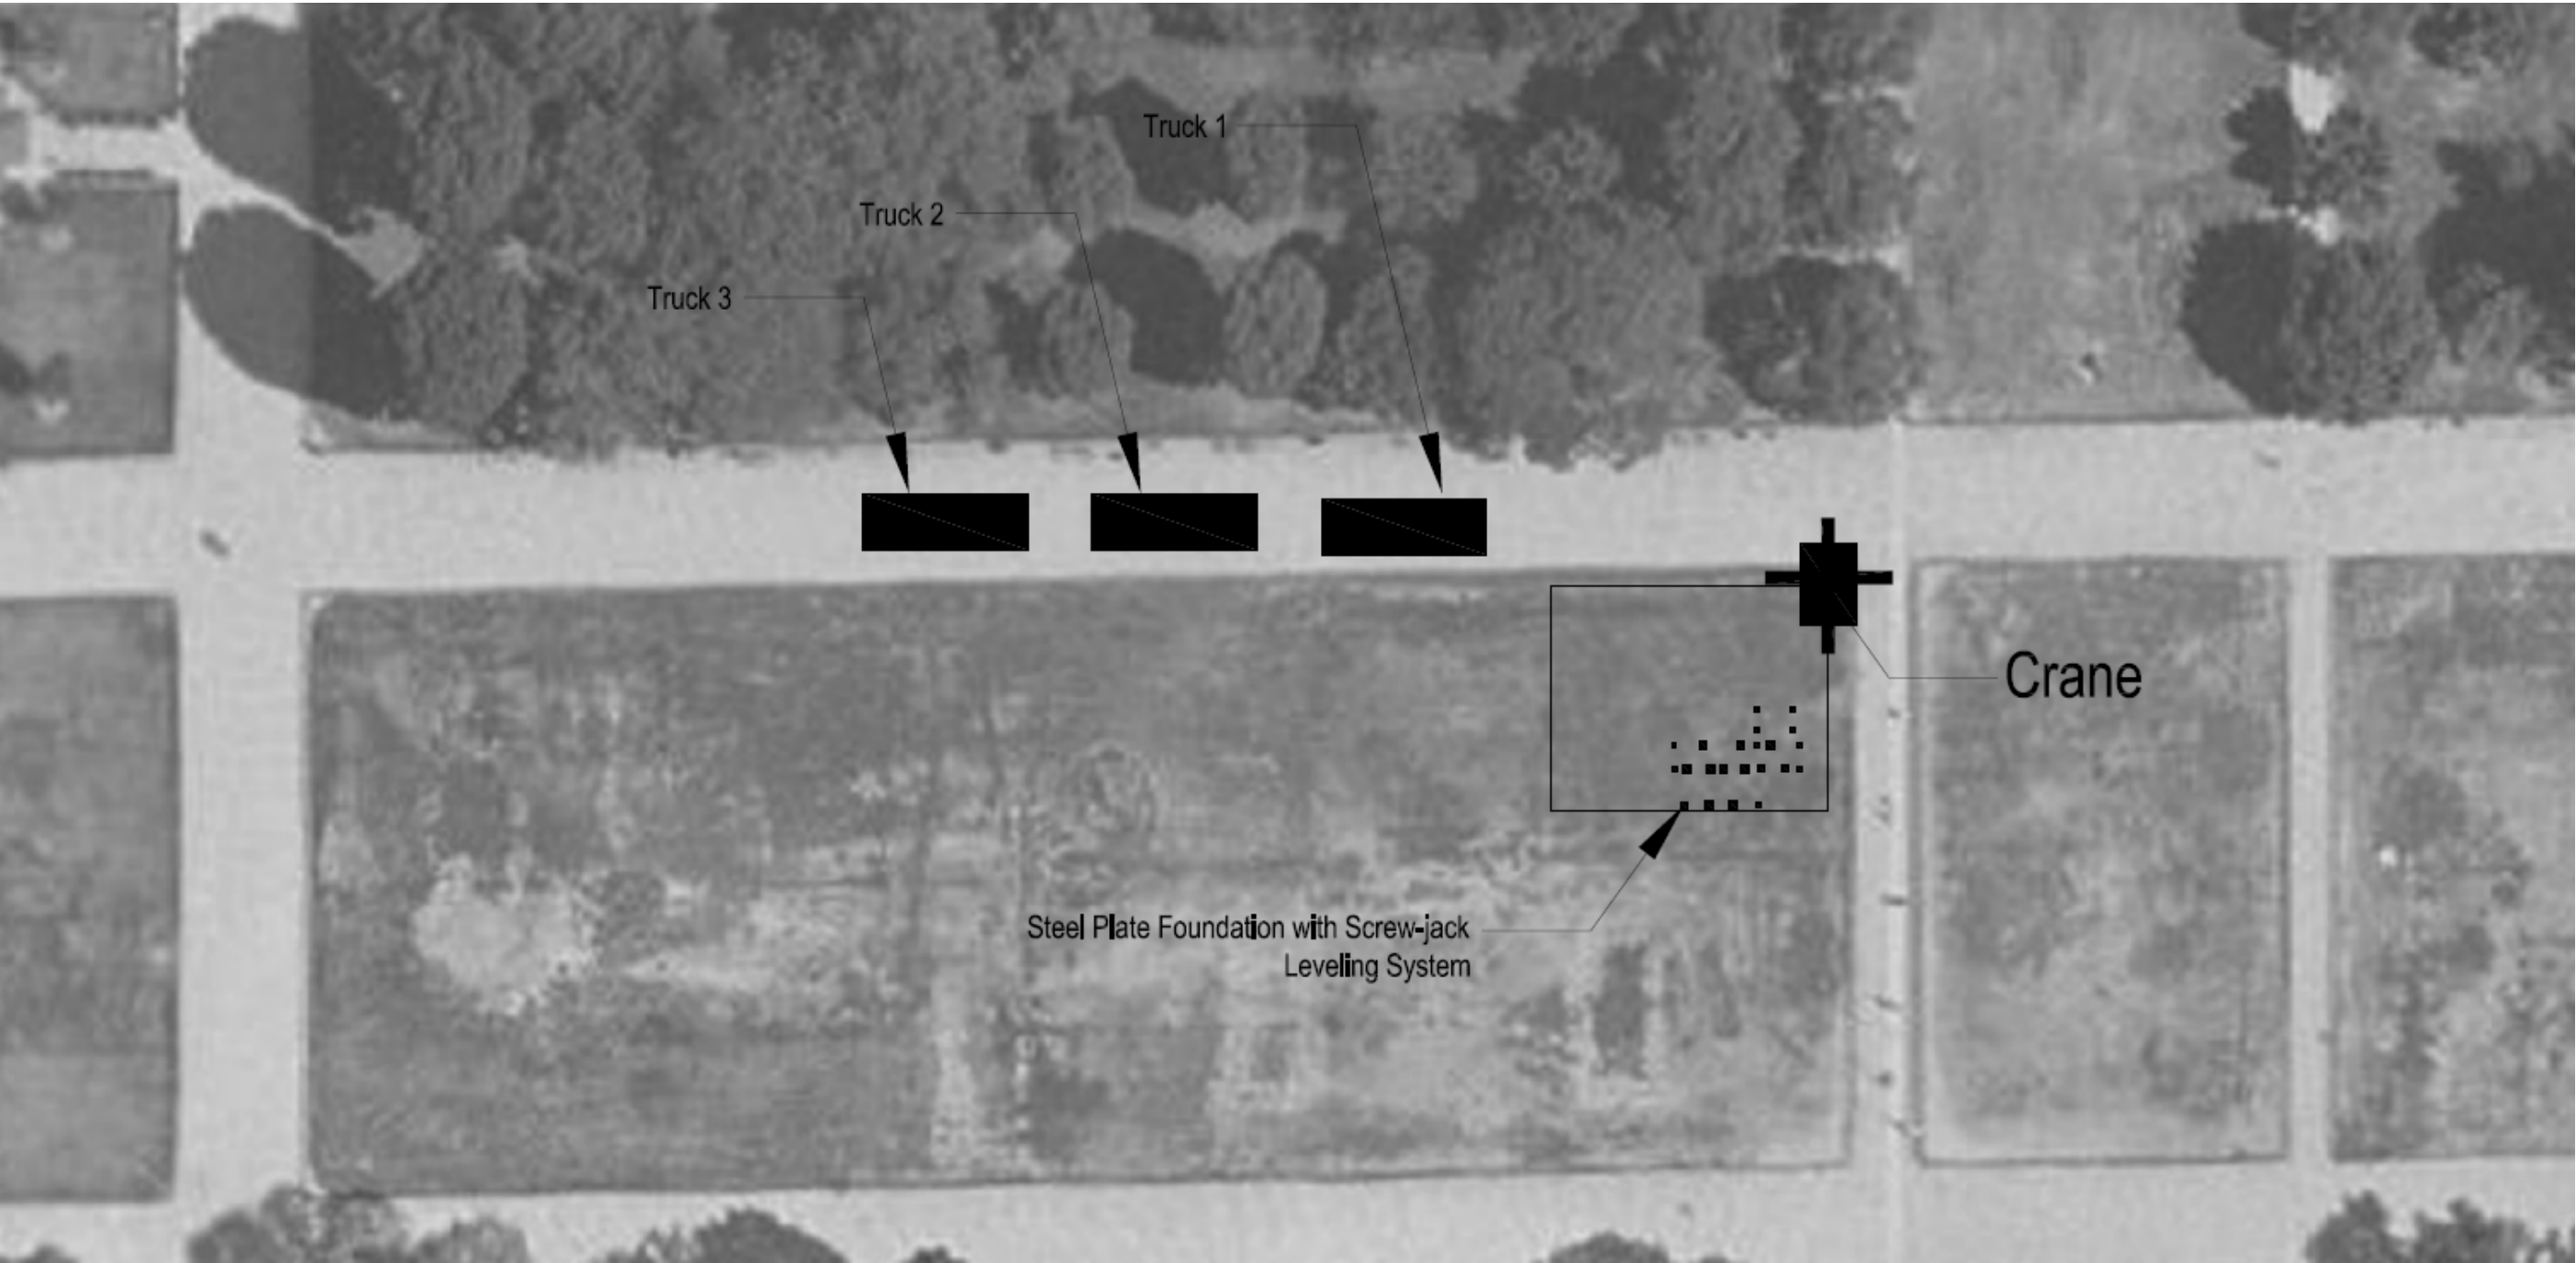


① STEP 1: FOUNDATION PLACEMENT  
N.T.S.

Drawn by	Date
C. Corbin	August 7, 2007
Revised	Date

Step 1: Foundation Placement	2007 Solar Decathlon
University of Colorado at Boulder Civil, Environmental, and Architectural Engineering 428 UCB, Room ECCE 441 Boulder, CO 80309-0428	



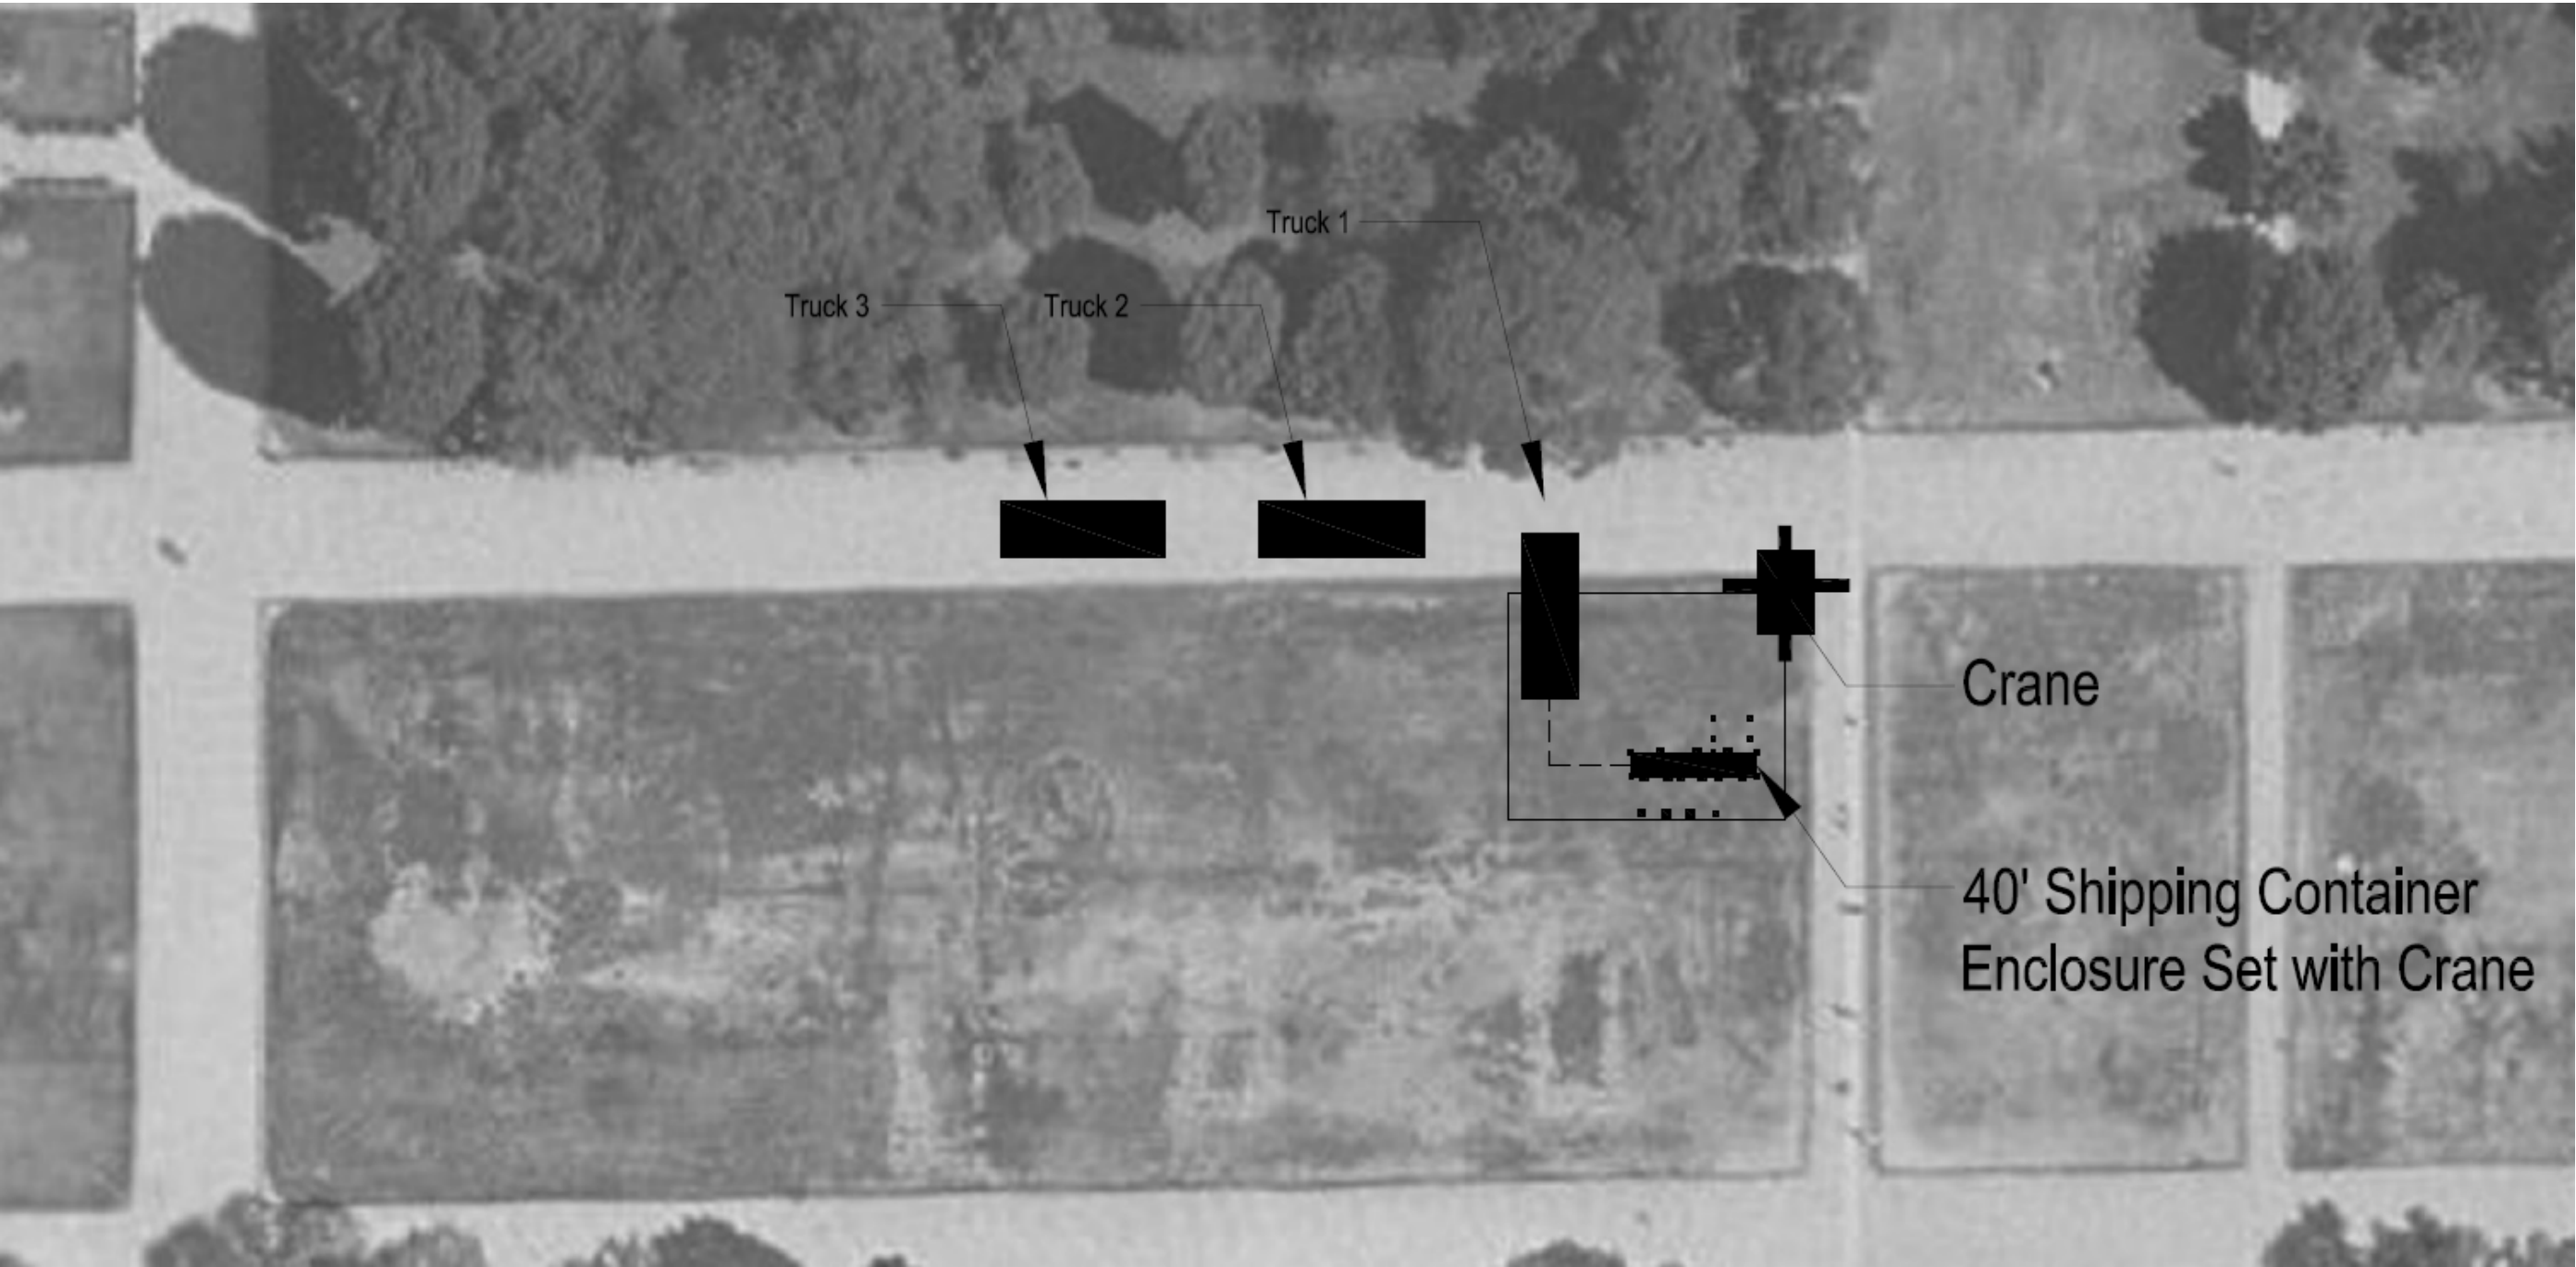

① STEP 2: CONTAINER PLACEMENT  
N.T.S.



CC  
1.11

Step 2: Container Placement

2007 Solar Decathlon

University of Colorado at Boulder  
Civil, Environmental, and Architectural Engineering  
428 UCB, Room ECCE 441  
Boulder, CO 80309-0428

Drawn by


C. Corbin


Revised

Date

August 7, 2007



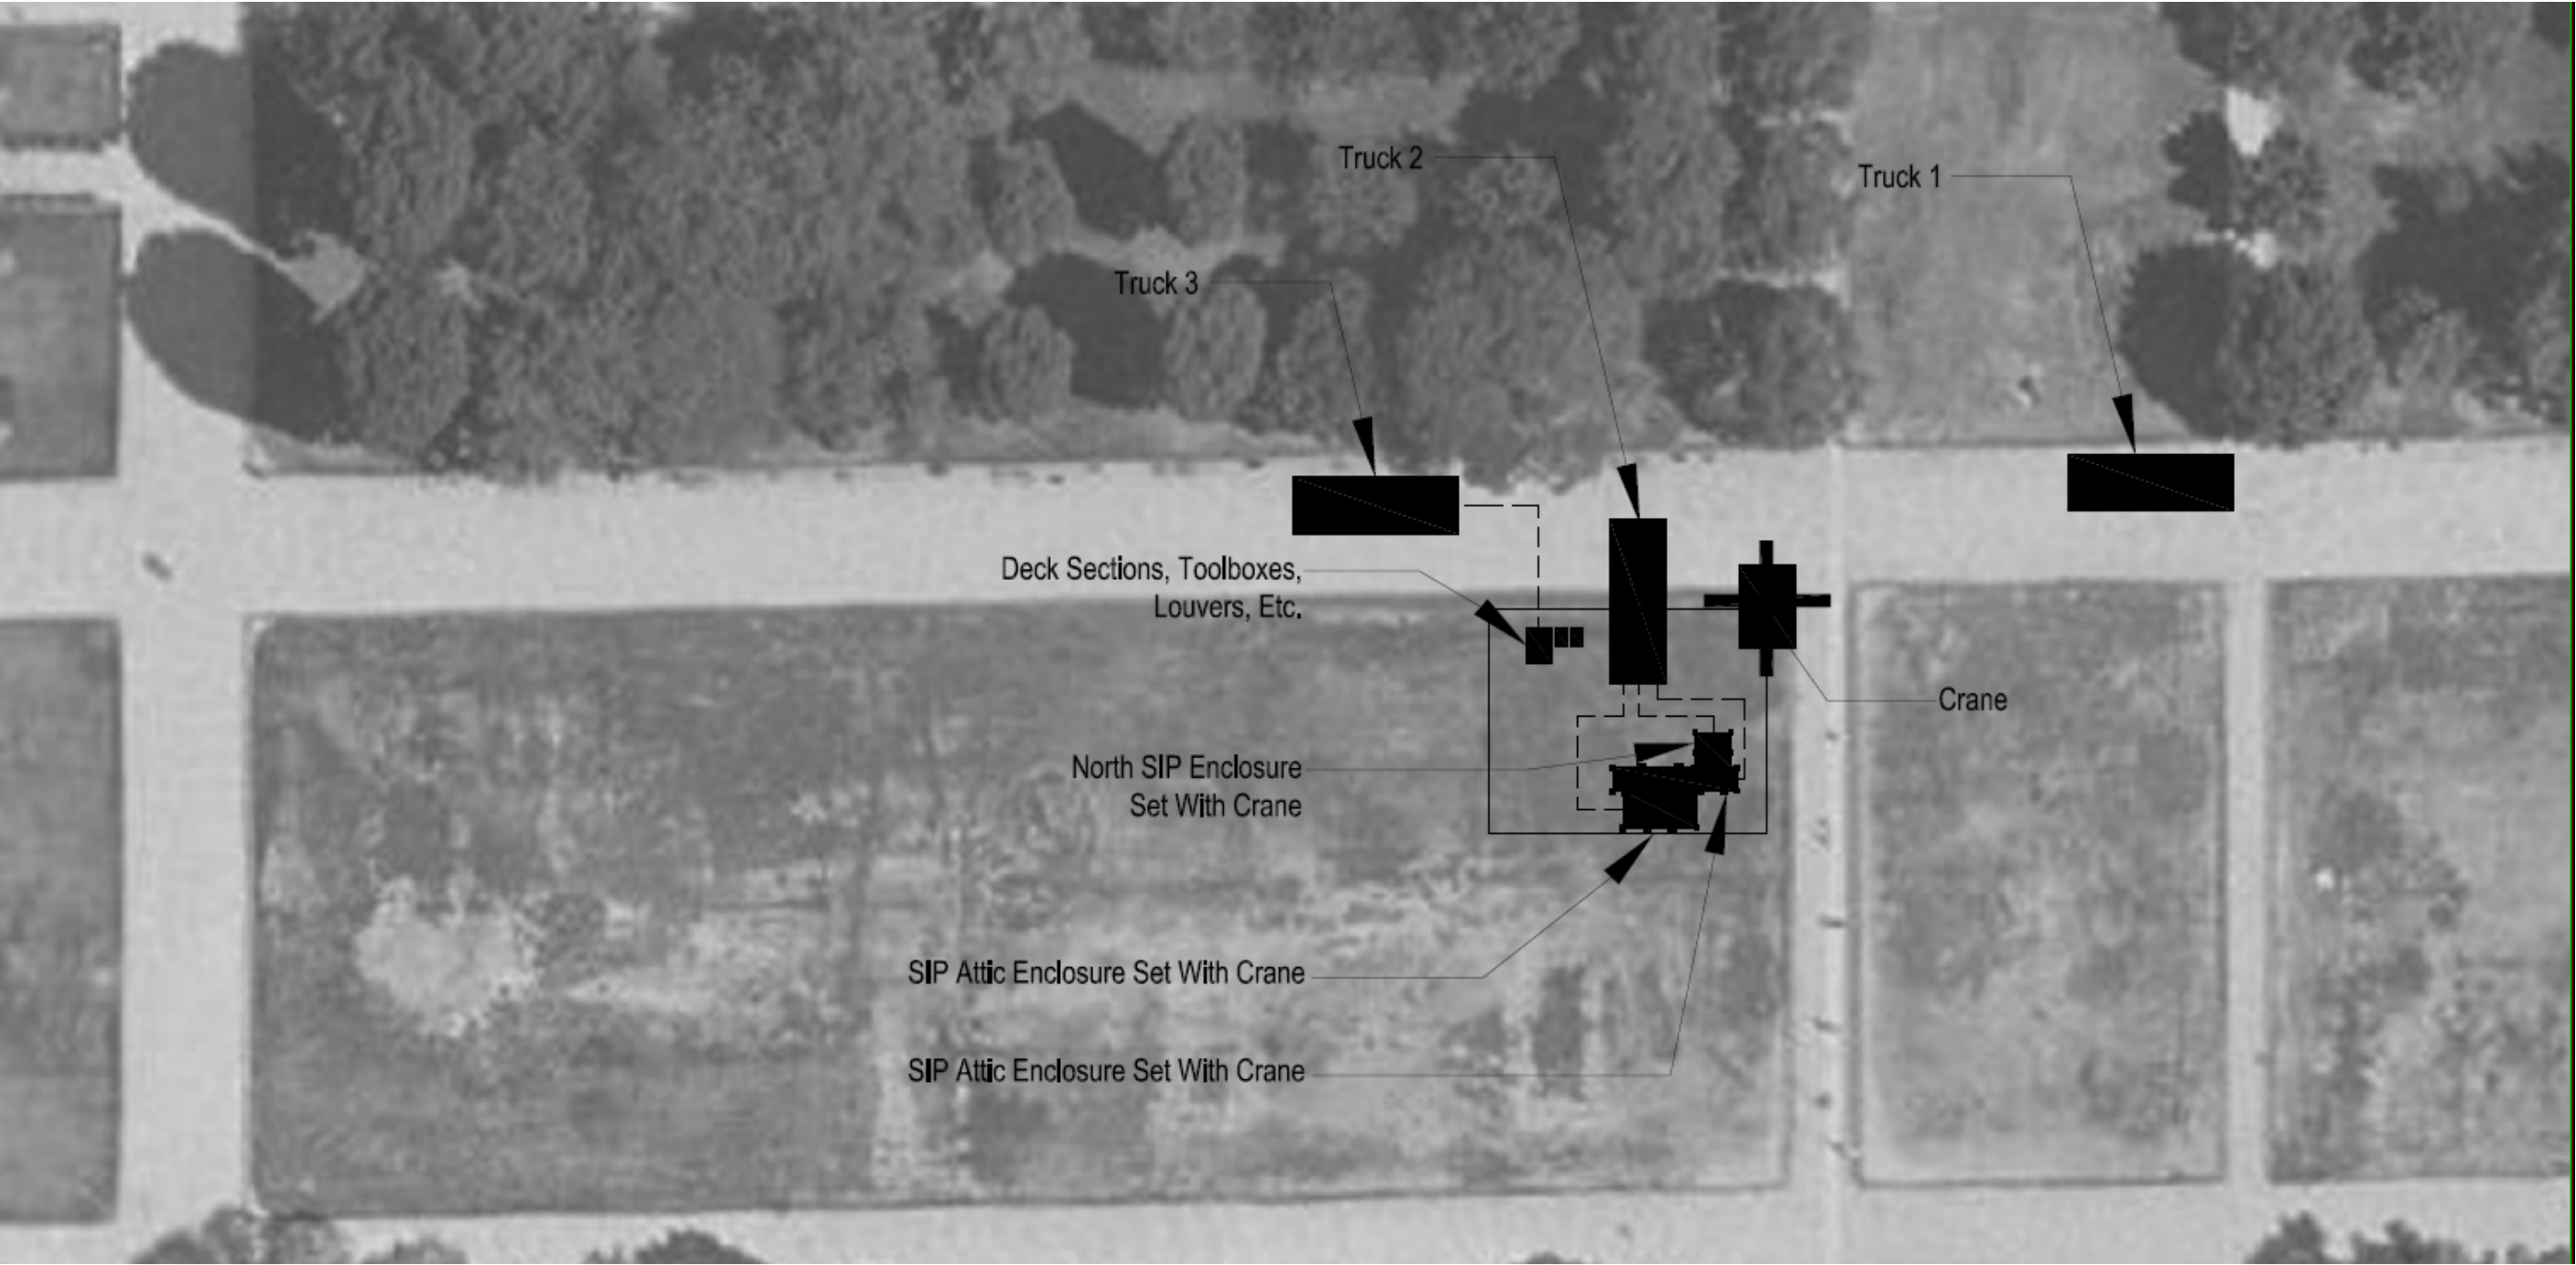

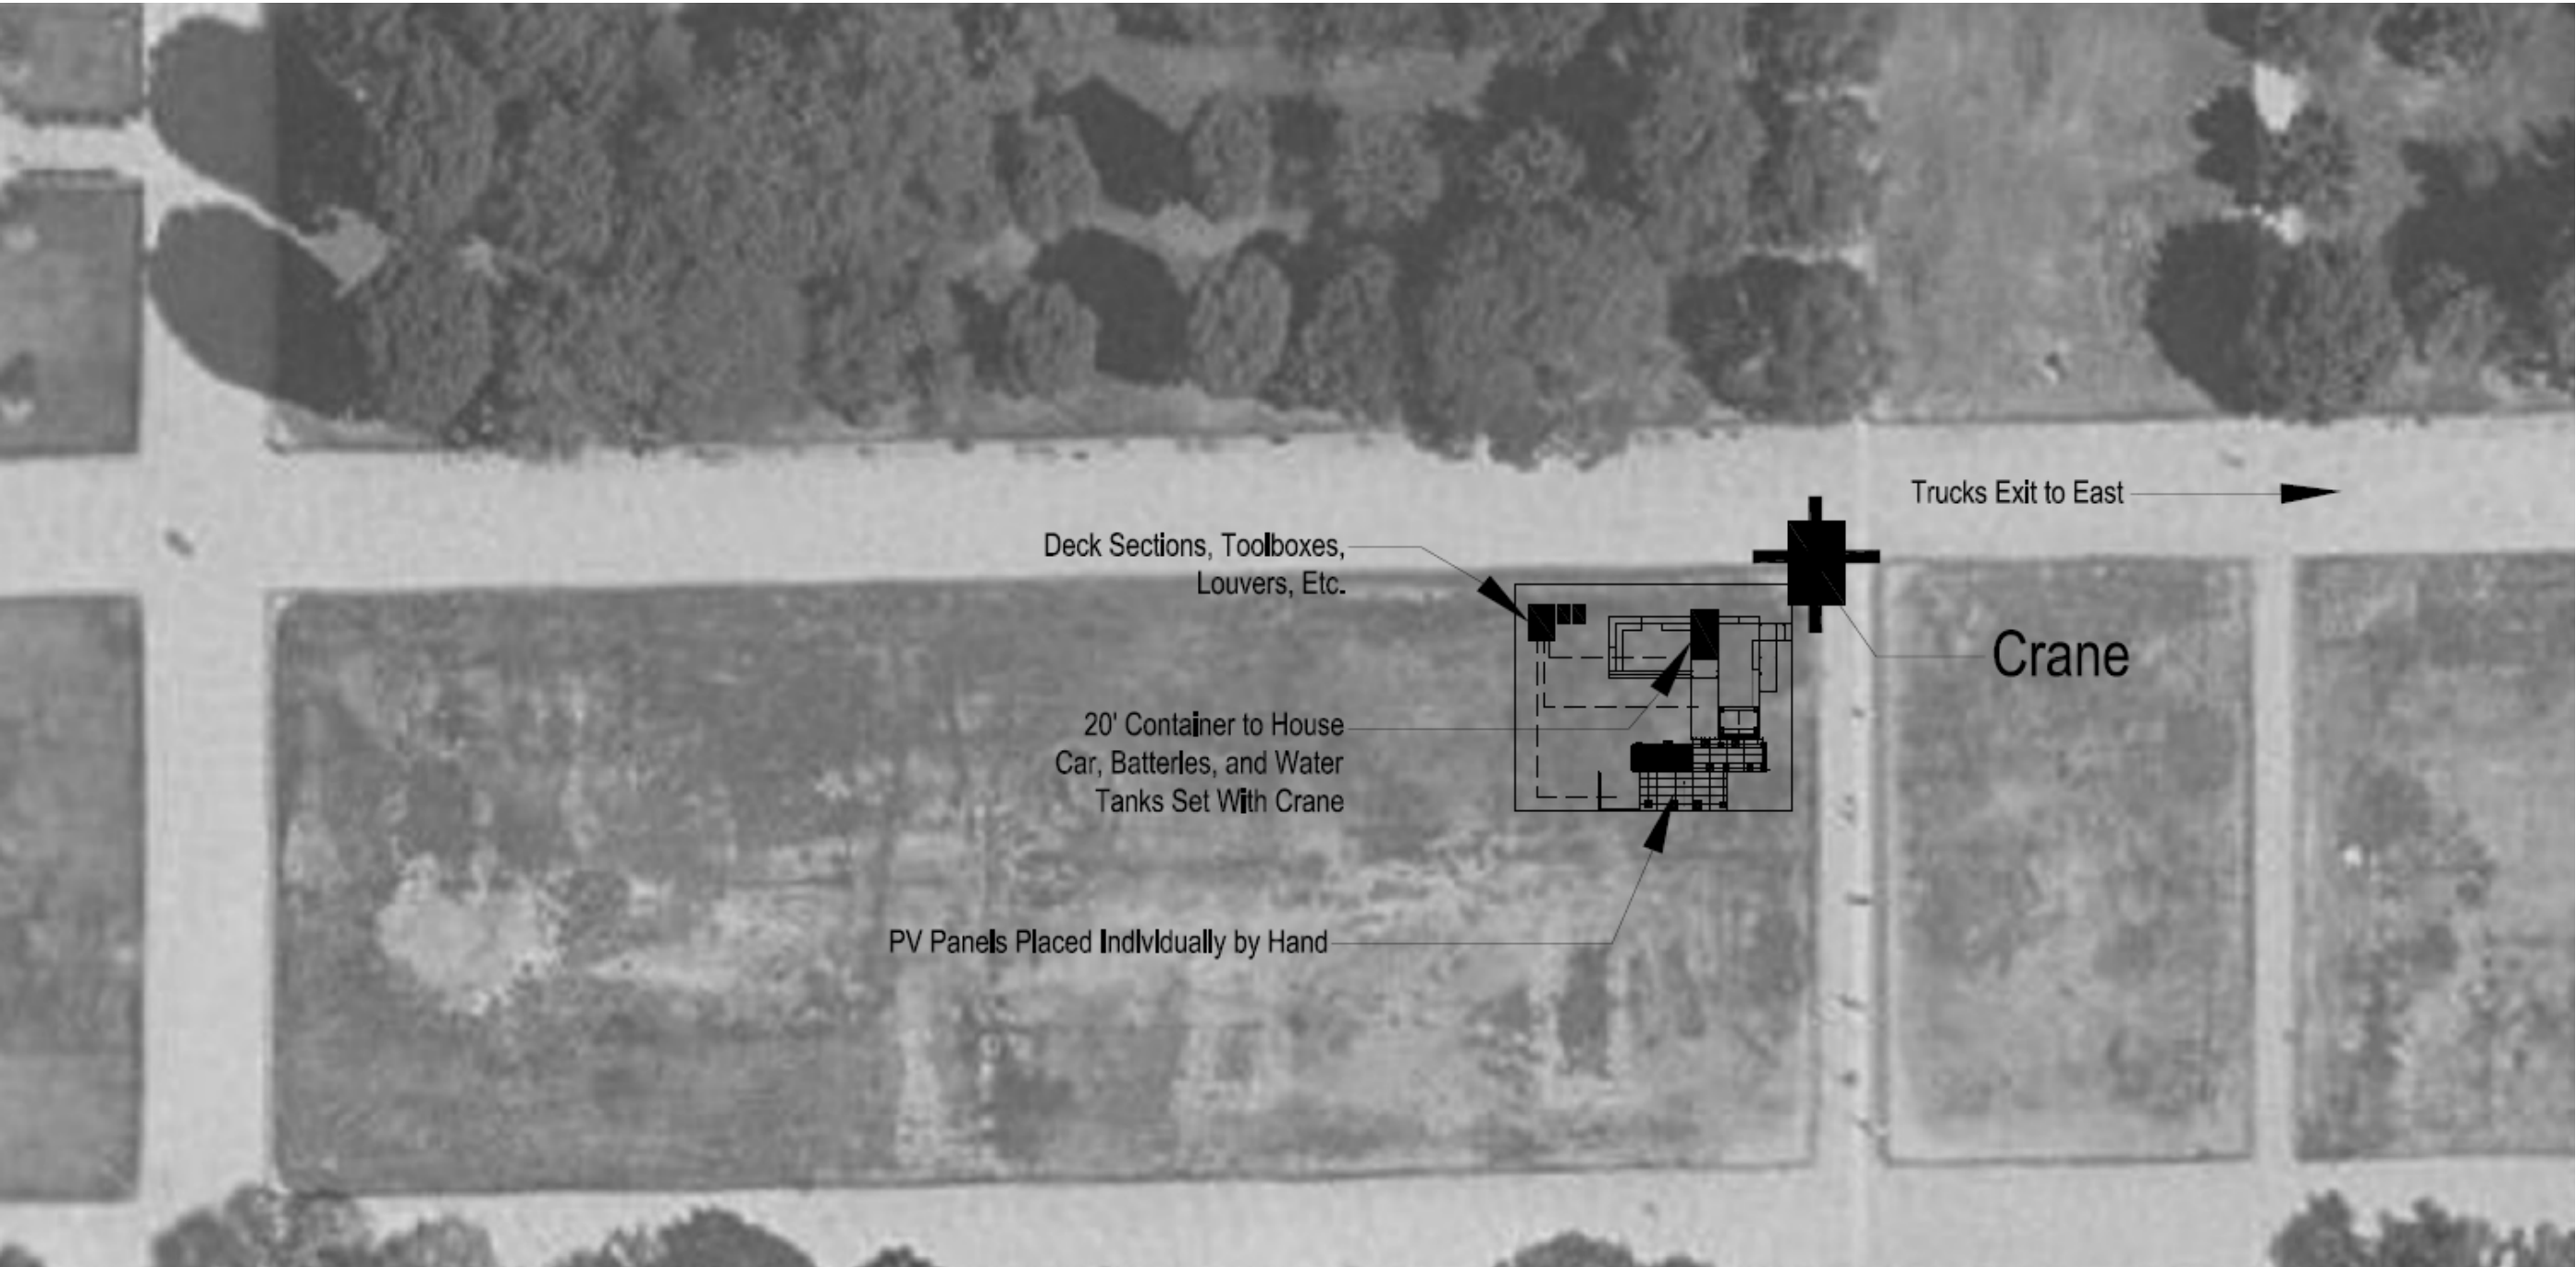

Drawn by	Date
C. Corbin	August 7, 2007
Revised	Date


Step 4: BIPV Roof Assembly

2007 Solar Decathlon

University of Colorado at Boulder  
Civil, Environmental, and Architectural Engineering  
428 UCB, Room ECCE 441  
Boulder, CO 80309-0428






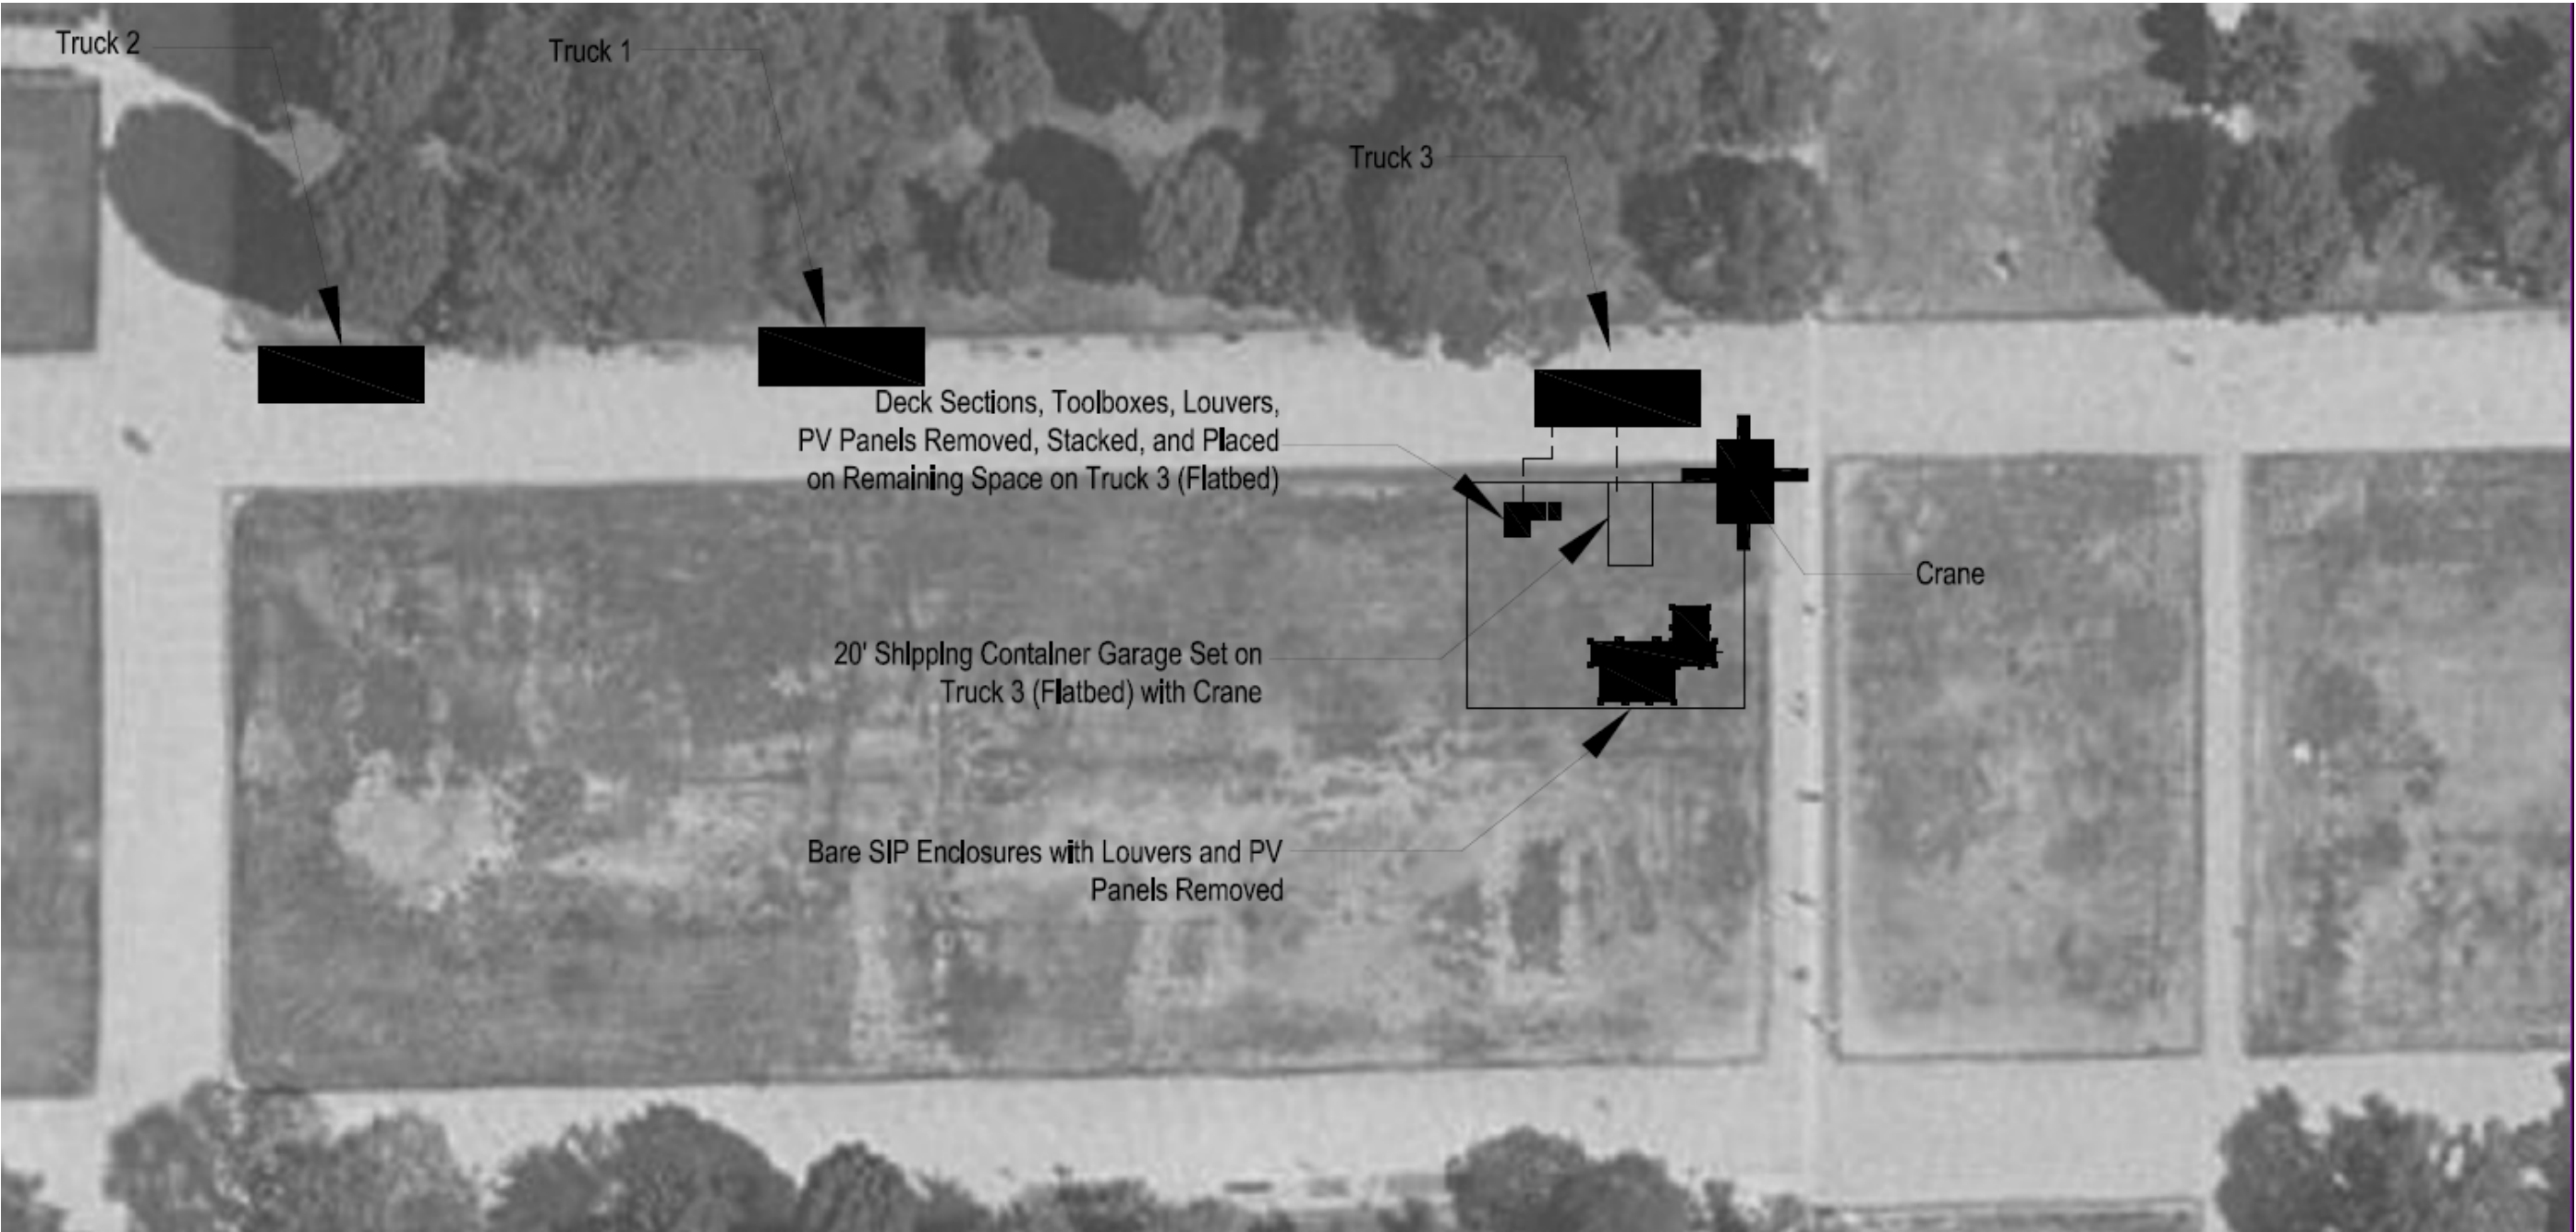

Drawn by	Date
C. Corbin	August 7, 2007
Revised	Date

2007 Solar Decathlon	University of Colorado at Boulder
Disassembly Step 1	Civil, Environmental, and Architectural Engineering 428 UCB, Room ECCE 441 Boulder, CO 80309-0428



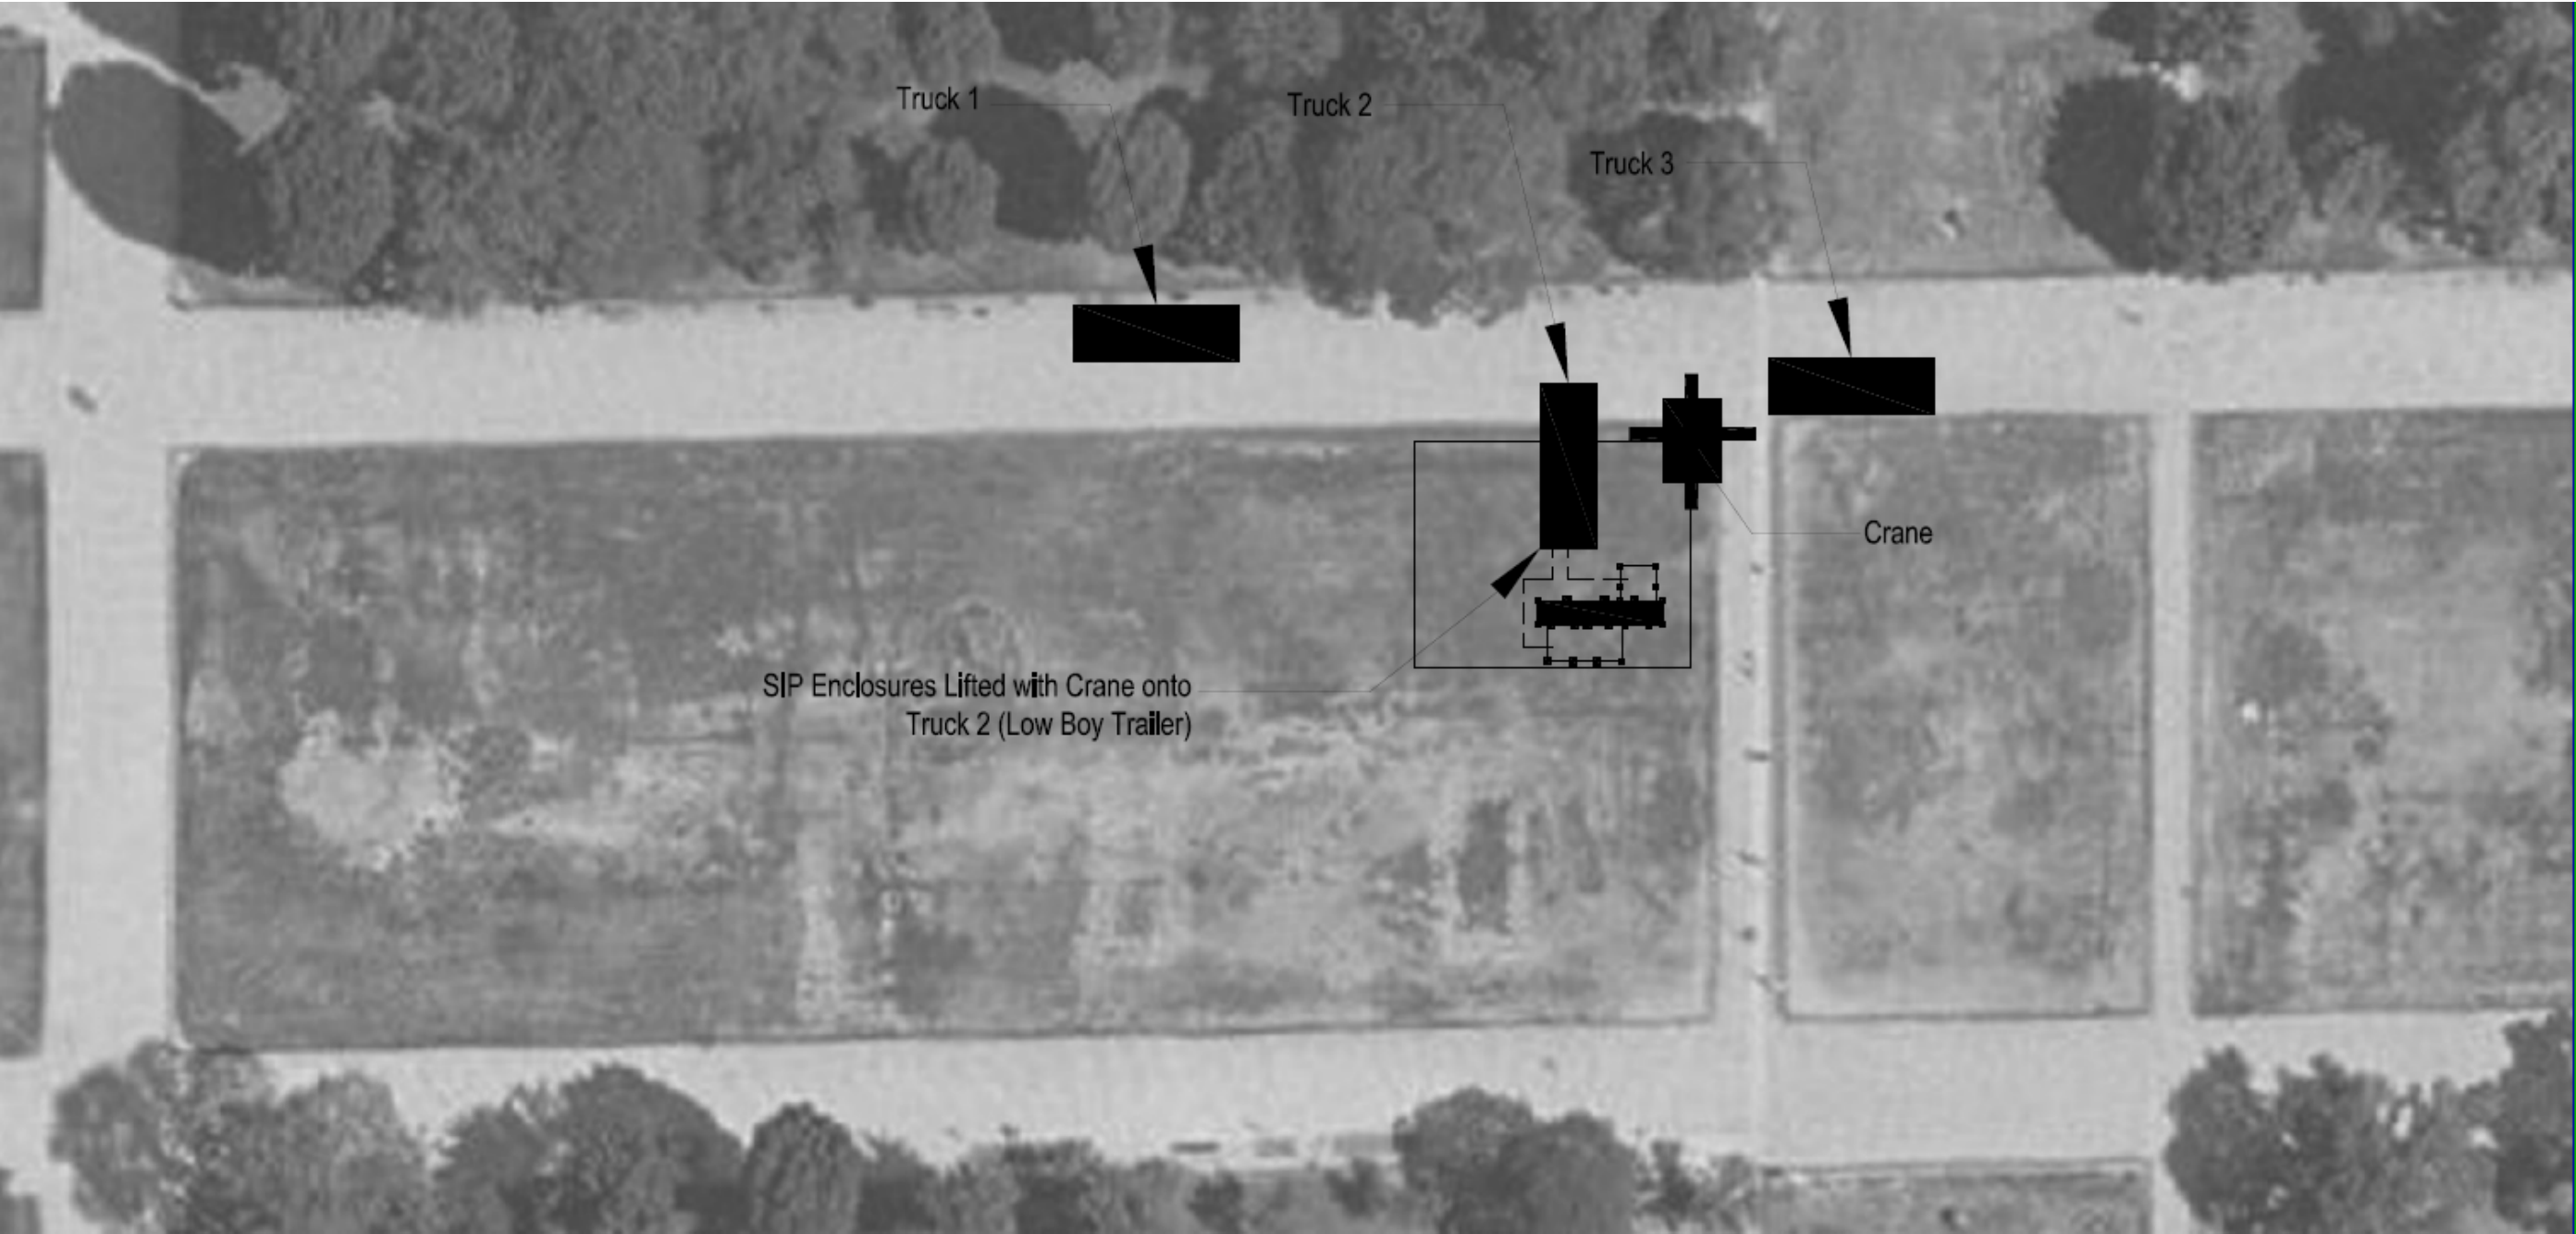


Drawn by	Date
C. Corbin	August 7, 2007
Revised	Date

2007 Solar Decathlon	University of Colorado at Boulder
Disassembly Step 2	Civil, Environmental, and Architectural Engineering 428 UCB, Room ECCE 441 Boulder, CO 80309-0428






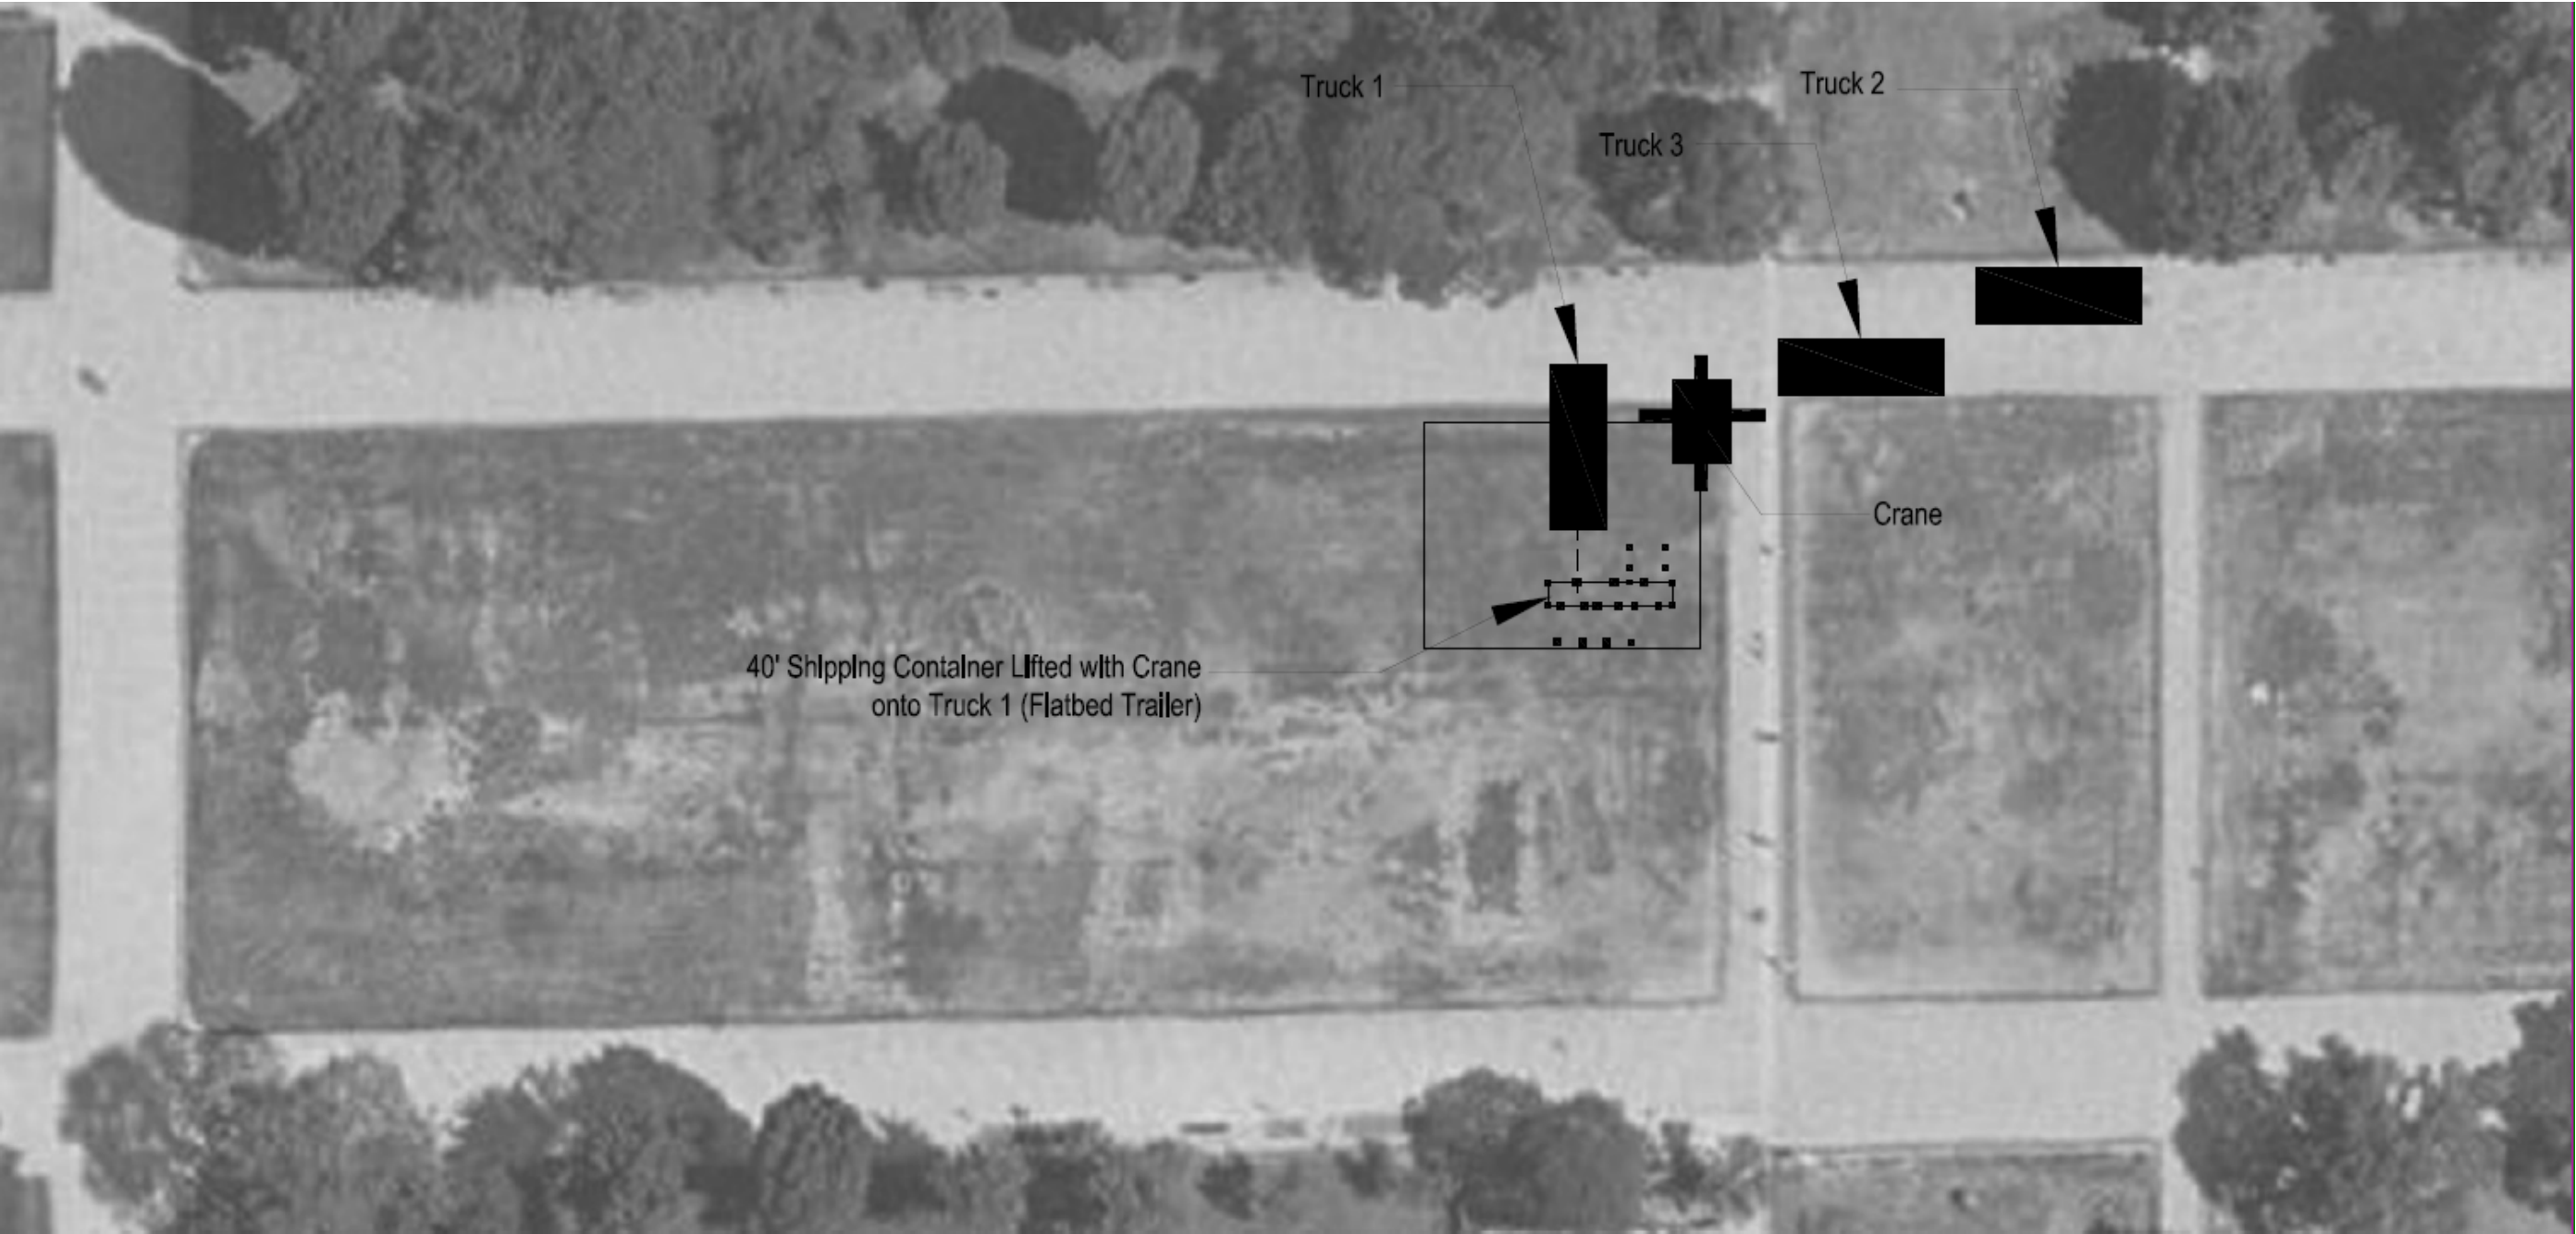

Drawn by	Date
C. Corbin	August 7, 2007
Revised	Date

2007 Solar Decathlon	University of Colorado at Boulder Civil, Environmental, and Architectural Engineering 428 UCB, Room ECCE 441 Boulder, CO 80309-0428
----------------------	--



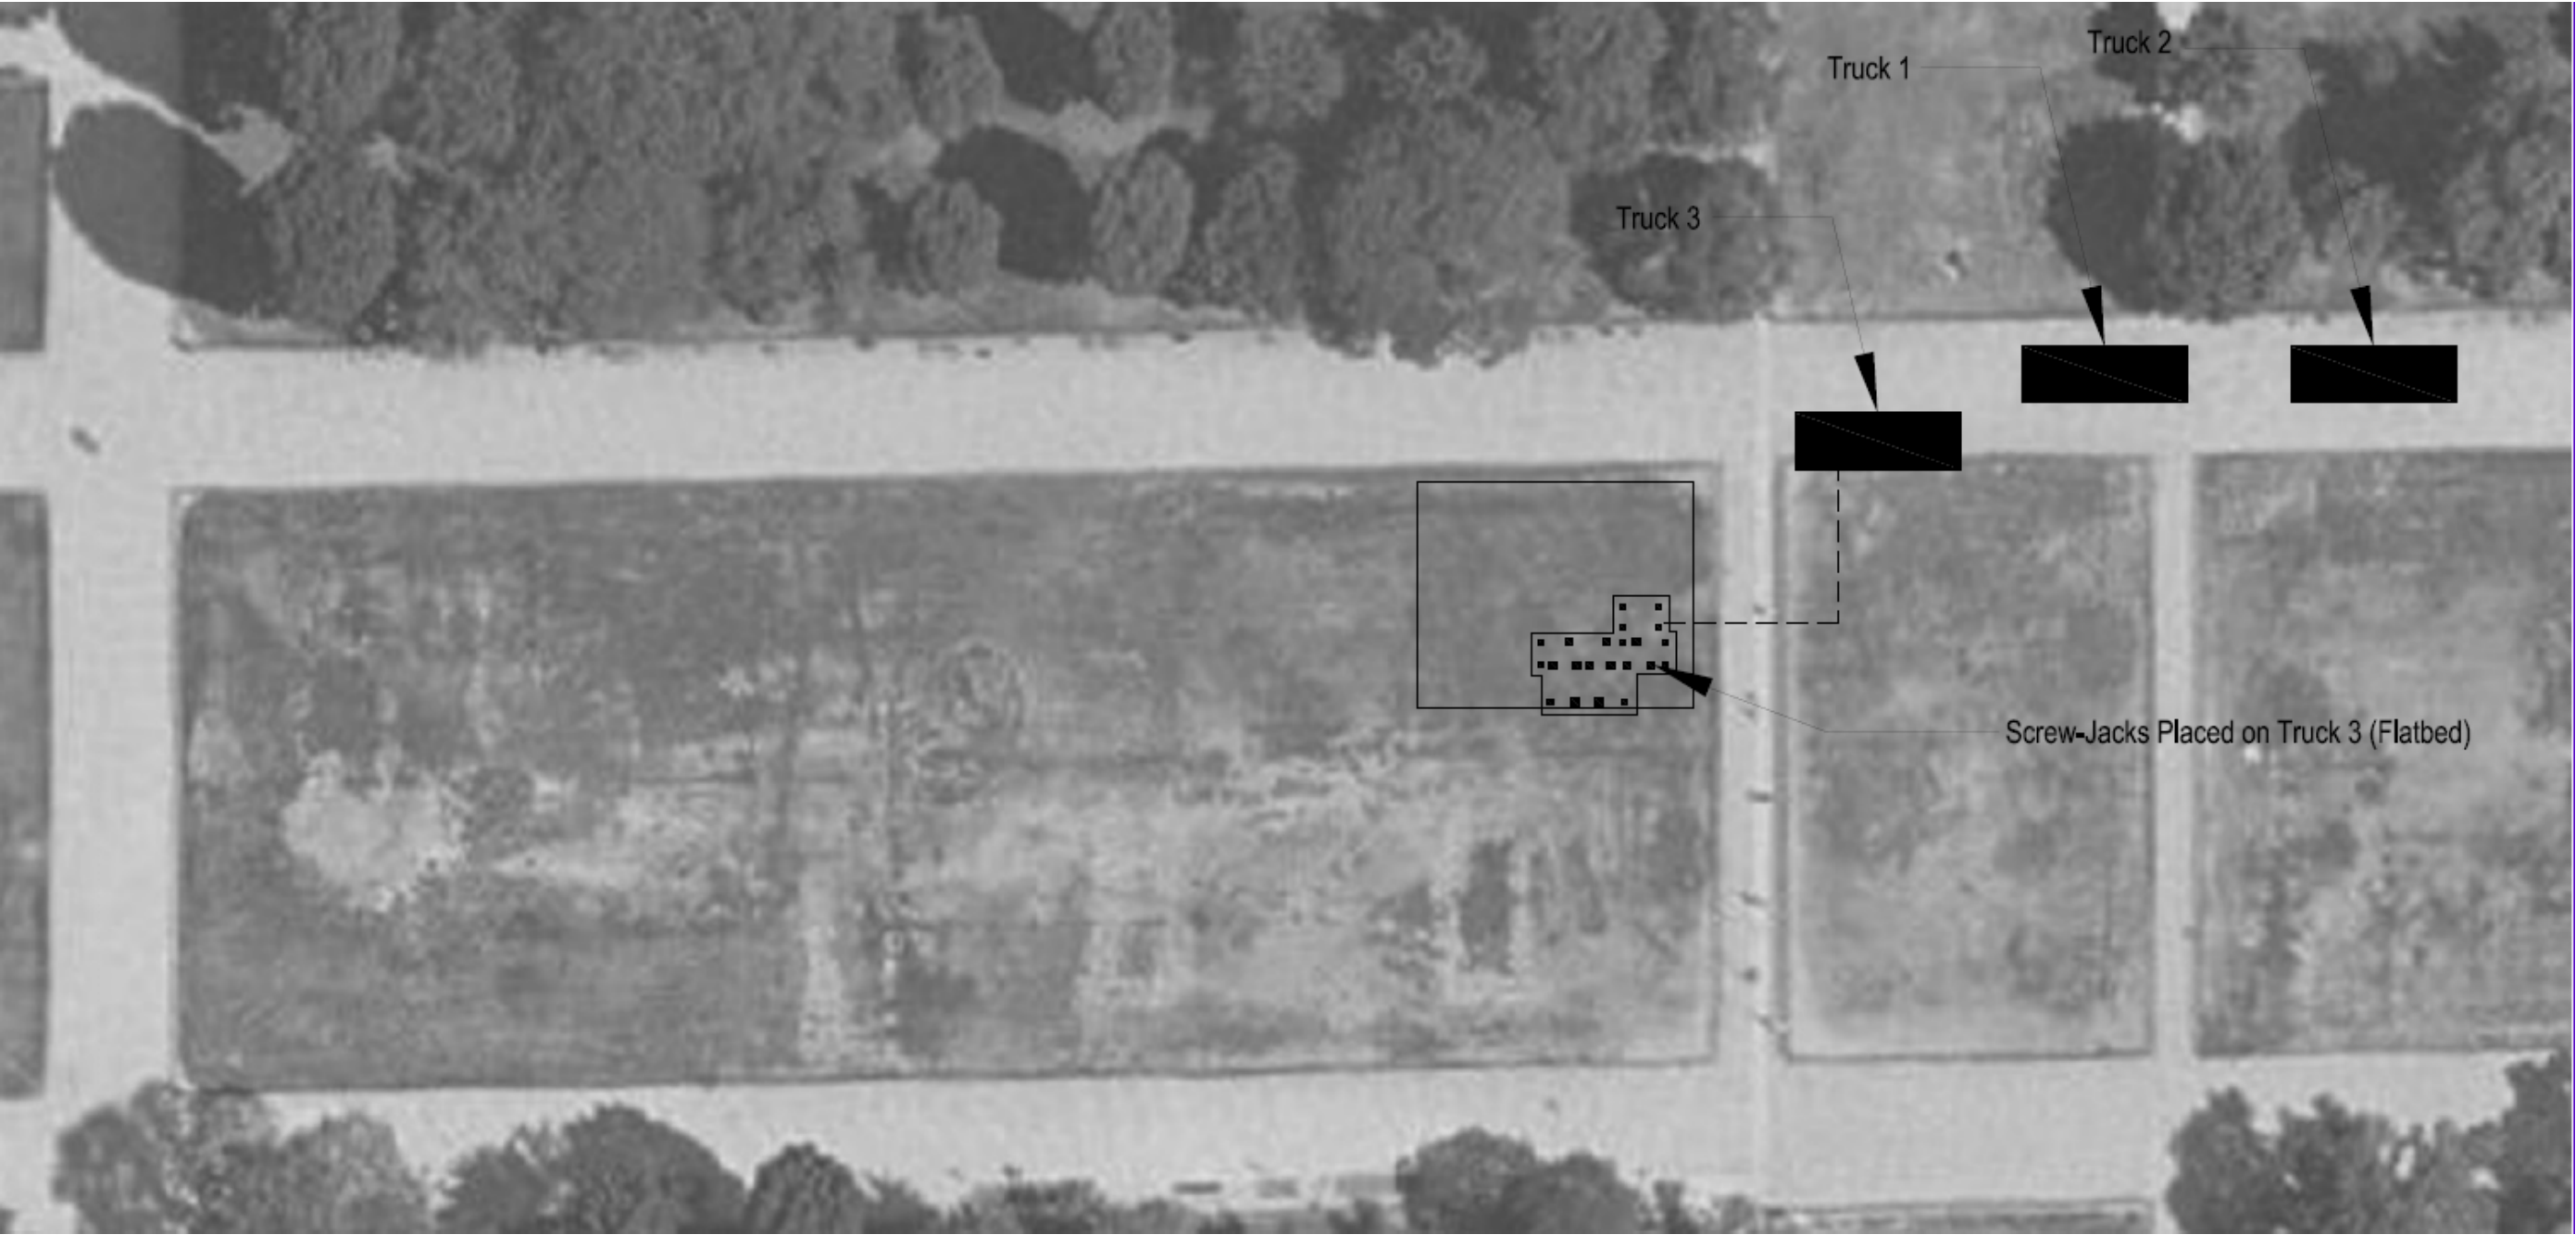

Drawn by	Date
C. Corbin	August 7, 2007
Revised	Date

2007 Solar Decathlon	University of Colorado at Boulder
Disassembly Step 4	Civil, Environmental, and Architectural Engineering 428 UCB, Room ECCE 441 Boulder, CO 80309-0428





JVA Job # Solar Decathlon 2007

GENERAL STRUCTURAL NOTES

DESIGN LIVE LOADS:

- 2006 IBC, U.O.N.
- \* Snow

20 psf
- \* Wind

60 mph, exp C, 3 second gust, DC
- 130 mph, exp C, # second gust, CO
- \* Floor

50 psf
- \* Exterior Decks

50 psf

FOUNDATION:

- Foundation design is in accordance with recommendations contained in soils investigation “Colar Decathlon Building Code” dated May 3, 2006 .
- The report is hereby referenced and except where otherwise specifically noted herein, all recommendations and precautions contained in that report shall be adhered to by the contractor.
- Footings shall be placed on undisturbed natural soil or compacted fill tested and approved by soils engineer.

Maximum design soil pressure: 1500 psf

STRUCTURAL STEEL:

- Structural Beams.:ASTM A992
- Angles, misc:ASTM A36
- Anchor Bolts:ASTM A307 or A36.
- Standard pipe columns:ASTM A 53, Grade B.
- Tube Columns:ASTM A500, Grade B, 46 ksi
- Connector bolts:ASTM A325
- All structural steel shall be fabricated and erected per the current edition of AISC Steel Construction Manual.
- Welding by qualified welders. E70XX electrodes. 3/16” fillet welds, unless noted otherwise.
- Except as noted, framed beam connections shall be detailed to develop 0.6 x Allowable Uniform Load values tabulated in the 9th Edition AISC Manual, Pp. 2-27 and following.
- All beams shall have full depth web stiffeners each side of webs above and below columns. (1/4" or as noted)
- Attach wood nailer plates to beams with 1/2" diameter machine or carriage bolts at maximum 32" o.c., or 3/8" diameter bolts at 32" with glued contact face, or 5/32" diameter powder actuated drive pins at 24" o.c., U.O.N.

WOOD FRAMING:

- Dimension Lumber is designed and shall be supplied using BASE VALUES Design Criteria.
- Hem-Fir #2 and better (Maximum Moisture Content 19%) U.O.N.
- Plates: Sill plates: Preservative treated Hem Fir or Southern Pine.
- “Pressure treated lumber” shall be framing material of the specified species which has been pressure treated with a decay and insect resistant solution, meeting all current standards for wood in contact with concrete or earth. Sill plates in contact with masonry or concrete foundations, footings or slabs may be treated Timber Strand LSL (zinc borate treatment). Acceptable treatment mediums for wood in contact with earth or in exterior applications include ACQ (Alkaline Copper Quaternary) and copper azole. All connectors shall meet the recommendations of the pressure treated wood manufacturer, but shall be not less than Hot Dipped Galvanized or Stainless Steel. All screws, nails and bolts shall match hangers and other connectors. Do not mix stainless with galvanized products.
- Do not allow aluminum to contact treated wood.
- Top and Bottom Plates: Hem Fir
- Hem Fir Studs U.O.N:

2 x 4 and 2 x 6

to 8'-0:

stud grade
- 2x4

over 8'-0

standard and better
- 2x6

over 8'-0

No. 2 and better
- Beams: Douglas Fir No. 1, Fb=1350 psi, E=1,600,000 psi
- Columns: Douglas Fir No. 1, Fb=1200 psi, E=1,600,000 psi
- Laminated Veneer Lumber (LVL): Manufactured 1 3/4" wide Microllams (ML) by Trus Joist or equivalent.
- Fb=2,600 psi, E=1,900,000 psi, Fv=285 psi, depth noted on plans.
- LSL Rim Joists: Manufactured 1-1/4” x depth indicated laminated strand lumber by Trus Joist. No substitutions.
- Glued, laminated framing members per ANSI Standard A190.1-92. Mark members with an AITC Quality Stamp and furnish an AITC Certificate of Conformance. Doug Fir, Fb = 2400 psi, E = 1,800,000
- Simple span: Combination Symbol: 24FV4, <<<<ZERO 2400 FT SEE PLANS for >>>> camber.
- Multiple span, continuous beam, and cantilevered beams. Combination Symbol: 24FV8, zero camber.
- Minimum nailing shall comply with UBC Table 23-II-B-1 or IBC Table 2304.9.1 except where more or larger nailing shown on drawings.
- Metal connectors: Simpson Strong Tie unless otherwise noted, installed with number and type of nails to achieve maximum rated capacity. Note that heavy duty and skewed hangers may require special order.
- All beams shall be braced against rotation at points of bearing.
- Drypack grout all beam pockets full after beams are set.
- Lead holes for lag screws shall be 60% to 70% of lag shank diameter in compliance with AITC criteria.

STRUCTURAL INSULATED PANEL FRAMING:

- \*Except as noted otherwise, minimum nailing shall be provided as specified in IBC Table 2304.9.1 “Fastening Schedule.”
- \*Roof to Wall connection

Fasteners shall have minimum of 1-1/2” penetration into support member. Secure roof panel to wall top spline with both screw fasteners 2” thicker than panel spaced 12” o.c. and two strips of construction adhesive.
- \*Roof to Beams or top wall plates

Fasteners for 4-1/2” roof panels shall be 6” panel screw at 8” o.c.

Fasteners for 6-1/2” roof panels shall be 8” panel screw at 8” o.c.
- \*Roof Panels to Ridge beam

Fasteners for 4-1/2” roof panels shall be 6” panel screw at 12” o.c.

Fasteners for 6-1/2” roof panels shall be 8” panel screw at 12” o.c.
- \*Wall to Floor connections

Use 16d nails space 6’ o.c. in two staggered rows to secure bottom spline to floor sill.
- \*Wall panel Assembly: Lock panels together using manufacturer specified locking system.
- \*Plywood and oriented strand board (OSB) floor and roof sheathing shall be APA graded with panel identification index, thickness, and nailing as noted on the drawings.
- \*End stud at each doorjamb, at all exterior corners, and at ends of OSB sheathed wall sections shall have one H4 anchor to the sole plate.

STRUCTURAL ERECTION AND BRACING REQUIREMENTS


- The structural drawings illustrate the completed structure with all elements in their final positions, properly supported and braced. The contractor, in the proper sequence, shall provide proper shoring and bracing as may be required to achieve the final completed structure.
- These plans have been engineered for construction at one specific building site. Builder assumes ALL responsibility for use of these plans at Any Other building site. Plans shall not be used for construction at any other building site without specific review by the engineer.

FRAMING NOTES:

- ① = number of studs in built-up stud columns below, nail all laminations with 16d at 12" o.c. full height.
- T = Header Trimmer
- K = King Stud
- One trimmer and one king stud each side of openings in stud walls U.O.N.
- Header sizes shown are minimum. Headers may be standardized at largest size at contractors option. (If not indicated, min. Header is 3 - 2X8 for 2x6 stud walls, or 2-2x8 for 2x4 stud walls)

SHOP DRAWINGS

Fabricator and / or supplier of structural steel, structurally insulated panels, and shipping container modifications shall submit shop and erection drawings for architect and engineer review. Submit one reproducible and two prints for each drawing. Allow five working days for review.

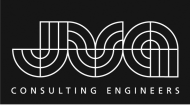

JVA, Incorporated1319 Spruce StreetBoulder, CO 80302Phone: 303.444.1951Fax: 303.444.1957E-mail: info@jvajva.com

Date	August 7, 2007
Drawn by	K. Rogne
Date	January 9, 2007
Revised	

2007 Solar Decathlon

General Notes

University of Colorado at Boulder


Civil, Environmental, and Architectural Engineering  
428 UCB, Room ECCE 441  
Boulder, CO 80309-0428

\*Scale as Noted



S-1.0

Date	August 7, 2007
Drawn by	K. Rogne
Revised	
Date	January 9, 2007

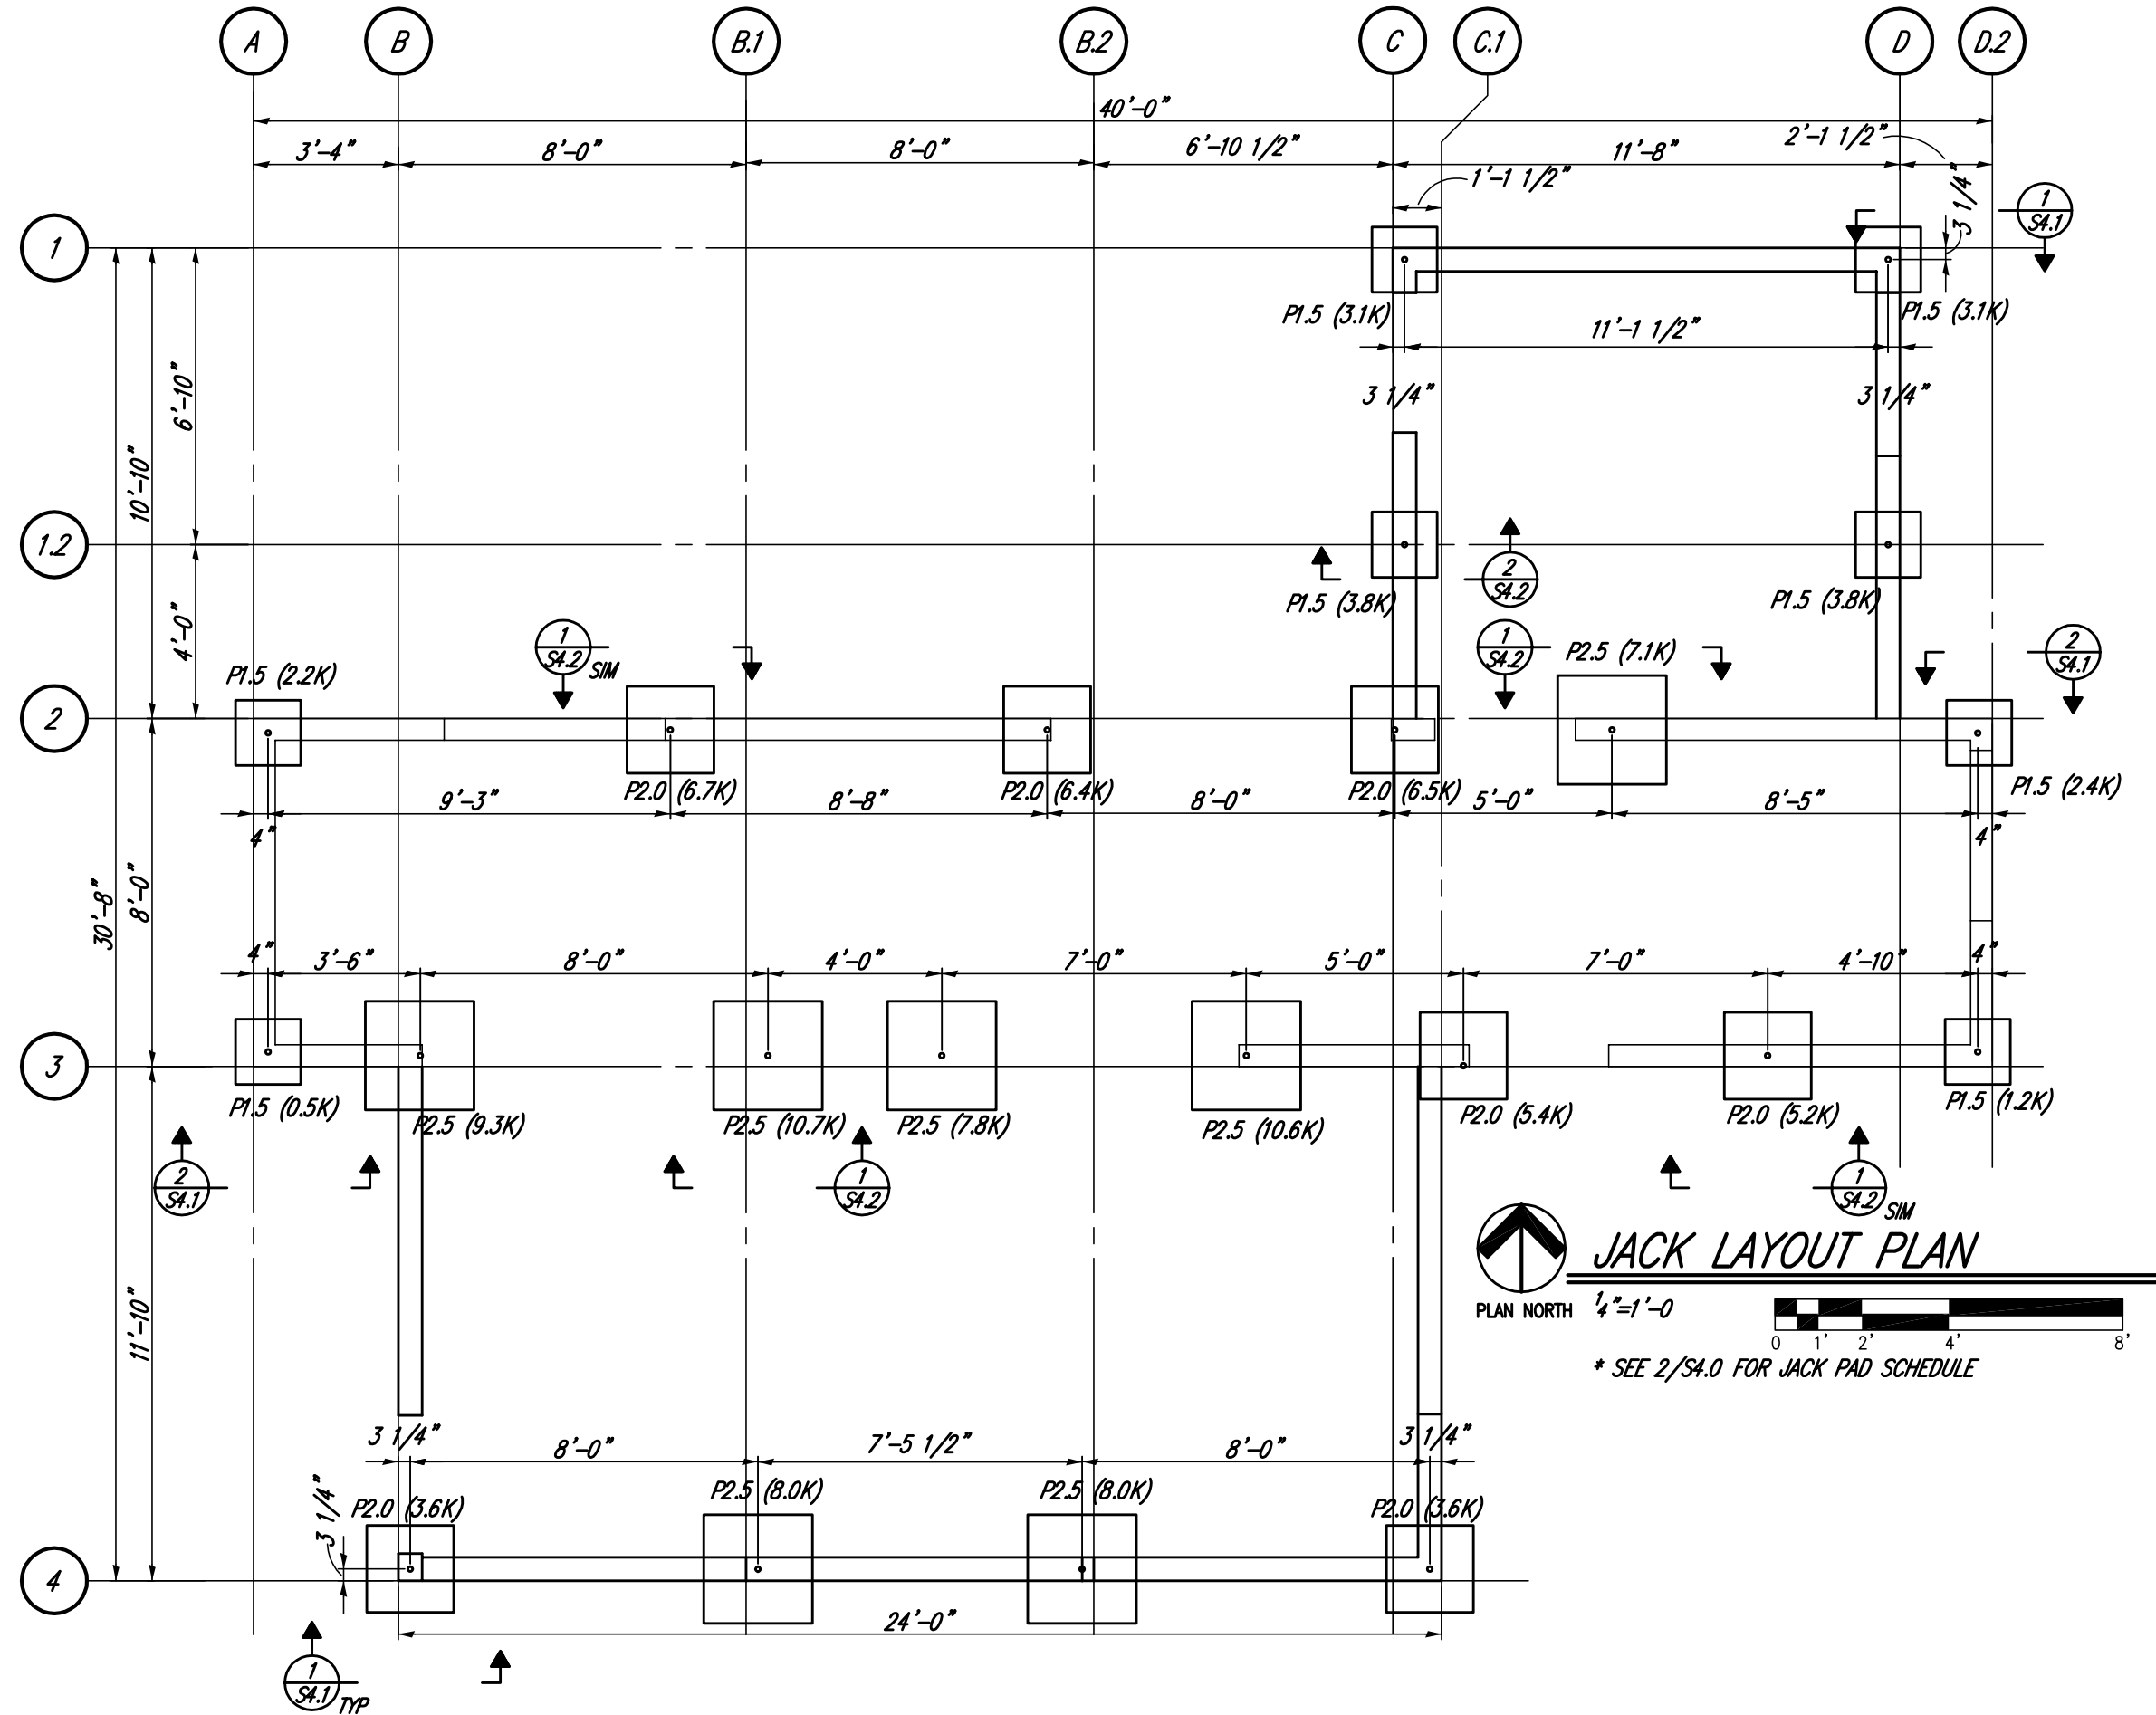

2007 Solar Decathlon
University of Colorado at Boulder
Civil, Environmental, and Architectural Engineering 428 UCB, Room ECCE 441 Boulder, CO 80309-0428
Foundation Jack Layout Plan
*Scale as Noted
0 1' 2' 4' 8'




Date	August 7, 2007
Drawn by	K. Rogne
Revised	
Date	January 9, 2007


2007 Solar Decathlon
University of Colorado at Boulder
Civil, Environmental, and Architectural Engineering
428 UCB, Room ECCE 441
Boulder, CO 80309-0428



S-2.1

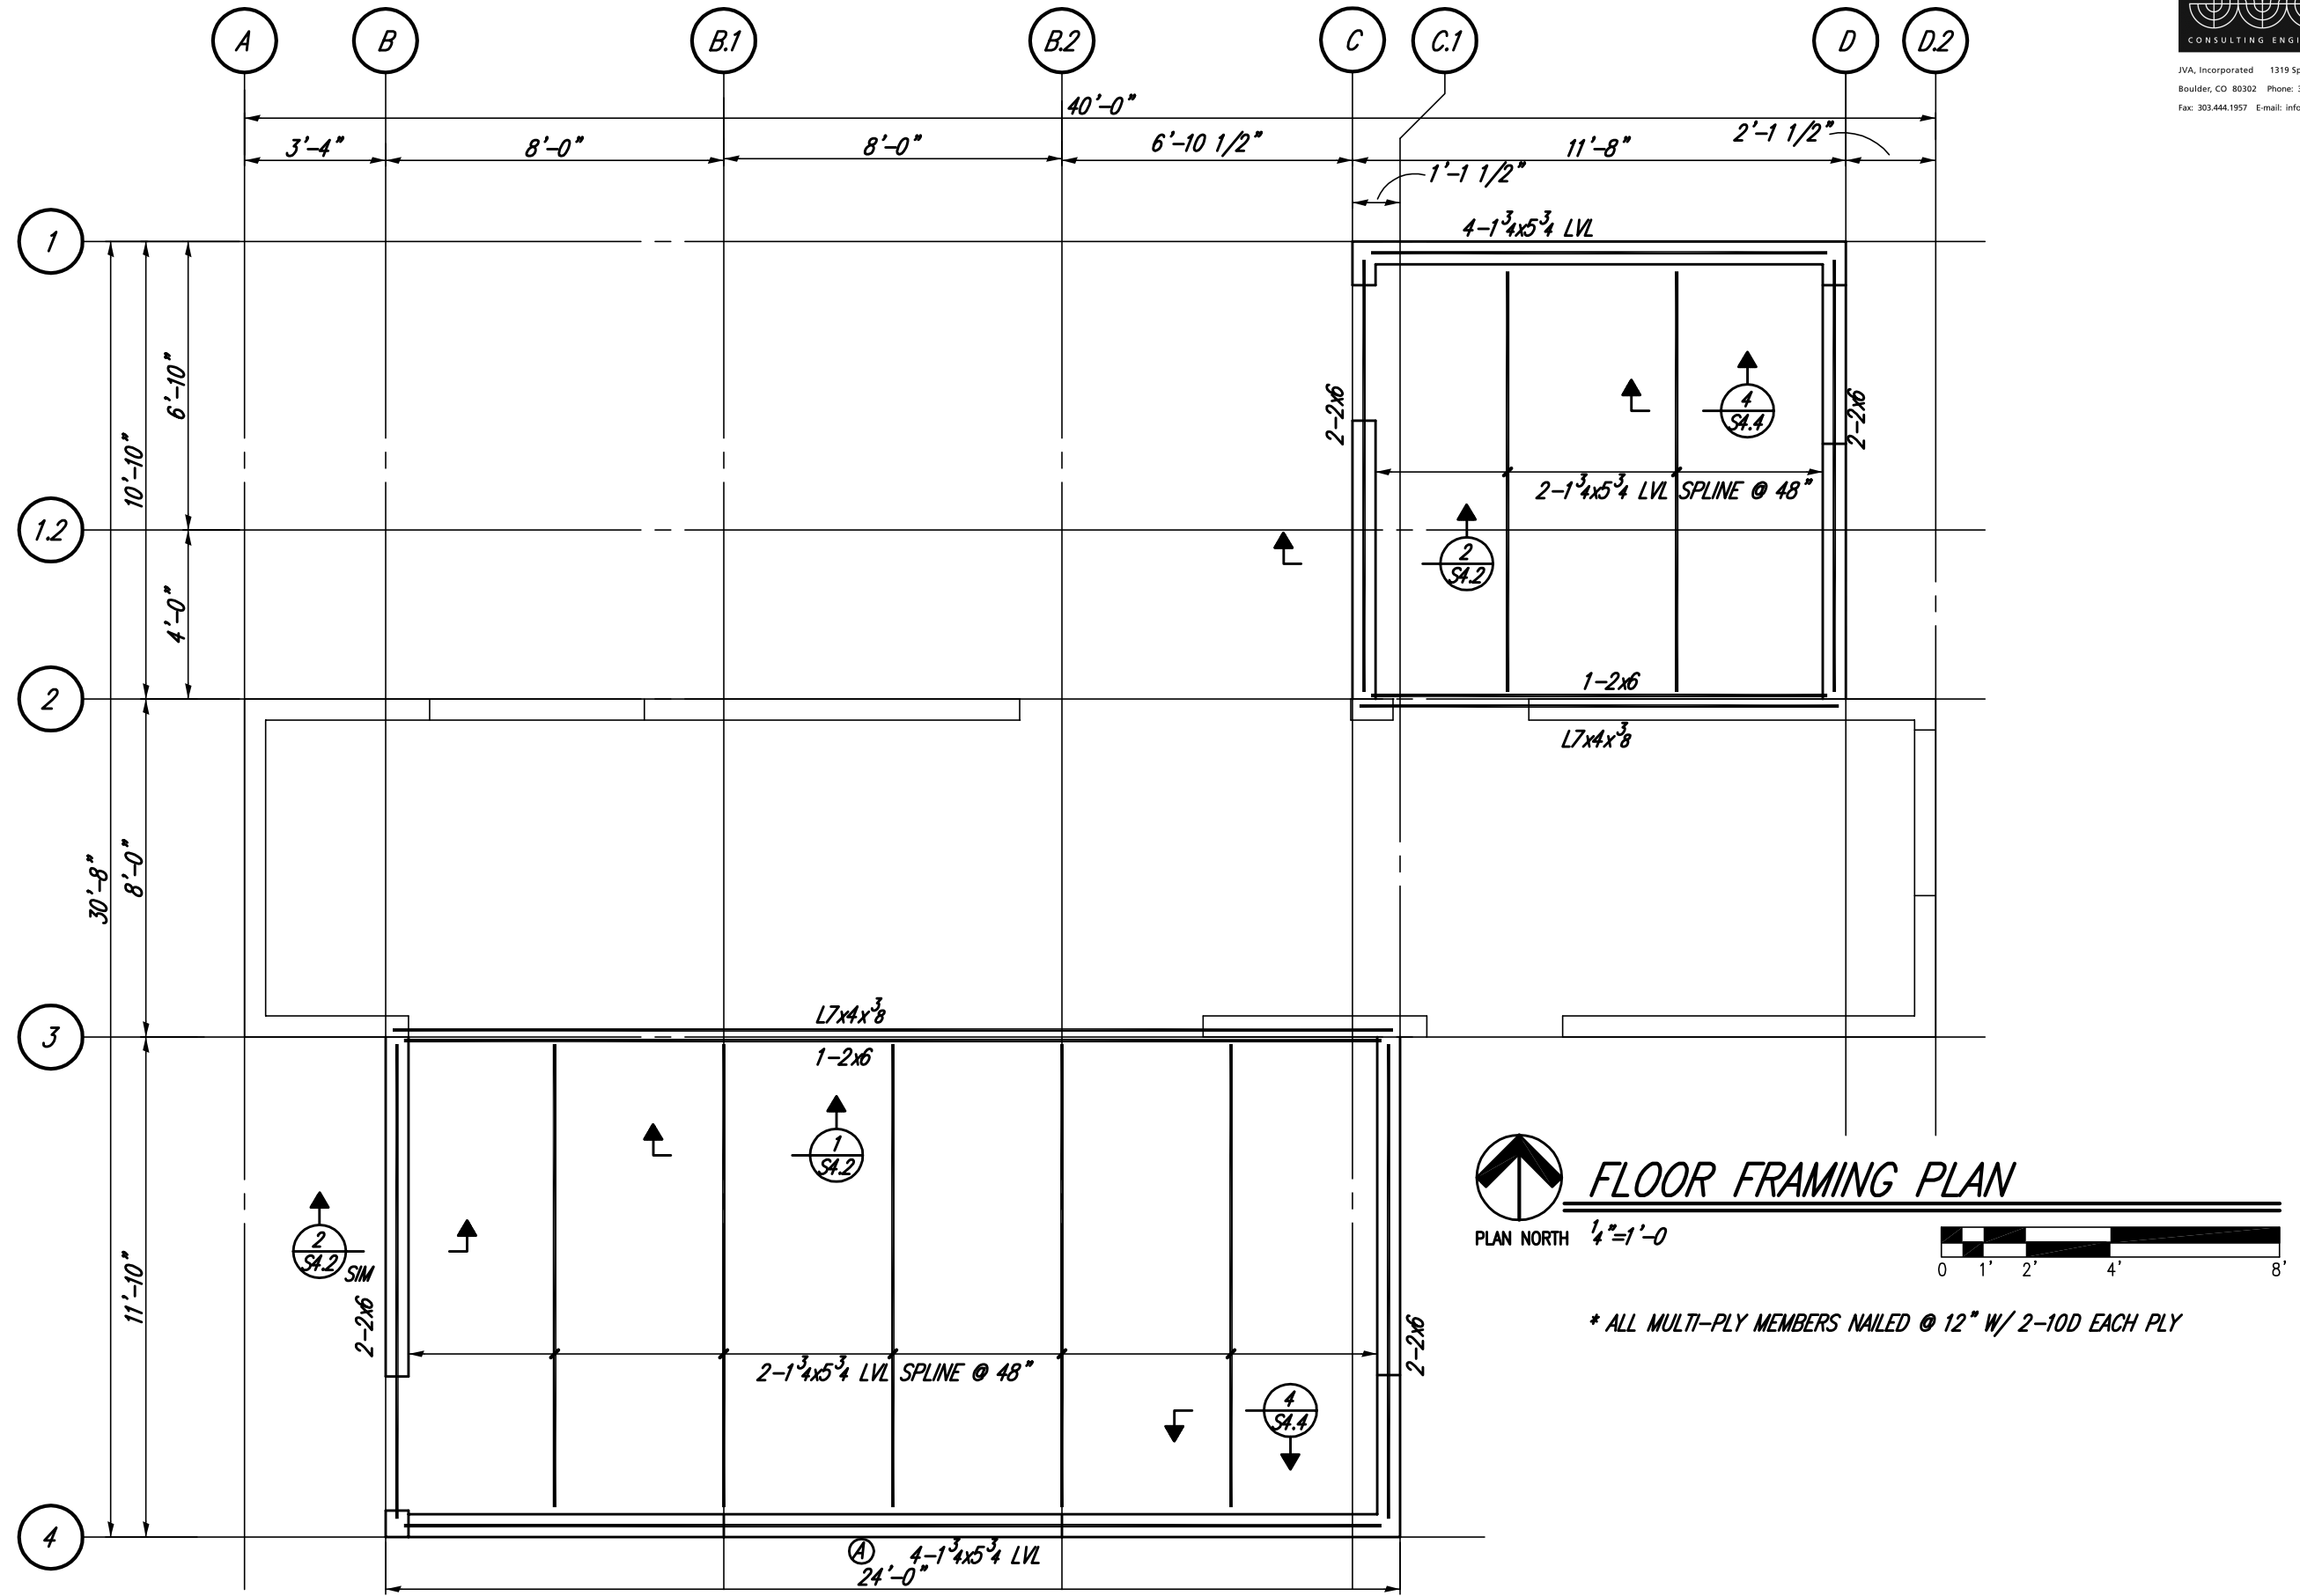




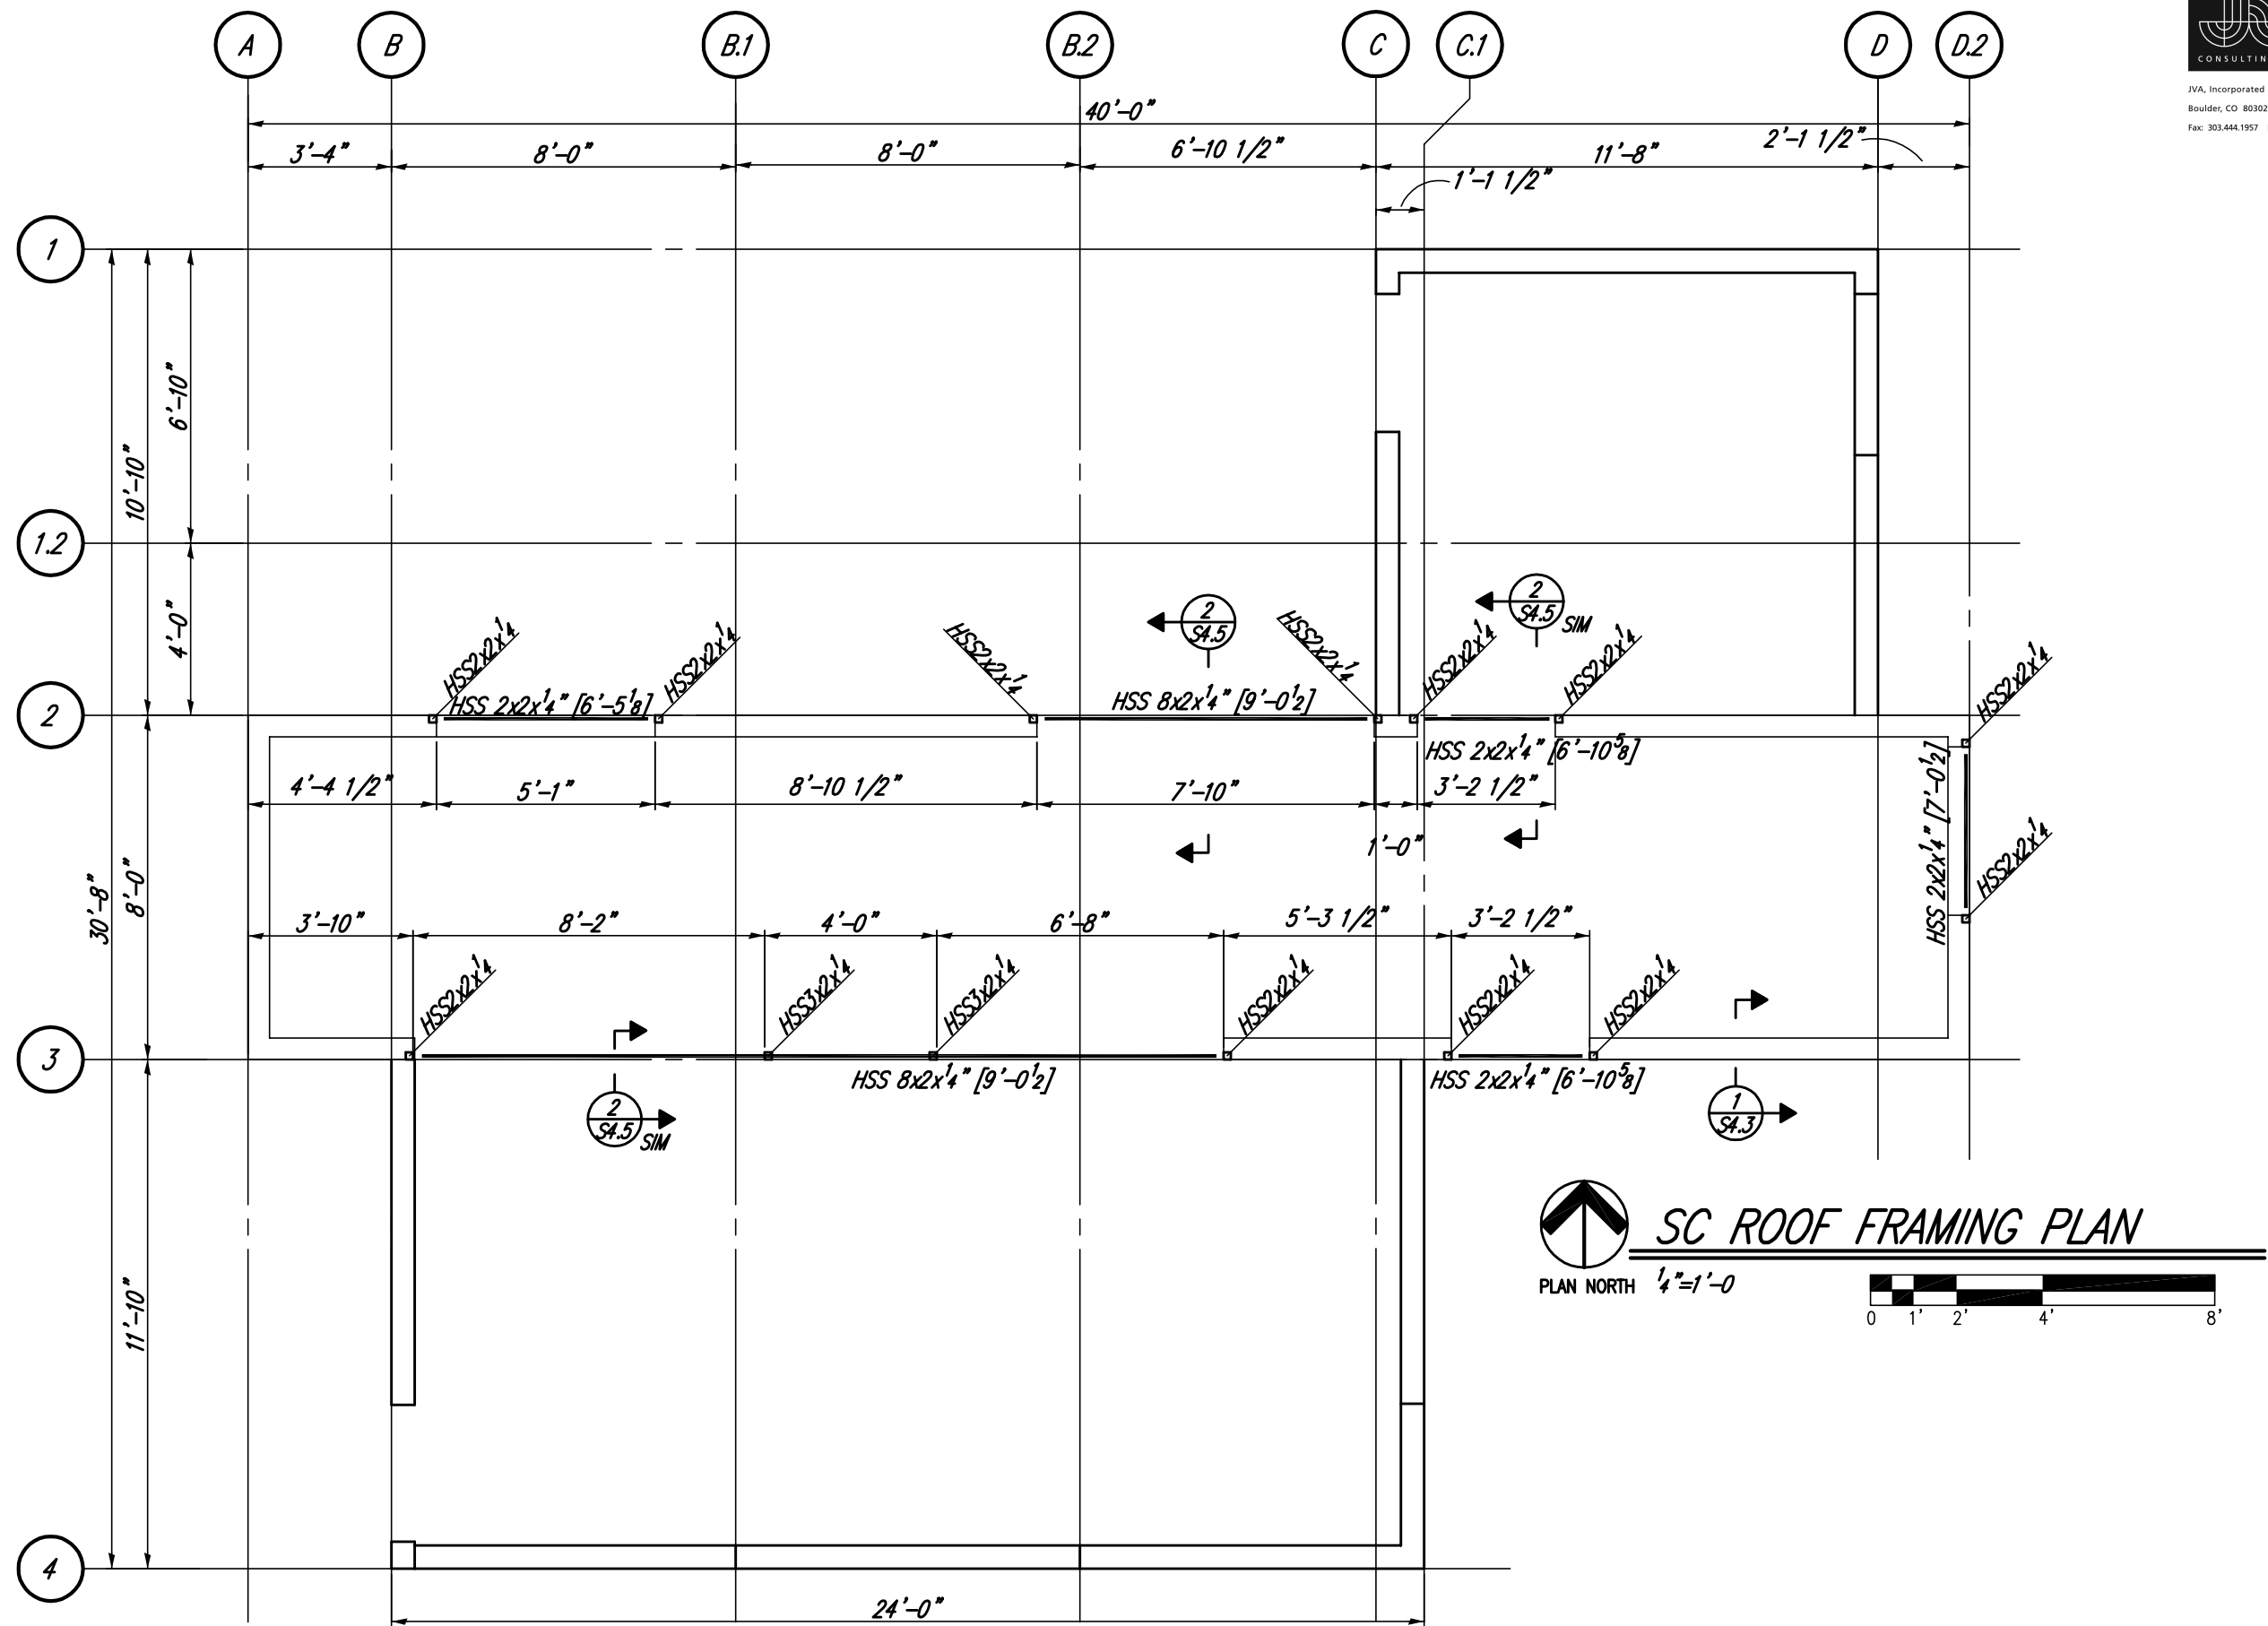

Date	August 7, 2007
Drawn by	K. Rogne
Revised	
Date	January 9, 2007

Shipping Container Framing Plan	2007 Solar Decathlon
University of Colorado at Boulder	
Civil, Environmental, and Architectural Engineering	
428 UCB, Room ECCE 441	
Boulder, CO 80309-0428	



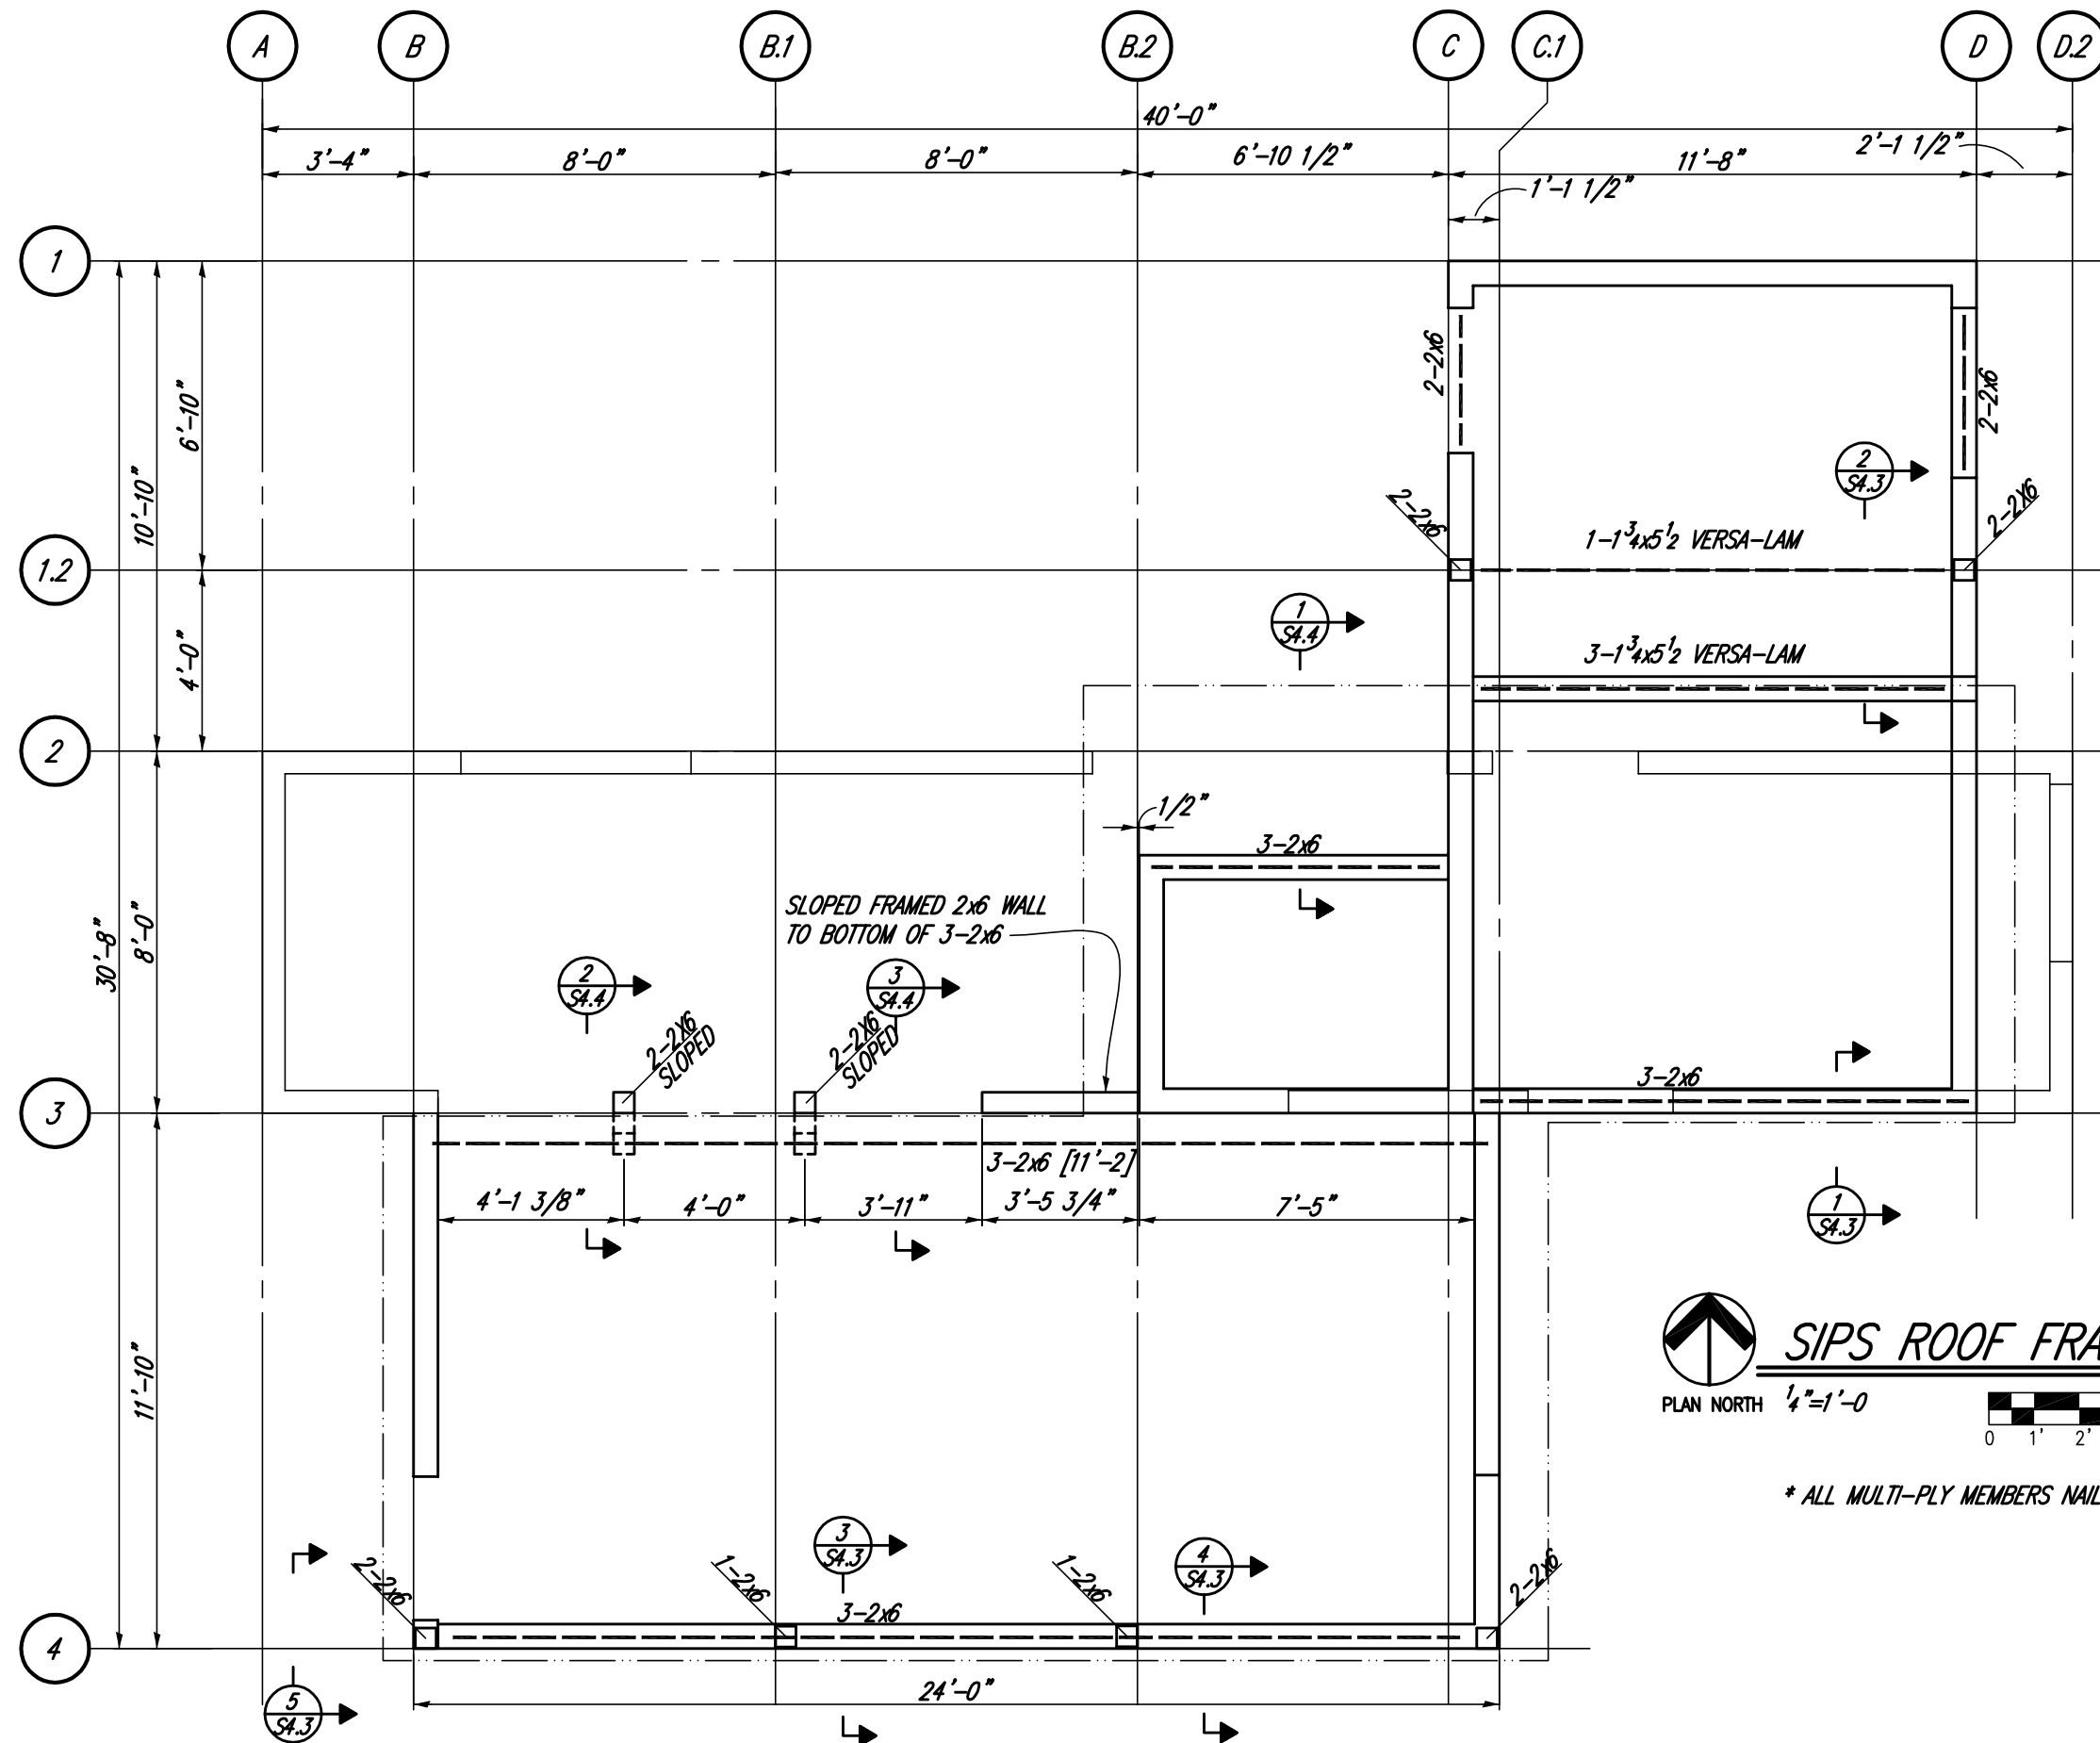

**SIPS ROOF FRAMING PLAN**

PLAN NORTH  $\frac{1}{4}" = 1'-0"$

\* ALL MULTI-PLY MEMBERS NAILED @ 12" W/ 2-10D EACH PLY

**JVA CONSULTING ENGINEERS**  
 JVA, Incorporated 1319 Spruce Street  
 Boulder, CO 80302 Phone: 303.444.1951  
 Fax: 303.444.1957 E-mail: info@jvajva.com

Drawn by	Date
	August 7, 2007
Revised	Date
	January 9, 2007

SIPS Roof Frame Plan

2007 Solar Decathlon

University of Colorado at Boulder

Civil, Environmental, and Architectural Engineering

428 UCB, Room ECCE 441

Boulder, CO 80309-0428

\*Scale as Noted




S-2.3

Drawn by	Date
K. Rogne	August 7, 2007
Revised	Date
	January 9, 2007

Solar Panel Frame Plan	2007 Solar Decathlon
University of Colorado at Boulder	
Civil, Environmental, and Architectural Engineering	
428 UCB, Room ECCE 441	
Boulder, CO 80309-0428	



S-2.4

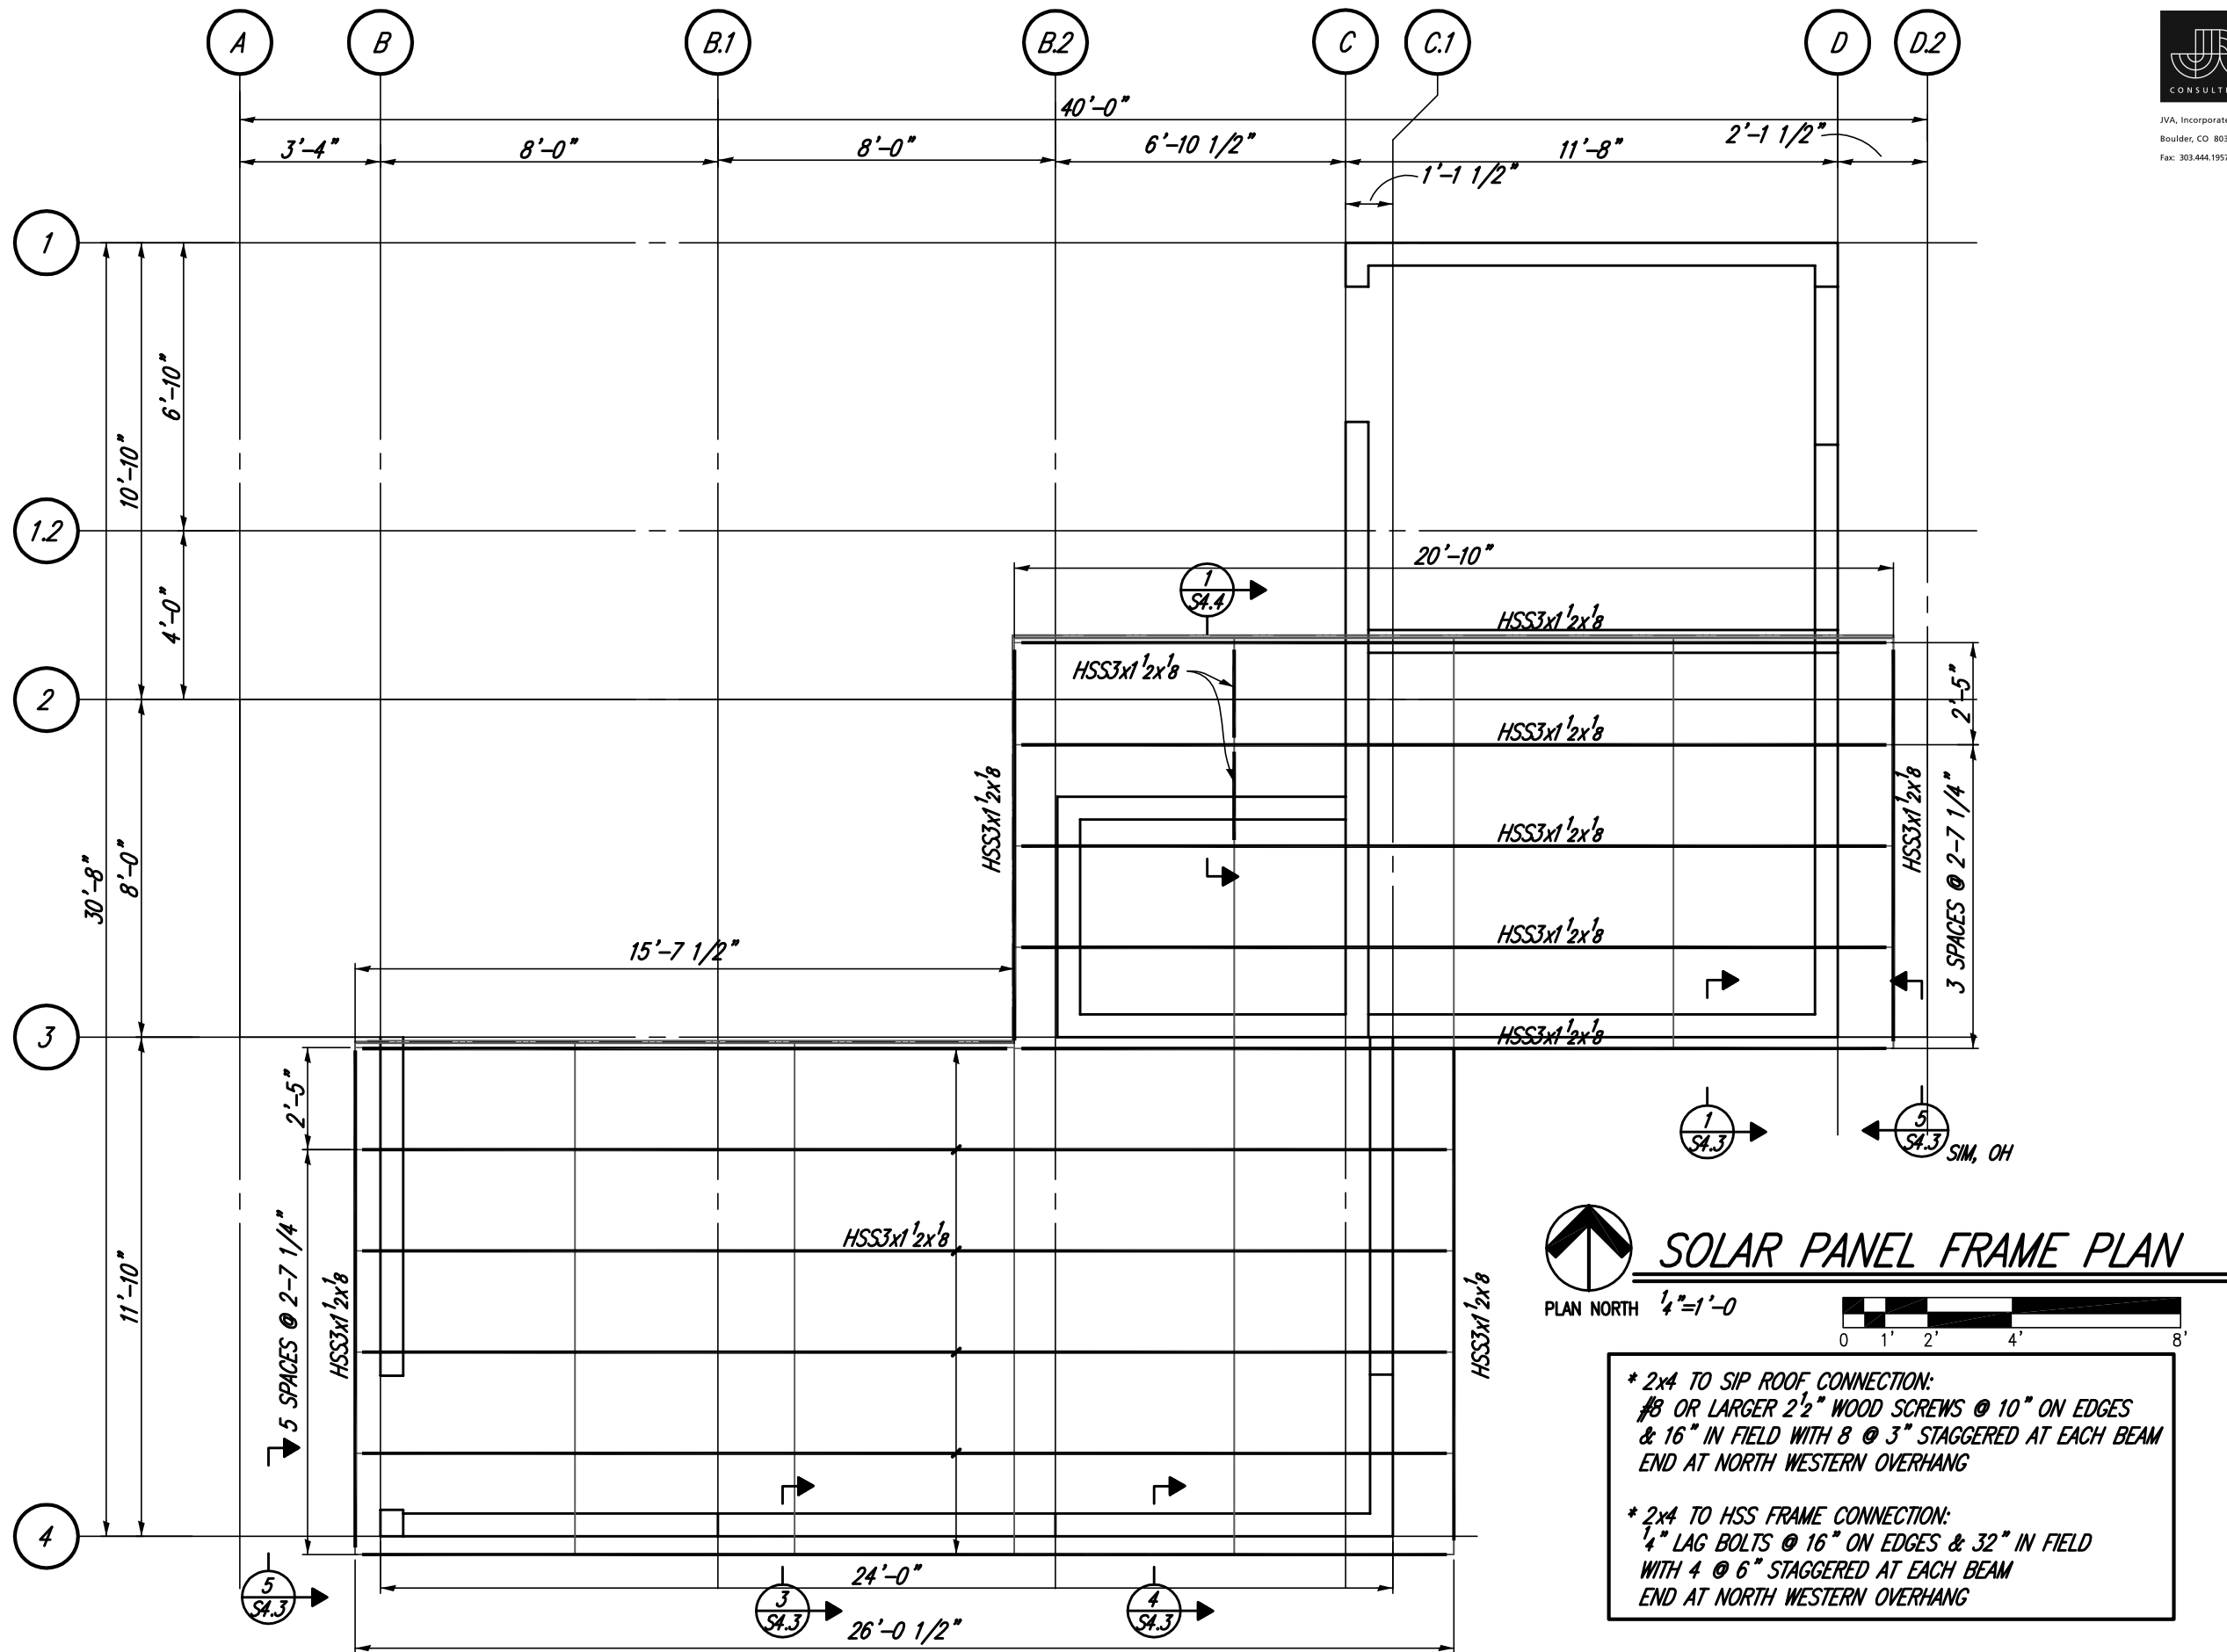




JVA, Incorporated 1319 Spruce Street  
Boulder, CO 80302 Phone: 303.444.1951  
Fax: 303.444.1957 E-mail: info@jvajva.com

Date	August 7, 2007
Drawn by	K. Rogne
Date	January 9, 2007
Revised	

Garage Floor and Roof Plan	2007 Solar Decathlon
University of Colorado at Boulder	
Civil, Environmental, and Architectural Engineering	
428 UCB, Room ECCE 441	
Boulder, CO 80309-0428	
*Scale as Noted	8'
0	4'
1'	2'




S-2.5

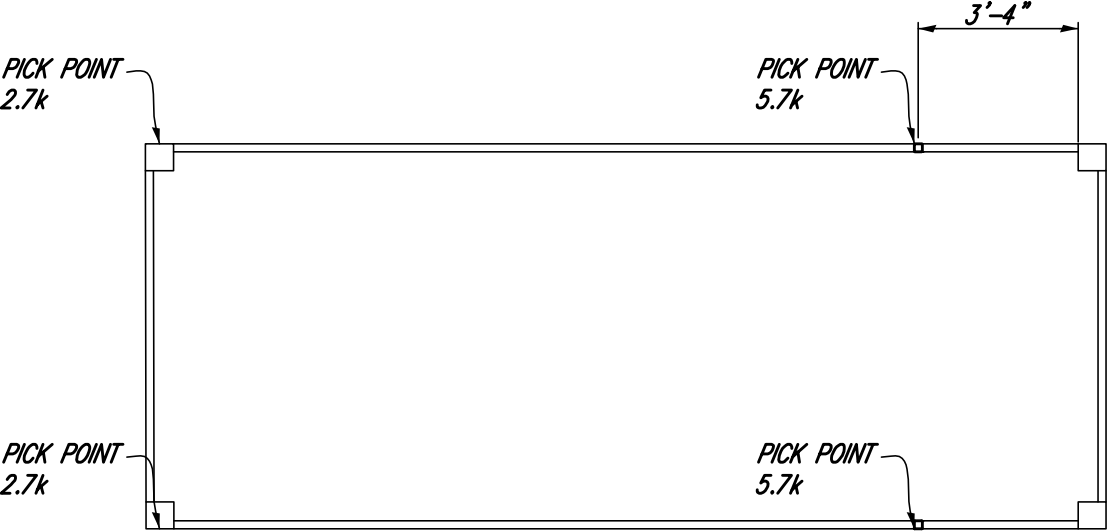


Garage Roof Plan

PLAN NORTH 1/4"=1'-0

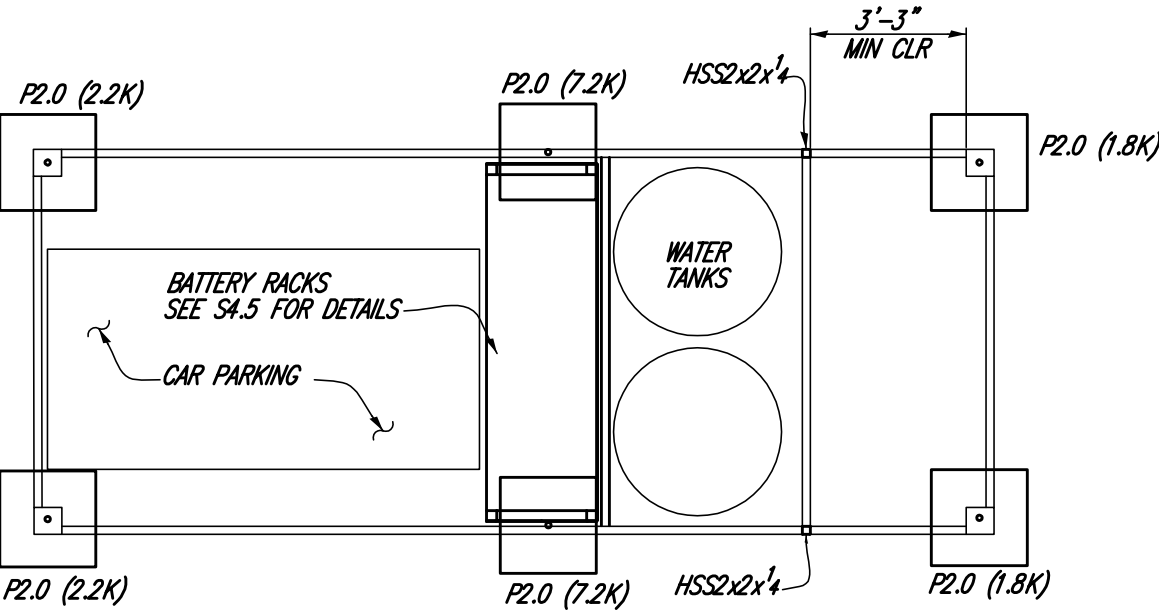


Garage Floor Plan

PLAN NORTH 1/4"=1'-0

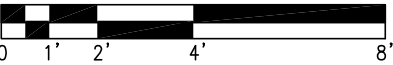


Drawn by	Date
K. Rogne	August 7, 2007
Revised	Date
	January 9, 2007

Shipping Container Elevations	2007 Solar Decathlon
University of Colorado at Boulder	
Civil, Environmental, and Architectural Engineering	
428 UCB, Room ECCE 441	
Boulder, CO 80309-0428	
*Scale as Noted	8'
0 1' 2' 4'	

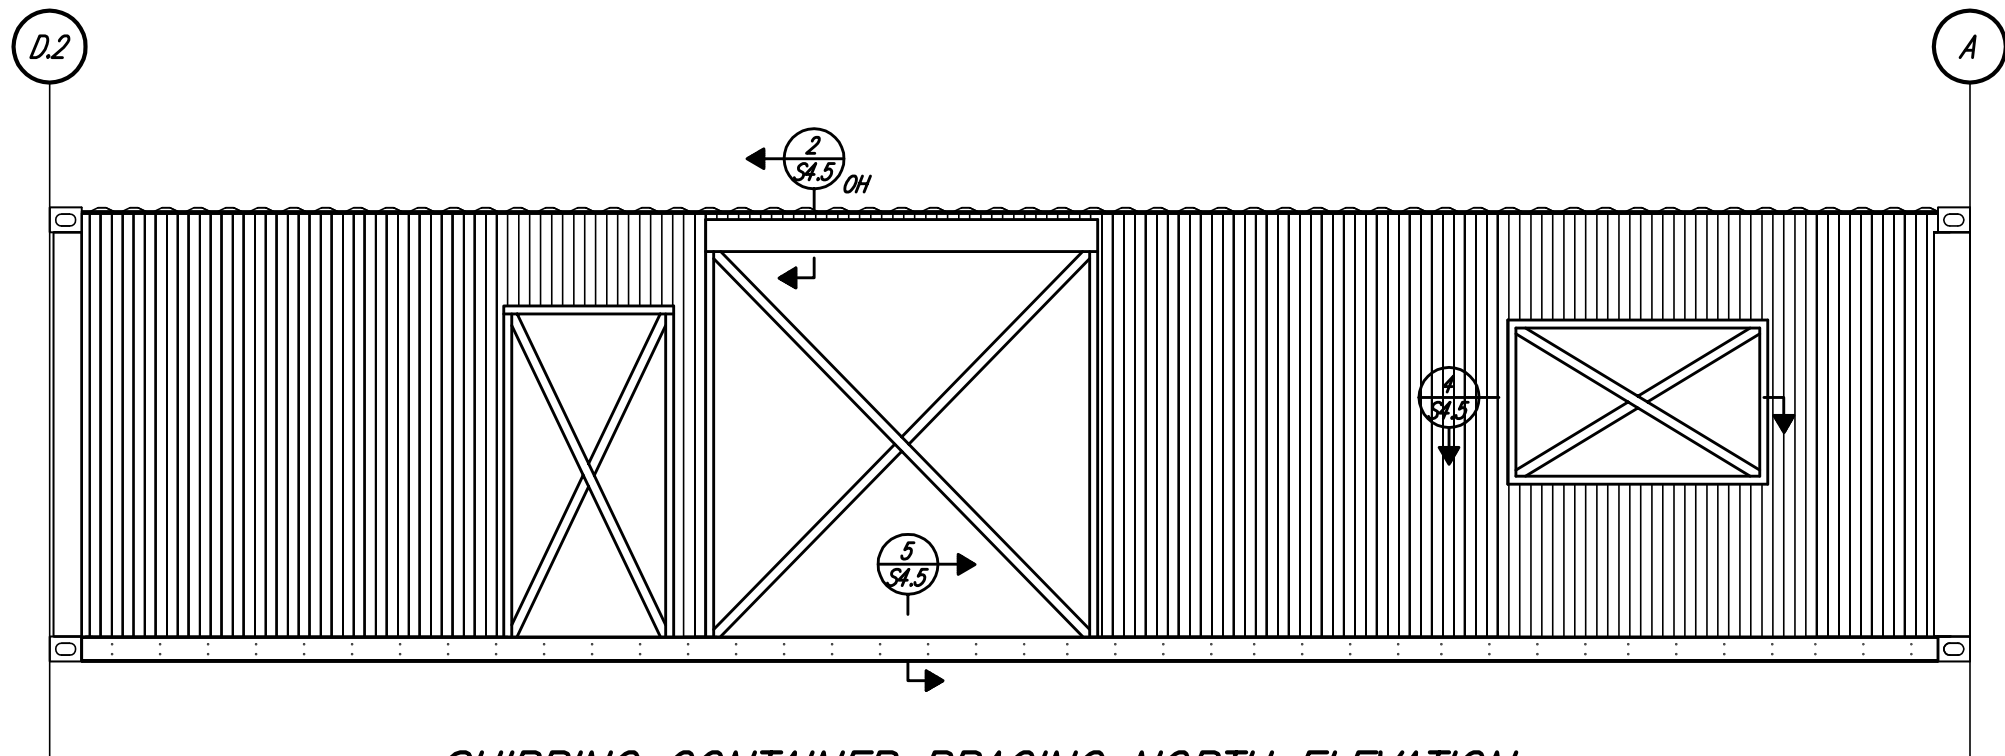


SHIPPING CONTAINER BRACING NORTH ELEVATION

$\frac{1}{4}''=1'-0$

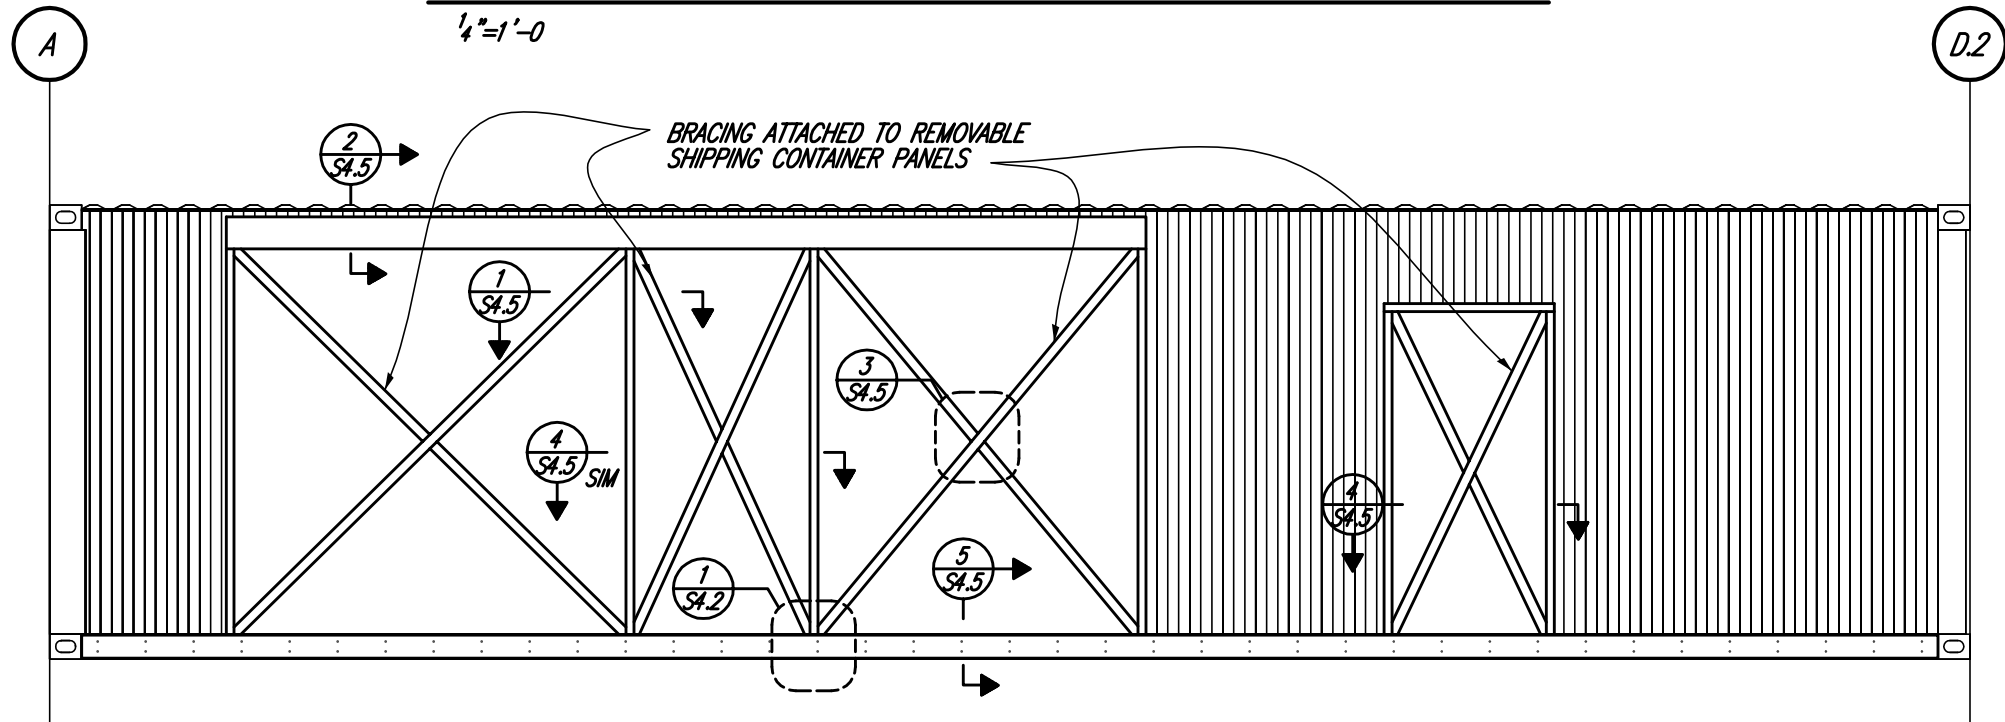

SHIPPING CONTAINER BRACING SOUTH ELEVATION

$\frac{1}{4}''=1'-0$

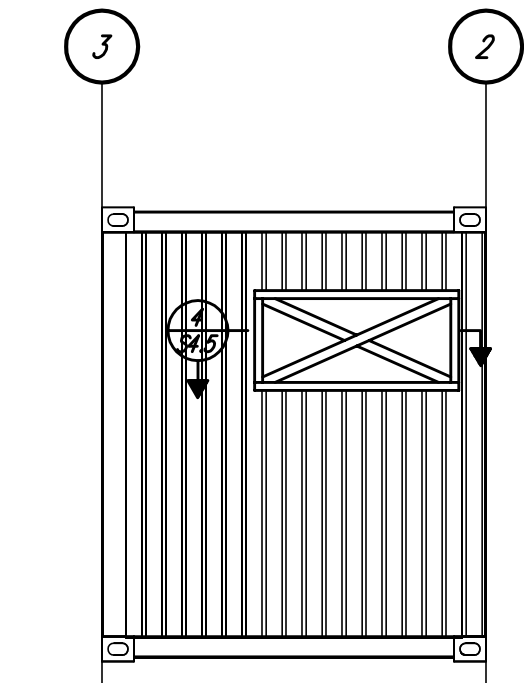

SHIPPING CONTAINER BRACING EAST ELEVATION

$\frac{1}{4}''=1'-0$



Drawn by	Date
K. Rogne	August 7, 2007
Revised	Date
	January 9, 2007

Schedules	2007 Solar Decathlon
*Scale as Noted	University of Colorado at Boulder Civil, Environmental, and Architectural Engineering 428 UCB, Room ECCE 441 Boulder, CO 80309-0428




S-4.0


NOT USED

SCHEDULE 1<sub>S4.0</sub> N.S.


SCHEDULE 2<sub>S4.0</sub> N.S.

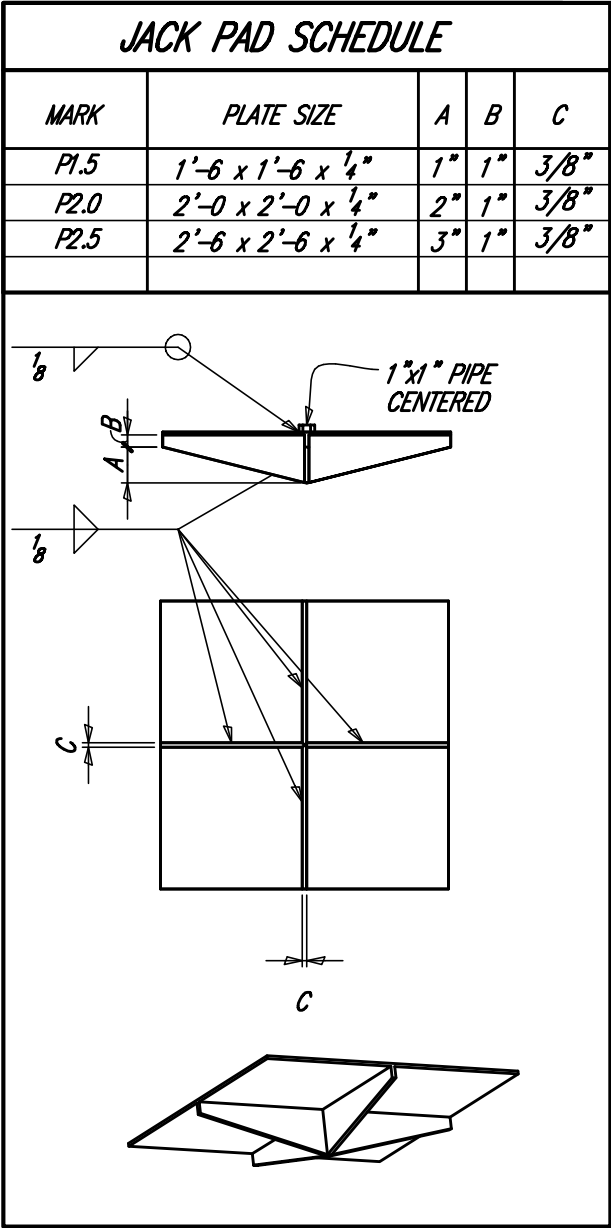


Date	August 7, 2007
Drawn by	K. Rogne
Revised	
Date	January 9, 2007

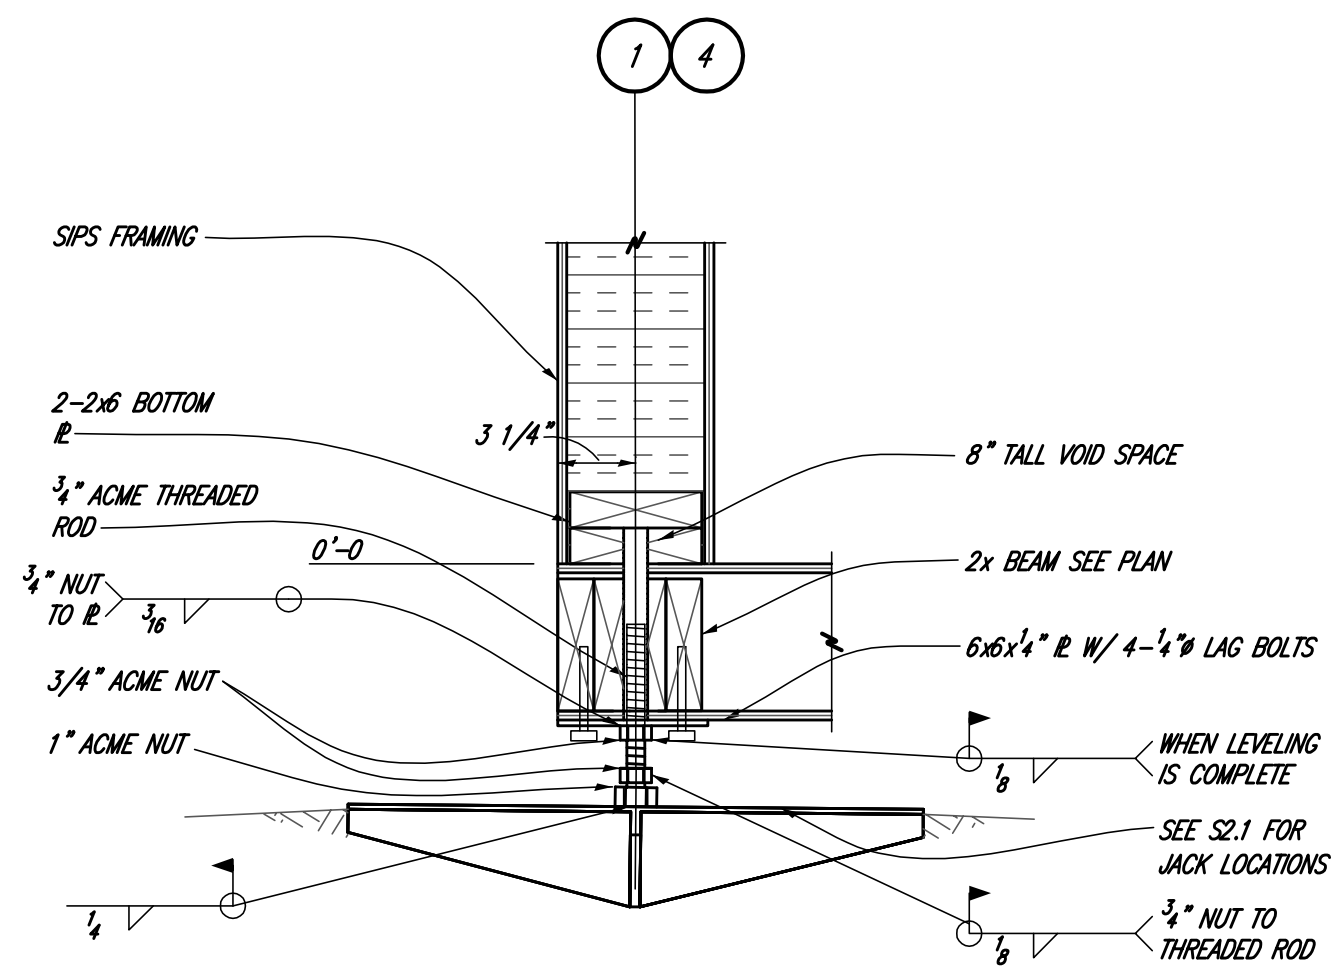

DETAIL  $\frac{1}{S4.1}$   $1\frac{1}{2}''=1'-0$

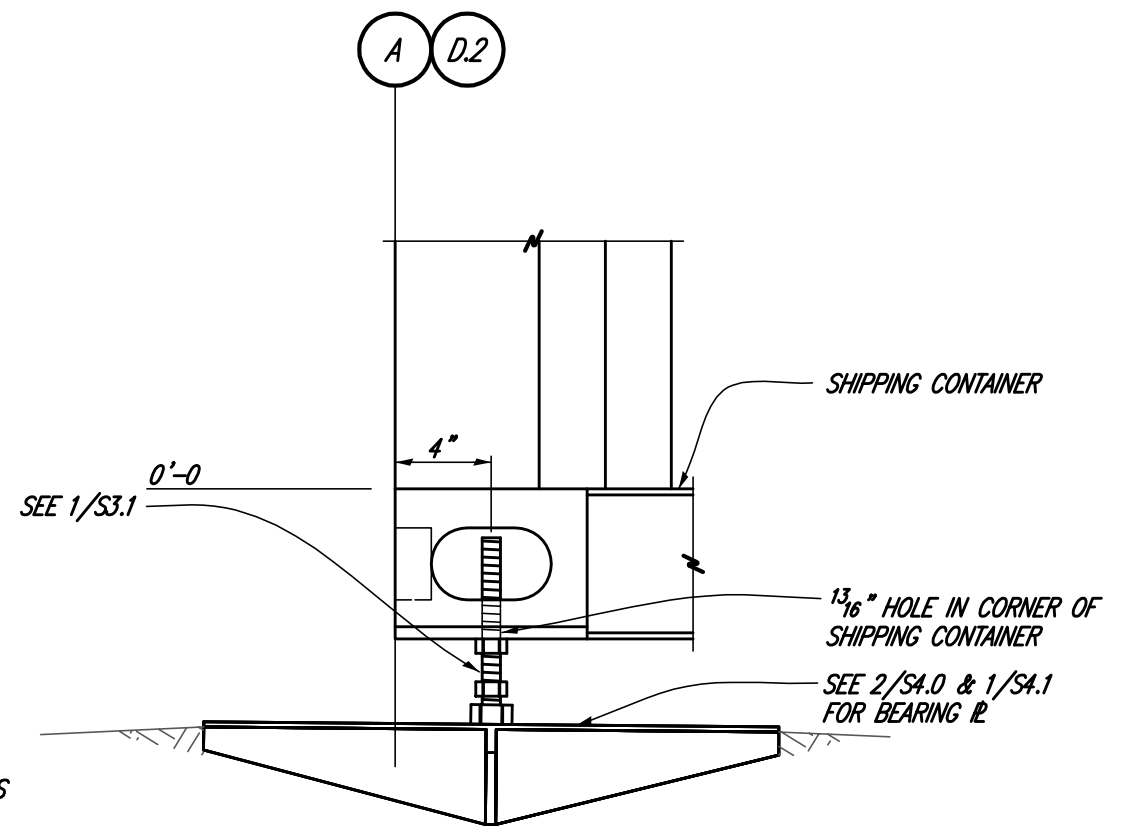

DETAIL  $\frac{2}{S4.1}$   $1\frac{1}{2}''=1'-0$

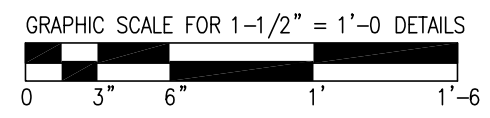

2007 Solar Decathlon

University of Colorado at Boulder

Civil, Environmental, and Architectural Engineering  
428 UCB, Room ECCE 441  
Boulder, CO 80309-0428

Jack Pad Details




\*Scale as Noted

0 3" 6" 1' 2'










Date	August 7, 2007
Drawn by	K. Rogne
Revised	
Date	January 9, 2007

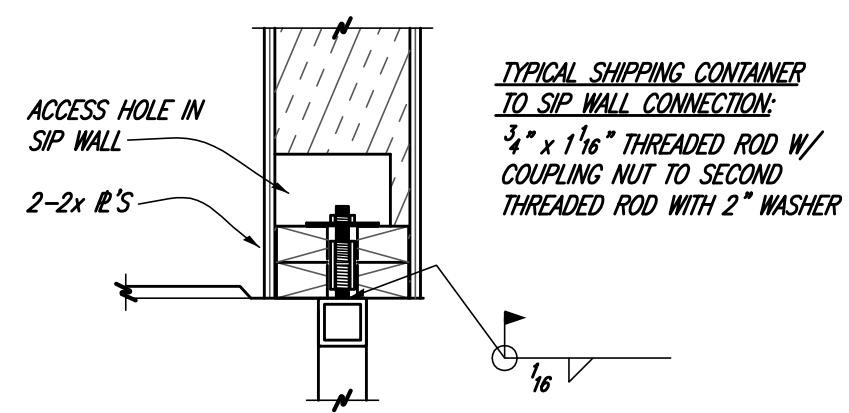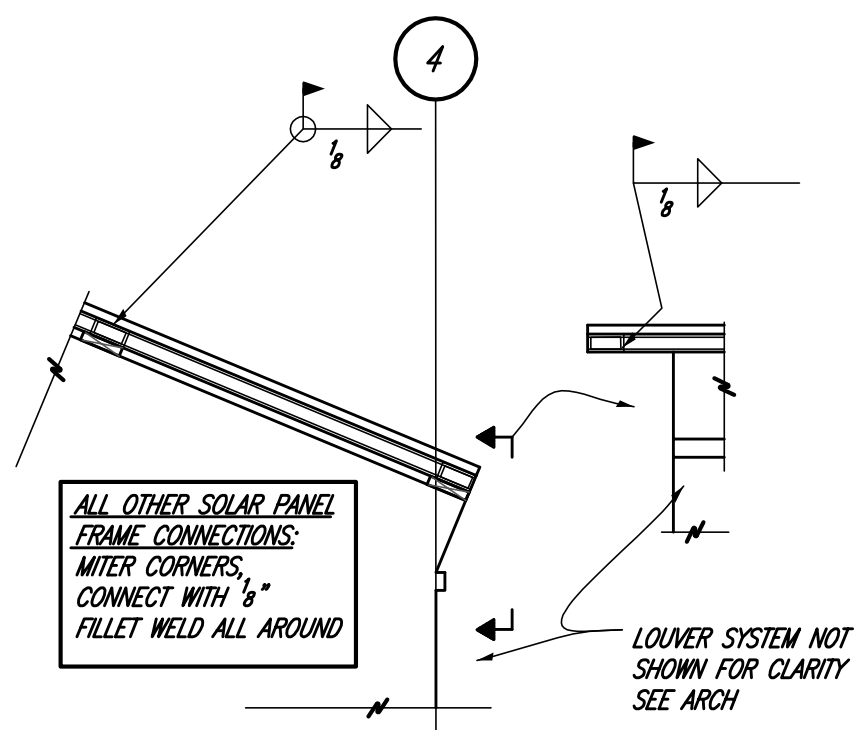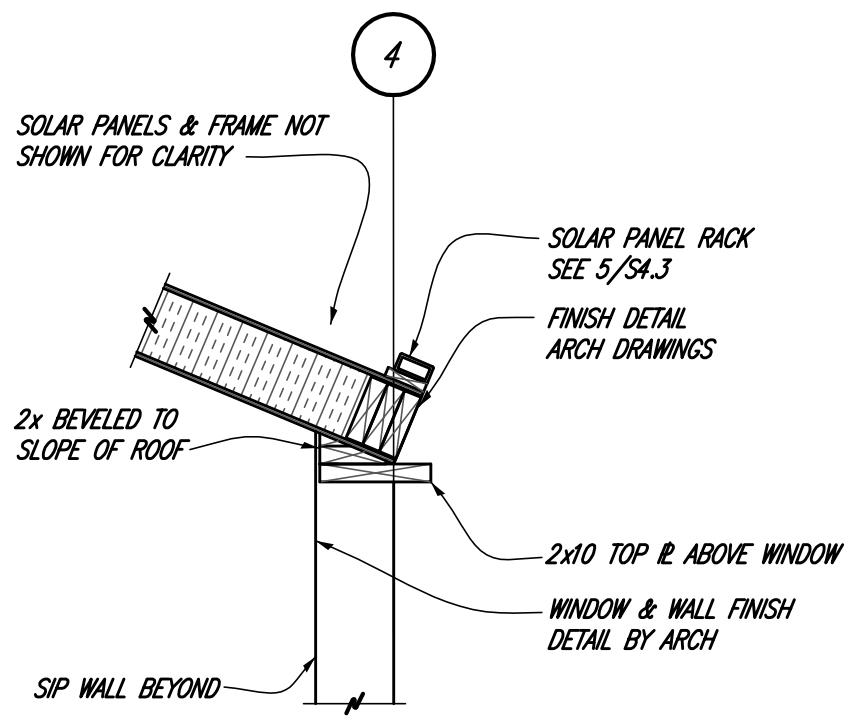

DETAIL  $\frac{4}{S4.3}$   $\frac{3}{4}" = 1' - 0"$

DETAIL  $\frac{5}{S4.3}$   $\frac{3}{4}" = 1' - 0"$

DETAIL  $\frac{6}{S4.3}$   $1\frac{1}{2}" = 1' - 0"$

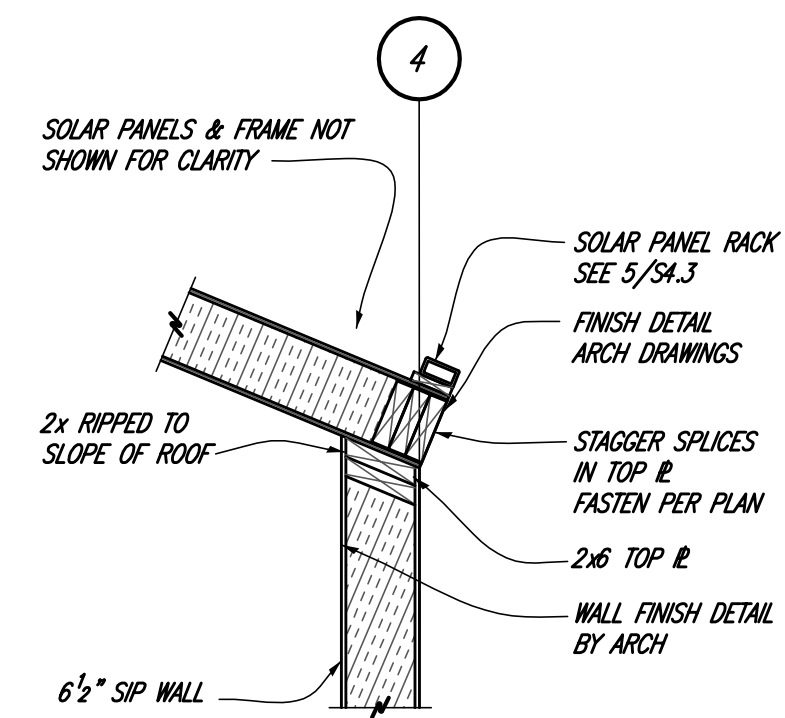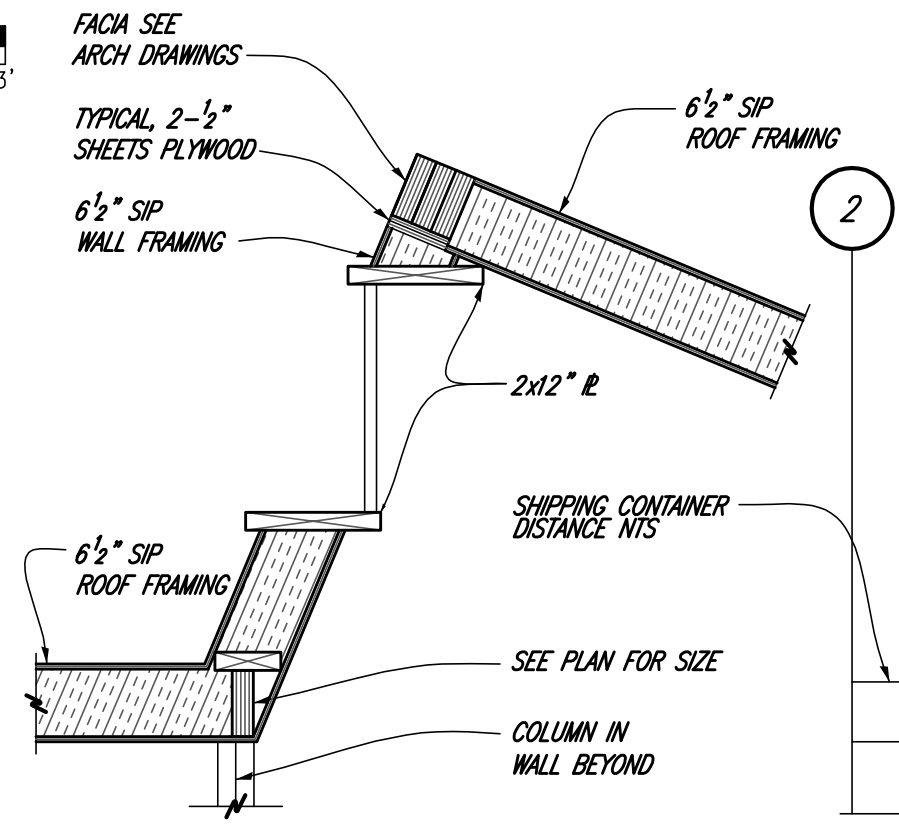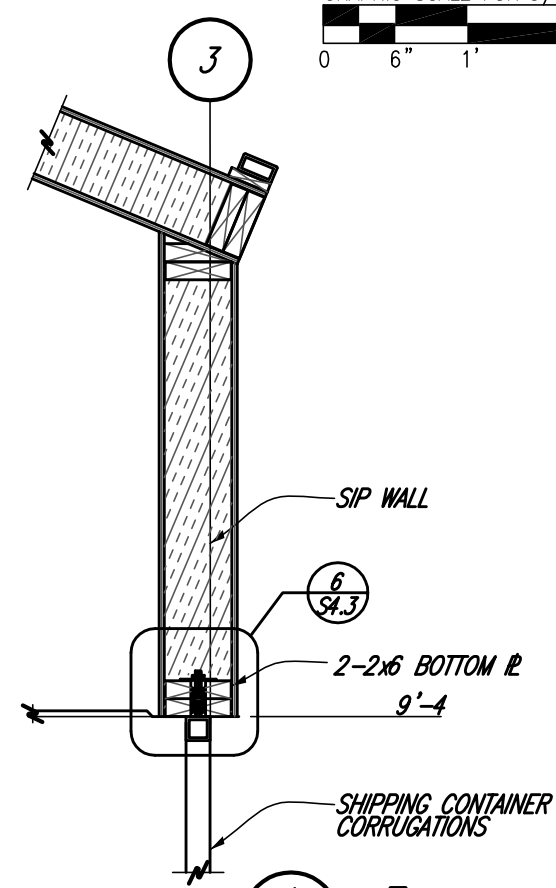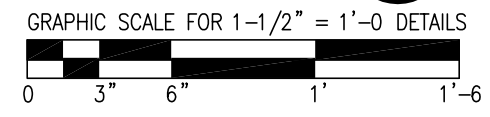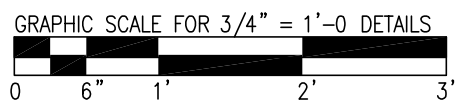

DETAIL  $\frac{1}{S4.3}$   $\frac{3}{4}" = 1' - 0"$

DETAIL  $\frac{2}{S4.3}$   $\frac{3}{4}" = 1' - 0"$

DETAIL  $\frac{3}{S4.3}$   $\frac{3}{4}" = 1' - 0"$



Date	August 7, 2007
Drawn by	K. Rognie
Revised	
Date	January 9, 2007

2007 Solar Decathlon	University of Colorado at Boulder
Civil, Environmental, and Architectural Engineering	428 UCB, Room ECCE 441
Boulder, CO 80309-0428	


Details

\*Scale as Noted

0 6" 1" 2' 4'




S-4.4

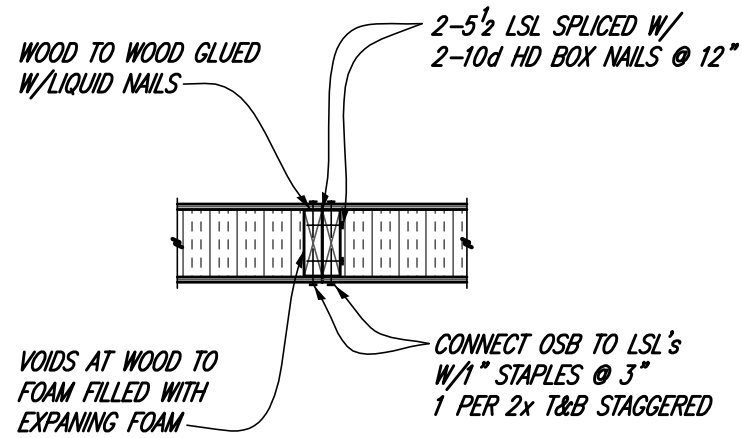


TYPICAL FLOOR SPLINE

DETAIL 4 S4.4 3/4" = 1' - 0

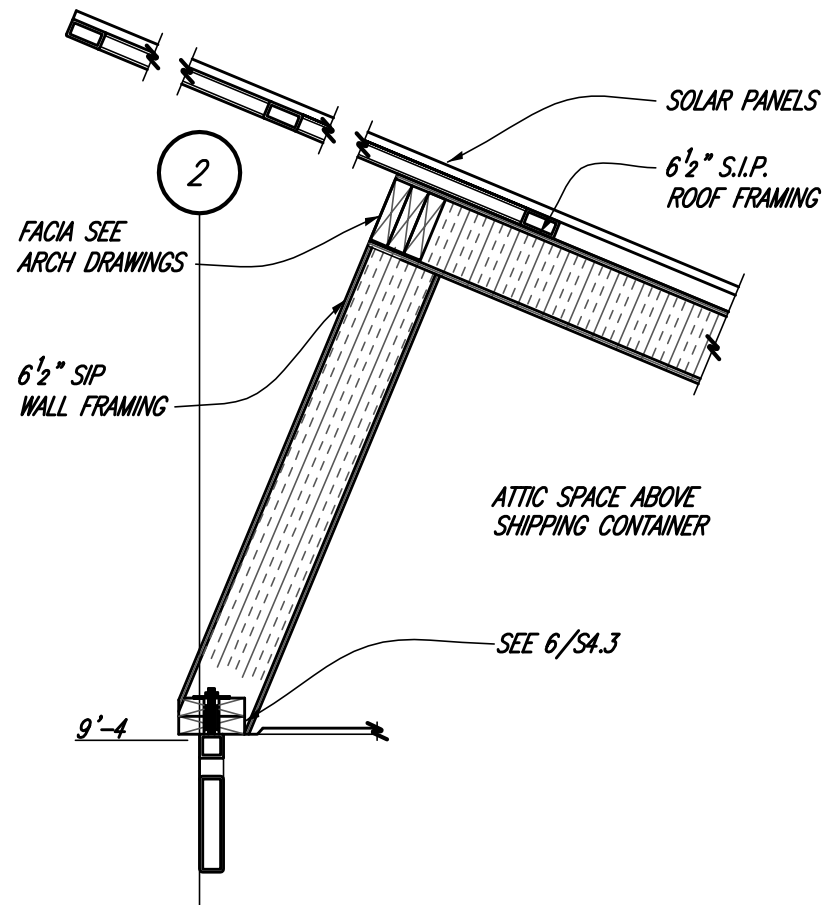


DETAIL 1 S4.4 3/4" = 1' - 0

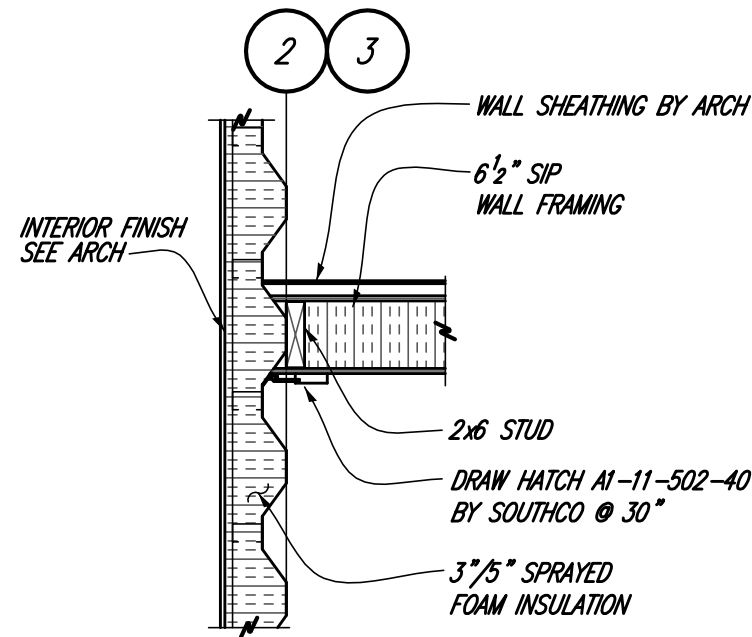


SHIPPING CONTAINER TO SIP CONNECTION

DETAIL 5 S4.4 3/4" = 1' - 0

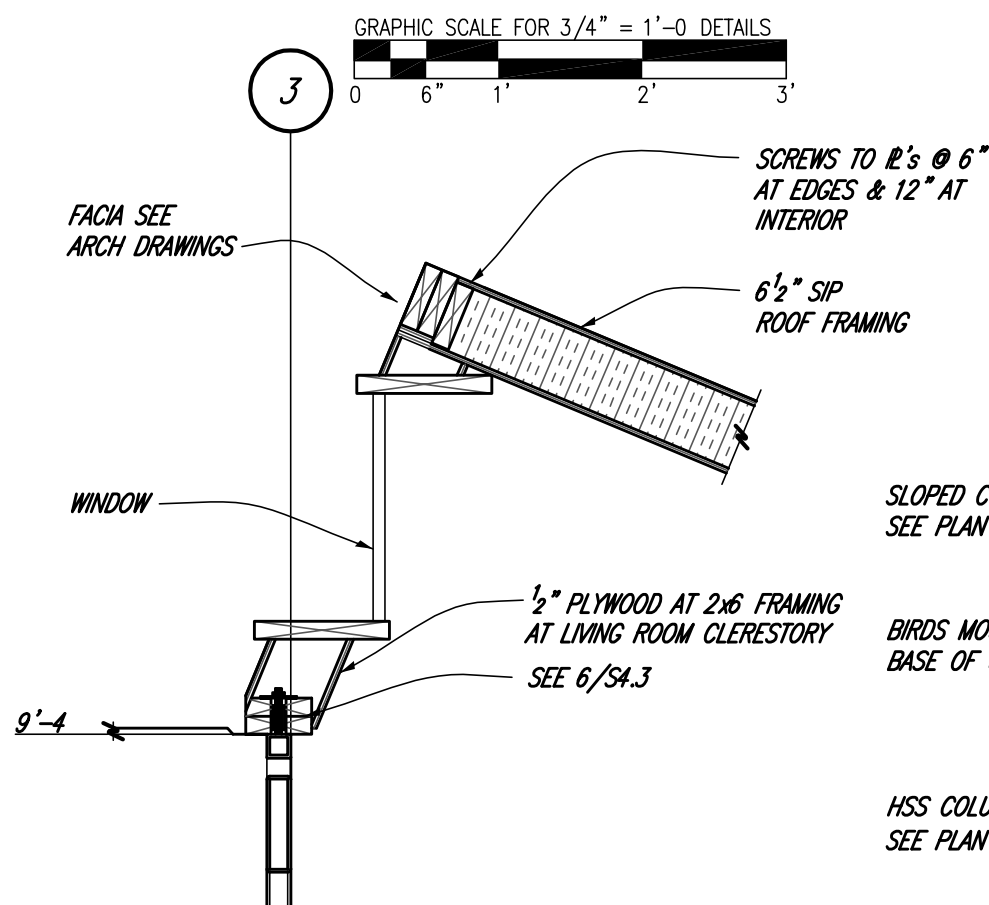


DETAIL 2 S4.4 3/4" = 1' - 0

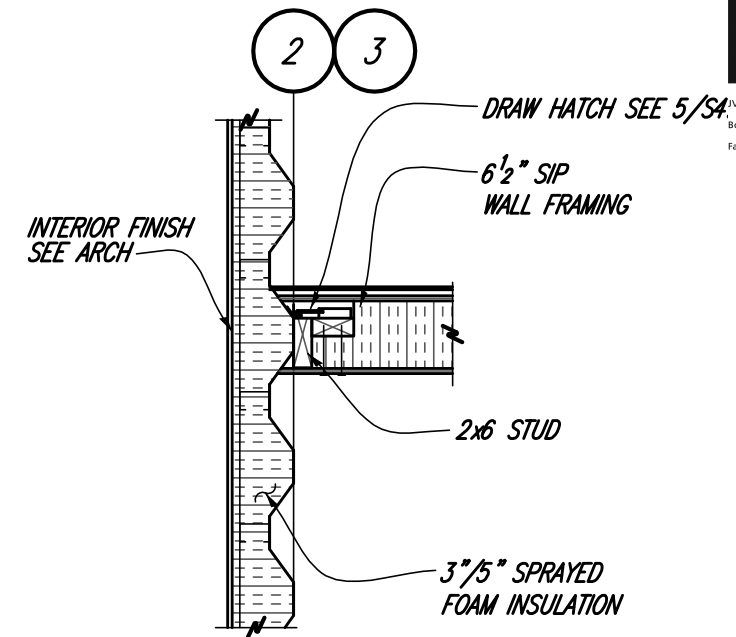

INSET SHIPPING CONTAINER TO SIP CONNECTION







DETAIL 6 S4.4 3/4" = 1' - 0

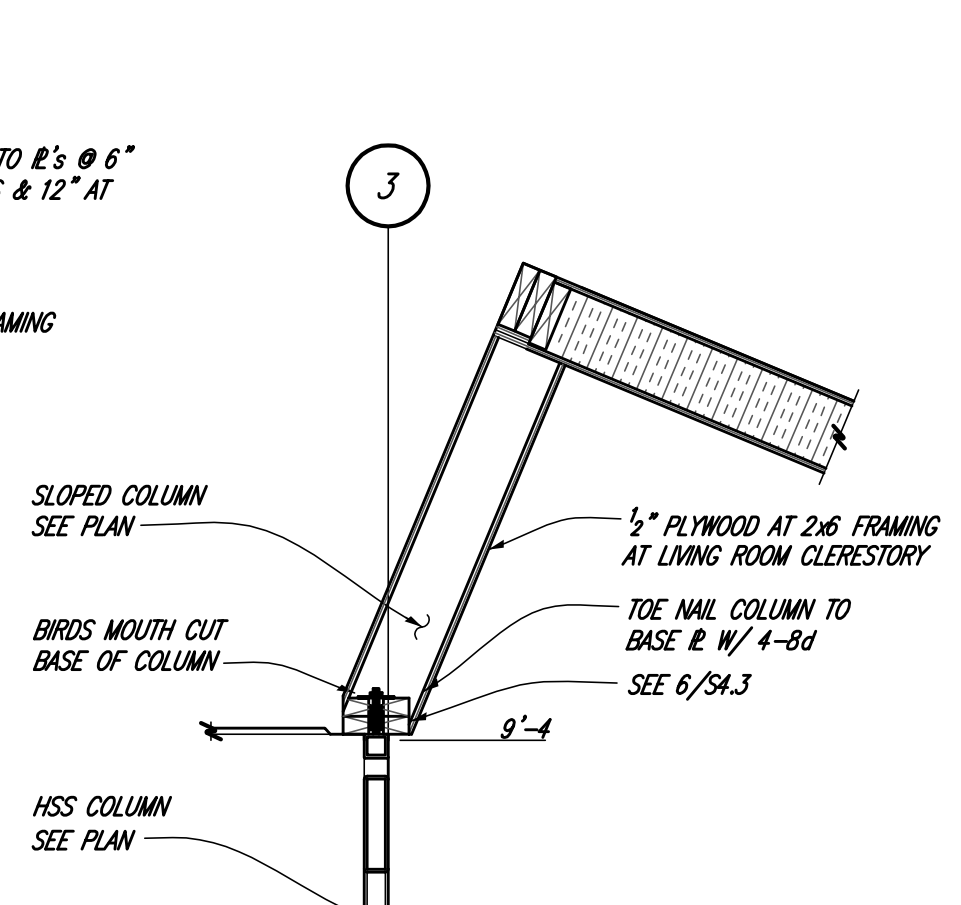

DETAIL 3 S4.4 3/4" = 1' - 0



Date	August 7, 2007
Drawn by	K. Rogne
Revised	
Date	January 9, 2007

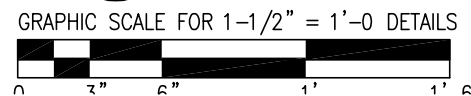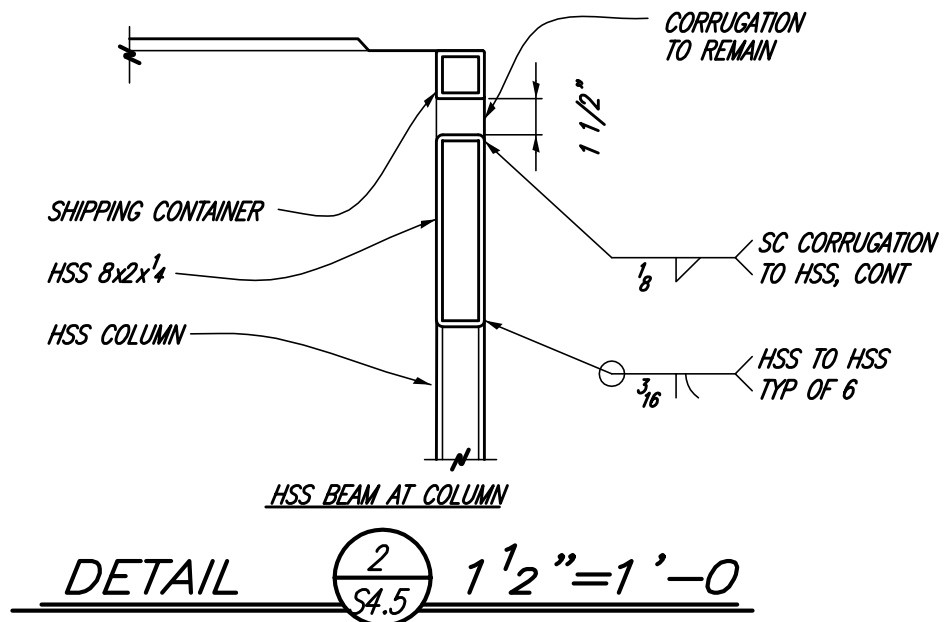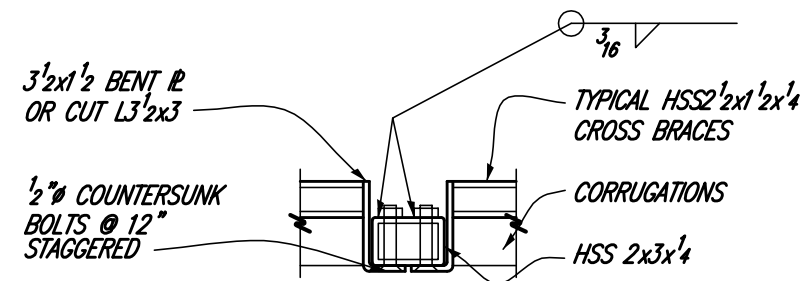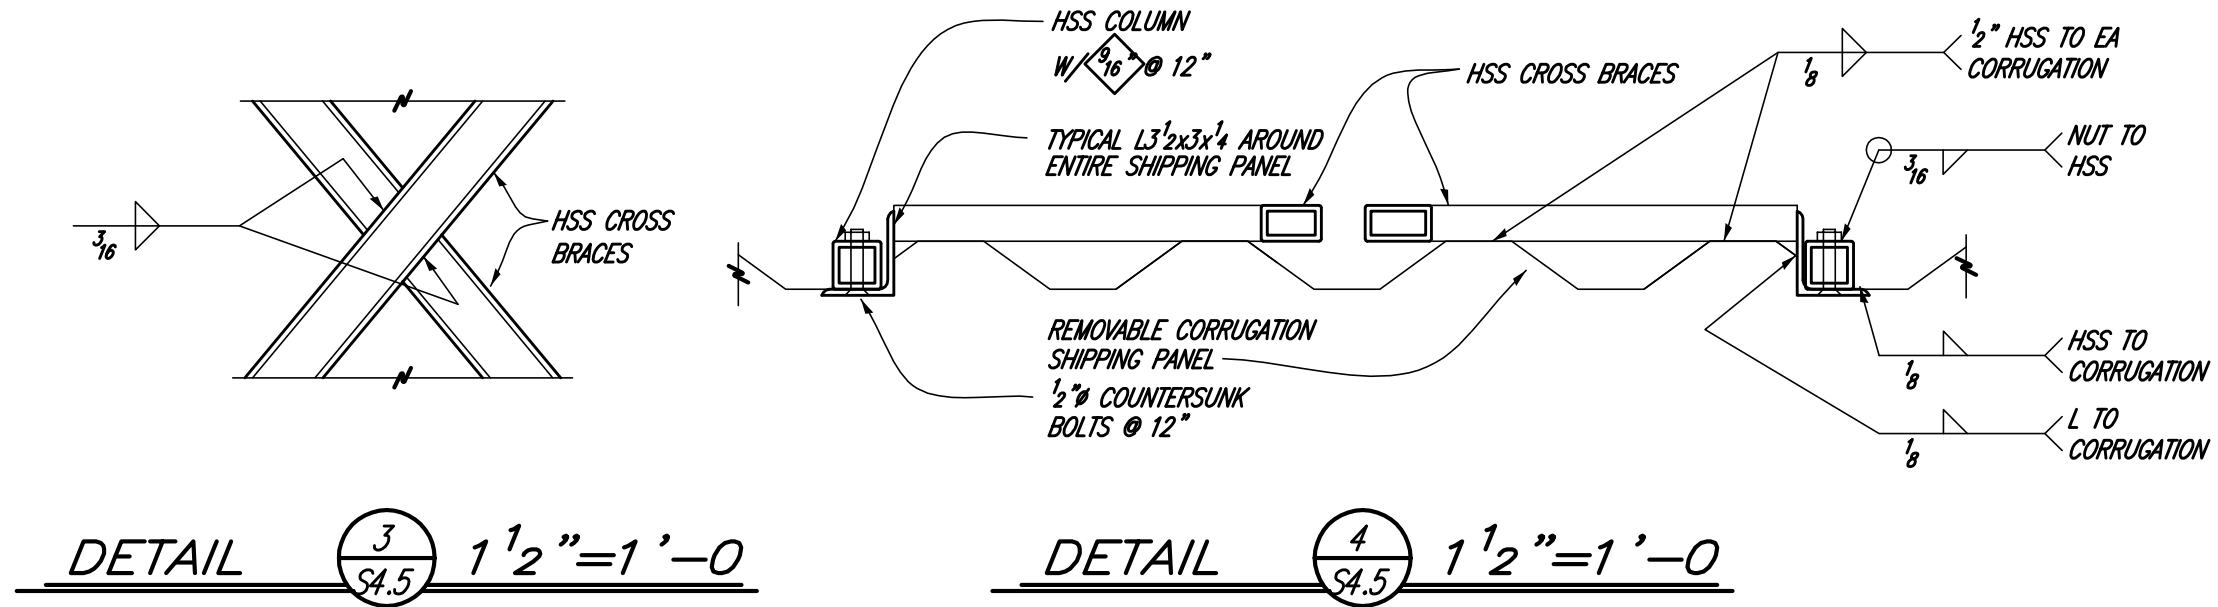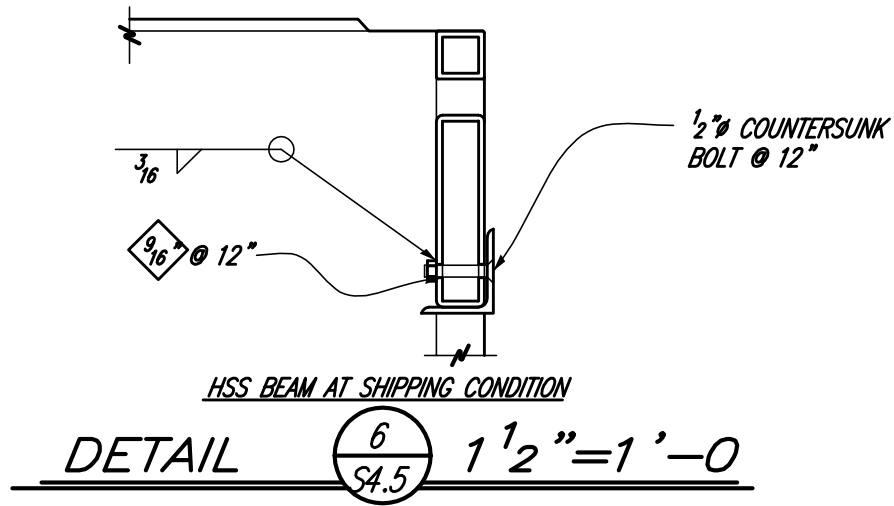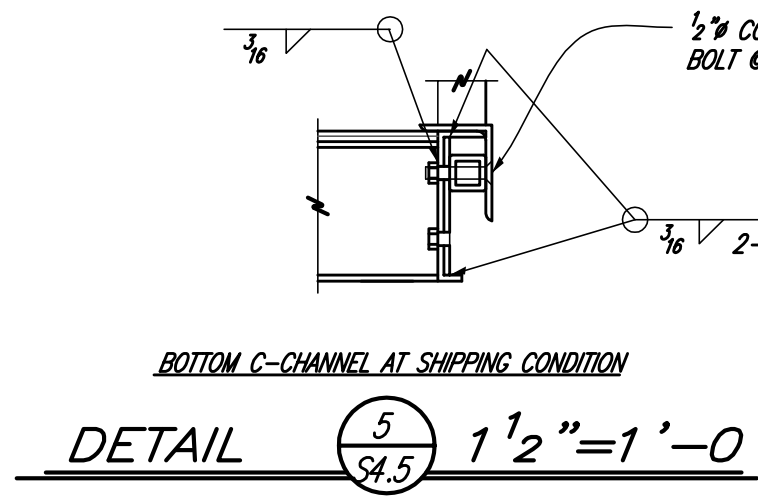

2007 Solar Decathlon

University of Colorado at Boulder  
Civil, Environmental, and Architectural Engineering  
428 UCB, Room ECCE 441  
Boulder, CO 80309-0428

Details

\*Scale as Noted

0 3' 6' 1' 2'




S-4.5

Date	August 7, 2007
Drawn by	K. Ronge
Revised	
Date	January 9, 2007


Battery Rack Details and Elevations	2007 Solar Decathlon
University of Colorado at Boulder	
Civil, Environmental, and Architectural Engineering	
428 UCB, Room ECCE 441	
Boulder, CO 80309-0428	




S-4.6

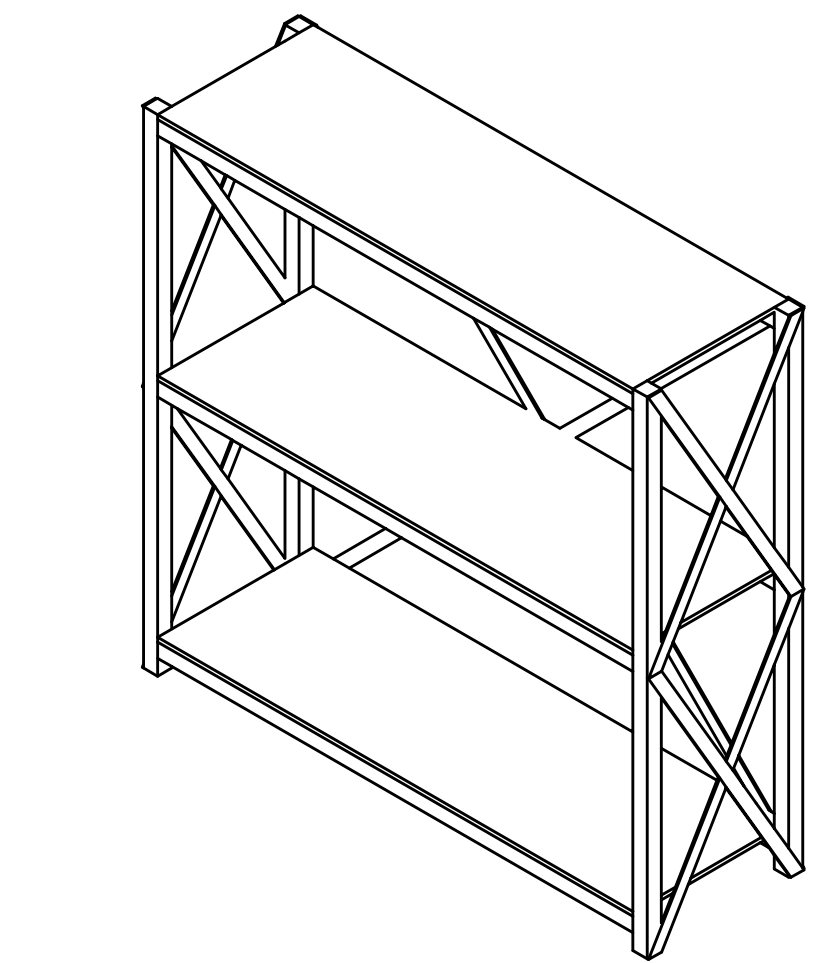


**DETAIL**  $\frac{1}{S4.6}$   $\frac{1}{2}''=1'-0$   
 BATTERY RACK ISOMETRIC VIEW

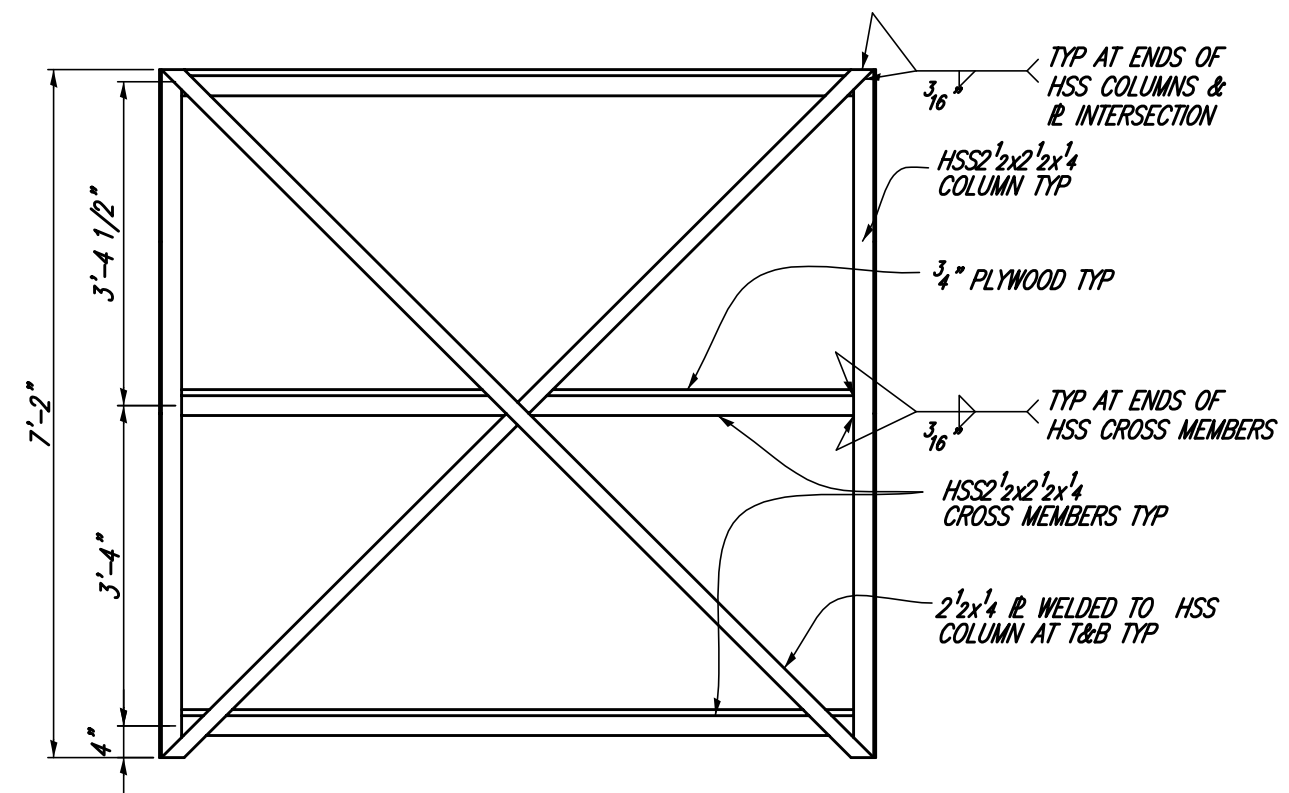

**DETAIL**  $\frac{3}{S4.6}$   $\frac{1}{2}''=1'-0$   
 BATTERY RACK REAR ELEVATION

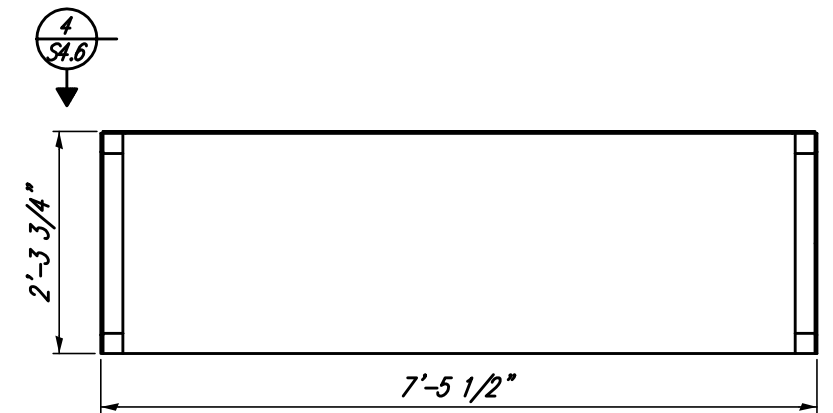


**DETAIL**  $\frac{2}{S4.6}$   $\frac{1}{2}''=1'-0$   
 BATTERY RACK PLAN VIEW

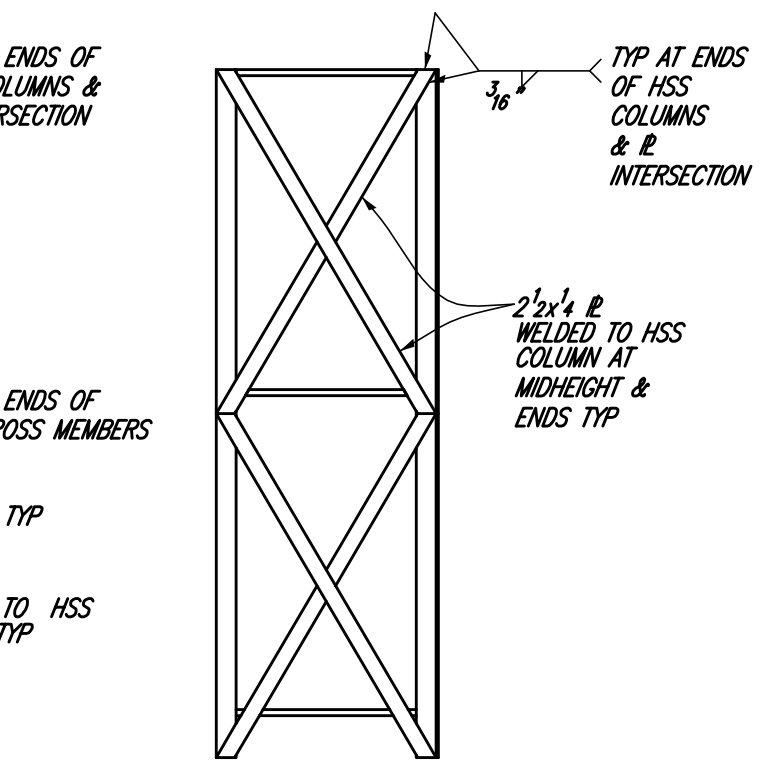

**DETAIL**  $\frac{4}{S4.6}$   $\frac{1}{2}''=1'-0$   
 BATTERY RACK SIDE ELEVATION, TYP.  
 GRAPHIC SCALE FOR  $\frac{1}{2}''=1'-0$  DETAILS  
 0 6" 1' 2' 4'

ALL MEMBERS REPLACED WITH APPROPRIATE SIZED FIBERGLASS MEMBERS BY OTHERS. ALL CONNECTIONS MADE PER SPECIFICATIONS BY OTHERS

① EGRESS PLAN  
N.T.S.

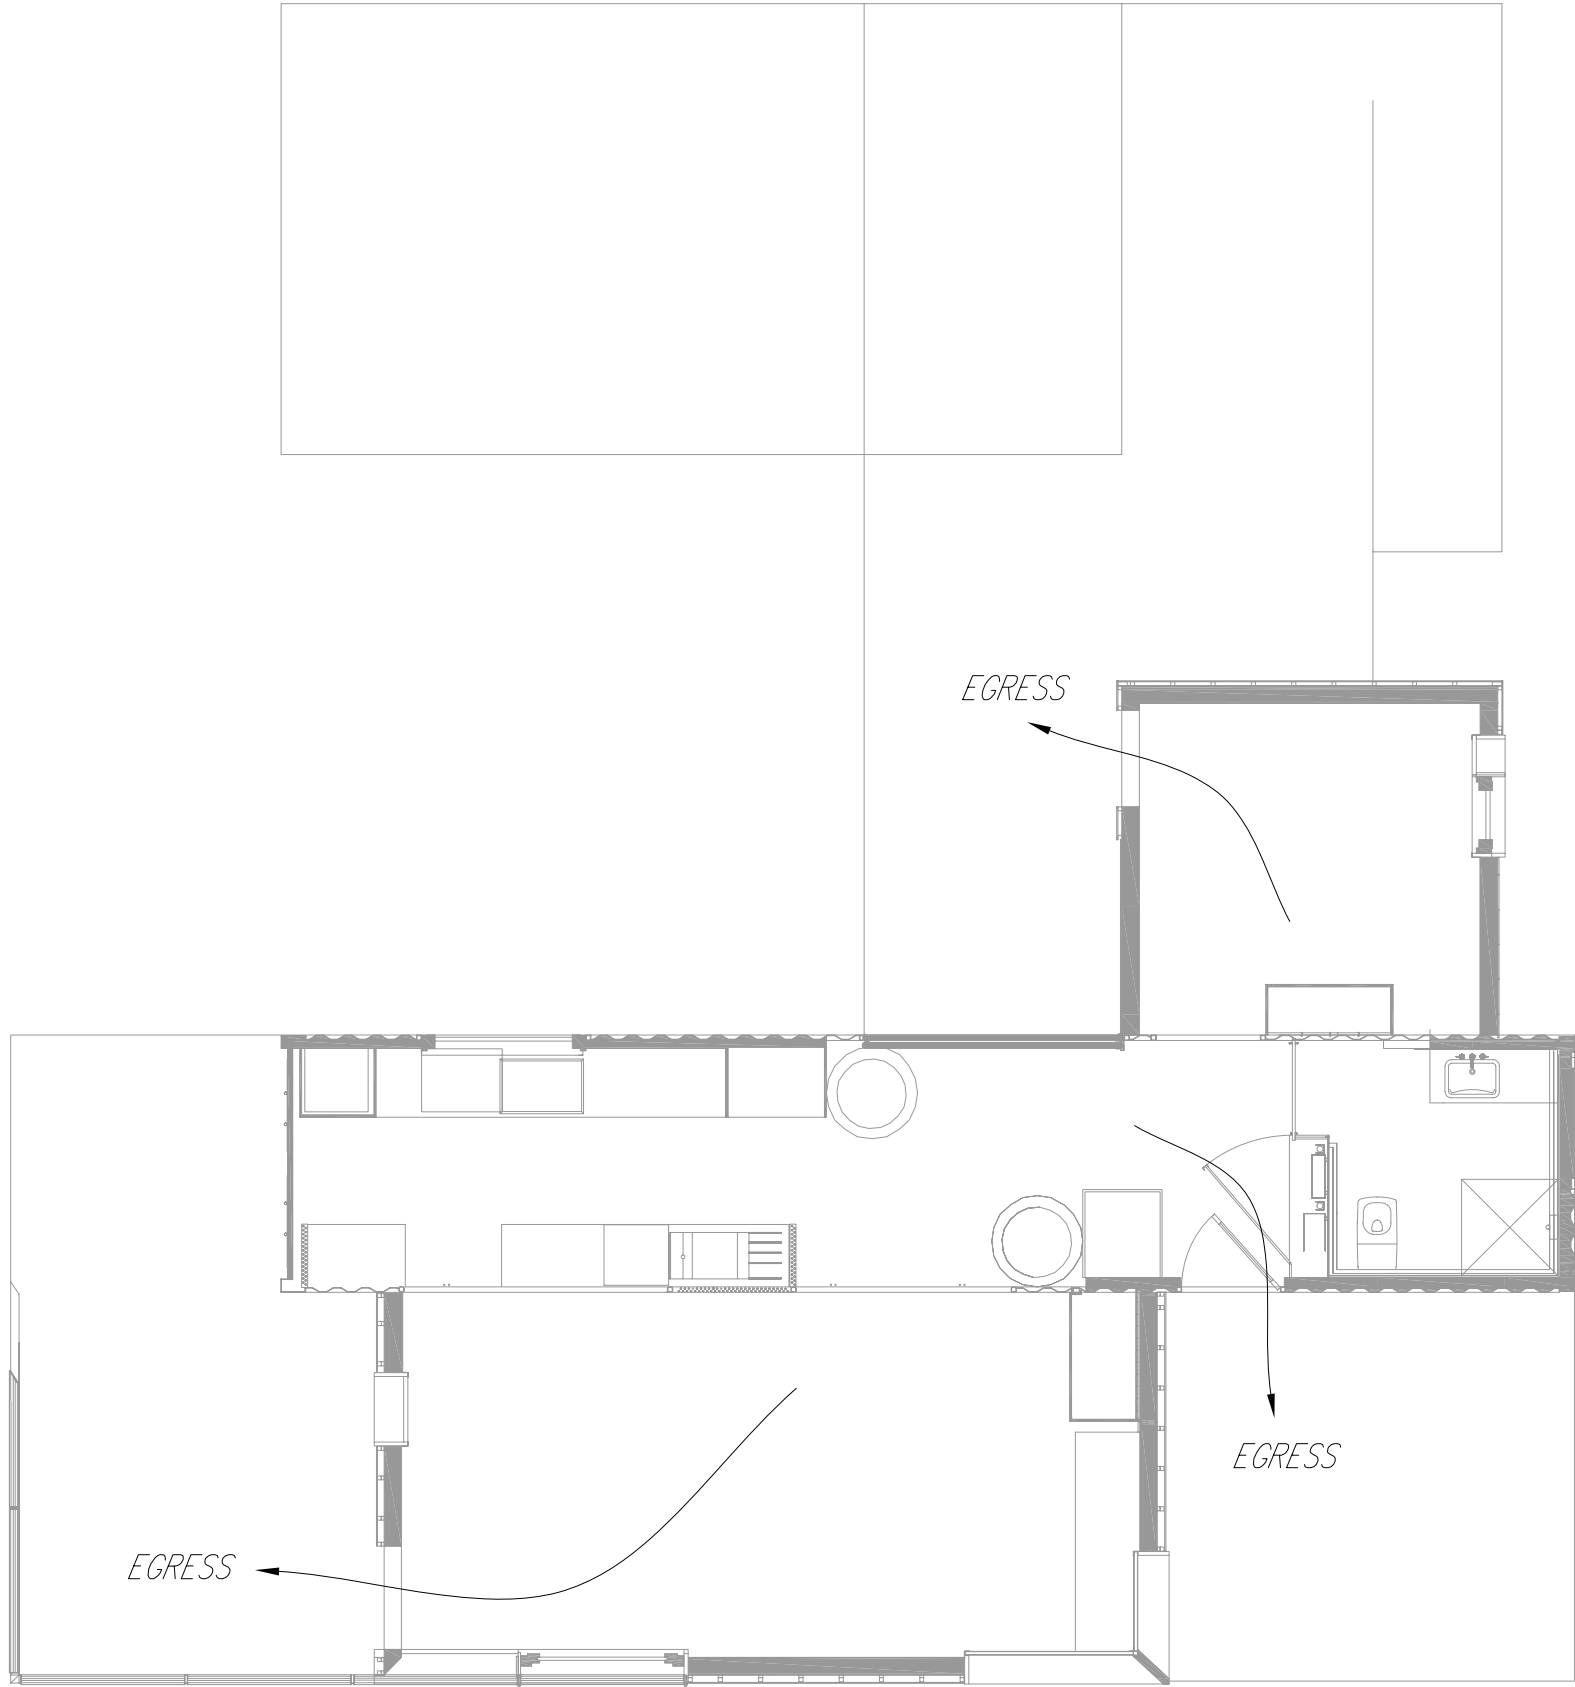

Drawn by	Date
C. Corbin	August 7, 2007
Revised	Date

Egress Plan

2007 Solar Decathlon

University of Colorado at Boulder

Civil, Environmental, and Architectural Engineering  
428 UCB, Room ECCE 441  
Boulder, CO 80309-0428




F1.01

# LEGEND

(FE)	FIRE EXTINGUISHER
(SD)	SMOKE DETECTOR

NOTE: SEE XX.XX FOR GARAGE FIRE EXTINGUISHER LOCATION

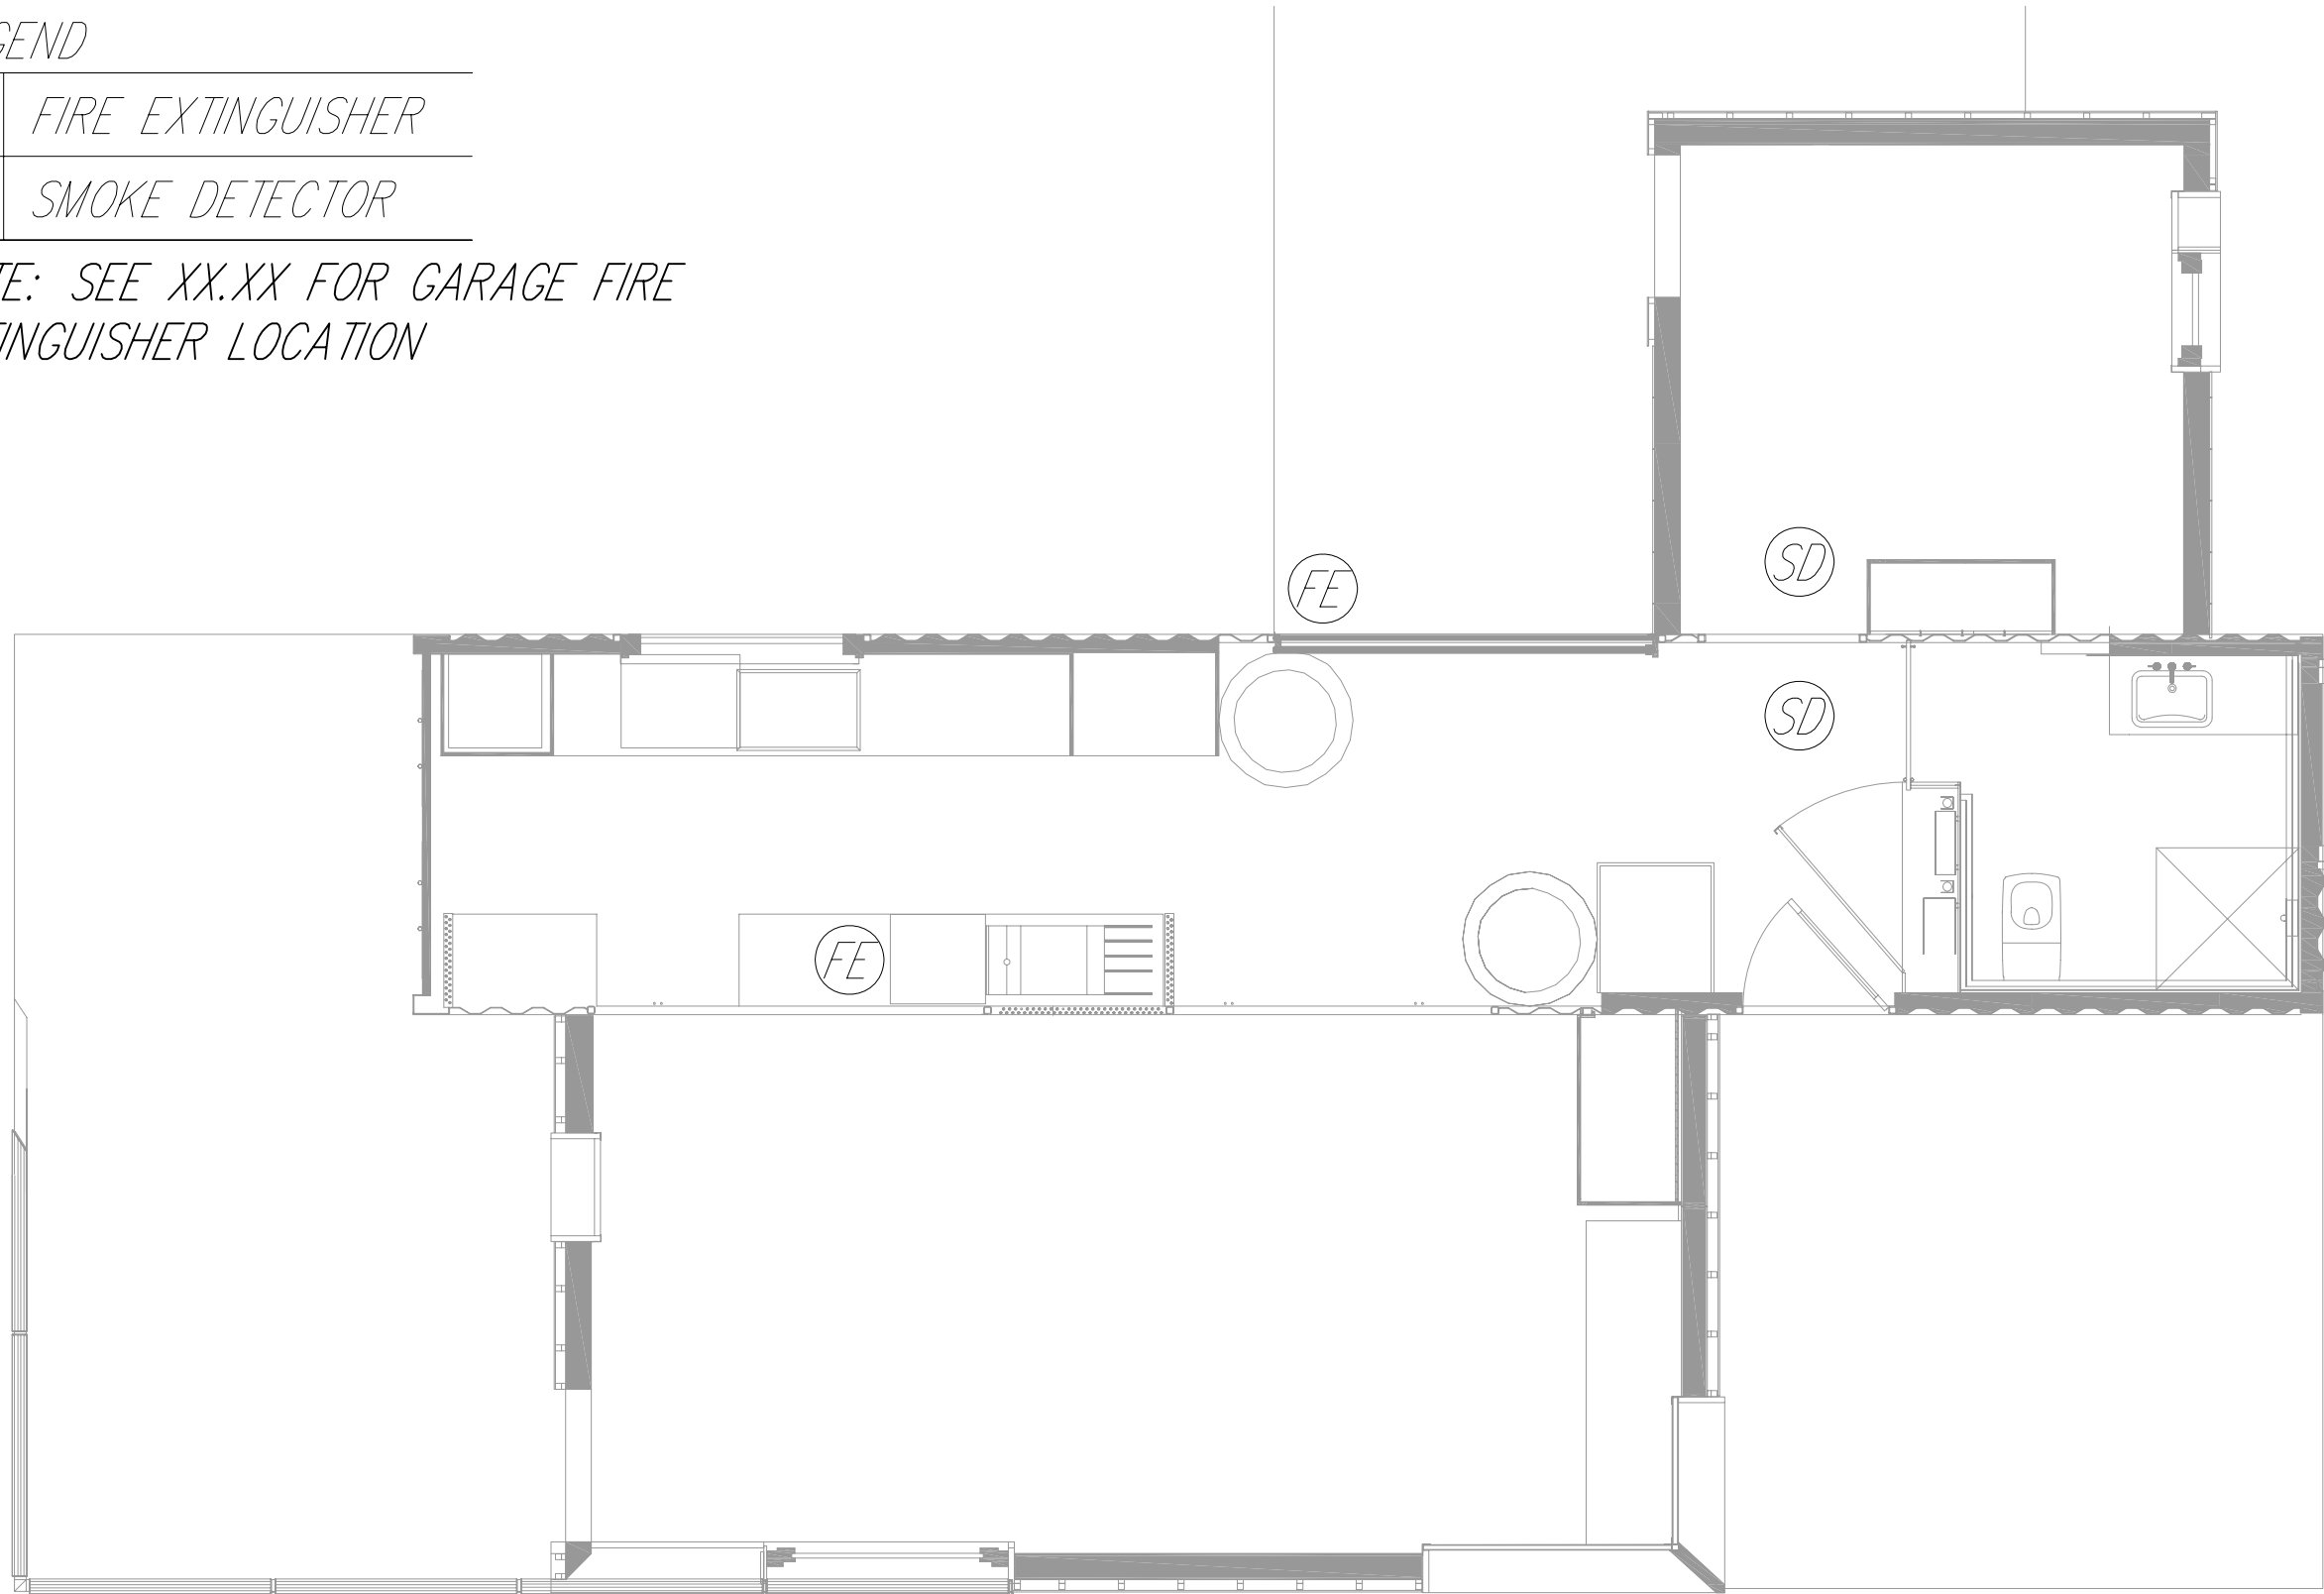

1 FIRE PROTECTION PLAN  
1/4" = 1'-0"

Drawn by	Date	Revised	Date
C. Corbin	August 7, 2007		

Fire Protection Plan


0 1' 2' 4' 8'

2007 Solar Decathlon

University of Colorado at Boulder  
Civil, Environmental, and Architectural Engineering  
428 UCB, Room ECCE 441  
Boulder, CO 80309-0428



F1.11

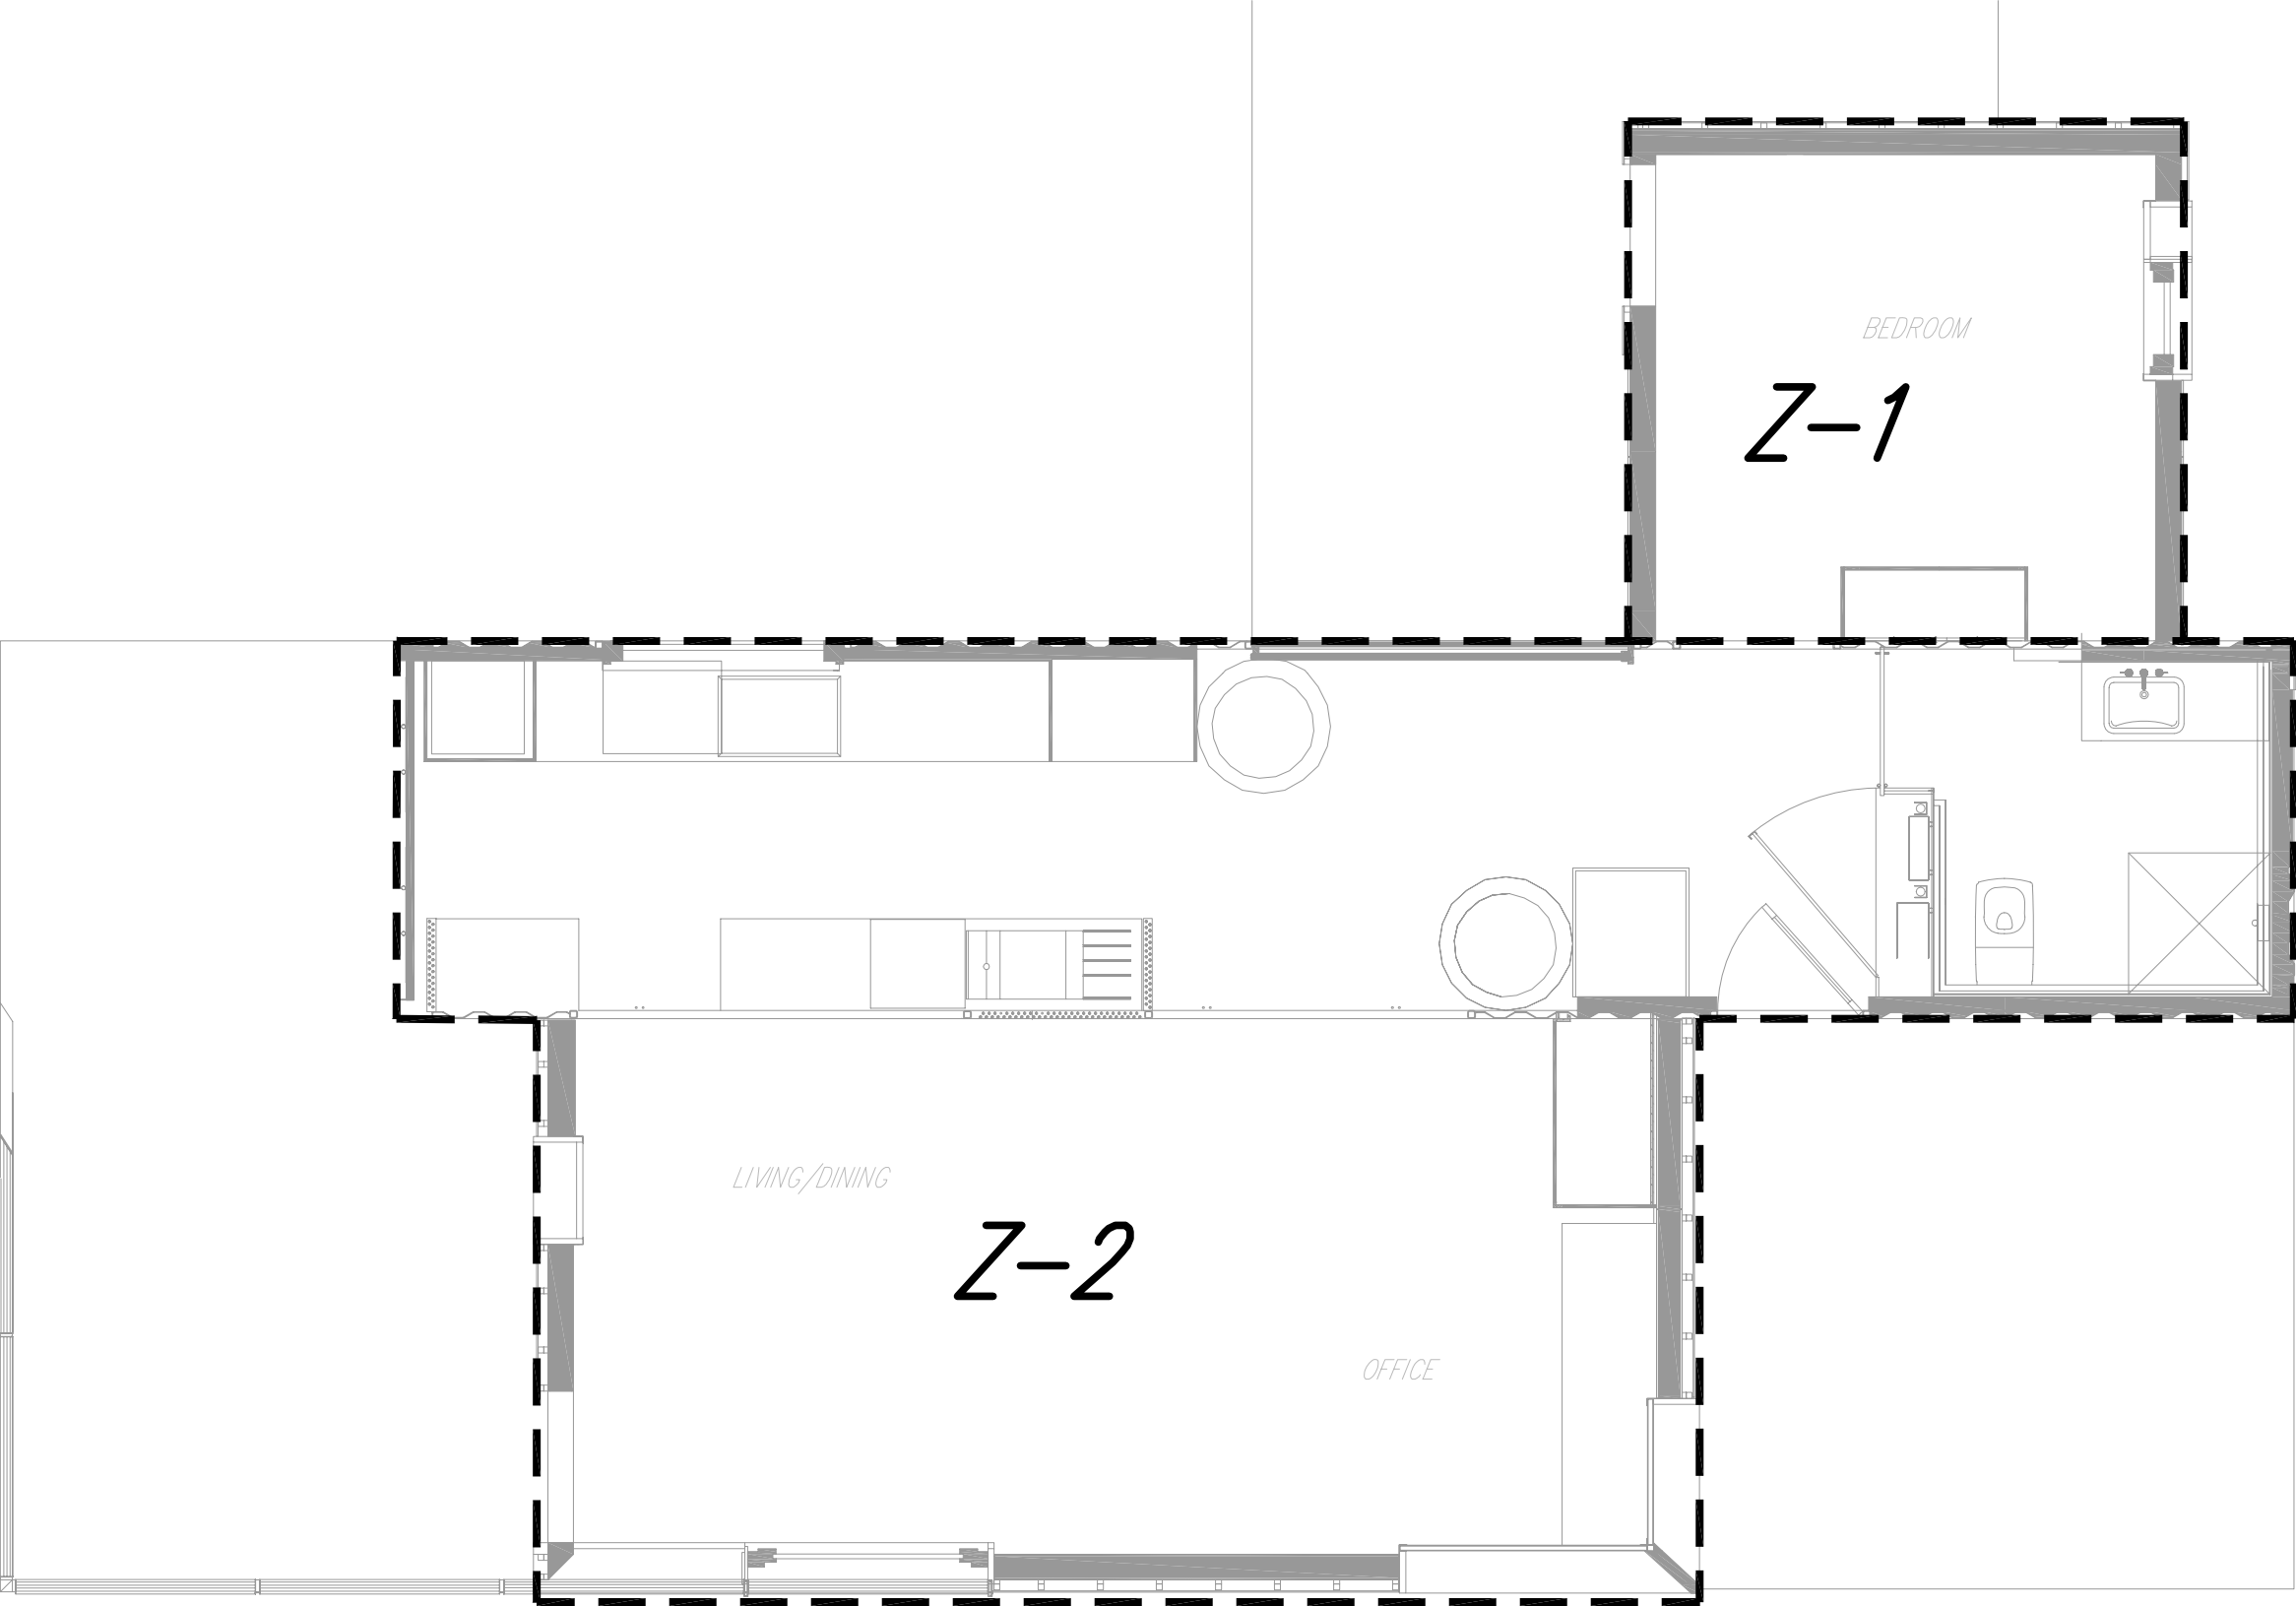

① HVAC ZONING PLAN  
N.T.S.

Drawn by	Date
C. Corbin	August 7, 2007
Revised	Date

HVAC Zoning Plan

2007 Solar Decathlon

University of Colorado at Boulder  
Civil, Environmental, and Architectural Engineering  
428 UCB, Room ECCE 441  
Boulder, CO 80309-0428




M1.01



# SPECIFIC NOTES:

1. PROVIDE JET DIFFUSER INSTALLATION FOR FUTURE USE. CLOSE OFF DAMPER FOR COMPETITION. COORDINATE DIFFUSER LOCATION WITH ARCHITECTURAL CEILING.
2. COORDINATE DIFFUSER LOCATION WITH ARCHITECTURAL CEILING.
3. PROVIDE SUPPLY FAN INSTALLATION IN LOCATION ABOVE REFRIGERATOR.
4. SUPPLY FAN RETURN AIR DUCT OPEN TO CEILING PLENUM. COVER DUCT OPENING WITH SIZE GALVANIZED WIRE MESH.
5. PROVIDE CUSTOM FAN COIL INSTALLATION IN LOCATION INDICATED. MOUNT FAN COIL WITHIN CEILING PLENUM. SEE DRAWING M6.05.
6. BATHROOM EXHAUST FAN RETURN AIR DUCT OPEN TO CEILING PLENUM. COVER DUCT OPENING WITH SIZE GALVANIZED WIRE MESH.
7. PROVIDE EXHAUST FAN INSTALLATION IN ARCHITECTURAL SOFFIT. CONNECT EXHAUST AIR DISCHARGE TO EXISTING SHIPPING CONTAINER VENT IN NORTHWEST LOCATION. CONNECT EXHAUST AIR INTAKE TO EXHAUST AIR PLENUM. COORDINATE PLENUM WITH ARCHITECTURAL DIFFUSER.

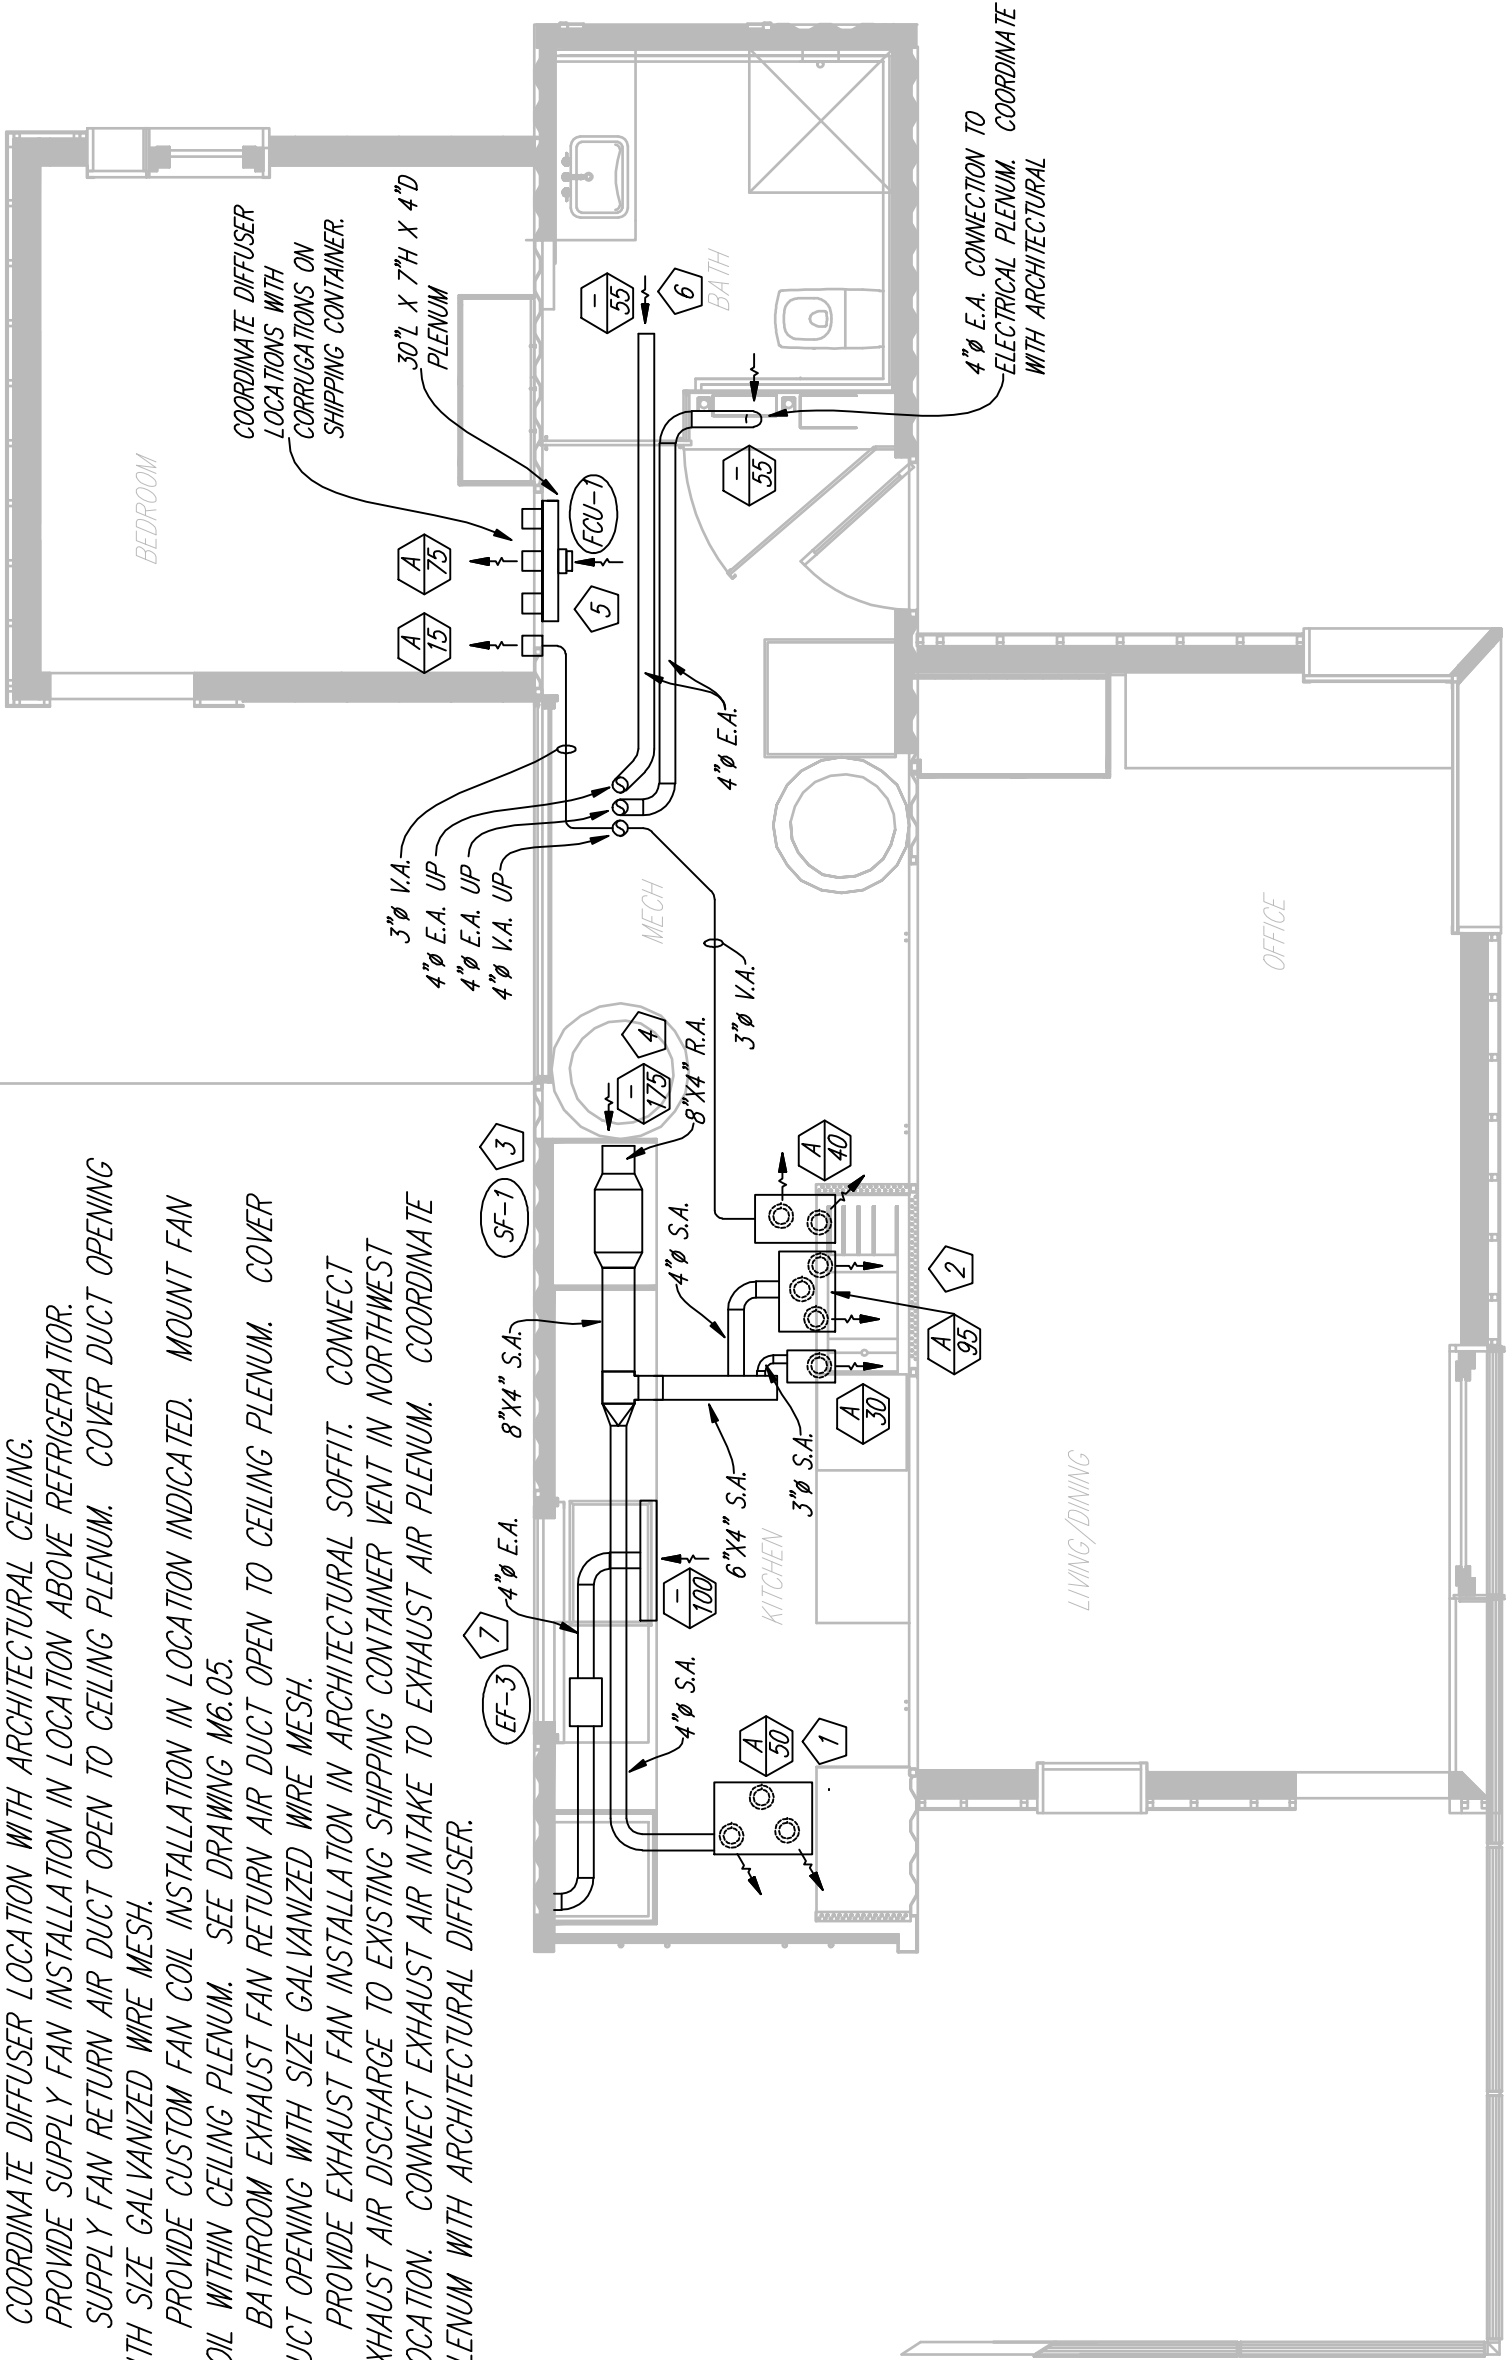

1 GROUND LEVEL HVAC DUCTWORK PLAN  
1/4" = 1'-0"

Drawn by	J.S. McNeill
Date	August 7, 2007
Revised	
Date	January 9, 2008


University of Colorado at Boulder  
Civil, Environmental, and Architectural Engineering  
428 UCB, Room ECE 441  
Boulder, CO 80309-0428

Ground Level HVAC Ductwork Plan

0 1' 2' 4' 8'




M1.11

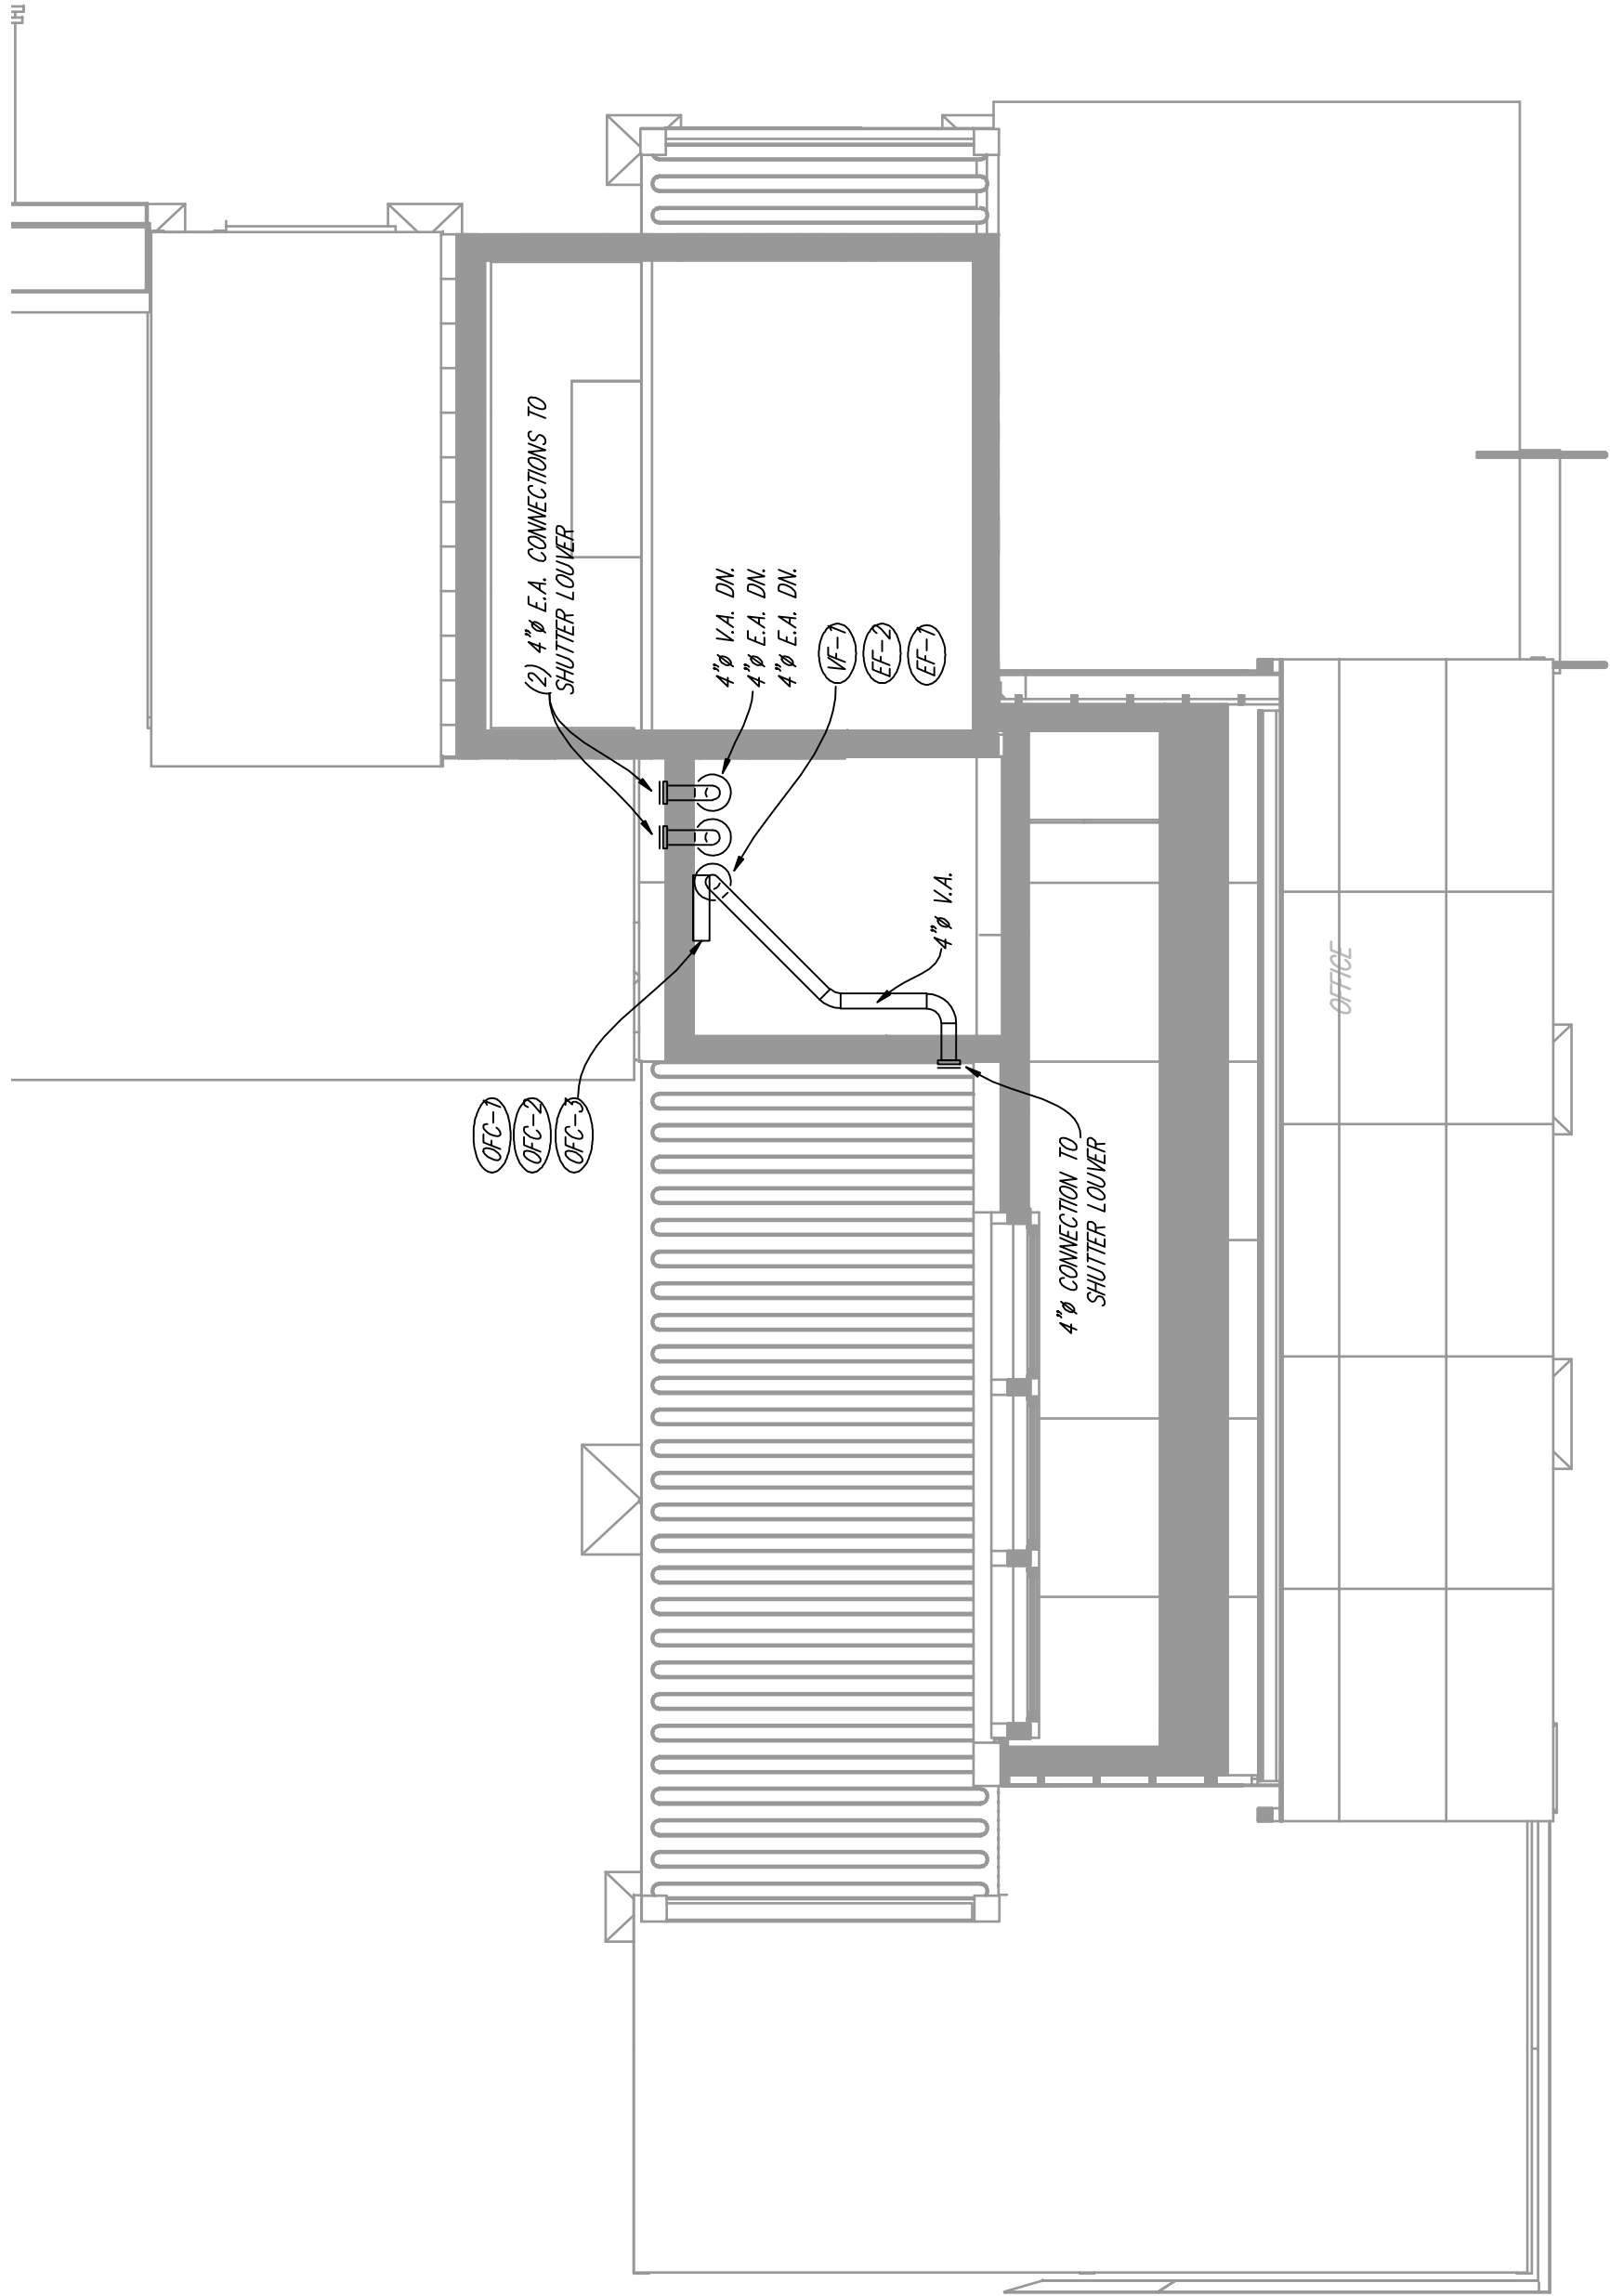

1 Attic Level HVAC Ductwork Plan  
1/4" = 1'-0"


M1.12

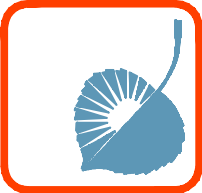

Drawn by	J.S. McNeill	Date	January 9, 2008
Revised	J.S. McNeill	Date	August 30, 2007

# SPECIFIC NOTES:

1. SEE HEAT PUMP DRAWING, M3.01, FOR DETAIL OF PIPING CONNECTIONS TO HEAT PUMP CABINET.
2. CAP HYDRONIC SUPPLY AND RETURN PIPING AT BALL VALVES FOR FUTURE USE.

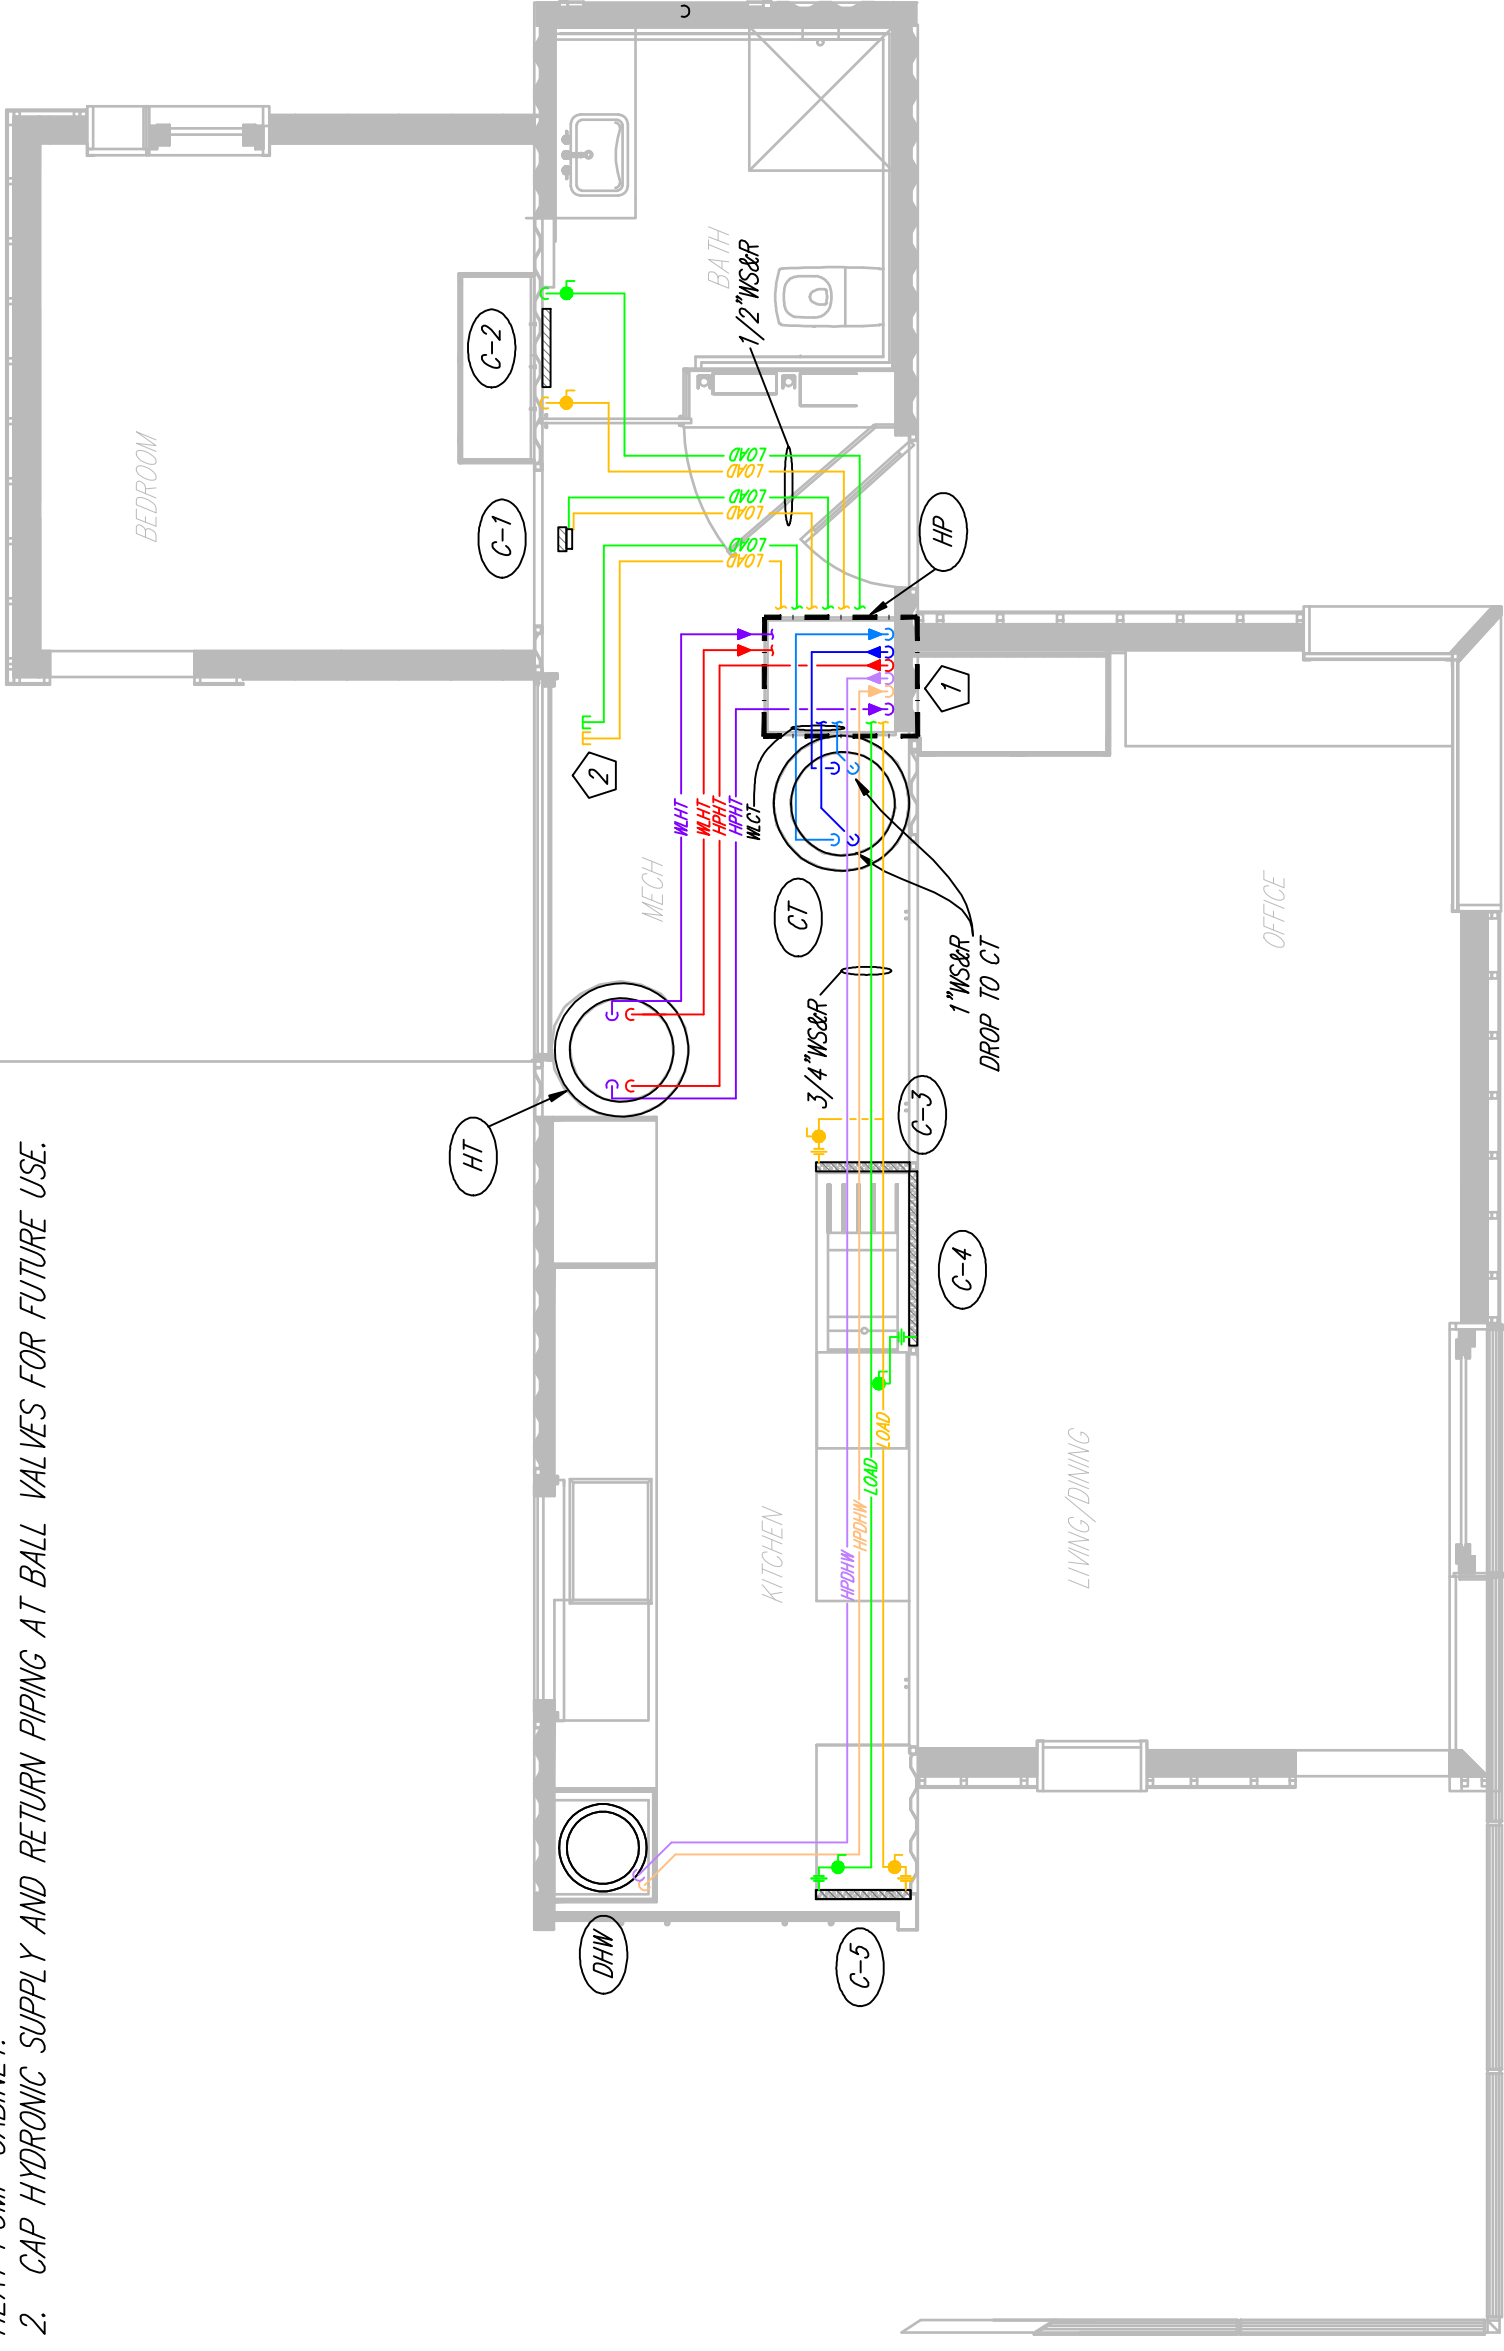

1 GROUND LEVEL HVAC PIPING PLAN  
1/4" = 1'-0"

M1.21



Ground Level HVAC Piping Plan

0 1' 2' 4' 8'


2007 Solar Decathlon

University of Colorado at Boulder  
Civil, Environmental, and Architectural Engineering  
428 UCB, Room ECE 441  
Boulder, CO 80309-0428

Drawn by	J.S. McNeill	Date	August 7, 2007
Revised	J.S. McNeill	Date	January 9, 2008

# SPECIFIC NOTES:

1. PIPING CONNECTION TO PVT SYSTEM. SEE PVT DRAWINGS, M1.31 TO M1.34.
2. (3) OUTDOOR FAN COIL UNITS STACKED VERTICALLY. EACH COIL SHALL HAVE ISOLATION BALL VALVES ON THE SUPPLY AND RETURN PIPING. PROVIDE A MANUAL AIR VENT AT THE TOP OF THE SUPPLY AND RETURN HEADERS.

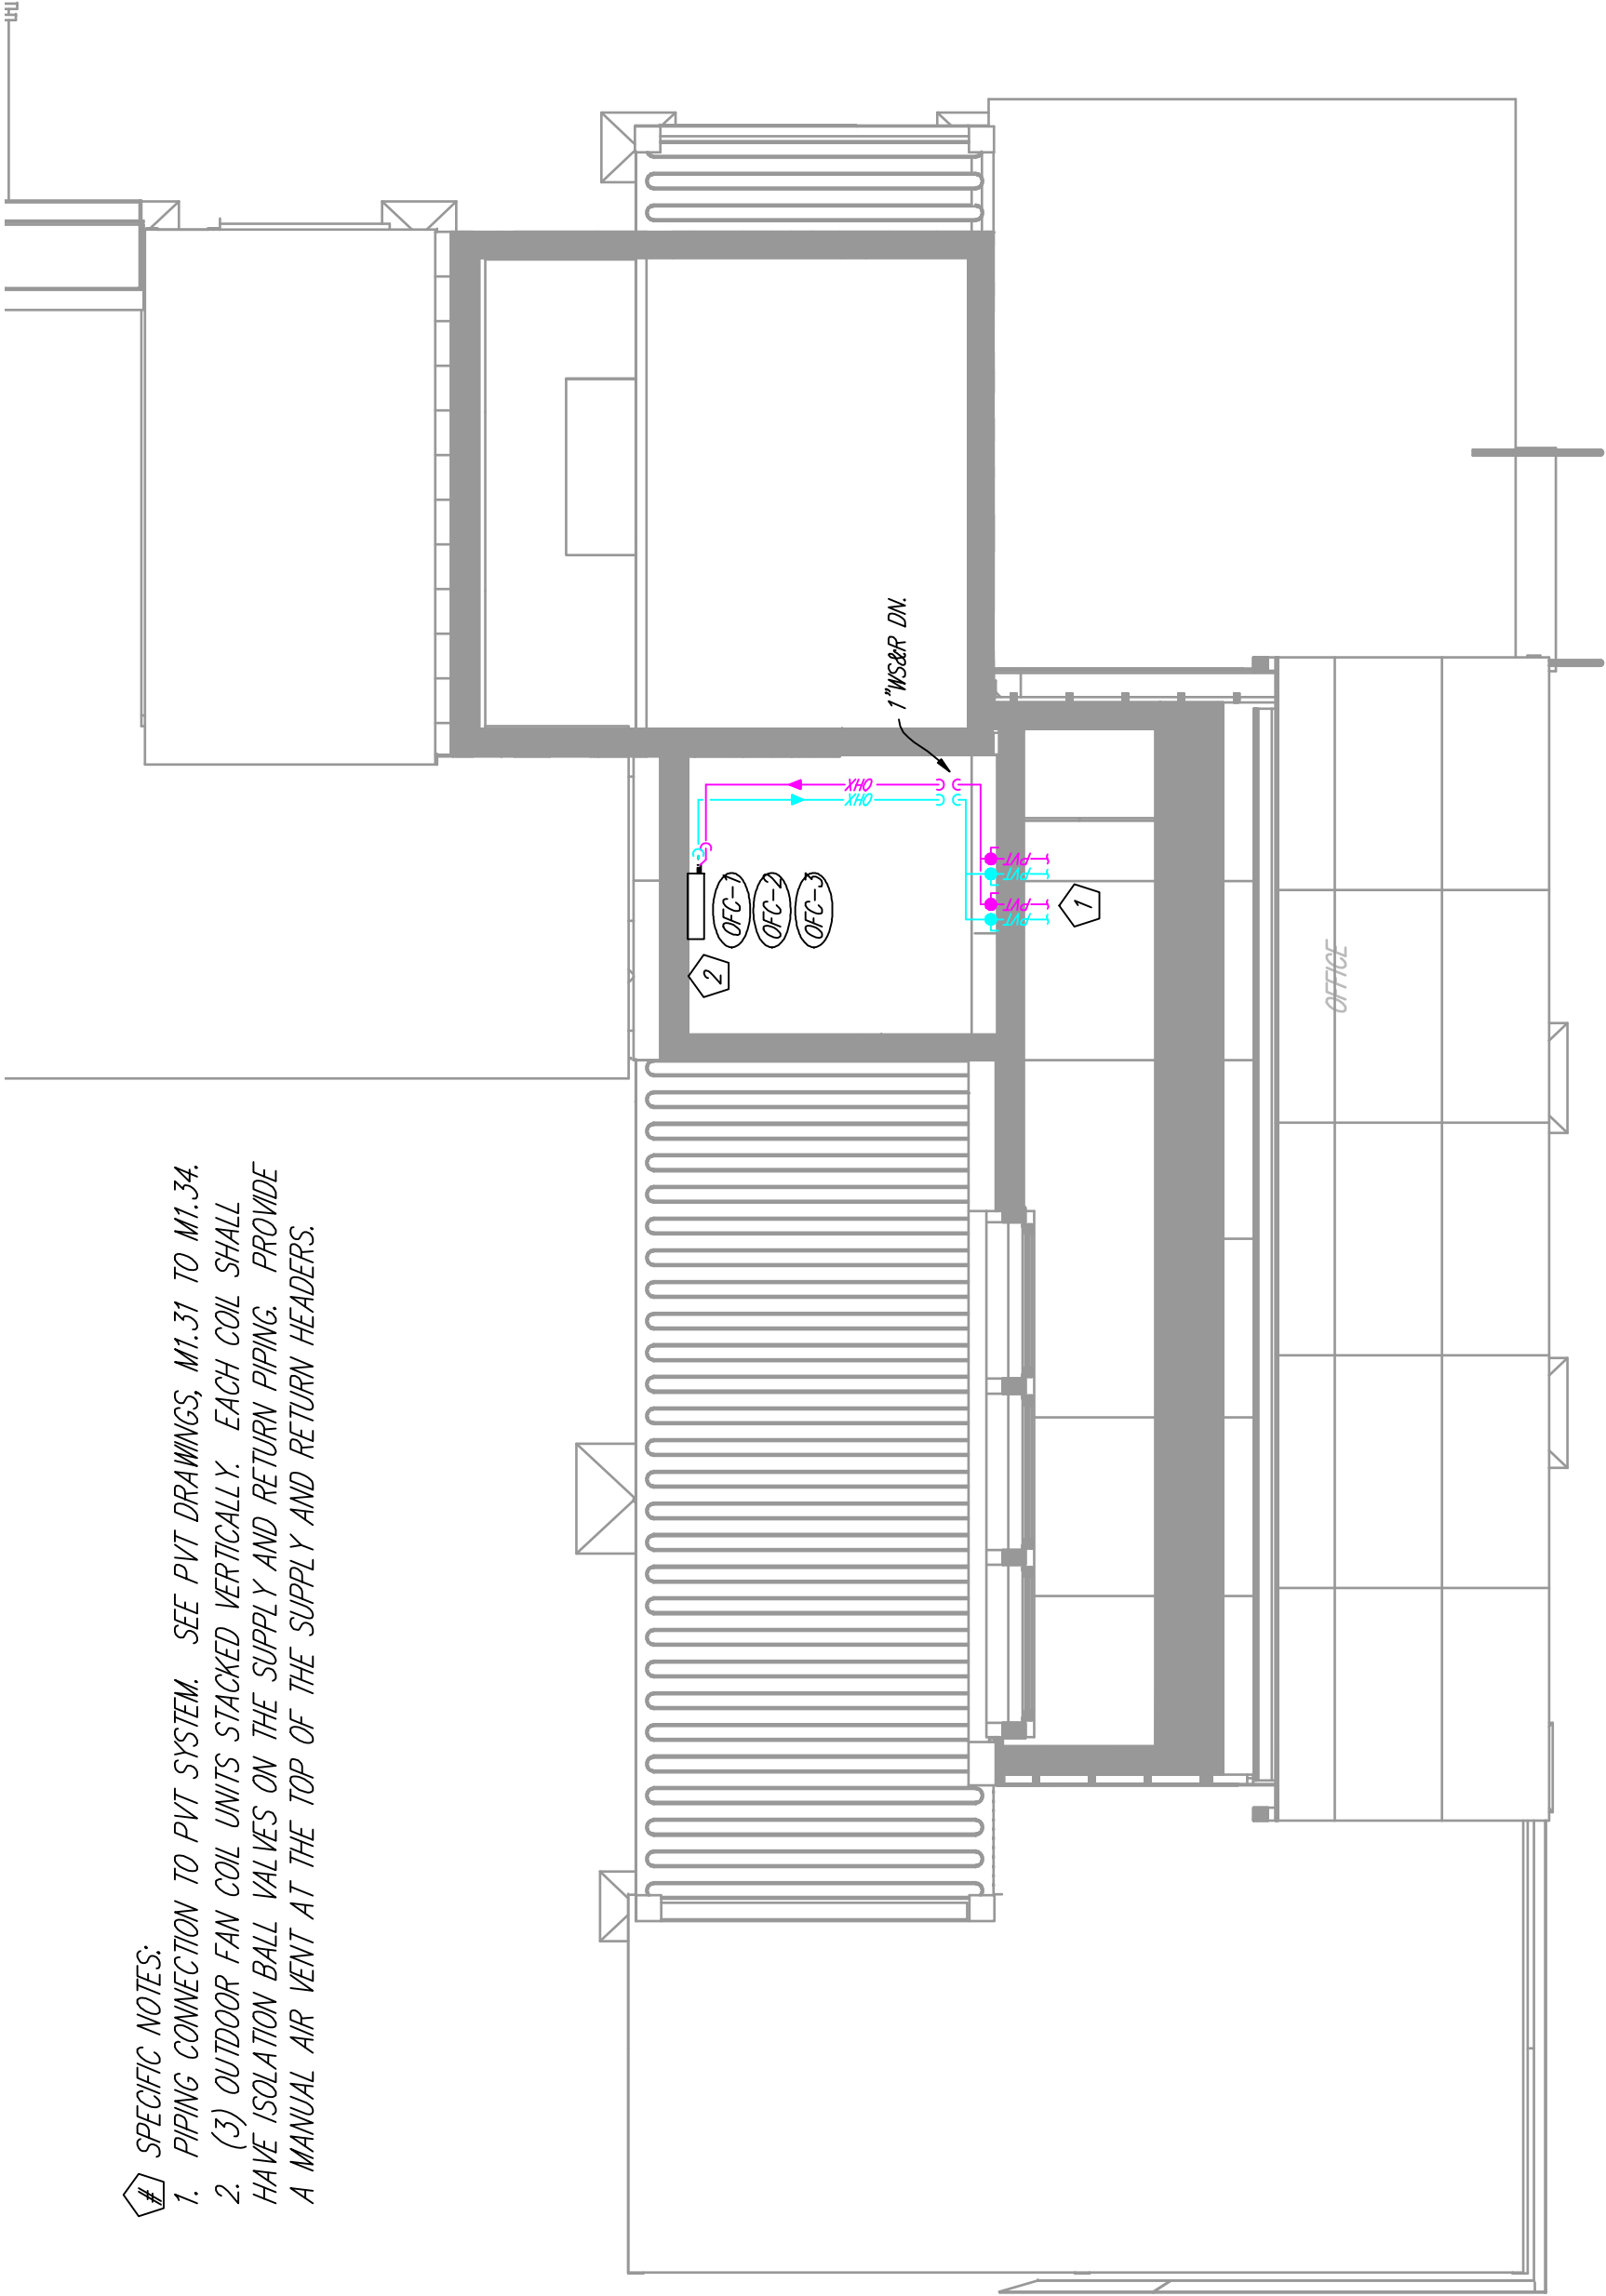

1 Attic Level HVAC Piping Plan  
1/4" = 1'-0"

Drawn by	Date
J.S. McNeil	January 9, 2008
Revised	Date

Attic Level HVAC Piping Plan

01'2'4'8'


University of Colorado at Boulder  
Civil, Environmental, and Architectural Engineering  
428 UCB, Room ECE 441  
Boulder, CO 80309-0428

2007 Solar Decathlon



M1.22

① PV ROOF PLAN  
1/4" = 1'-0"

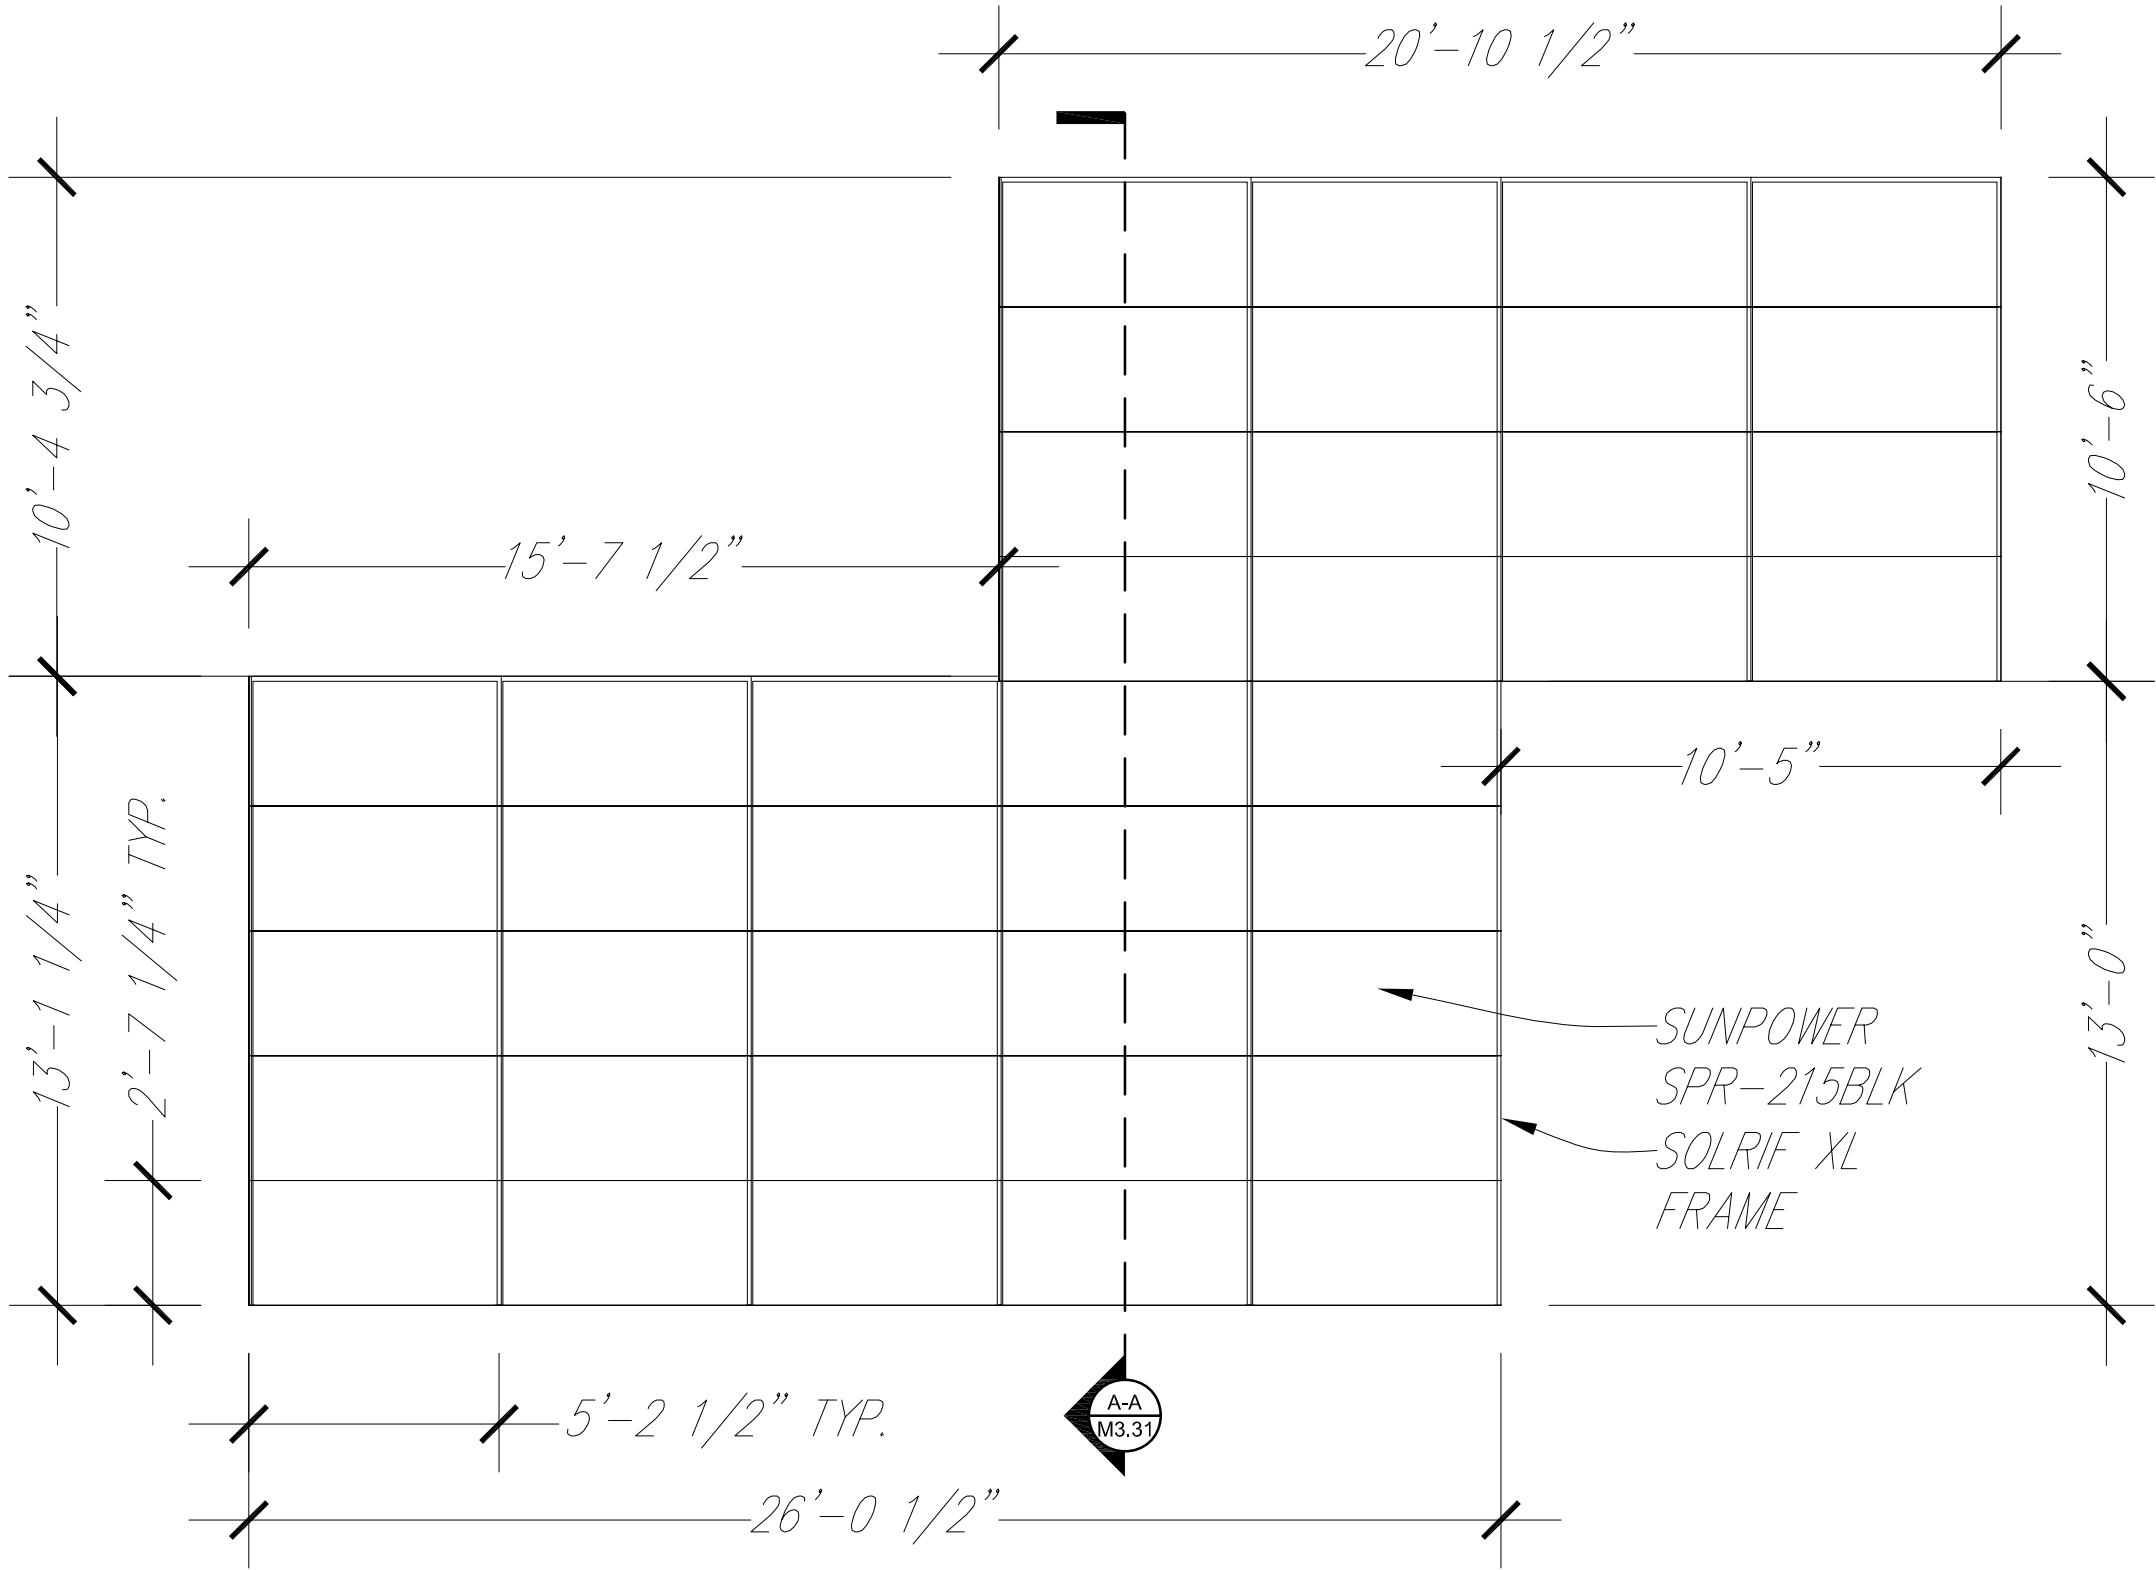

Drawn by	Date
C. Corbin	August 7, 2007
Revised	Date

PV Roof Plan

0

1'

2'

4'

8'

2007 Solar Decathlon

University of Colorado at Boulder

Civil, Environmental, and Architectural Engineering

428 UCB, Room ECCE 441


Boulder, CO 80309-0428



M1.31



① PV FRAME SUPPORT PLAN  
1/4" = 1'-0"

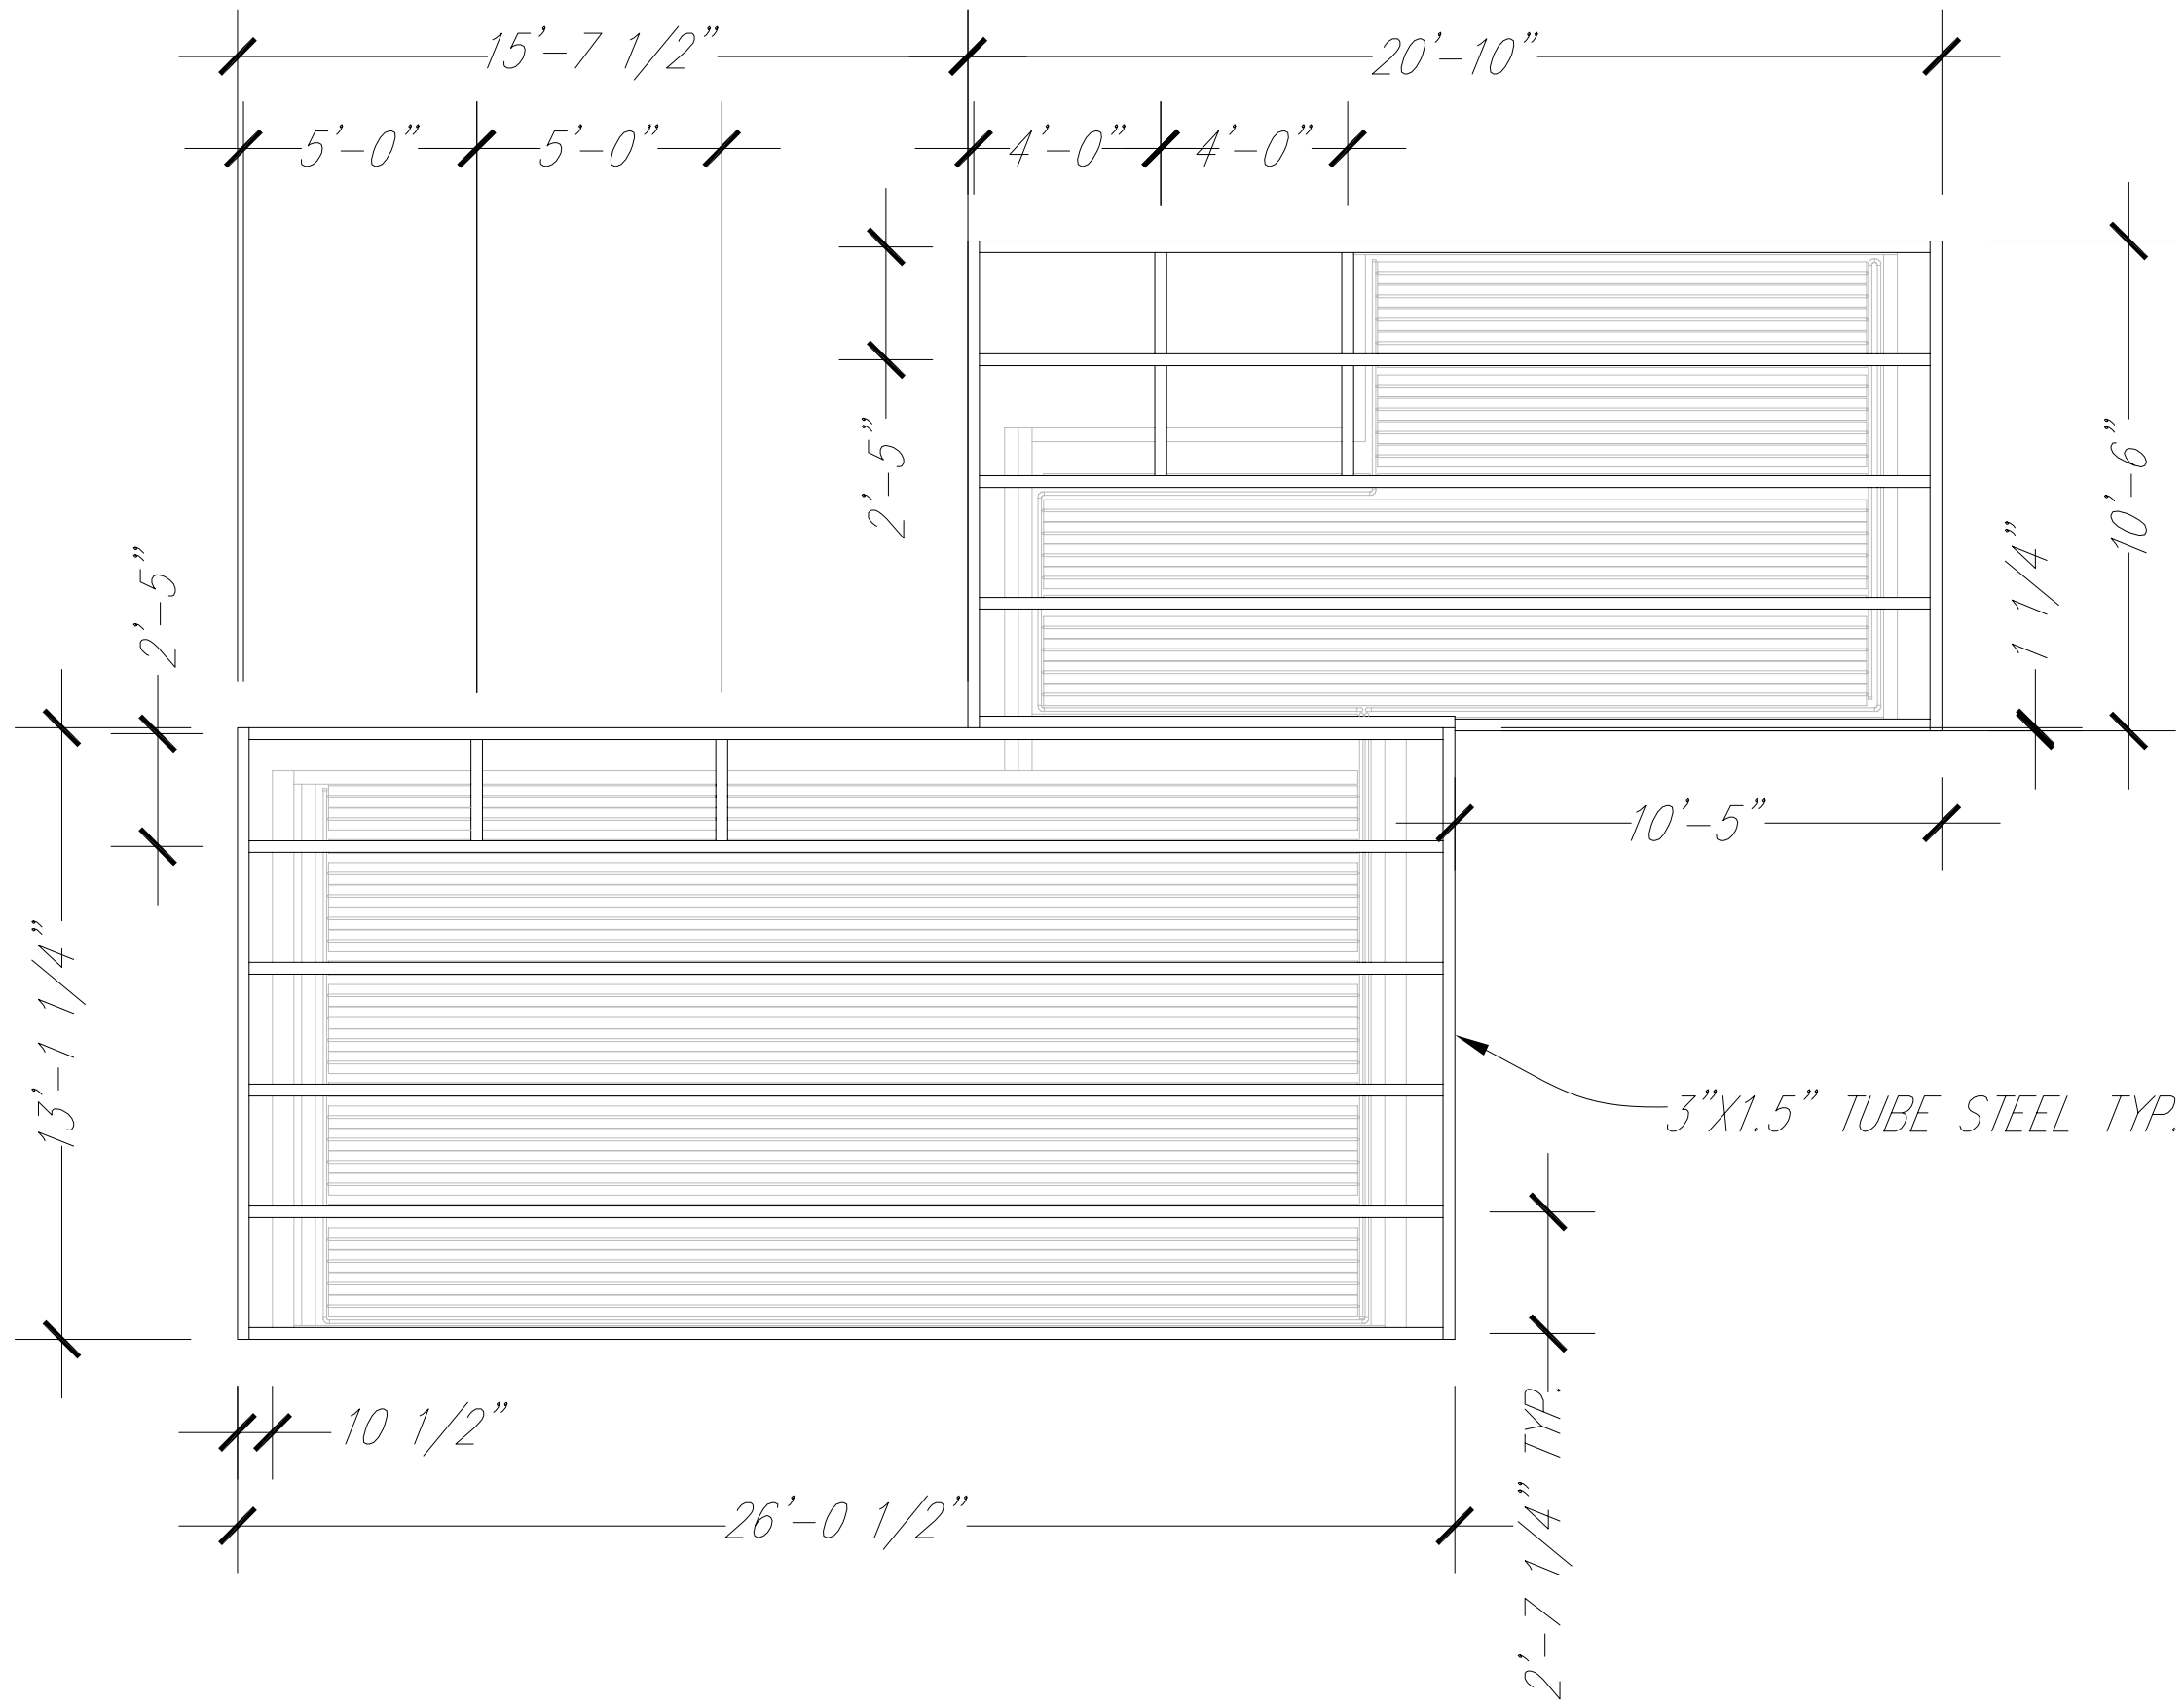

Drawn by	Date
C. Corbin	August 7, 2007
Revised	Date

PV Frame Support Plan


2007 Solar Decathlon

University of Colorado at Boulder  
Civil, Environmental, and Architectural Engineering  
428 UCB, Room ECCE 441  
Boulder, CO 80309-0428

0 1' 2' 4' 8'



① PV FRAME BLOCKING PLAN  
1/4" = 1'-0"

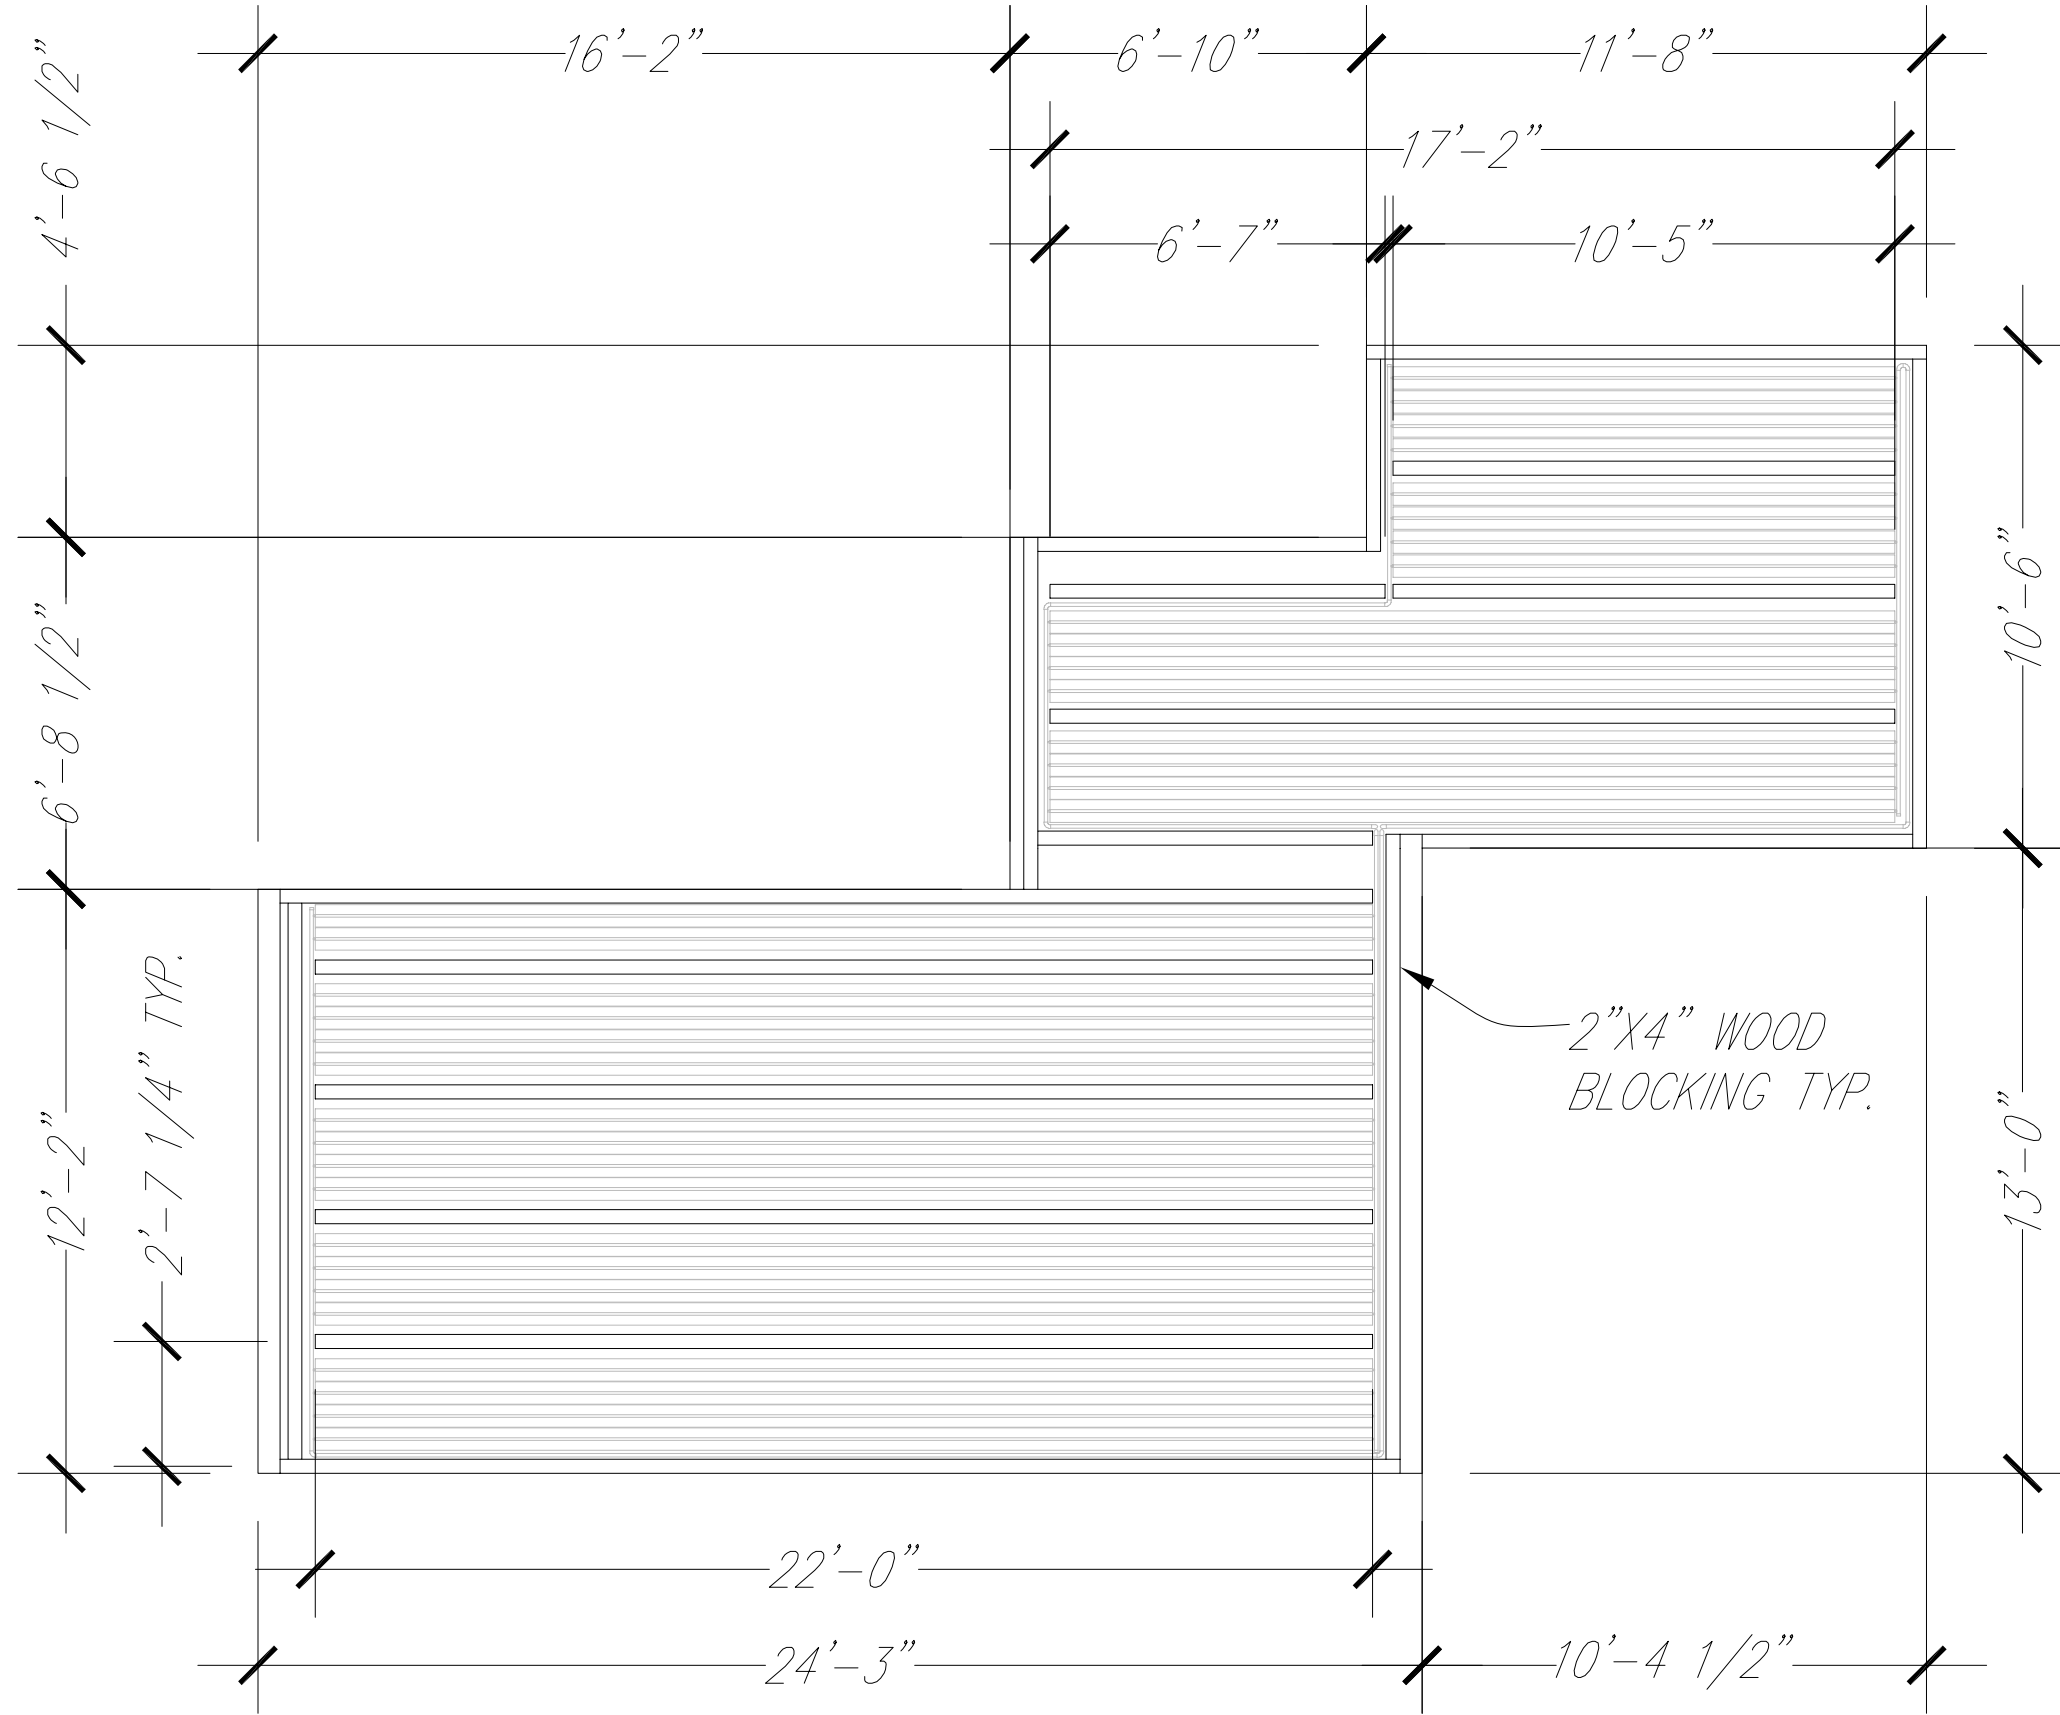

M1.33

PV Frame Blocking Plan


0 1' 2' 4' 8'

2007 Solar Decathlon

University of Colorado at Boulder  
Civil, Environmental, and Architectural Engineering  
428 UCB, Room ECCE 441  
Boulder, CO 80309-0428

Drawn by	Date
C. Corbin	August 7, 2007
Revised	Date

① PVT ABSORBER PLAN  
1/4" - 1'-0"

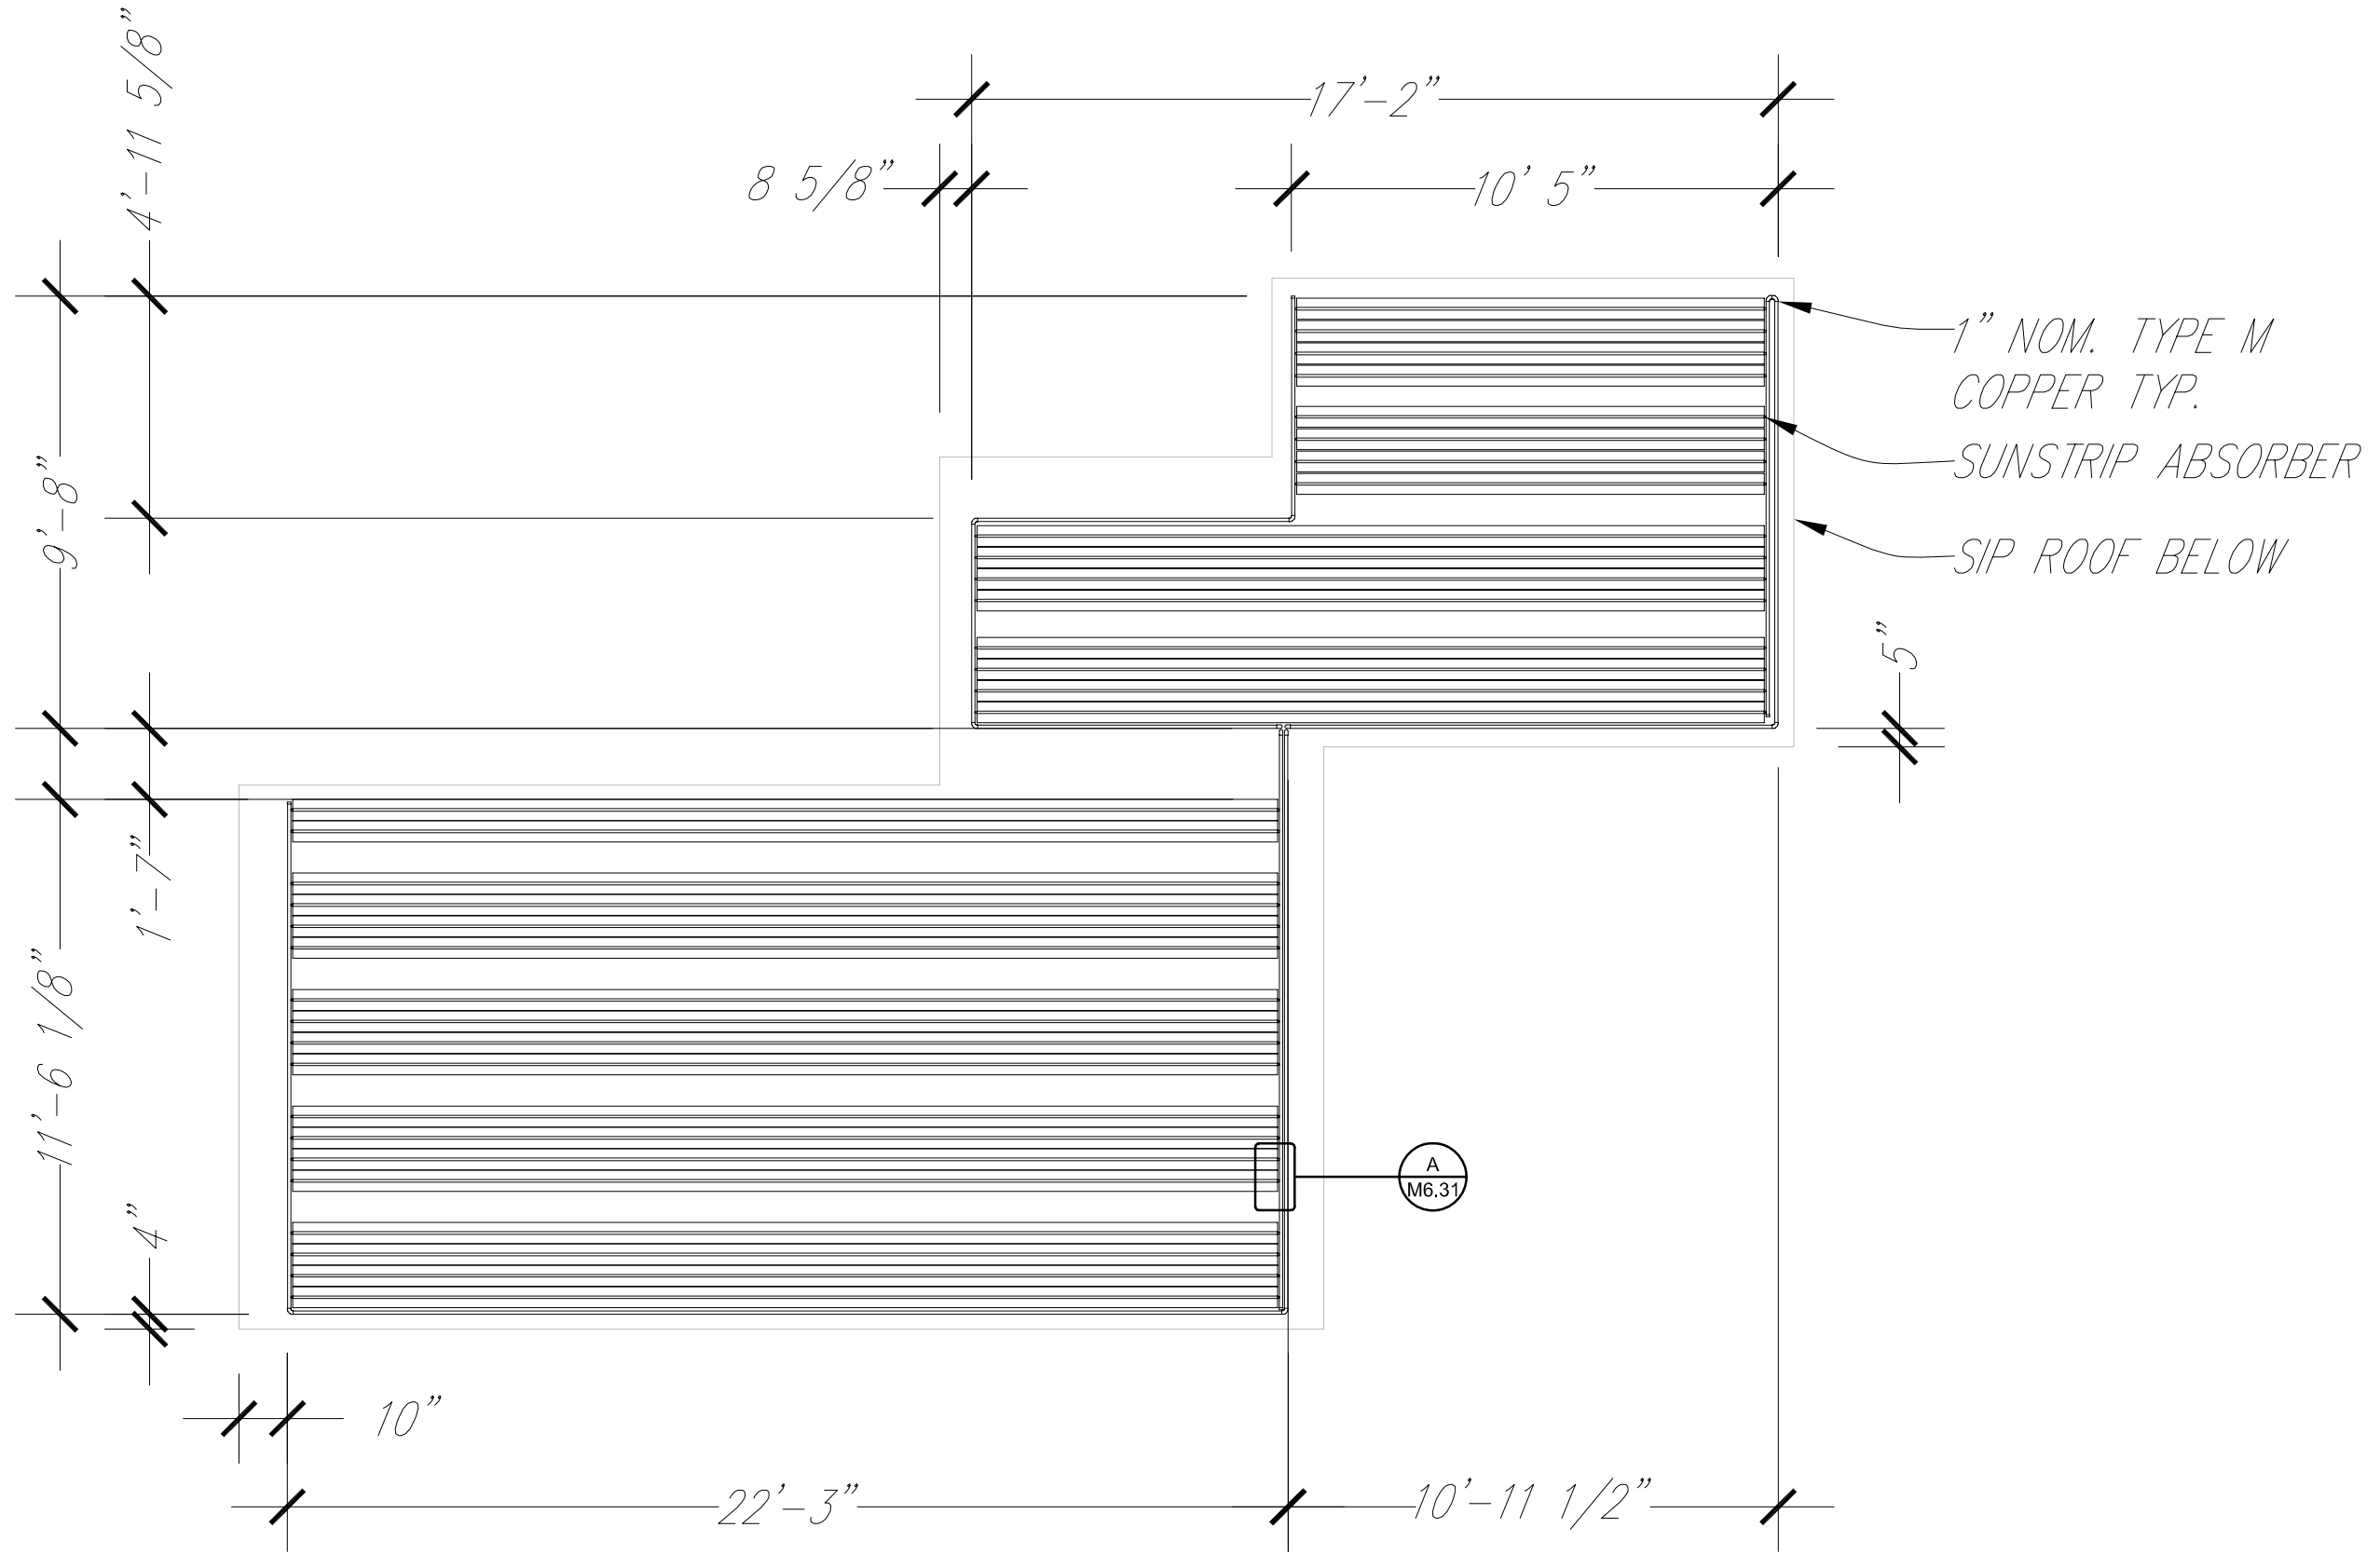

M1.34


PVT Absorber Plan

2007 Solar Decathlon

University of Colorado at Boulder  
Civil, Environmental, and Architectural Engineering  
428 UCB, Room ECCE 441  
Boulder, CO 80309-0428

Drawn by	Date	Revised	Date
C. Corbin	August 7, 2007		



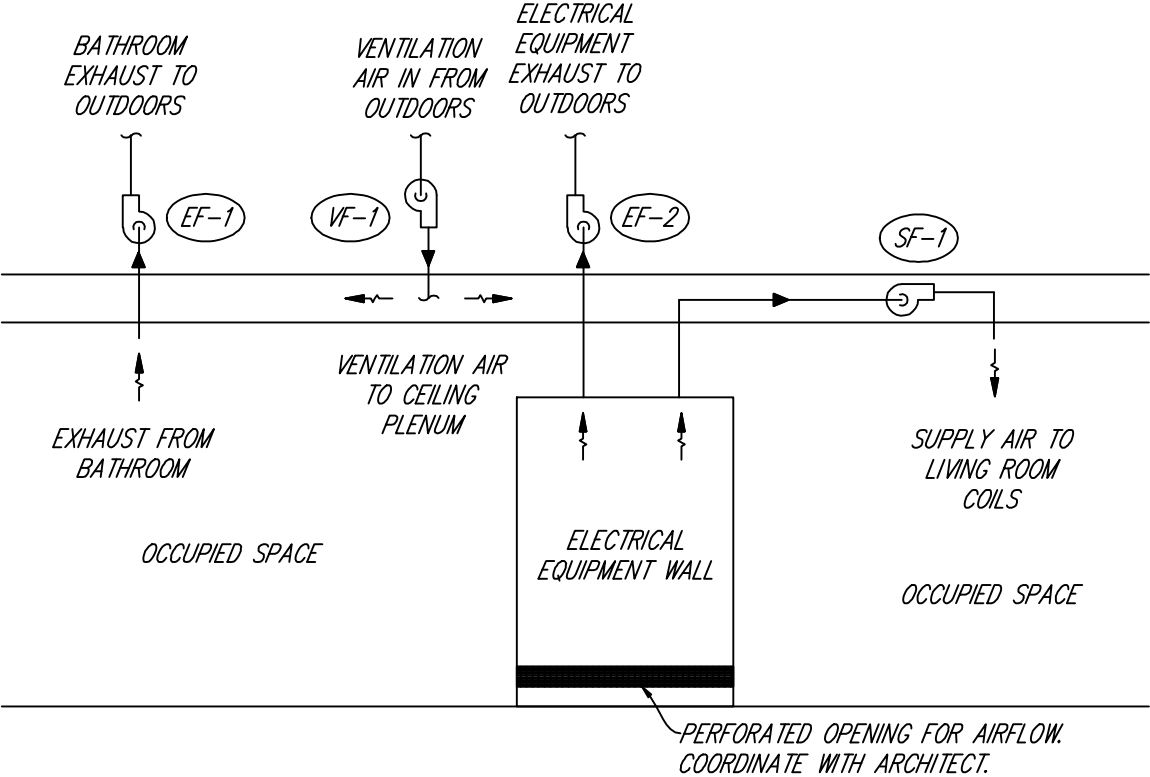

- NOTES:
1. BATHROOM EXHAUST FAN, EF-1, SHALL OPERATE INTERMITTENTLY BY MEANS OF SWITCH WITH TIMER DURING THE COOLING PERIOD. DURING THE HEATING PERIOD EF-1 SHALL OPERATE CONTINUOUSLY IN ORDER TO MAINTAIN BALANCED VENTILATION FLOW.
  2. ELECTRICAL EQUIPMENT EXHAUST, EF-2, SHALL OPERATE CONTINUOUSLY DURING THE COOLING PERIOD IN REMOVE EXCESS HEAT GENERATED BY ELECTRICAL EQUIPMENT FROM THE BUILDING AND PROVIDE BALANCED VENTILATION. DURING TEH HEATING PERIOD EF-2 SHALL NOT OPERATE.
  3. SF-1 SHALL OPERATE UPON CALL FOR ZONE HEATING OR COOLING.
  4. VENTILATION FAN, VF-1 SHALL OPERATE CONTINUOUSLY TO PROVIDE ADEQUATE VENTILATION AIR.


1 HVAC DUCTWORK ONE-LINE DIAGRAM  
N.T.S.

Drawn by	Date	Revised	Date
J.S. McNeill	August 7, 2007	J.S. McNeill	January 9, 2008


HVAC Ductwork One-line Diagram	2007 Solar Decathlon
University of Colorado at Boulder Civil, Environmental, and Architectural Engineering 428 UCB, Room ECCE 441 Boulder, CO 80309-0428	





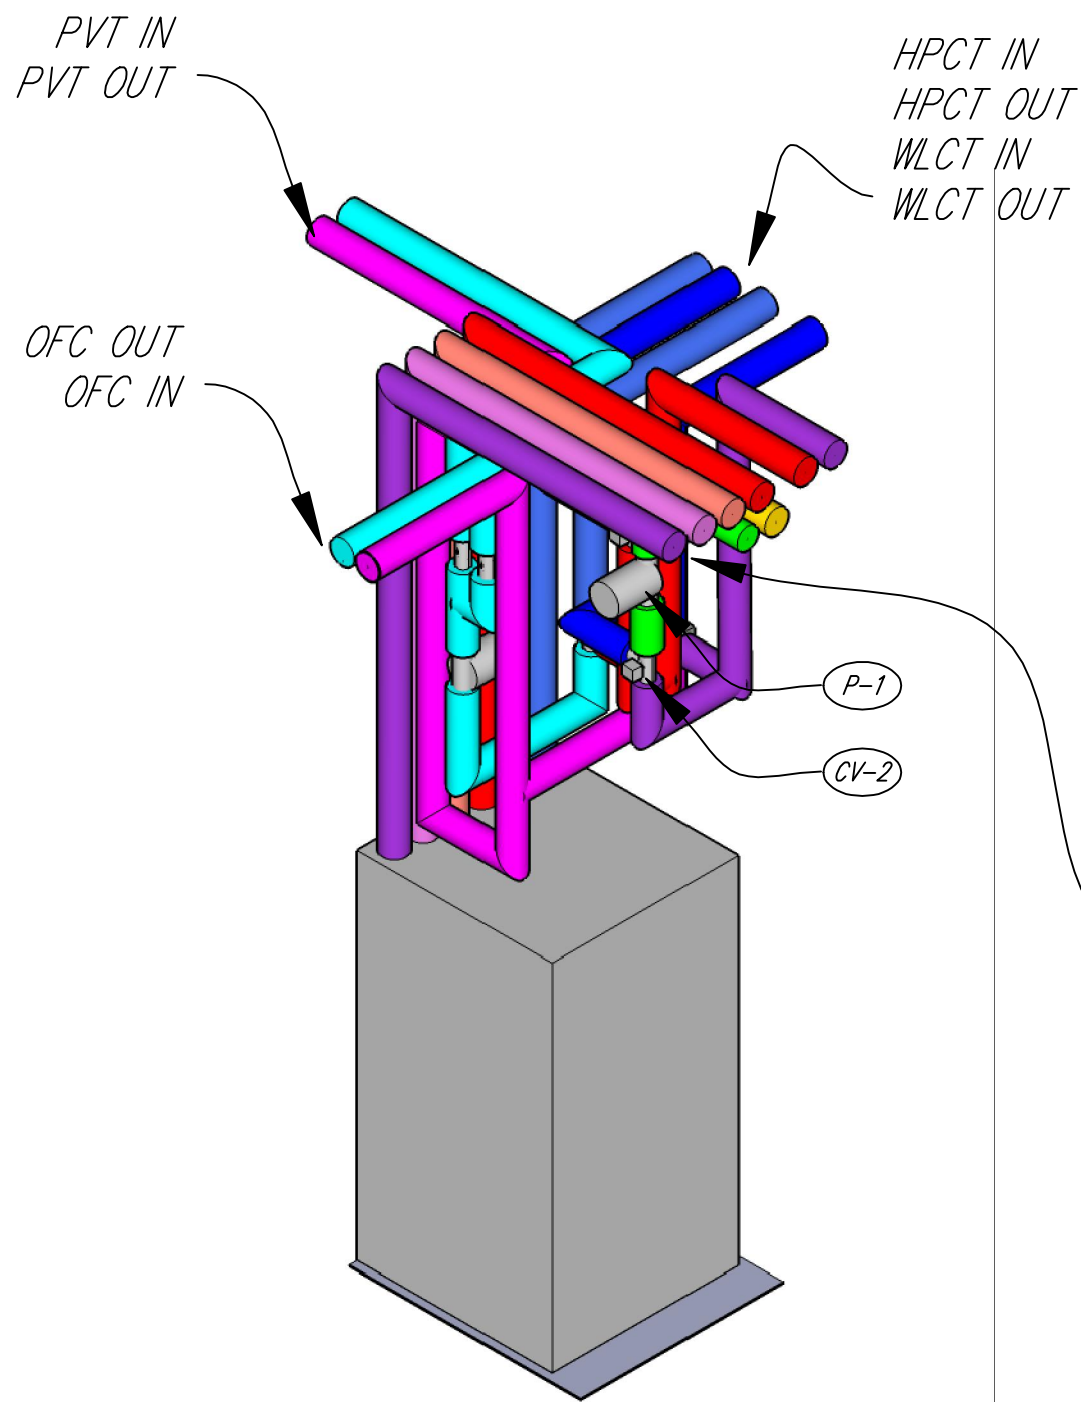


① HEAT PUMP CABINET NW ISOMETRIC  
1/2" = 1'-0"

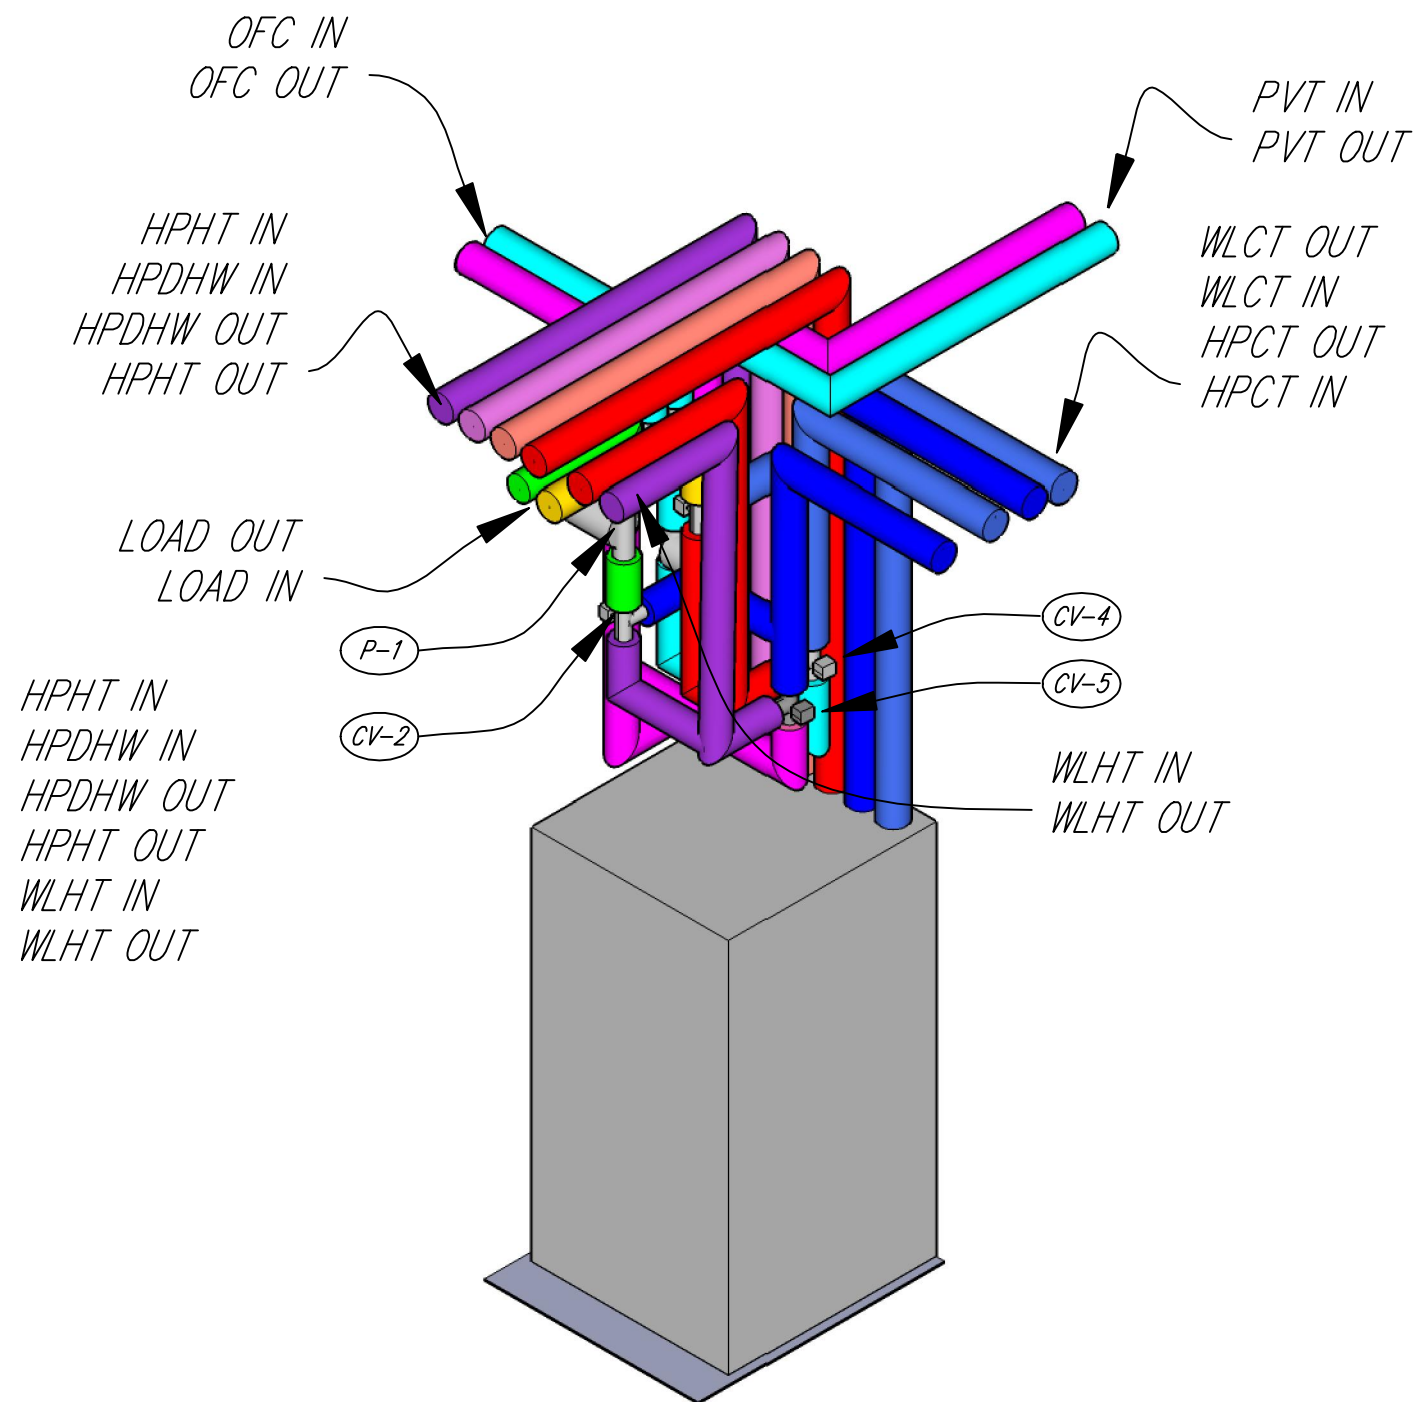


② HEAT PUMP CABINET NE ISOMETRIC  
1/2" = 1'-0"

Drawn by	Date
J.S. McNeill	August 7, 2007
Revised	Date
J.S. McNeill	January 9, 2008


Heat Pump Cabinet Piping	2007 Solar Decathlon
University of Colorado at Boulder Civil, Environmental, and Architectural Engineering 428 UCB, Room ECE 441 Boulder, CO 80509-0428	

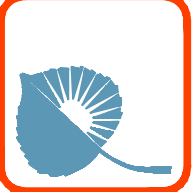

M3.01

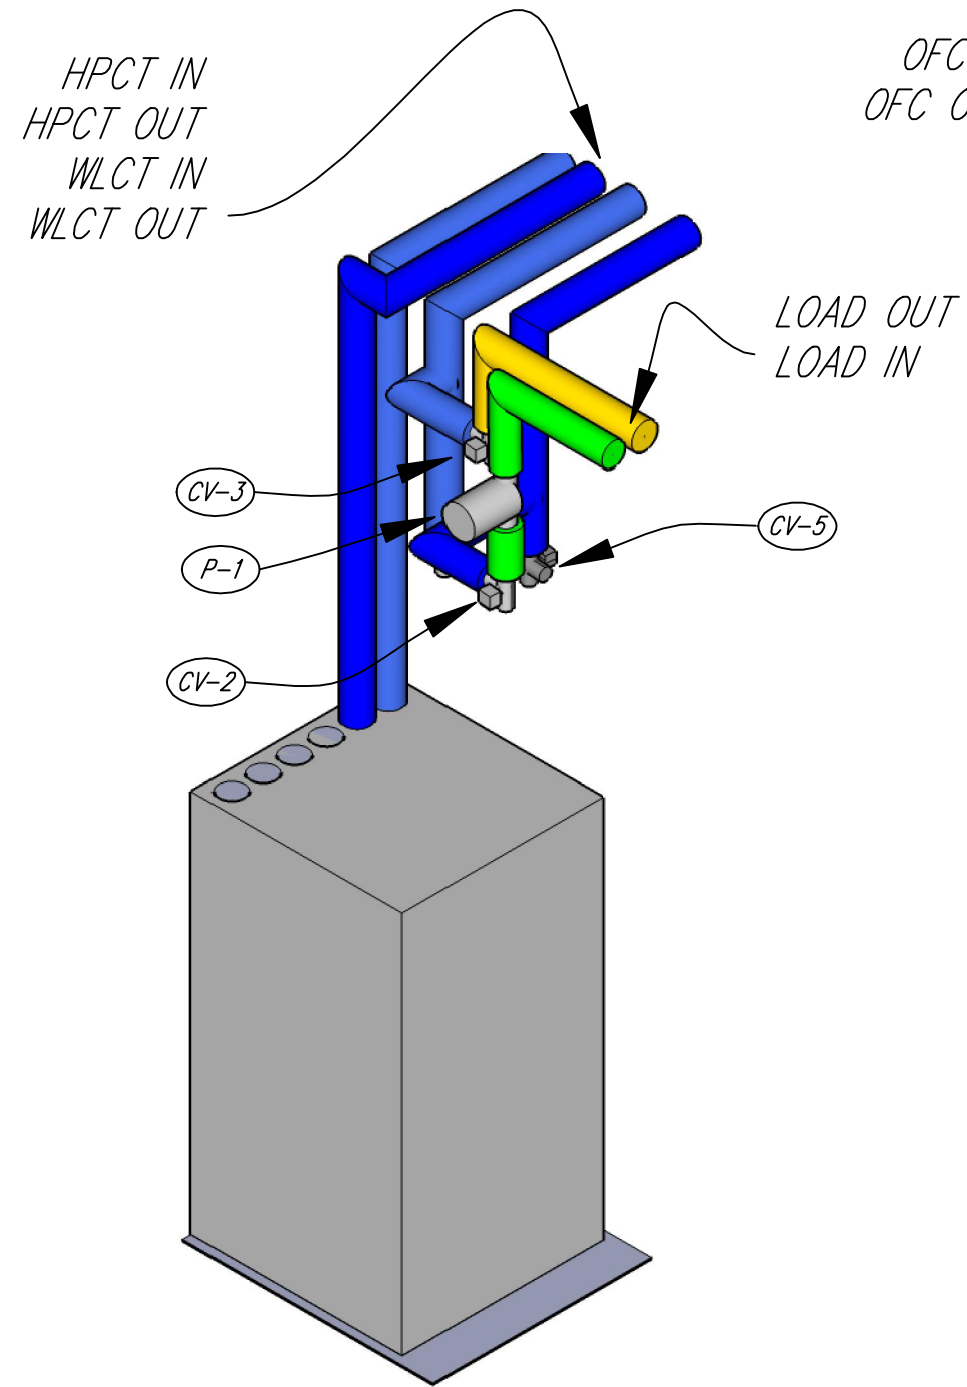


HEAT PUMP CABINET  
COLD TANK - LOADS  
NE ISOMETRIC  
①  $\frac{1}{2}" = 1'-0"$

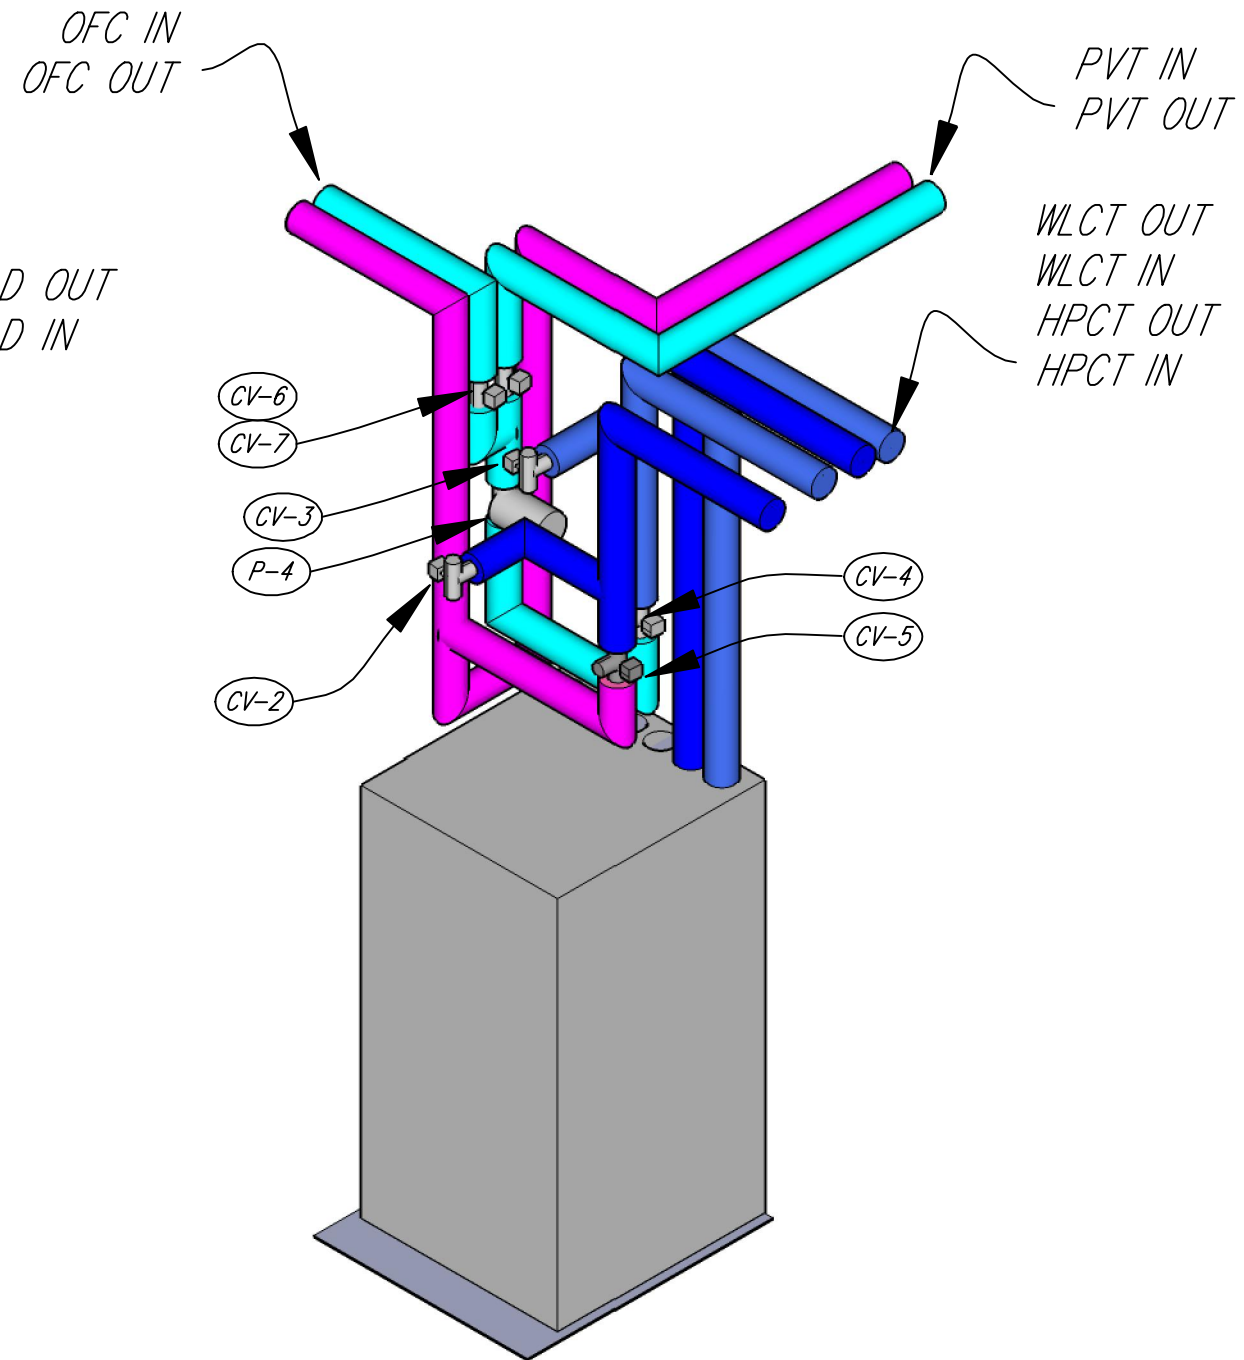


HEAT PUMP CABINET  
COLD TANK - PVT/OFC  
NW ISOMETRIC  
②  $\frac{1}{2}" = 1'-0"$


Drawn by	Date	Drawn by	Date
J.S. McNeill	August 7, 2007	J.S. McNeill	January 9, 2008
Revised		Revised	
J.S. McNeill		J.S. McNeill	

Heat Pump Cabinet Piping	2007 Solar Decathlon				
0	6"	1'	2'	4'	University of Colorado at Boulder Civil, Environmental, and Architectural Engineering 428 UCB, Room ECE 441 Boulder, CO 80309-0428

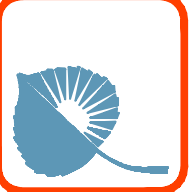


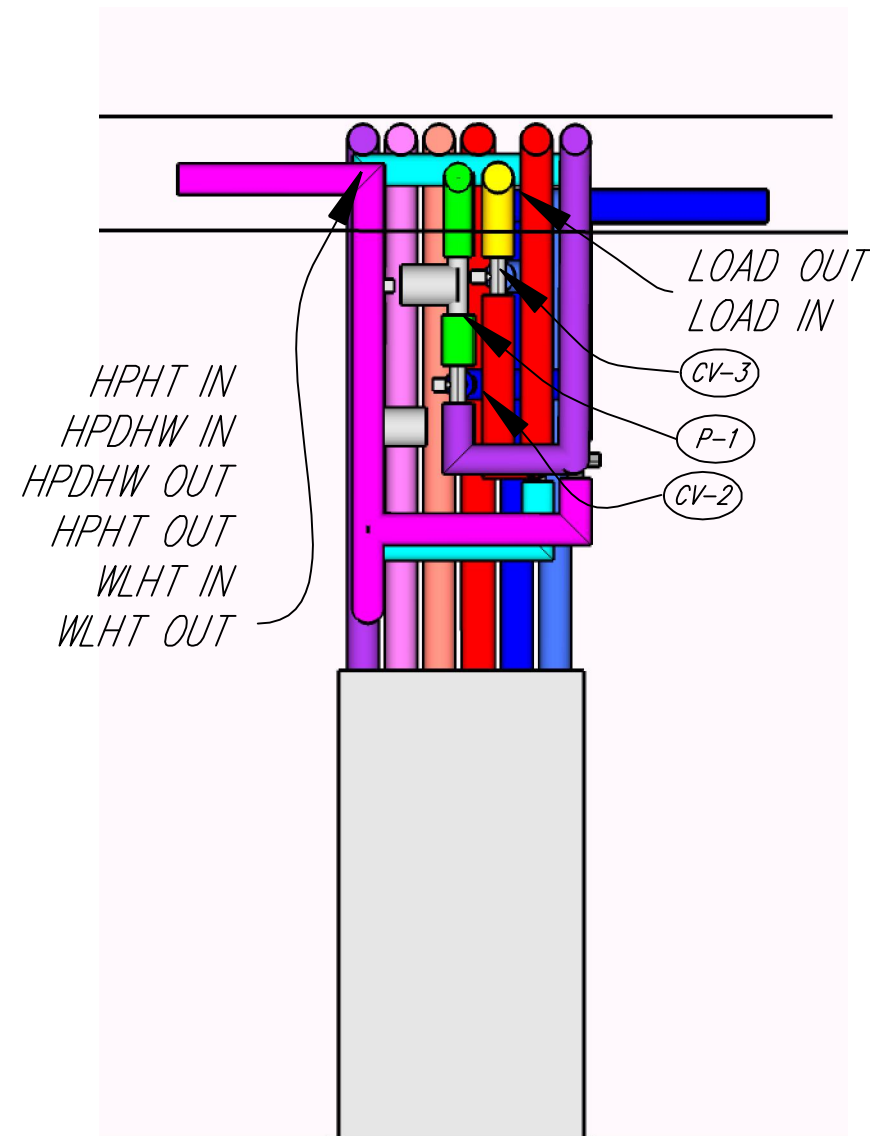

① HEAT PUMP CABINET  
NORTH ELEVATION  
 $1/2'' = 1'-0''$

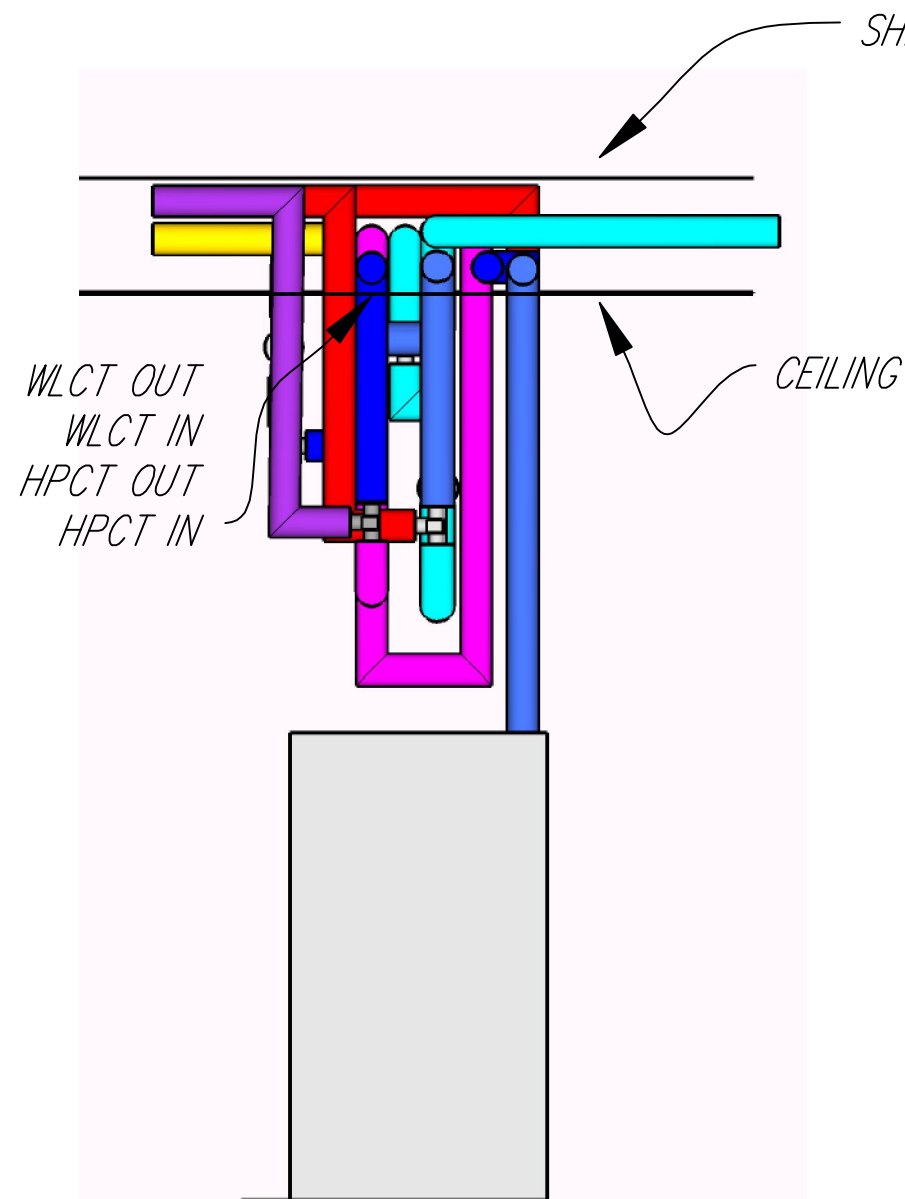

② HEAT PUMP CABINET  
WEST ELEVATION  
 $1/2'' = 1'-0''$

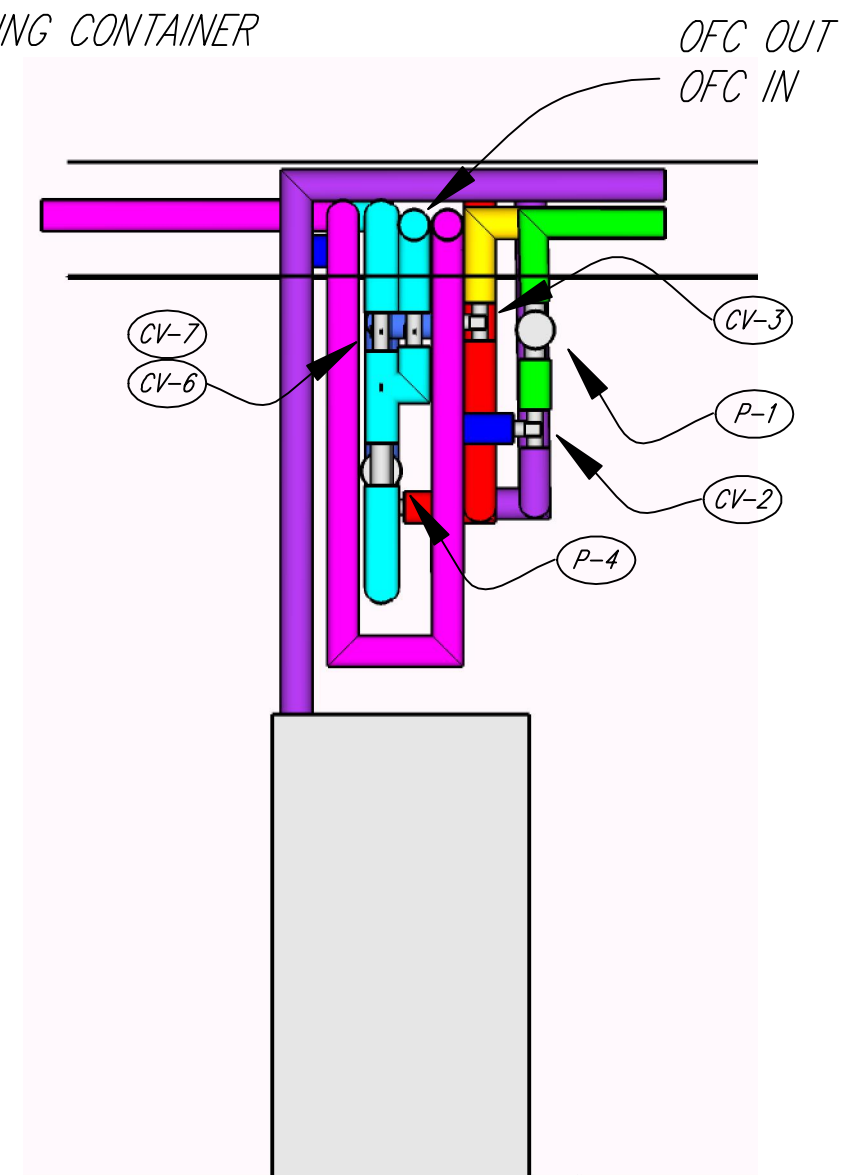

③ HEAT PUMP CABINET  
WEST ELEVATION  
 $1/2'' = 1'-0''$

Drawn by	J.S. McNeill	Date	August 7, 2007
Revised	J.S. McNeill	Date	January 9, 2008


2007 Solar Decathlon  
University of Colorado at Boulder  
Civil, Environmental, and Architectural Engineering  
428 UCB, Room ECE 441  
Boulder, CO 80509-0428

Heat Pump Cabinet Piping


0 6" 1' 2' 4'




M3.03

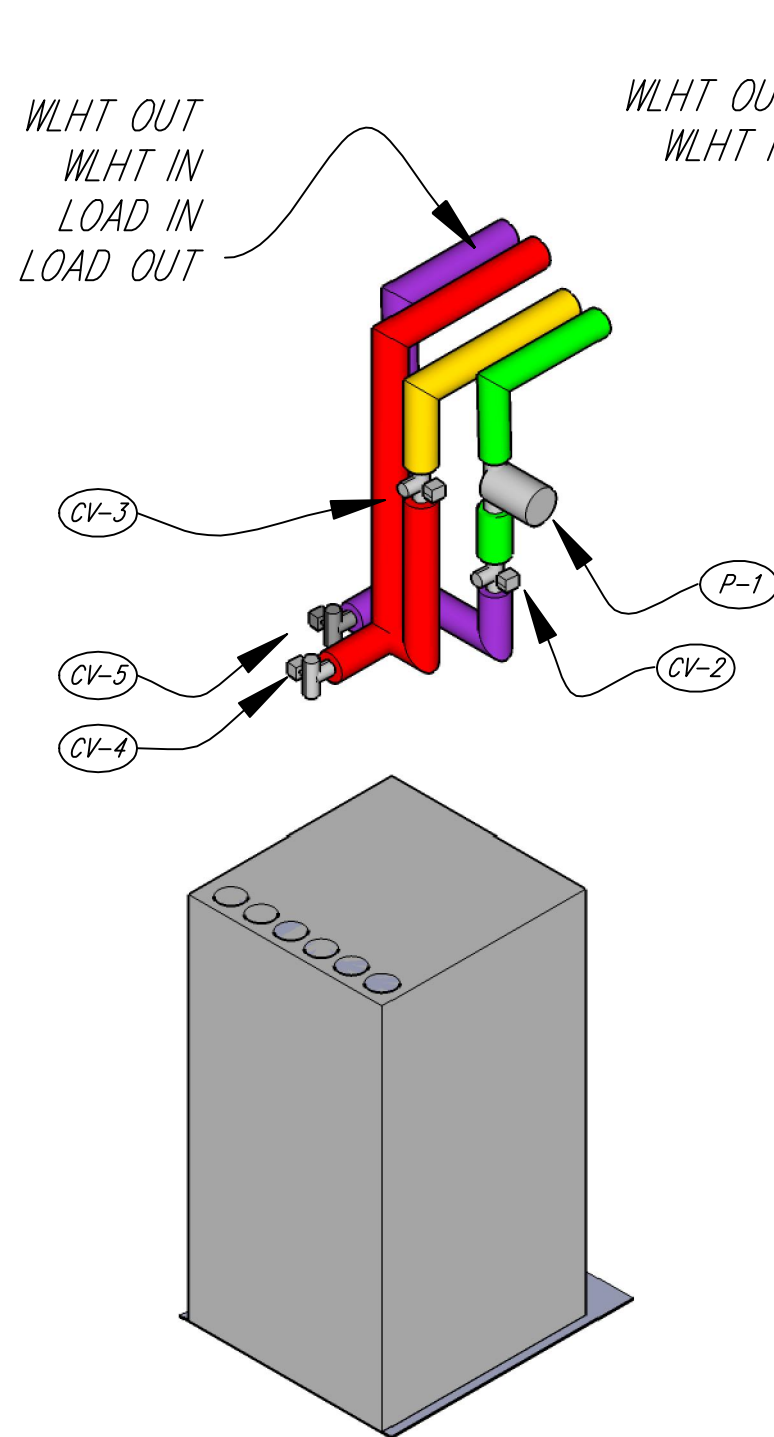

HEAT PUMP CABINET  
HOT TANK – LOADS  
SE ISOMETRIC  
①  $\frac{1}{2}" = 1'-0"$

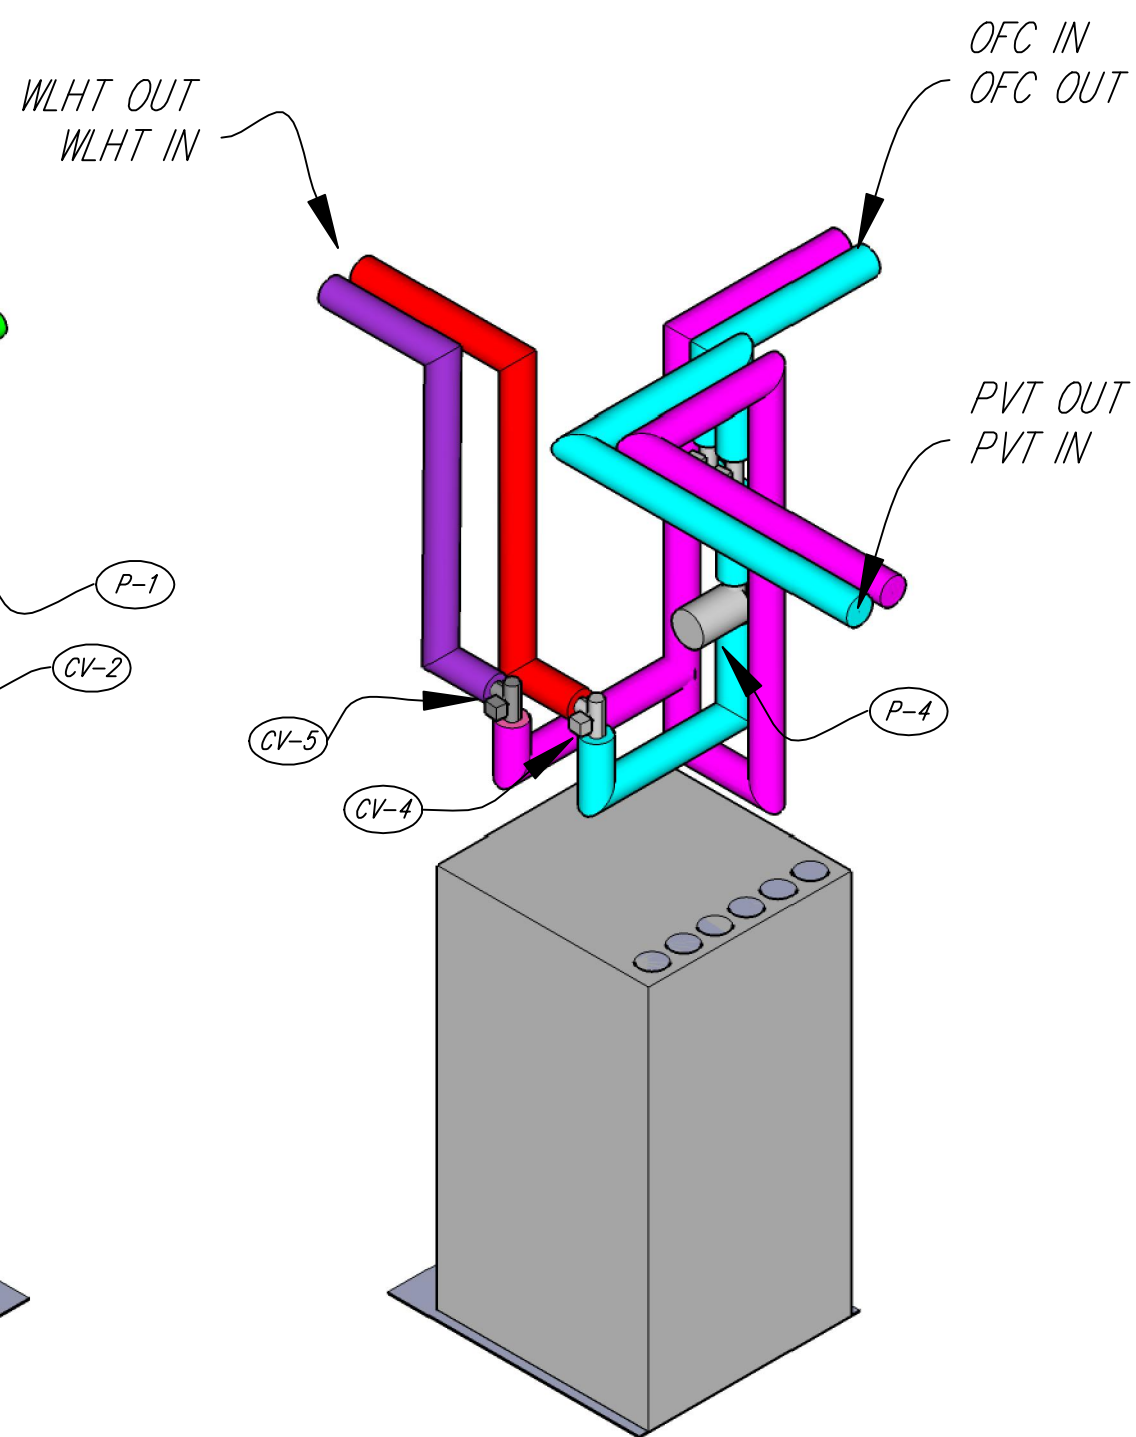

HEAT PUMP CABINET  
HOT TANK – PVT/OFC  
SW ISOMETRIC  
②  $\frac{1}{2}" = 1'-0"$

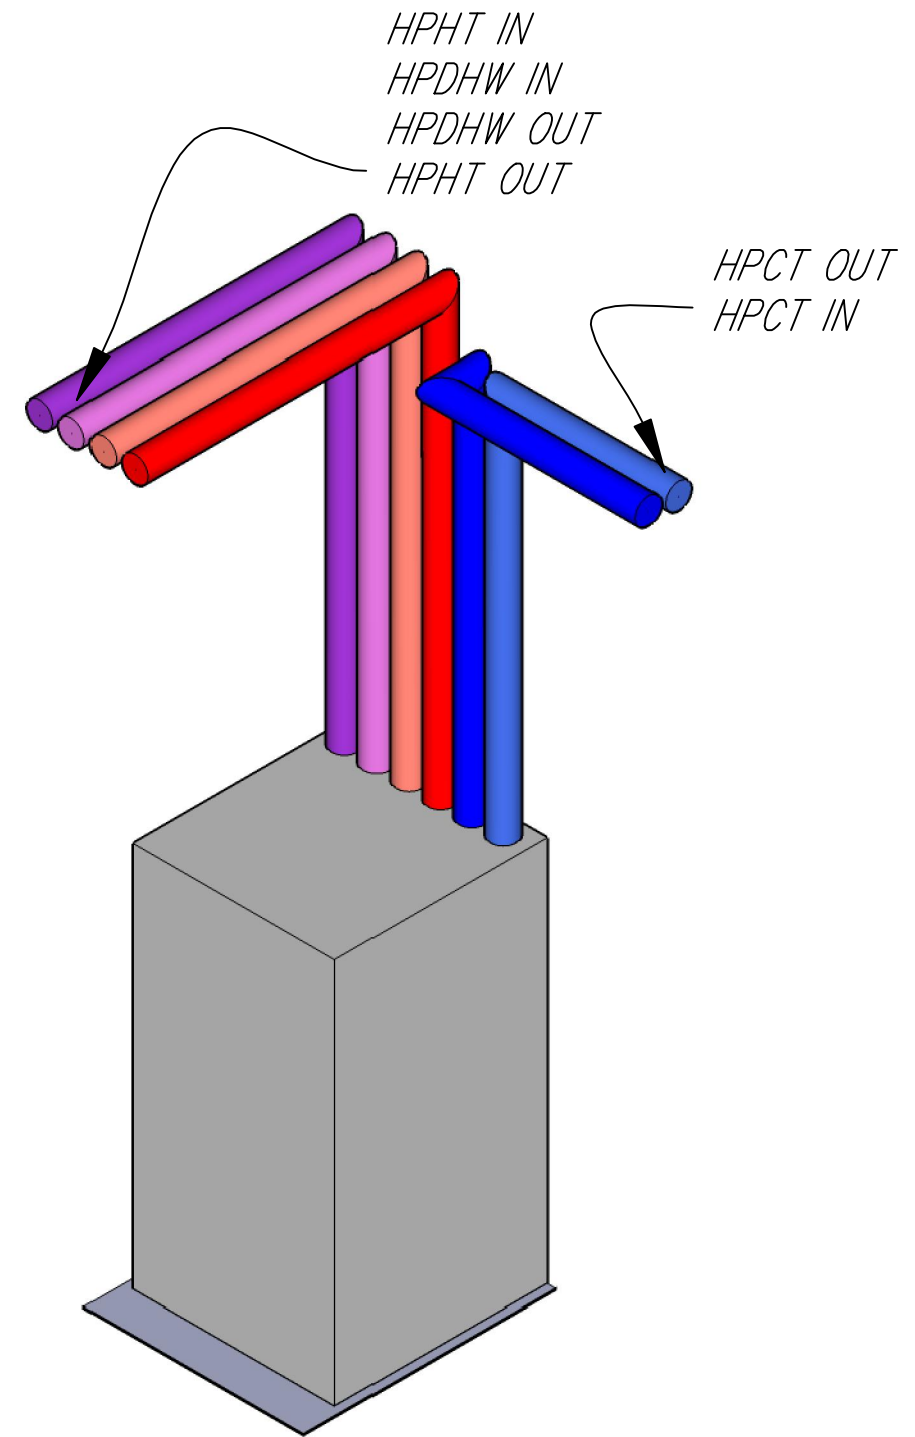


HEAT PUMP CABINET  
HEAT PUMP CONNECTIONS  
NW ISOMETRIC  
③  $\frac{1}{2}" = 1'-0"$

Drawn by	J.S. McNeill	Date	August 7, 2007
Revised	J.S. McNeill	Date	January 9, 2008

Heat Pump Cabinet Piping	2007 Solar Decathlon					University of Colorado at Boulder Civil, Environmental, and Architectural Engineering 428 UCB, Room ECE 441 Boulder, CO 80309-0428
0	6"	1'	2'	4'		



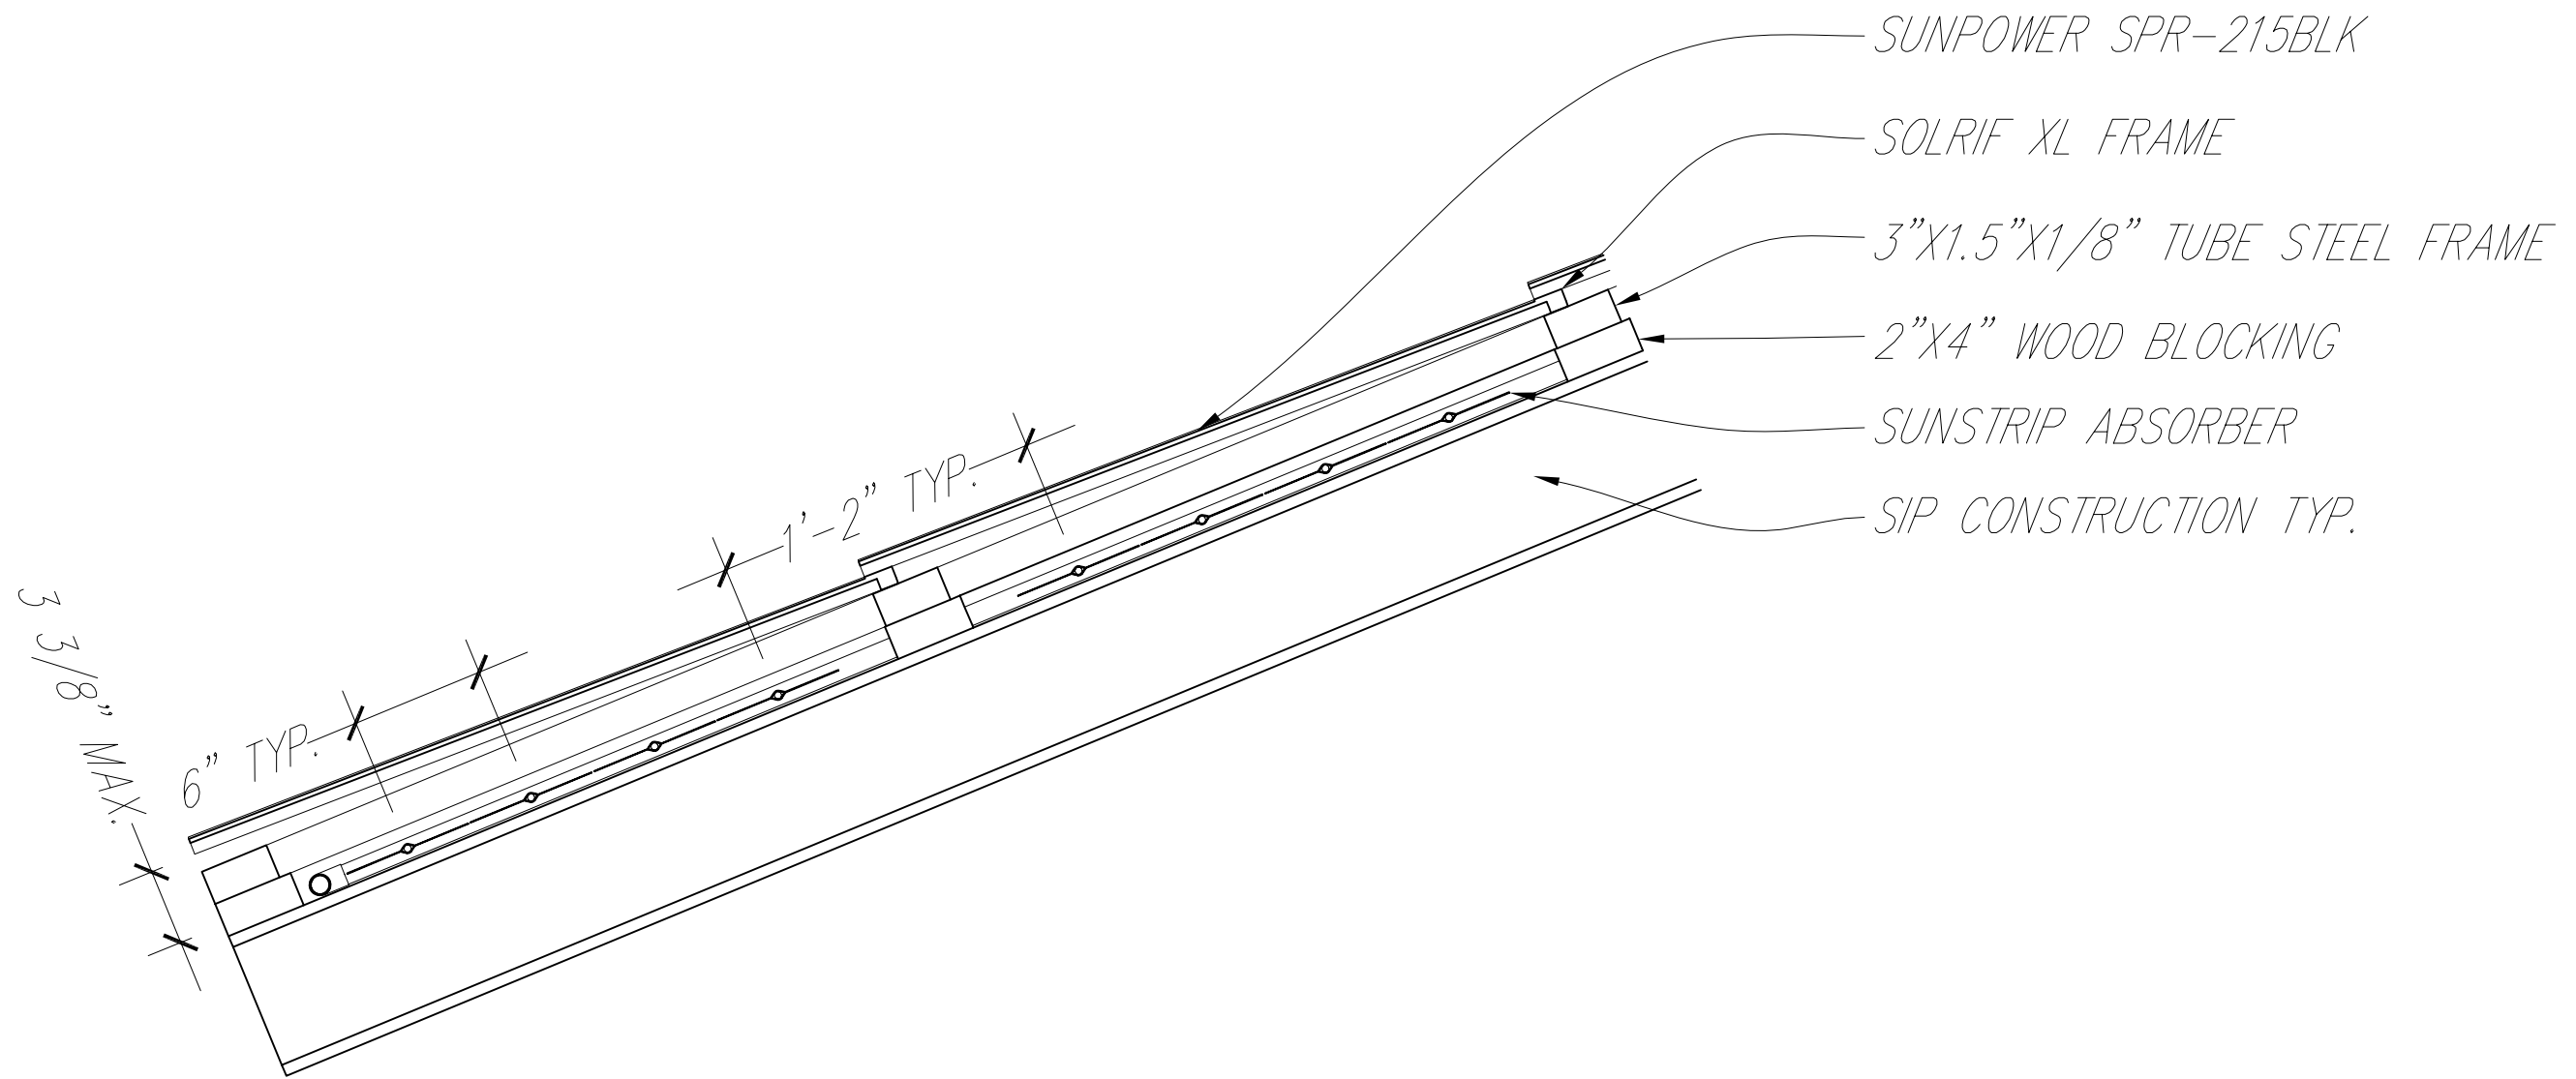

A PVT ASSEMBLY SECTION  
 1 1/2" - 1'-0"


Drawn by	Date
C. Corbin	August 7, 2007
Revised	Date

2007 Solar Decathlon	
University of Colorado at Boulder	
Civil, Environmental, and Architectural Engineering	
428 UCB, Room ECCE 441	
Boulder, CO 80309-0428	



M3.31



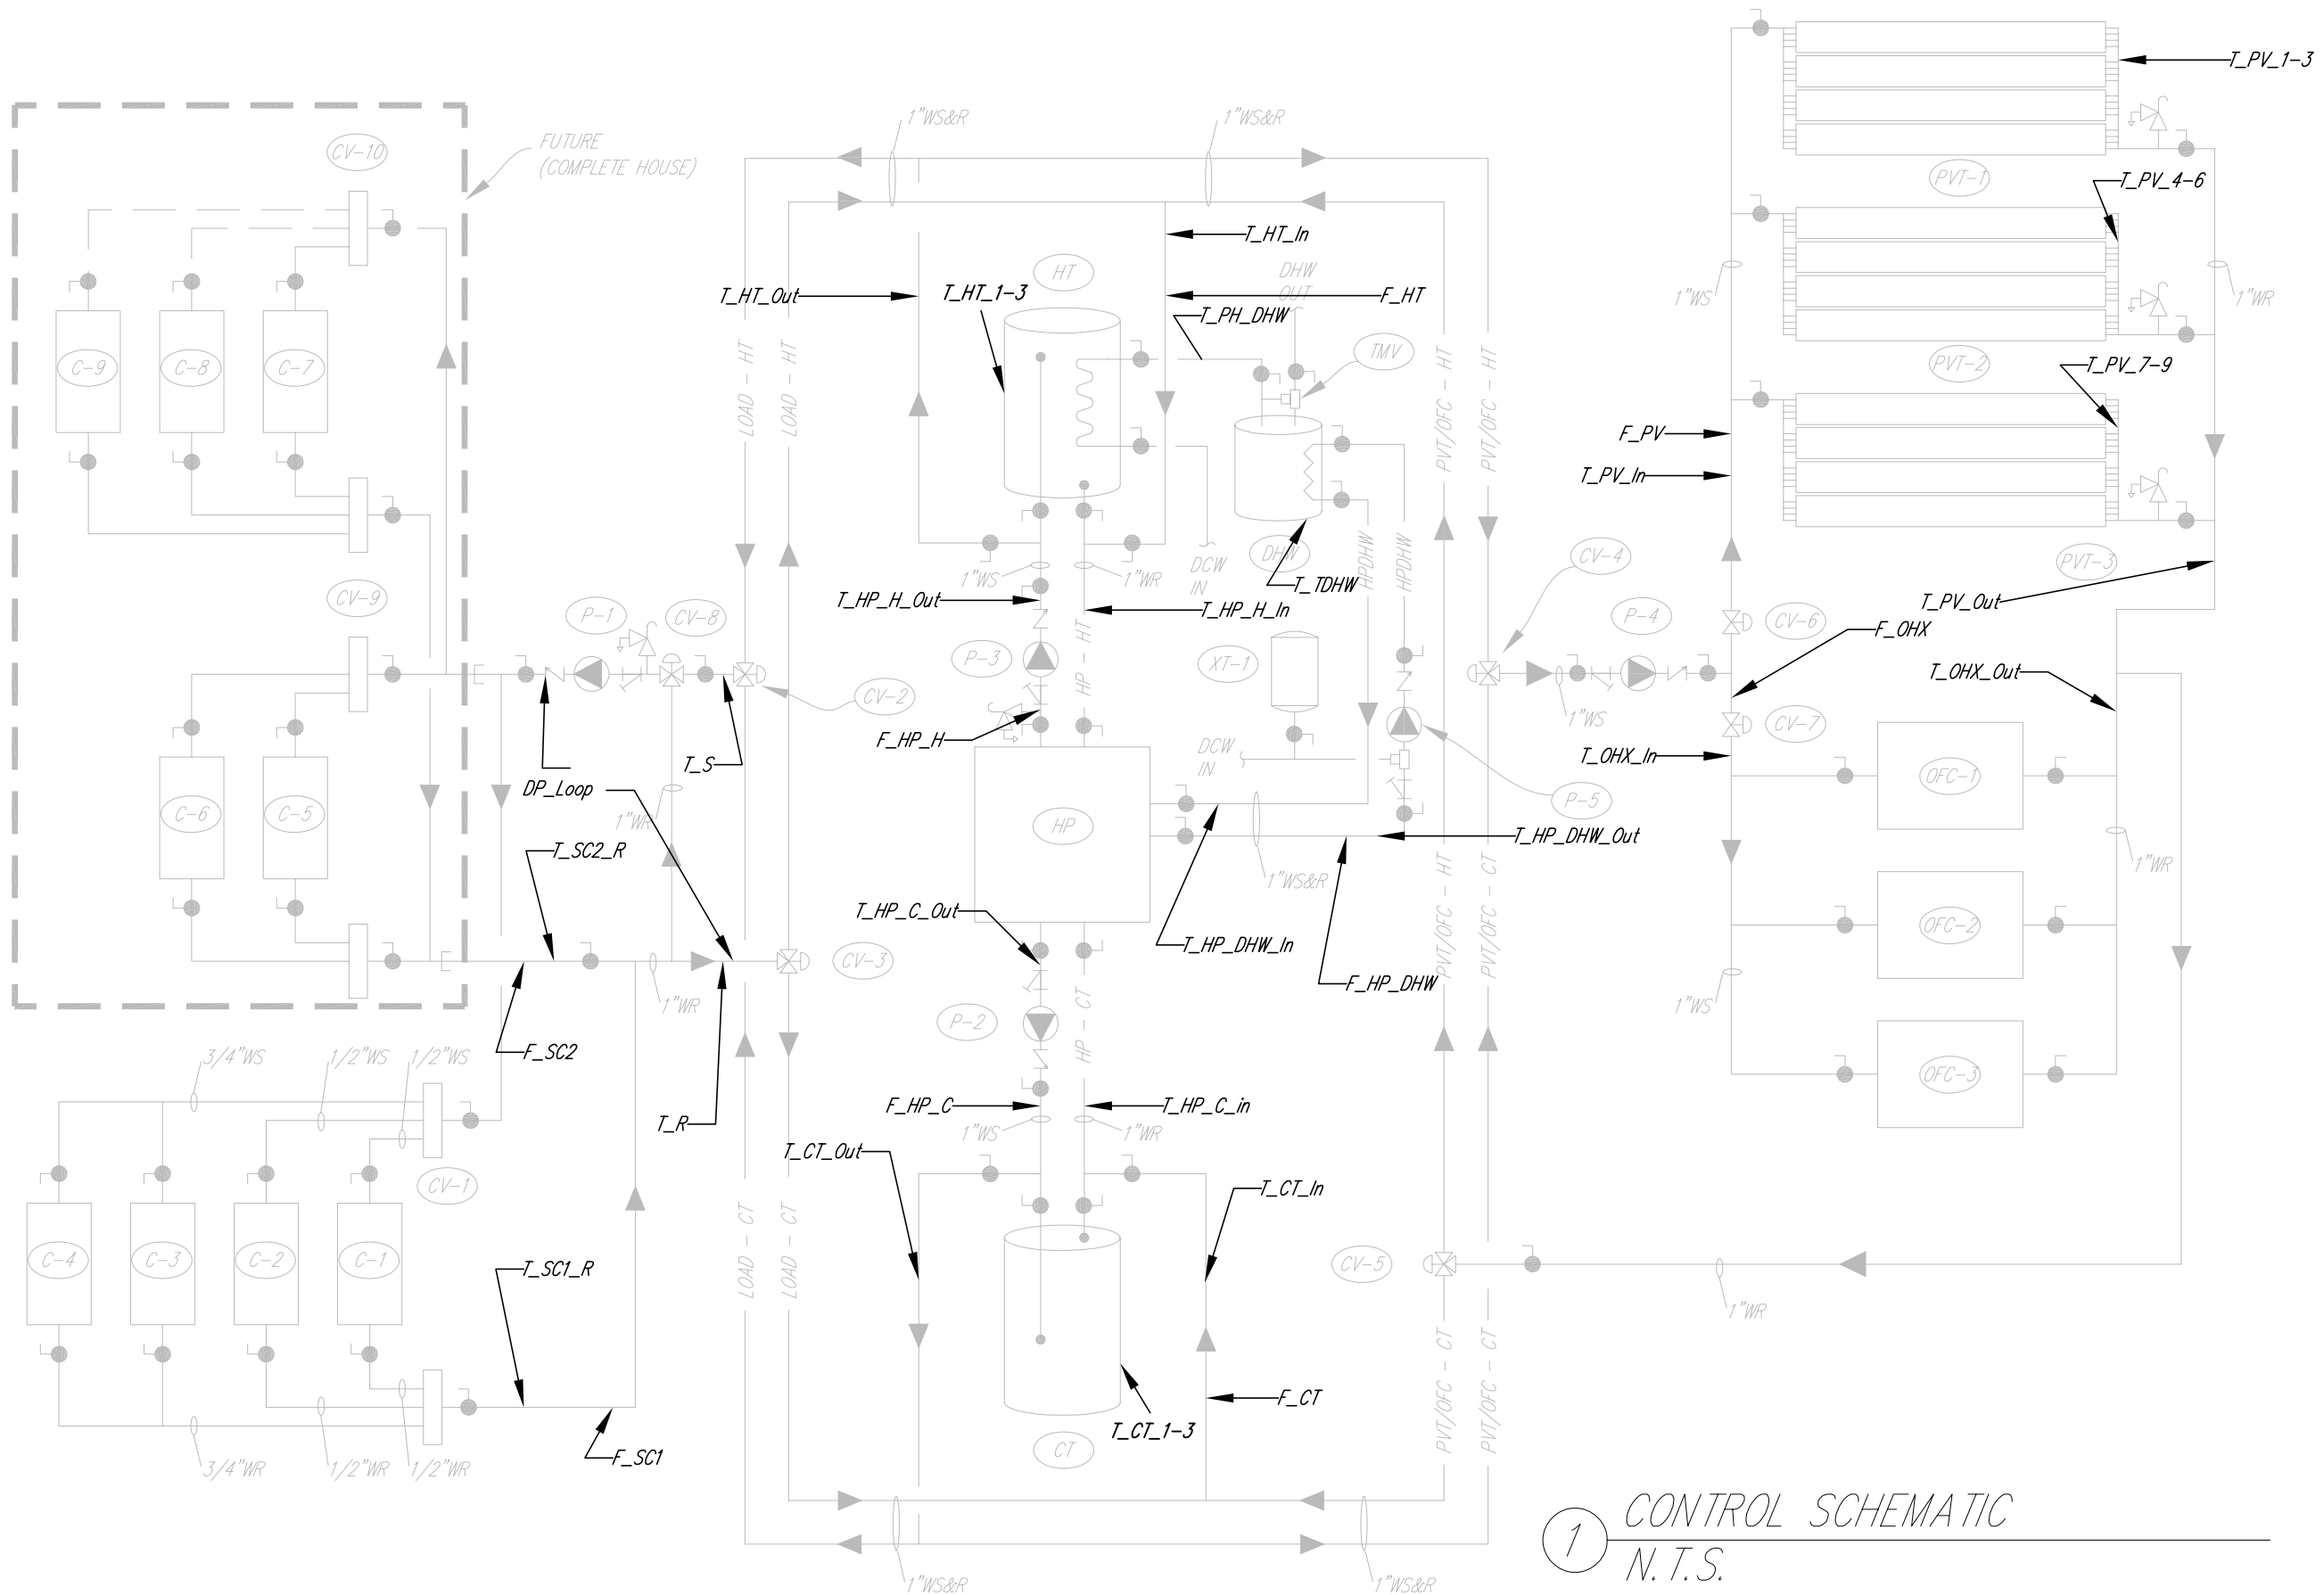

Drawn by	Date
A. Boehm	August 7, 2007
Revised	Date

2007 Solar Decathlon

University of Colorado at Boulder

Civil, Environmental, and Architectural Engineering  
428 UCB, Room ECCE 441  
Boulder, CO 80309-0428

Controls Schematic



INPUT														
	ID	Sensor	Type	Signal	Number	Description			ID	Sensor	Type	Signal	Number	Description
Zones								Hydronic Loops						
	T_ZK	Thermistor	AI	0-5 VDC	1	Kitchen temp			T_OHX_in	Thermistor	AI	0-5 VDC	1	Outdoor HX inlet temp
	T_ZLR	Thermistor	AI	0-5 VDC	1	Living room temp			T_OHX_out	Thermistor	AI	0-5 VDC	1	Outdoor HX outlet temp
	T_ZBed	Thermistor	AI	0-5 VDC	1	Comp bedroom temp			T_PV_in	Thermistor	AI	0-5 VDC	1	Solar thermal inlet temp
	T_ZBath	Thermistor	AI	0-5 VDC	1	Comp bathroom temp			T_PV_out	Thermistor	AI	0-5 VDC	1	Solar thermal outlet temp
	T_ZMast	Thermistor	AI	0-5 VDC	1	Master bedroom temp			T_S	Thermistor	AI	0-5 VDC	1	Zone loop supply temp
	T_ZGuest1	Thermistor	AI	0-5 VDC	1	Guest1 bedroom temp			T_R	Thermistor	AI	0-5 VDC	1	Zone loop return temp
	T_ZGuest2	Thermistor	AI	0-5 VDC	1	Guest2 bedroom temp			T_Zone_SC1_R	Thermistor	AI	0-5 VDC	1	Container 1 zone return temp
	T_ZMBath	Thermistor	AI	0-5 VDC	1	Master bathroom temp			T_Zone_SC2_R	Thermistor	AI	0-5 VDC	1	Container 2 zone return temp
	T_ZHall	Thermistor	AI	0-5 VDC	1	Hall temp			DP_Loop	Pressure Sensor	AI	0-5 VDC	1	Zone loop pressure drop
	T_ZGBath	Thermistor	AI	0-5 VDC	1	Guest bathroom temp			F_Zone_SC1	Flowmeter	AI or Count		1	Container 1 zone loop flow
	T_SunSp	Thermistor	AI	0-5 VDC	1	Sunspace temp			F_Zone_SC2	Flowmeter	AI or Count		1	Container 2 zone loop flow
	H_Kitchen	Humidity Sensor	AI	0-5 VDC	1	Kitchen Humidity Sensor			F_OHX	Flowmeter	AI or Count		1	Outdoor HX flow
	H_Bathroom	Humidity Sensor	AI	0-5 VDC	1	Bathroom Humidity Sensor			F_ST	Flowmeter	AI or Count		1	Solar thermal flow
	CO2_1-3	CO2 Sensors	AI		3			DHW						
									T_DHW_Mix	Thermistor	AI	0-5 VDC	1	DHW supply temp
Storage Tanks									T_Inter_DHW	Thermistor	AI	0-5 VDC	1	DHW preheat temp
	T_HT_1_1-3	Thermistor	AI	0-5 VDC	3	Hot tank temps								
	T_CT_1_1-3	Thermistor	AI	0-5 VDC	3	Cold tank temps			T_Water_main	Thermistor	AI	0-5 VDC	1	Water mains temp
	T_CT_in	Thermistor	AI	0-5 VDC	1	Cold tank inlet temp								
	T_CT_out	Thermistor	AI	0-5 VDC	1	Cold tank outlet temp		PV						
	T_HT_in	Thermistor	AI	0-5 VDC	1	Hot tank inlet temp			T_PV_1-9	Thermistor	AI	0-5 VDC	10	Photovoltaic module temps
	T_HT_out	Thermistor	AI	0-5 VDC	1	Hot tank outlet temp								
	F_CT	Flowmeter	AI or Count		1	Cold water tank flow		Weather						
	F_HT	Flowmeter	AI or Count		1	Hot water tank flow			Sol_Rad_Horiz	Radiation Sensors	AI	0-5 VDC	1	Solar radiation, horizontal
Heat Pump									Sol_Rad_PV	Radiation Sensors	AI	0-5 VDC	1	Solar radiation, roof plane
	T_HP_C_in	Thermistor	AI	0-5 VDC	1	HP cold-side inlet temp			Wind_Dir	Potentiometer	AI	0-5 VDC	1	Wind direction
	T_HP_C_out	Thermistor	AI	0-5 VDC	1	HP cold-side outlet temp			Wind_Speed	Anemometer	Count		1	Wind speed
	T_HP_H_in	Thermistor	AI	0-5 VDC	1	HP hot-side inlet temp			H_OA	Humidity Sensor	AI	0-5 VDC	1	Outdoor humidity
	T_HP_H_out	Thermistor	AI	0-5 VDC	1	HP hot-side outlet temp			T_OA	Thermistor	AI	0-5 VDC	1	Outdoor temperaure
	T_HP_DHW_in	Thermistor	AI	0-5 VDC	1	HP DHW inlet temp		Power						
	T_HP_DHW_out	Thermistor	AI	0-5 VDC	1	HP DHW outlet temp			DC_Shunt_1-4	DC Shunt	AI		4	Various DC power
	F_HP_C	Flowmeter	AI or Count		1	HP cold-side flow			AC_Sub_1-16	AC Submeters	AI or Count		16	Various AC power
	F_HP_H	Flowmeter	AI or Count		1	HP hot-side flow								
	F_HP_DHW	Flowmeter	AI or Count		1	HP DHW flow								
													91	Total

OUTPUT														
ID	Type	Device	Device Voltage	Signal	Number	Description		ID	Type	Device	Device Voltage	Signal	Number	Description
Valve_Z1	DO	Water valve, 2-way	24 VAC	NA	3	Zone water control valves (On CV 1)		Ctrl_P2*	DO	Const. Spd Pump	115 VAC	NA	1	HP cold-side pump on/off
Valve_Z4	DO	Water valve, 2-way	25 VAC	NA	5	Zone water control valves (On CV 9-10)		Ctrl_P3*	DO	Const. Spd Pump	115 VAC	NA	1	HP hot-side pump on/off
SF_1-2	DO	Fan	24 VAC	NA	2	Supply air to zones		Ctrl_P4	DO	Variable Spd. Pump	115 VAC	NA	1	Roof heat exchanger pump on/off
SF_3-4	DO	Fan	24 VAC	NA	2	Supply air to zones		Ctrl_P4	AO	Variable Spd. Pump	NA	2-10 VDC	1	Roof heat exchanger pump speed signal
EF_1	DO	Fan	24 VAC	NA	1	Bathroom exhaust fan		Ctrl_P5*	DO	Const. Spd Pump	115 VAC	NA	1	HP DHW pump on/off
EF_2	DO	Fan	24 VAC	NA	1	Electrical equipment exhaust fan		CV_4	AO	Three Way Control Valve	NA	2-10 VDC	1	Control valve from hot tank or cold tank to air and PV
EF_3	DO	Fan	24 VAC	NA	1	Bathroom exhaust fan		CV_5	AO	Three Way Control Valve	NA	2-10 VDC	1	Control valve from hot tank or cold tank to air and PV
VF_1	DO	Fan	24 VAC	NA	1	Ventilation air from outdoors		CV_6	DO	Two Way Control Valve	NA	2-10 VDC	1	Control valve to PV
VF_2	DO	Fan	24 VAC	NA	1	Ventilation air from outdoors		CV_7	DO	Two Way Control Valve	NA	2-10 VDC	1	Control valve to outside air
Ctrl_HP	DO	Heat Pump Controler	208 VAC	NA	1	Heat pump on/off		CV_8	AO	Three Way Control Valve	NA	2-10 VDC	1	Mixing valve for zone supply flow
Ctrl_P1	DO	Variable Spd. Pump	NA	NA	1	Zone loop pump on/off		OFC_1-3	DO	Fan	115 VAC	NA	3	Outside air HX fan on/off
Ctrl_P1	AO	Variable Spd. Pump	NA	2-10 VDC	1	Zone loop pump speed signal								
*- Controlled by heat pump														
														Totals
													28	DO
													5	AO

1

CONTROL DEVICES

N.T.S.


Drawn by	Date	Revised	Date
A. Boehm	August 7, 2007		

2007 Solar Decathlon

University of Colorado at Boulder


Civil, Environmental, and Architectural Engineering  
428 UCB, Room ECCE 441  
Boulder, CO 80309-0428



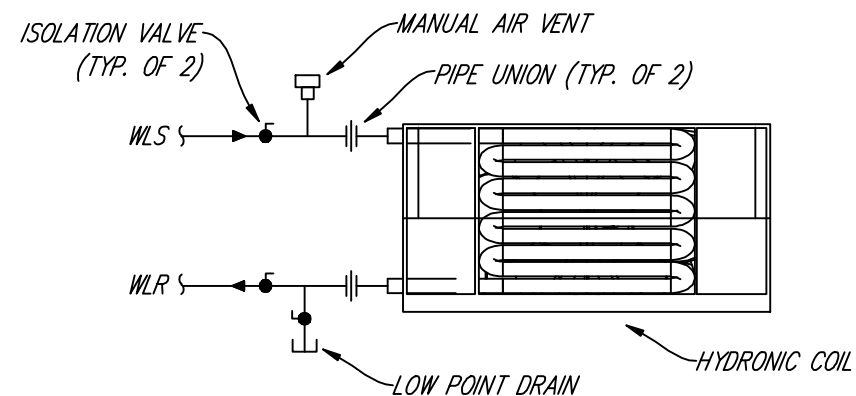

NOTE: INDIVIDUAL ZONE COILS ARE TO BE BALANCED AT MULTI-ZONE CONTROL VALVES.


## 1 TYPICAL HYDRONIC COIL PIPING DETAIL N.T.S.

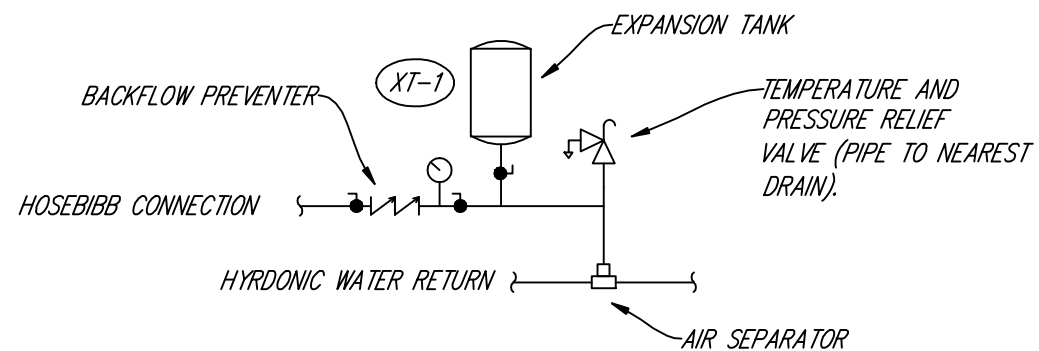


## 2 HPDHW LOOP FILL POINT DIAGRAM N.T.S.

Drawn by	Date
J.S. McNeill	August 7, 2007
Revised	Date
J.S. McNeill	January 9, 2008

2007 Solar Decathlon	General Mechanical Details
University of Colorado at Boulder Civil, Environmental, and Architectural Engineering 428 UCB, Room ECE 441 Boulder, CO 80509-0428	

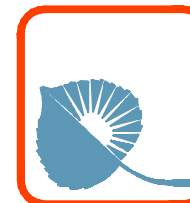

M6.01

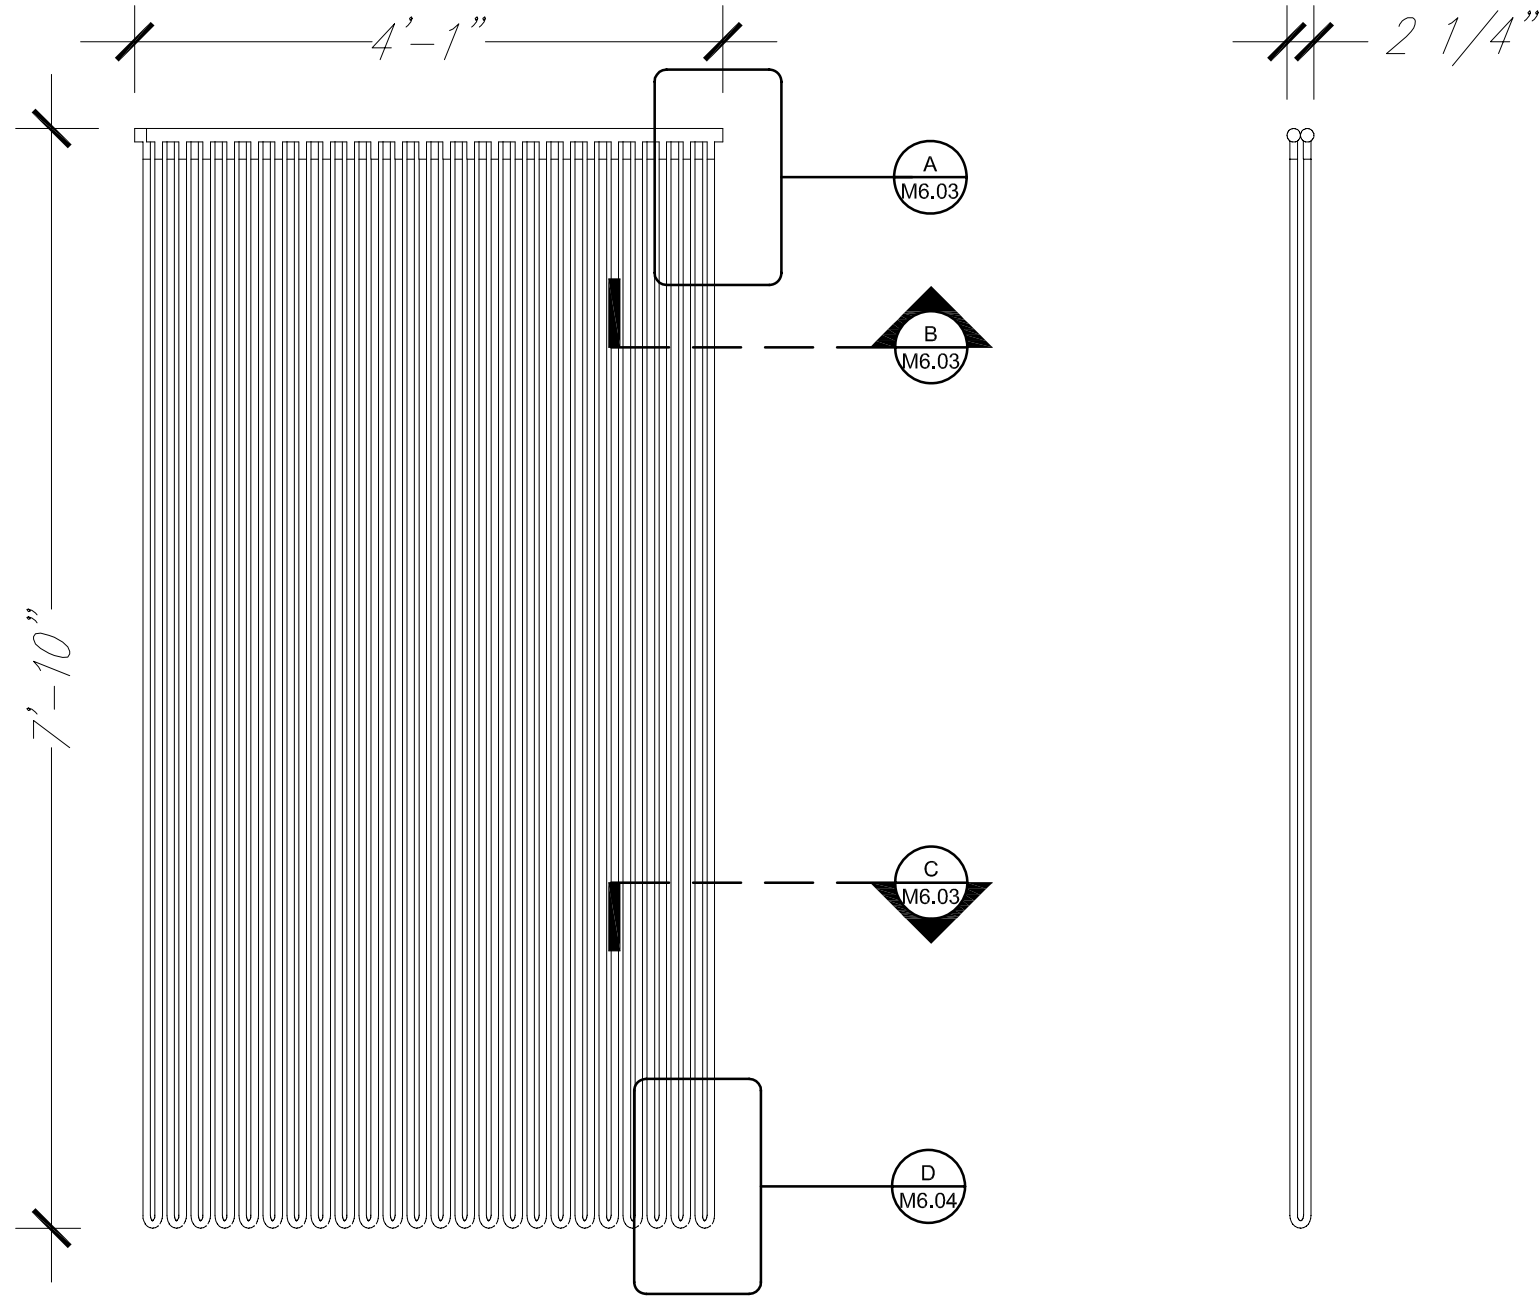

① *RADIANT ELEMENT FRONT*  
3/4" - 1'-0"

① *RADIANT ELEMENT SIDE*  
3/4" - 1'-0"



M6.02


Radiant Element Details

2007 Solar Decathlon




University of Colorado at Boulder  
Civil, Environmental, and Architectural Engineering  
428 UCB, Room ECCE 441  
Boulder, CO 80309-0428


Drawn by	Date
C. Corbin	August 7, 2007
Revised	Date

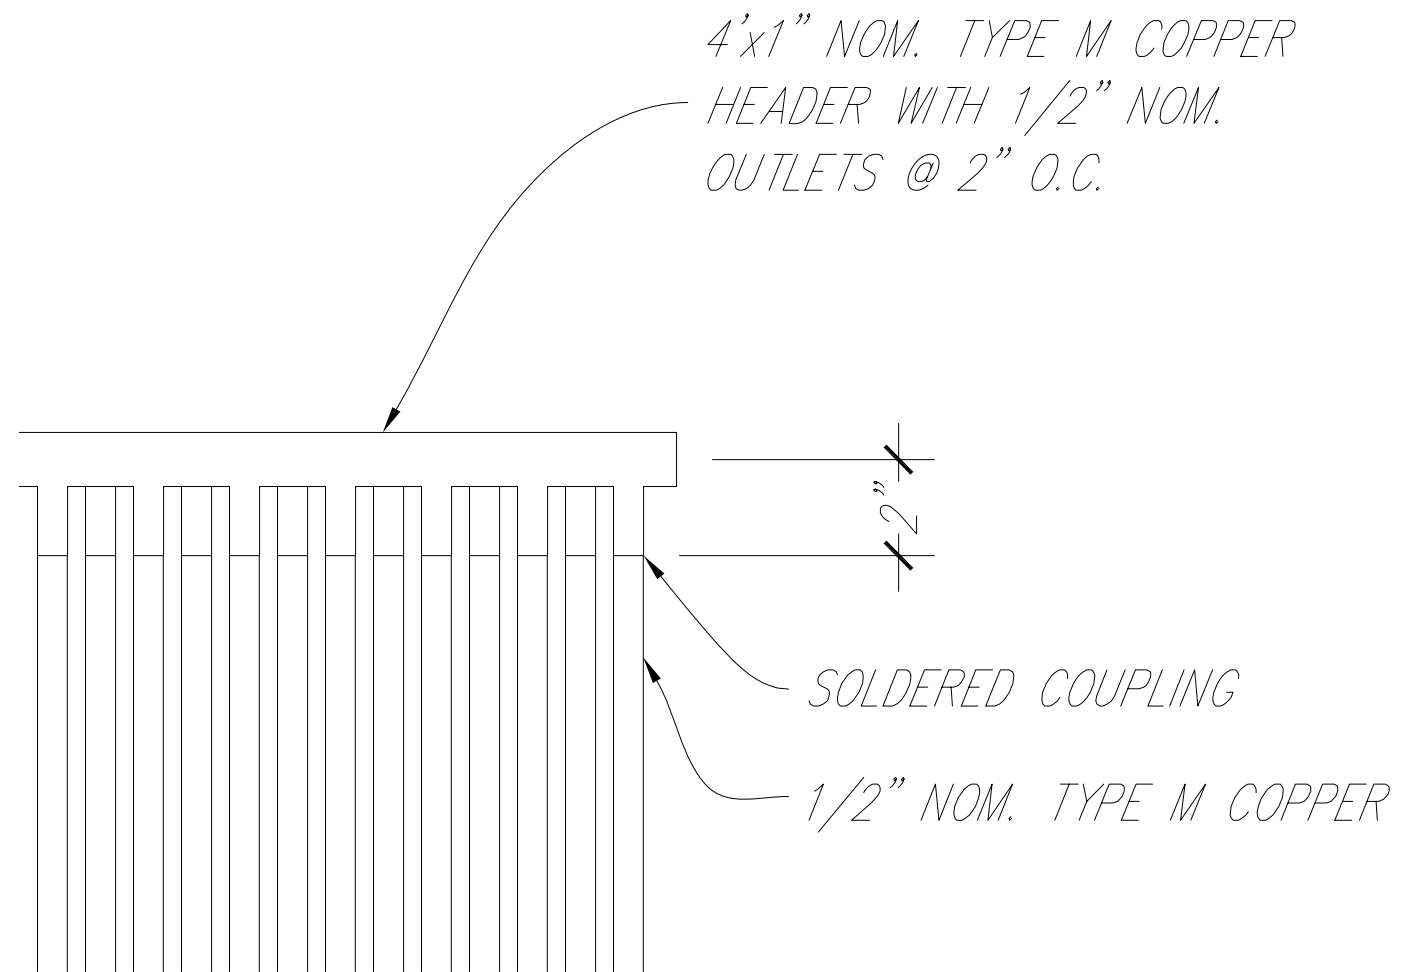

**A** RADIANT ELEMENT DETAILS  
3" - 1'-0"

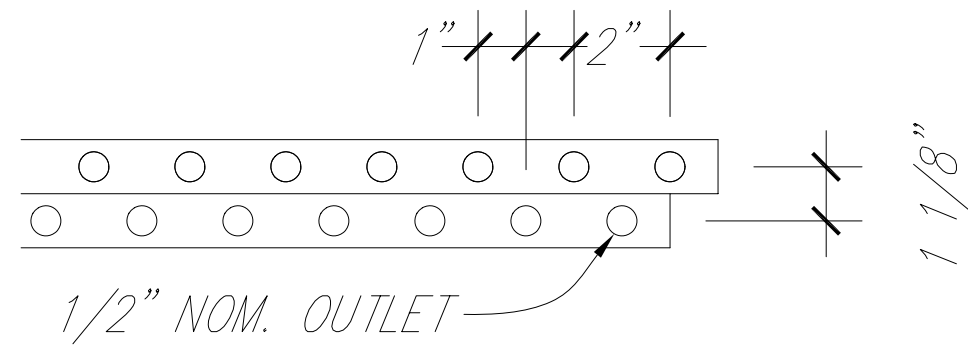

**B** RADIANT ELEMENT SECTION  
3" - 1'-0"

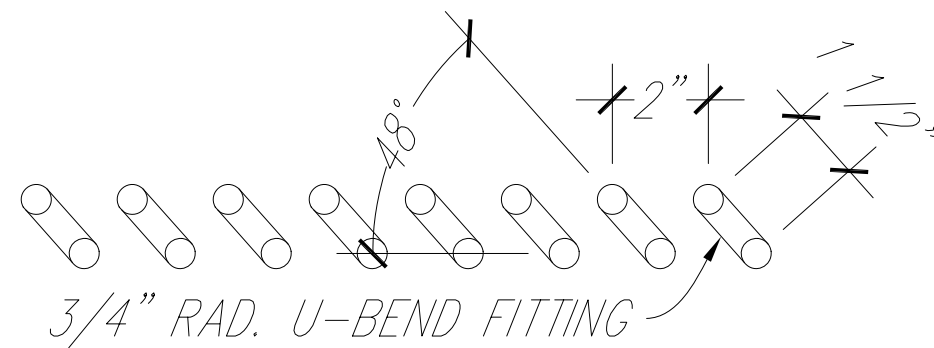


**C** RADIANT ELEMENT SECTION  
3" - 1'-0"

Drawn by	Date
C. Corbin	August 7, 2007
Revised	Date


Radiant Element Details	2007 Solar Decathlon
University of Colorado at Boulder Civil, Environmental, and Architectural Engineering 428 UCB, Room ECCE 441 Boulder, CO 80309-0428	
0	1'
1.5"	
3"	
6"	





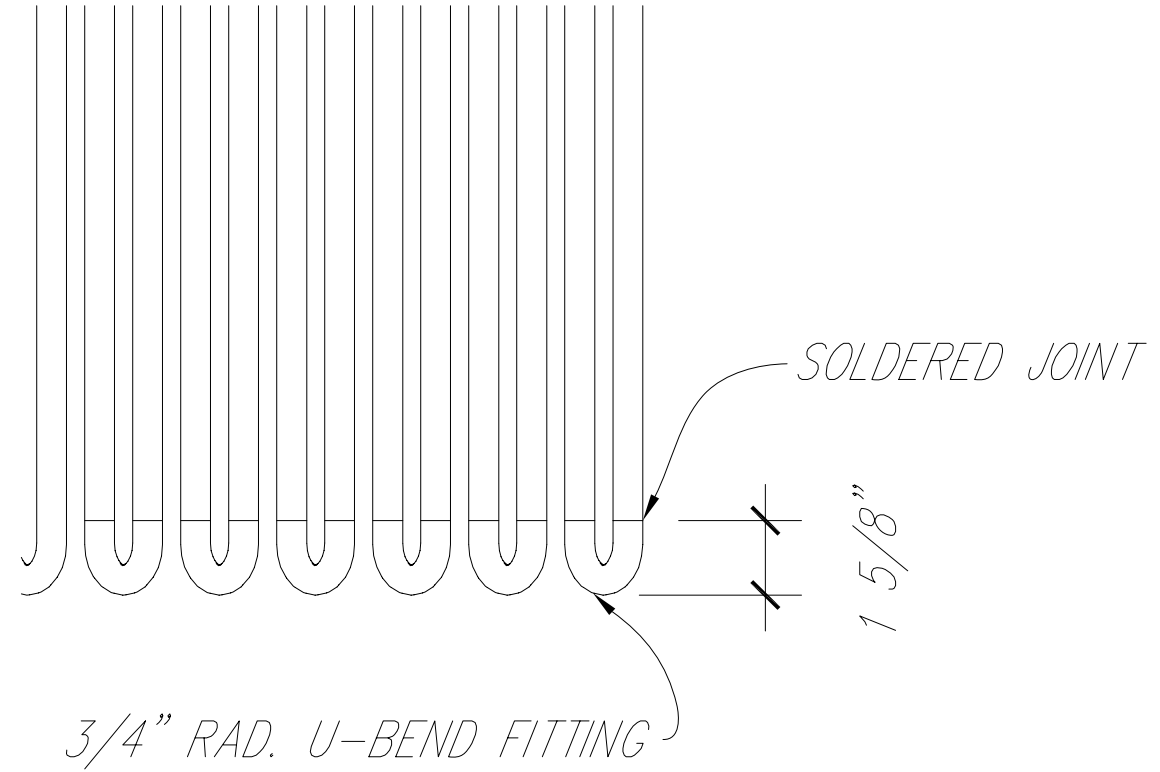


*D* RADIANT ELEMENT DETAIL  
*3" - 1'-0"*

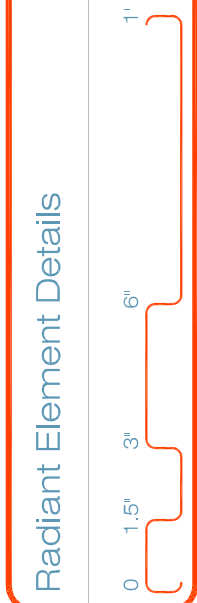


Drawn by	Date
C. Corbin	August 7, 2007
Revised	Date


① FAN COIL PARTS DETAIL  
N.T.S.

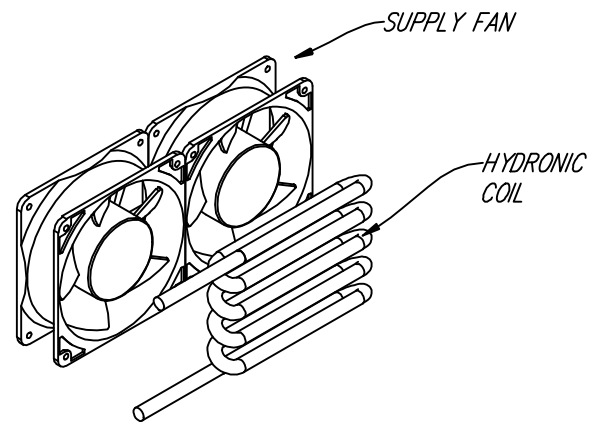


② FAN COIL PLANS AND SECTIONS  
N.T.S.

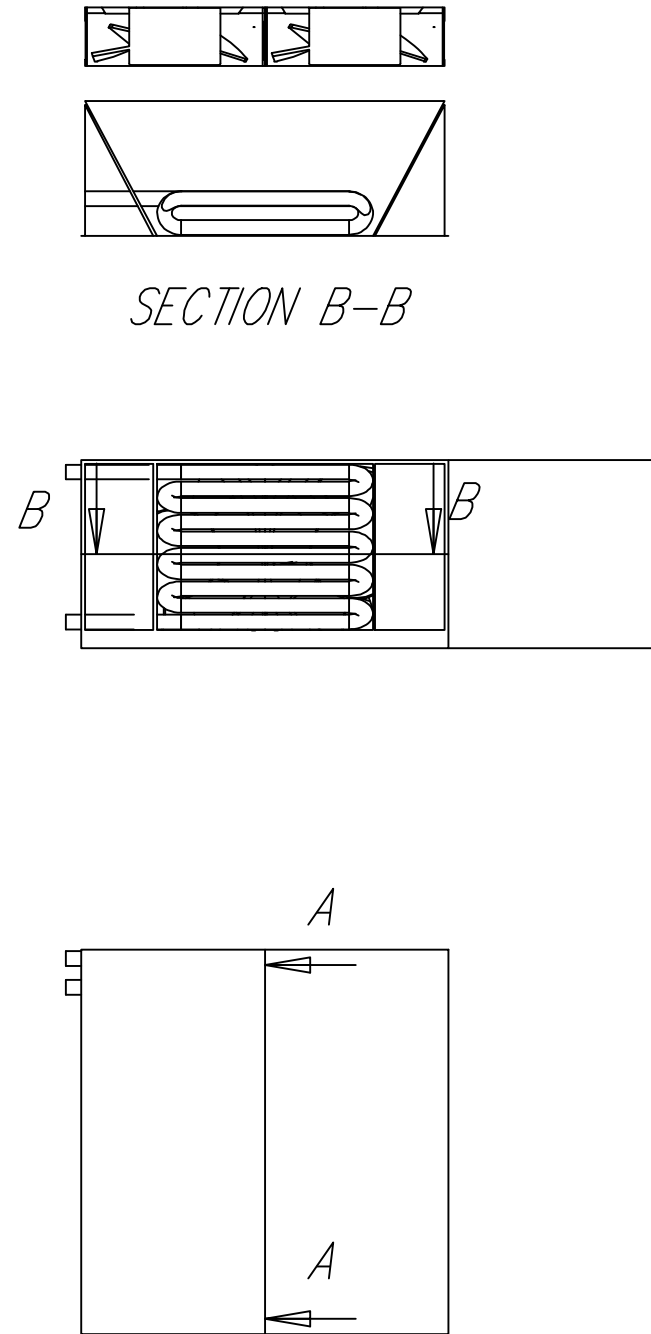


SECTION A-A

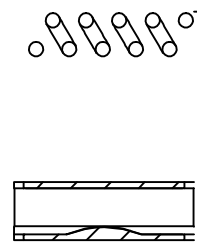

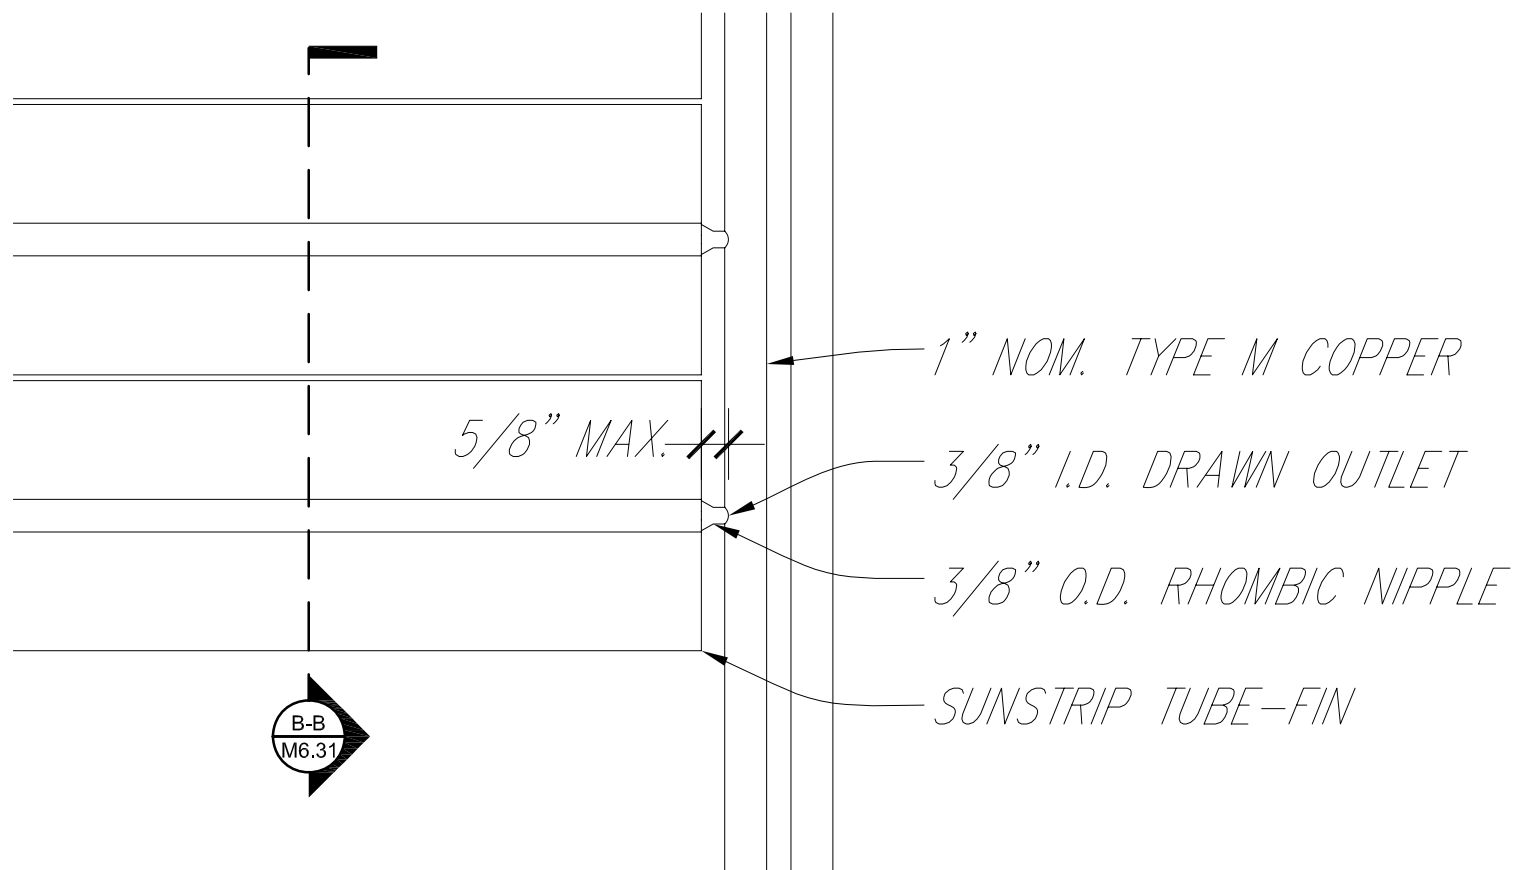

(A) *PVT ABSORBER DETAIL*  
3" - 1'-0"

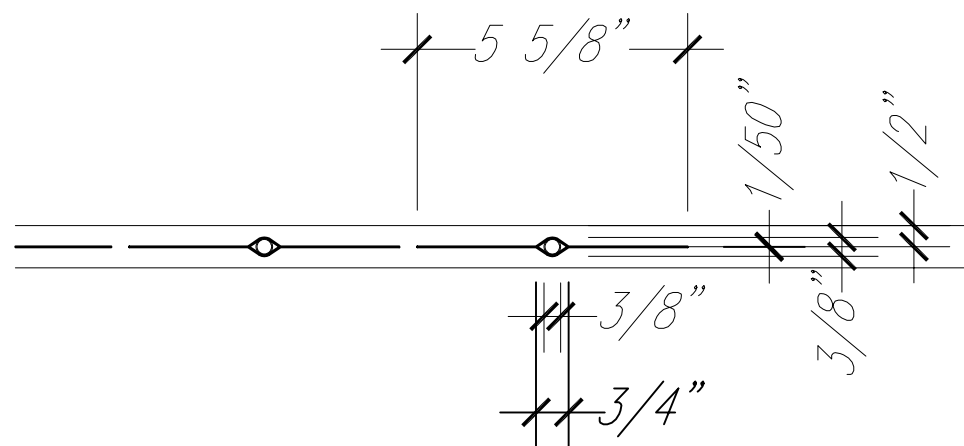


(B) *PVT ABSORBER SECTION*  
3" - 1'-0"

Drawn by	Date
C. Corbin	August 7, 2007
Revised	Date

2007 Solar Decathlon	University of Colorado at Boulder
Civil, Environmental, and Architectural Engineering	428 UCB, Room ECCE 441
Boulder, CO 80309-0428	




M6.31

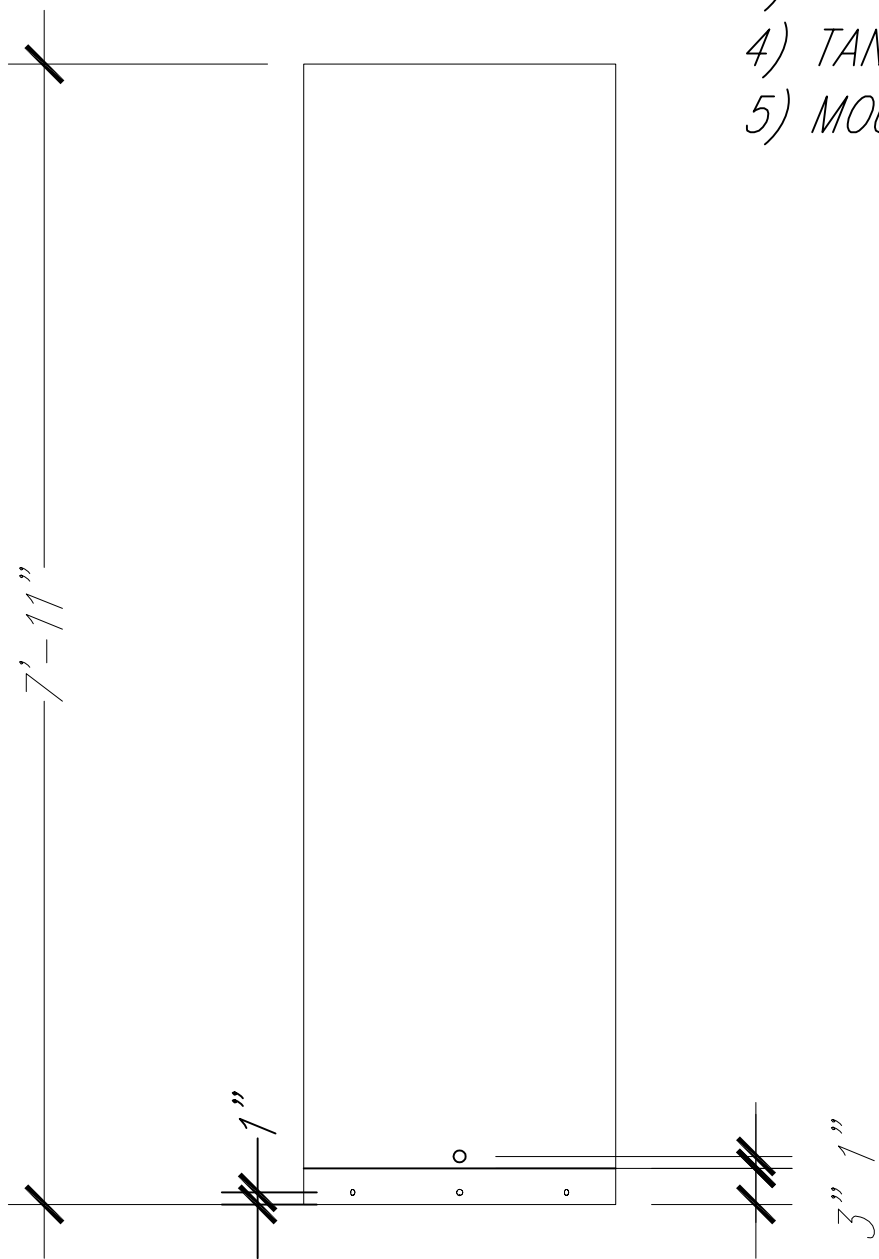


① TANK FRONT VIEW  
3/4" - 1'-0"

- NOTES:
- 1) ONE OF TWO TANKS TO HAVE TWO MIDDLE INLETS ELIMINATED.
  - 2) BOTTOM OF TANK RECESSED VERTICALLY 3" TO ALLOW FOR INSULATION.
  - 3) DRAIN OUTLET TO INCLUDE 1" NPT THREADED FITTING.
  - 4) TANK AND LID TO BE CONSTRUCTED OF 10GA 304 STAINLESS.
  - 5) MOUNTING HOLES AROUND BOTTOM RIM 1/2" DIAMETER.

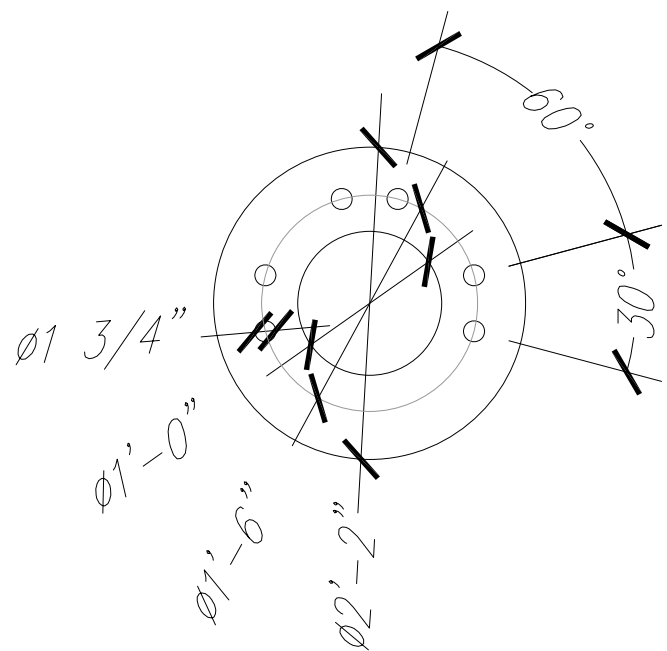

② TANK TOP VIEW  
3/4" - 1'-0"

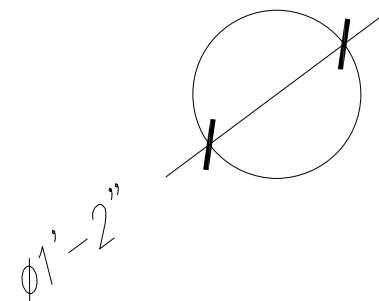


③ TANK LID TOP VIEW  
3/4" - 1'-0"


Drawn by	Date
C. Corbin	August 7, 2007
Revised	Date

Thermal Storage Tank	2007 Solar Decathlon	University of Colorado at Boulder Civil, Environmental, and Architectural Engineering 428 UCB, Room ECCE 441 Boulder, CO 80309-0428		
0	6"	1"	2'	4'




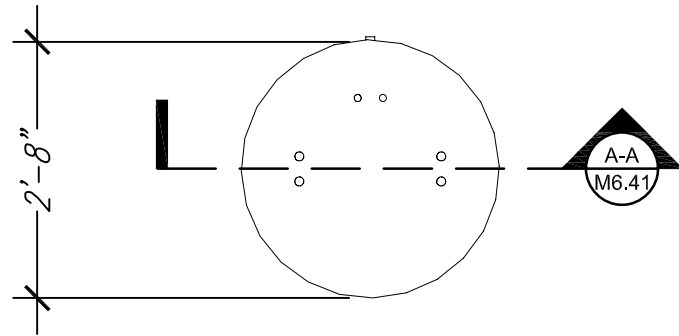

① TANK ASSEMBLY TOP  
1/2" - 1'-0"

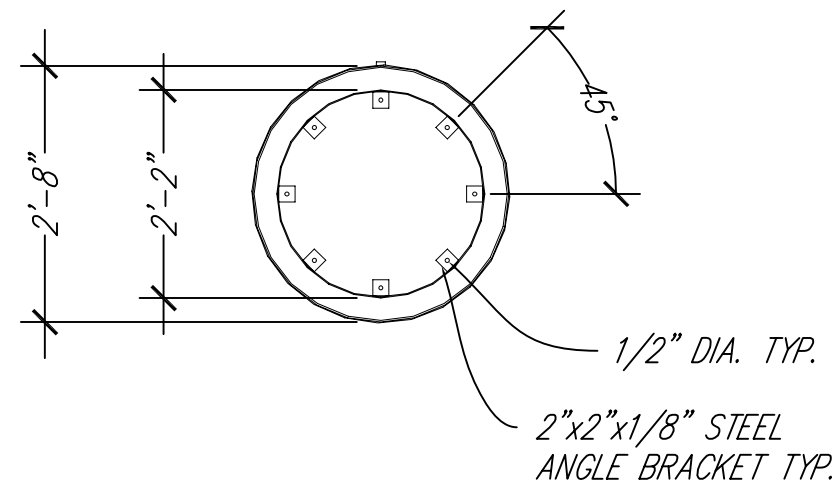

② TANK ASSEMBLY BOTTOM  
1/2" - 1'-0"

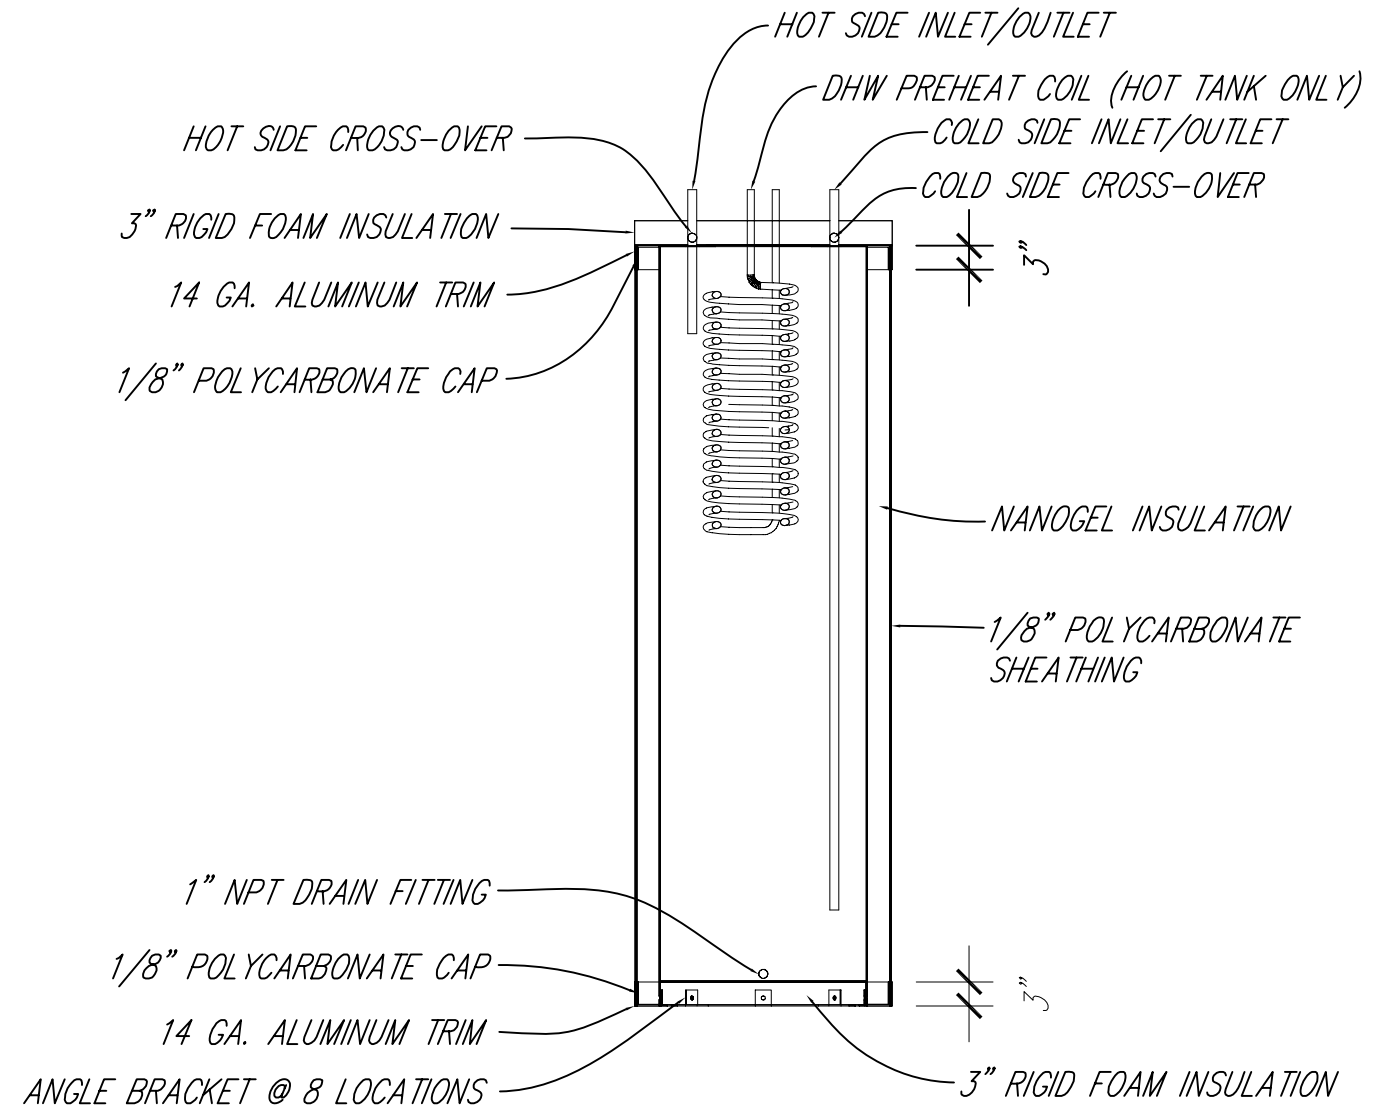


③ TANK ASSEMBLY SECTION  
1/2" - 1'-0"

Drawn by	Date
C. Corbin	August 7, 2007
Revised	Date

2007 Solar Decathlon	University of Colorado at Boulder
Thermal Storage Tank	Civil, Environmental, and Architectural Engineering
	428 UCB, Room ECCE 441
	Boulder, CO 80309-0428





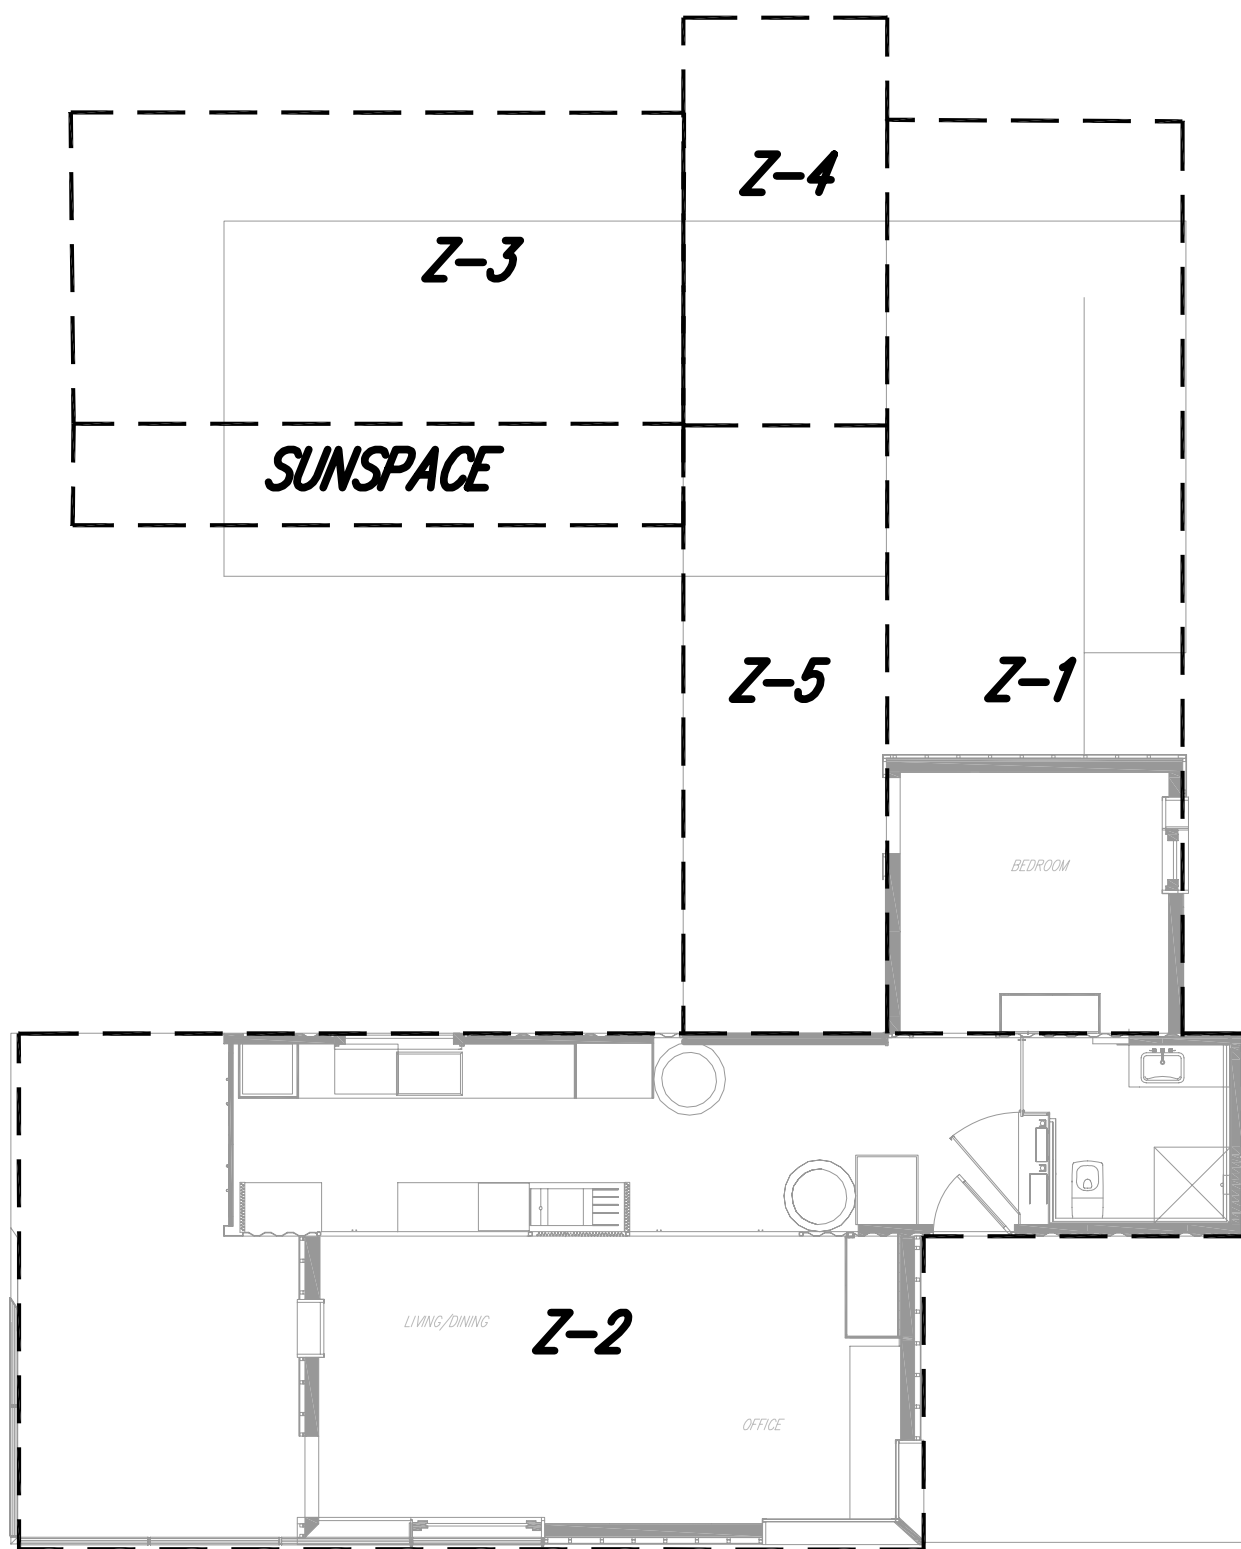

BUILDING LOADS

ZONE	DESCRIPTION	PHASE	CNTL. VLV.	COIL	HEATING BTU/HR	COOLING BTU/HR
Z-1	BEDROOM (FUTURE STUDY)	COMPETITION	CV-1	C-1	775	500
Z-1	EAST BEDROOM	COMPLETE	CV-10	C-9	2250	2100
Z-2	SOUTH BATHROOM	COMPETITION	CV-1	C-2	975	500
Z-2	LIVING RM. - EAST HEAT EXCHANGER	COMPETITION	CV-1	C-3	6750	5075
Z-2	LIVING RM. - WEST HEAT EXCHANGER	COMPETITION	CV-1	C-4	3375	2550
Z-3	NORTH BEDROOMS	COMPLETE	CV-9	C-6	5000	6100
Z-4	NORTH BATH - EXTERIOR	COMPLETE	CV-9	C-7	550	700
Z-4	NORTH BATH - INTERIOR	COMPLETE	CV-9	C-8	165	350
Z-5	CORRIDOR	COMPLETE	CV-10	C-10	1050	1250
TOTAL					20890	19125

1 COMPLETE HOUSE HVAC ZONING PLAN  
N.T.S.

Drawn by	Date
C. Corbin	August 7, 2007
Revised	

Complete House HVAC Zoning Plan

2007 Solar Decathlon

University of Colorado at Boulder

Civil, Environmental, and Architectural Engineering

428 UCB, Room ECCE 441

Boulder, CO 80309-0428





Drawn by	J.S. McNeill	Date	August 7, 2007
Revised	J.S. McNeill	Date	January 9, 2008


University of Colorado at Boulder  
2007 Solar Decathlon  
Civil, Environmental, and Architectural Engineering  
428 UCB, Room ECE 441  
Boulder, CO 80309-0428

Complete House HVAC Piping Plan

0 1' 2' 4' 8'



M7.21

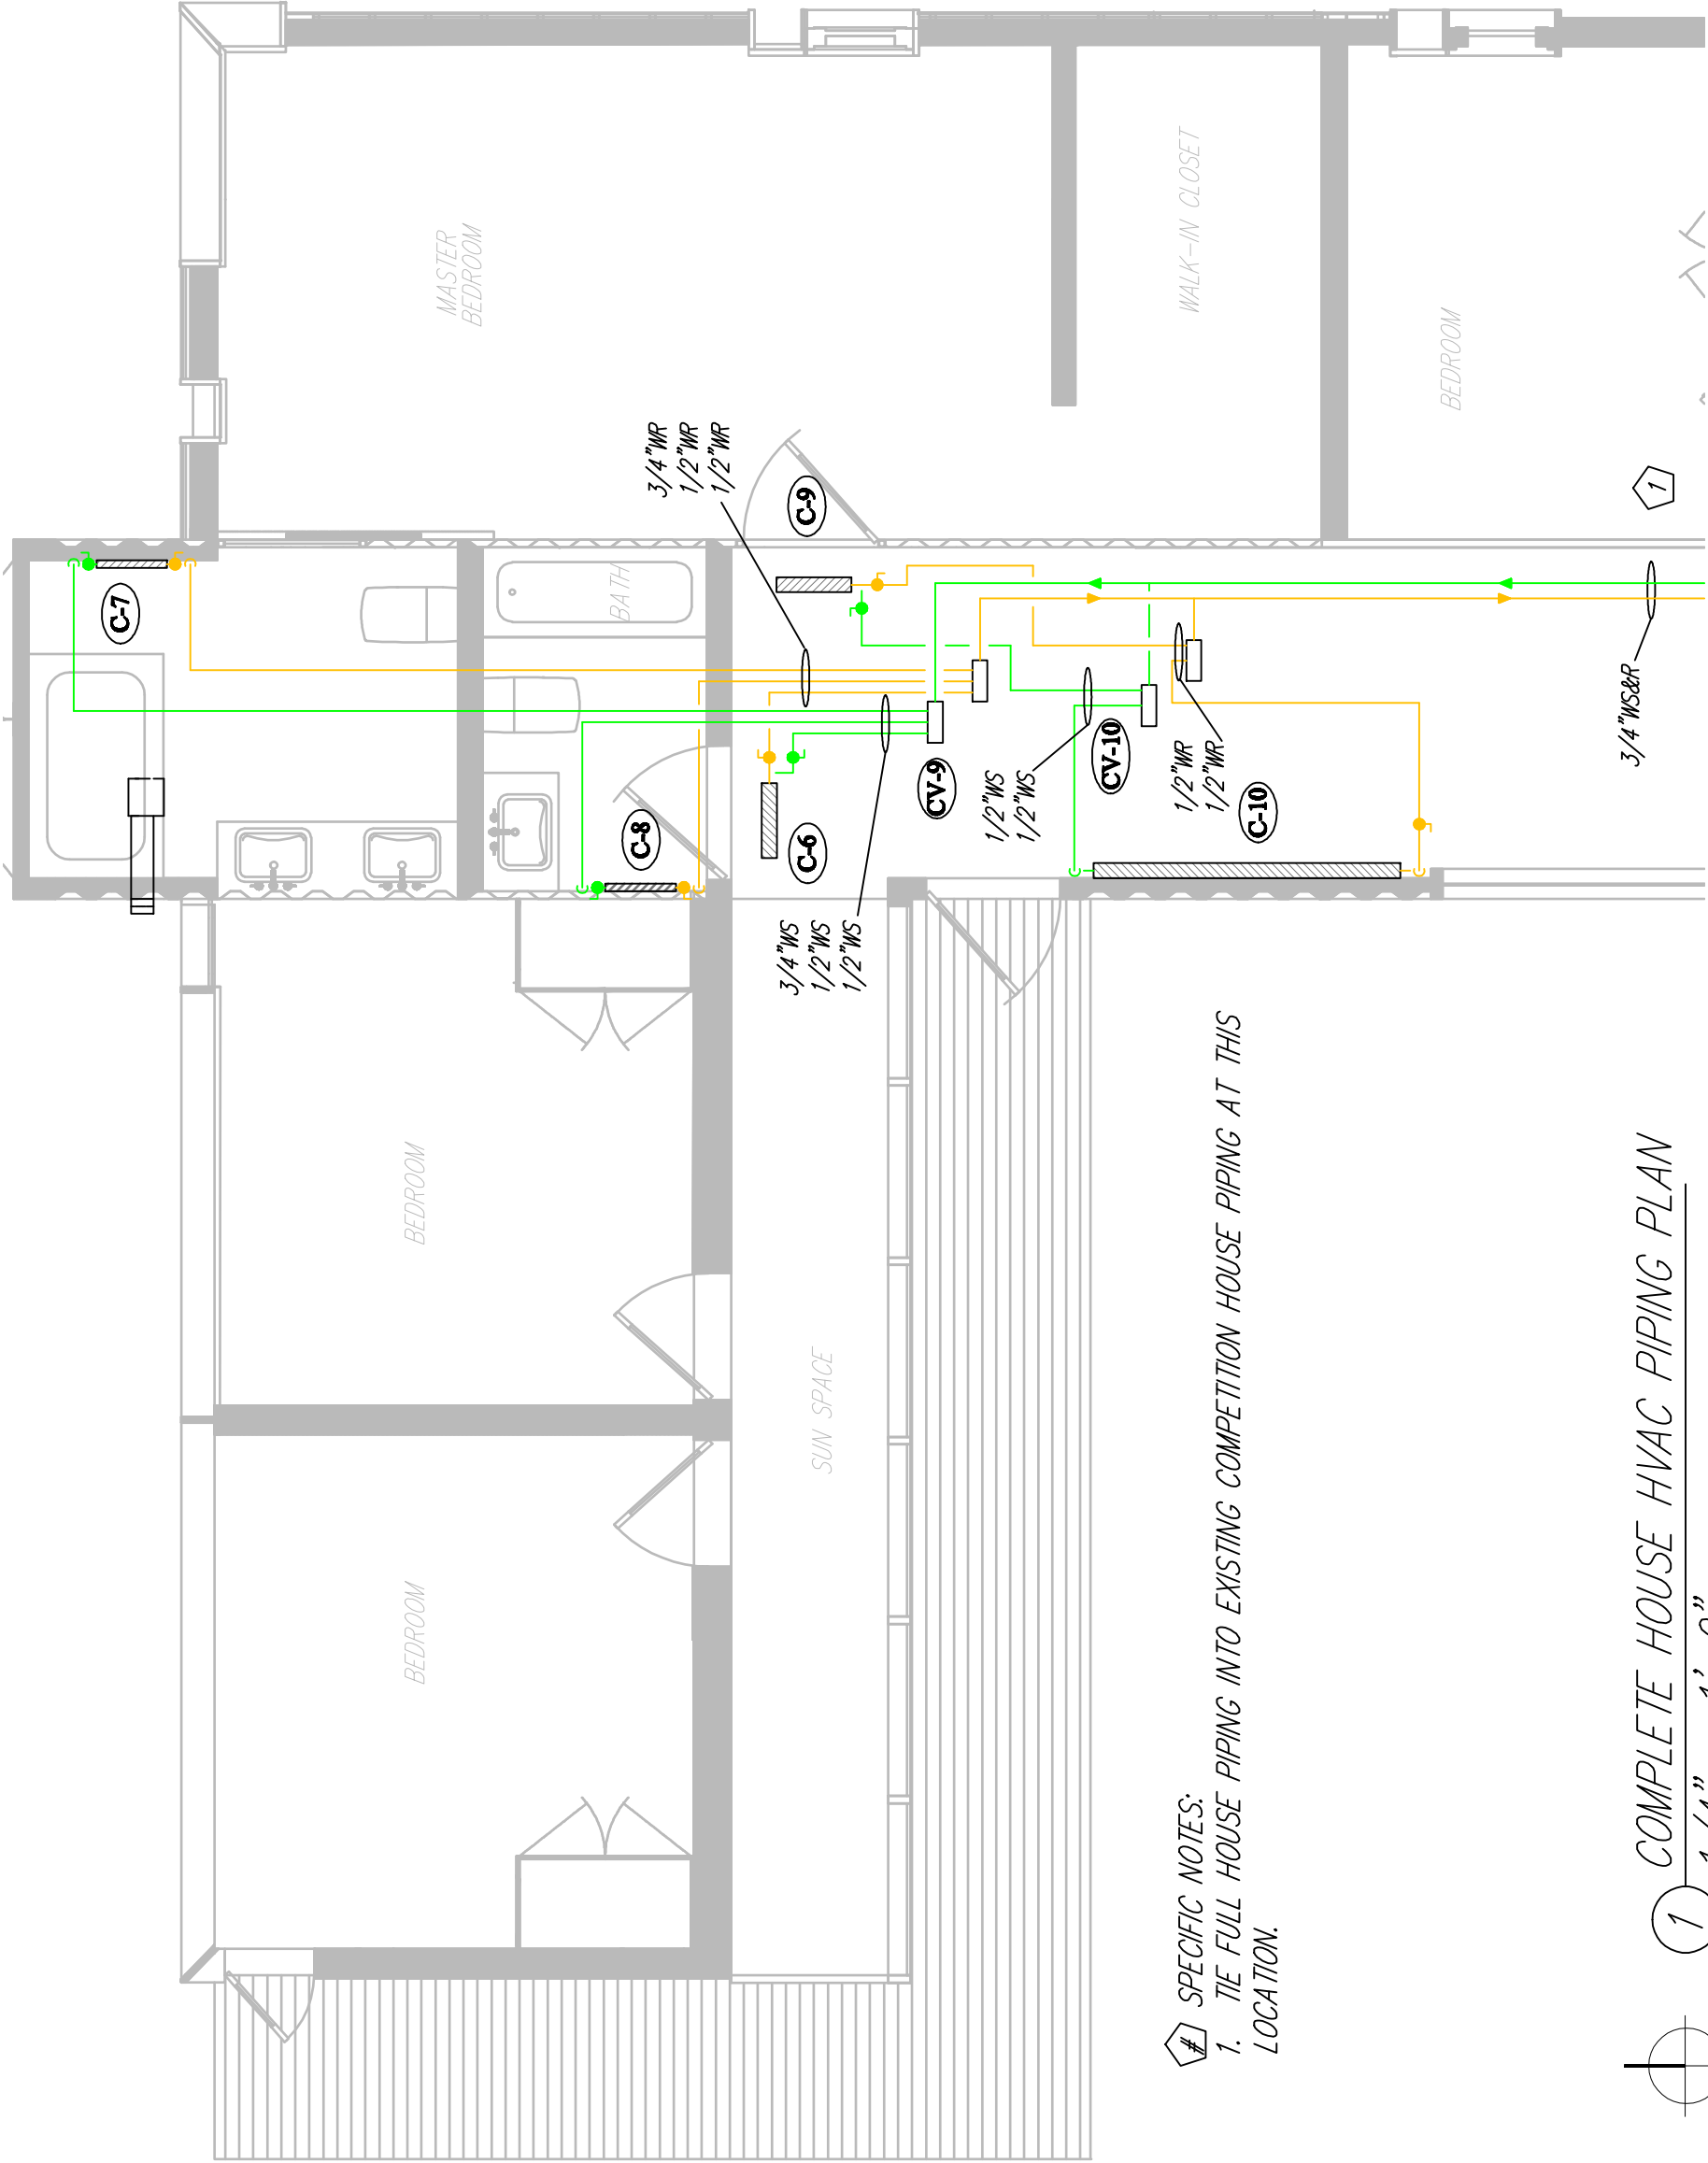

# SPECIFIC NOTES:  
1. TIE FULL HOUSE PIPING INTO EXISTING COMPETITION HOUSE PIPING AT THIS LOCATION.

1 COMPLETE HOUSE HVAC PIPING PLAN  
1/4" = 1'-0"

GENERAL MECHANICAL NOTES:

1. THE PROJECT CONSISTS OF TWO PHASES. THE FIRST PHASE CONSISTS OF THE CONSTRUCTION OF A SMALLER MODULE THAT WILL BE USED DURING THE SOLAR DECATHLON COMPETITION IN WASHINGTON D.C. THE SECOND PHASE CONSISTS OF AN ADDITION TO THE NORTH AND WEST OF THE COMPETITION MODULE. THE COMPLETE HOUSE HVAC WILL BE SUPPORTED FROM THE COMPETITION MODULE HVAC SYSTEMS.

GENERAL MECHANICAL DUCTWORK NOTES:

1. ALL DUCTWORK SHALL BE INSTALLED PER ACCA MANUAL D – RESIDENTIAL HVAC INSTALLATION SPECIFICATION: SUPPLEMENTARY DOCUMENT, DUCT INSTALLATION AND SEALING SPECIFICATION (HTTP://WWW.CEE1.ORG/RESID/RS-AC/HVAC.PHP3).
2. DUCT INSULATION IS ONLY REQUIRED ON VENTILATION AIR DUCTWORK AND DUCTWORK ON THE SUPPLY-SIDE OF FAN COIL UNITS.
3. FLEX DUCT MAY BE USED, WITH A MAXIMUM FLEX DUCT LENGTH OF 5 FT.
4. SEE SPECIFICATIONS FOR ACCEPTABLE DUCTWORK SPECIALTIES. EQUIPMENT MAY BE SUBSTITUTED WITH AN EQUIVALENT MANUFACTURER.

GENERAL MECHANICAL PIPING NOTES:

1. ALL HYDRONIC PIPING SHALL BE TYPE L COPPER WITH WROUGHT FITTINGS.
2. PIPING SHALL BE INSULATED WITH INSULATION PER ASHRAE 90.2-2004 AND 2003 INTERNATIONAL ENERGY CONSERVATION CODE, WHICHEVER IS MORE STRINGENT. ALL INSULATION SHALL BE CLOSED CELL FOAM PER SPECIFICATIONS.
3. ALL HYDRONIC FLUID SHALL BE 40% FOOD GRADE PROPYLENE GLYCOL FLUID. FILLS POINT FOR SYSTEM IS AT HOT AND COLD TANK. PROPYLENE GLYCOL IS NOT TO BE USED AS A HEAT TRANSFER FLUID IN THE DHW HEAT PUMP LOOP. THE DHW HEAT PUMP LOOP SHALL USE WATER AS A HEAT TRANSFER FLUID.
4. PROPYLENE GLYCOL IS NOT TO BE USED DURING THE COMPETITION. WATER ONLY WILL BE USED AS A HEAT TRANSFER FLUID DURING THE COMPETITION.
5. SEE SPECIFICATIONS FOR ACCEPTABLE PIPE SPECIALTIES. EQUIPMENT MAY BE SUBSTITUTED WITH AN EQUIVALENT MANUFACTURER.

HVAC PIPING LEGEND

C	ZONE HEATING/COOLING COIL
CT	COLD WATER/ICE STORAGE TANK
HP	HEAT PUMP
HT	HOT WATER STORAGE TANK
HX	HEAT EXCHANGER
OFC	OUTDOOR FAN COIL UNIT
P	CIRCULATION PUMP
PVT	PHOTOVOLTAIC THERMAL COLLECTOR
XT	EXPANSION TANK
WS	HYDRONIC WATER SUPPLY
WR	HYDRONIC WATER RETURN

HVAC DUCTWORK LEGEND

C	ZONE HEATING/COOLING COIL
EA	EXHAUST AIR
EF	EXHAUST FAN
GR	GRILLE/REGISTRIER
MD	MOTOR CONTROL DAMPER
RA	RETURN AIR
SF	SUPPLY FAN
SA	SUPPLY AIR
VA	VENTILATION AIR
VF	VENTILATION FAN
VD	VOLUME DAMPER

HVAC Piping Symbols

	3-WAY CONTROL VALVE
	2-WAY CONTROL VALVE
	BALANCE VALVE
	BALL VALVE
	CIRCULATION PUMP
	PIPE STRAINER
	PIPE REDUCER
	PIPE UNION
	SWING CHECK VALVE
	AIR SEPARATOR
	PRESSURE GAGE
	BACKFLOW PREVENTER

HVAC Ductwork Symbols

	90° ELBOW
	DUCT TAKE-OFF
	RECTANGULAR TO ROUND DUCT TRANSITION
	RECTANGULAR TO RECTANGULAR DUCT TRANSITION
	ROUND DUCT ELBOW DOWN
	RECTANGULAR DUCT ELBOW DOWN
	RECTANGULAR EXHAUST AIR DUCT ELBOW DOWN
	ROUND DUCT ELBOW UP
	RECTANGULAR DUCT ELBOW UP
	RECTANGULAR EXHAUST AIR DUCT ELBOW UP

HVAC ABBREVIATIONS

AFF.	ABOVE FINISHED FLOOR
DN.	DOWN
BOD	BOTTOM OF DUCT
TOD	TOP OF DUCT

HVAC SYSTEM ABBREVIATIONS

HPCT	HEAT PUMP/COLD TANK SUPPLY PIPING
HPCT	HEAT PUMP/COLD TANK RETURN PIPING
HPHT	HEAT PUMP/HOT TANK SUPPLY PIPING
HPHT	HEAT PUMP/HOT TANK RETURN PIPING
HPDHW	HEAT PUMP/DOMESTIC HOT WATER SUPPLY PIPING
HPDHW	HEAT PUMP/DOMESTIC HOT WATER RETURN PIPING
WLCT	HYDRONIC WATER LOOP/COLD TANK SUPPLY PIPING
WLCT	HYDRONIC WATER LOOP/COLD TANK RETURN PIPING
WLHT	HYDRONIC WATER LOOP/HOT TANK SUPPLY PIPING
WLHT	HYDRONIC WATER LOOP/HOT TANK RETURN PIPING
LOAD	BUILDING LOADS SUPPLY
LOAD	BUILDING LOADS RETURN
PVT	PHOTOVOLTAIC THERMAL SUPPLY PIPING
PVT	PHOTOVOLTAIC THERMAL RETURN PIPING
3FC	OUTDOOR FAN COIL SUPPLY PIPING
3FC	OUTDOOR FAN COIL RETURN PIPING



Drawn by	J.S. McNeill	Date	August 7, 2007
Revised	J.S. McNeill	Date	January 9, 2008

PUMP SCHEDULE

TAG	DESCRIPTION	MAKE	MODEL	SIZE	GPM	FT.HD.	ELECTRICAL	WATTS	NOTES
P-1	BUILDING LOADS CIRCULATOR	WLO	STRATOS	1.25 X 3-35	10	20	230V-1PH-60HZ	65	-
P-2	HEAT PUMP SOURCE CIRCULATOR	GRUNDFOS	UPS	26-64F	10	20	120V-1PH-60HZ	185	-
P-3	HEAT PUMP LOADS CIRCULATOR	GRUNDFOS	UPS	26-64F	10	20	120V-1PH-60HZ	185	-
P-4	PVT/OFC CIRCULATOR	WLO	STRATOS	1.25 X 3-35	10	20	230V-1PH-60HZ	65	-
P-5	HEAT PUMP DHW CIRCULATOR	GRUNDFOS	UPS	26-64F	10	20	120V-1PH-60HZ	185	-

FAN SCHEDULE

TAG	DESCRIPTION	MAKE	MODEL	CFM	E.S.P.	RPM	ELECTRICAL	WATTS	NOTES
SF-1	LIVING ROOM SUPPLY FAN	FANTECH	FRD 12-6	175	0.375 IN. W.G.	2545	120V-1PH-60HZ	85	PROVIDE WITH VARIABLE SPEED CONTROL
VF-1	VENTILATION FAN	FANTECH	FR100	55	0.25 IN. W.G.	2900	120V-1PH-60HZ	19	PROVIDE WITH INSULATED BACKDRAFT DAMPER
EF-1	BATHROOM EXHAUST FAN	FANTECH	FR100	55	0.25 IN. W.G.	2900	120V-1PH-60HZ	19	PROVIDE WITH INSULATED BACKDRAFT DAMPER
EF-2	ELECTRICAL COOLING FAN	FANTECH	FR100	55	0.375 IN. W.G.	2900	120V-1PH-60HZ	19	PROVIDE WITH INSULATED BACKDRAFT DAMPER
EF-3	KITCHEN EXHAUST FAN	FANTECH	RVF6	100	0.75 IN. W.G.	-	120V-1PH-60HZ	92	-
EF-4	BATHROOM EXHAUST FAN (FUTURE)	FANTECH	FR125	100	0.375 IN. W.G.	2950	120V-1PH-60HZ	18	PROVIDE WITH INSULATED BACKDRAFT DAMPER
FCU-1	BEDROOM FCU FAN	LYTRON	102076	40	0.20 IN. W.G.	3100	120V-1PH-60HZ	15	SEE DRAWING M6.05
FCU-2	BEDROOM FCU FAN (FUTURE)	LYTRON	102076	40	0.20 IN. W.G.	3100	120V-1PH-60HZ	15	SEE DRAWING M6.05
FCU-3	BEDROOM FCU FAN (FUTURE)	LYTRON	102076	40	0.20 IN. W.G.	3100	120V-1PH-60HZ	15	SEE DRAWING M6.05

DIFFUSER SCHEDULE

TAG	DESCRIPTION	MAKE	MODEL	CFM	A.P.D.	SIZE	FINISH	NOTES
A	LIVING ROOM JET DIFFUSER	AIR CONCEPTS	APL-04/04A	22	0.05 IN. W.G.	4"Ø	#00 ALUMINUM MILL	PROVIDE WITH APERTURE DAMPER
B	BEDROOM LINEAR BAR GRILLE	CARNES	CCNBG	75	0.01 IN. W.G.	2"	STANDARD	35-1/8"W X 2"H

Drawn by	Date
J.S. McNeill	August 7, 2007
Revised	Date

Mechanical Schedules

2007 Solar Decathlon

University of Colorado at Boulder  
Civil, Environmental, and Architectural Engineering  
428 UCB, Room ECCE 441  
Boulder, CO 80309-0428





HYDRONIC COIL SCHEDULE

COIL	DESCRIPTION	PHASE	CNTL. VLV.	AIR FLOW CFM	WATER FLOW GPM	HEATING BTU/HR	E.W.T F	L.W.T F	COOLING BTU/HR	E.W.T F	L.W.T F	NOTES:
C-1	BEDROOM (FUTURE STUDY)	COMPETITION	CV-1	50	0.5	775	100	95	500	50	55	SEE DRAWING M6.05
C-8	EAST BEDROOM	COMPLETE	CV-10	125	1.0	2250	100	95	2100	50	55	SEE DRAWING M6.05
C-2	SOUTH BATHROOM	COMPETITION	CV-1	–	0.5	975	100	95	500	50	55	SEE DRAWING M6.02 THRU M6.04
C-3	LIVING RM. – EAST HEAT EXCH. 1	COMPETITION	CV-1	125	2.75	5750	100	95	4075	50	55	SEE DRAWING M6.02 THRU M6.04
C-4	LIVING RM. – EAST HEAT EXCH. 2	COMPETITION	CV-1	–	0.5	1000	100	95	1000	50	55	SEE DRAWING M6.02 THRU M6.04
C-5	LIVING RM. – WEST HEAT EXCHANGER	COMPETITION	CV-1	50	1.5	3375	100	95	2550	50	55	SEE DRAWING M6.02 THRU M6.04
C-6	NORTH BEDROOMS	COMPLETE	CV-9	300	2.5	5000	100	95	6100	50	55	SEE DRAWING M6.05
C-7	NORTH BATH – EXTERIOR	COMPLETE	CV-9	–	0.5	550	100	95	700	50	55	SEE DRAWING M6.02 THRU M6.04
C-9	NORTH BATH – INTERIOR	COMPLETE	CV-9	–	0.5	165	100	95	350	50	55	SEE DRAWING M6.02 THRU M6.04
C-10	CORRIDOR	COMPLETE	CV-10	–	0.5	1050	100	95	1250	50	55	SEE DRAWING M6.02 THRU M6.04

FAN COIL UNIT SCHEDULE

TAG	DESCRIPTION	MAKE	MODEL	CFM	E.F.T.	E.A.T.	HEAT CAP.	ELECTRICAL	WATTS	NOTES
OFC-1	OUTDOOR FAN COIL UNIT	LYTRON	6340G2	10	120 F	100 F	2 MBTUH	120V-1PH-60HZ	240	–
OFC-2	OUTDOOR FAN COIL UNIT	LYTRON	6340G2	10	120 F	100 F	2 MBTUH	120V-1PH-60HZ	240	–
OFC-3	OUTDOOR FAN COIL UNIT	LYTRON	6340G2	10	120 F	100 F	2 MBTUH	120V-1PH-60HZ	240	–

PHOTOVOLTAIC-THERMAL SCHEDULE

TAG	DESCRIPTION	MAKE	MODEL	NOTES
PVT-1	PVT COLLECTOR	THERMODYNAMICS	SUNSTRIP	SEE DRAWING M6.31
PVT-2	PVT COLLECTOR	THERMODYNAMICS	SUNSTRIP	SEE DRAWING M6.31
PVT-3	PVT COLLECTOR	THERMODYNAMICS	SUNSTRIP	SEE DRAWING M6.31

WATER STORAGE TANK SCHEDULE

TAG	DESCRIPTION	MAKE	DIMENSIONS	SIZE	ICE CAP.	ICE TYPE	TYPE	INSULATION	NOTES
HT	HOT WATER THERMAL STORAGE TANK	CUSTOM	28"Øx96"H	240 GAL.	NO	NO	ATMOSPHERIC	R-28	–
CT	COLD WATER/ICE THERMAL STORAGE TANK	CUSTOM	28"Øx96"H	240 GAL.	25 TON-HRS	CRYOGEL	ATMOSPHERIC	R-28	–

Drawn by	Date
J.S. McNeill	August 7, 2007
Revised	Date

Mechanical Schedules

2007 Solar Decathlon

University of Colorado at Boulder  
Civil, Environmental, and Architectural Engineering  
428 UCB, Room ECCE 441  
Boulder, CO 80309-0428



EXPANSION TANK SCHEDULE

TAG	DESCRIPTION	MAKE	MODEL	VOLUME	DIMENSIONS	NOTES
XT-1	HYDRONIC EXPANSION TANK	HONEYWELL	TX-5-C	2.0 GAL.	10" DIAM. X 10-3/8"H	-

DHW HEATER SCHEDULE

TAG	DESCRIPTION	MAKE	MODEL	RECOVERY	DIMENSIONS	NOTES
DHW	INDIRECT WATER HEATER	BRADFORD WHITE	SW-2-30-L	429 GAL. @ 115F	20" DIAM. X 30"H	-

THERMOSTATIC MIXING VALVE SCHEDULE

TAG	DESCRIPTION	MAKE	MODEL	SIZE	NOTES
TMV	THERMOSTATIC MIXING VALVE	HONEYWELL	AMX-102 -UT-1	1" NPT	ASSE 1017 CERTIFIED. SET TO 120 F OUTLET TEMPERATURE

CONTROL VALVE SCHEDULE

TAG	DESCRIPTION	COIL	MAKE	MODEL	SIZE	TYPE	OPER.	FLOW	ELECTRICAL	NOTES
CV-1	MULTI ZONE CONTROL VALVE	C-1 TO C-5	HONEYWELL	SZ3T1	3/4 IN.	2-WAY	2-POS.	5.0 GPM	24 VAC	-
CV-2	BUILDING SUPPLY ISOLATION VALVE	-	HONEYWELL	VC8715AM1000	1 IN.	3-WAY	2-POS.	10 GPM	24 VAC	-
CV-3	BUILDING RETURN ISOLATION VALVE	-	HONEYWELL	VC8715AM1000	1 IN.	3-WAY	2-POS.	10 GPM	24 VAC	-
CV-4	OUTDOOR SUPPLY ISOLATION VALVE	-	HONEYWELL	VC8715AM1000	1 IN.	3-WAY	2-POS.	10 GPM	24 VAC	-
CV-5	OUTDOOR RETURN ISOLATION VALVE	-	HONEYWELL	VC8715AM1000	1 IN.	3-WAY	2-POS.	10 GPM	24 VAC	-
CV-6	PVT ISOLATION VALVE	-	HONEYWELL	VC8715AM1000	1 IN.	2-WAY	2-POS.	10 GPM	24 VAC	-
CV-7	OFC ISOLATION VALVE	-	HONEYWELL	VC8715AM1000	1 IN.	2-WAY	2-POS.	10 GPM	24 VAC	-
CV-8	BUILDING BYPASS VALVE	-	HONEYWELL	VC8715AM1000	1 IN.	3-WAY	MOD.	10 GPM	24 VAC	-
CV-9	MULTI ZONE CONTROL VALVE (FUTURE)	C-6 TO C-8	HONEYWELL	SZ3T1	3/4 IN.	2-WAY	2-POS.	2.5 GPM	24 VAC	-
CV-10	MULTI ZONE CONTROL VALVE (FUTURE)	C-9 AND C-10	HONEYWELL	SZ3T1	3/4 IN.	2-WAY	2-POS.	1.5 GPM	24 VAC	-


Drawn by	Date
J.S. McNeill	August 7, 2007
Revised	Date

Mechanical Schedules


2007 Solar Decathlon

University of Colorado at Boulder  
Civil, Environmental, and Architectural Engineering  
428 UCB, Room ECCE 441  
Boulder, CO 80309-0428



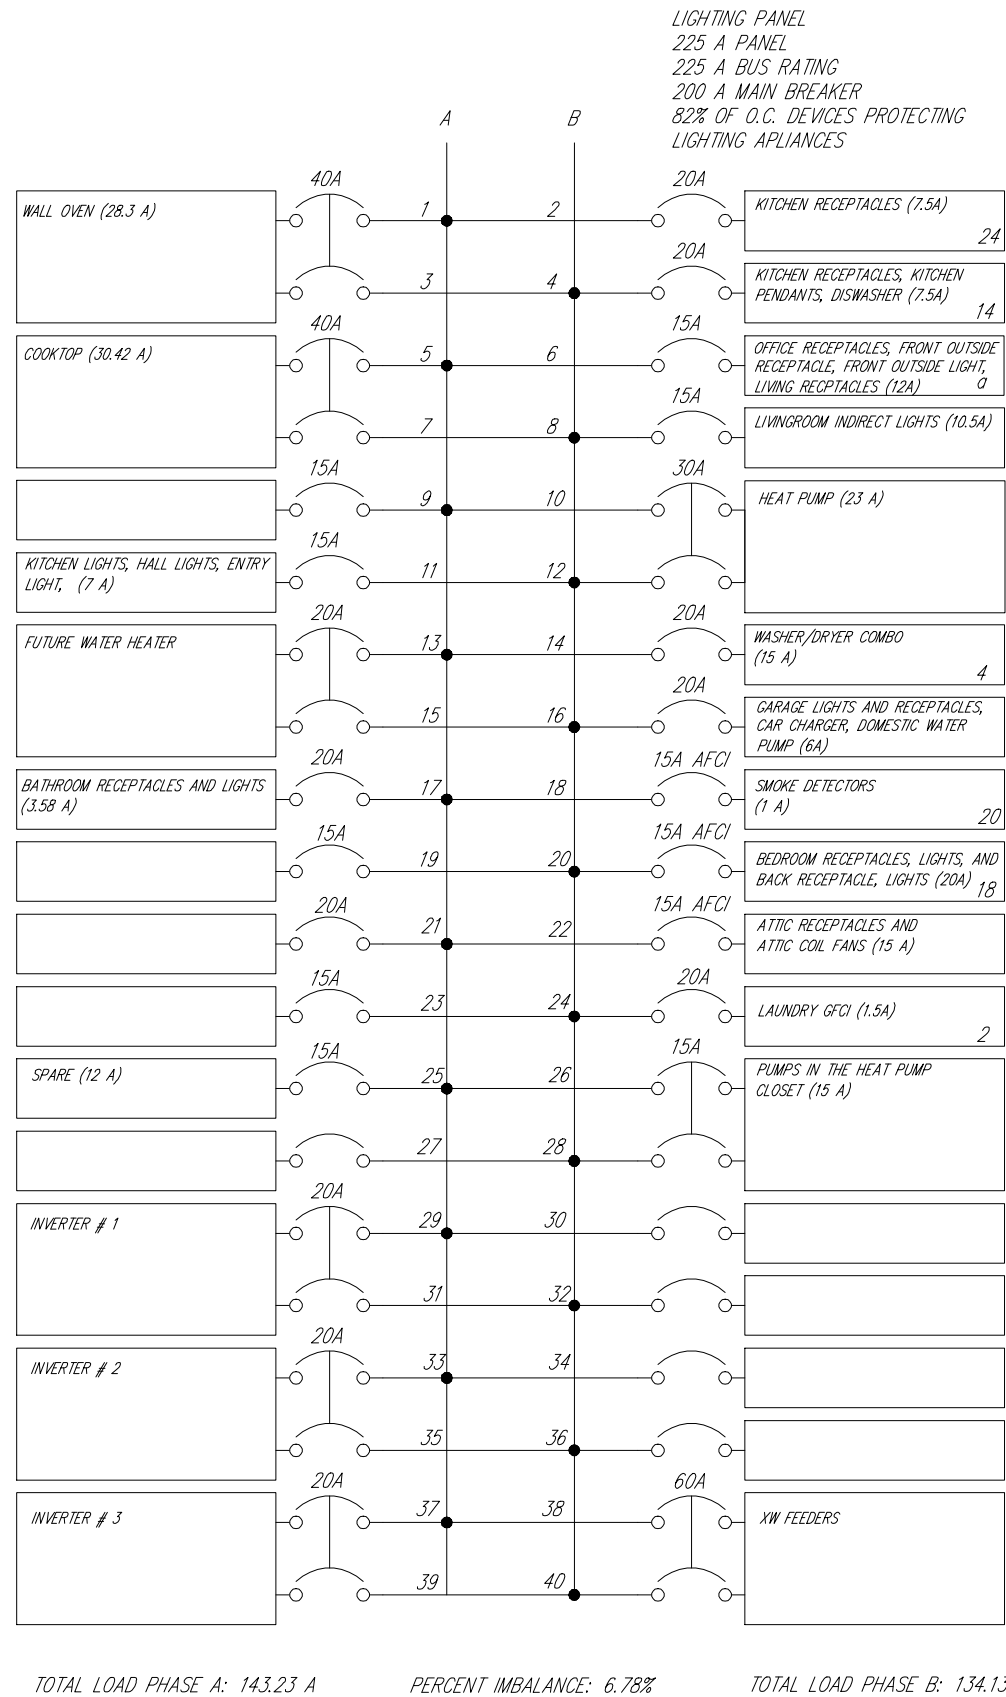

WALL OVEN (28.3 A)	KITCHEN RECEPTACLES (7.5A)	24
	KITCHEN RECEPTACLES, KITCHEN PENDANTS, DISWASHER (7.5A)	14
COOKTOP (30.42 A)	OFFICE RECEPTACLES, FRONT OUTSIDE RECEPTACLE, FRONT OUTSIDE LIGHT, LIVING RECEPTACLES (12A)	0
	LIVINGROOM INDIRECT LIGHTS (10.5A)	
	HEAT PUMP (23 A)	
KITCHEN LIGHTS, HALL LIGHTS, ENTRY LIGHT, (7 A)		
FUTURE WATER HEATER	WASHER/DRYER COMBO (15 A)	4
	GARAGE LIGHTS AND RECEPTACLES, CAR CHARGER, DOMESTIC WATER PUMP (6A)	
BATHROOM RECEPTACLES AND LIGHTS (3.58 A)	SMOKE DETECTORS (1 A)	20
	BEDROOM RECEPTACLES, LIGHTS, AND BACK RECEPTACLE, LIGHTS (20A)	18
	ATTIC RECEPTACLES AND ATTIC COIL FANS (15 A)	
	LAUNDRY GFCI (1.5A)	2
SPARE (12 A)	PUMPS IN THE HEAT PUMP CLOSET (TURN ON WITH CKT 28) (15 A)	
	PUMPS IN THE HEAT PUMP CLOSET (TURN ON WITH CKT 26) (15 A)	
INVERTER # 1		
INVERTER # 2		
INVERTER # 3	XW FEEDERS	

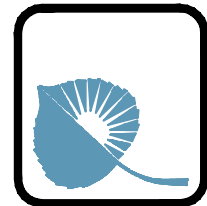

Panels- SunPower SPR 215 (215W per panel)  
Inverter- SunPower SPR-x 3.3 (3.3 kW)  
Array- 4 strings of 8 panels and 1 string of nine panels

Total System Power= (8 x 4 x 215W) + (9 x 215W) = 8815 W

4x8 panel strings	# in string	# of strings	Correction Factors	Total
V <sub>oc</sub> = 48.3 V per panel	8		x 1.25 (-40°F Ambient Temp)	386.4 V per string
V <sub>oc</sub> = 48.3 V				483 V per string
V <sub>oc</sub> = 48.3 V				
V <sub>mp</sub> = 39.8 V per panel				318.4 V per string
V <sub>mp</sub> = 39.8 V	8		x 1.25 (Continuous Current) x 1.25 (Extra Irradiance)	5.8 A
I <sub>sc</sub> = 5.80 A per string				9.0625 A
I <sub>sc</sub> = 5.80 A				
I <sub>mp</sub> = 5.40 A per string				5.40 A
I <sub>mp</sub> = 5.40 A	9		x 1.25 (-40°F Ambient Temp)	434.7 V per string
V <sub>oc</sub> = 48.3 V per panel				543.375 V per string
V <sub>oc</sub> = 48.3 V				
V <sub>oc</sub> = 48.3 V				
V <sub>mp</sub> = 39.8 V per panel	9		x 1.25 (Continuous Current) x 1.25 (Extra Irradiance)	358.2 V per string
V <sub>mp</sub> = 39.8 V				5.8 A
I <sub>sc</sub> = 5.80 A per string				9.0625 A
I <sub>sc</sub> = 5.80 A				
I <sub>mp</sub> = 5.40 A per string				5.40 A
I <sub>mp</sub> = 5.40 A	9		x 1.25 (Continuous Current) x 1.25 (Extra Irradiance)	5.40 A
V <sub>oc</sub> = 48.3 V per panel				
V <sub>oc</sub> = 48.3 V				
V <sub>oc</sub> = 48.3 V				

Inverter Information	
# of units:	3
make:	SunPower
model:	SPR-3300x
rated wattage:	3300
V input range (DC):	195-600
V output (AC):	240
Max Continuous output Current:	13.8A
# Phases:	single
frequency:	60 Hz
UL Listing:	1741- 01

## 1 PV CALCULATIONS

GT Inverter Information	
# of units:	3
make:	SunPower
model:	SPR-3300x
rated wattage:	3300
V input range (DC):	195-600
V output (AC):	240
Max Continuous output Current:	13.8A
# Phases:	single
frequency:	60 Hz
UL Listing:	1741- 01

XM6048- 120/240-60 Inverter Information	
Continuous Output Power	6000 W
Surge Rating (10 seconds)	12000 W
Surge Current	L-n: 105 A <sub>rms</sub> (7 sec)
	L-L: 62.5 A <sub>rms</sub> (7 sec)
CEC Weighted Efficiency	93.5%
DC Input voltage range	44-64 v
Battery breakers	250 A

Cable from Batteries to Inverters	
NEC 310.16 4/0 MTW/THW in conduit ampacity =	230 A
temp de-rating for 41 - 45°C = 230A x 0.82=	188.6 A
Parallel runs: 188.6 x 2=	377.2 A
6000W / 44v/ 0.935=	145.84 A
145.84 x1.25=	182.30 A

Battery Information	
Battery Voltage	6 v
# in string	8
# of strings	6
Amp hours per Battery	370 A-h
Voltage per string	48 v
Amp hours total	2220 A-h @ 48v
Battery Bank Capacity	2220 Watt-hours

## 4 BATTERY CABLE SIZING CALCULATIONS

- Conductors from PV panels to Jbox  
10 Current carrying conductors  
#10 USE-2 cable from panels- manufacturer provided  
NEC 310.17 #10 USE-2 in free air = 55A  
temp de-rating for 71-80 C = 55A x .41 = 22.55A
- Conductors from Jbox to Inverter  
10 Current carrying conductors  
NEC 310.16 #10 THWN-2 in conduit ampacity = 40A  
NEC 310.10 FPN #2 temp de-rating for 61 - 70 C = 40A x .58 = 23.2A  
NEC 310.15 Conduit fill derate 23.2 x .8 = 18.56A  
Internal DC disconnect rated for 20A
- Inverter (AC wiring) to Breaker Panel - maximum continuous output current = 13.8A  
Overcurrent protection required for inverter output: 13.8 x 1.25 = 17.25A  
Use 20A Overcurrent protection and wire  
6 current carrying conductors ( 2 per inverter)  
NEC 310.16 #10 THHN in conduit ampacity = 40A  
No temp de-rating, assume 30 C  
NEC 240.(D) Max ampacity for #10 THHN = 30A  
NEC 310.15(B)(2) Wireway de-rating: 40A x .7 = 28A

All Equipment grounding conductors for PV's - #10 AWG

## 2 DC CONDUCTOR SIZING CALCULATIONS

### PV NEC

NEC 690.7  
Lowest Ambient temperature in Colorado: -40  
Correction Factor: 1.25

NEC 690.8  
(1) Maximum current shall be the sum of the parallel module rated short circuit currents multiplied by 125%.

NEC 690.14 (C)(1)  
Exception: Installations that comply with 690.31(E) shall be permitted to have the disconnecting means located remote from the point of entry of the system conductors.

NEC 690.31 (E)  
Where source or output circuits are run inside the building, they shall be contained in metallic raceways from the point of penetration to the first disconnecting means.

NEC 690.47 (C)(2)  
The dc and ac grounding electrode conductors shall be connected to a single electrode the separate electrode conductors shall be sized as required by 250.66 and 250.166.

## 3 RELEVANT NEC ARTICLES

Drawn by	Date	Reviewed	Date
J.Baum	August 7, 2007		

2007 Solar Decathlon			
University of Colorado at Boulder			
Civil, Environmental, and Architectural Engineering			
438 UCB, Room EOCB 441			
Boulder, CO 80509-0428			
DC Calculations		NTS	
0 6' 1' 2' 4'			



	<table><tr><th>Appliance</th><th>Amp</th><th>Voltage</th><th>VA</th></tr><tr><td>Cook Top</td><td>30.00</td><td>240</td><td>7200</td></tr><tr><td>Wall Oven</td><td>28.30</td><td>240</td><td>6792</td></tr><tr><td>Dishwasher</td><td>15.00</td><td>120</td><td>1800</td></tr><tr><td>Washer / Dryer</td><td>15.00</td><td>120</td><td>1800</td></tr><tr><td>Refrigerator</td><td>0.58</td><td>120</td><td>70</td></tr></table>	Appliance	Amp	Voltage	VA	Cook Top	30.00	240	7200	Wall Oven	28.30	240	6792	Dishwasher	15.00	120	1800	Washer / Dryer	15.00	120	1800	Refrigerator	0.58	120	70	
Appliance	Amp	Voltage	VA																							
Cook Top	30.00	240	7200																							
Wall Oven	28.30	240	6792																							
Dishwasher	15.00	120	1800																							
Washer / Dryer	15.00	120	1800																							
Refrigerator	0.58	120	70																							
<b>Sizing of the Service-entrance Conductors Using the Standard Method</b>																										
<b>A. Design of Conductors for Phases</b>																										
	<b>NEC Section</b>	<b>Explanation or Calculation</b>																								
<u>General Loads</u>																										
<i>General Lighting Circuits</i> 800 square feet 6623.2 VA                      800 *3VA= 2,400	220.42																									
<i>Small Appliance Branch Circuits</i> 3,000 VA	210.11 (C)(1)																									
<i>Laundry Branch Circuits</i> 1,500 VA	210.11 (C)(11) 220.82 (B)(2)																									
Total General Load = 11,123 VA Demand Load = <b>5,843 VA</b>	220.42	Total general lighting load is the general lighting load + small appliance loads Demand load is 100% x the first 3000 VA + 35% x the remaining VA																								
<u>Fixed Appliance Load</u>																										
<i>Dishwasher, Washing Machine</i>																										
Demand Load = <b>7,794 VA</b>	220.53	(Sum of VA's)*0.75																								
<u>Special Appliances</u>																										
Dryer 1,800 VA + Range 5,760 VA DL = <b>7,560 VA</b>	220.54 220.55	Range is 0.8 x Rated VA																								
Total Demand Load = 21,197 VA I <sub>Load</sub> = <b>88.3 A</b>		Sum of the demand loads Total demand load / 240V																								
Size of THW (Cu) Conductor (For a 200 amp Panel according to future expansion plans) <b>4/0</b>	310.15(B)(6)																									
Size of Main Breaker <b>200 A, 2P</b>																										

1 CONDUCTOR SIZING CALCULATIONS

<b>B. Design of Conductors for Neutral</b>		
<u>General Loads</u>		
Demand Load = 5,843 VA		
<u>Fixed Appliance Load</u>		
Demand Load = 3,353 VA		
<u>Special Appliances</u>		
Dryer 910 VA Range 4,032 VA DL = 4,942 VA		Apply a Demand Factor of 0.7 to Dryers and Ranges
Total Demand Load = 14,138 VA I <sub>Load</sub> = 58.9 A		Total demand load [VA] / 240 [V]
Size of THW (Cu) Conductor for Neutral #2	Table 310.16	
Size of Grounding Electrode Conductor #2	Table 250.66	
Size of Equipment Grounding Conductors #6	Table 250.122	

2 NEUTRAL CONDUCTOR SIZING CALCULATIONS

D. Conduit Fill Calculations						
Location	Insulation	Size	Area [in^2]	Quantity	Total Area	NEC Section
1) PDP to Panelboard	THW	4/0	0.3718	3	1.1154	350 Tables 4 and 5
	THW	#6	0.0726	1	0.0726	
	Total				1.188	
	Conduit LFNC-B	Size 2"	40% of Area 1.298			
2) DC Wireway to Inverters	Insulation	Size	Number of conductors			Annex C Table C.1
	THHN	#10	5			
	Conduit	Size	Maximum number of conductors			
	EMT	1"	16			
3) Inverters to AC WireWay	Insulation	Size	Number of conductors			Annex C Table C.1
	THHN	#12	3			
	Conduit	Size	Maximum number of conductors			
	EMT	1"	26			
4) AC Wireway to Panelboard	Insulation	Size	Number of conductors			Annex C Table C.1
	THHN	#12	9			
	Conduit	Size	Maximum number of conductors			
	EMT	1"	26			

3 CONDUIT FILL CALCULATIONS

Drawn by	Date
J.Baum	August 7, 2007
Revised	Date

2007 Solar Decathlon

University of Colorado at Boulder

Civil, Environmental, and Architectural Engineering


438 UCB, Room EOCB 441

Boulder, CO 80509-0458

AC Calculations













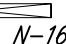

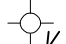

NTS

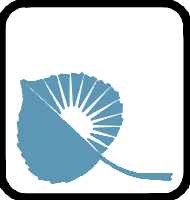0 1' 2' 4'





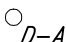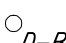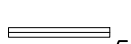

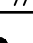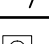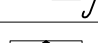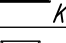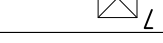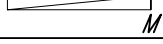



LIGHTING SYMBOL LEGEND

	RECESSED LIGHT FIXTURE W/ALUMINUM TRIM
	RECESSED LIGHT FIXTURE W/BLACK TRIM
	BATHROOM VANITY LIGHT
	BEDROOM INDIRECT
	LED ROPE LIGHT
	READING LIGHT
	PENDANT FIXTURE
	SCONCE
	DESK LAMP
	4' FLUORESCENT COVE
	8' FLUORESCENT DIMMABLE INDIRECT COVE
	16' FLUORESCENT DIMMABLE INDIRECT COVE
	RECESSED LIGHT FIXTURE W/FROSTED LENSE
	VAPOR TIGHT LIGHT FIXTURE
	OUTDOOR DECK LIGHT
	OUTDOOR WALL LIGHT

SWITCHING SYMBOL LEGEND

	SINGLE POLE SWITCH
	DIMMER SWITCH
	3-WAY SWITCH
	DAYLIGHT PHOTOSENSOR


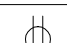
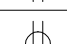
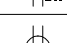
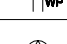
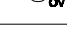
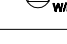
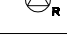
LOW VOLTAGE SYMBOL LEGEND

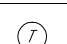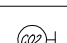	DATA OUTLET
	TEMPERATURE / HUMIDITY SENSOR
	TEMPERATURE SENSOR
	CO <sub>2</sub> SENSOR





FIRE SAFETY SYMBOL LEGEND

	SMOKE DETECTOR
---	----------------





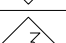

OUTLET SYMBOL LEGEND

	DUPLEX RECEPTACLE
	GFCI DUPLEX RECEPTACLE
	DISHWASHER DUPLEX RECEPTACLE
	WEATHER PROOF GFCI RECEPTACLE
	OVEN RECEPTACLE
	WASHER/DRYER RECEPTACLE
	RANGE RECEPTACLE
	JUNCTION BOX FOR EQUIPMENT POWER

E1.01 KEYNOTE LEGEND

	WIRES IN ATTIC SPACE SUBJECT TO DERATION AS PER NEC 310.16 FOOTNOTES
	SEE EQUIPMENT SCHEDULE
	PANEL LAC TO HAVE PROPER WORKING CLEARANCES AS PER NEC 110.26
	OUTLETS LOCATED UNDER SHIPPING CONTAINER

E1.03 KEYNOTE LEGEND


	BATTERY RACK TO BE MADE OF CORROSION RESISTANT METAL
	ALL ELECTRICALLY ENERGIZED PARTS ARE TO HAVE PROPERLY INSULATED COVERINGS
	BATTERY RACK TO HAVE PROPER WORKING CLEARANCES AS PER NEC 110.26
	BATTERY STORAGE ENTRANCE IS TO HAVE SIGNAGE DECLARING THAT AUTORIZED PERSONAL ONLY IS ALLOWED
	EXPLOSION PROOF LIGHT FIXTURES TO BE MOUNTED ABOVE EACH BATTERY SHELF
	LUGS IN PDP WILL BE RATED FOR THE TYPE OF CONDUCTORS THAT WILL BE ATTACHED TO THE LUG

1 SYMBOL LEGENDS

Drawn by	Date
J.Baurn	August 7, 2007
Revised	Date

Key Notes and Symbols	2007 Solar Decathlon	University of Colorado at Boulder Civil, Environmental, and Architectural Engineering 428 UCB, Room ECDE 441 Boulder, CO 80309-0428
		0 6' 1' 2' 4' NTS



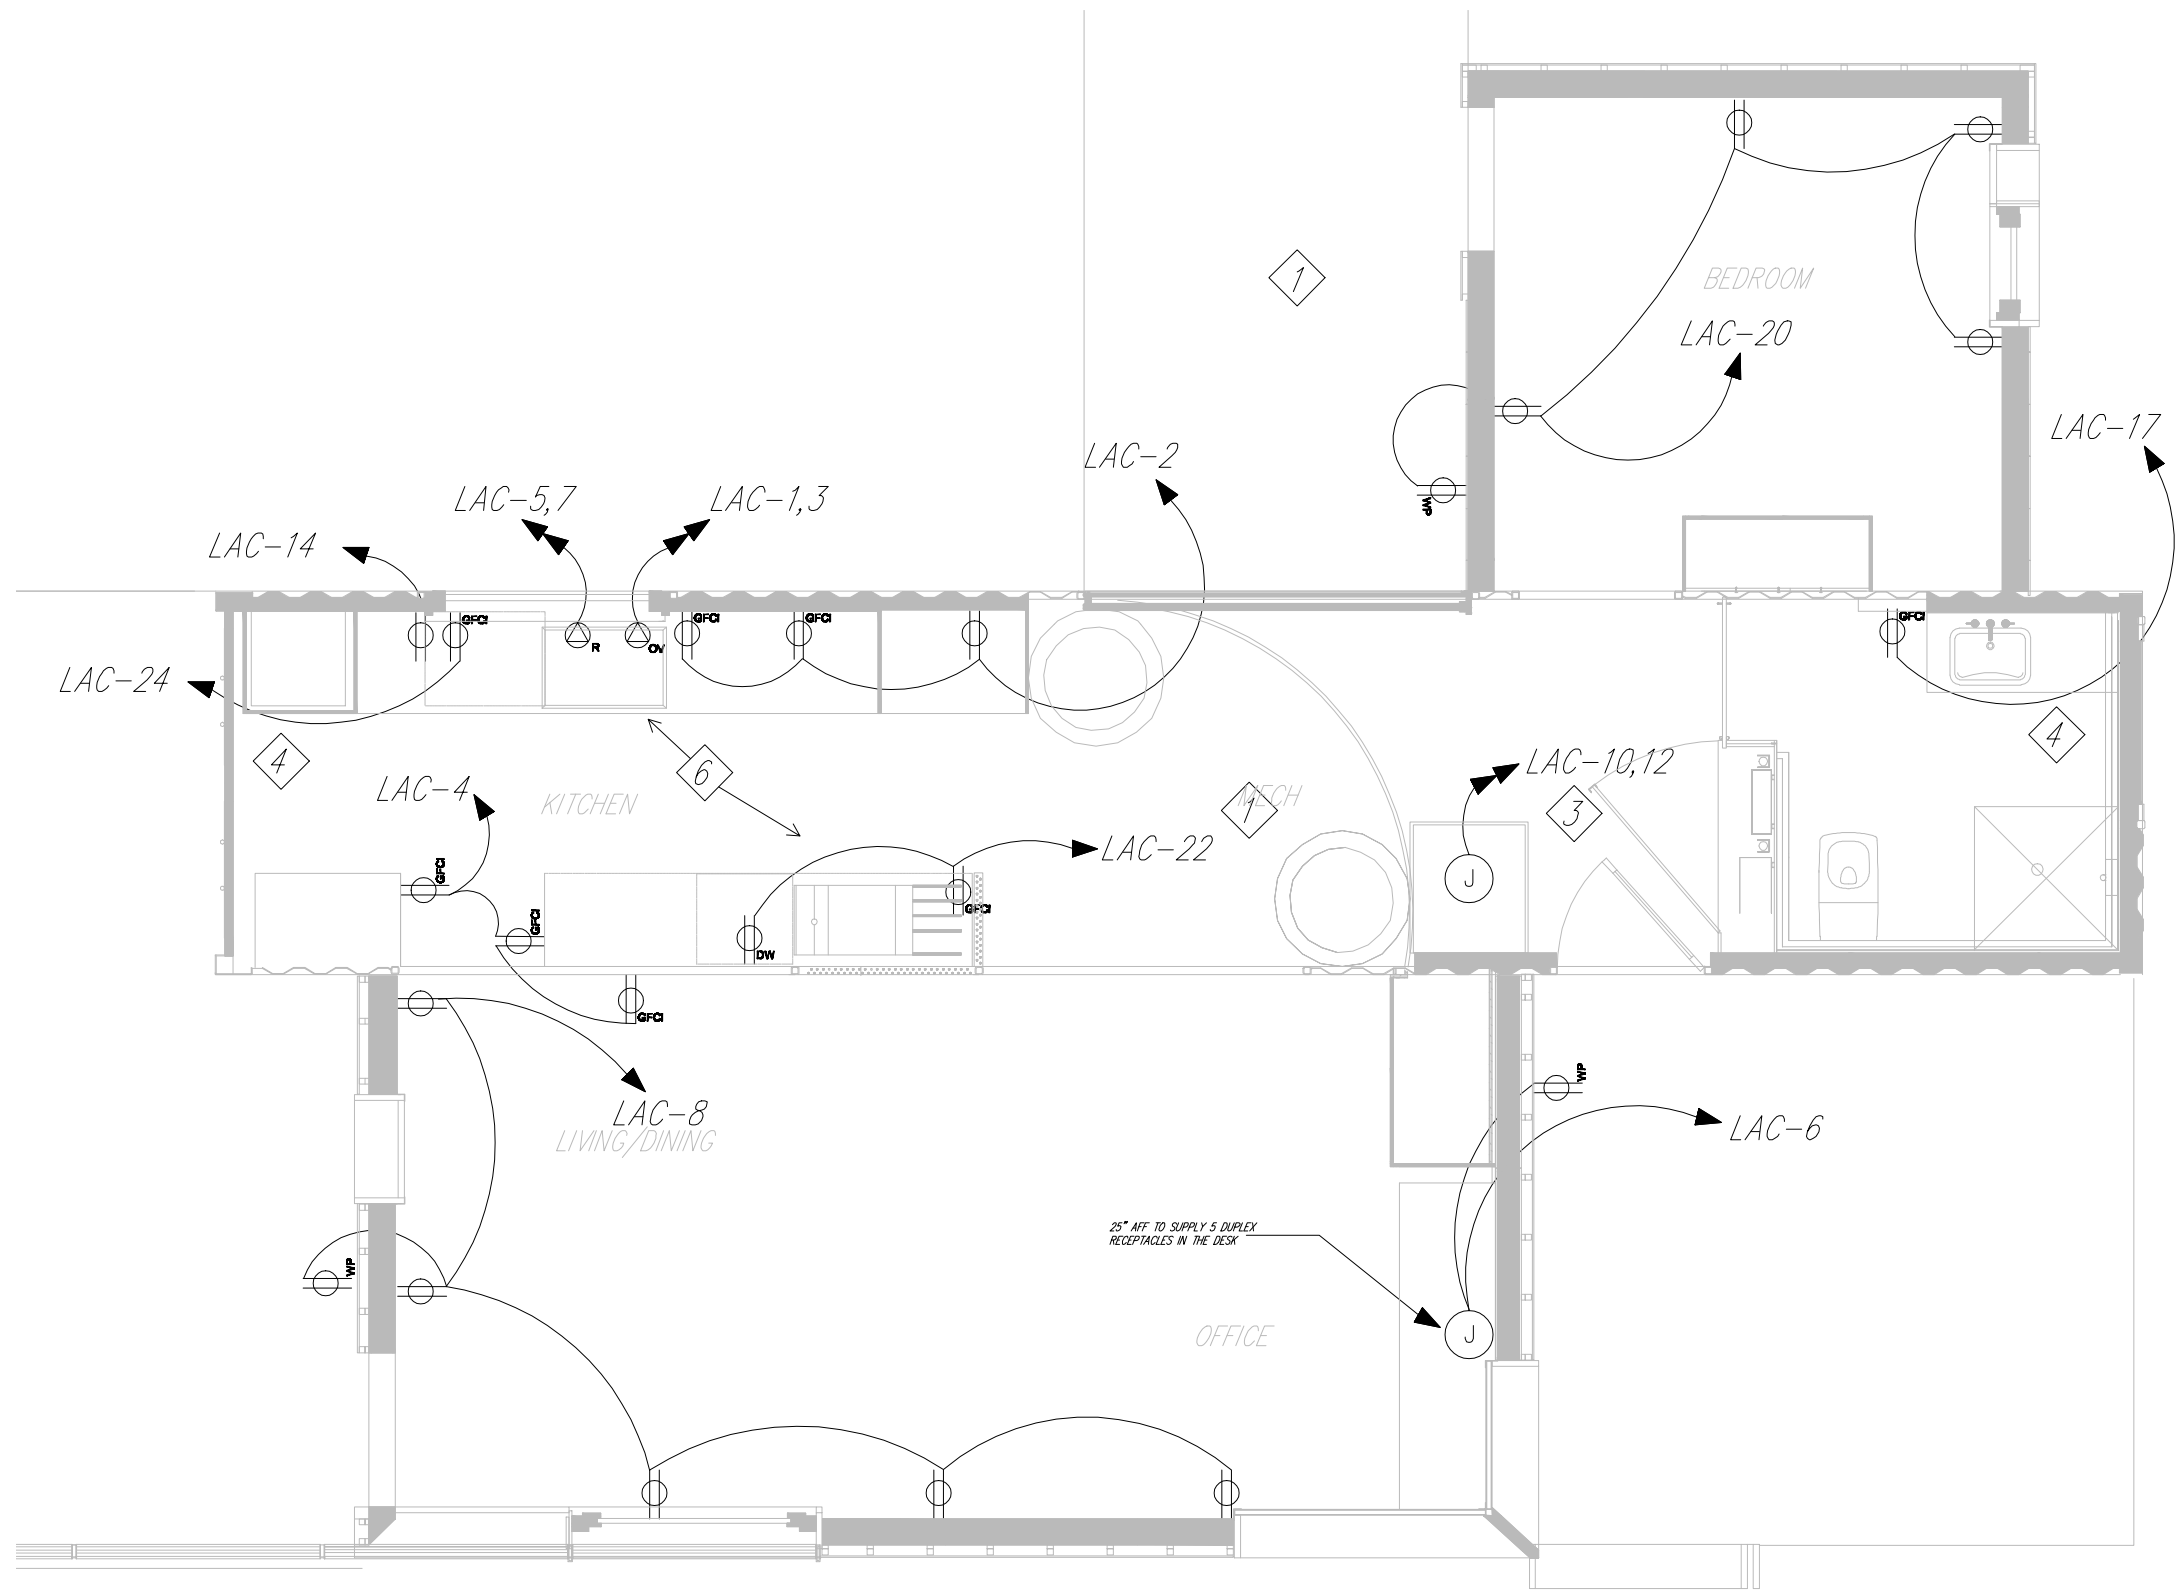

E1.01 KEYNOTE LEGEND

1	WIRES IN ATTIC SPACE SUBJECT TO DERATION AS PER NEC 310.16 FOOTNOTES
2	SEE EQUIPMENT SCHEDULE
3	PANEL LAC TO HAVE PROPER WORKING CLEARANCES AS PER NEC 110.26
4	OUTLETS LOCATED UNDER SHIPPING CONTAINER

 1 GROUND LEVEL POWER PLAN  
SCALE: 1/4" = 1'


Drawn by	Date
J.Baum	August 7, 2007
Revised	Date

Ground Level Power Plan

2007 Solar Decathlon



University of Colorado at Boulder  
Civil, Environmental, and Architectural Engineering  
428 UCB, Room ECCE 441  
Boulder, CO 80509-0428

0' 1' 2' 4' 8'

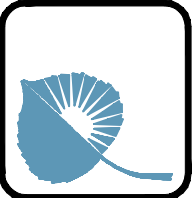

E1.02 KEYNOTE LEGEND

1	15- 1W OUTDOOR LED LUMINAIRES TO BE PLACED AROUND THE PATIO AT LIGHTING DESIGNERS DISCRETION
---	--

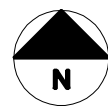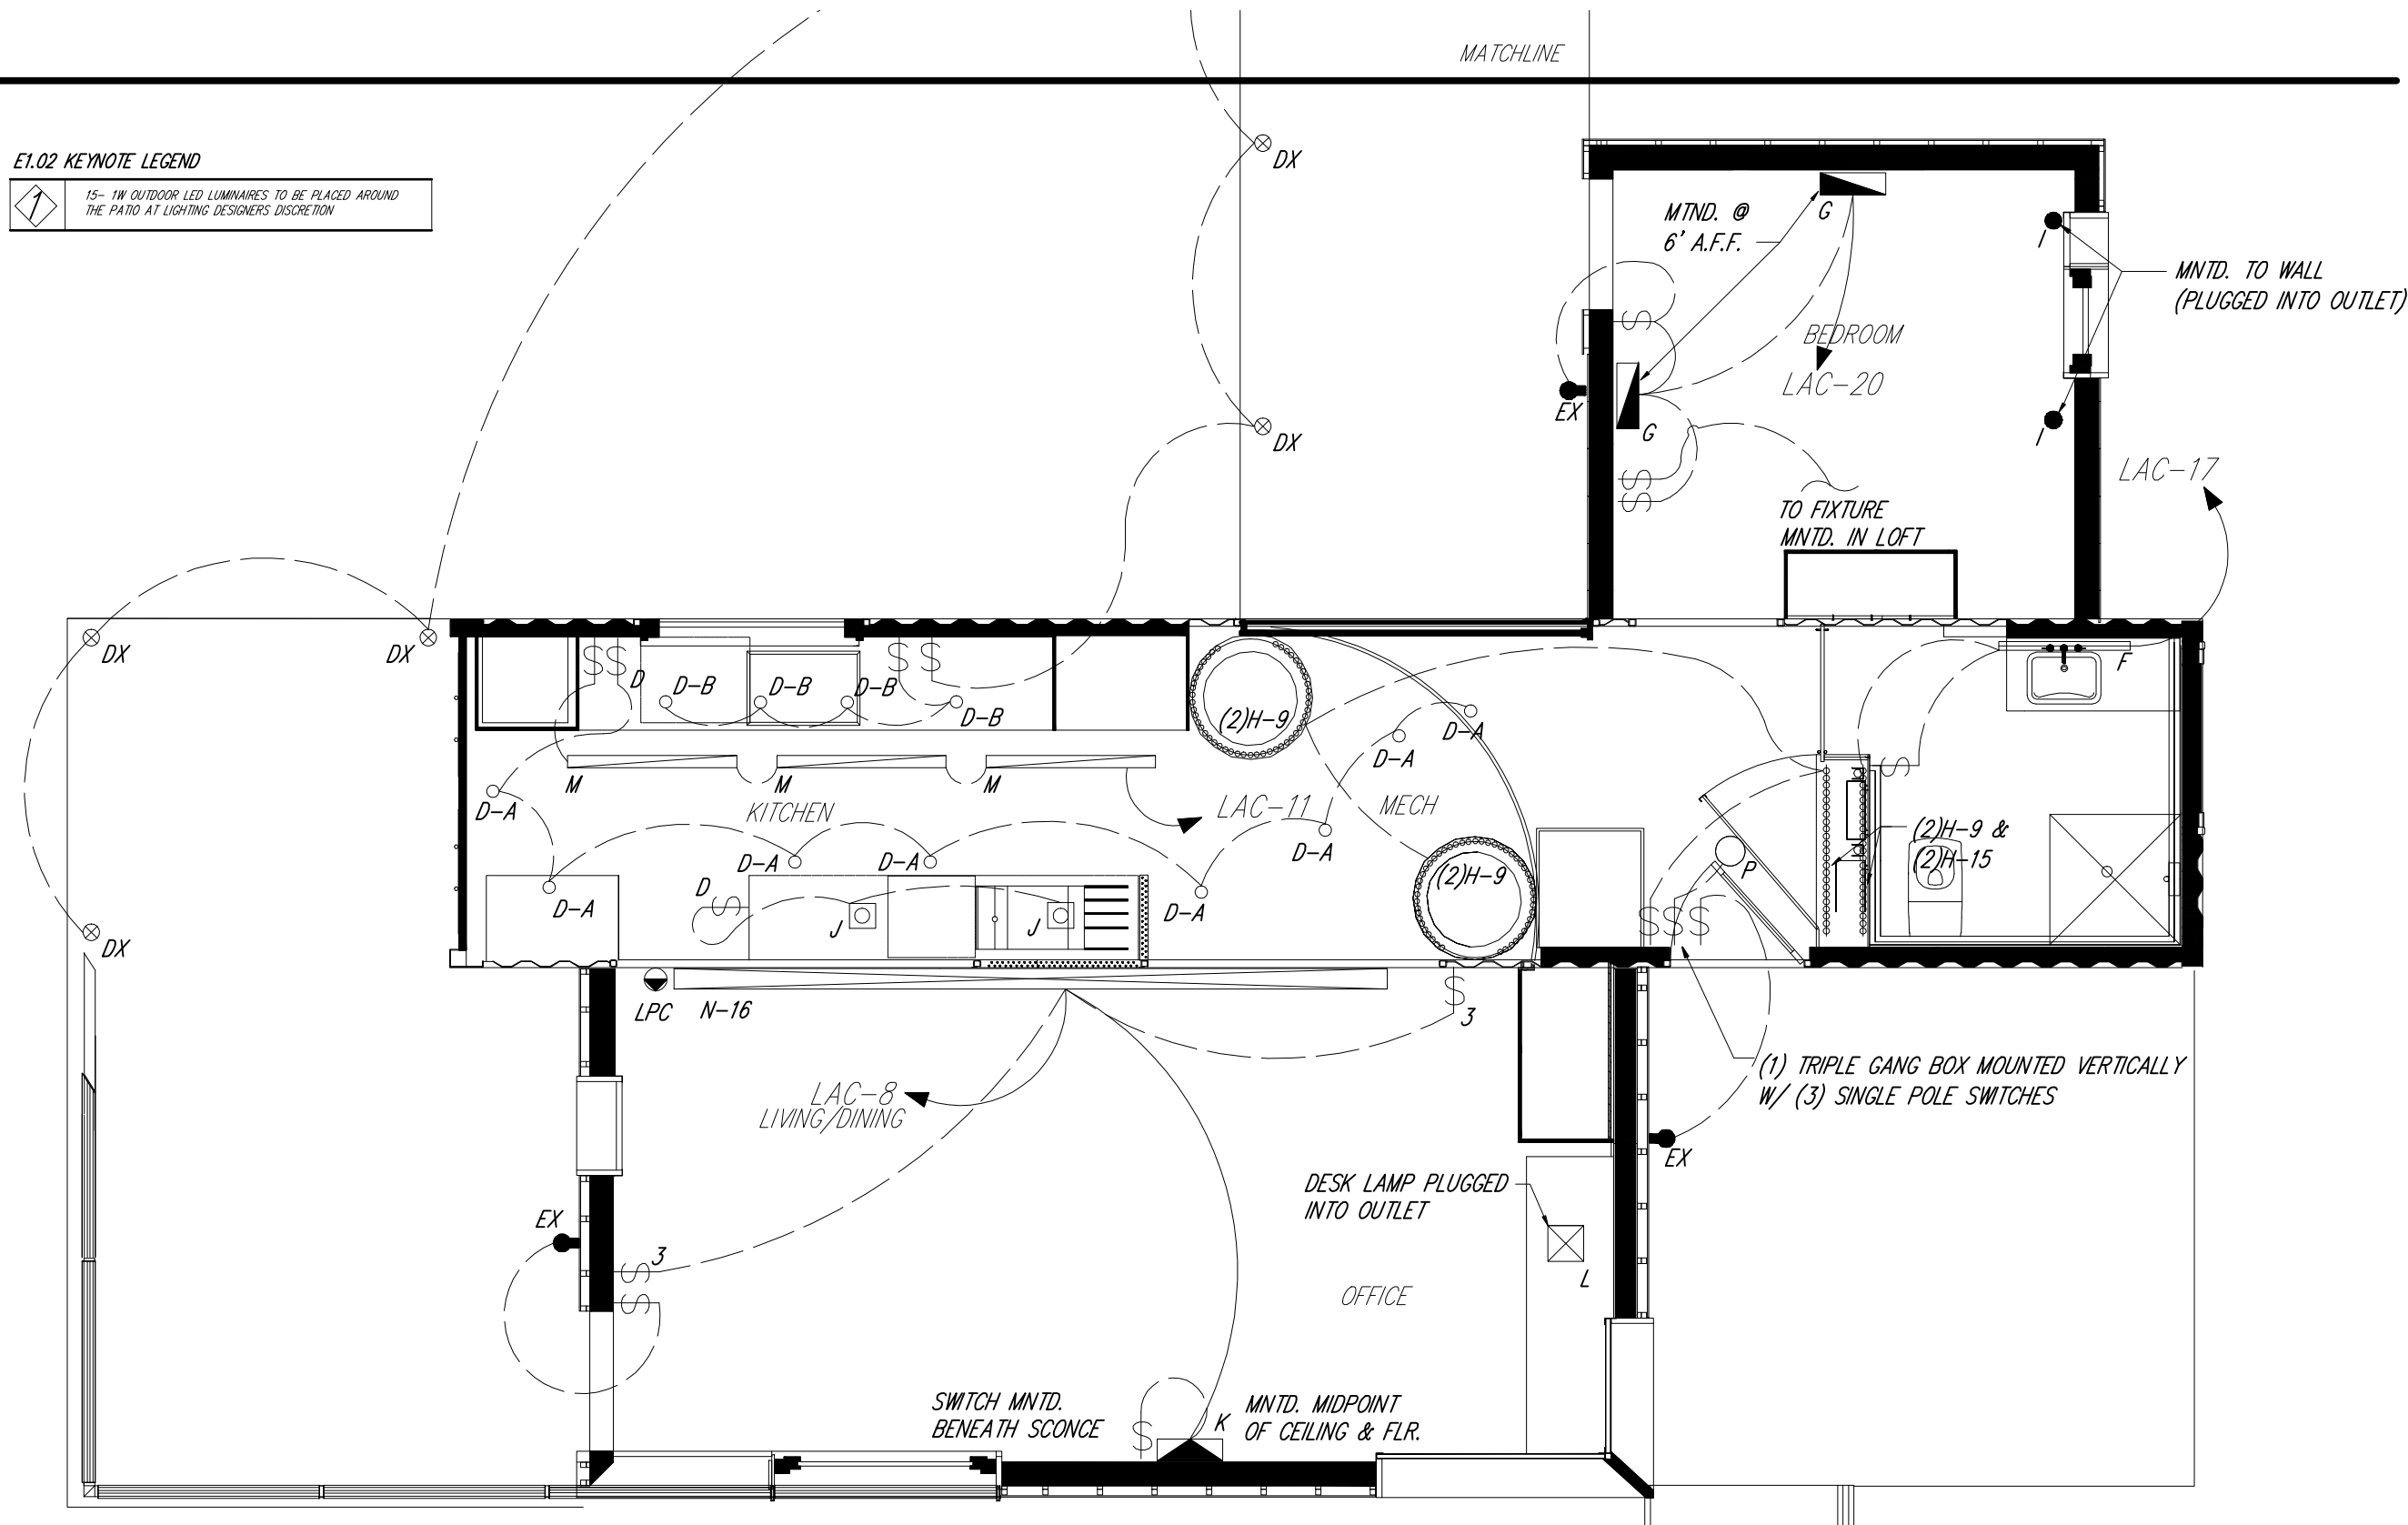

1 GROUND LEVEL LIGHTING PLAN  
SCALE: 1' = 1/4"


Drawn by	Date
J. Baum	August 7, 2007
Revised	Date

2007 Solar Decathlon  
University of Colorado at Boulder  
Civil, Environmental, and Architectural Engineering  
1251 INS. BOM. ERYE 111



Ground Level Lighting Plan





E1.02

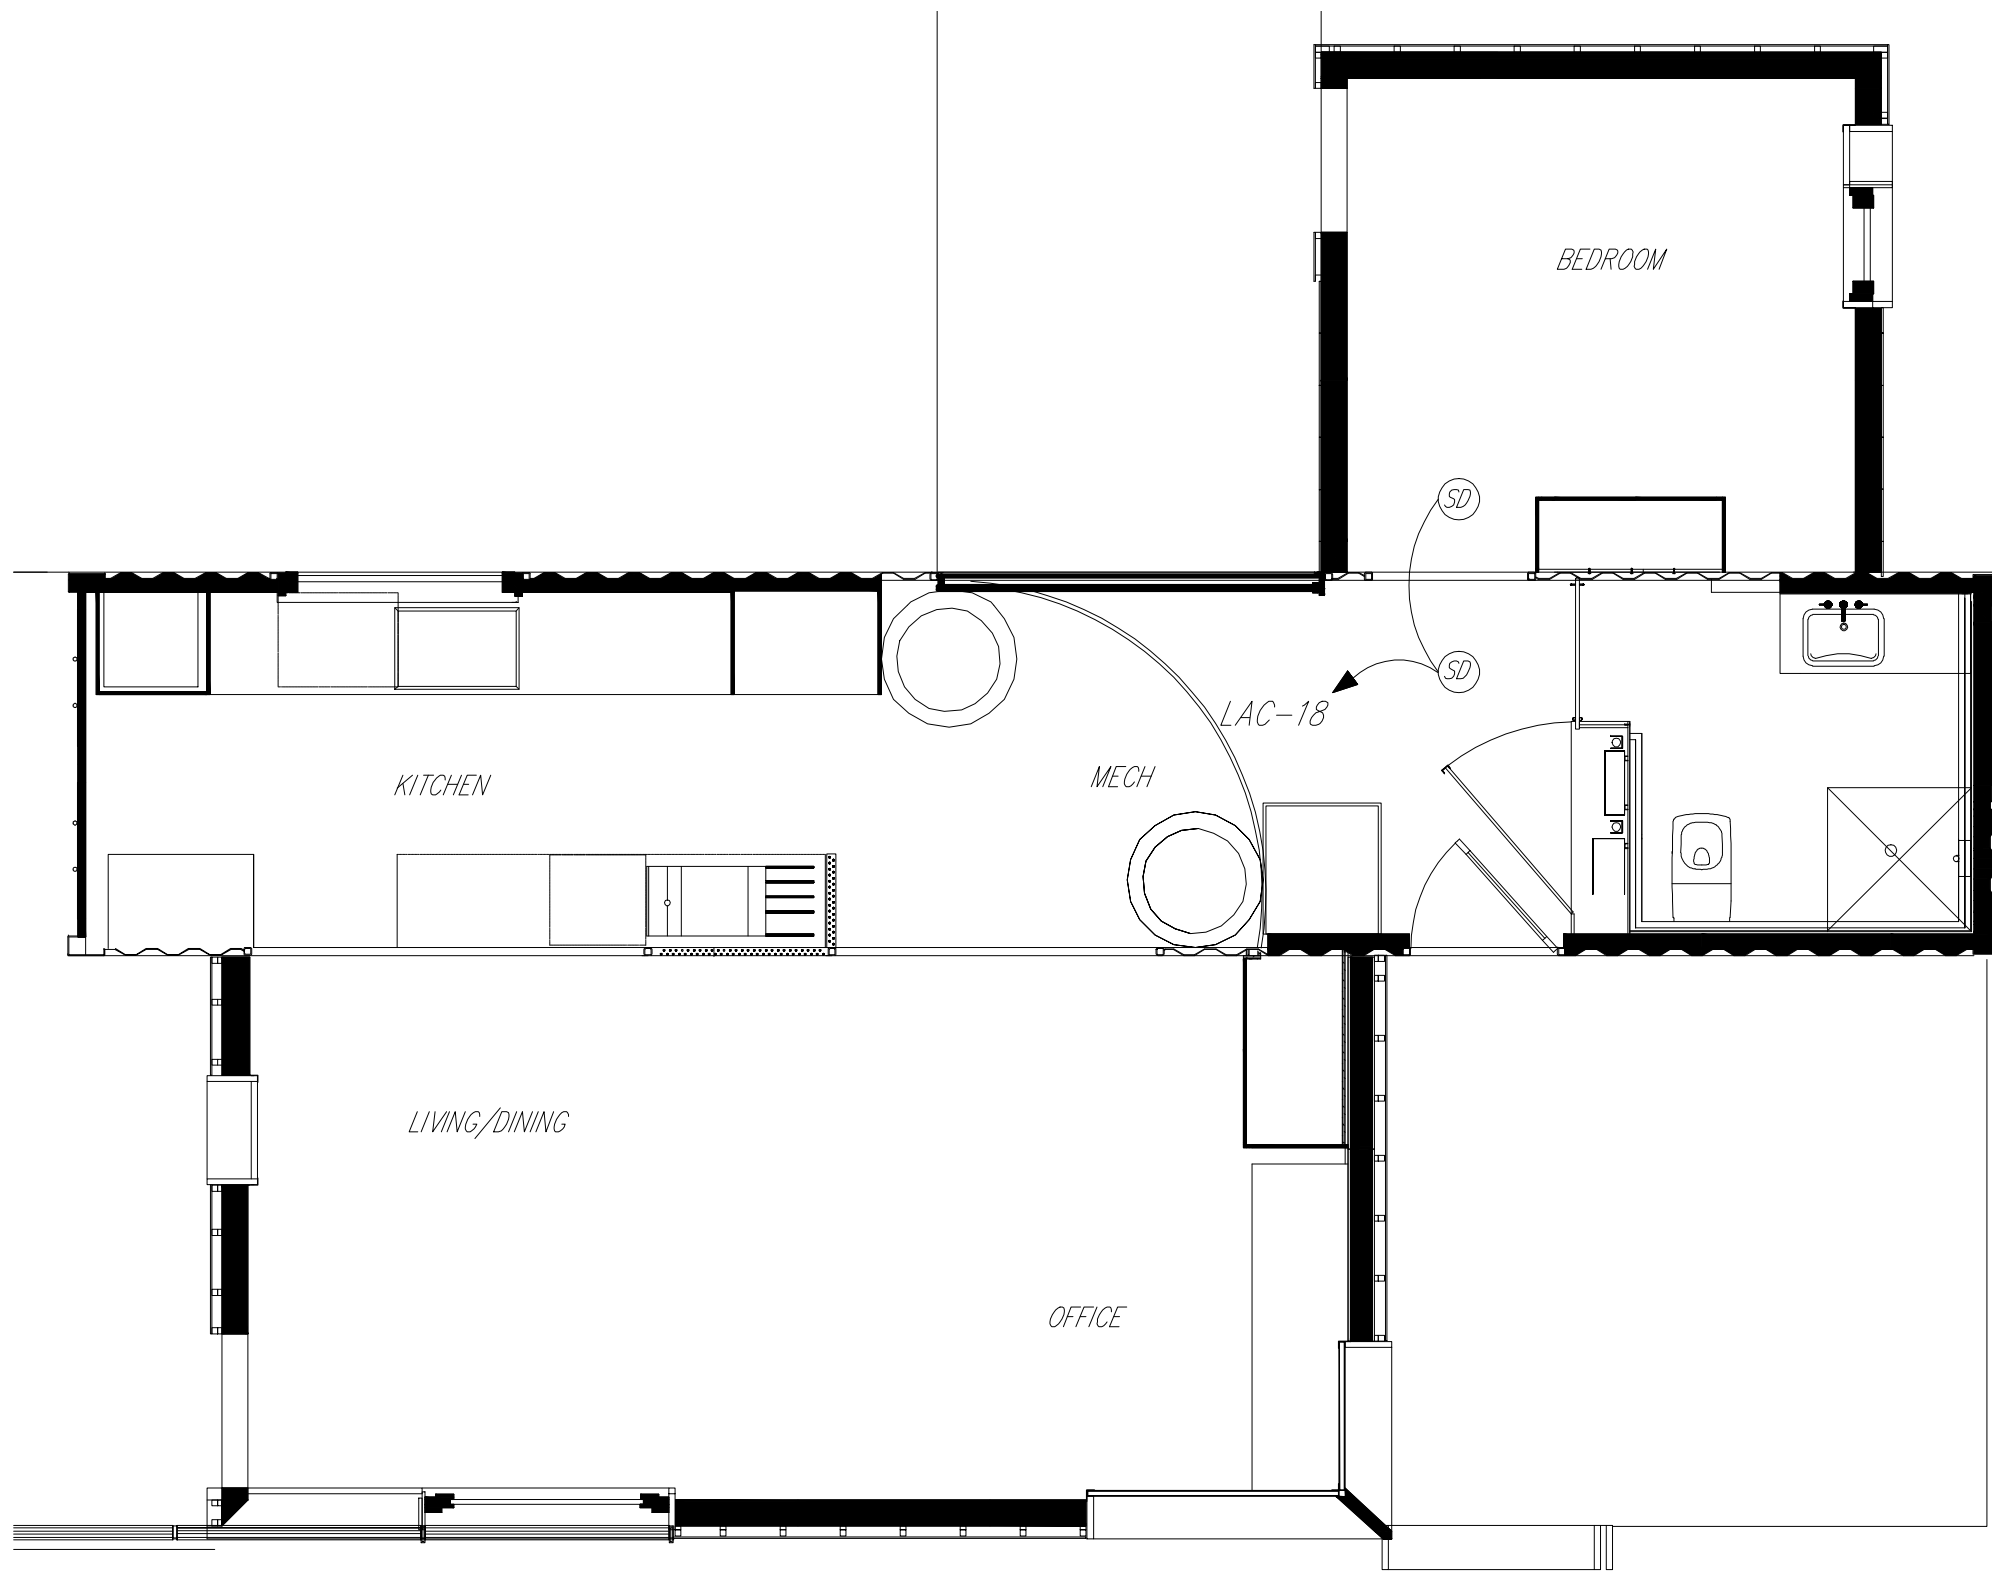

 **1** FIRE SAFETY PLAN  
SCALE: 1' = 1/4"

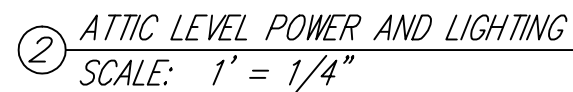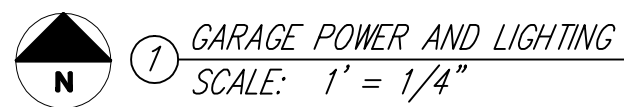

1	BATTERY RACK TO BE MADE OF CORROSION RESISTANT METAL
2	ALL ELECTRICALLY ENERGIZED PARTS ARE TO HAVE PROPERLY INSULATED COVERINGS
3	BATTERY RACK TO HAVE PROPER WORKING CLEARANCES AS PER NEC 110.26
4	BATTERY STORAGE ENTRANCE IS TO HAVE SIGNAGE DECLARING THAT AUTHORIZED PERSONAL ONLY IS ALLOWED
5	EXPLOSION PROOF LIGHT FIXTURES TO BE MOUNTED ABOVE EACH BATTERY SHELF
6	LUGS IN POP WILL BE RATED FOR THE TYPE OF CONDUCTORS THAT WILL BE ATTACHED TO THE LUG

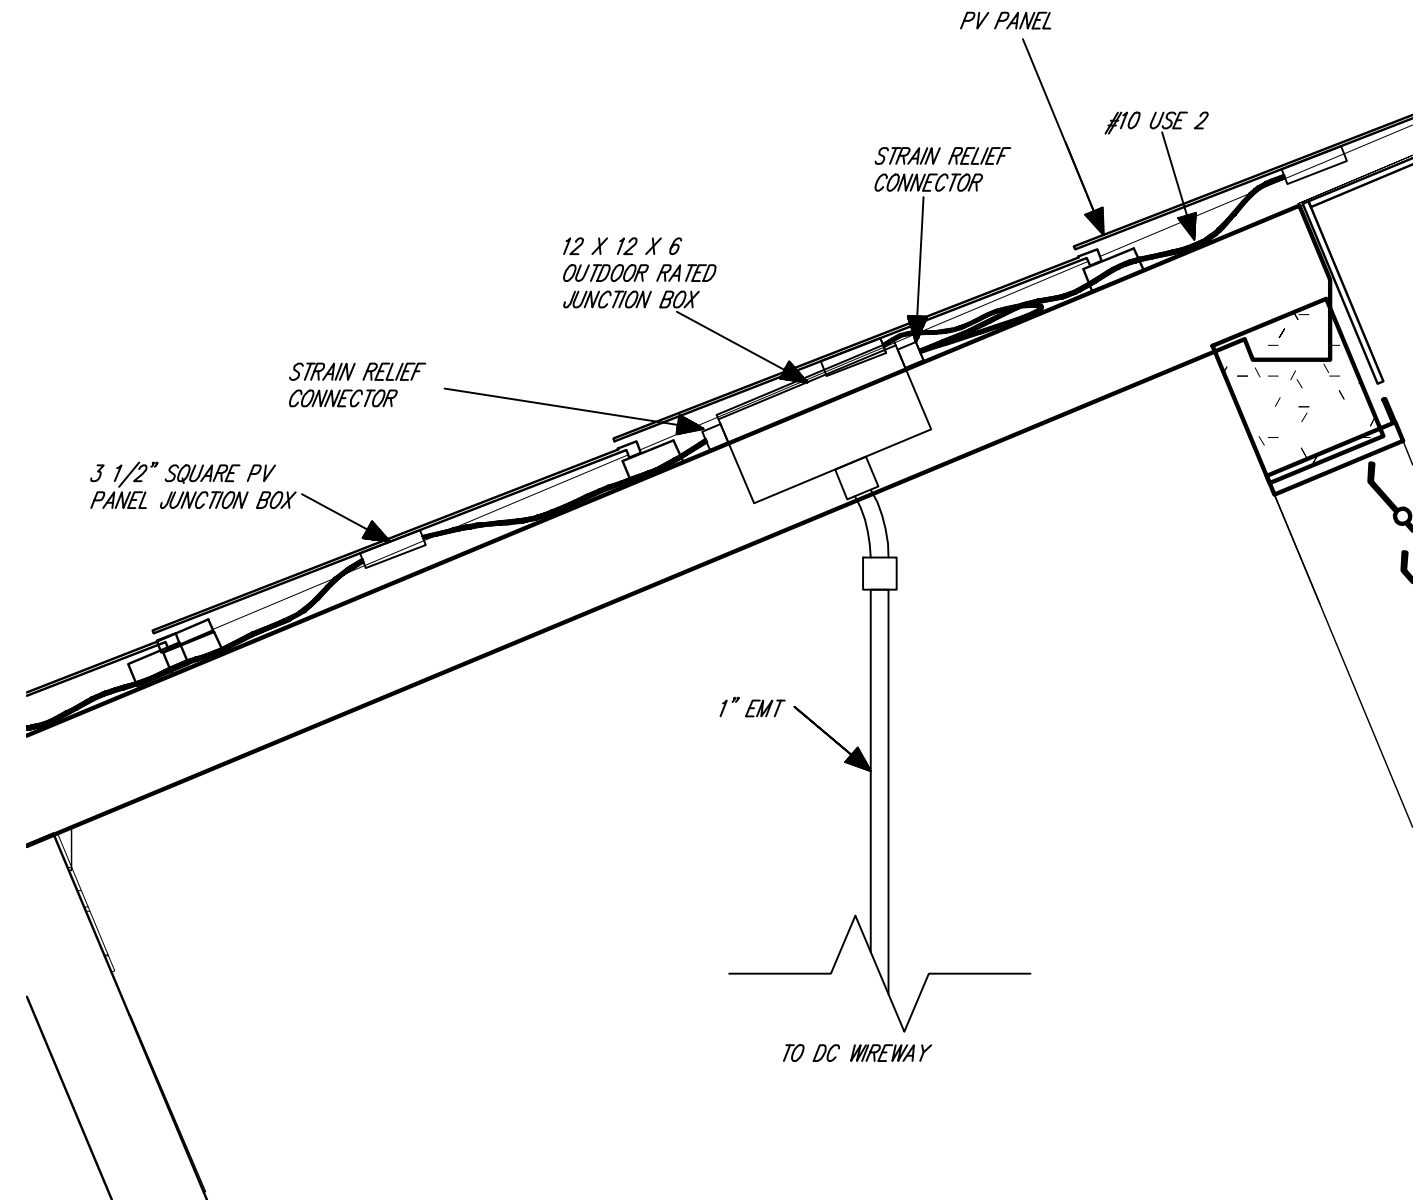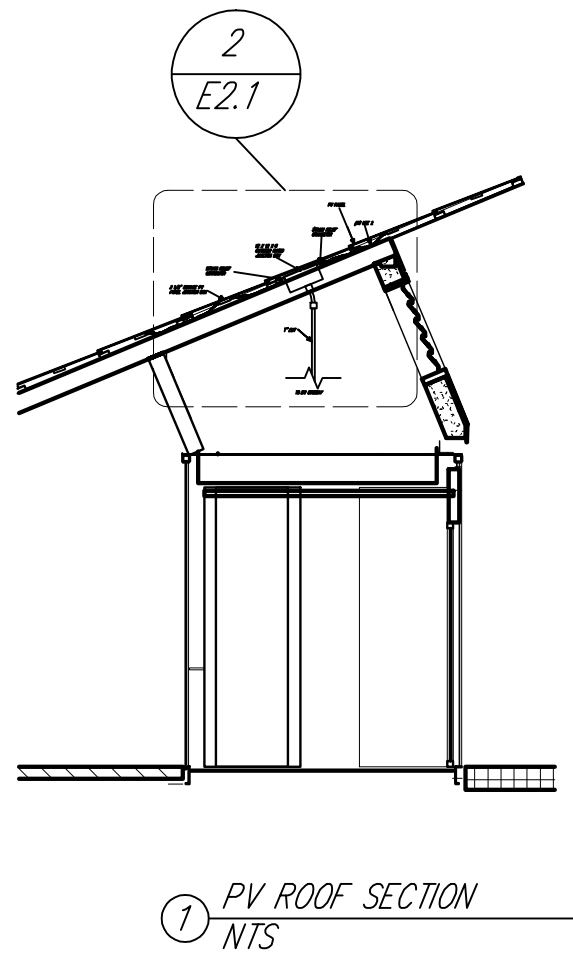


2 PV ROOF PENETRATION DETAIL  
SCALE: 1" = 1'


Drawn by	Date
J. Baum	August 7, 2007
Revised	Date







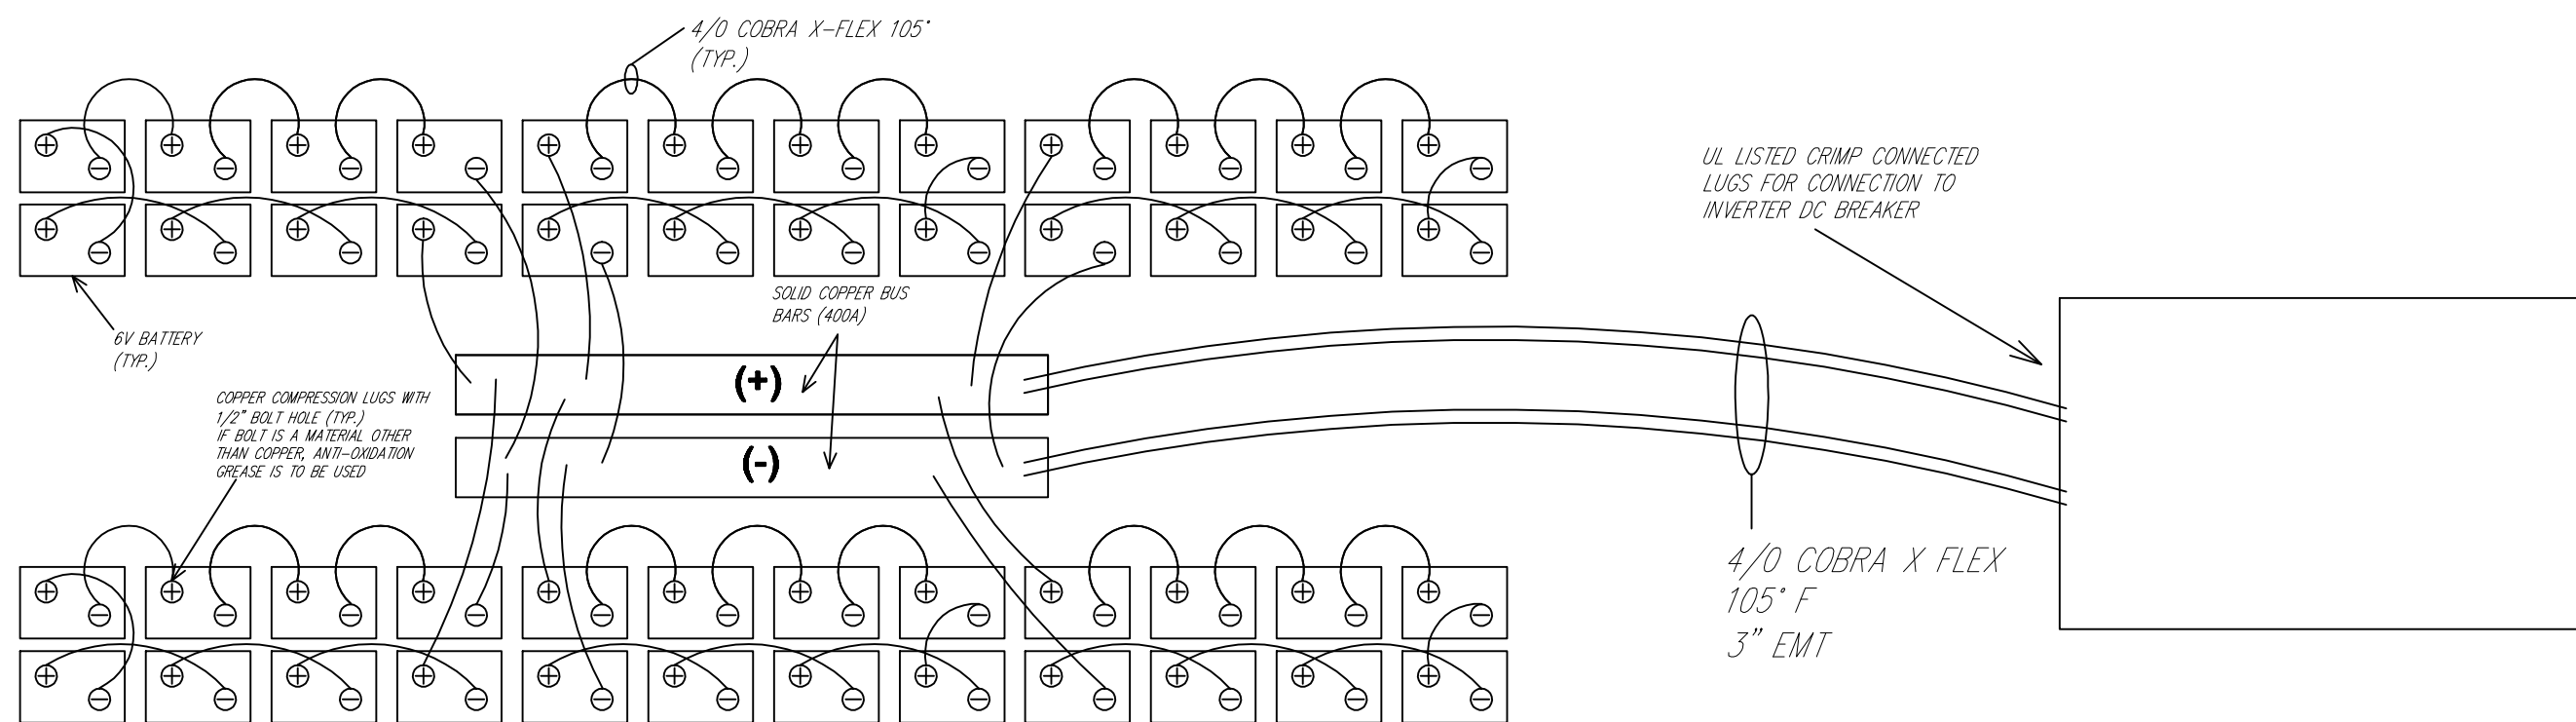


1 BATTERY WIRING DETAIL  
NTS

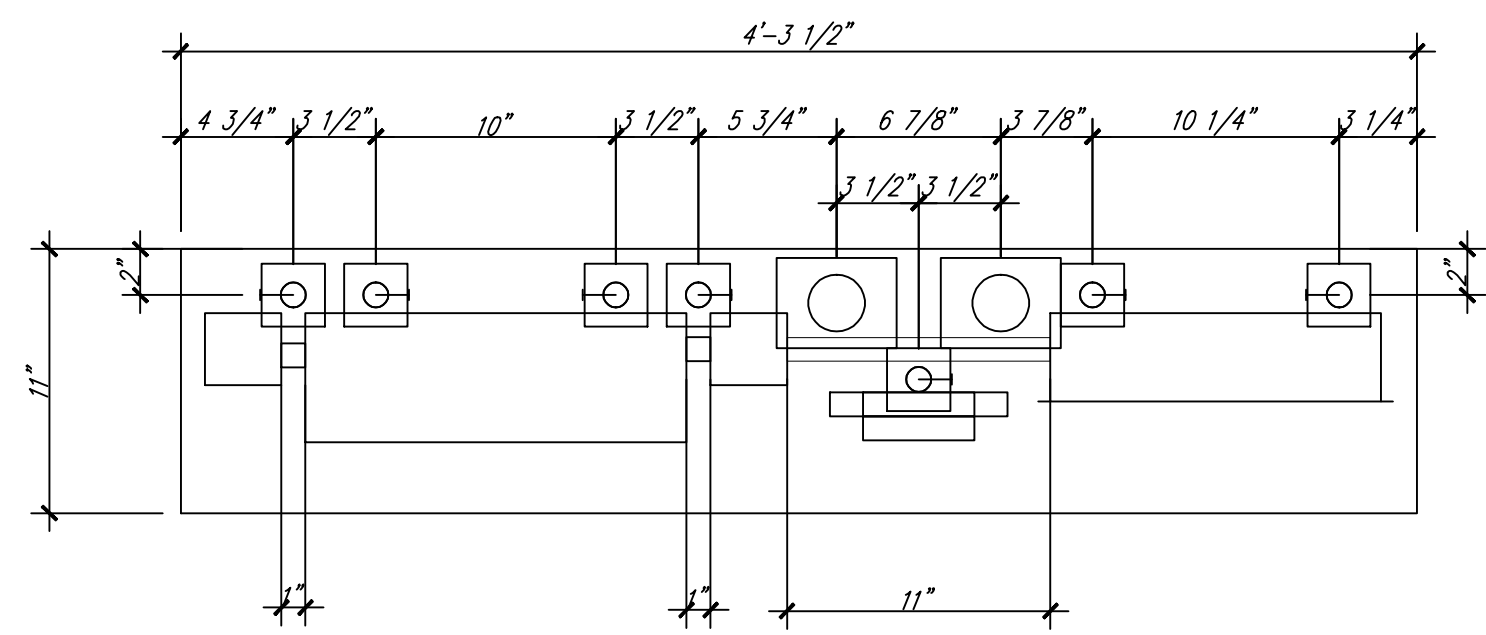

1 FAT WALL PLAN  
SCALE: 1- 1/2" = 1'

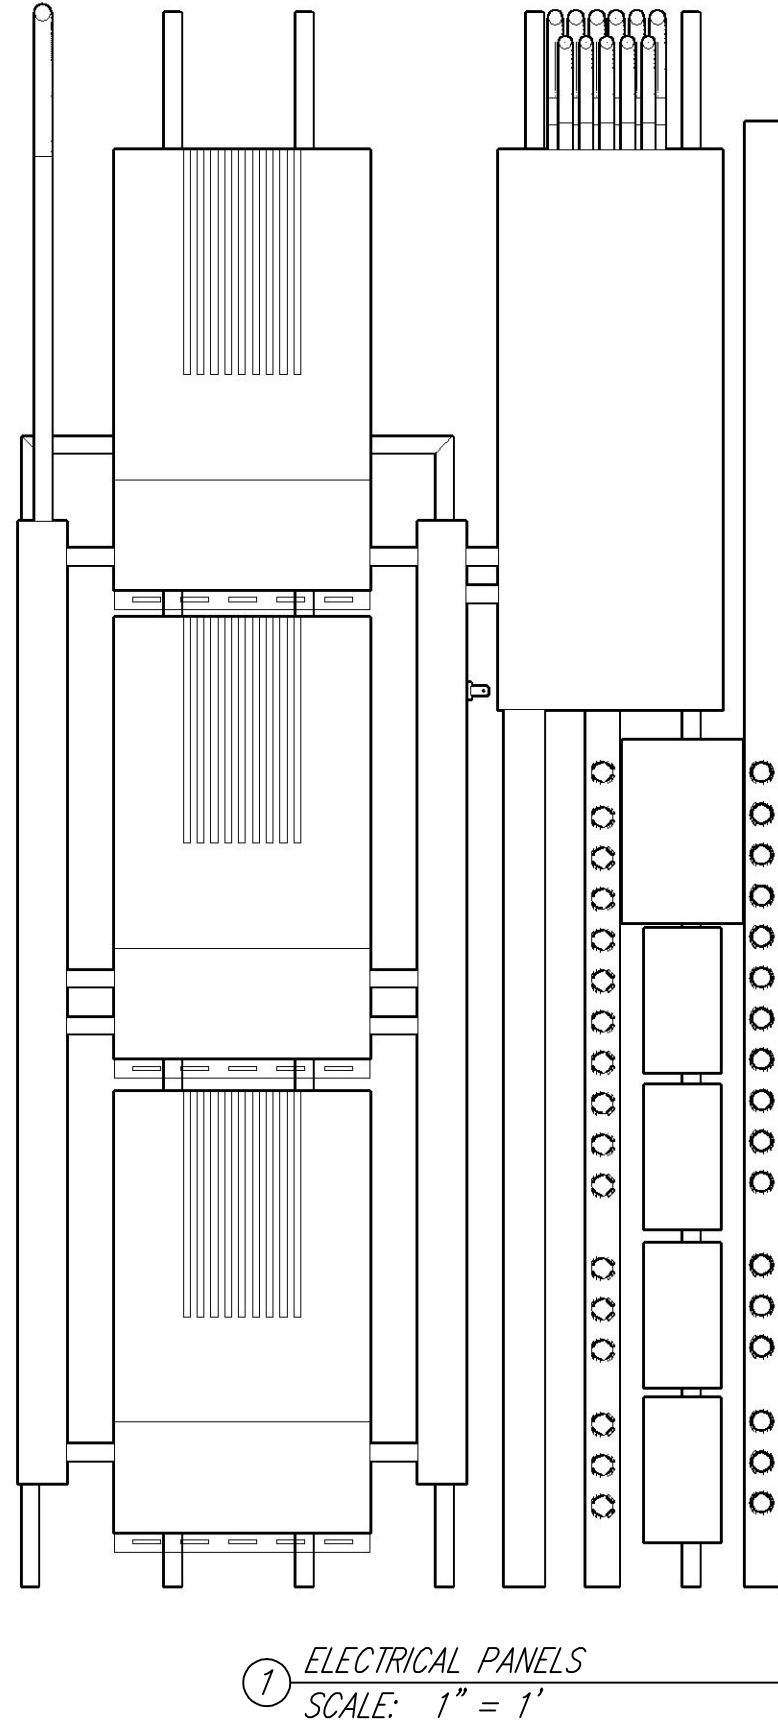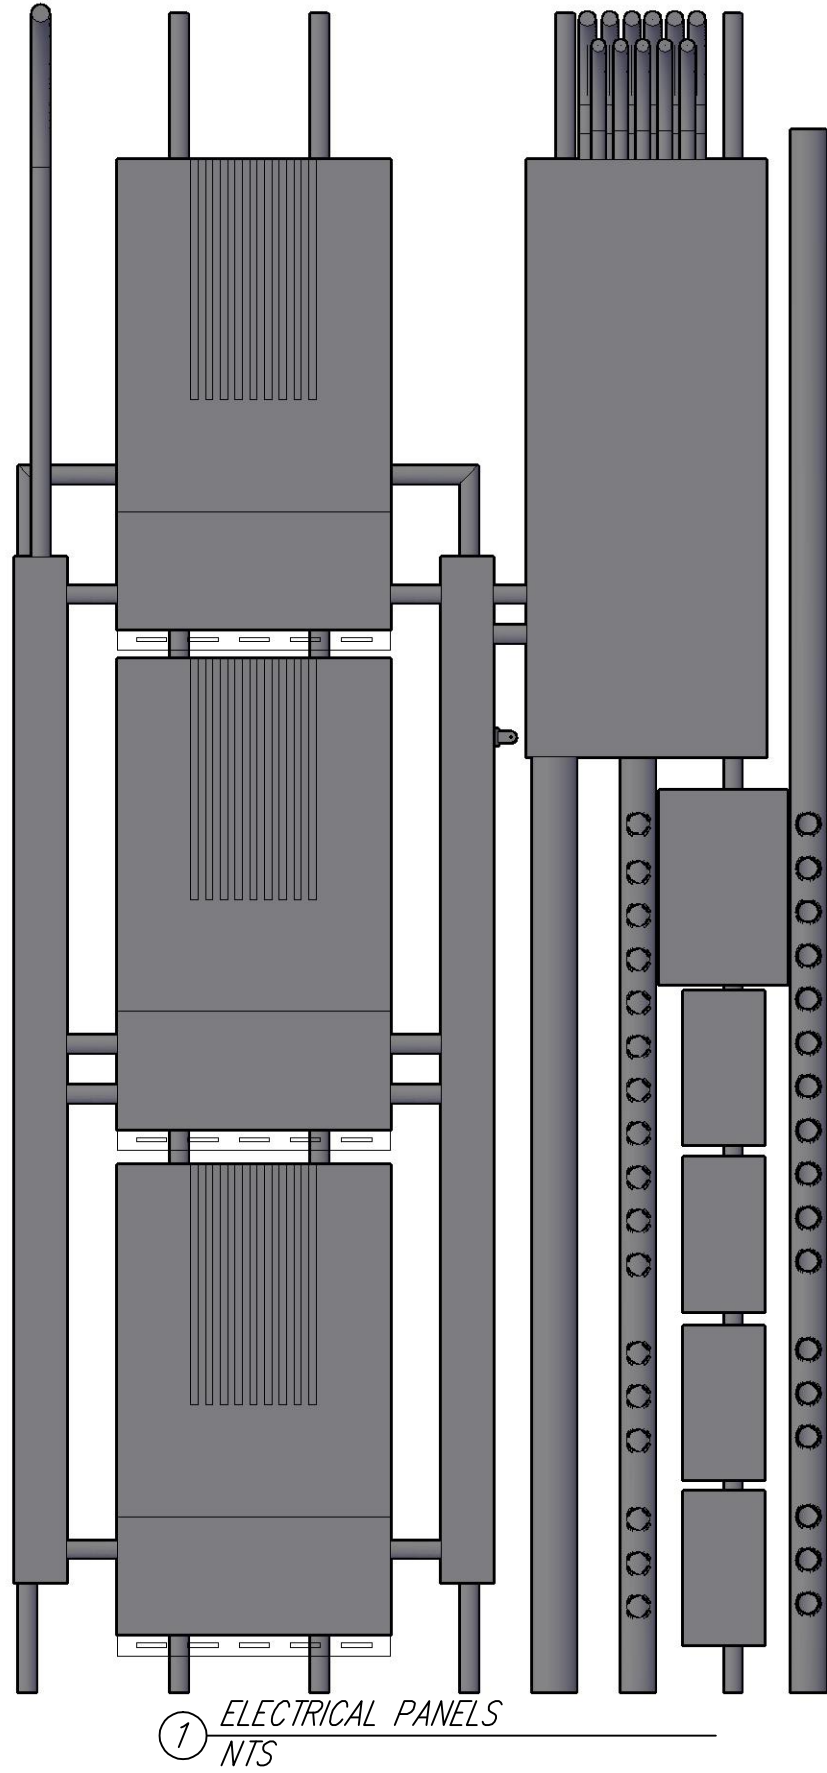

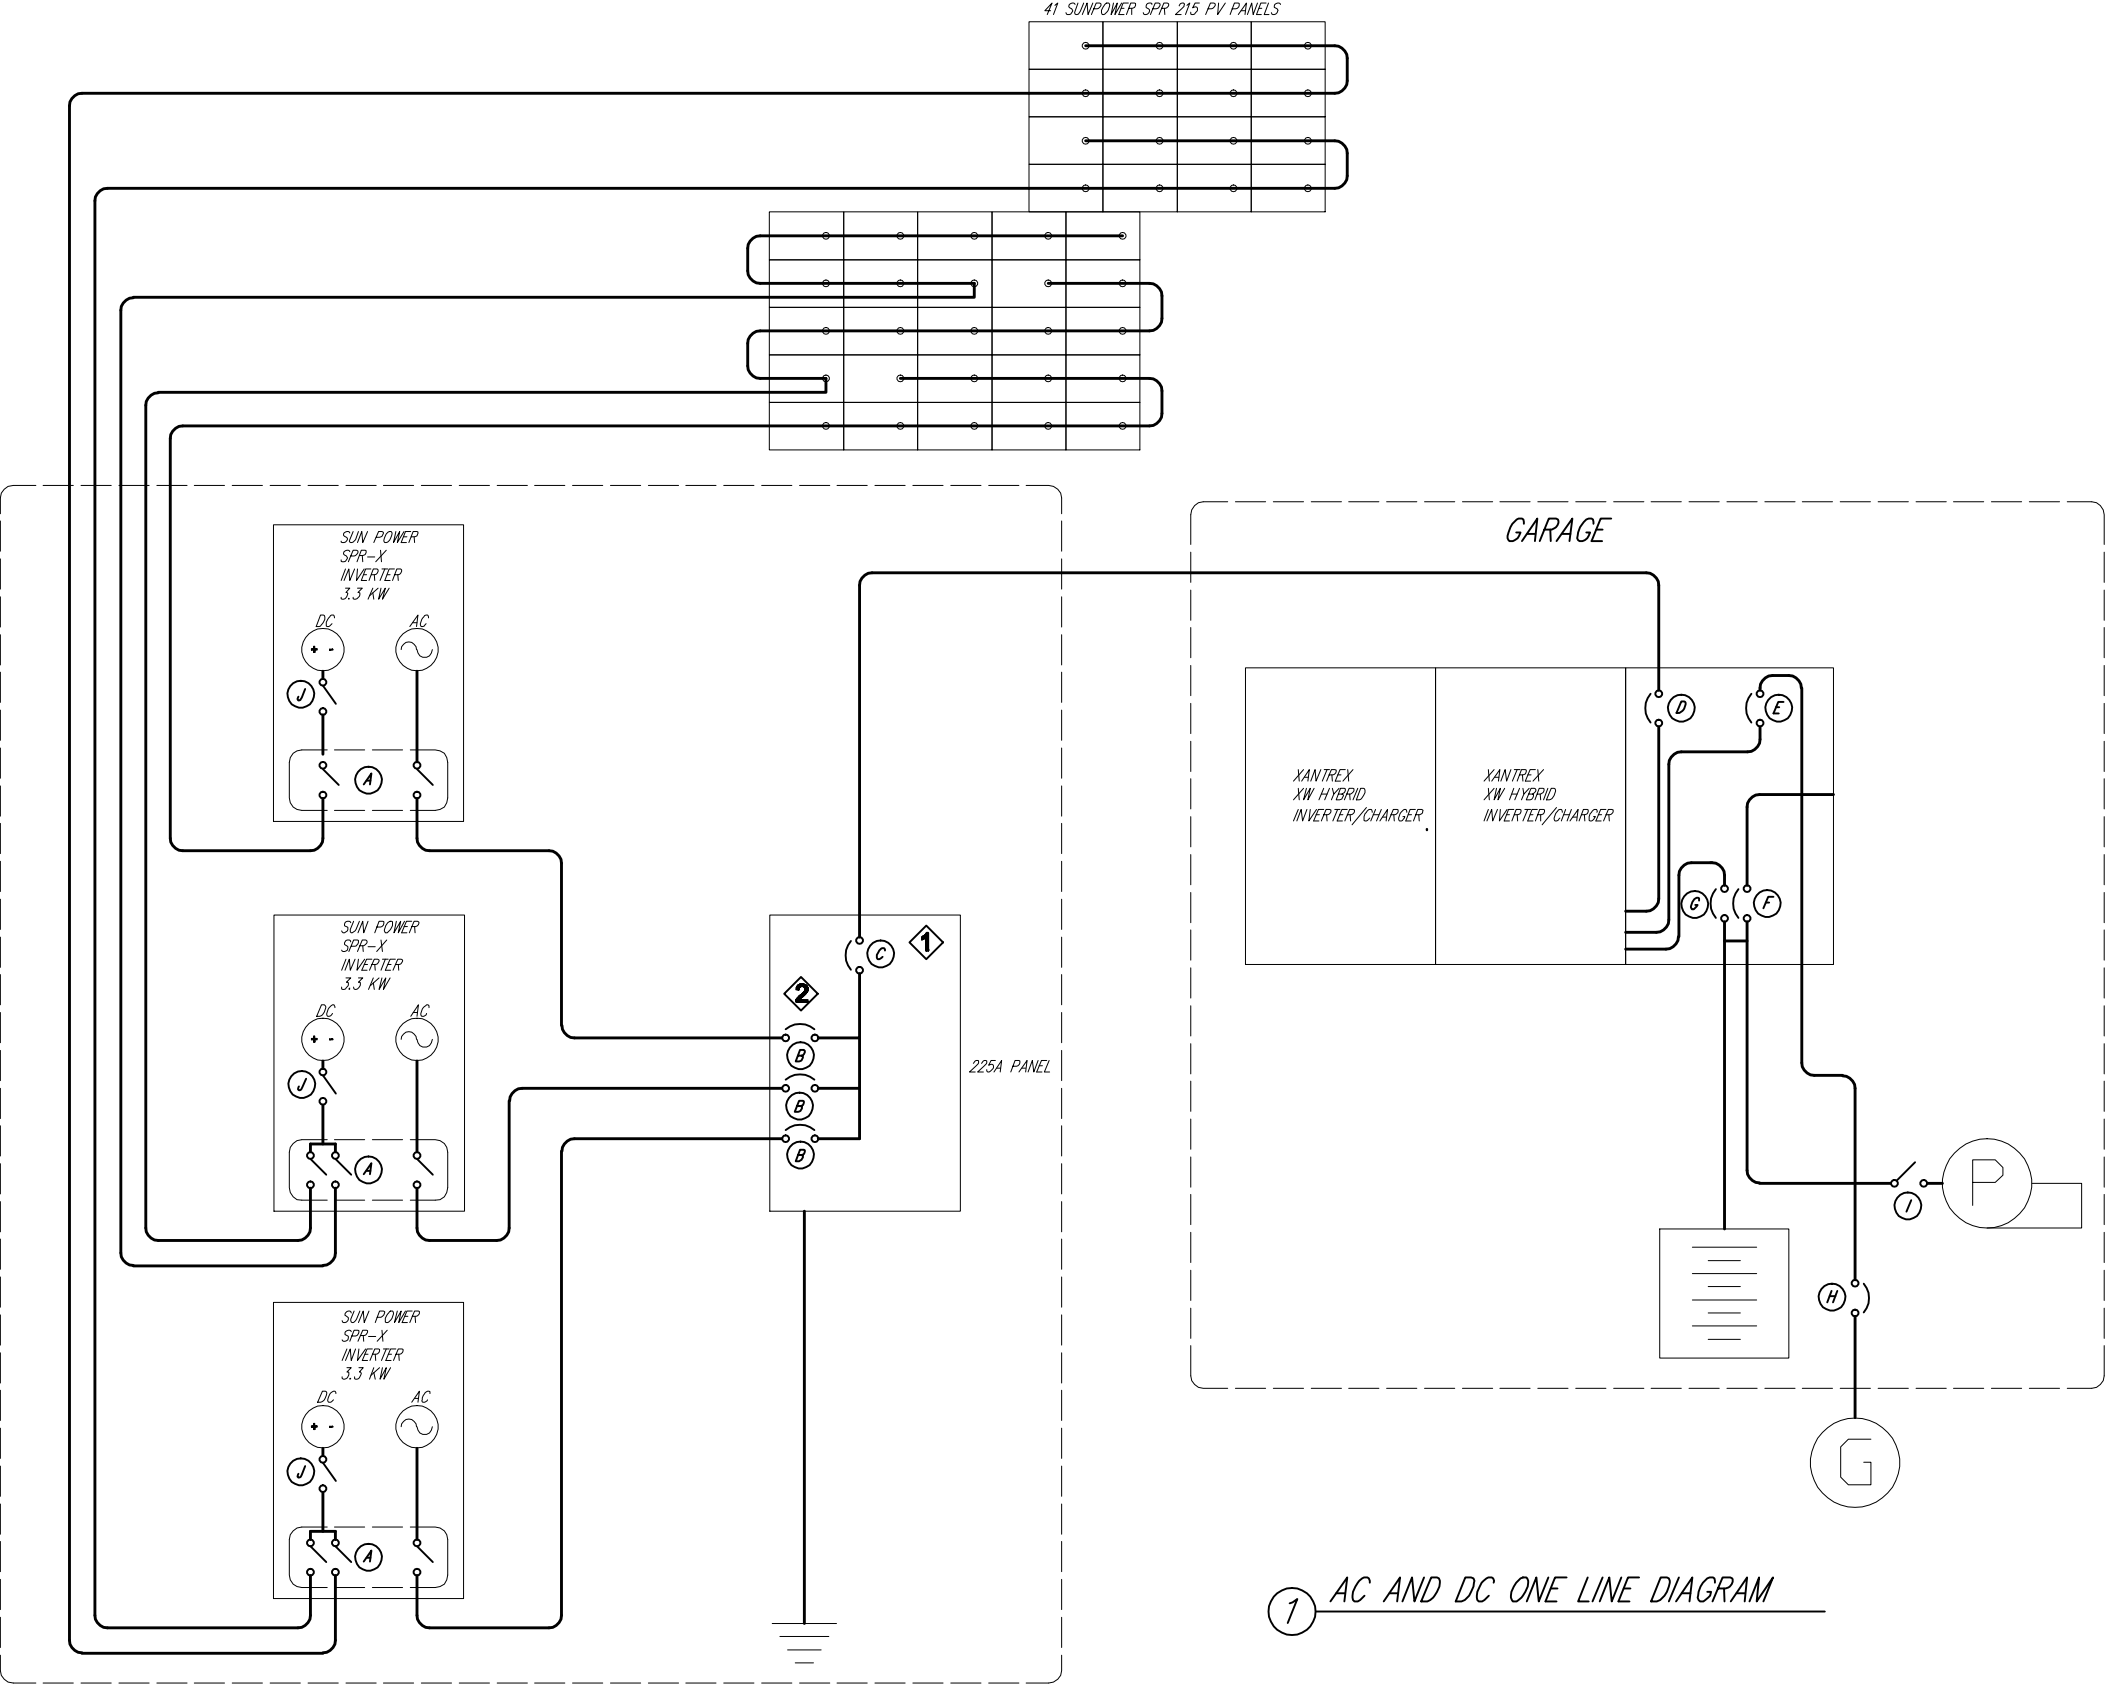

1 AC AND DC ONE LINE DIAGRAM

GENERAL NOTES

PANEL LAC IS TO IS TO BE DURABLY MARKED WITH VOLTAGE AND CURRENT RATING AND THE NUMBER OF PHASES AND THE MANUFACTURERS NAME OR TRADE MARK

ALL DISCONNECTS FOR THE INDIVIDUAL EQUIPMENT AND BATTERIES ARE TO BE MARKED WITH A PERMANENT PLAQUE NEAR THE SPECIFIED EQUIPMENT


KEYNOTE SCHEDULE

1	DISCONNECT IS TO BE MARKED WITH A PERMANENT PLAQUE IN A VISIBLE LOCATION NEAR THE DISCONNECT
2	INVERTER SUPPLY POWER DISCONNECT IS TO BE MARKED WITH A PERMANENT PLAQUE IN A VISIBLE LOCATION NEAR THE DISCONNECT
3	AC AND DC DISCONNECT LOCATED IN INVERTER AS PER 690.14 (C)(1) EXCEPTION AND 690.31(E)

DISCONNECT SCHEDULE

A	20A AC/DC DISCONNECT LOCATED ON INVERTER
B	20A 2-POLE CIRCUIT BREAKER
C	200A 2-POLE MAIN BREAKER
D	200A 2-POLE MAIN BREAKER
E	20A AC GENERATOR BREAKER DISCONNECT
F	AUXILIARY 15A DC BREAKER DISCONNECT
G	BATTERY DC DISCONNECT: 4- 250A BREAKERS
H	20A GENERATOR AC BREAKER DISCONNECT
I	15A PUMP DC DISCONNECT
J	1A GROUND FAULT PROTECTION DEVICE (GFPD)



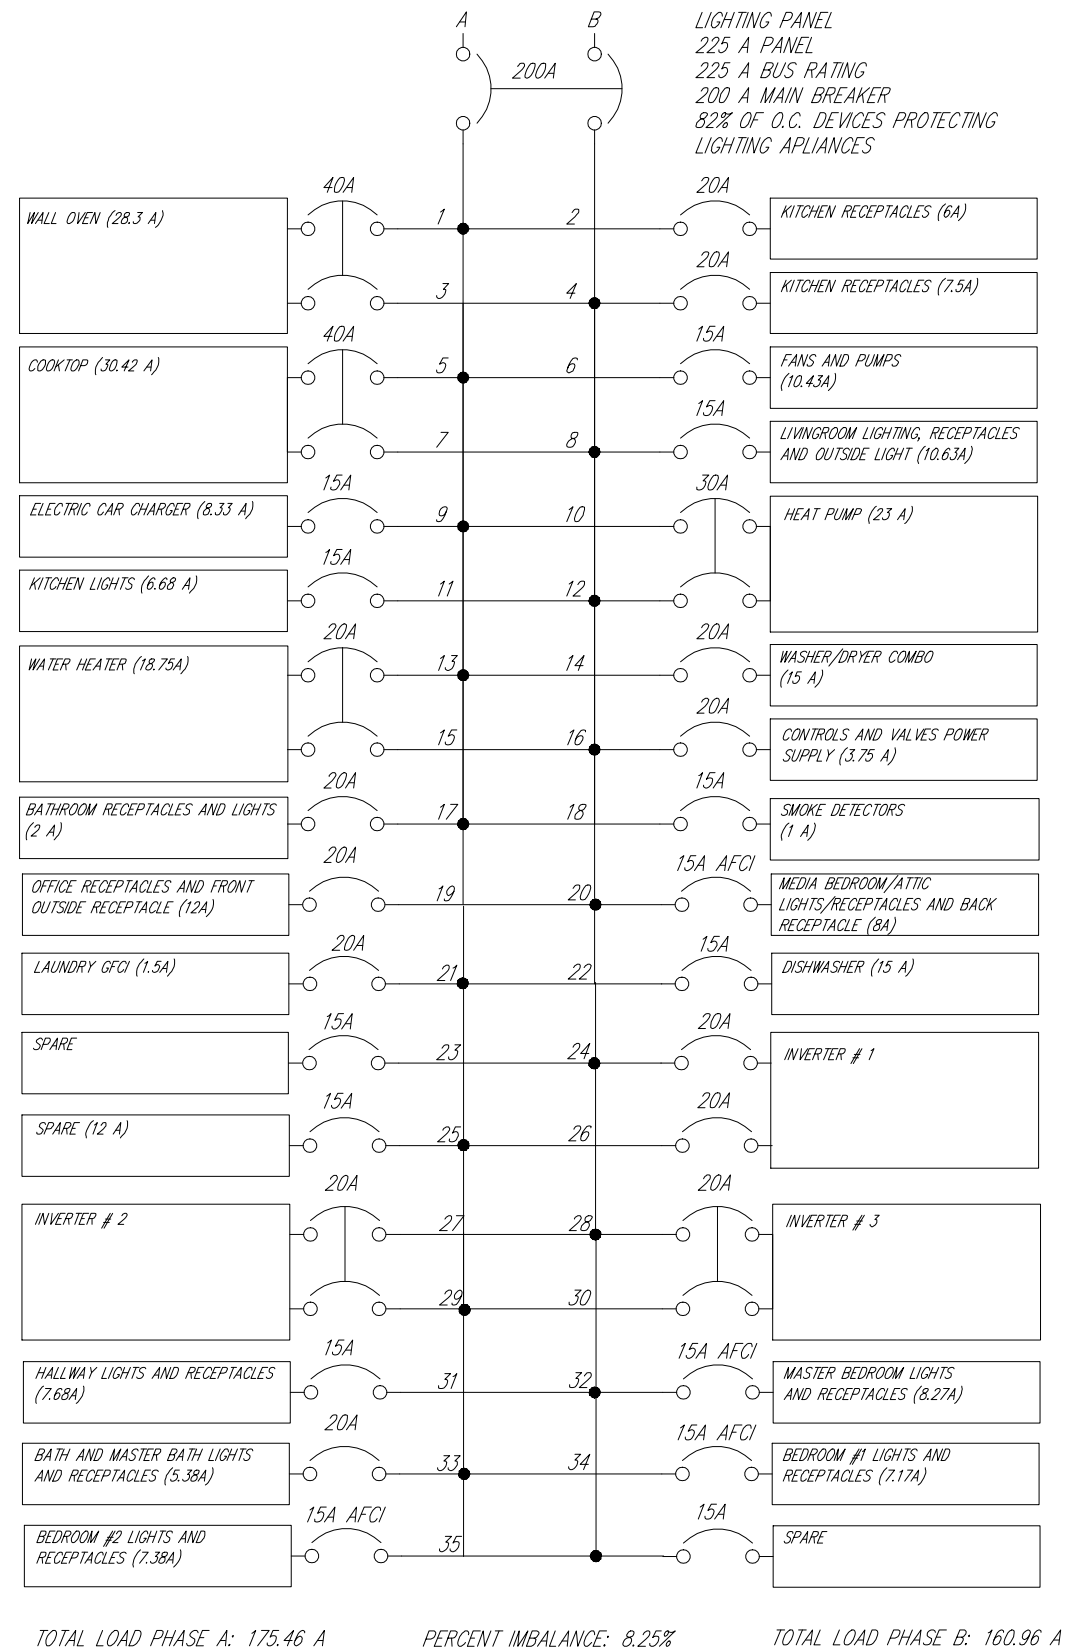

1 PANEL SCHEDULE

PANEL SCHEDULE TO BE LOCATED IN PANEL LAC

1	WALL OVEN (40A)	KITCHEN RECEPTACLES (20A)	2
3		KITCHEN RECEPTACLES (20 A)	4
5	COOKTOP (40A)	FANS AND PUMPS (15A)	6
7		LIVINGROOM LIGHTING, RECEPTACLES AND OUTSIDE LIGHT (20 A)	8
9	ELECTRIC CAR CHARGER (15 A)	HEAT PUMP (30 A)	10
11	KITCHEN LIGHTS (7 A)		12
13	FUTURE WATER HEATER	WASHER/DRYER COMBO (15 A)	14
15		CONTROLS AND VALVES POWER SUPPLY (15A)	16
17	BATHROOM RECEPTACLES AND LIGHTS (15A)	SMOKE DETECTORS (15 A)	18
19	OFFICE RECEPTACLES AND FRONT OUTSIDE RECEPTACLE (20A)	BEDROOM/ATTIC LIGHTS/RECEPTACLES AND BACK RECEPTACLE (20A)	20
21	LAUNDRY GFCI (15A)	DISHWASHER (15 A)	22
23	GARAGE LIGHTS AND RECEPTACLES (15A)	INVERTER # 1	24
25	SPARE (15A)		26
27	INVERTER # 2	INVERTER # 3	28
29			30
31	HALLWAY LIGHTS AND RECEPTACLES (15A)	MASTER BEDROOM LIGHTS AND RECEPTACLES (15A)	32
33	BATH AND MASTER BATH LIGHTS AND RECEPTACLES (15A)	BEDROOM #1 LIGHTS AND RECEPTACLES (15A)	34
35	BEDROOM #2 LIGHTS AND RECEPTACLES (15A)	SPARE	34

2 PANEL DIRECTORY

Drawn by	Date
J.Baum	August 7, 2007
Revised	Date

2007 Solar Decathlon


University of Colorado at Boulder

Civil, Environmental, and Architectural Engineering  
428 UCB, Room ECE 441  
Boulder, CO 80309-0428

Panel Schedule and Label

NTS

0 1' 2' 4'

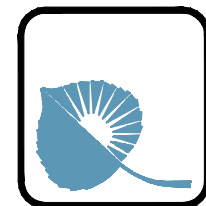

Appliance	Amp	Voltage	VA
Range	30.00	240	7200
Wall Oven	6.25	120	1500
Dishwasher	6.96	120	1670
Washing/ Dryer	5.42	120	1300
Refrigerator	0.22	120	52

Sizing of the Service-entrance Conductors Using the Standard Method

A. Design of Conductors for Phases

General Loads

Lighting Load and Receptacles Outlets  
2,100 square feet  
11003.2 VA      2,100 \*3VA= 6,300  
Small Appliance Receptacles  
3,000 VA  
Laundry Receptacle  
1,500 VA

Total General Load = 15,503 VA  
Demand Load = 7,376 VA

Fixed Appliance Load

Dishwasher, Washing Machine

Demand Load = 3,353 VA

Special Appliances

Dryer 1,300 VA  
Range 5,760 VA  
DL = 7,060 VA

Total Demand Load = 17,789 VA  
I<sub>Load</sub> = 74.1 A

Size of THW (Cu) Conductor According to Table 310.15(B)(6)  
For a 200 amp Panel according to future expansion plans

4/0

Size of Main Breaker

200 A, 2P

NEC Section

220.42

210.11 (C)(1)

210.11 (C)(11)  
220.82 (B)(2)

220.42

220.53

220.54

220.55

Total general lighting load is the general lighting load + small appliance loads  
Demand load is 100% x the first 3000 VA + 35% x the remaining VA

(Sum of VA's)\*0.75

Range is 0.8 x Rated VA

Sum of the demand loads  
Total demand load / 240V

1 CONDUCTOR SIZING CALCULATIONS

B. Design of Conductors for Neutral

General Loads

Demand Load = 7,376 VA

Fixed Appliance Load

Demand Load = 3,353 VA

Special Appliances

Dryer 910 VA  
Range 4,032 VA  
DL = 4,942 VA

Total Demand Load = 15,671 VA  
I<sub>Load</sub> = 65.3 A

Size of THW (Cu) Conductor for Neutral  
As per NEC 310.16

#2

Size of Grounding Electrode Conductor  
As per NEC Table 250.66

#2

Size of Equipment Grounding Conductors  
As per NEC Table 250.122

#6

Apply a Demand Factor of 0.7 to Dryers and Ranges

Total demand load [VA] / 240 [V]

2 NEUTRAL CONDUCTOR SIZING CALCULATIONS

D. Conduit Fill Calculations

Location	Insulation	Size	Area [in^2]	Quantity	Total Area	NEC Section
1) PDP to Panelboard	THW	4/0	0.3718	3	1.1154	350 Tables 4 and 5
	THW	#6	0.0726	1	0.0726	
	Total				1.188	
	Conduit	Size	40% of Area			
2) DC Wireway to Inverters	LFNC-B	2"	1.298			Annex C Table C.1
	Insulation	Size	Number of conductors			
	THHN	#10	5			
	Conduit	Size	Maximum number of conductors			
3) Inverters to AC WireWay	EMT	1"	16			Annex C Table C.1
	Insulation	Size	Number of conductors			
	THHN	#12	3			
	Conduit	Size	Maximum number of conductors			
4) AC Wireway to Panelboard	EMT	1"	26			Annex C Table C.1
	Insulation	Size	Number of conductors			
	THHN	#12	9			
	Conduit	Size	Maximum number of conductors			

3 CONDUIT FILL CALCULATIONS

Drawn by	Date
J.Baum	August 7, 2007
Revised	Date

2007 Solar Decathlon

University of Colorado at Boulder

Civil, Environmental, and Architectural Engineering


428 UCB, Room EOC-E 441

Boulder, CO 80509-0428


AC Calculations


NTS

0 6" 1' 2' 4'

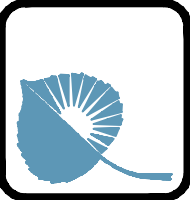




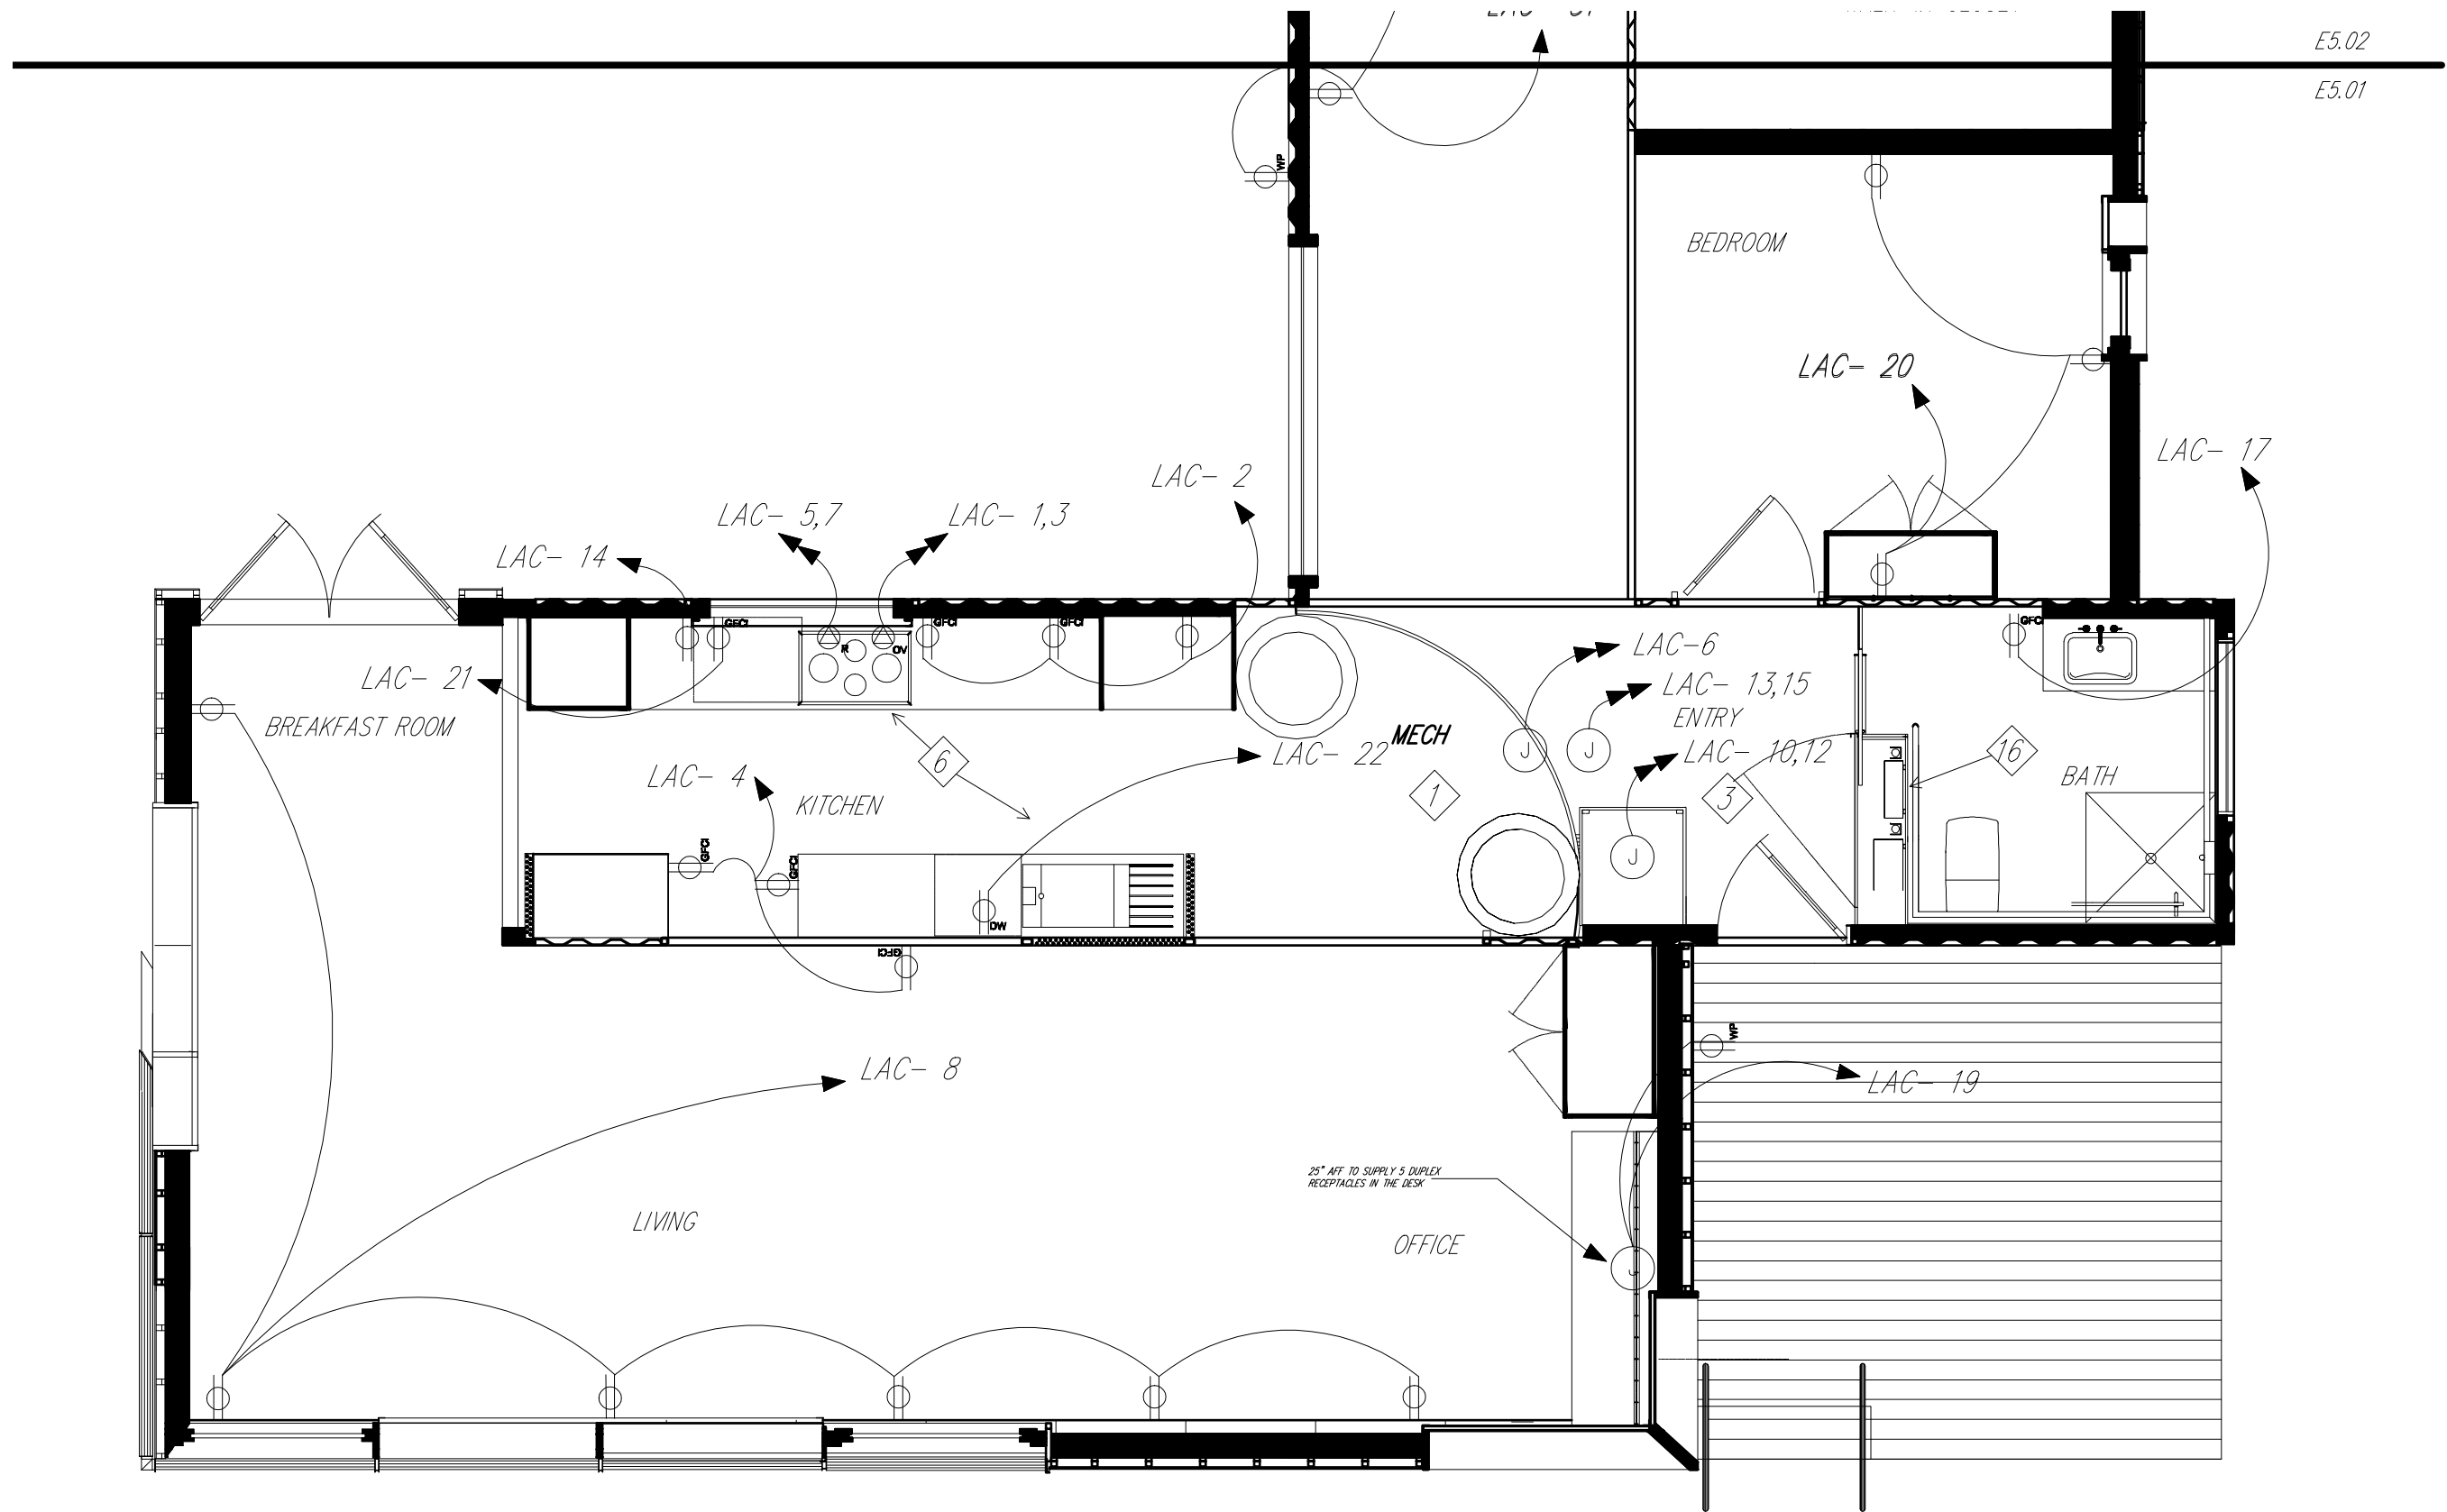


 1 SOUTH FULL HOUSE POWER PLAN  
 SCALE: 1/4" = 1'


Drawn by	Date
J. Baum	August 7, 2007
Revised	Date



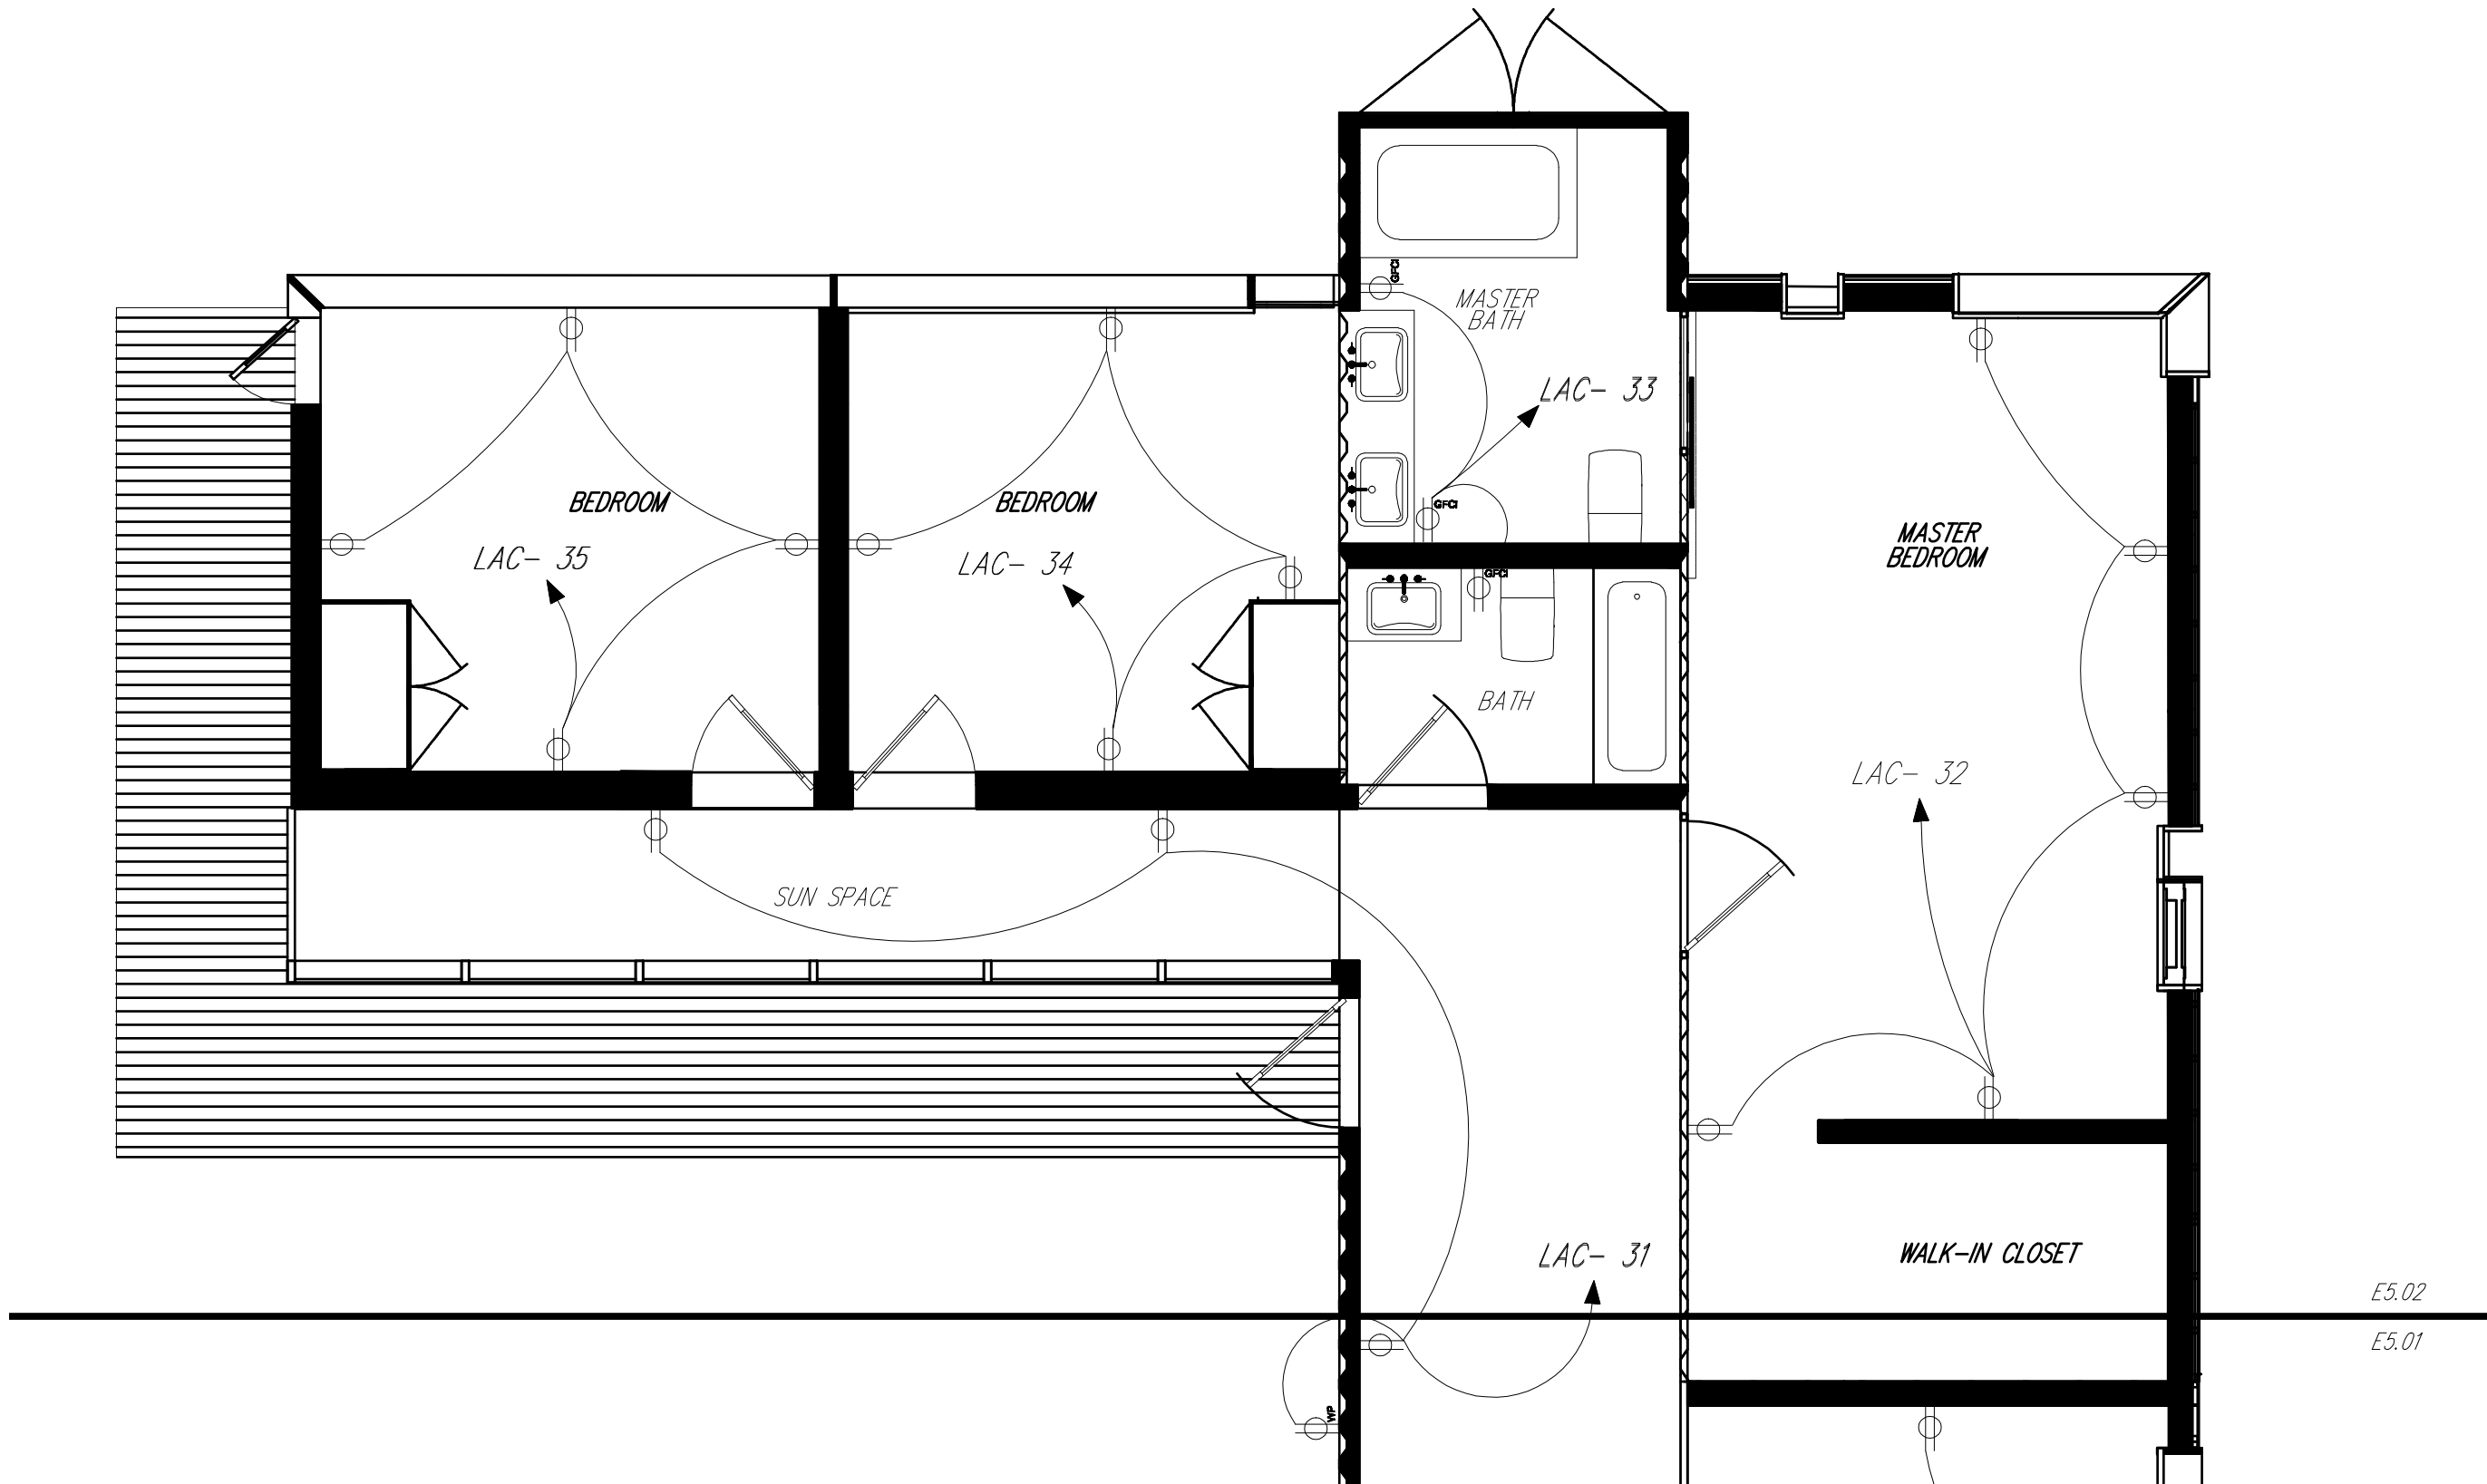


1 NORTH FULL HOUSE POWER PLAN  
SCALE: 1/4" = 1'

Drawn by	Date
J. Baum	August 7, 2007
Revised	Date

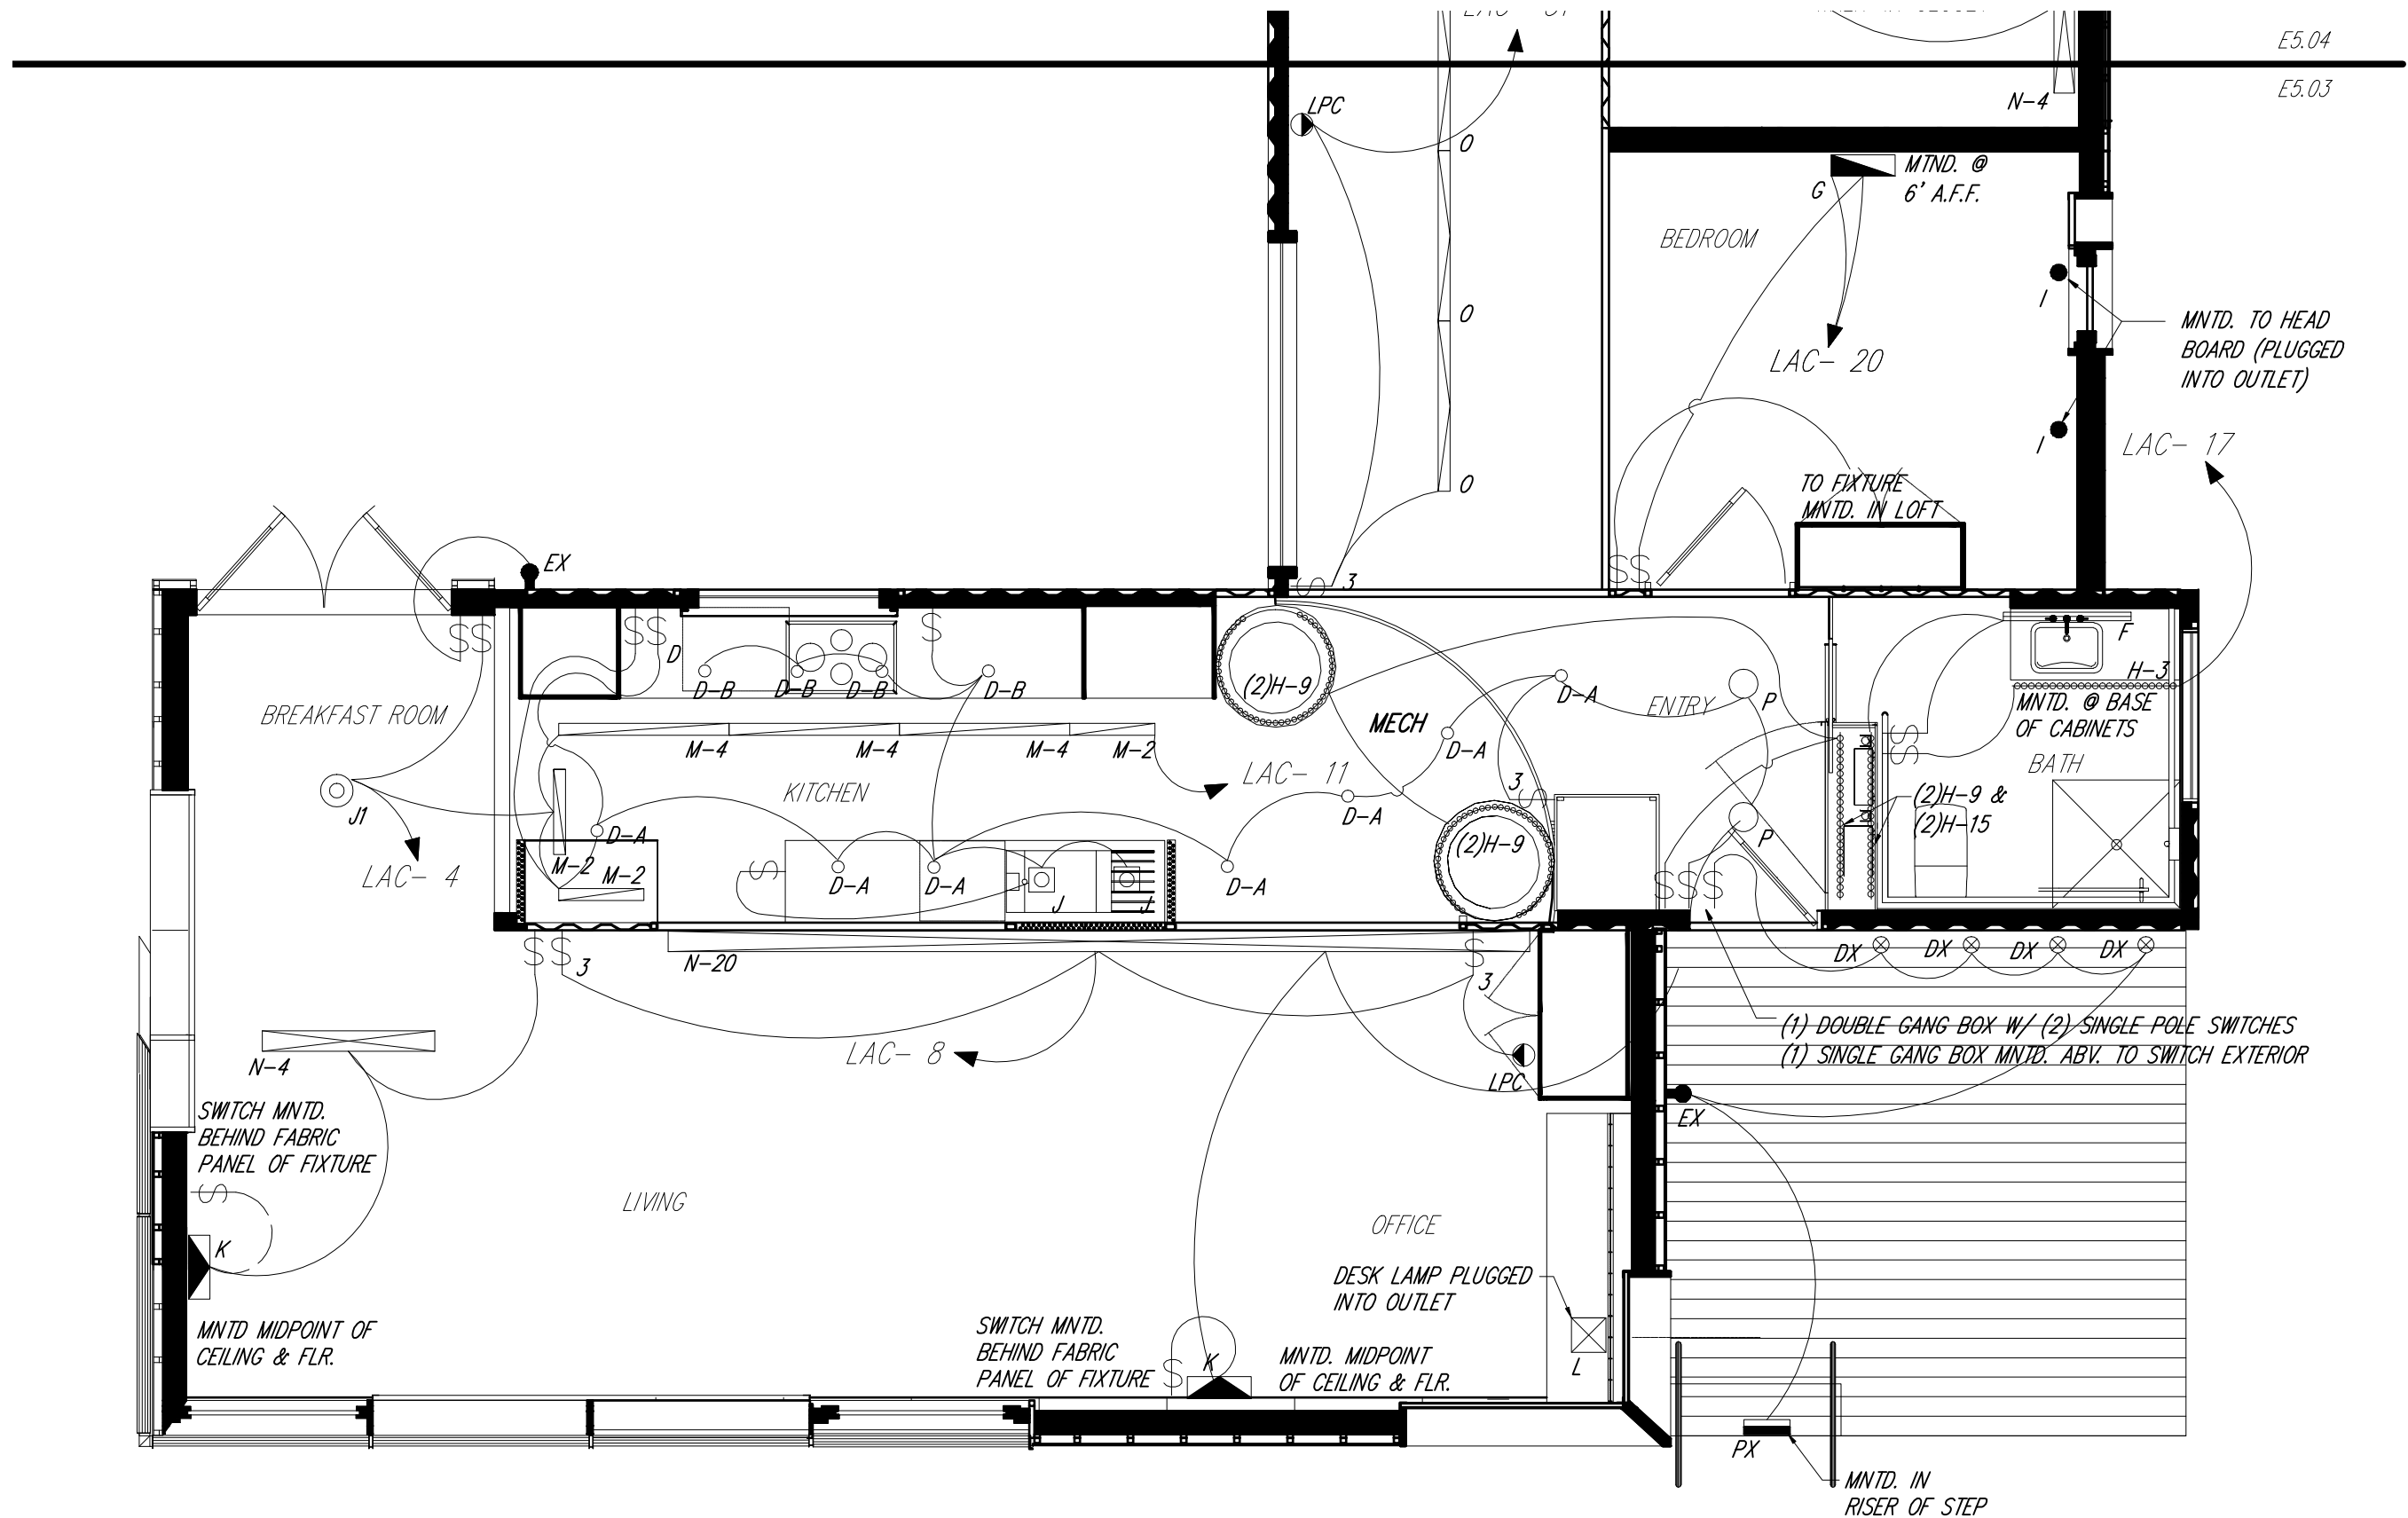




 ① SOUTH FULL HOUSE LIGHTING PLAN  
 SCALE: 1/4" = 1'

Drawn by	Date
J. Baum	August 7, 2007
Revised	Date

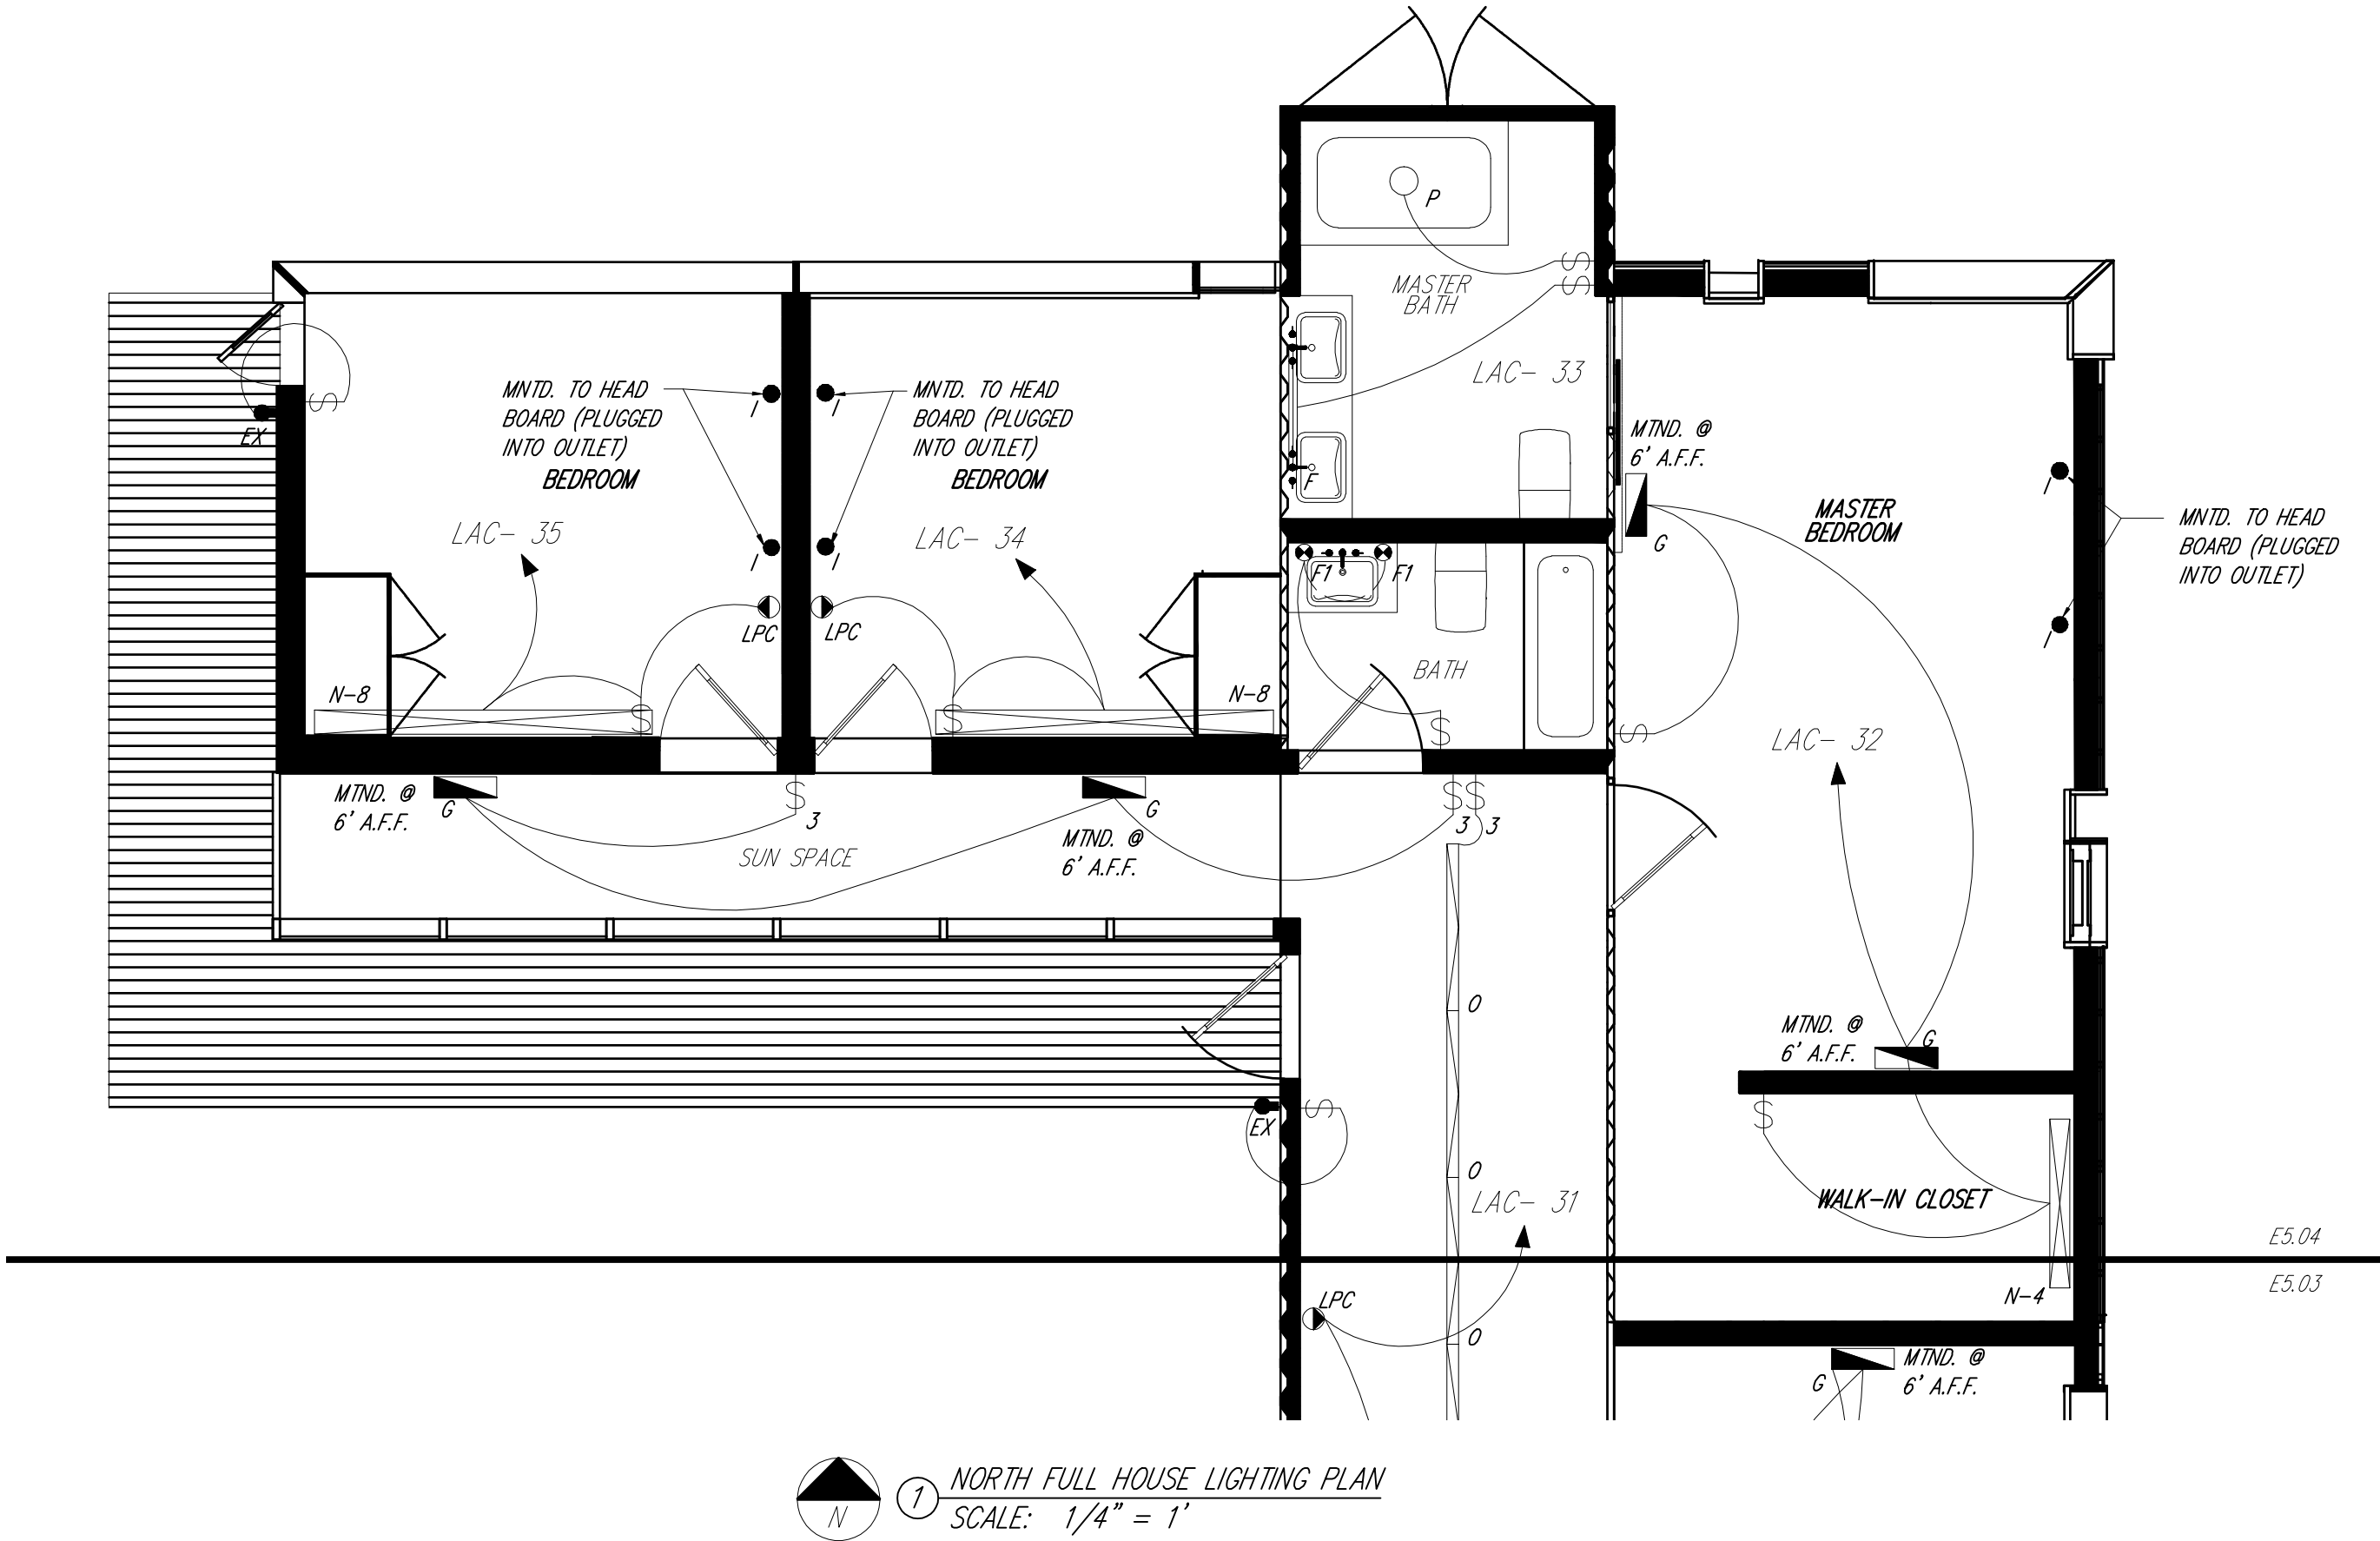

Drawn by	Date
J. Baum	August 7, 2007
Revised	Date






1

NORTH FULL HOUSE LIGHTING PLAN

SCALE: 1/4" = 1'

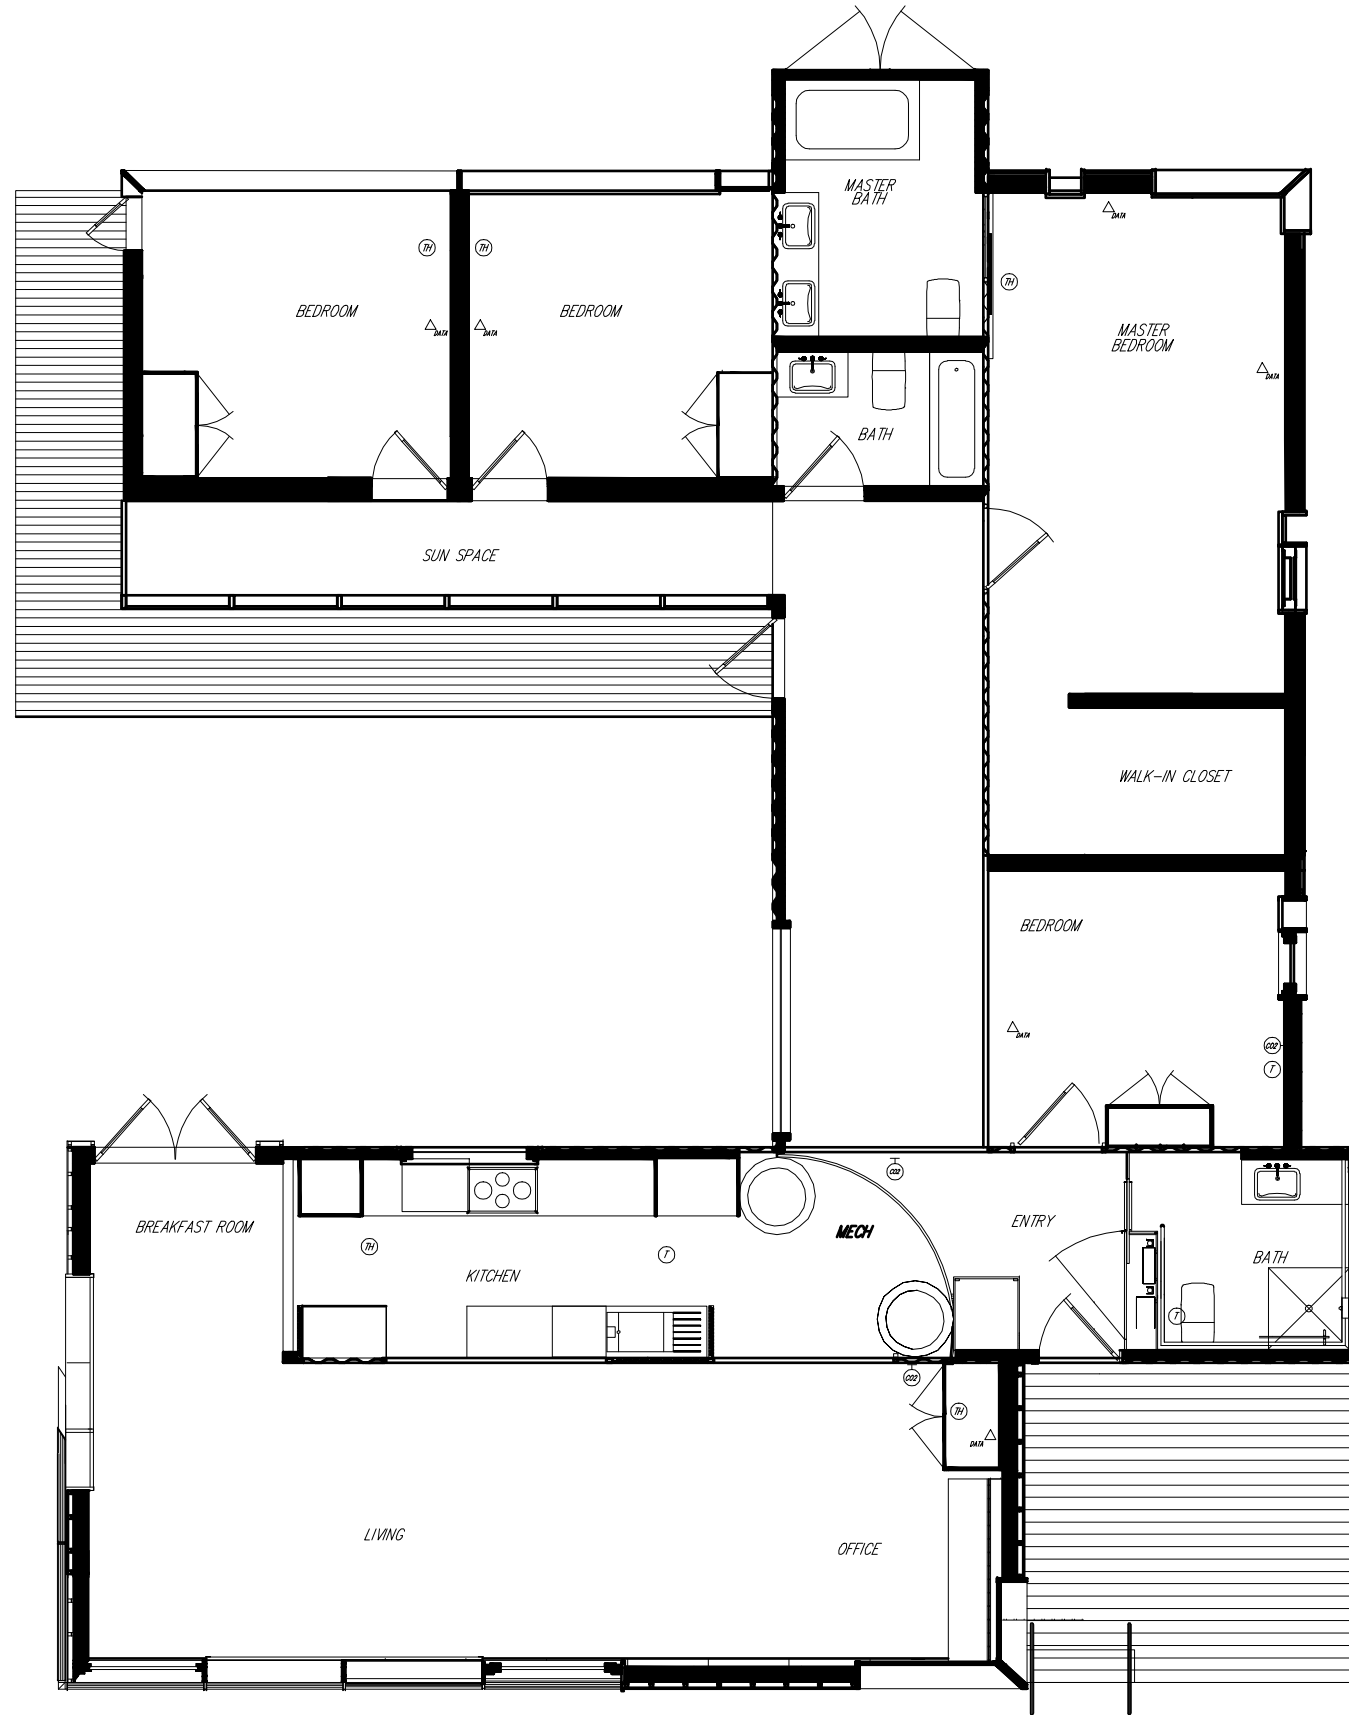

1 SOUTH FULL HOUSE POWER PLAN  
SCALE: 1/4" = 1'



E5.05

Full House Data Plan

NITC


0 6" 1' 2'

4"

2007 Solar Decathlon

University of Colorado at Boulder  
Civil, Environmental, and Architectural Engineering  
1251 INS BOWEN DRIVE 444

Drawn by	Date
J. Baum	August 7, 2007
Revised	Date

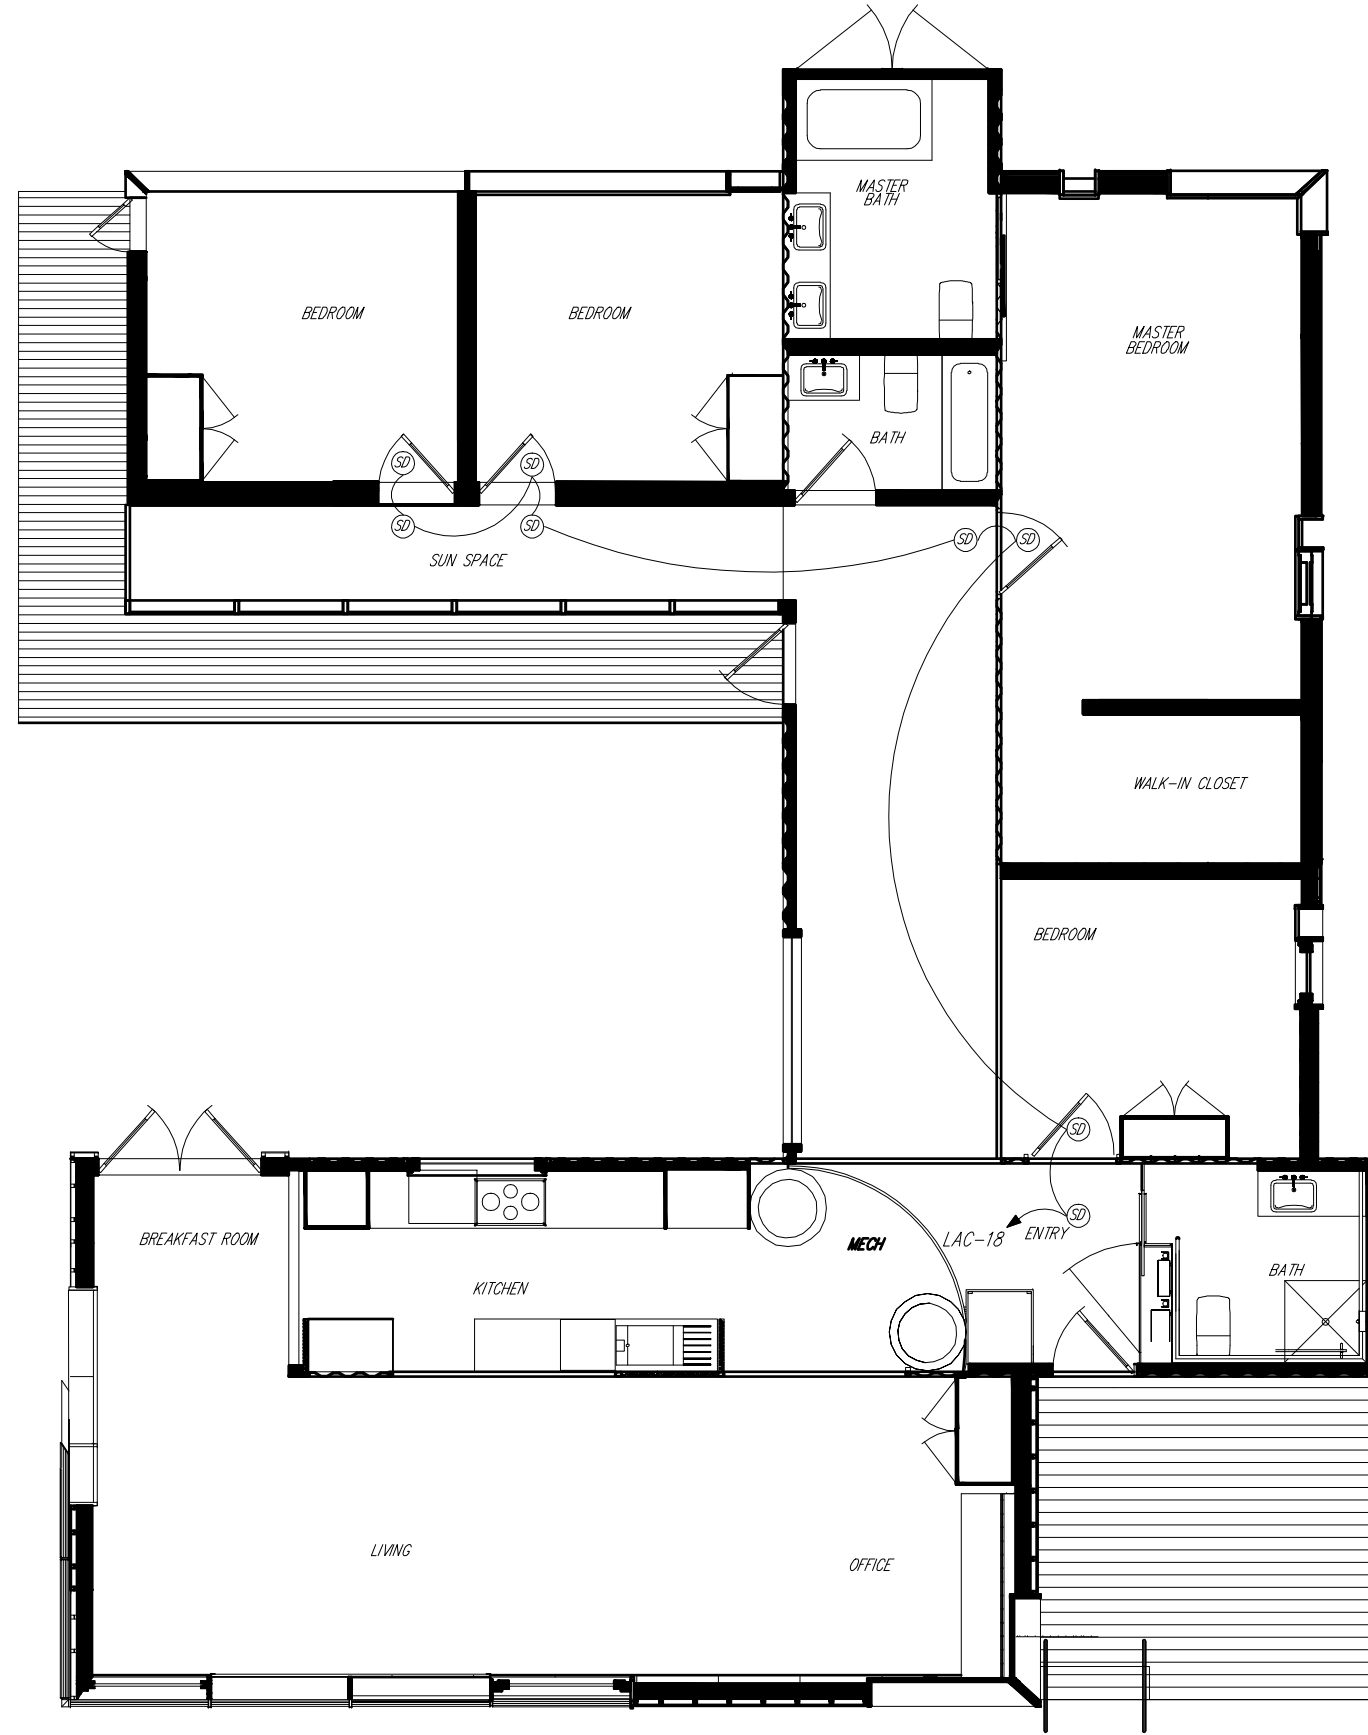


1 FULL HOUSE FIRE SAFETY PLAN  
NTS

Drawn by	Date
J. Baum	August 7, 2007
Revised	Date





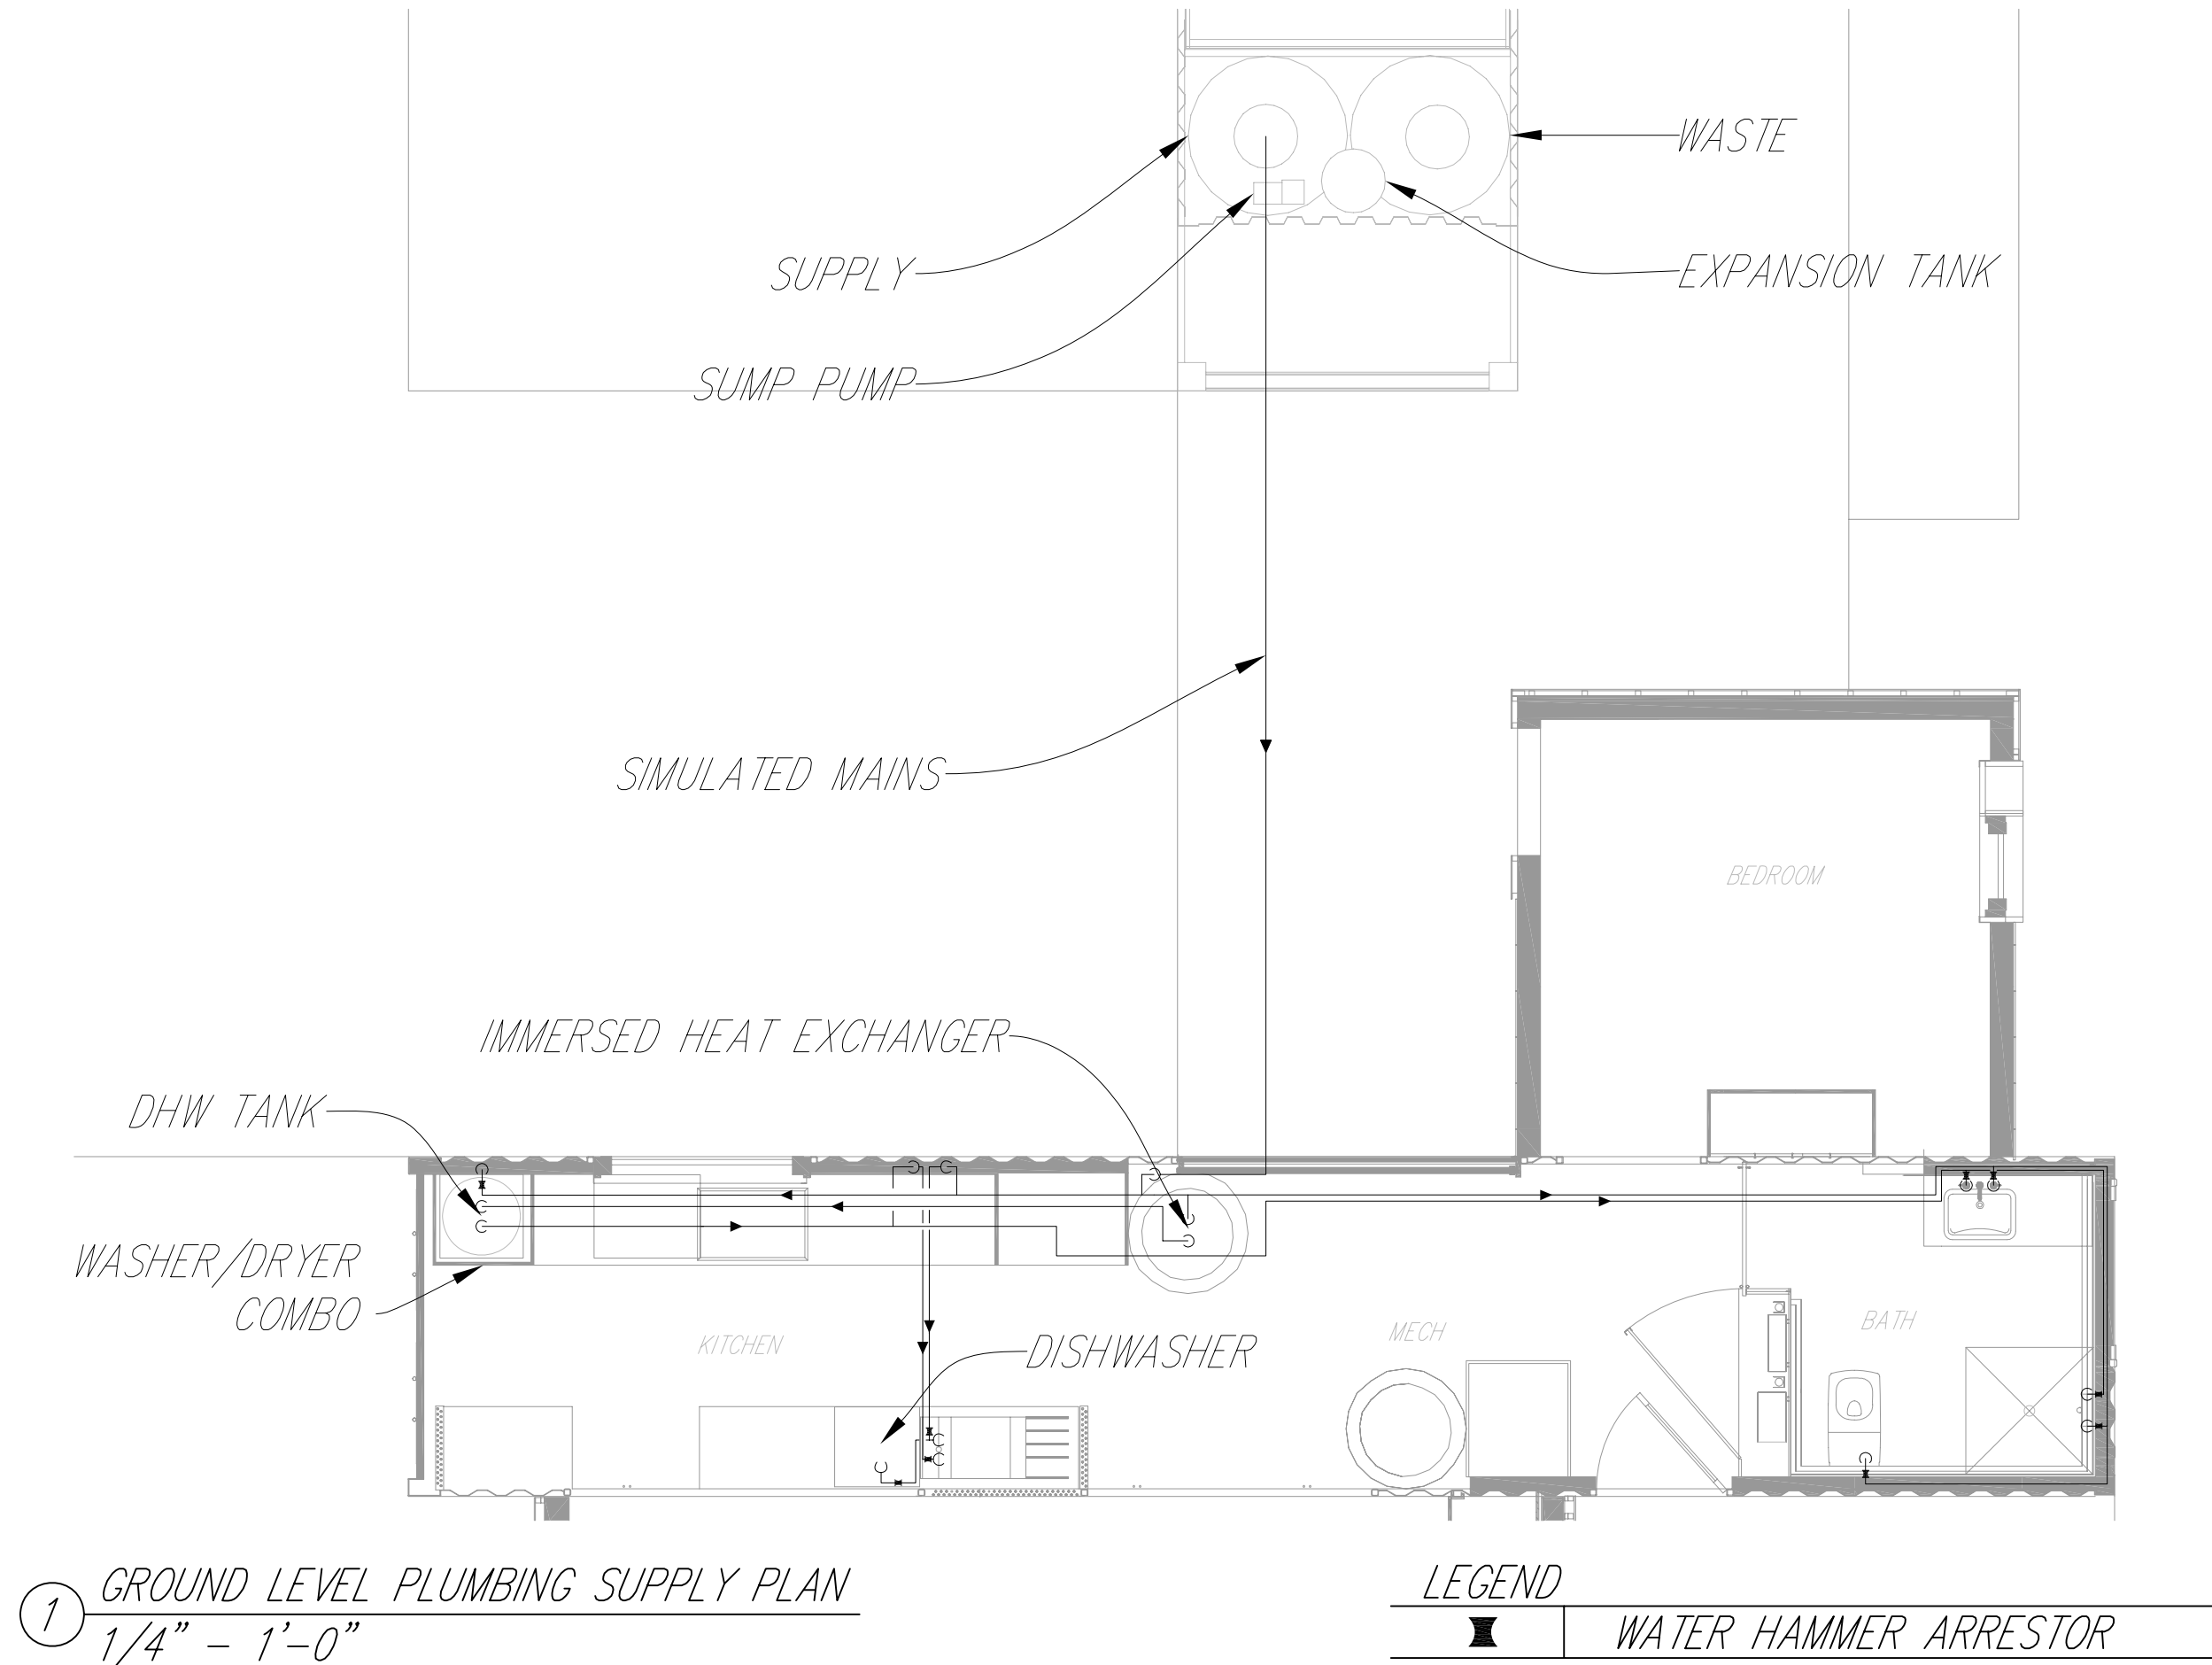

Drawn by	Date
C. Corbin	August 7, 2007
Revised	Date

Ground Level Plumbing Supply Plan    2007 Solar Decathlon

University of Colorado at Boulder  
 Civil, Environmental, and Architectural Engineering  
 428 UCB, Room ECCE 441  
 Boulder, CO 80309-0428

0   1'   2'   4'   8'




Drawn by	Date
C. Corbin	August 7, 2007
Revised	Date


Ground Level Plumbing DWV Plan
2007 Solar Decathlon

University of Colorado at Boulder  
Civil, Environmental, and Architectural Engineering  
428 UCB, Room ECCE 441  
Boulder, CO 80309-0428

0
1'
2'
4'
8'

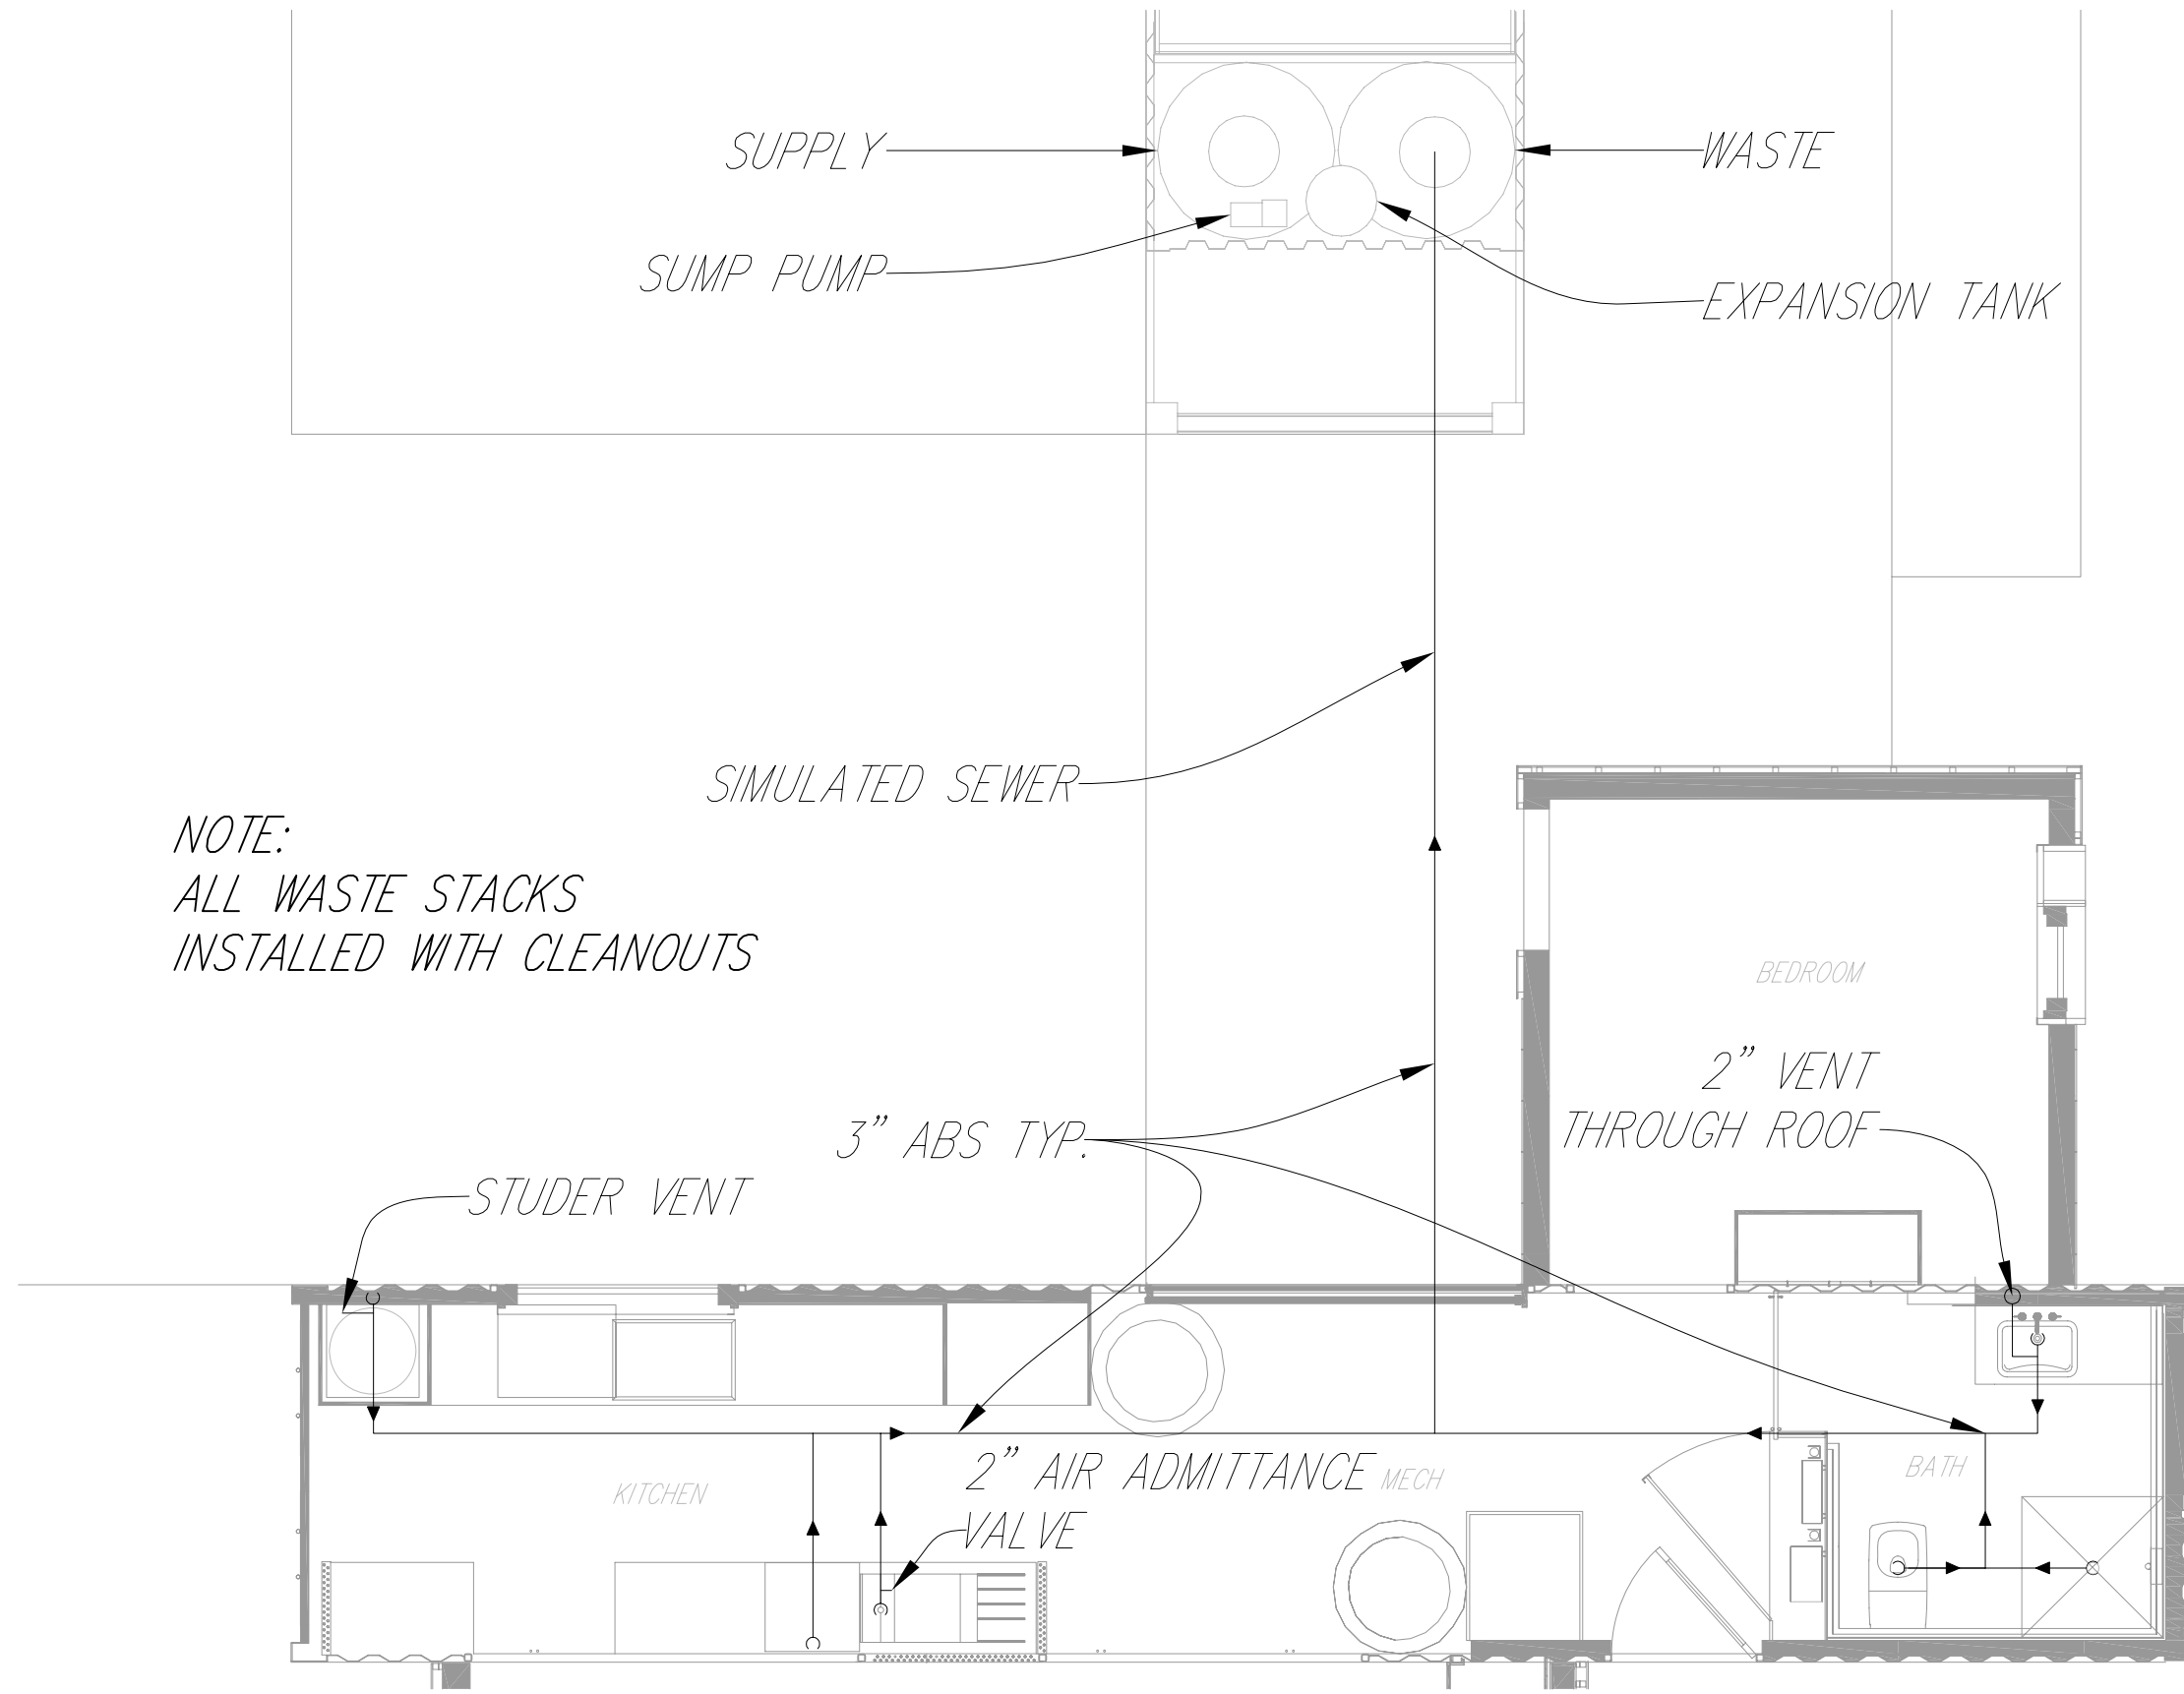

1 GROUND LEVEL PLUMBING DWV PLAN  
1/4" = 1'-0"

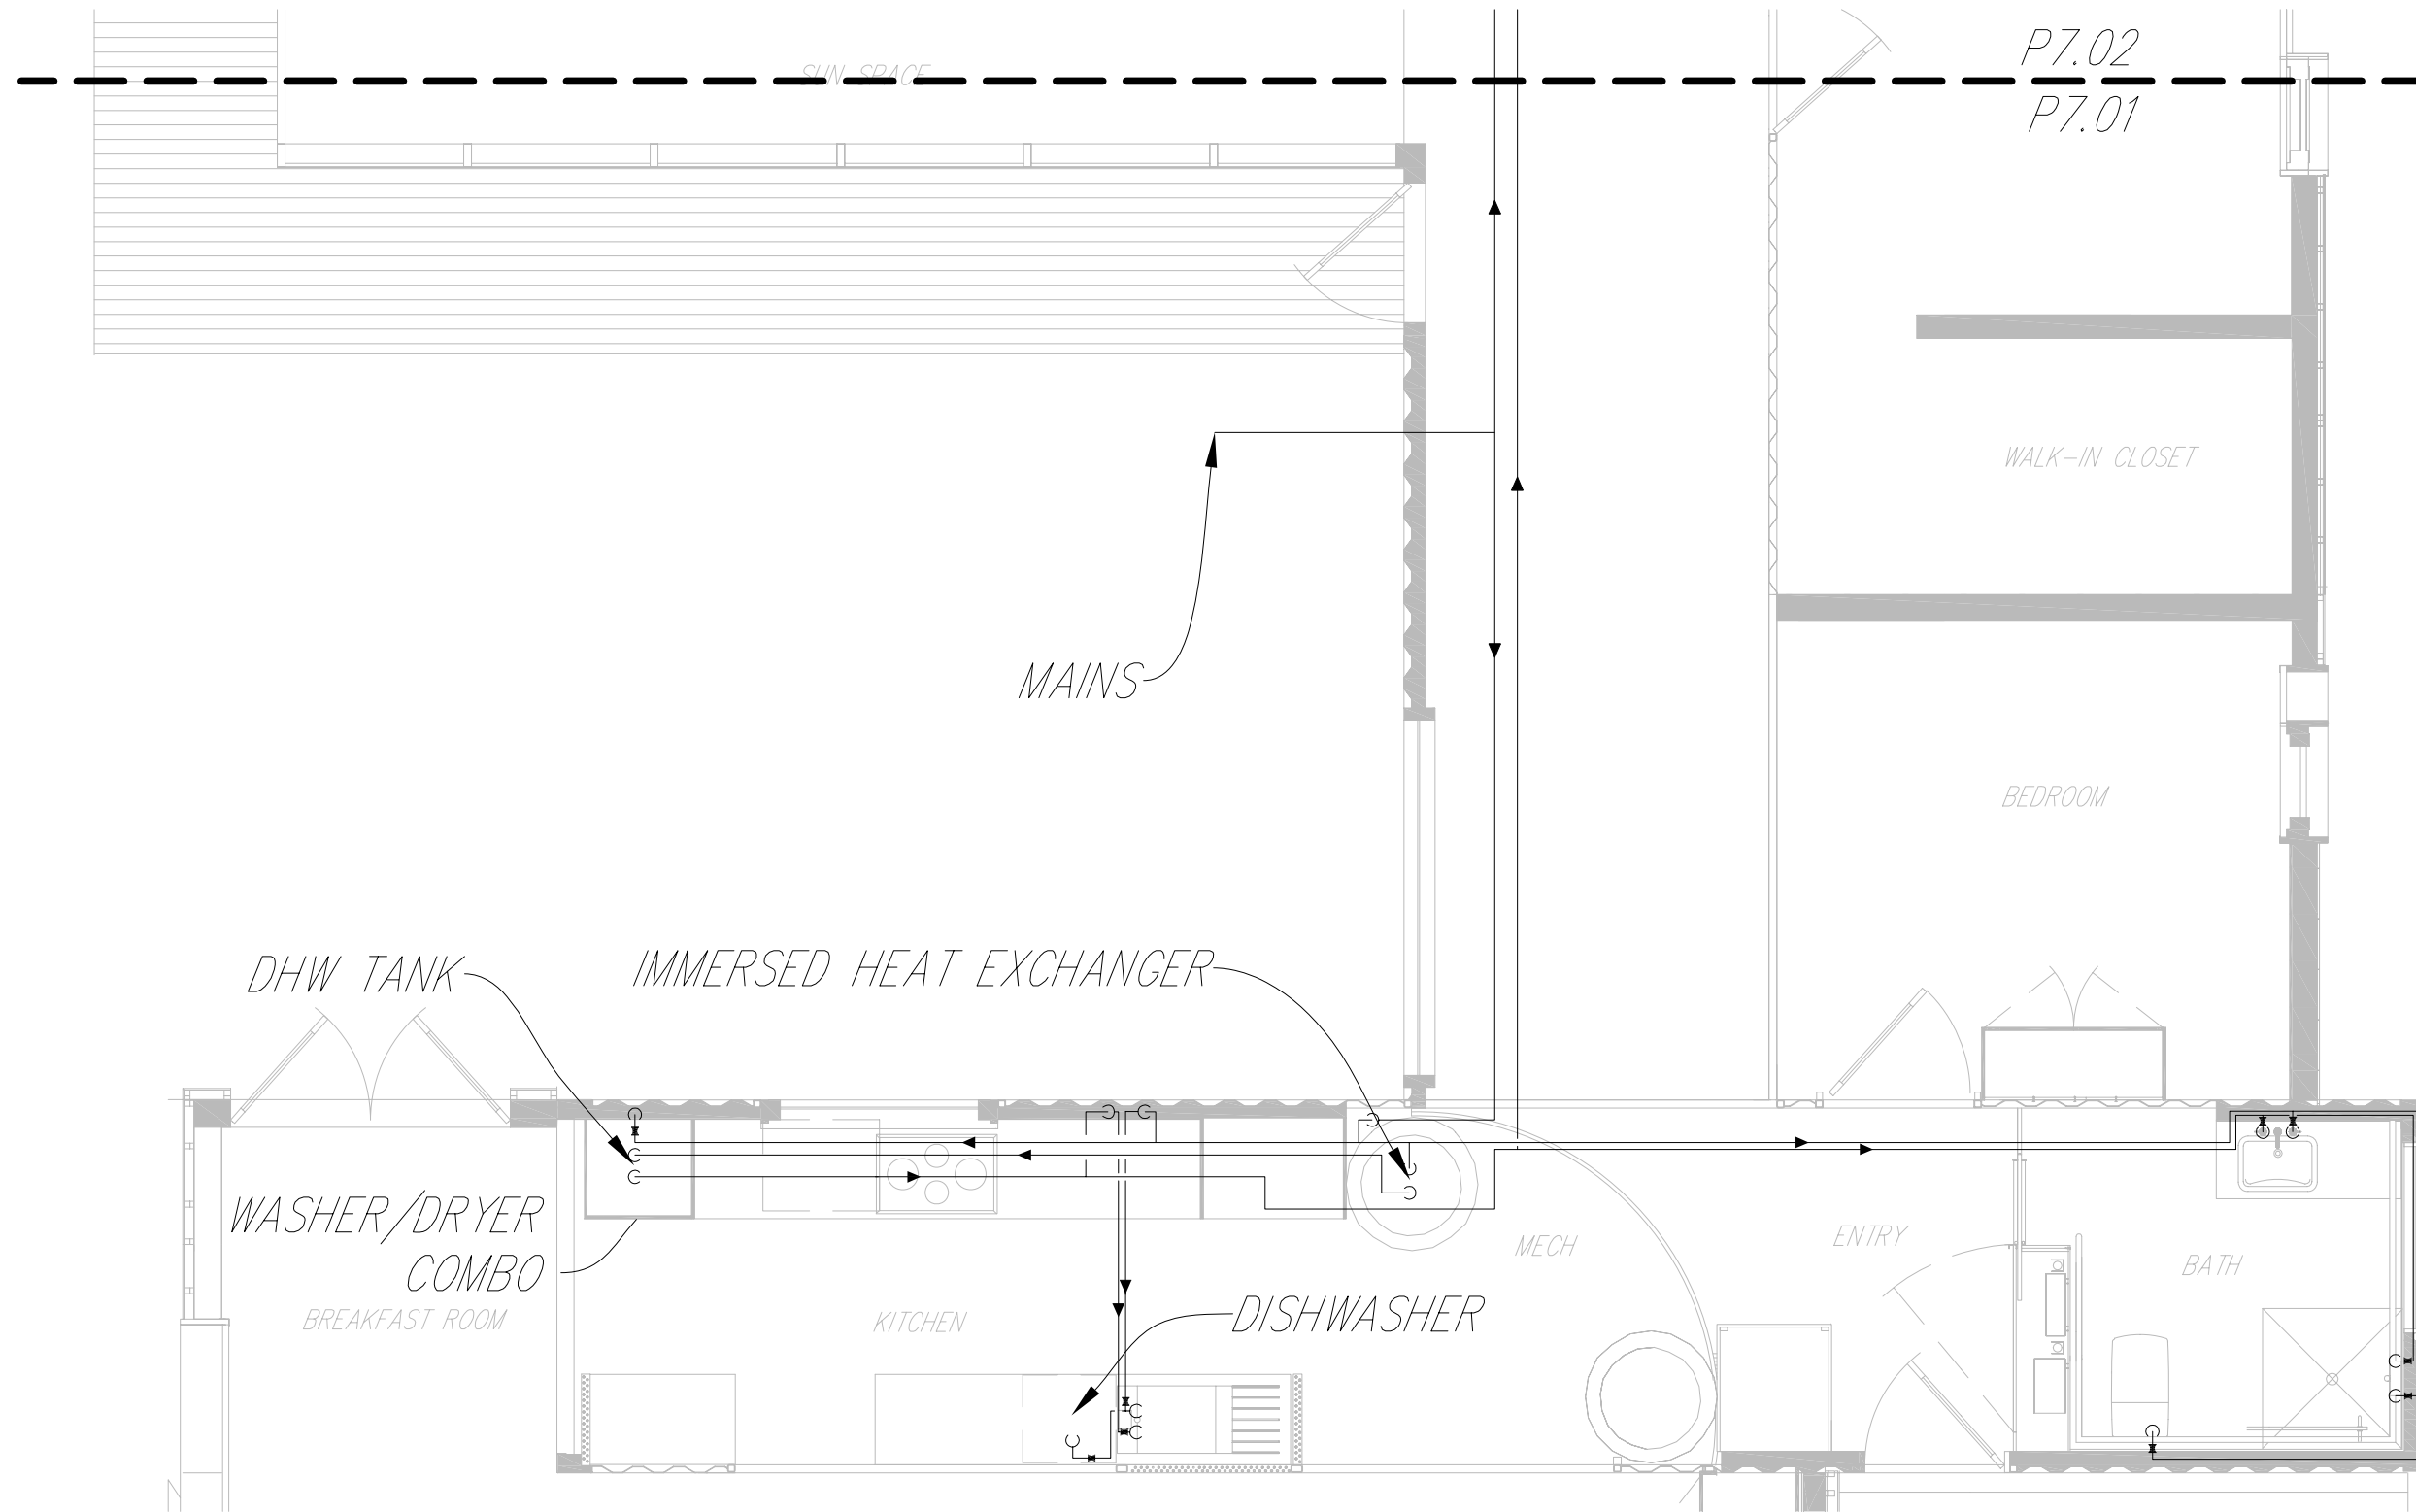

① COMPLETE HOUSE PLUMBING SUPPLY PLAN  
 1/4" - 1'-0"

LEGEND	
	WATER HAMMER ARRESTOR

Drawn by	Date
C. Corbin	August 7, 2007
Revised	Date

Complete House Plumbing Supply Plan

2007 Solar Decathlon

University of Colorado at Boulder

Civil, Environmental, and Architectural Engineering

428 UCB, Room ECCE 441

Boulder, CO 80309-0428

0

1'


2'

4'

8'



P7.01

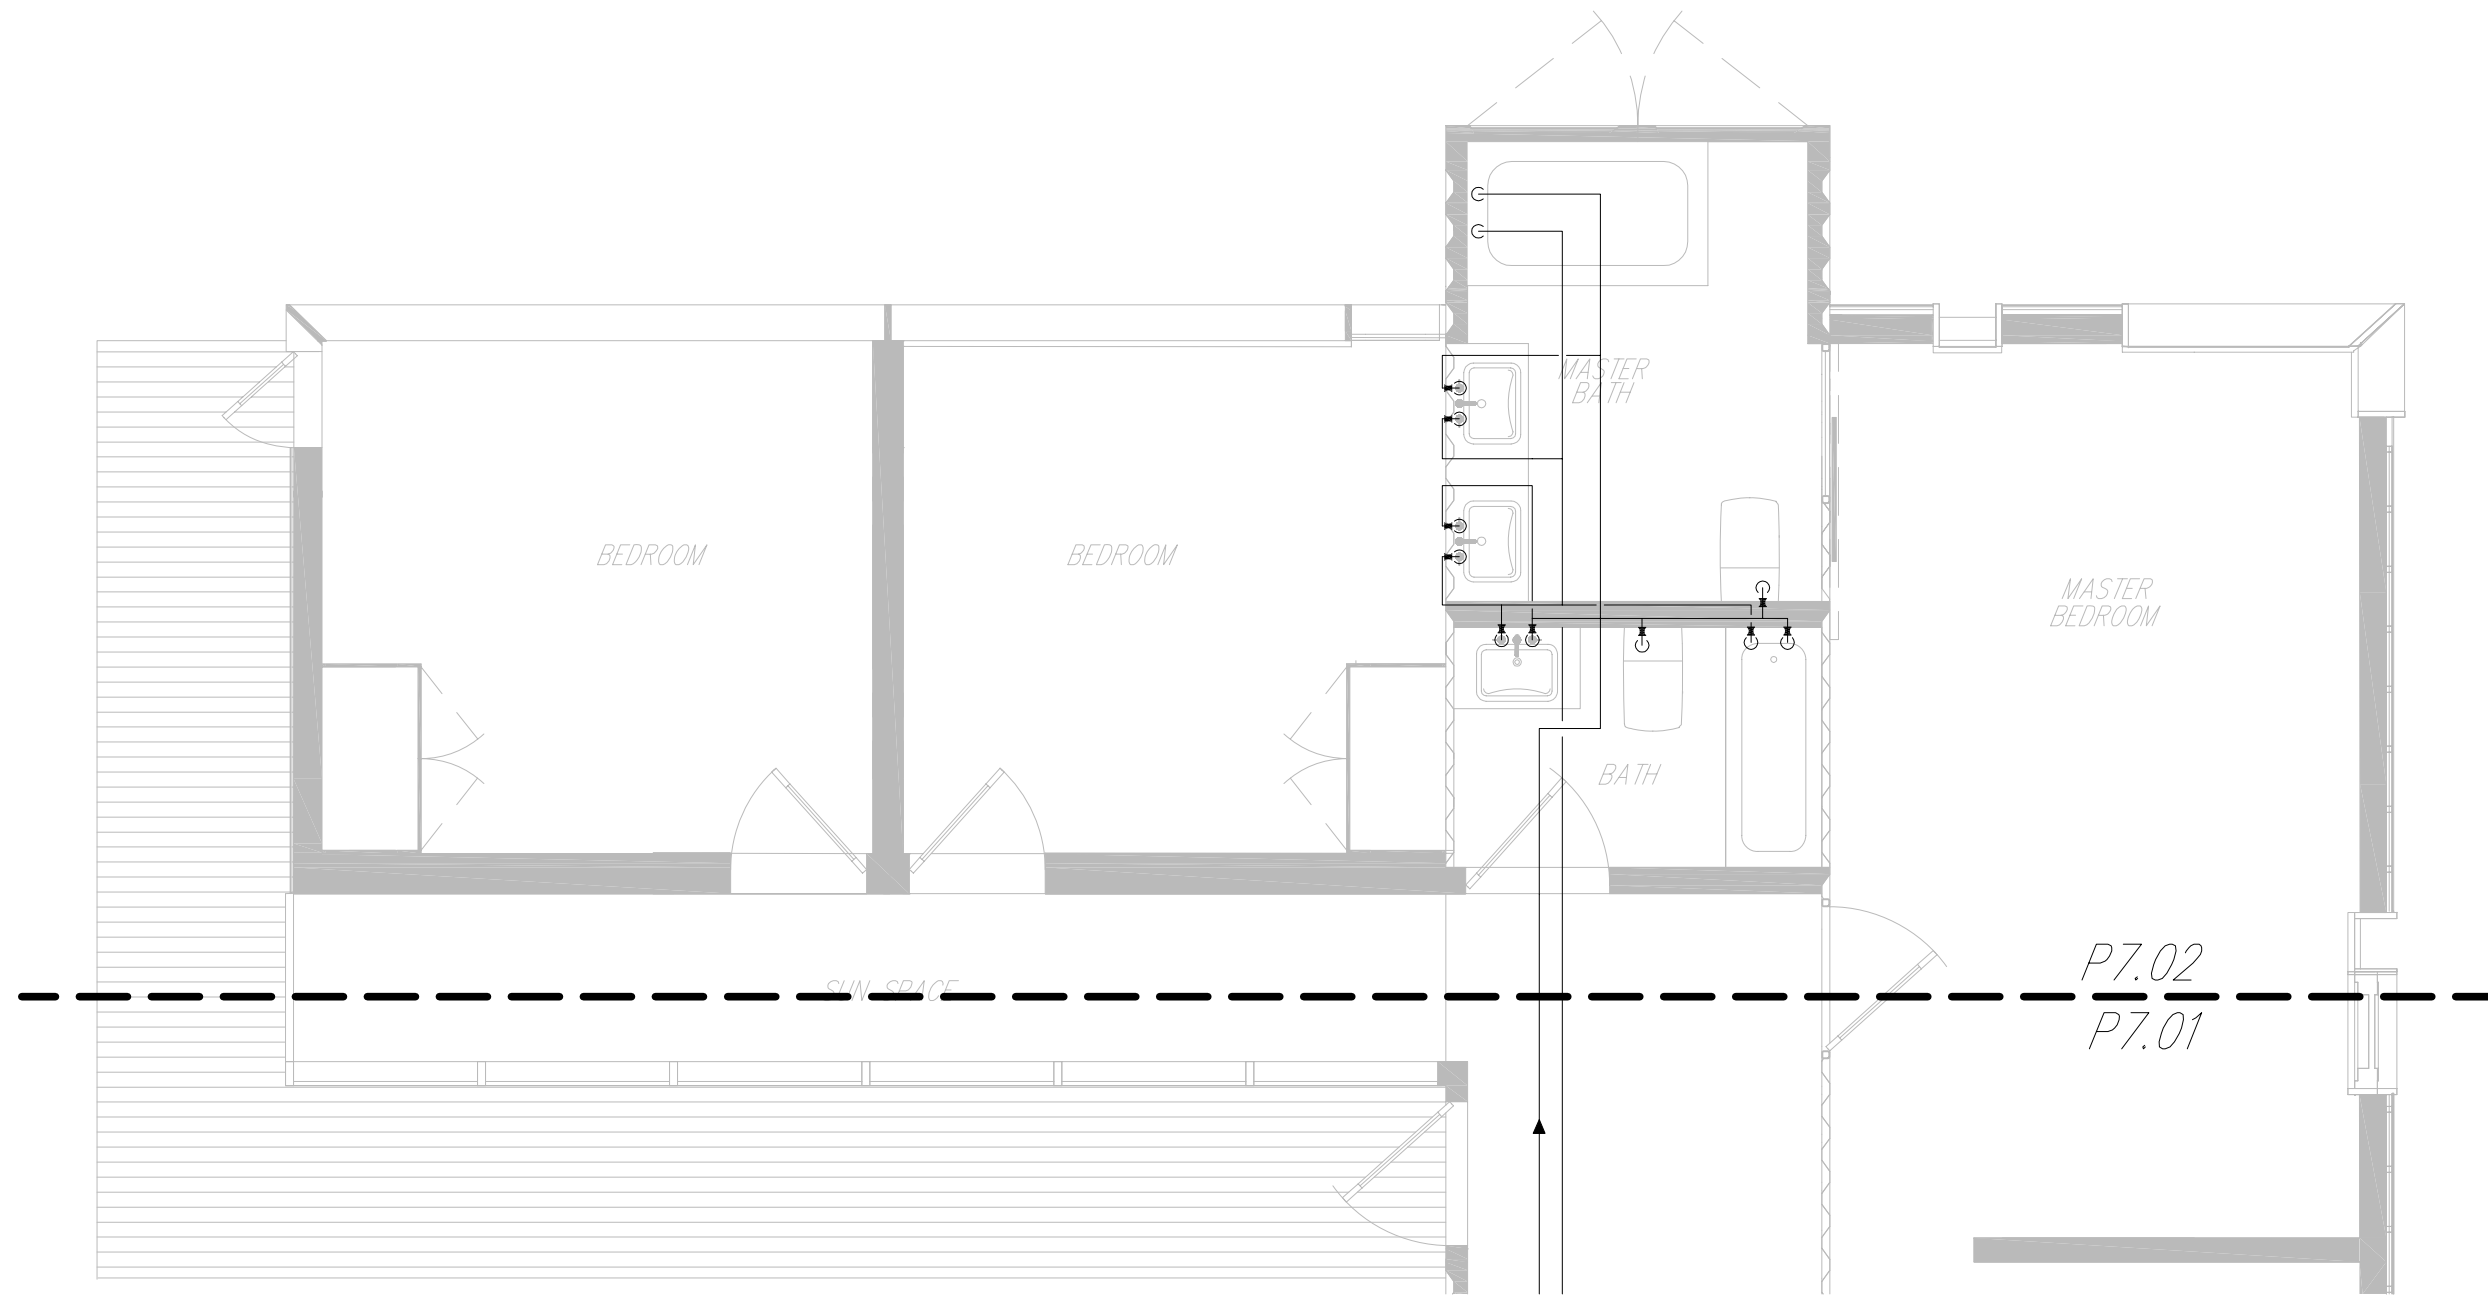

① COMPLETE HOUSE PLUMBING SUPPLY PLAN  
1/4" - 1'-0"

LEGEND	
	WATER HAMMER ARRESTOR

Drawn by	Date
C. Corbin	August 7, 2007
Revised	Date

Complete House Plumbing Supply Plan

2007 Solar Decathlon


University of Colorado at Boulder

Civil, Environmental, and Architectural Engineering  
428 UCB, Room ECCE 441  
Boulder, CO 80309-0428

0 1' 2' 4' 8'



P7.02

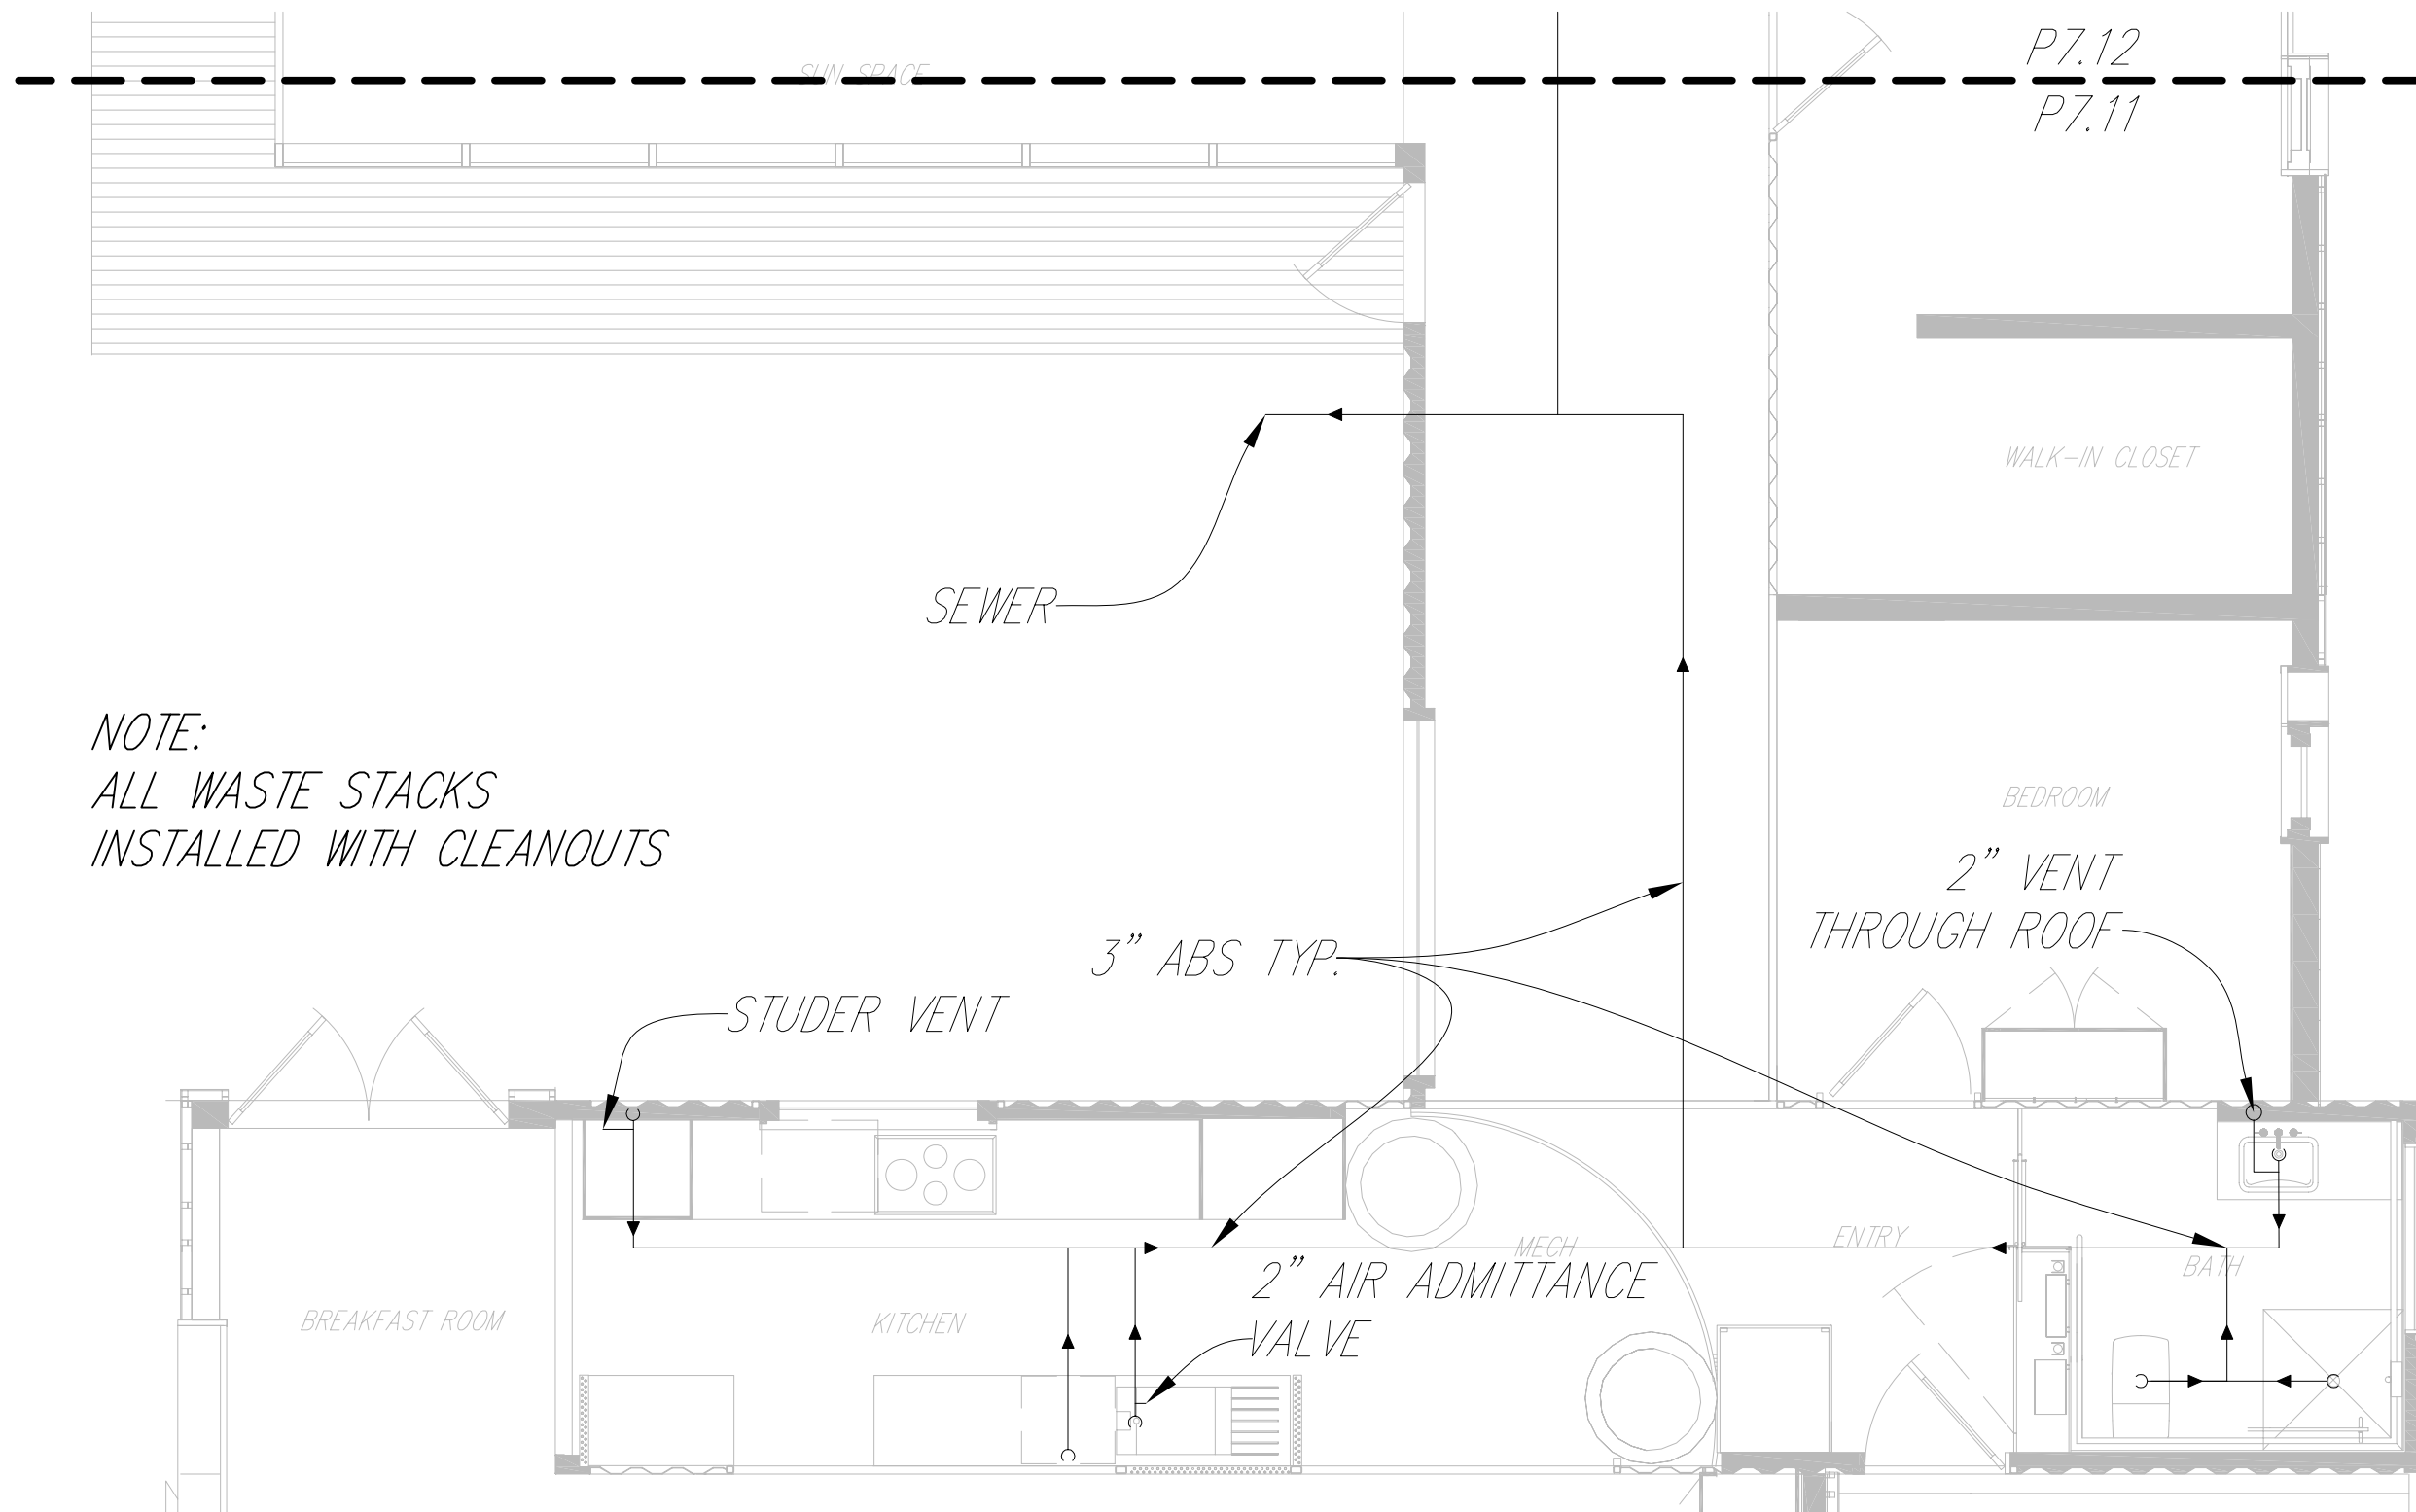

① COMPLETE HOUSE PLUMBING DWV PLAN  
1/4" = 1'-0"

Drawn by	Date	Revised	Date
C. Corbin	August 7, 2007		


Complete House Plumbing DWV Plan

2007 Solar Decathlon

University of Colorado at Boulder  
Civil, Environmental, and Architectural Engineering  
428 UCB, Room ECCE 441  
Boulder, CO 80309-0428

0 1' 2' 4' 8'



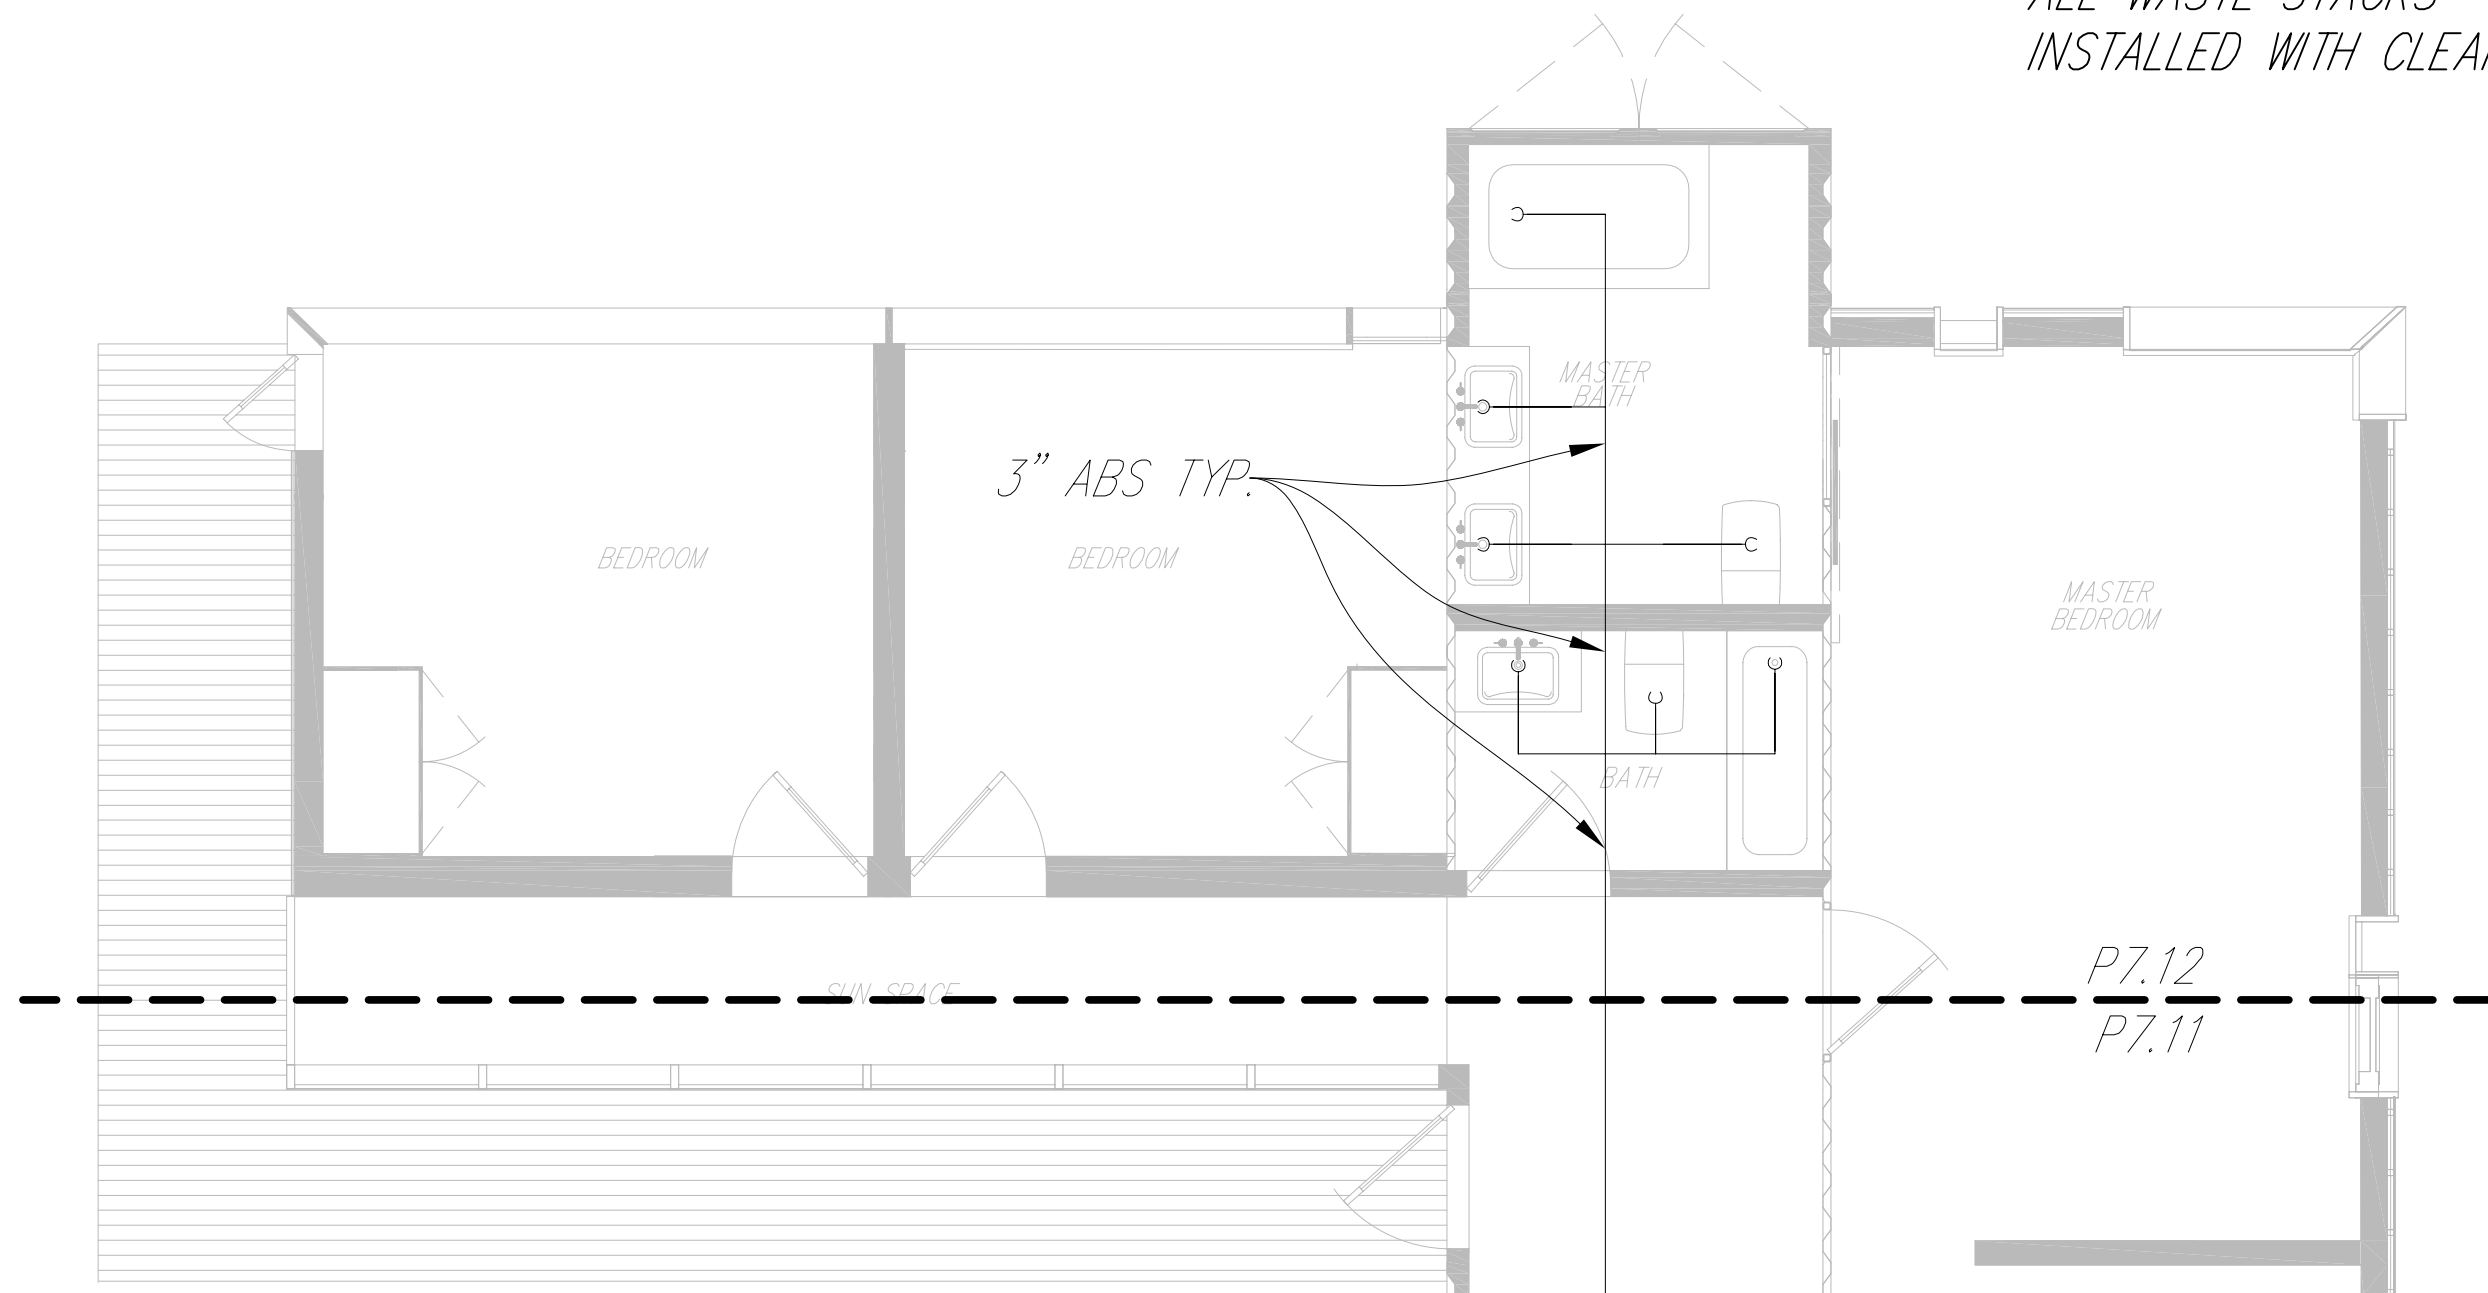

NOTE:  
ALL WASTE STACKS  
INSTALLED WITH CLEANOUTS

① COMPLETE HOUSE PLUMBING DWV PLAN  
1/4" - 1'-0"

Drawn by	Date	Revised	Date
C. Corbin	August 7, 2007		

Complete House Plumbing DWV Plan	2007 Solar Decathlon
University of Colorado at Boulder Civil, Environmental, and Architectural Engineering 428 UCB, Room ECCE 441 Boulder, CO 80309-0428	
0	8'
1'	
2'	
4'	



P7.12



Competition Water Requirements		
<b>Filling Tanks</b>		
Hot		230 gallons
Cold		100 gallons
DWH		50 gallons
<b>Shower Tests</b>		
10 Tests	@20 gallons	200 gallons
<b>Appliances</b>		
Clotheswasher		11.2 gallons
Dishwasher		10 gallons
<b>Pre-competition Testing</b>		
Showers		5 gallons
Dishwasher		2.5 gallons
Clotheswasher		5.6 gallons
<b>Demonstration Use</b>		
5 Tour Days	@10 gallons	50 gallons
	Sub Total	664 gallons
	20% Safety Factor	57 gallons
	<b>Total</b>	<b>721 gallons</b>

Drawn by	Date
C. Corbin	August 7, 2007
Revised	Date



Fixtures				
Fixture Location	Make	Model	Name	Color
Bathroom toilet	Kohler	K-19796	Escale Dual Flush toilet tank&	White
			Escale Dual Flush toilet bowl	White
Supply Angle	Kohler	K-7637	Angle SUpply Elbow	Polished Chrome
Lavatory SInk	Kohler	K-2214-G	Ladena Undermount Lav SInk	White
Bathroom faucet	Kohler	K-14410-4	Stillness widespread lav faucet	Polished chrome
Thermostatic Valve	Kohler	K-304-NA	Rite-Temp Valve	n/a
Bathroom shower	Kohler	K-8543	Mastershower Eco handshower	Polished chrome
	Kohler	K-8516	Mastershower slide bar kit	Polished chrome
	Kohler	K-9513	Mastershower wall supply elbow	Polished chrome
Kitchen faucet	Kohler	K-6331	Evoke kitchen sink faucet	Vibrant Stainless