



Sustainable and affordable home for everyman



TEAM NAME: Selficient
 ADDRESS: Padualaan 99
 3584 CH Utrecht
 CONTACT: info@selficient.org
 www.selficient.org

CONSULTANTS
 ARCHITECTURE
 ENGINEERS
 LANDSCAPING
 SAFETY FIRST CODE CONSULTANTS

CLIENT
 U.S. DEPARTMENT OF ENERGY
 SOLAR DECATHLON 2017
 WWW.SOLARDECATHLON.GOV



0	17-11-2016	90% revision
---	------------	--------------

MARK	DATE	DESCRIPTION
------	------	-------------

LOT NUMBER: 106
 DRAWN BY: Author
 CHECKED BY: Selficient
 COPYRIGHT: NONE; PROJECT IS PUBLIC DOMAIN

SCALE:
 SHEET TITLE

COVER PAGE

G-001



**AS-BUILT
 DRAWINGS**

University of applied sciences Utrecht
 Solar Decathlon 2017



TEAM NAME: Selficient
 ADDRESS: Padualaan 99
 3584 CH Utrecht
 CONTACT: info@selficient.org
 www.selficient.org

CONSULTANTS
 ARCHITECTURE
 ENGINEERS
 LANDSCAPING
 SAFETY FIRST CODE CONSULTANTS

CLIENT
 U.S. DEPARTMENT OF ENERGY
 SOLAR DECATHLON 2017
 WWW.SOLARDECATHLON.GOV



0	17-11-2016	90% revision
---	------------	--------------


MARK	DATE	DESCRIPTION
------	------	-------------

LOT NUMBER: 106
 DRAWN BY: SELFICIENT
 CHECKED BY: Selficient
 COPYRIGHT: NONE; PROJECT IS PUBLIC DOMAIN

SCALE: 1 : 50


SHEET TITLE

ADA TOUR ROUTE
 COMPLIANCE PLAN &
 EMERGENCY EGRESS
 PLAN
G-103

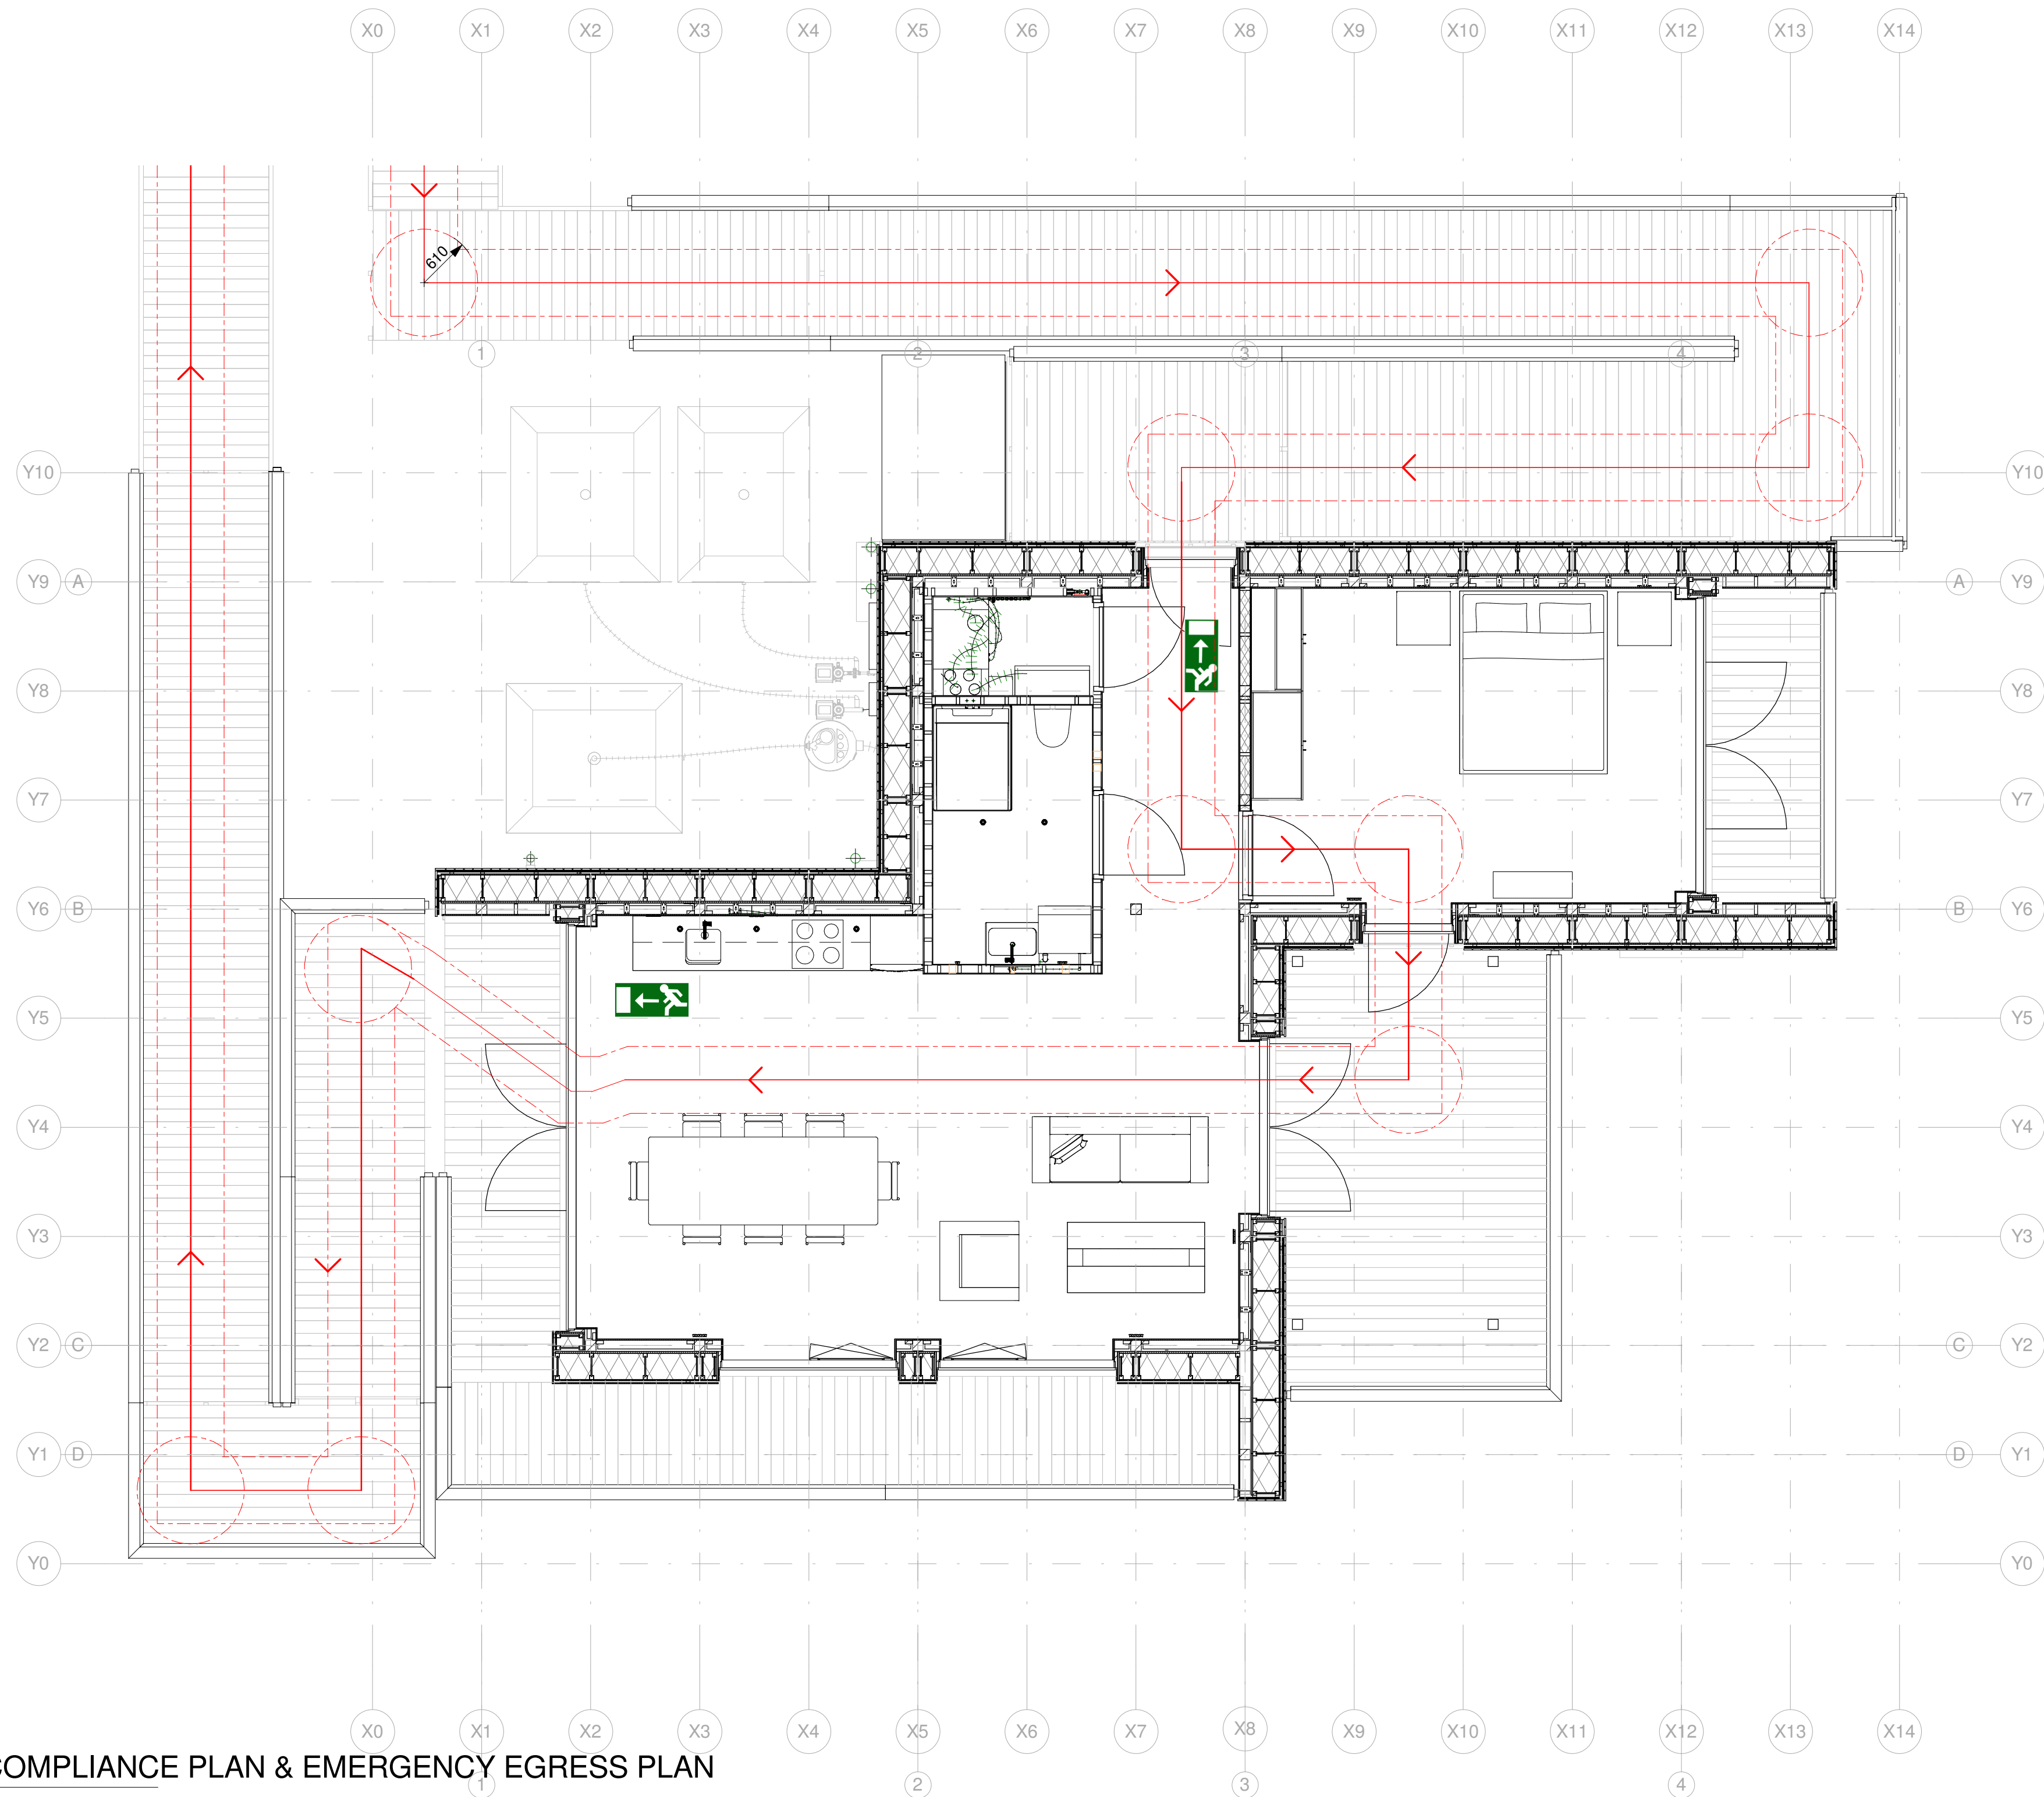

- Walk Path
- Chairwheel Width
- Chairwheel Turn Width
- Emergency Egress Exit

ADA TOUR ROUTE COMPLIANCE PLAN & EMERGENCY EGRESS PLAN
 1 : 50

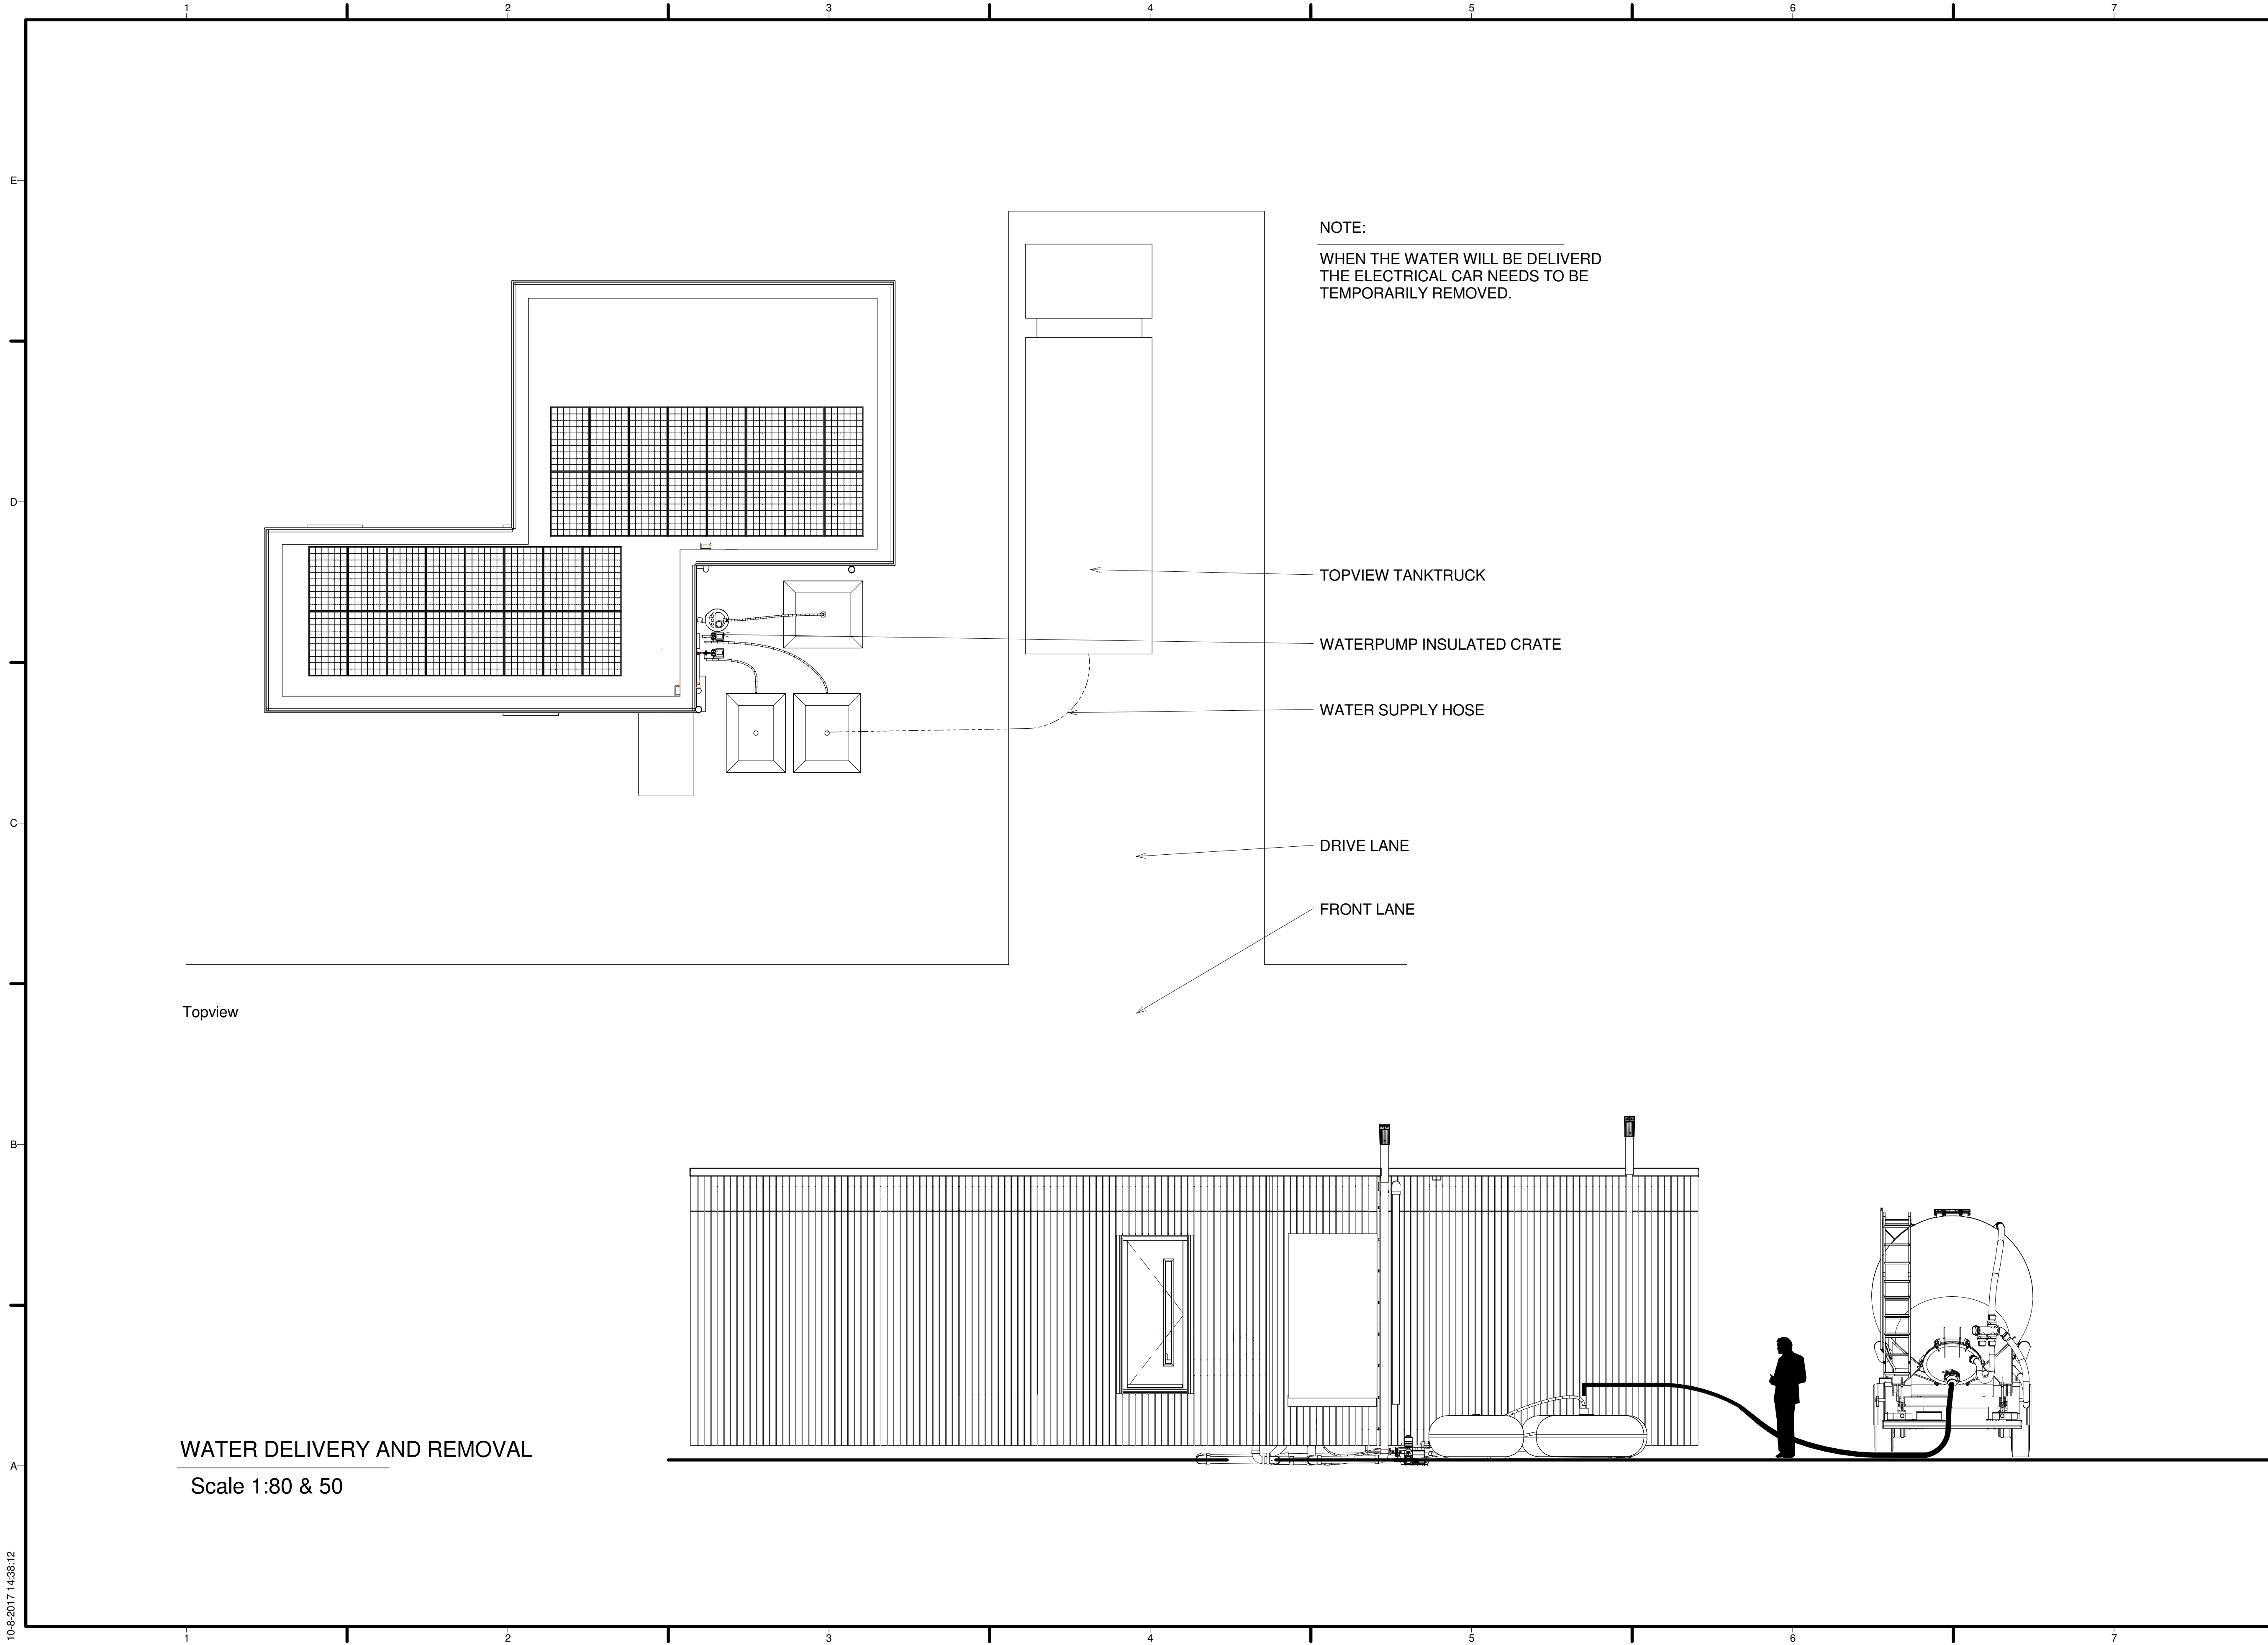

NOTE:
 WHEN THE WATER WILL BE DELIVERD
 THE ELECTRICAL CAR NEEDS TO BE
 TEMPORARILY REMOVED.

TOPVIEW TANKTRUCK

WATERPUMP INSULATED CRATE

WATER SUPPLY HOSE

DRIVE LANE

FRONT LANE


Topview

WATER DELIVERY AND REMOVAL
 Scale 1:80 & 50



TEAM NAME: Selficient
 ADDRESS: Padualaan 99
 3584CH Utrecht
 The Netherlands
 CONTACT: info@selficient.org
 www.selficient.org

CONSULTANTS
 ARCHITECTURE
 ENGINEERS
 LANDSCAPING
 SAFETY FIRST CODE CONSULTANTS

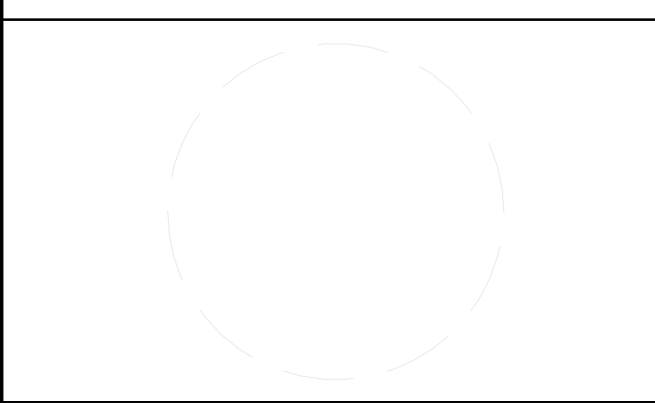

CLIENT
 U.S. DEPARTMENT OF ENERGY
 SOLAR DECATHLON 2017
 WWW.SOLARDECATHLON.GOV




Rev.00	02-24-2017	ADD. WATER DELIVERY
MARK	DATE	DESCRIPTION

LOT NUMBER: 106
 DRAWN BY: Kars Slagter
 CHECKED BY: Remco Polle
 COPYRIGHT: NONE; PROJECT IS
 PUBLIC DOMAIN

SHEET TITLE
 WATER DELIVERY AND
 REMOVAL

G-202

10-8-2017 14:38:12

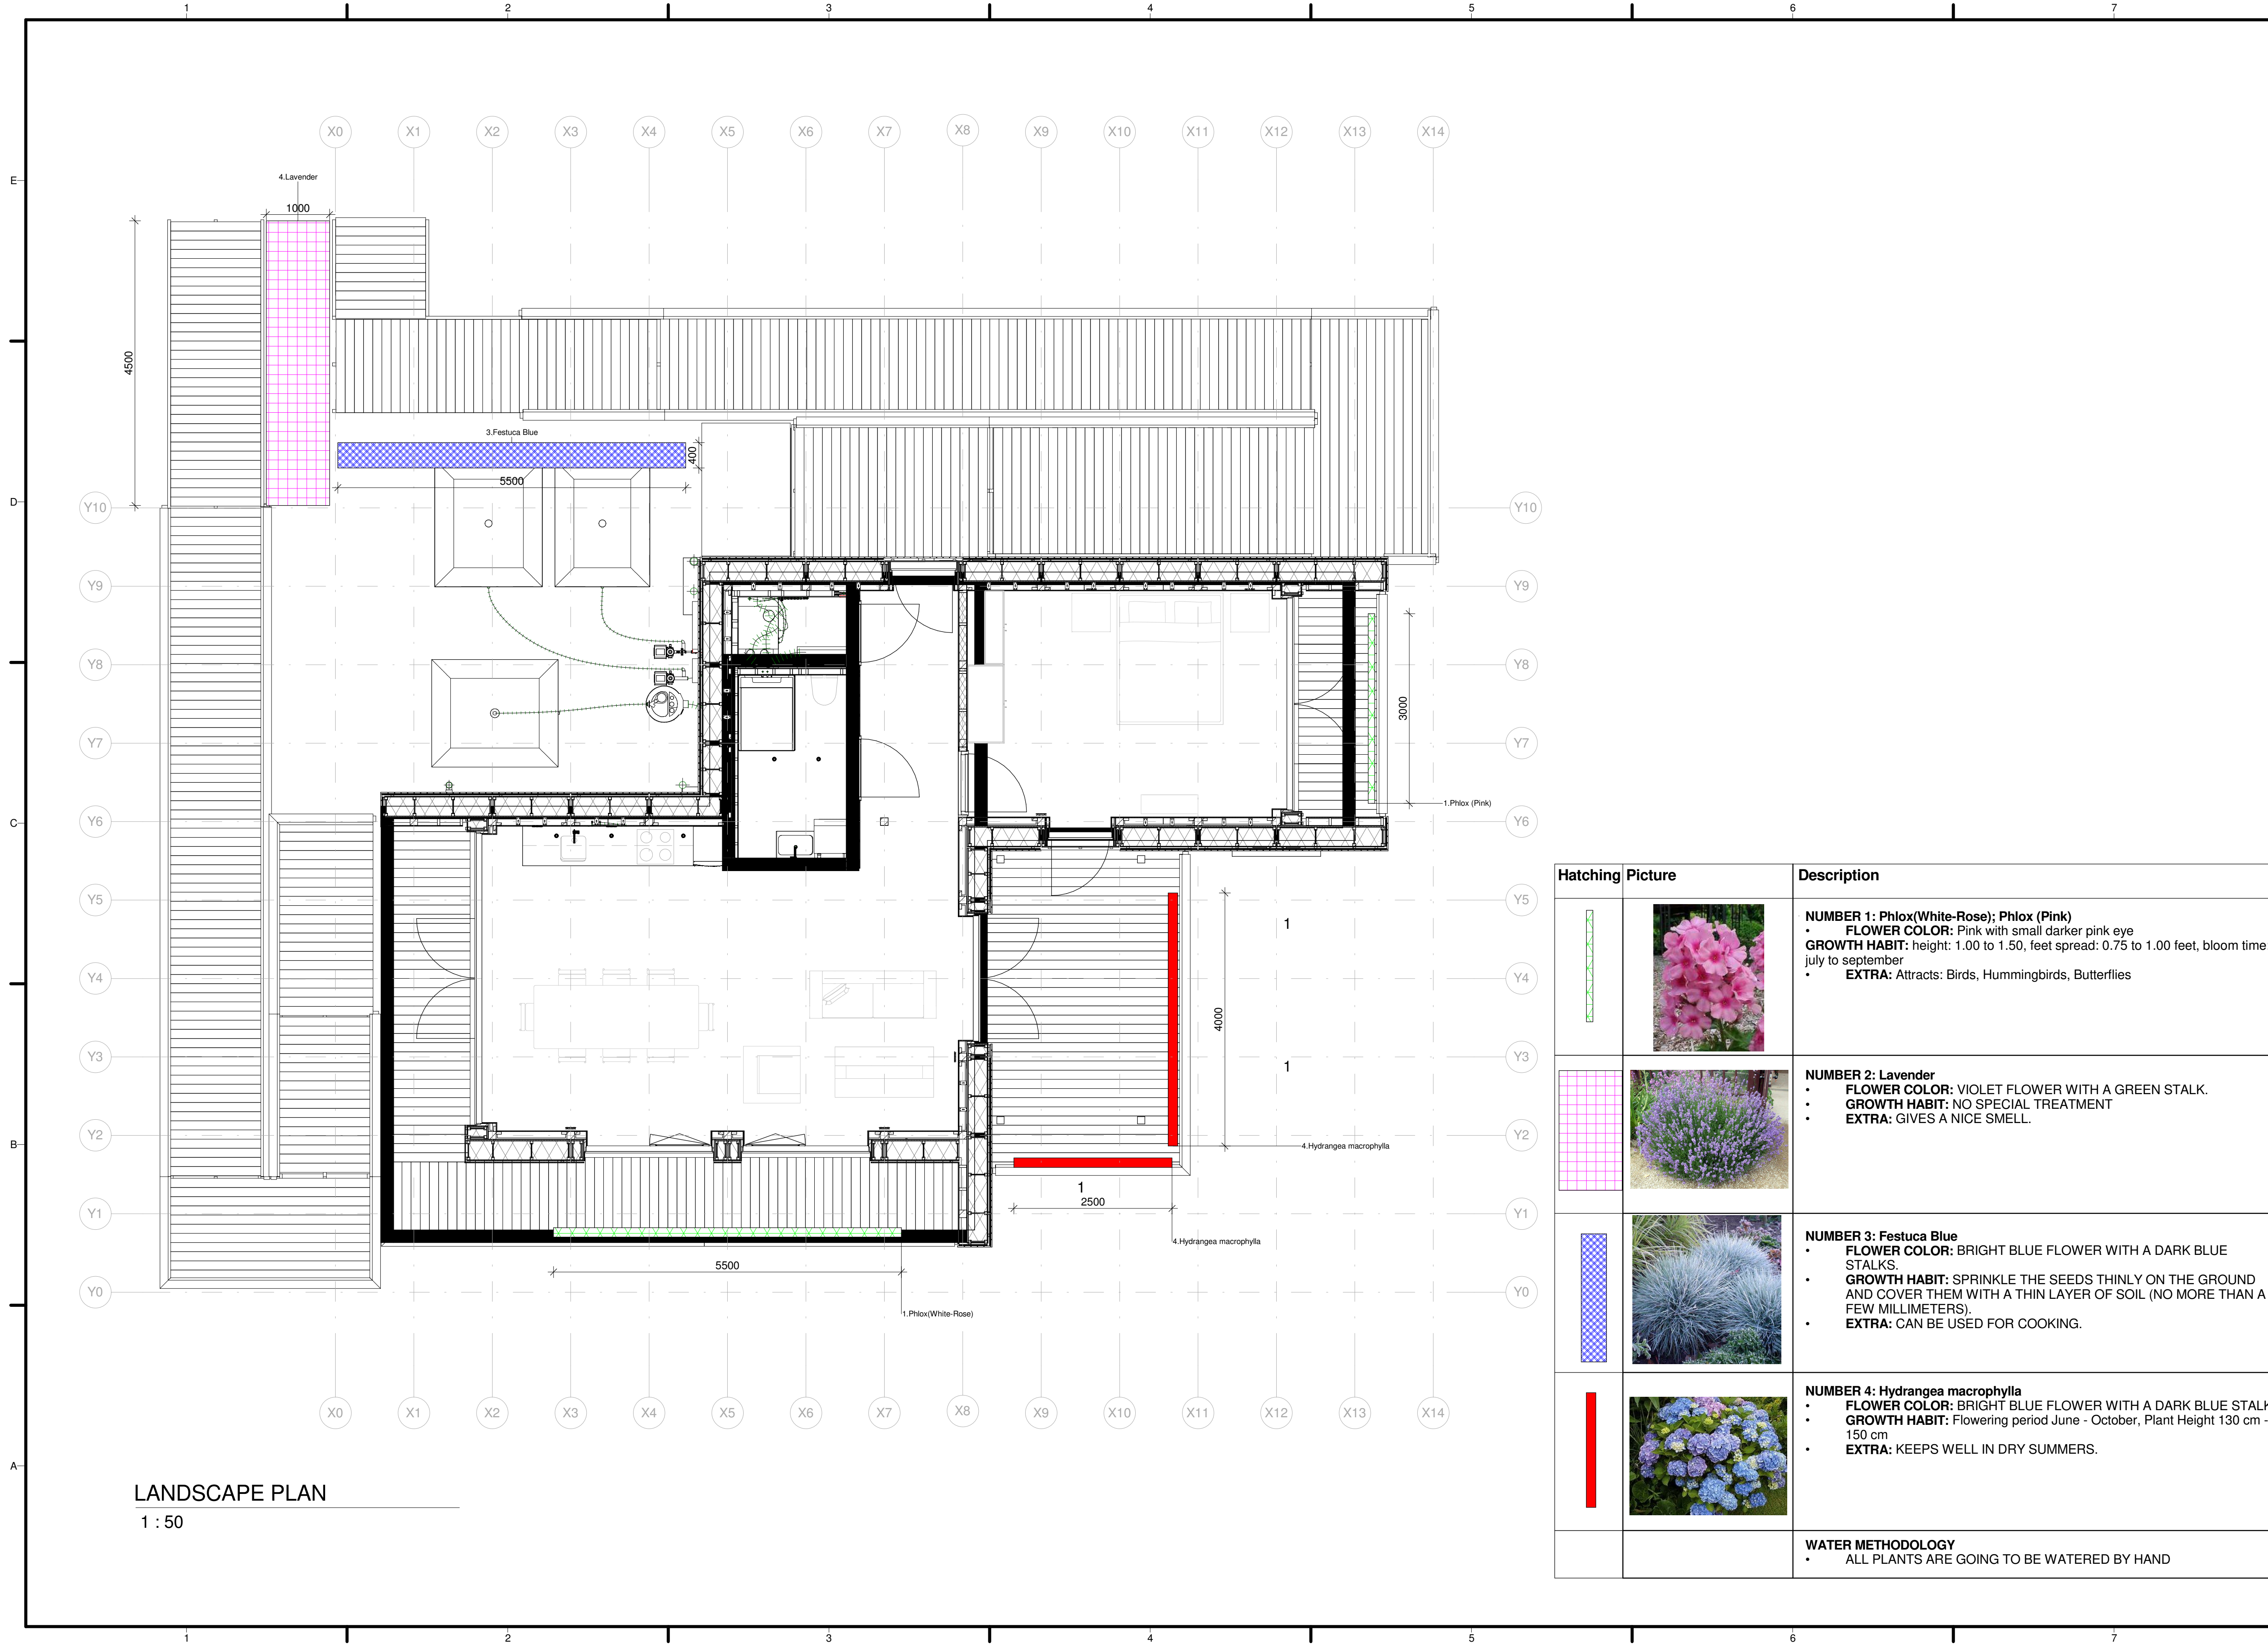

LANDSCAPE PLAN
1 : 50

Hatching	Picture	Description
		NUMBER 1: Phlox(White-Rose); Phlox (Pink) <ul style="list-style-type: none"> FLOWER COLOR: Pink with small darker pink eye GROWTH HABIT: height: 1.00 to 1.50, feet spread: 0.75 to 1.00 feet, bloom time: july to september EXTRA: Attracts: Birds, Hummingbirds, Butterflies
		NUMBER 2: Lavender <ul style="list-style-type: none"> FLOWER COLOR: VIOLET FLOWER WITH A GREEN STALK. GROWTH HABIT: NO SPECIAL TREATMENT EXTRA: GIVES A NICE SMELL.
		NUMBER 3: Festuca Blue <ul style="list-style-type: none"> FLOWER COLOR: BRIGHT BLUE FLOWER WITH A DARK BLUE STALKS. GROWTH HABIT: SPRINKLE THE SEEDS THINLY ON THE GROUND AND COVER THEM WITH A THIN LAYER OF SOIL (NO MORE THAN A FEW MILLIMETERS). EXTRA: CAN BE USED FOR COOKING.
		NUMBER 4: Hydrangea macrophylla <ul style="list-style-type: none"> FLOWER COLOR: BRIGHT BLUE FLOWER WITH A DARK BLUE STALK GROWTH HABIT: Flowering period June - October, Plant Height 130 cm - 150 cm EXTRA: KEEPS WELL IN DRY SUMMERS.
		WATER METHODOLOGY <ul style="list-style-type: none"> ALL PLANTS ARE GOING TO BE WATERED BY HAND

TEAM NAME: Selficient
ADDRESS: Padualaan 99, 3584 CH Utrecht
CONTACT: info@selficient.org, www.selficient.org

CONSULTANTS
ARCHITECTURE
ENGINEERS
LANDSCAPING
SAFETY FIRST CODE CONSULTANTS

CLIENT
U.S. DEPARTMENT OF ENERGY
SOLAR DECATHLON 2017
WWW.SOLARDECATHLON.GOV


MARK	DATE	DESCRIPTION
0	17-11-2016	90% revision

LOT NUMBER: 106
DRAWN BY: Author
CHECKED BY: Selficient
COPYRIGHT: NONE; PROJECT IS PUBLIC DOMAIN

SCALE: 1 : 50

SHEET TITLE
LANDSCAPE PLAN


L-200

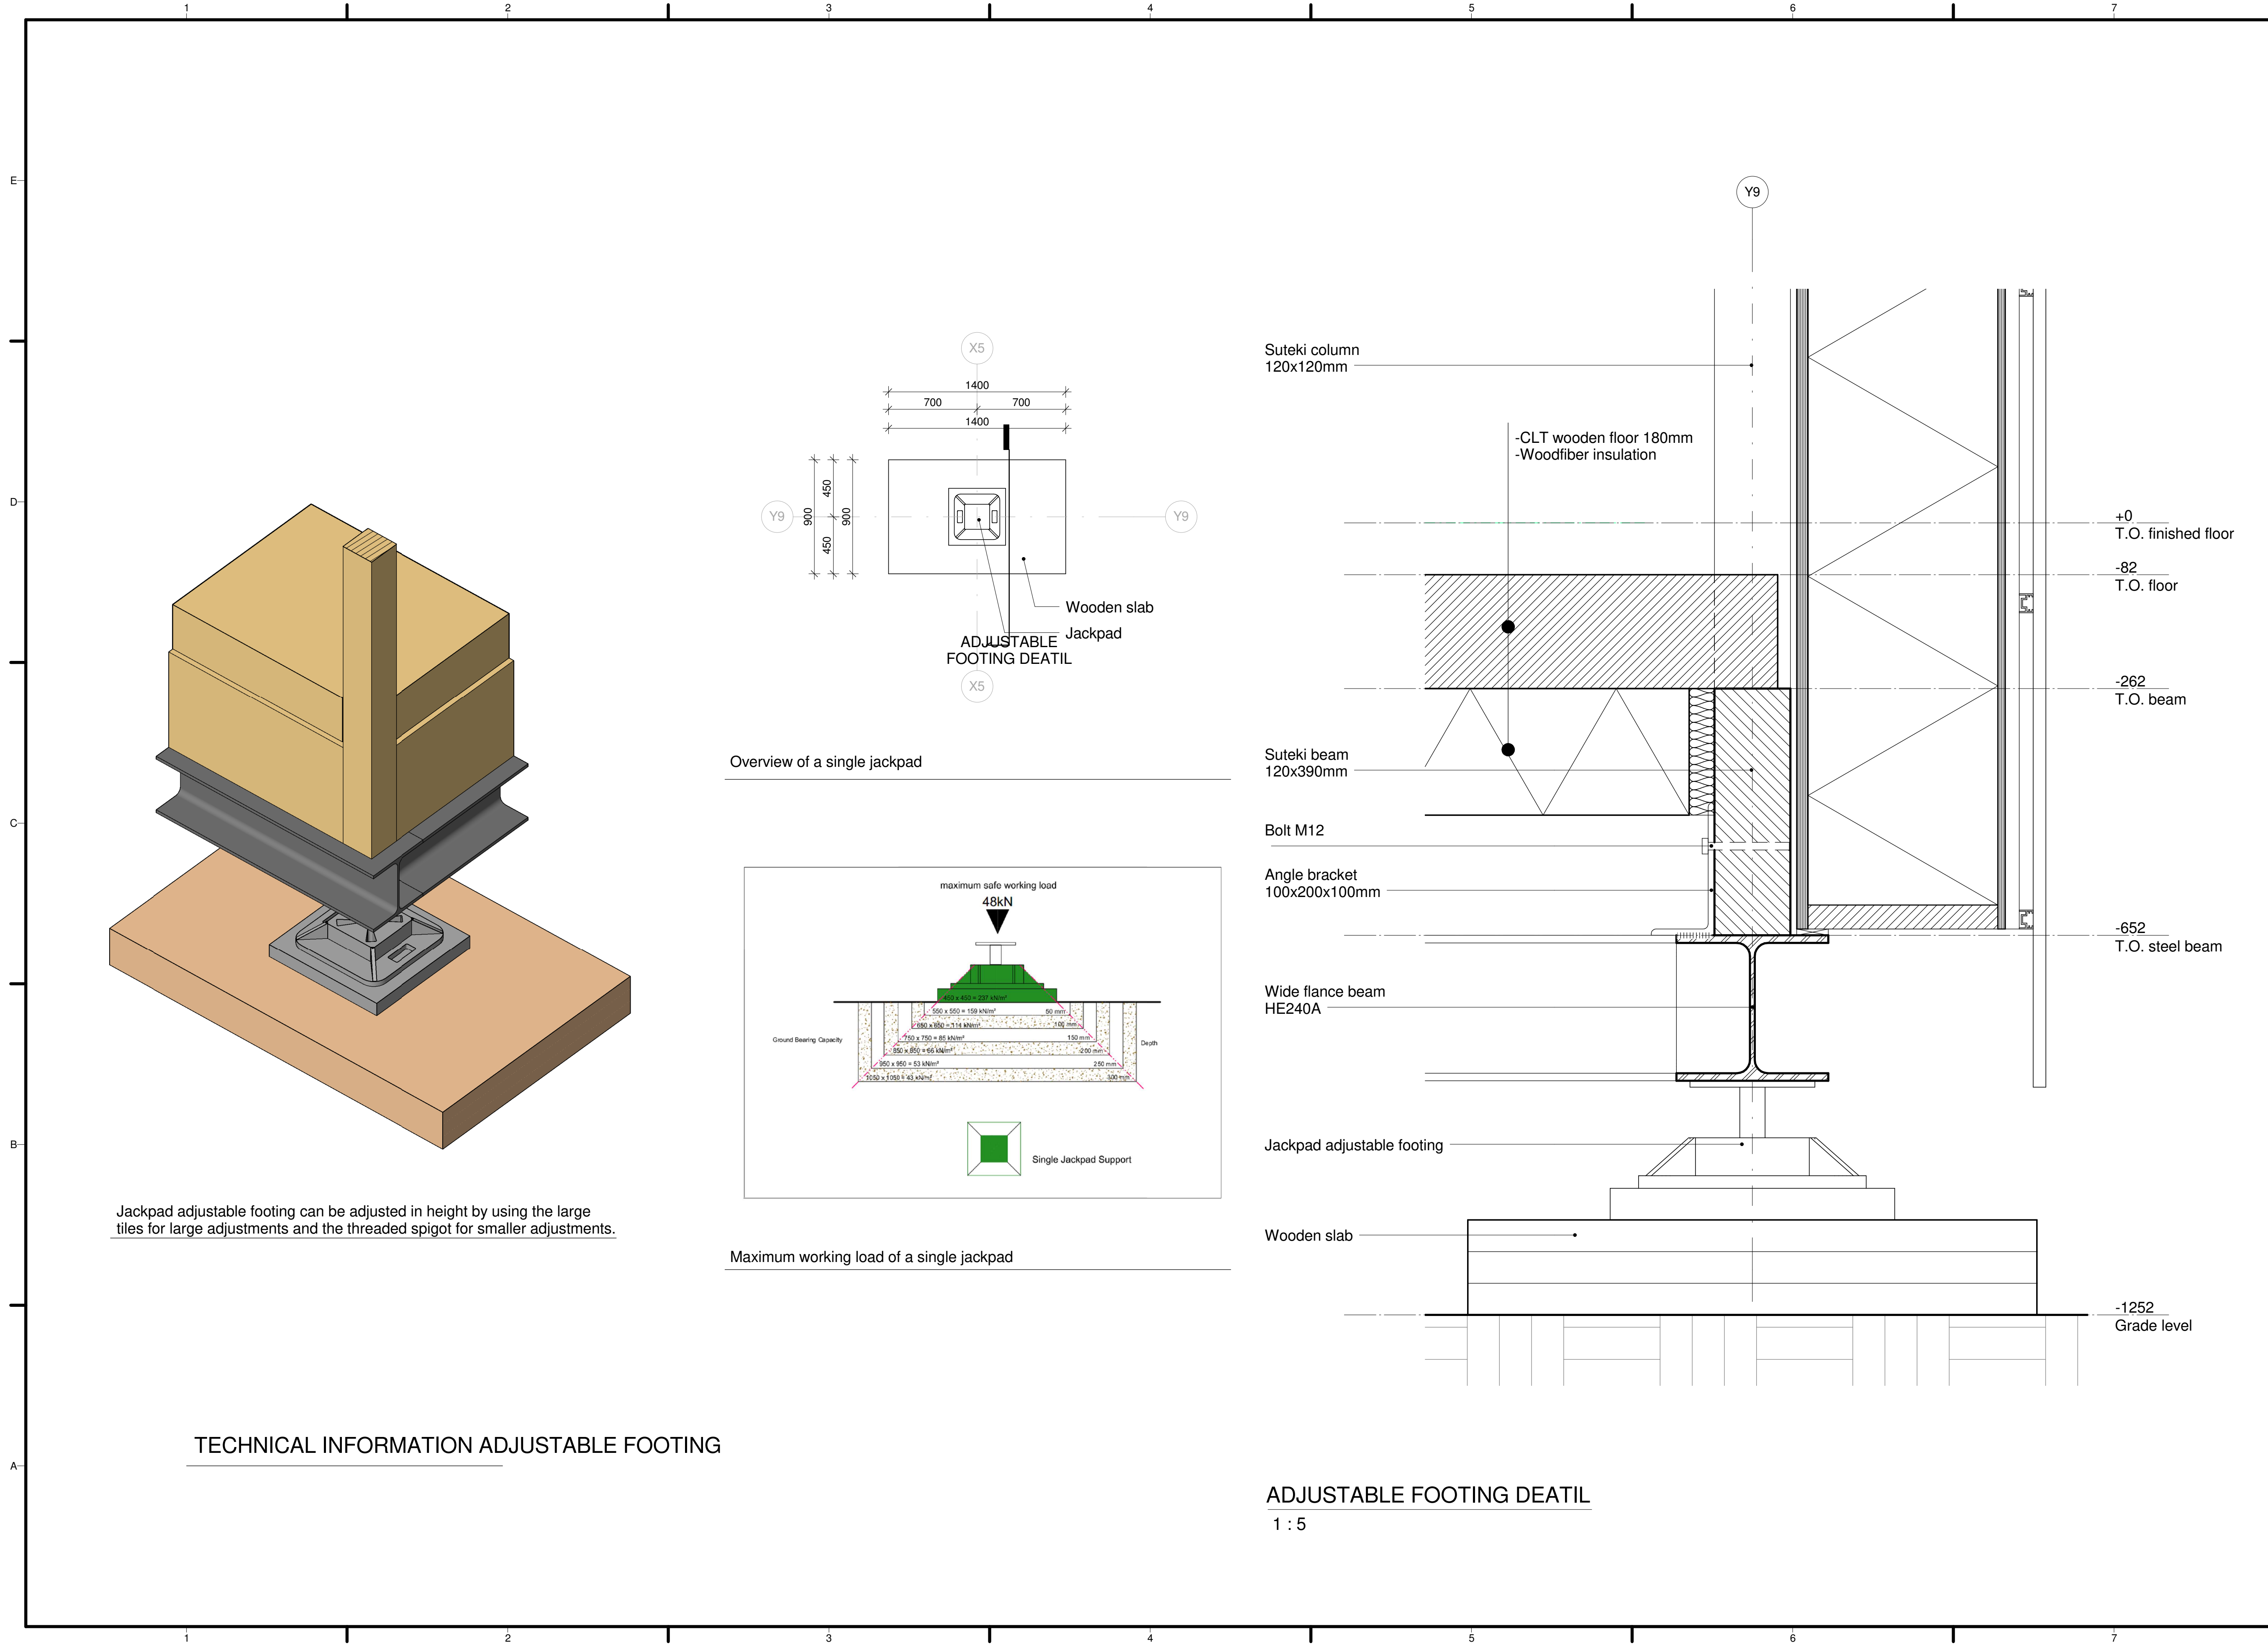

Jackpad adjustable footing can be adjusted in height by using the large tiles for large adjustments and the threaded spigot for smaller adjustments.


TECHNICAL INFORMATION ADJUSTABLE FOOTING

Overview of a single jackpad

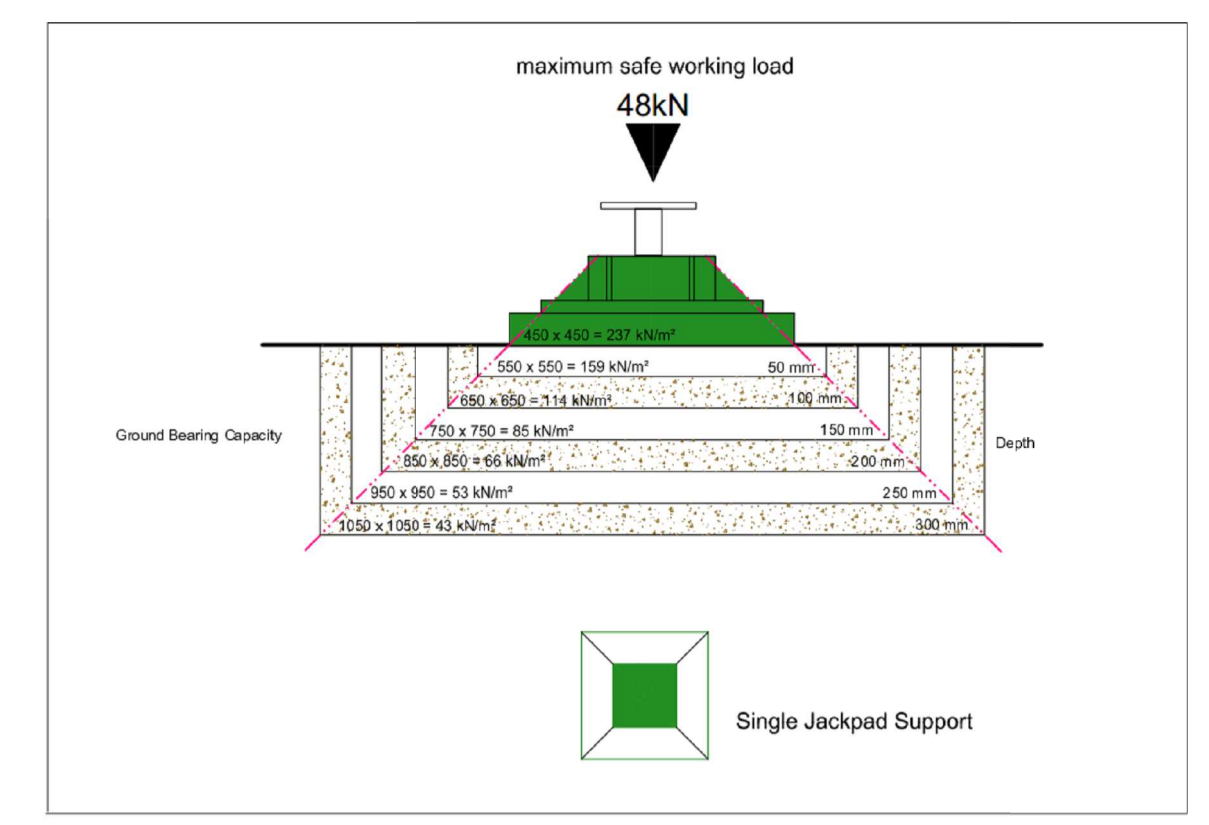


Maximum working load of a single jackpad

ADJUSTABLE FOOTING DETAIL
1 : 5



TEAM NAME:	Selficient
ADDRESS:	Padualaan 99 3584 CH Utrecht
CONTACT:	info@selficient.org www.selficient.org

CONSULTANTS	
ARCHITECTURE	
ENGINEERS	
LANDSCAPING	
SAFETY FIRST CODE CONSULTANTS	




CLIENT	
U.S. DEPARTMENT OF ENERGY SOLAR DECATHLON 2017 WWW.SOLARDECATHLON.GOV	

MARK	DATE	DESCRIPTION
0	17-11-2016	90% revision

LOT NUMBER:	106
DRAWN BY:	SELFICIENT
CHECKED BY:	Selficient
COPYRIGHT:	NONE; PROJECT IS PUBLIC DOMAIN
SCALE:	As indicated

**ADJUSTABLE FOOTING
DETAIL**

S-201

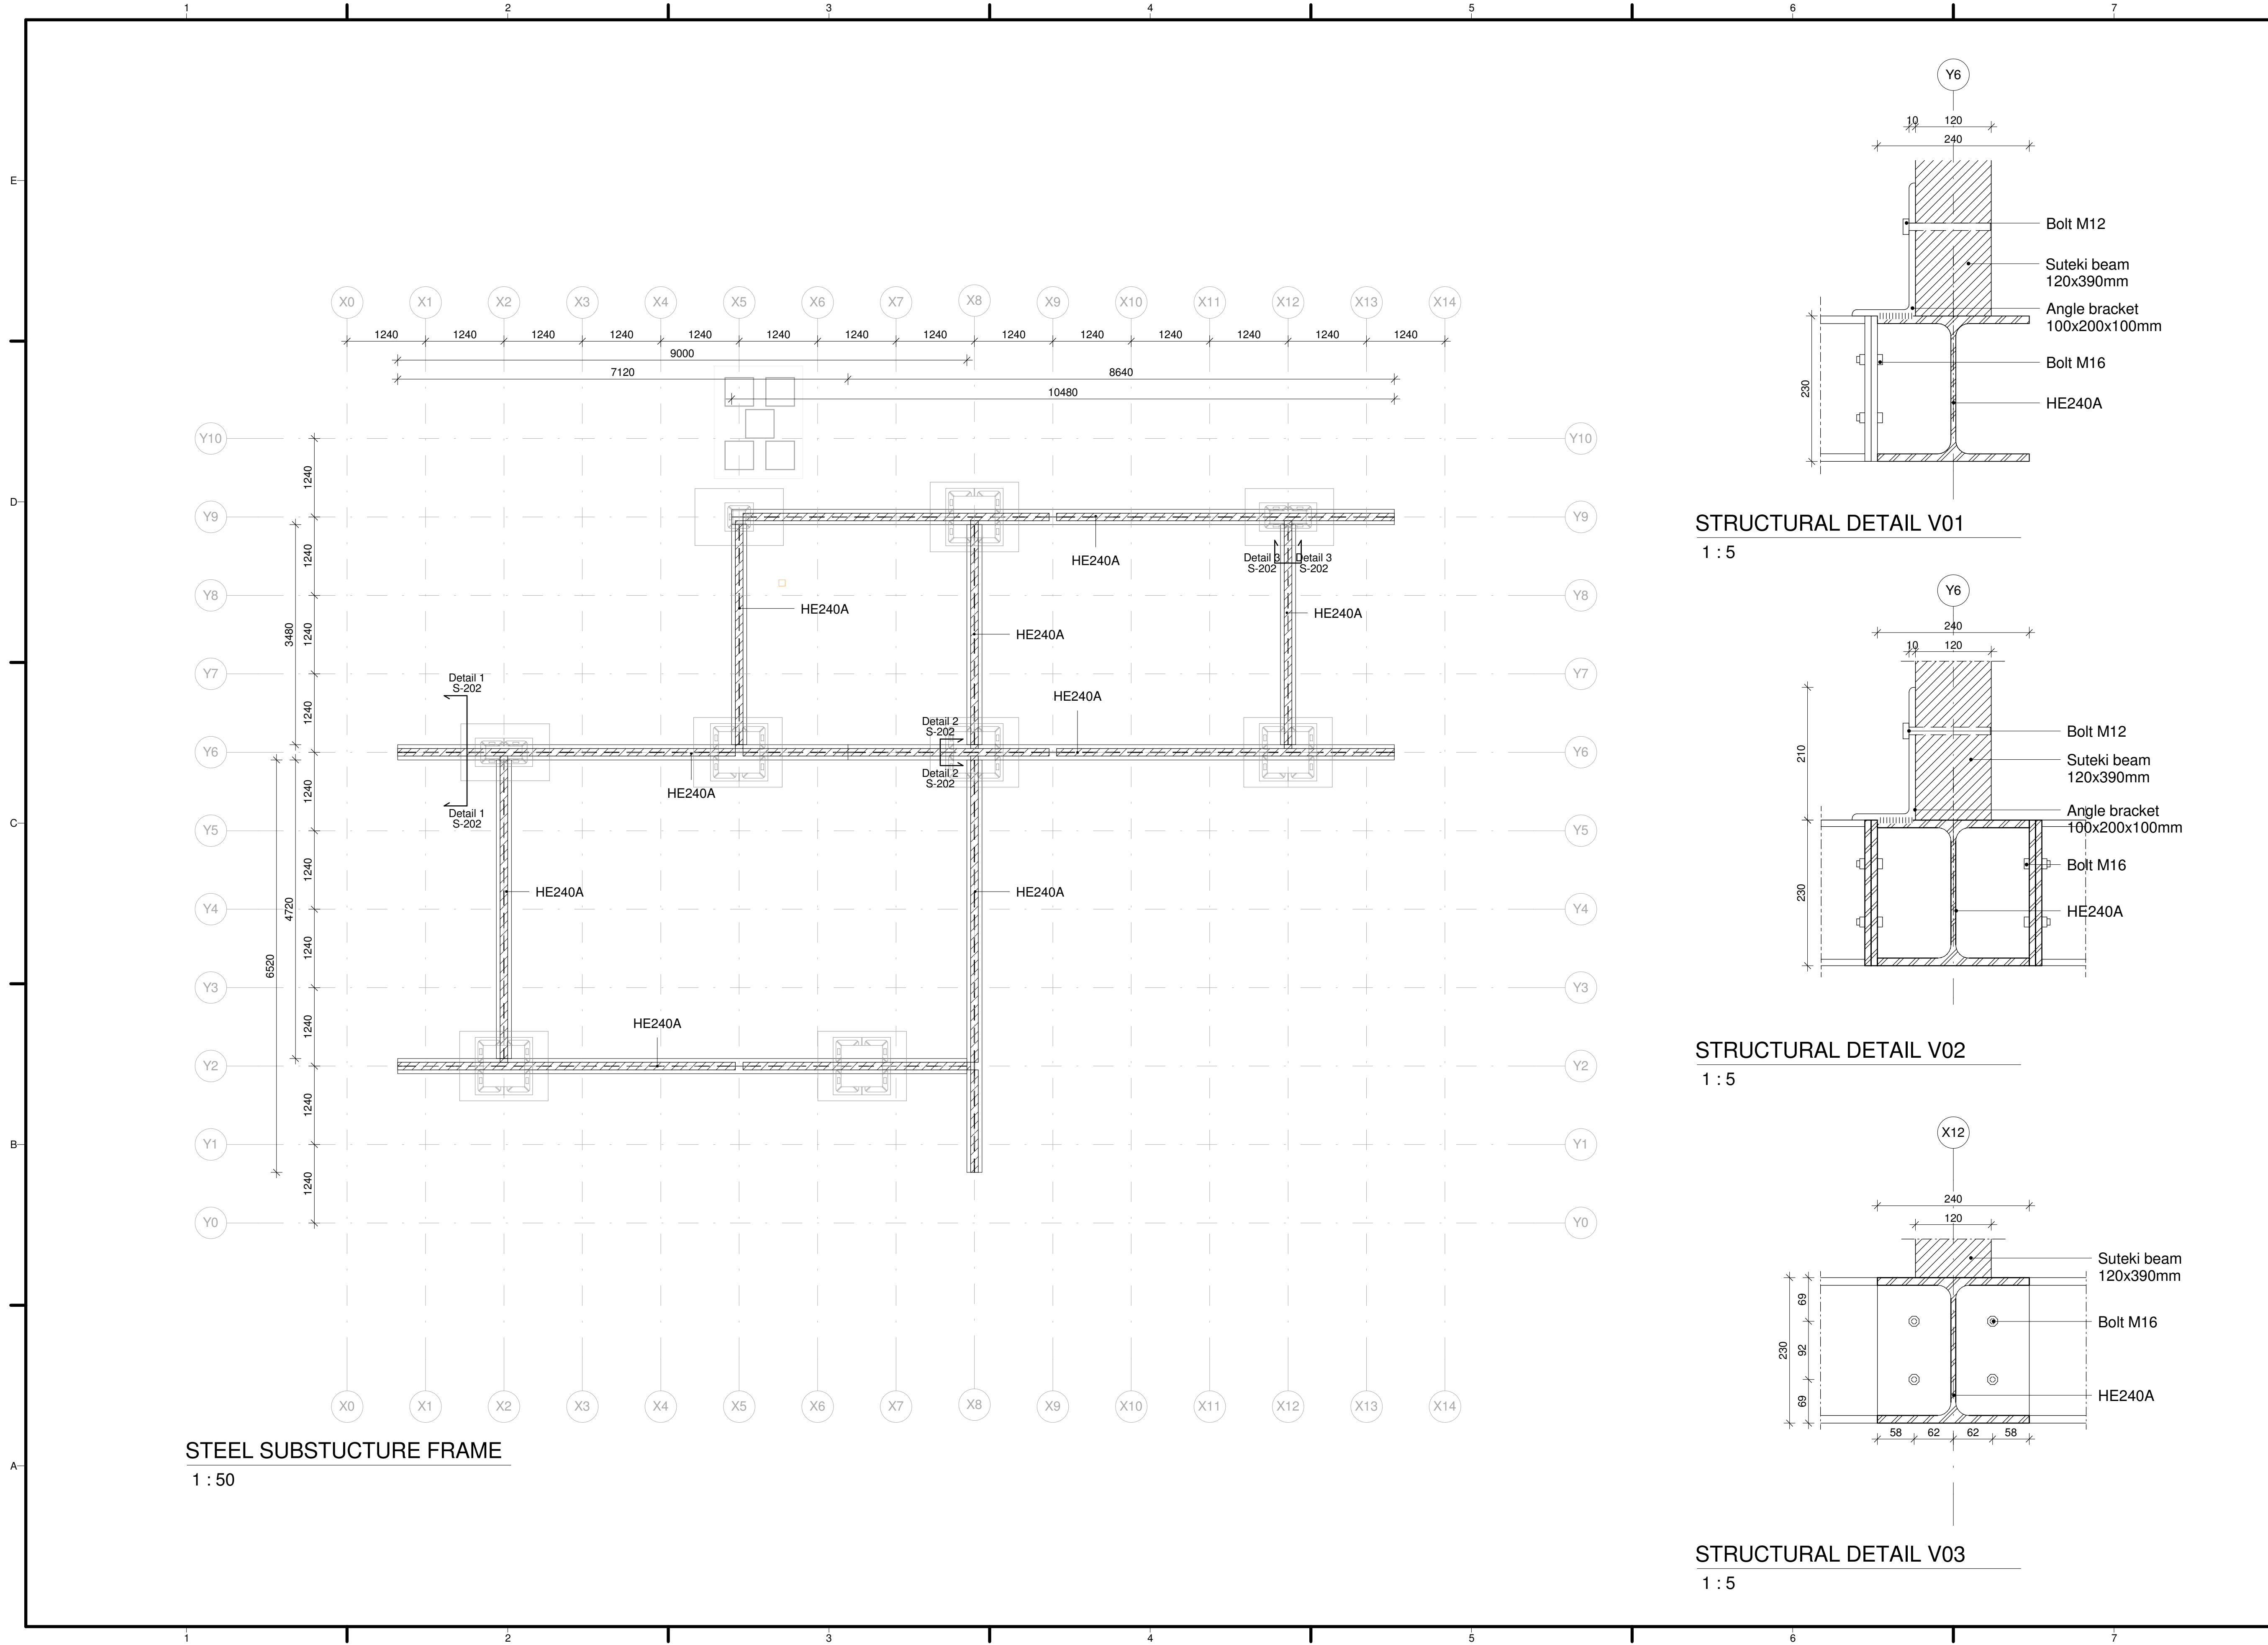

STEEL SUBSTRUCTURE FRAME
1 : 50

STRUCTURAL DETAIL V01
1 : 5

STRUCTURAL DETAIL V02
1 : 5

STRUCTURAL DETAIL V03
1 : 5



TEAM NAME: Selficient
ADDRESS: Padualaan 99
3584 CH Utrecht
CONTACT: info@selficient.org
www.selficient.org

CONSULTANTS
ARCHITECTURE
ENGINEERS
LANDSCAPING
SAFETY FIRST CODE CONSULTANTS

CLIENT
U.S. DEPARTMENT OF ENERGY
SOLAR DECATHLON 2017
WWW.SOLARDECATHLON.GOV



0	17-11-2016	90% revision

MARK	DATE	DESCRIPTION

LOT NUMBER: 106
DRAWN BY: SELFICIENT
CHECKED BY: Selficient
COPYRIGHT: NONE; PROJECT IS PUBLIC DOMAIN
SCALE: As indicated

SHEET TITLE
STEEL SUBSTRUCTURE FRAMING PLAN

S-202

TEAM NAME: Selficient
 ADDRESS: Padualaan 99
 3584 CH Utrecht
 CONTACT: info@selficient.org
 www.selficient.org

CONSULTANTS
 ARCHITECTURE
 ENGINEERS
 LANDSCAPING
 SAFETY FIRST CODE CONSULTANTS

CLIENT
 U.S. DEPARTMENT OF ENERGY
 SOLAR DECATHLON 2017
 WWW.SOLARDECATHLON.GOV




MARK	DATE	DESCRIPTION
0	17-11-2016	90% revision

LOT NUMBER: 106
 DRAWN BY: SELFICIENT
 CHECKED BY: Selficient
 COPYRIGHT: NONE; PROJECT IS PUBLIC DOMAIN


SCALE: 1 : 50

SHEET TITLE
FLOOR FRAMING PLAN


S-203

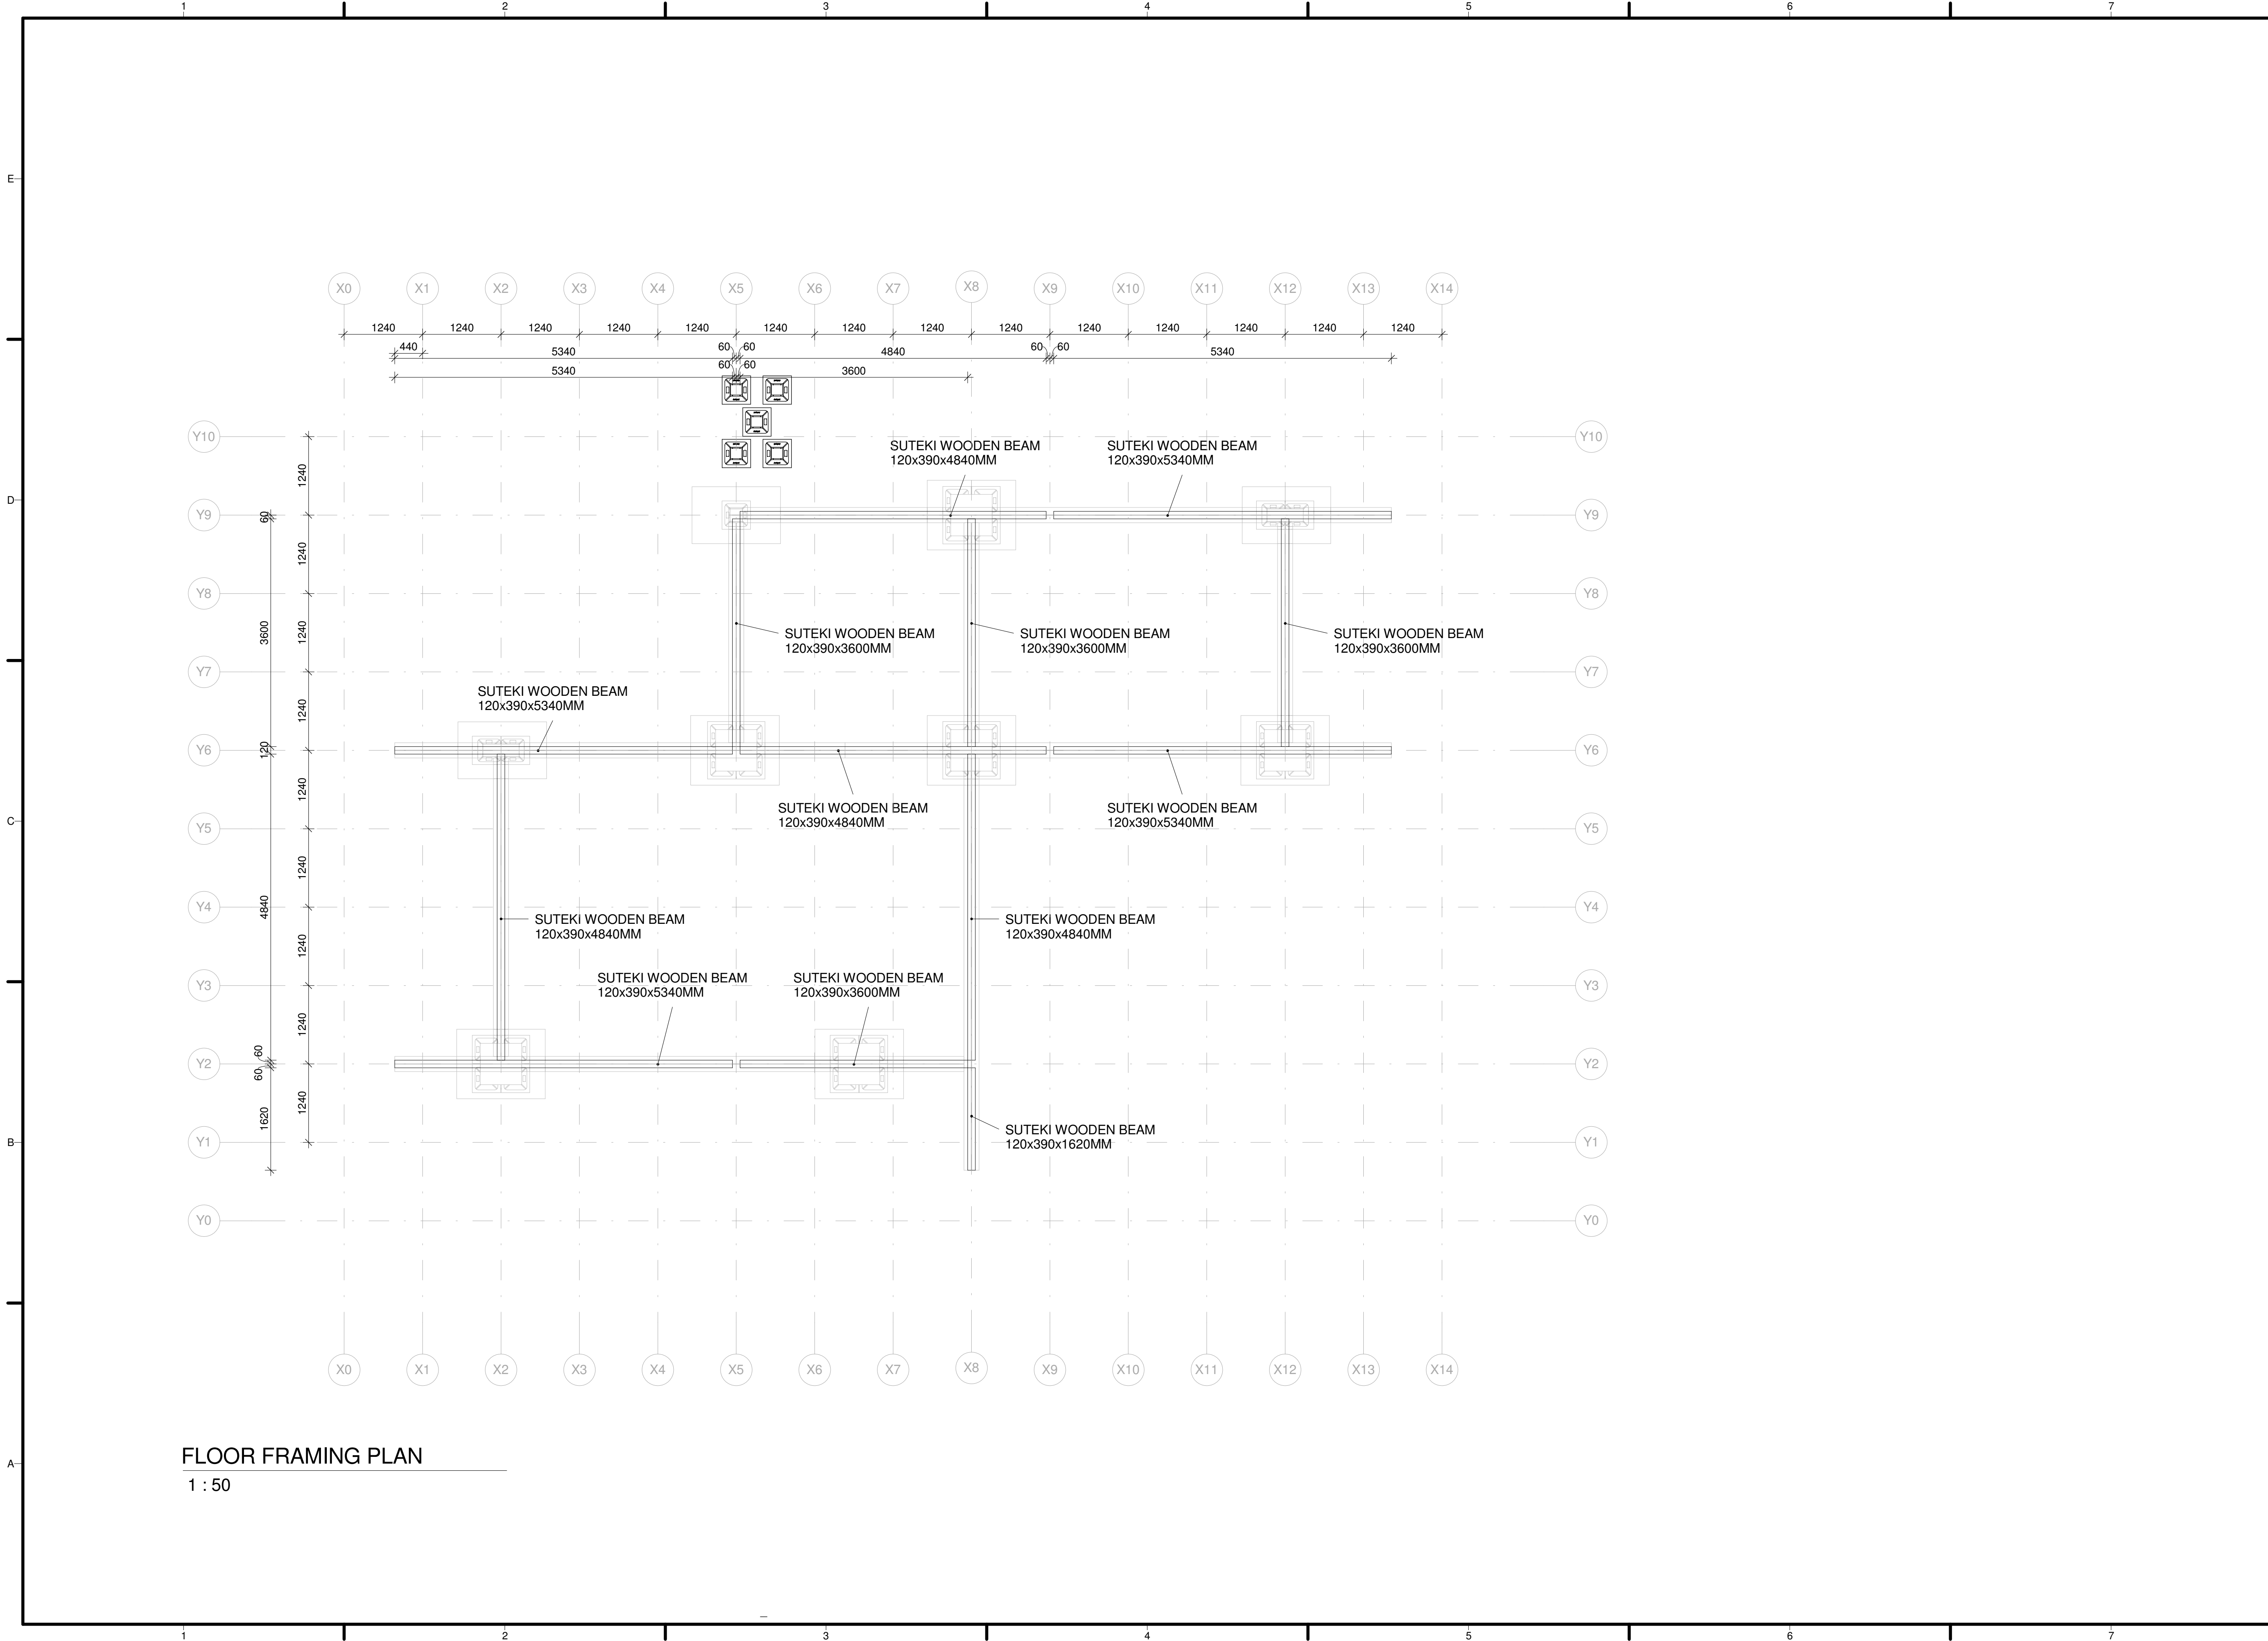


FLOOR FRAMING PLAN
 1 : 50

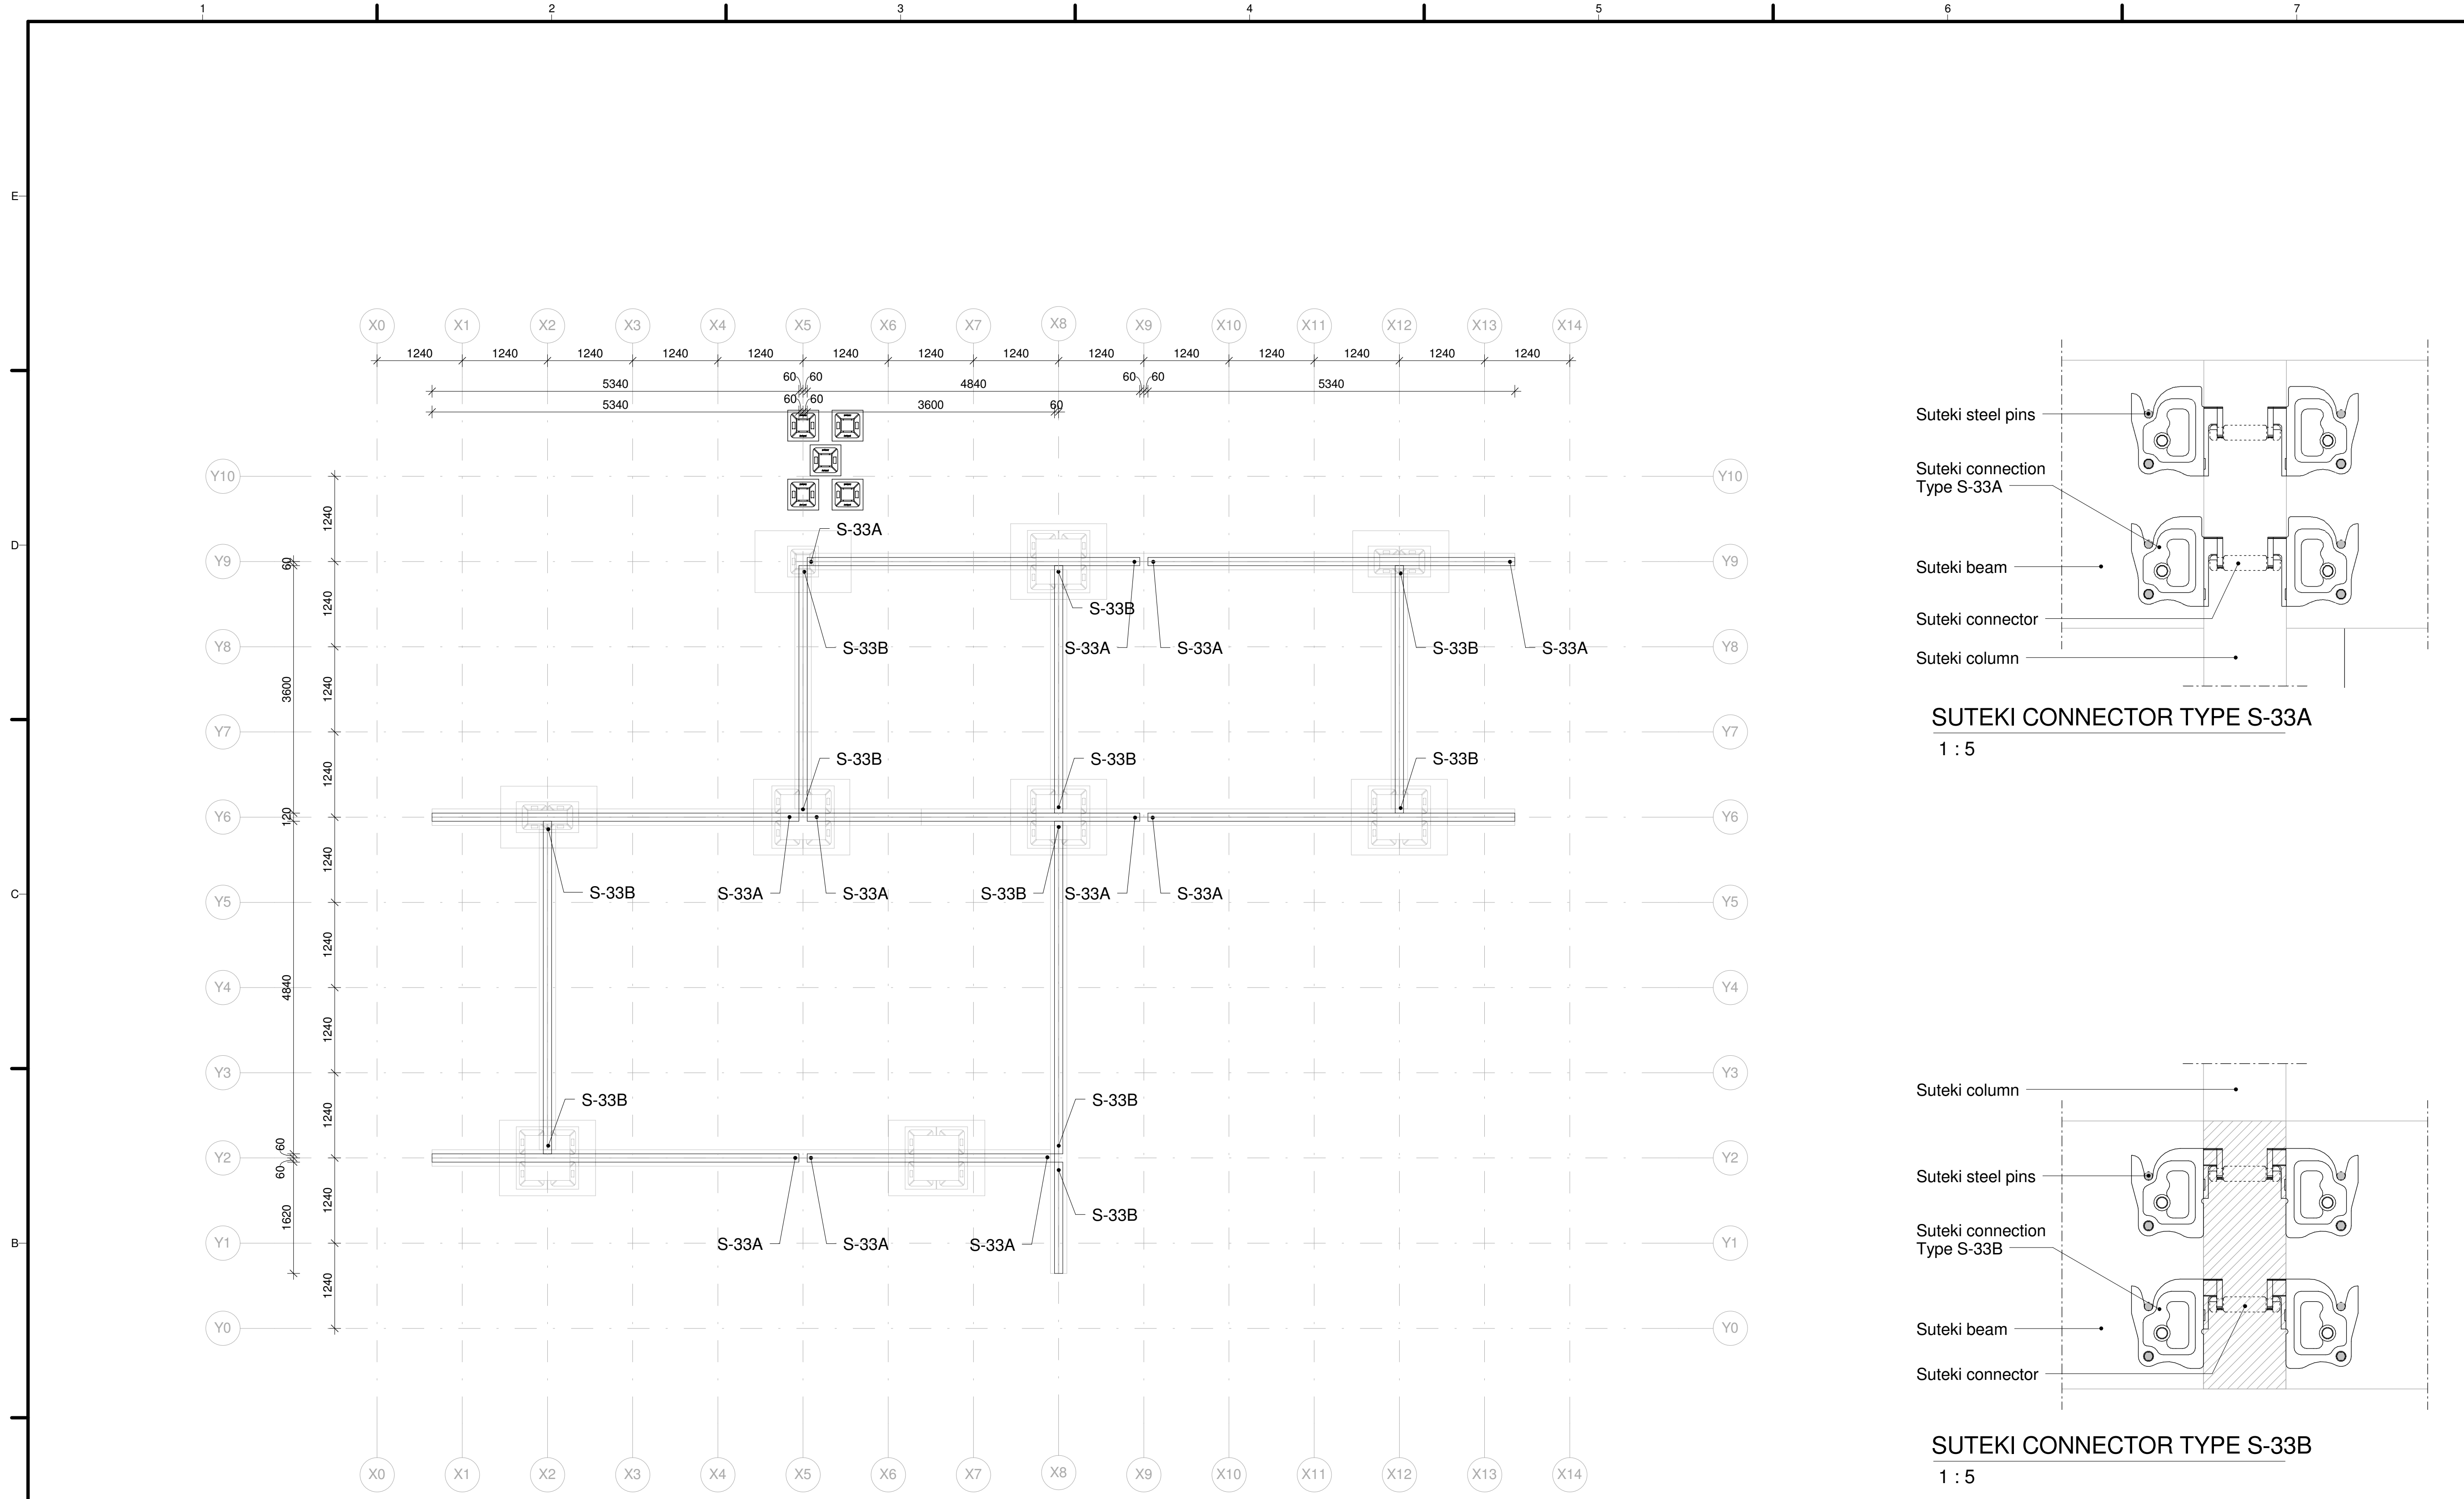

SUTEKI CONNECTION BEAMS
1 : 50

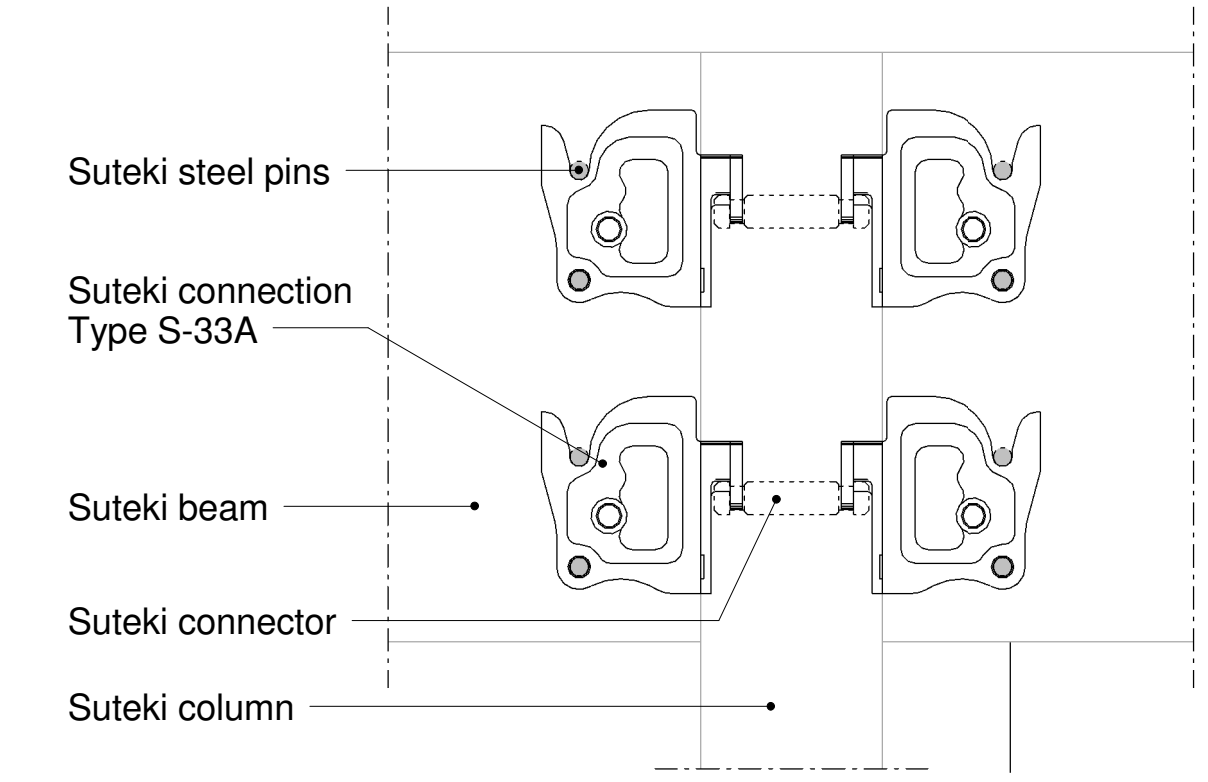

SUTEKI CONNECTOR TYPE S-33A
1 : 5

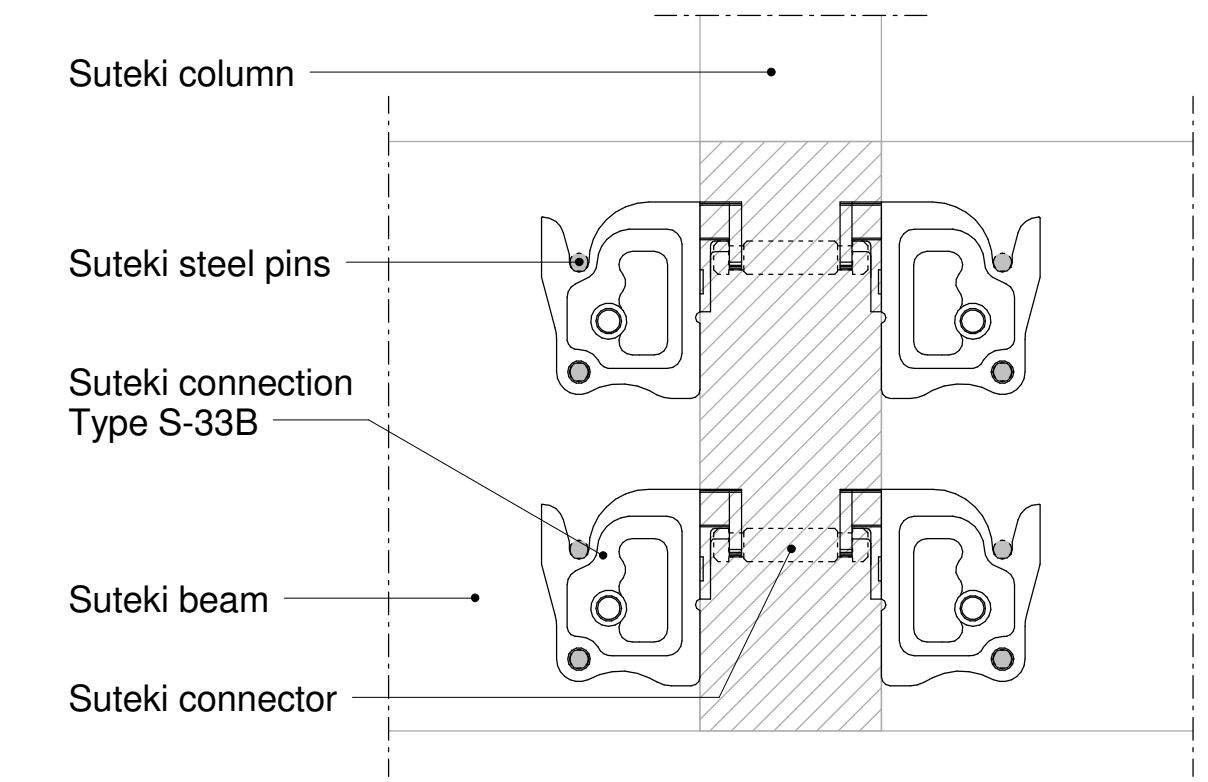

SUTEKI CONNECTOR TYPE S-33B
1 : 5

TEAM NAME: Selficient
 ADDRESS: Padualaan 99
 3584 CH Utrecht
 CONTACT: info@selficient.org
 www.selficient.org



CONSULTANTS
 ARCHITECTURE
 ENGINEERS
 LANDSCAPING
 SAFETY FIRST CODE CONSULTANTS

CLIENT
 U.S. DEPARTMENT OF ENERGY
 SOLAR DECATHLON 2017
 WWW.SOLARDECATHLON.GOV


MARK	DATE	DESCRIPTION
0	17-11-2016	90% revision

LOT NUMBER: 106
 DRAWN BY: SELFICIENT
 CHECKED BY: Selficient
 COPYRIGHT: NONE; PROJECT IS PUBLIC DOMAIN
 SCALE: As indicated


**FLOOR FRAMING
 SUTEKI CONNECTIONS
 PLAN**

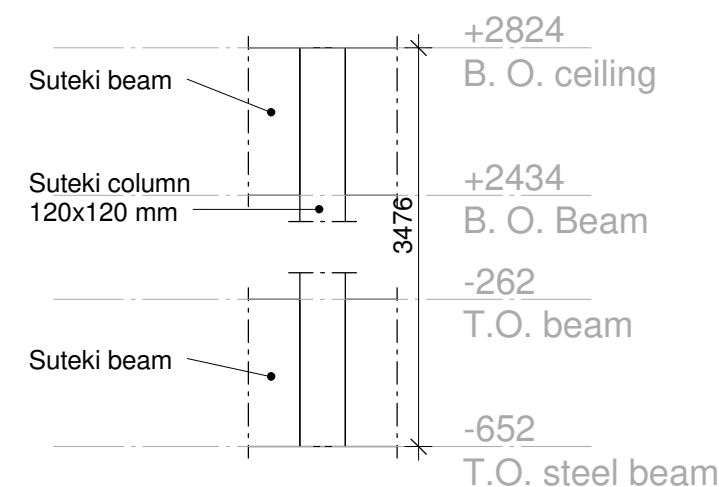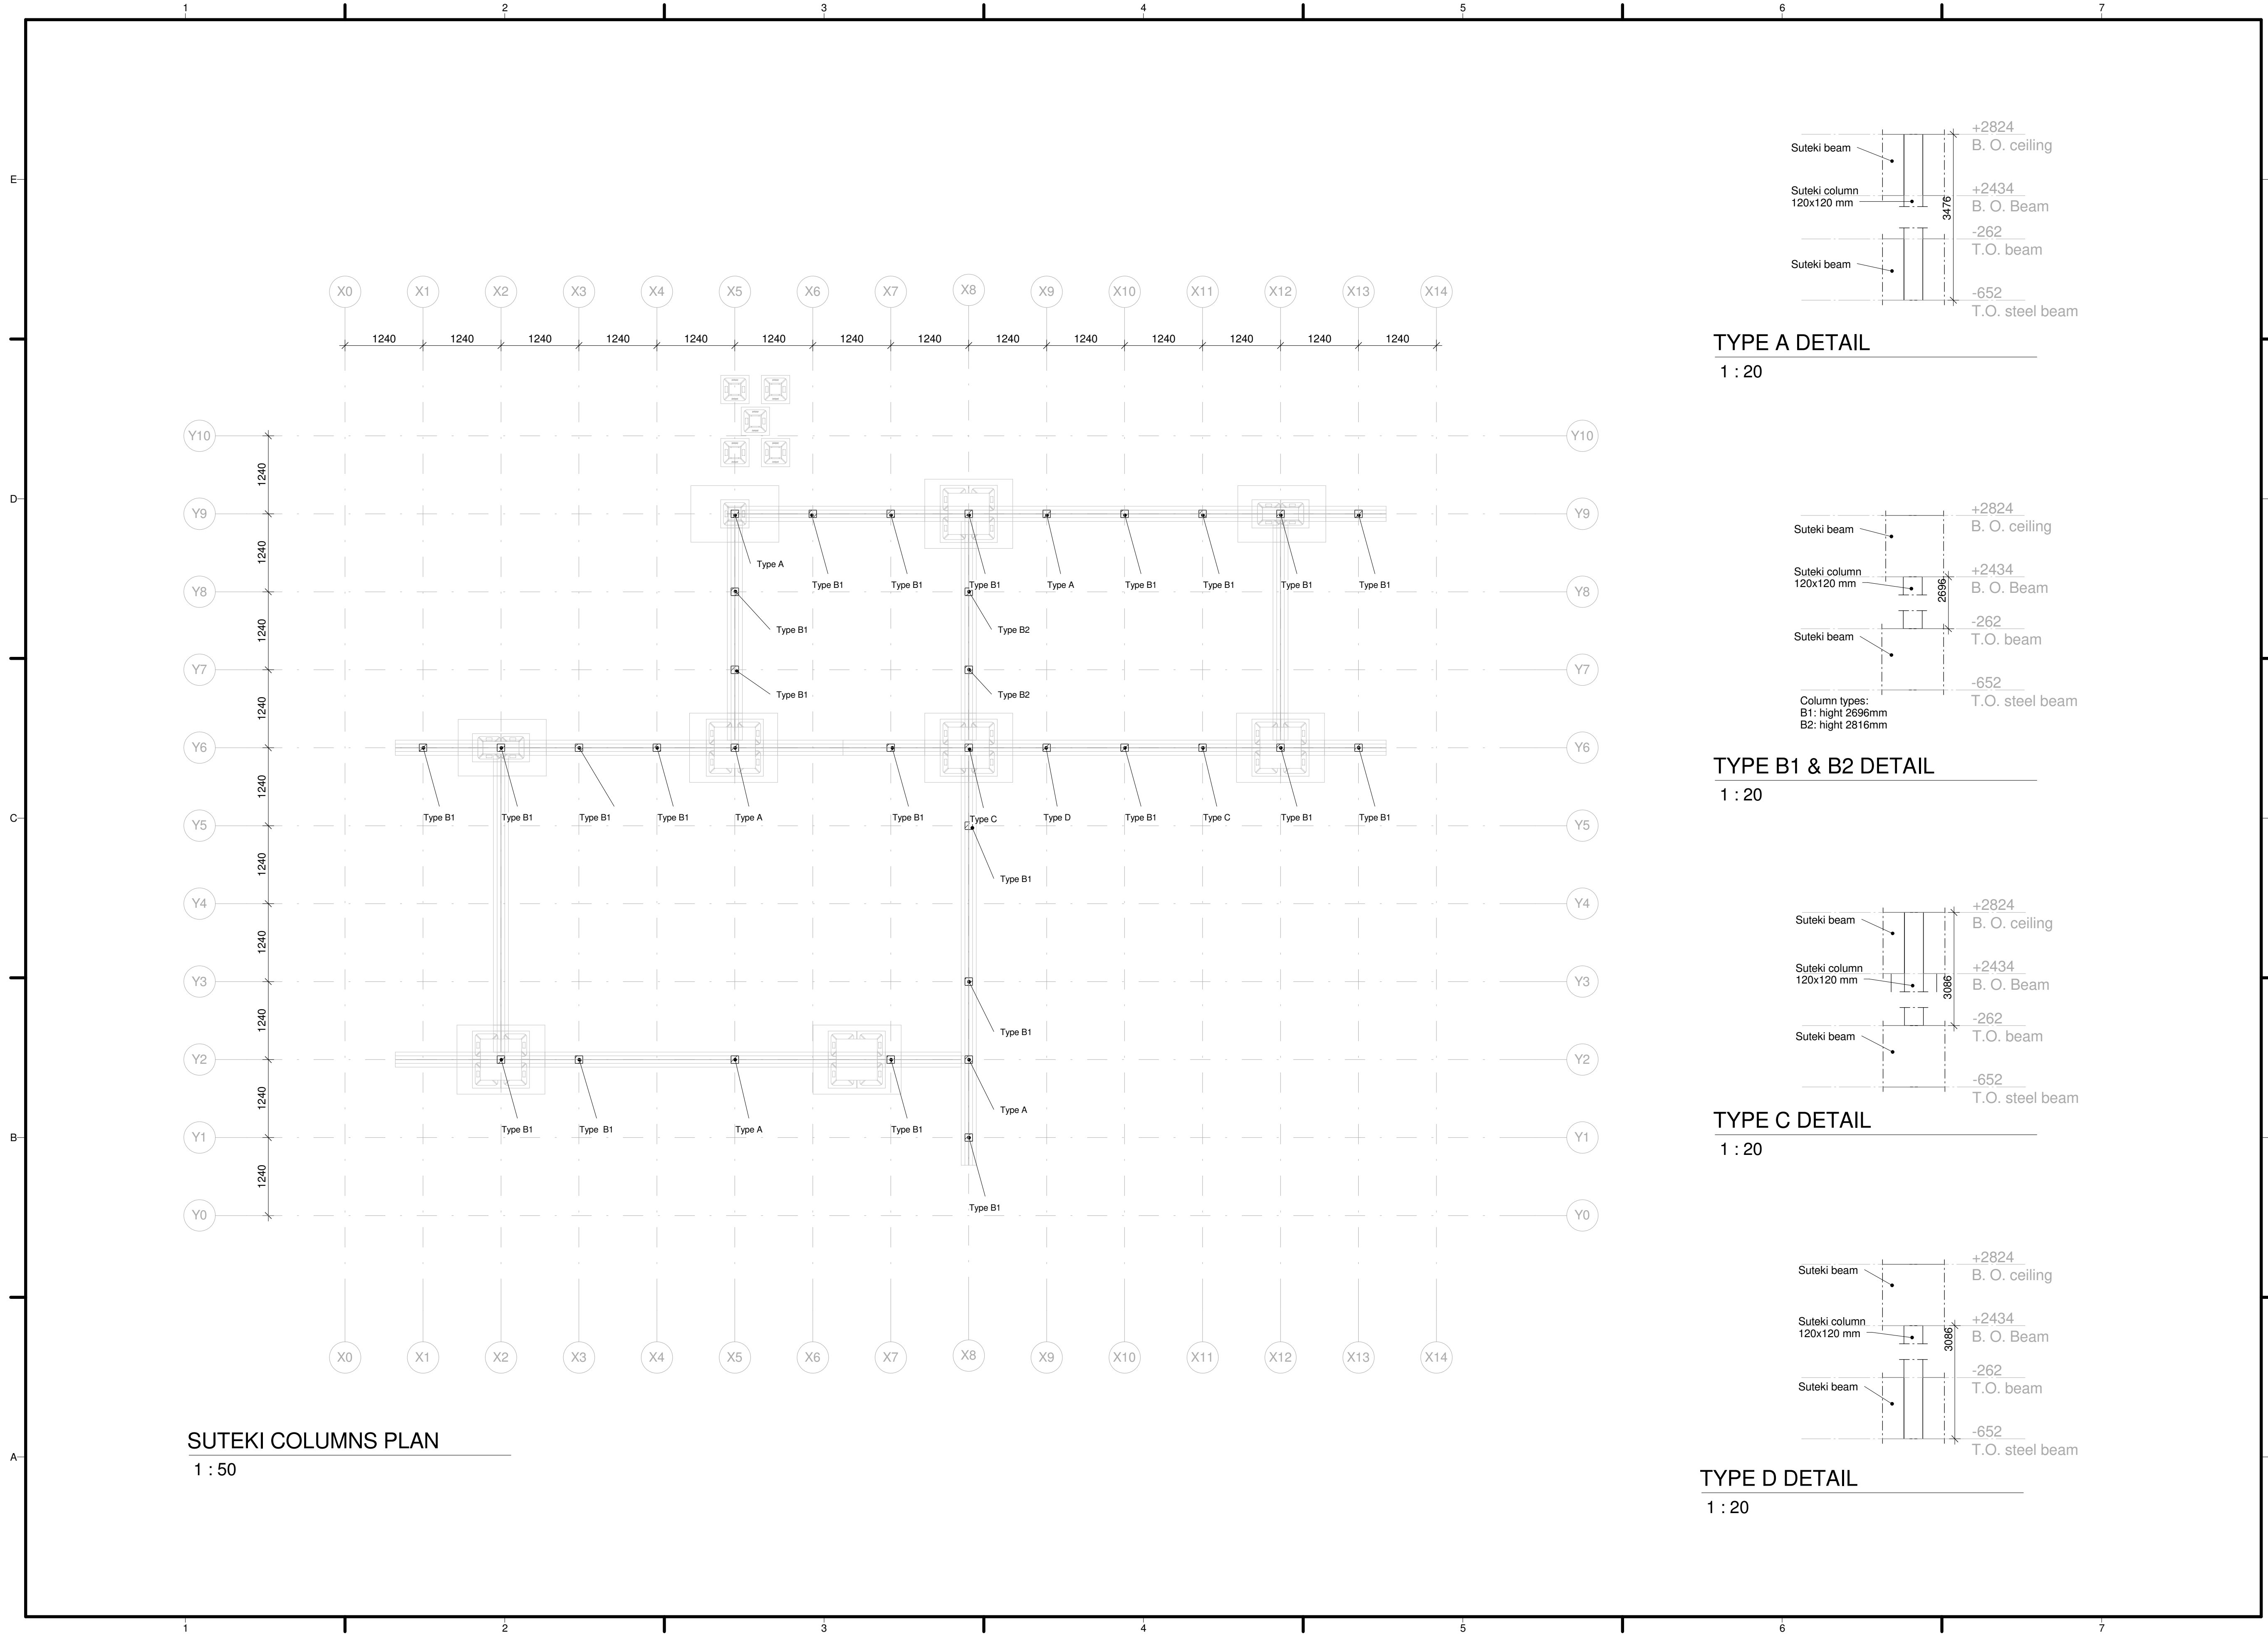


TYPE A DETAIL
1 : 20

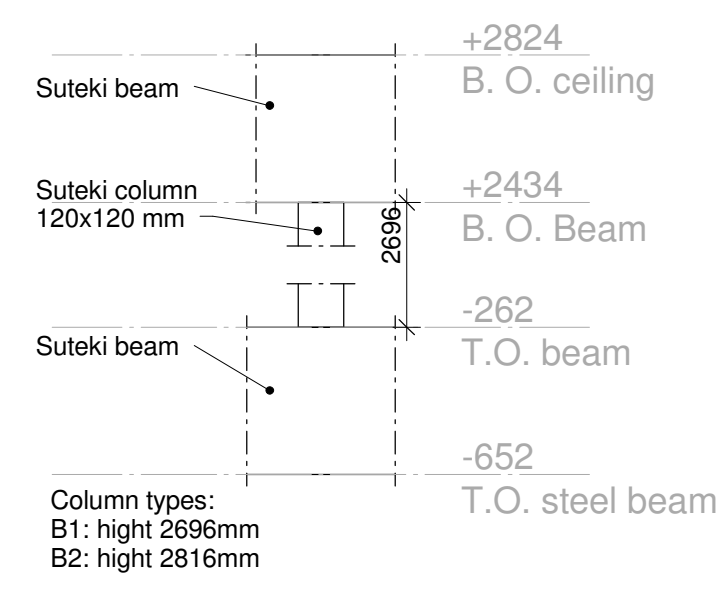


TYPE B1 & B2 DETAIL
1 : 20

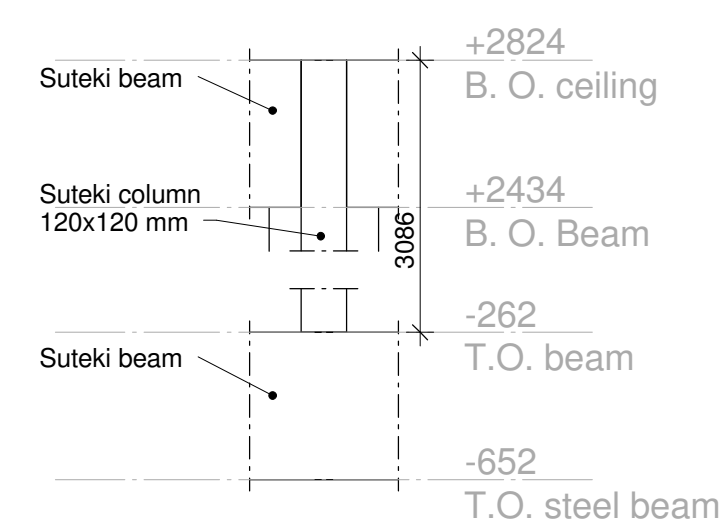

TYPE C DETAIL
1 : 20

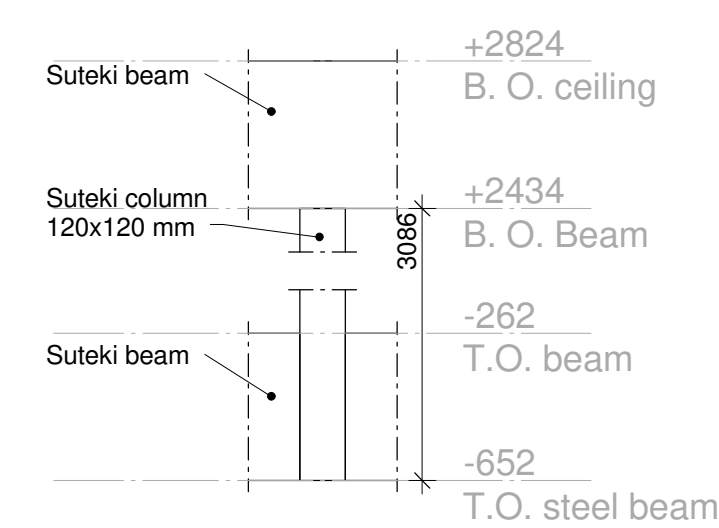


TYPE D DETAIL
1 : 20



TEAM NAME: Selficient
ADDRESS: Padualaan 99, 3584 CH Utrecht
CONTACT: info@selficient.org, www.selficient.org

CONSULTANTS:
ARCHITECTURE
ENGINEERS
LANDSCAPING
SAFETY FIRST CODE CONSULTANTS

CLIENT:
U.S. DEPARTMENT OF ENERGY
SOLAR DECATHLON 2017
WWW.SOLARDECATHLON.GOV




MARK	DATE	DESCRIPTION
0	17-11-2016	90% revision

LOT NUMBER: 106
DRAWN BY: SELFICIENT
CHECKED BY: Selficient
COPYRIGHT: NONE; PROJECT IS PUBLIC DOMAIN

SCALE: As indicated

SHEET TITLE:
SUTEKI COLUMNS PLAN

S-205

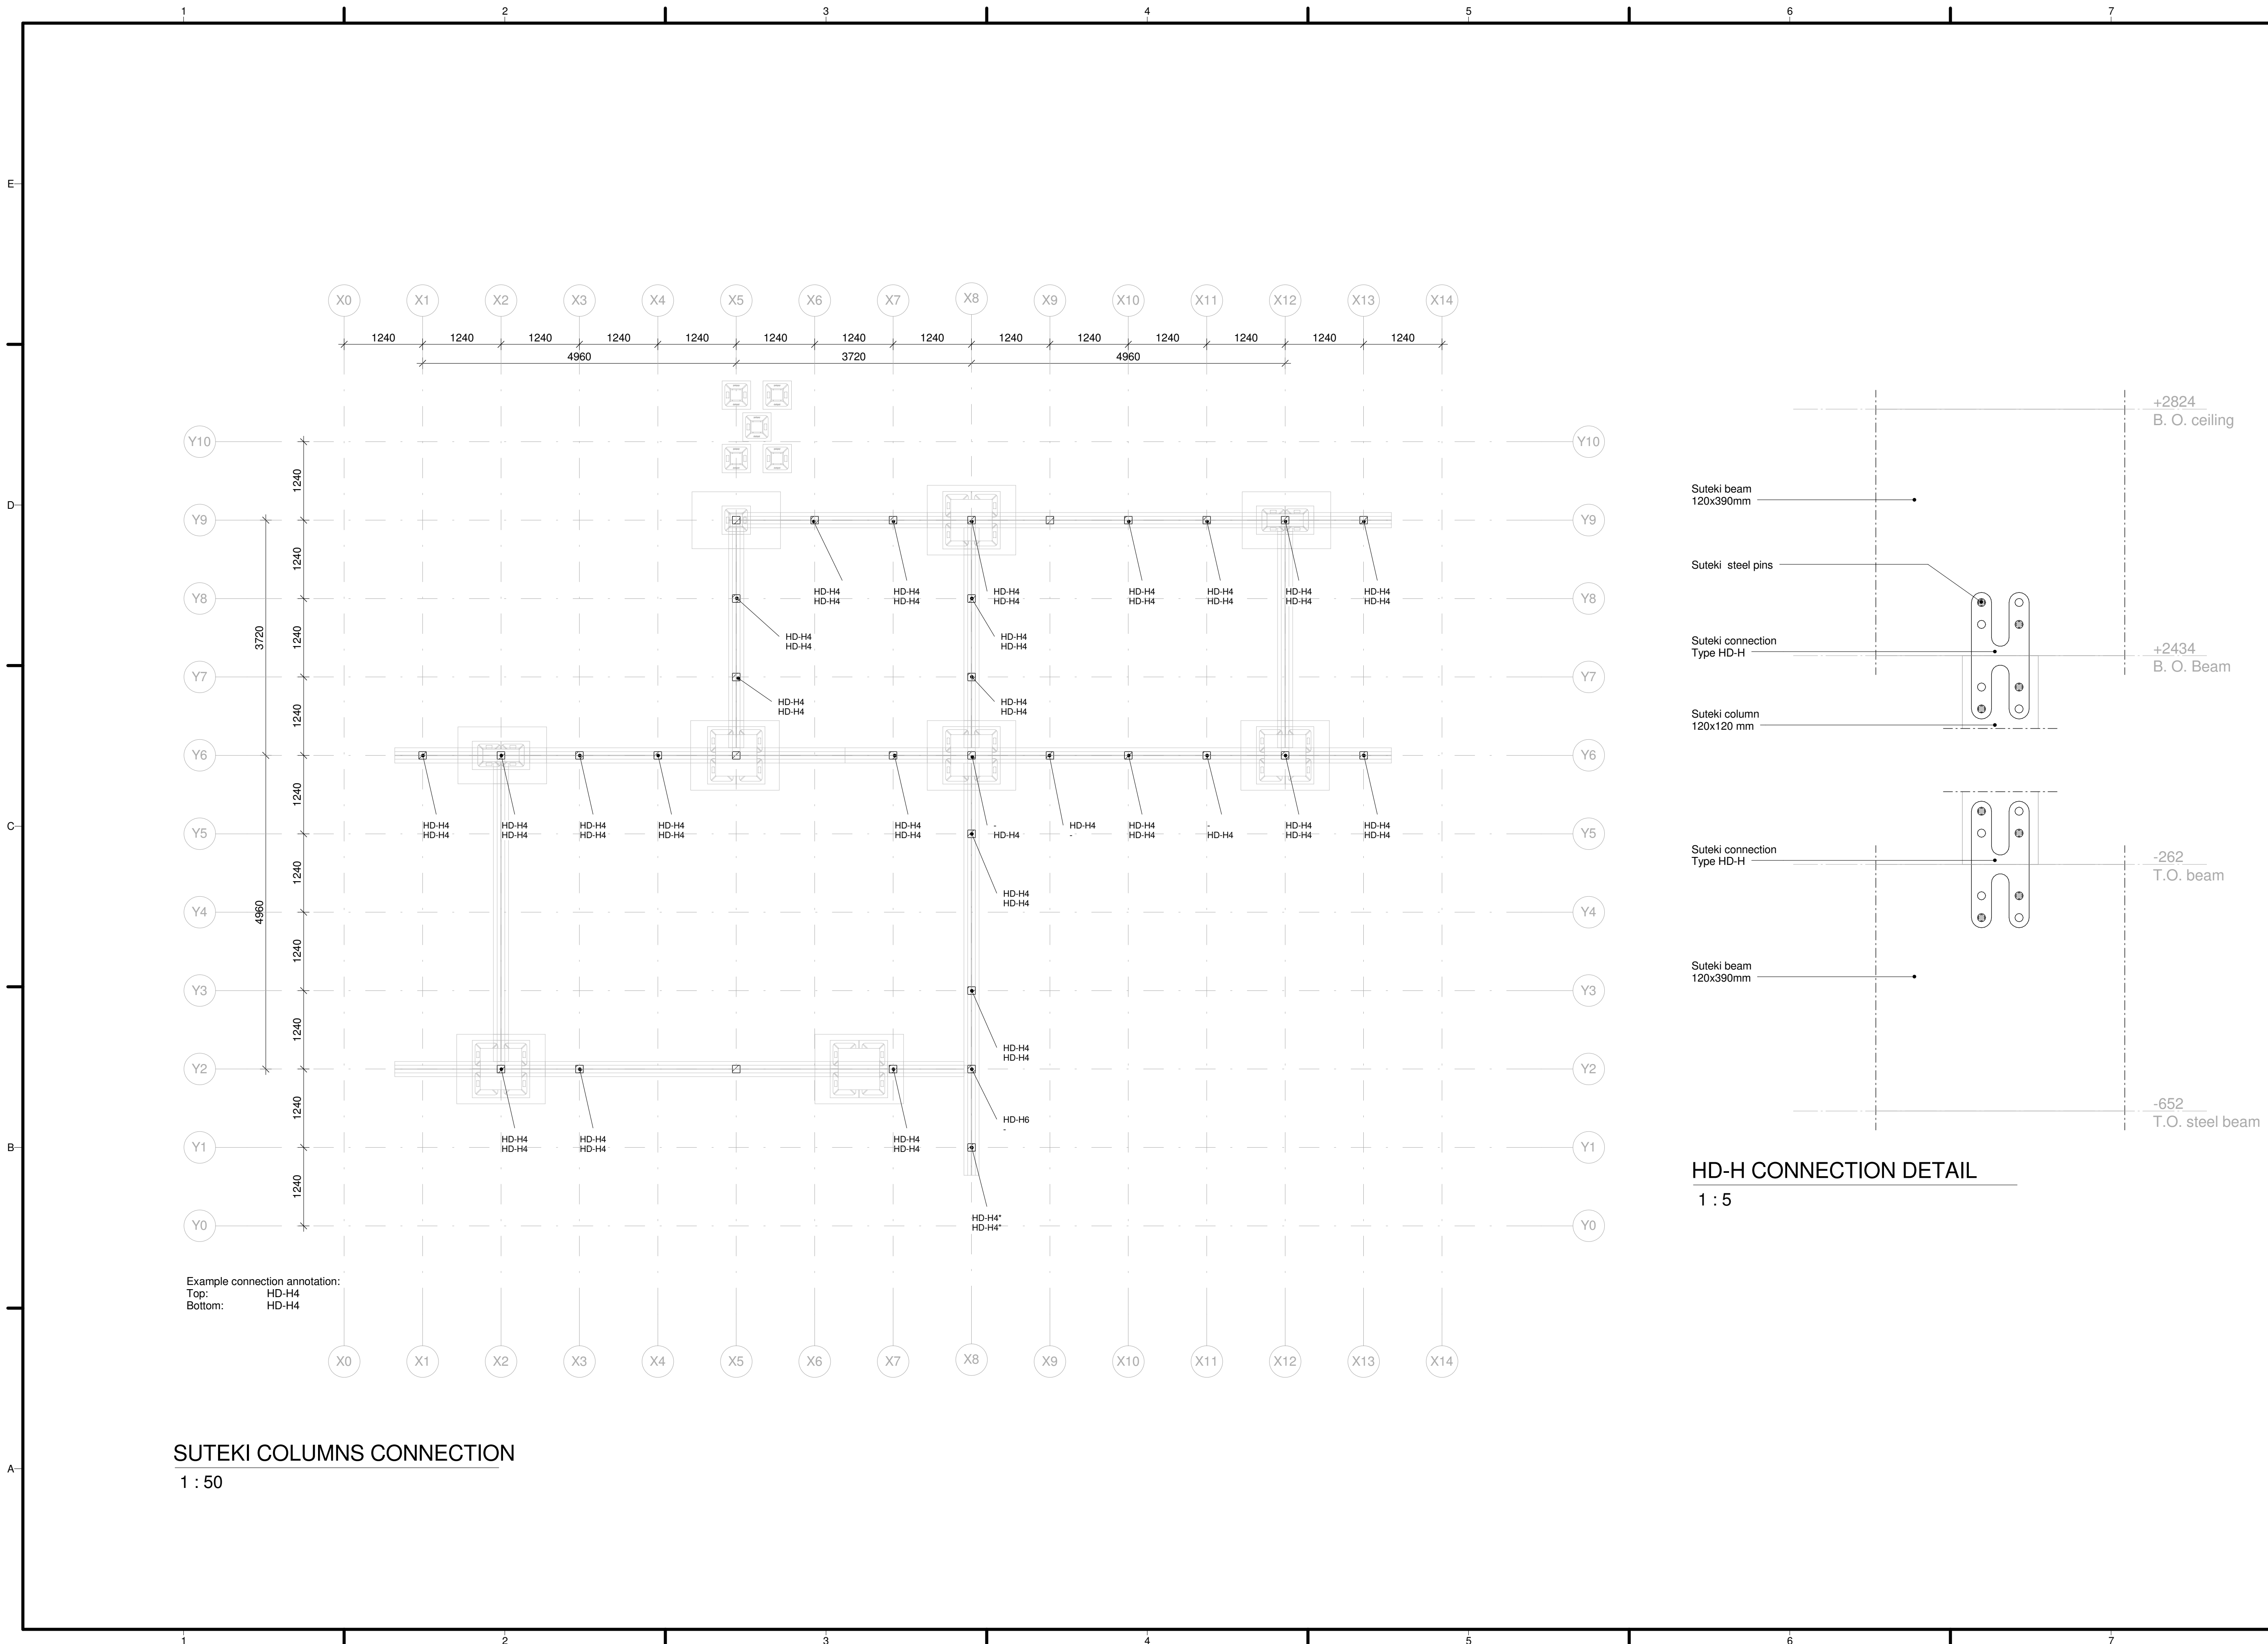

Example connection annotation:
 Top: HD-H4
 Bottom: HD-H4

SUTEKI COLUMNS CONNECTION
 1 : 50

HD-H CONNECTION DETAIL
 1 : 5



TEAM NAME: Selficient
 ADDRESS: Padualaan 99
 3584 CH Utrecht
 CONTACT: info@selficient.org
 www.selficient.org

CONSULTANTS
 ARCHITECTURE
 ENGINEERS
 LANDSCAPING
 SAFETY FIRST CODE CONSULTANTS

CLIENT
 U.S. DEPARTMENT OF ENERGY
 SOLAR DECATHLON 2017
 WWW.SOLARDECATHLON.GOV




MARK	DATE	DESCRIPTION
0	17-11-2016	90% revision


LOT NUMBER: 106
 DRAWN BY: Author
 CHECKED BY: Selficient
 COPYRIGHT: NONE; PROJECT IS PUBLIC DOMAIN
 SCALE: As indicated

SUTEKI COLUMNS CONNECTIONS

S-206

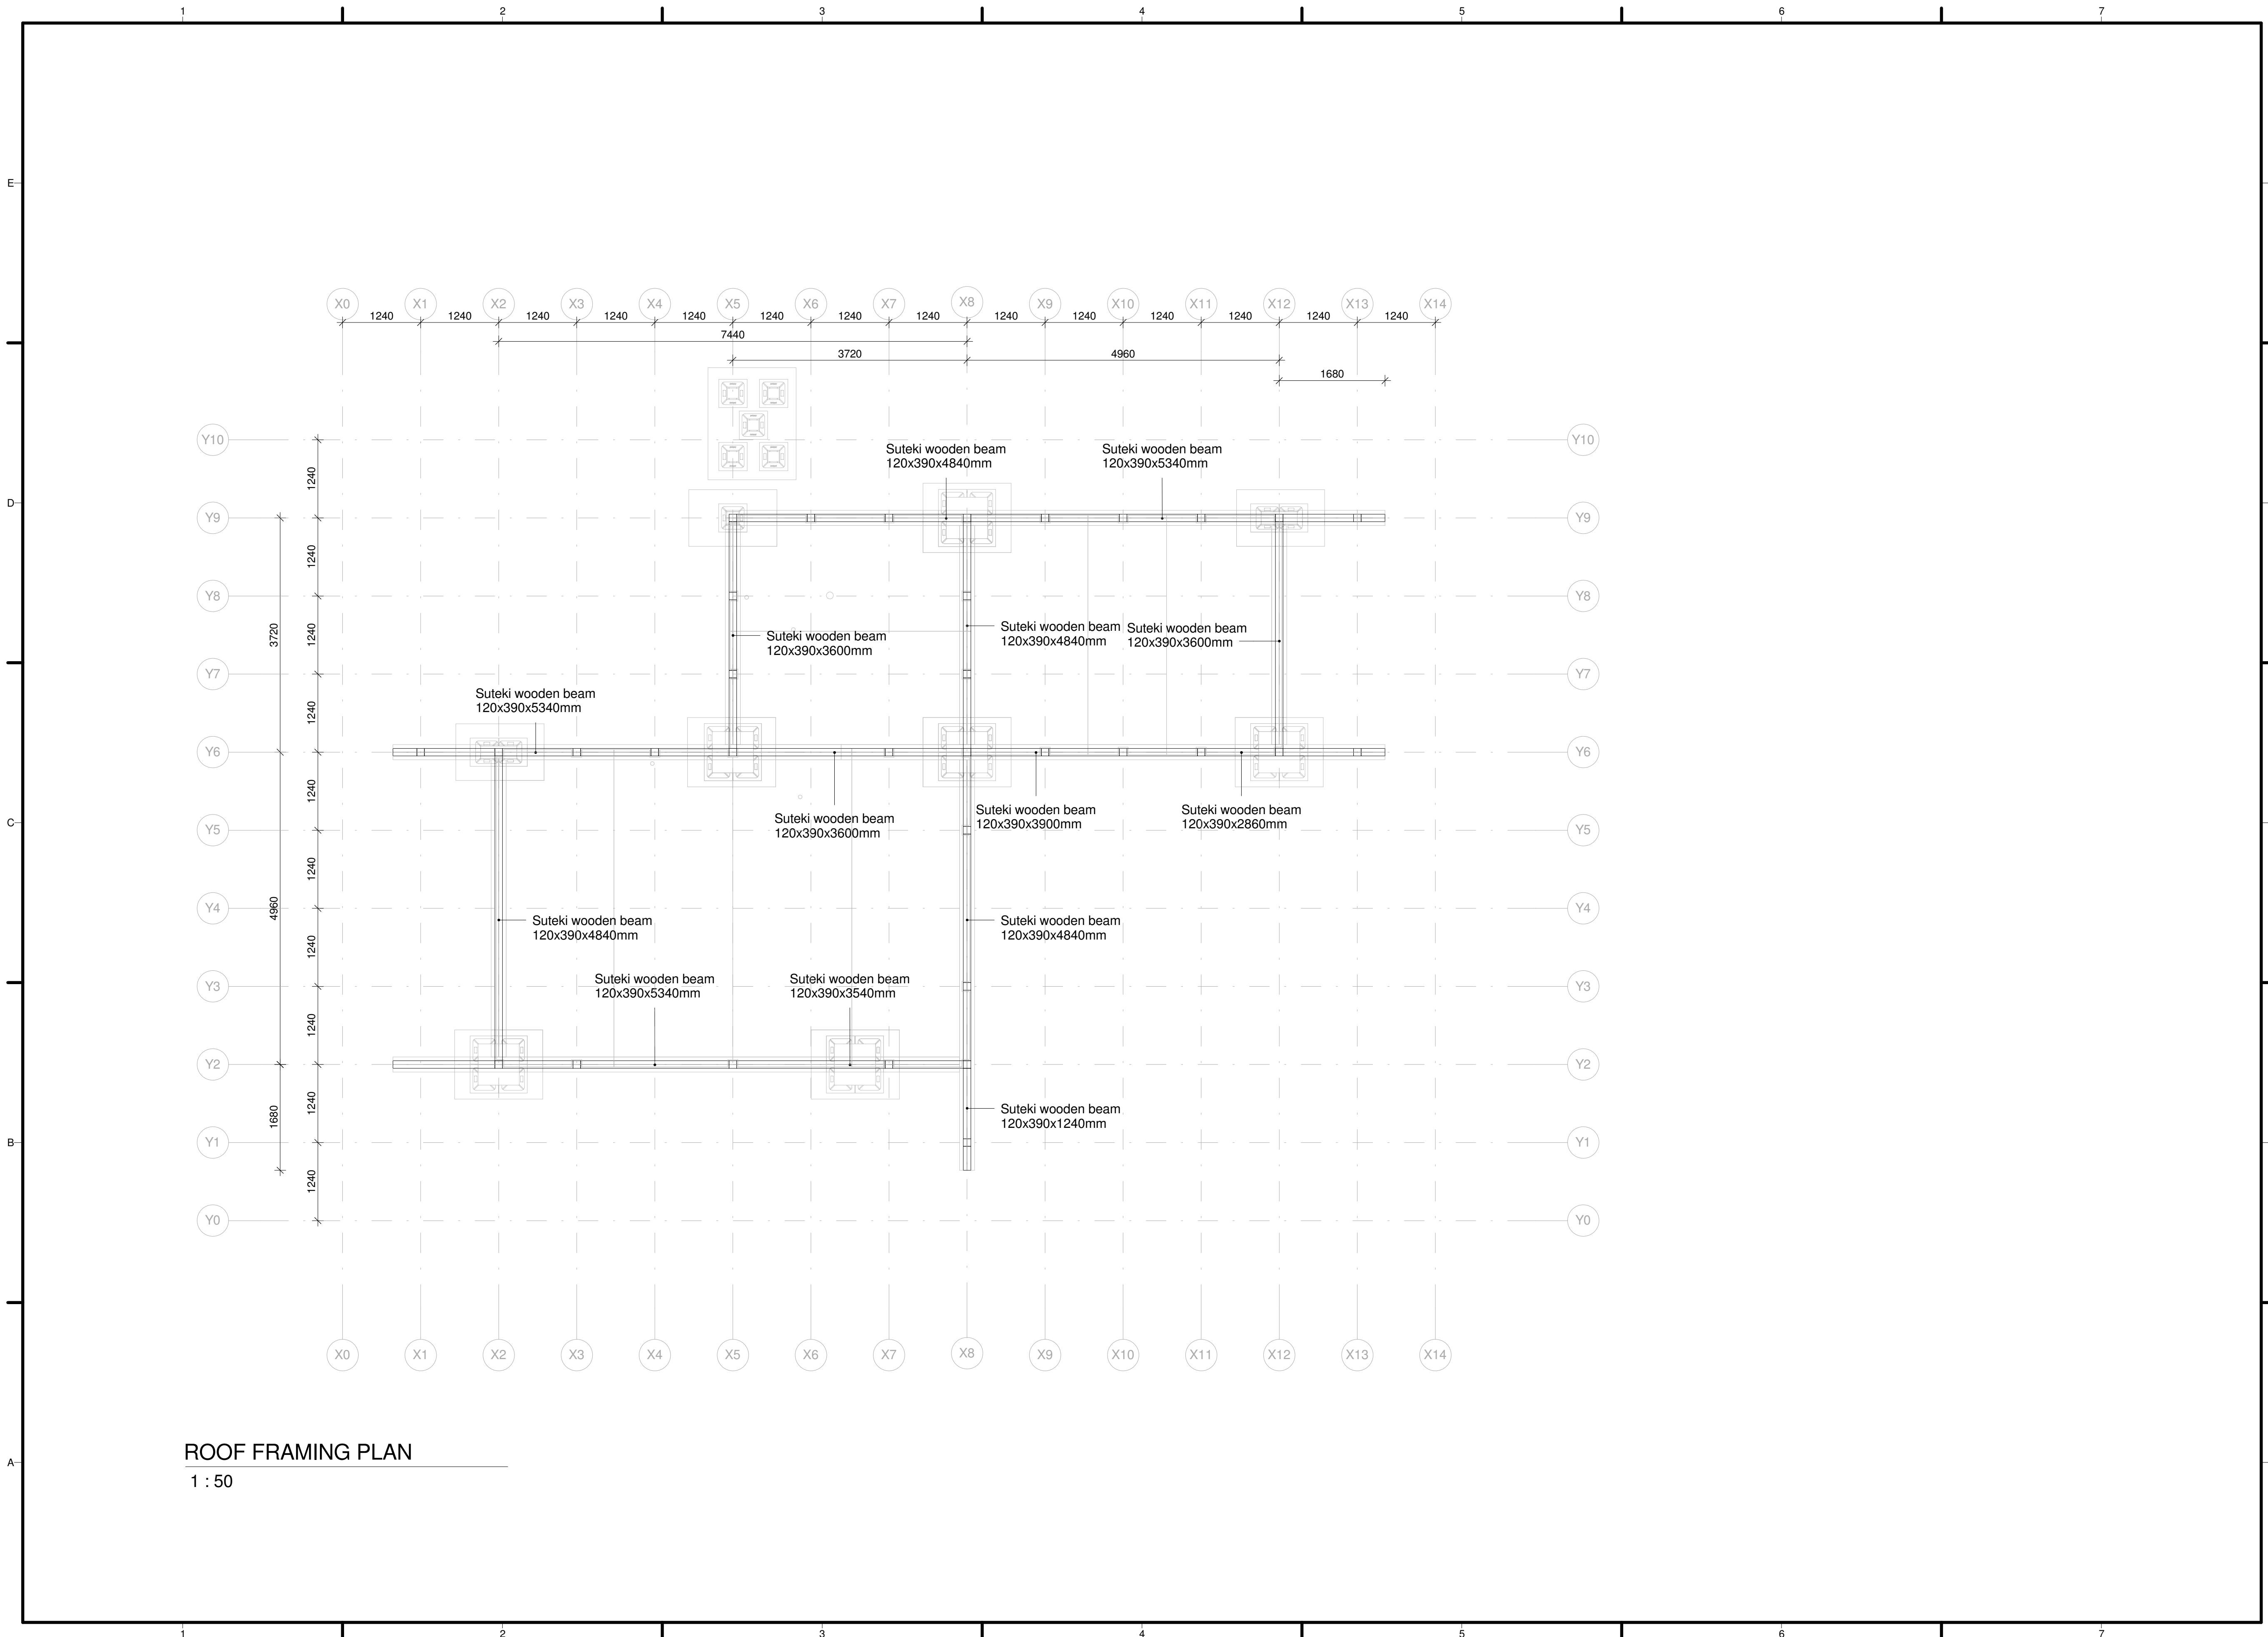


ROOF FRAMING PLAN
1 : 50



TEAM NAME: Selficient
ADDRESS: Padualaan 99, 3584 CH Utrecht
CONTACT: info@selficient.org, www.selficient.org

CONSULTANTS:
 ARCHITECTURE
 ENGINEERS
 LANDSCAPING
 SAFETY FIRST CODE CONSULTANTS

CLIENT:
 U.S. DEPARTMENT OF ENERGY
 SOLAR DECATHLON 2017
 WWW.SOLARDECATHLON.GOV



MARK	DATE	DESCRIPTION
0	17-11-2016	90% revision

LOT NUMBER: 106
DRAWN BY: SELFICIENT
CHECKED BY: Selficient
COPYRIGHT: NONE; PROJECT IS PUBLIC DOMAIN

SCALE: 1 : 50

SHEET TITLE:
 ROOF FRAMING PLAN

S-207

TEAM NAME: Selficient
 ADDRESS: Padualaan 99
 3584 CH Utrecht
 CONTACT: info@selficient.org
 www.selficient.org

CONSULTANTS
 ARCHITECTURE
 ENGINEERS
 LANDSCAPING
 SAFETY FIRST CODE CONSULTANTS

CLIENT
 U.S. DEPARTMENT OF ENERGY
 SOLAR DECATHLON 2017
 WWW.SOLARDECATHLON.GOV



0 17-11-2016 90% revision

MARK	DATE	DESCRIPTION
------	------	-------------


LOT NUMBER: 106
 DRAWN BY: SELFICIENT
 CHECKED BY: Selficient
 COPYRIGHT: NONE; PROJECT IS PUBLIC DOMAIN

SCALE: As indicated


SHEET TITLE

ROOF FRAMING SUTEKI CONNECTIONS PLAN


S-208

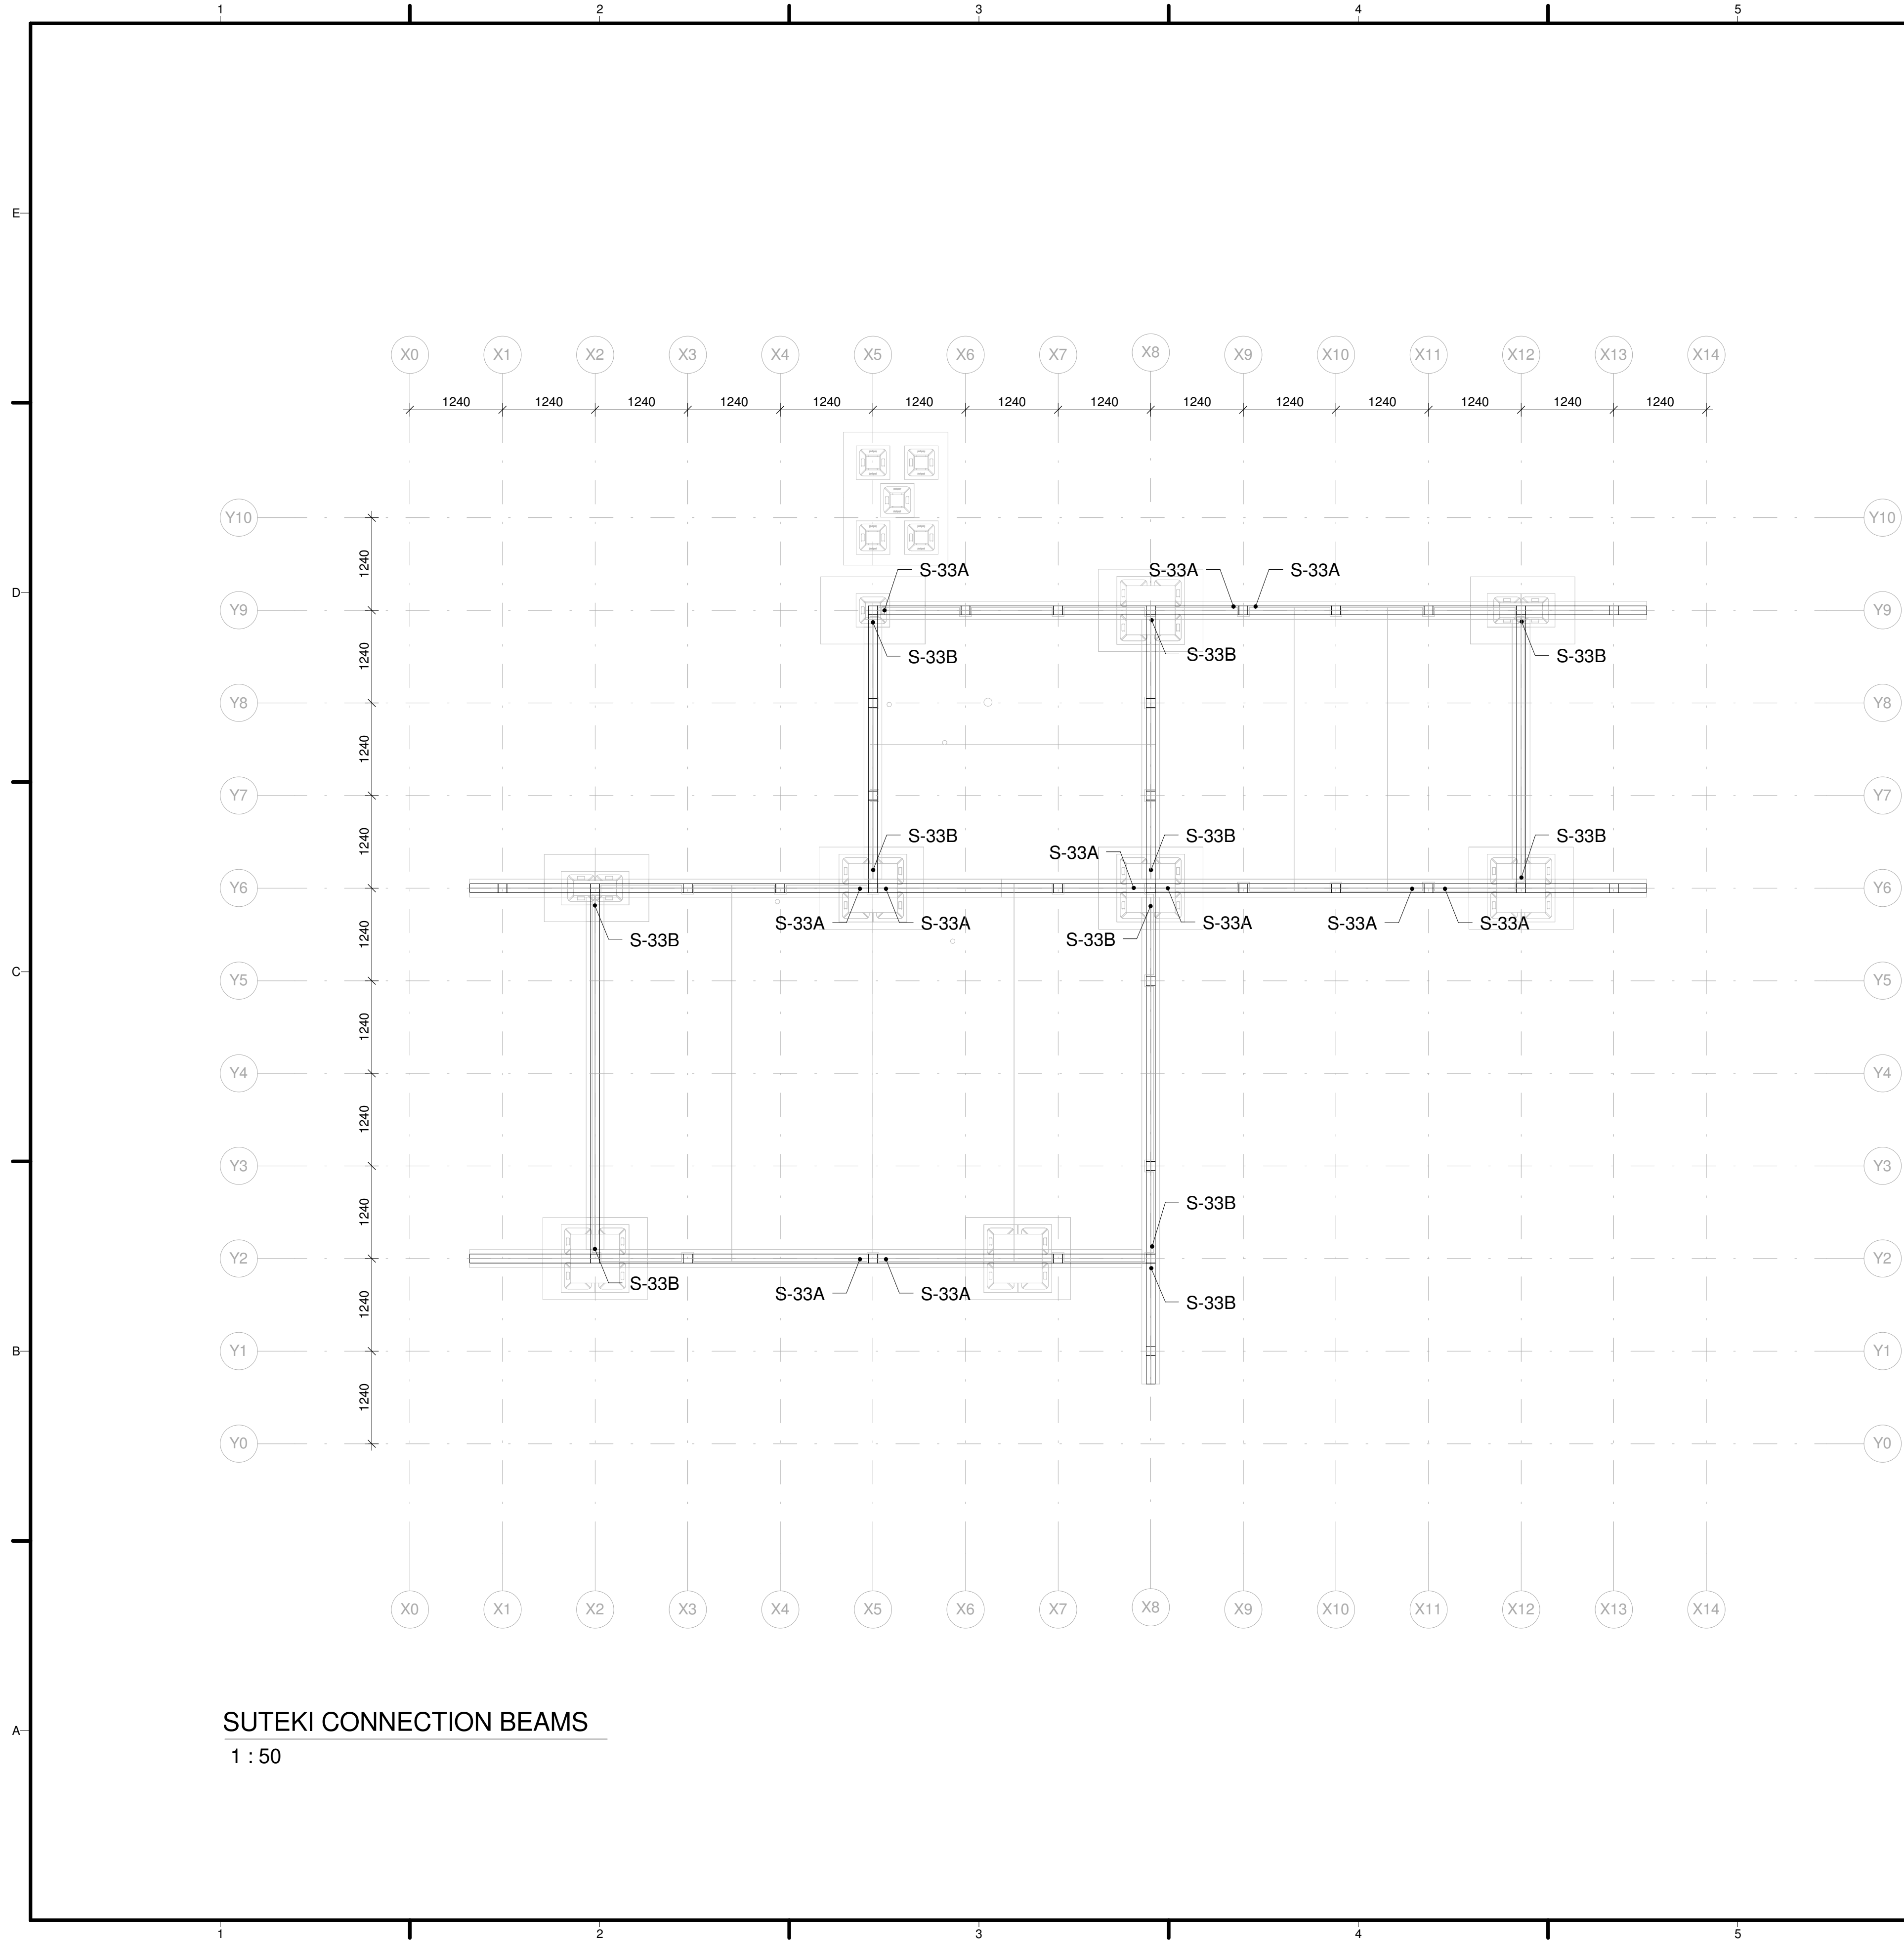


SUTEKI CONNECTION BEAMS
 1 : 50

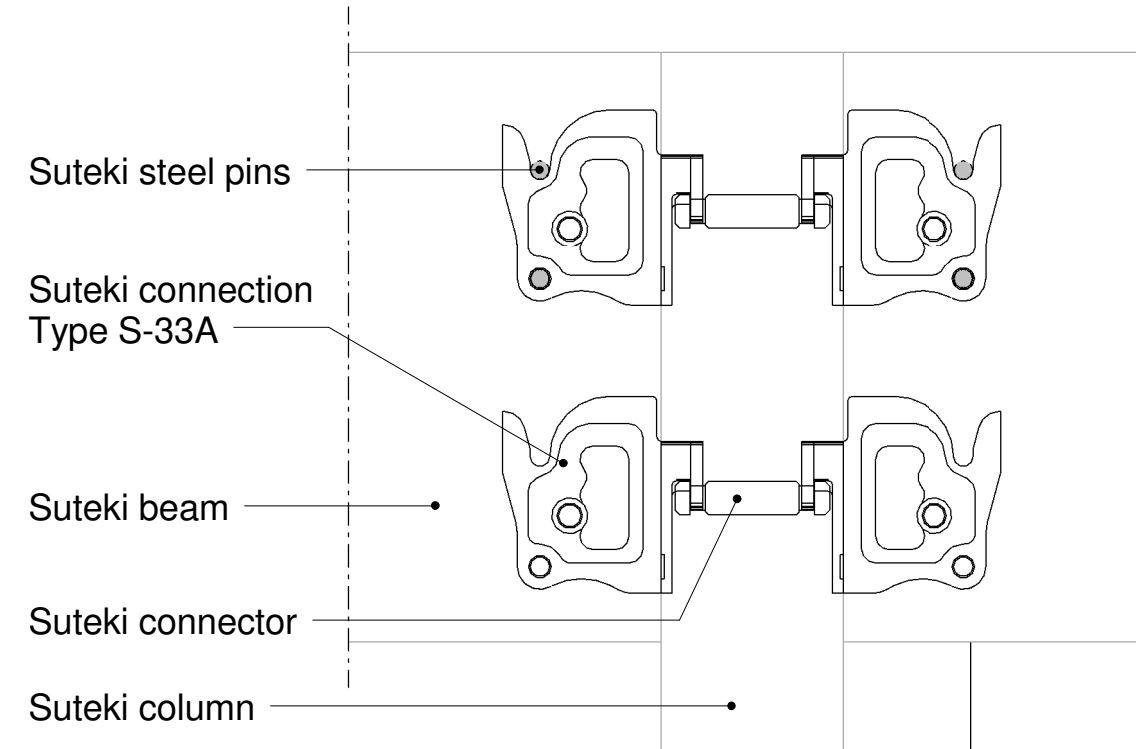

SUTEKI CONNECTOR TYPE S-33A
 1 : 5

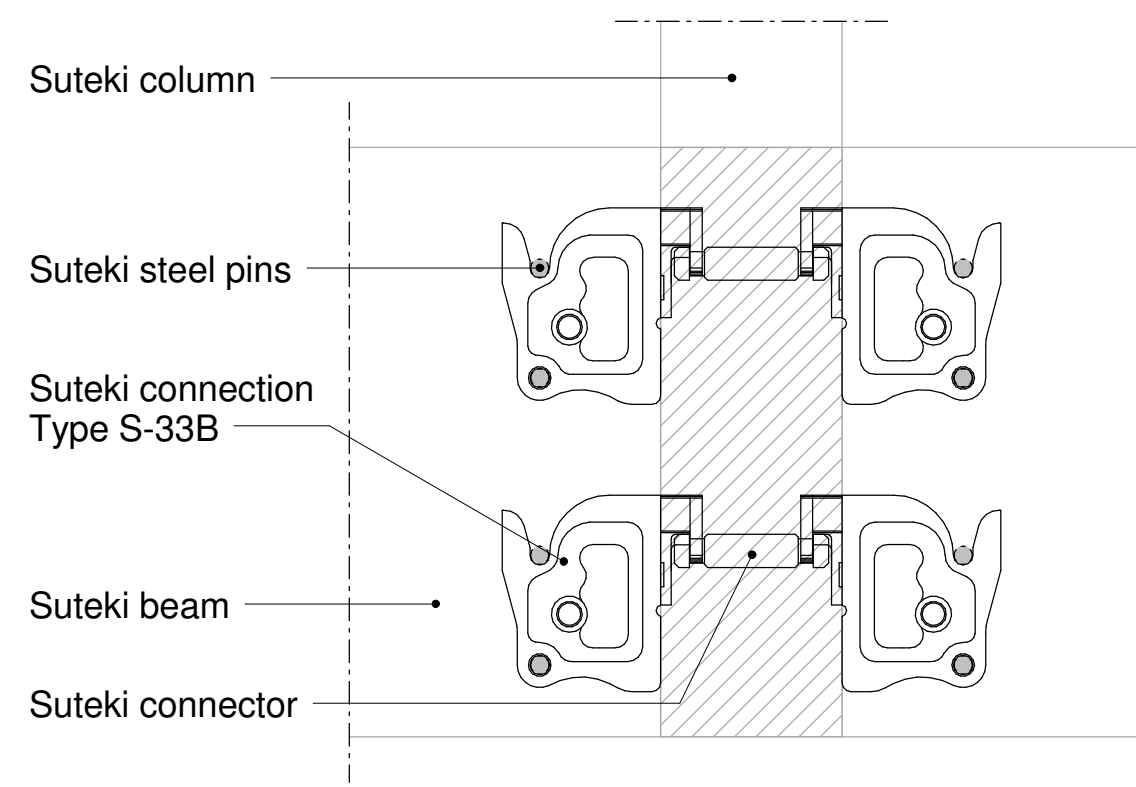

SUTEKI CONNECTOR TYPE S-33B
 1 : 5

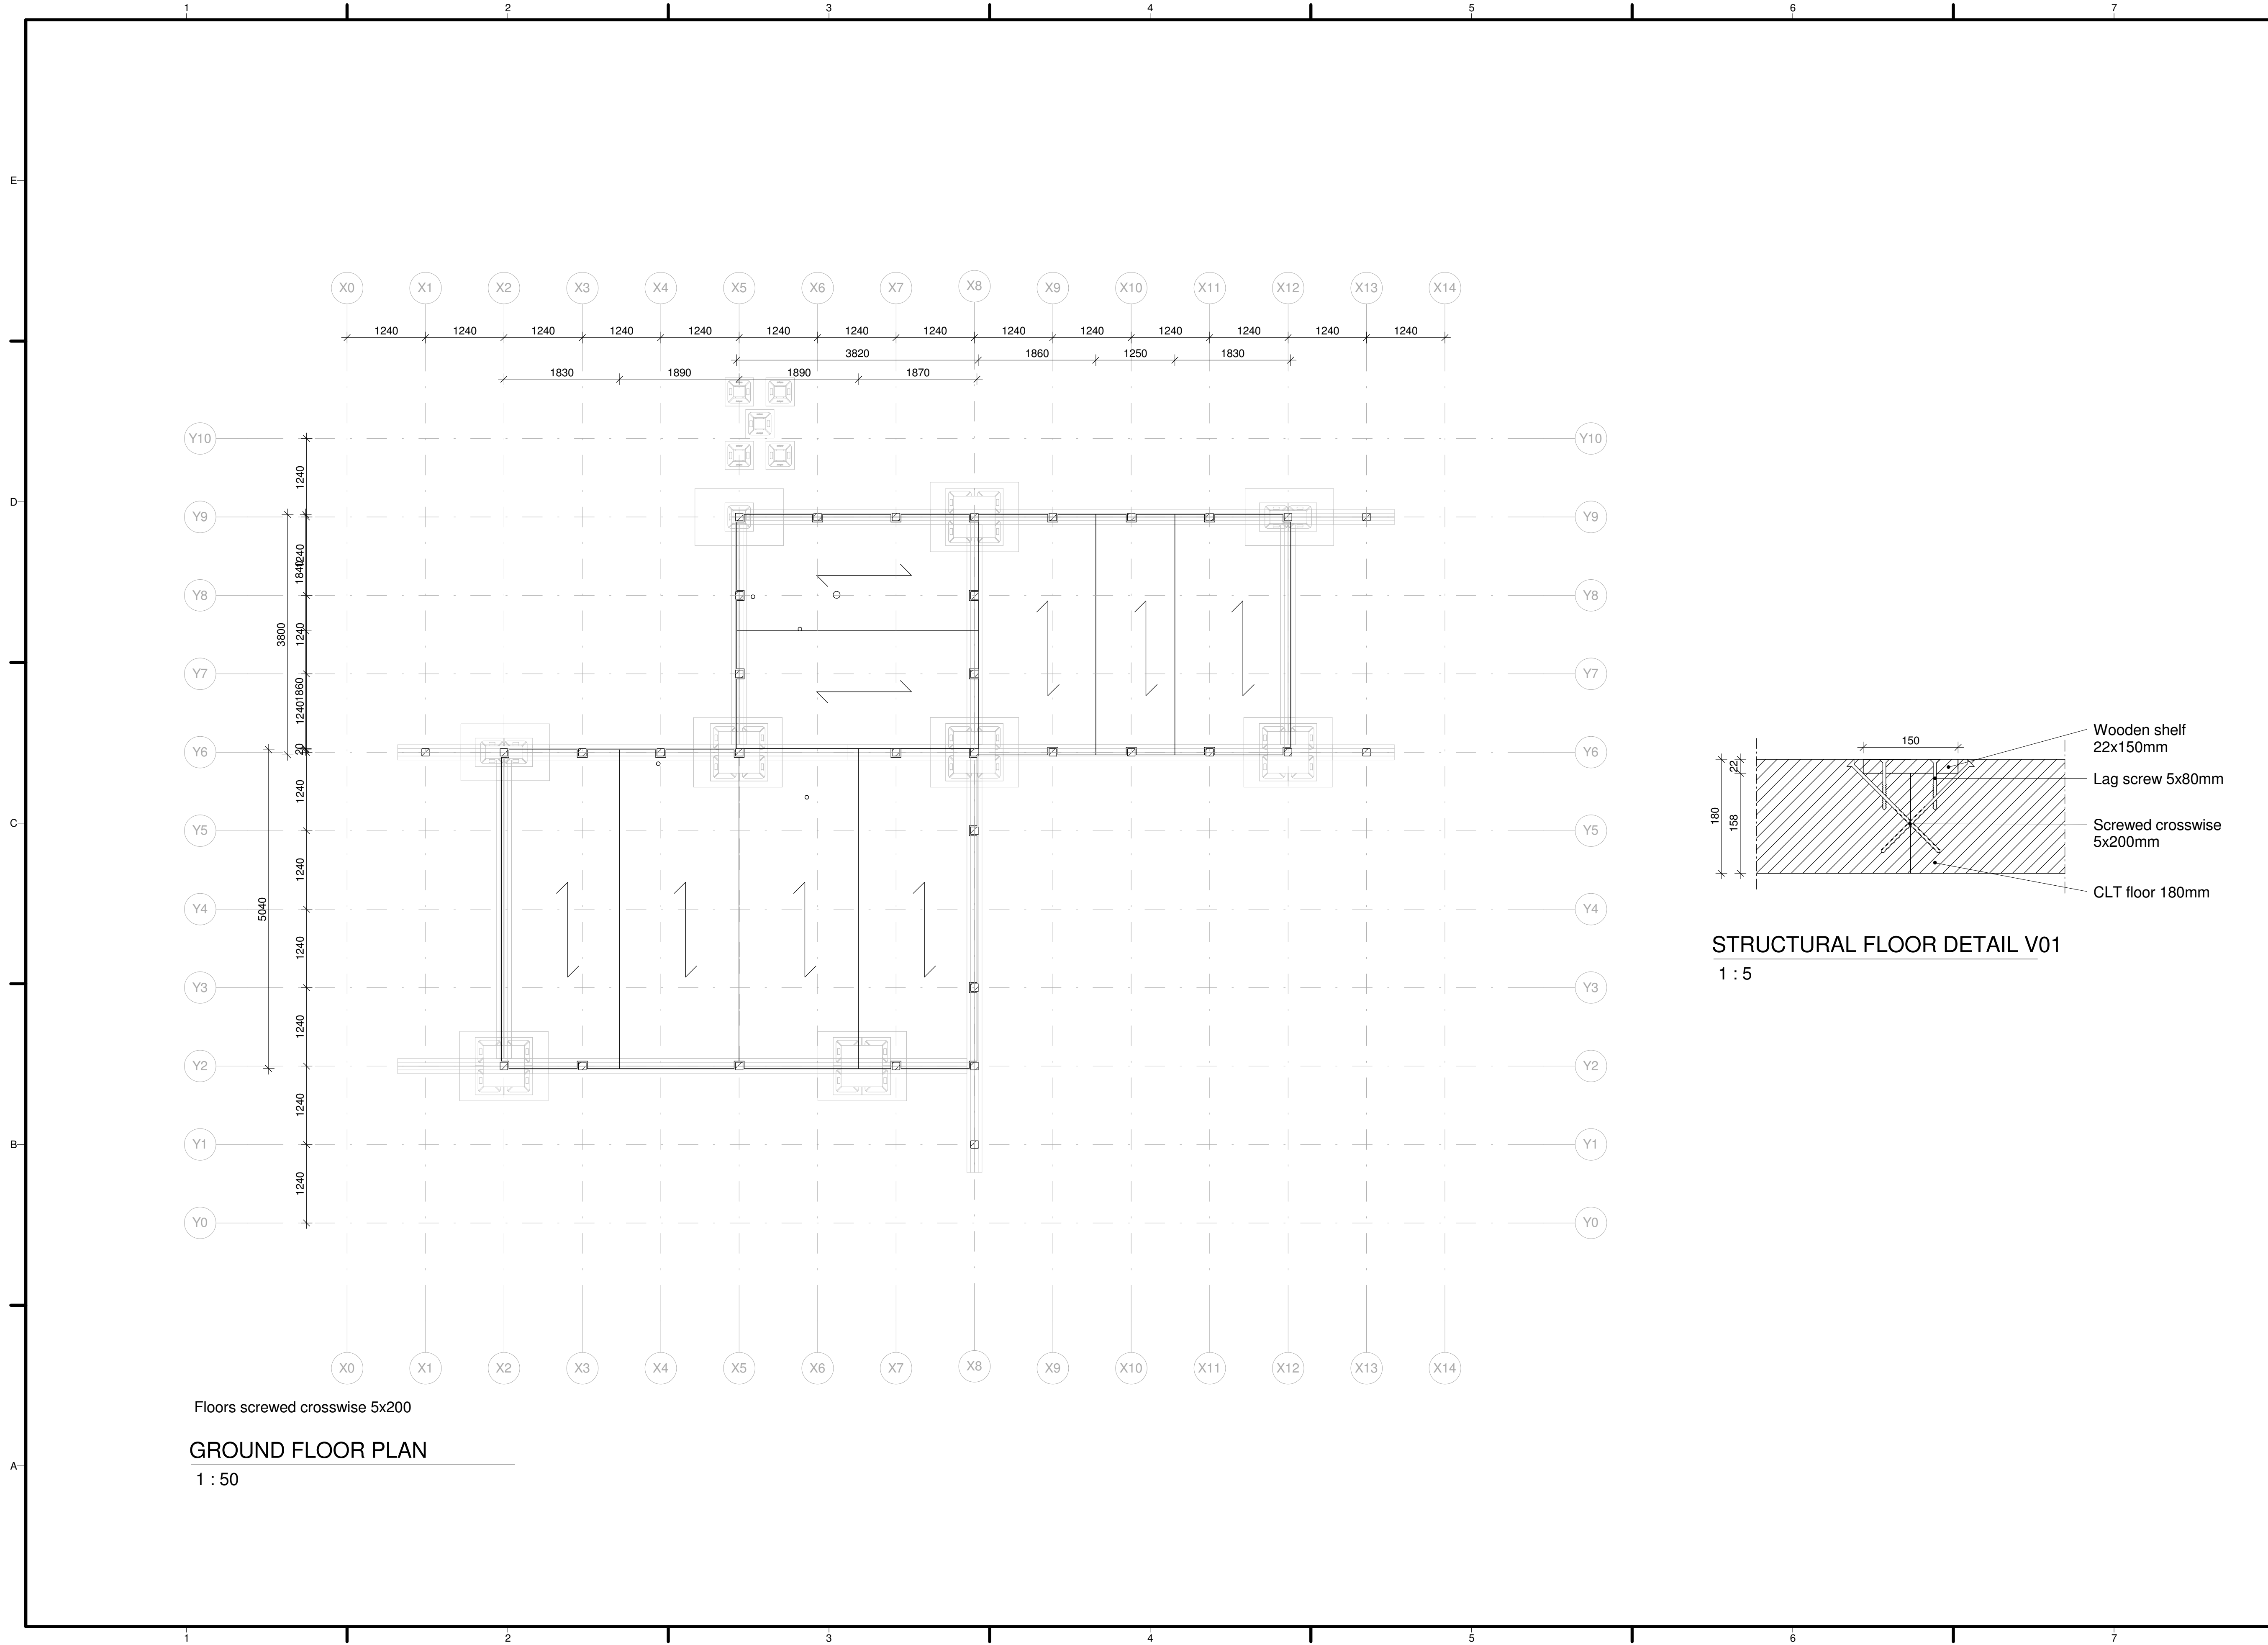

TEAM NAME: Selficient
 ADDRESS: Padualaan 99
 3584 CH Utrecht
 CONTACT: info@selficient.org
 www.selficient.org

CONSULTANTS
 ARCHITECTURE
 ENGINEERS
 LANDSCAPING
 SAFETY FIRST CODE CONSULTANTS



CLIENT
 U.S. DEPARTMENT OF ENERGY
 SOLAR DECATHLON 2017
 WWW.SOLARDECATHLON.GOV




MARK	DATE	DESCRIPTION
0	17-11-2016	90% revision

LOT NUMBER: 106
 DRAWN BY: SELFICIENT
 CHECKED BY: Selficient
 COPYRIGHT: NONE; PROJECT IS PUBLIC DOMAIN
 SCALE: As indicated

SHEET TITLE
GROUND FLOOR PLAN

S-209

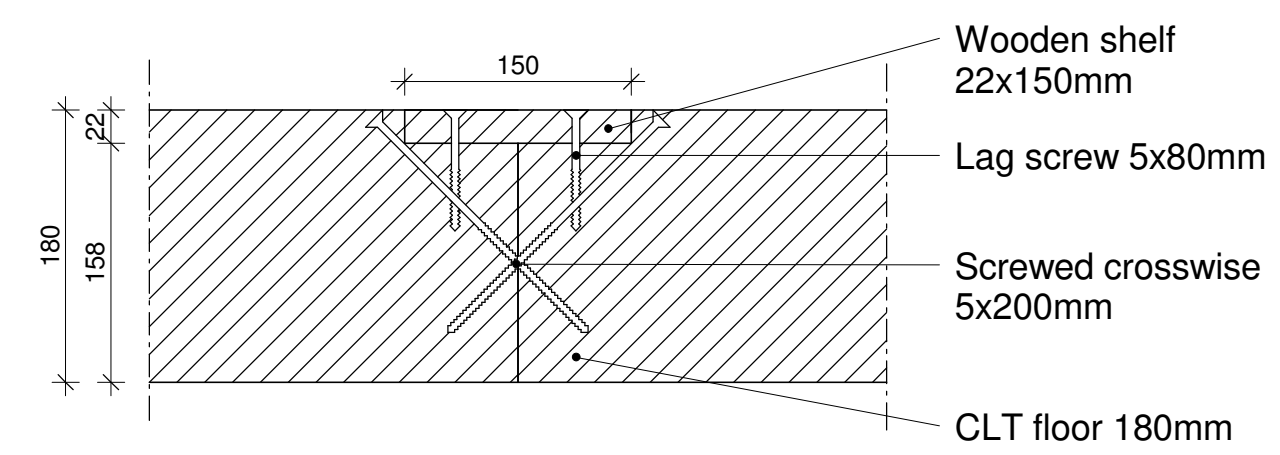

STRUCTURAL FLOOR DETAIL V01
 1 : 5

Floors screwed crosswise 5x200
GROUND FLOOR PLAN
 1 : 50

TEAM NAME: Selficient
 ADDRESS: Padualaan 99
 3584 CH Utrecht
 CONTACT: info@selficient.org
 www.selficient.org

CONSULTANTS
 ARCHITECTURE
 ENGINEERS
 LANDSCAPING
 SAFETY FIRST CODE CONSULTANTS

CLIENT
 U.S. DEPARTMENT OF ENERGY
 SOLAR DECATHLON 2017
 WWW.SOLARDECATHLON.GOV





0	17-11-2016	90% revision
---	------------	--------------

MARK	DATE	DESCRIPTION

LOT NUMBER: 106
 DRAWN BY: SELFICIENT
 CHECKED BY: Selficient
 COPYRIGHT: NONE; PROJECT IS PUBLIC DOMAIN
 SCALE: As indicated

SHEET TITLE
ROOF FLOOR PLAN

S-210

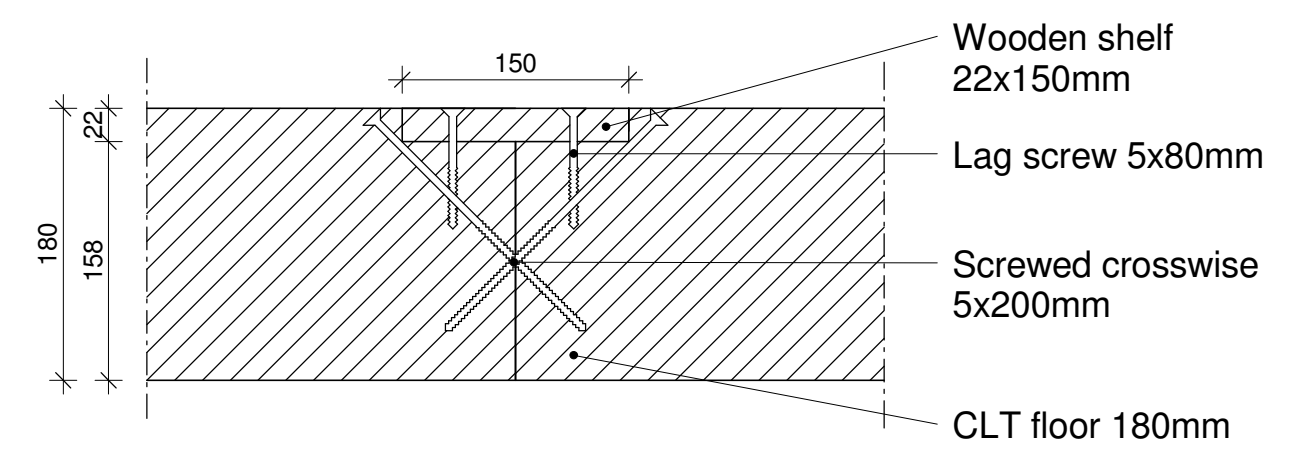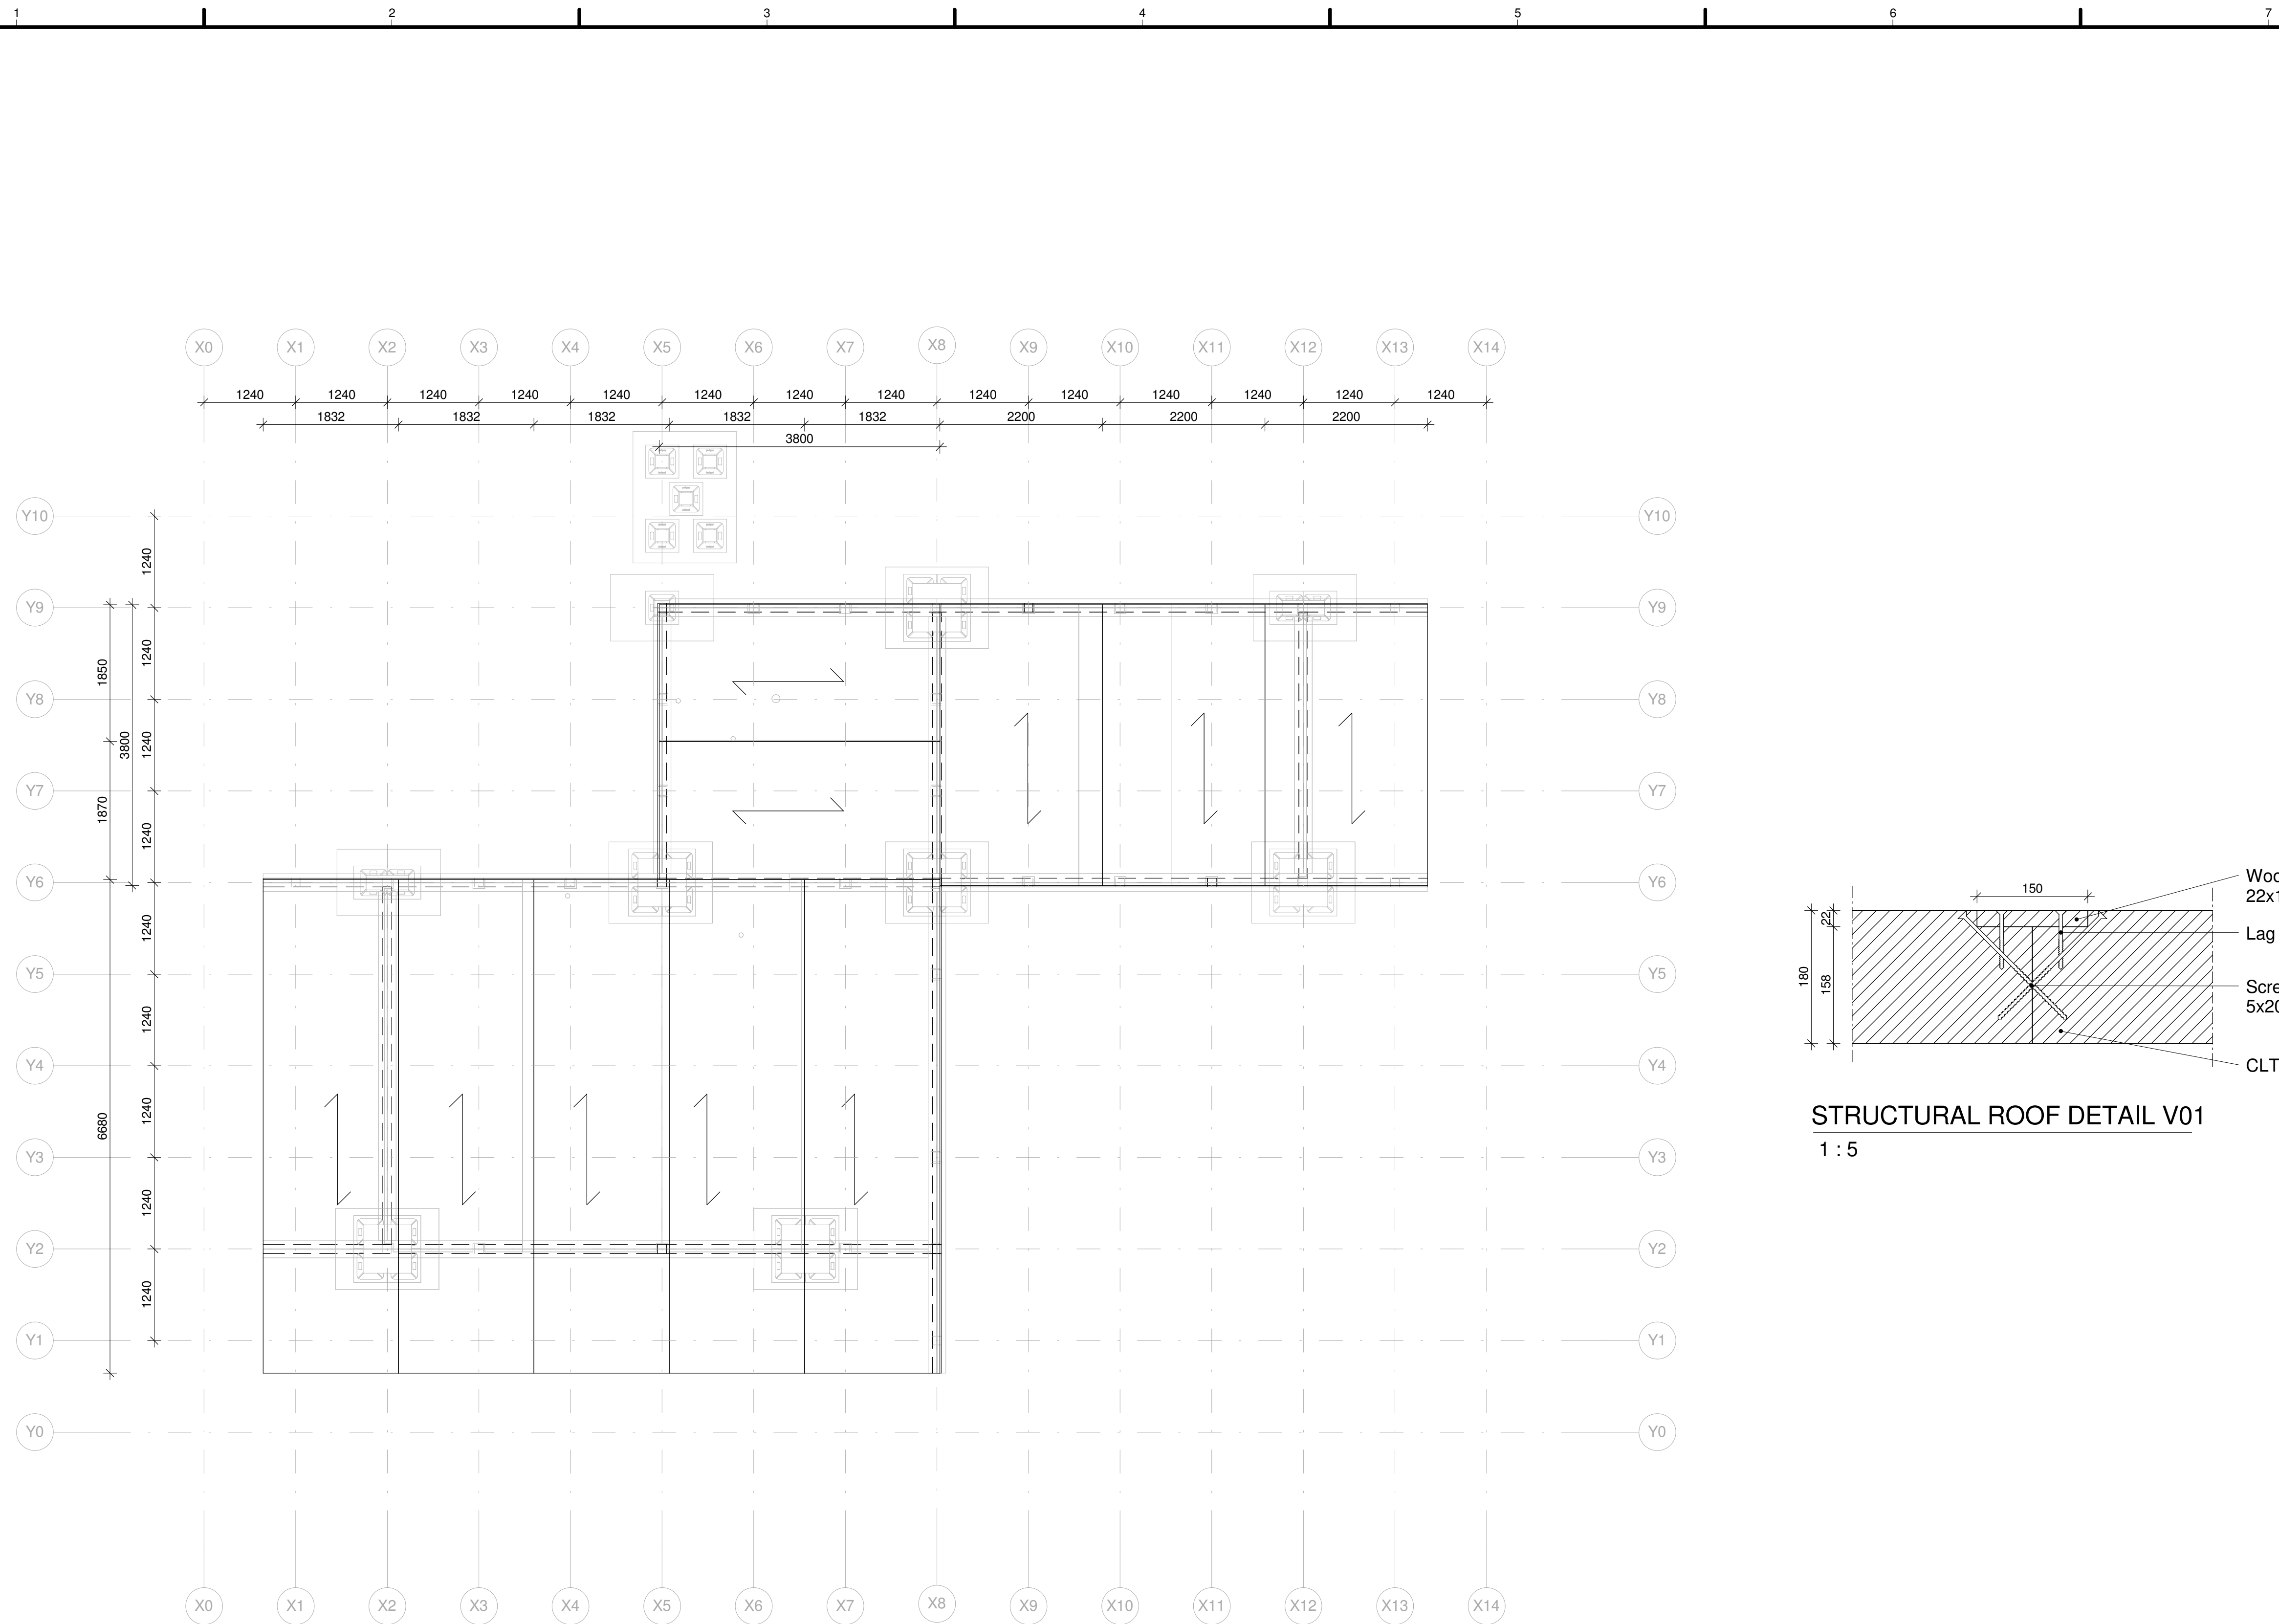

STRUCTURAL ROOF DETAIL V01
 1 : 5

Floors screwed crosswise 5x200
ROOF FLOOR PLAN
 1 : 50

1 2 3 4 5 6 7


E

D

C

B

A

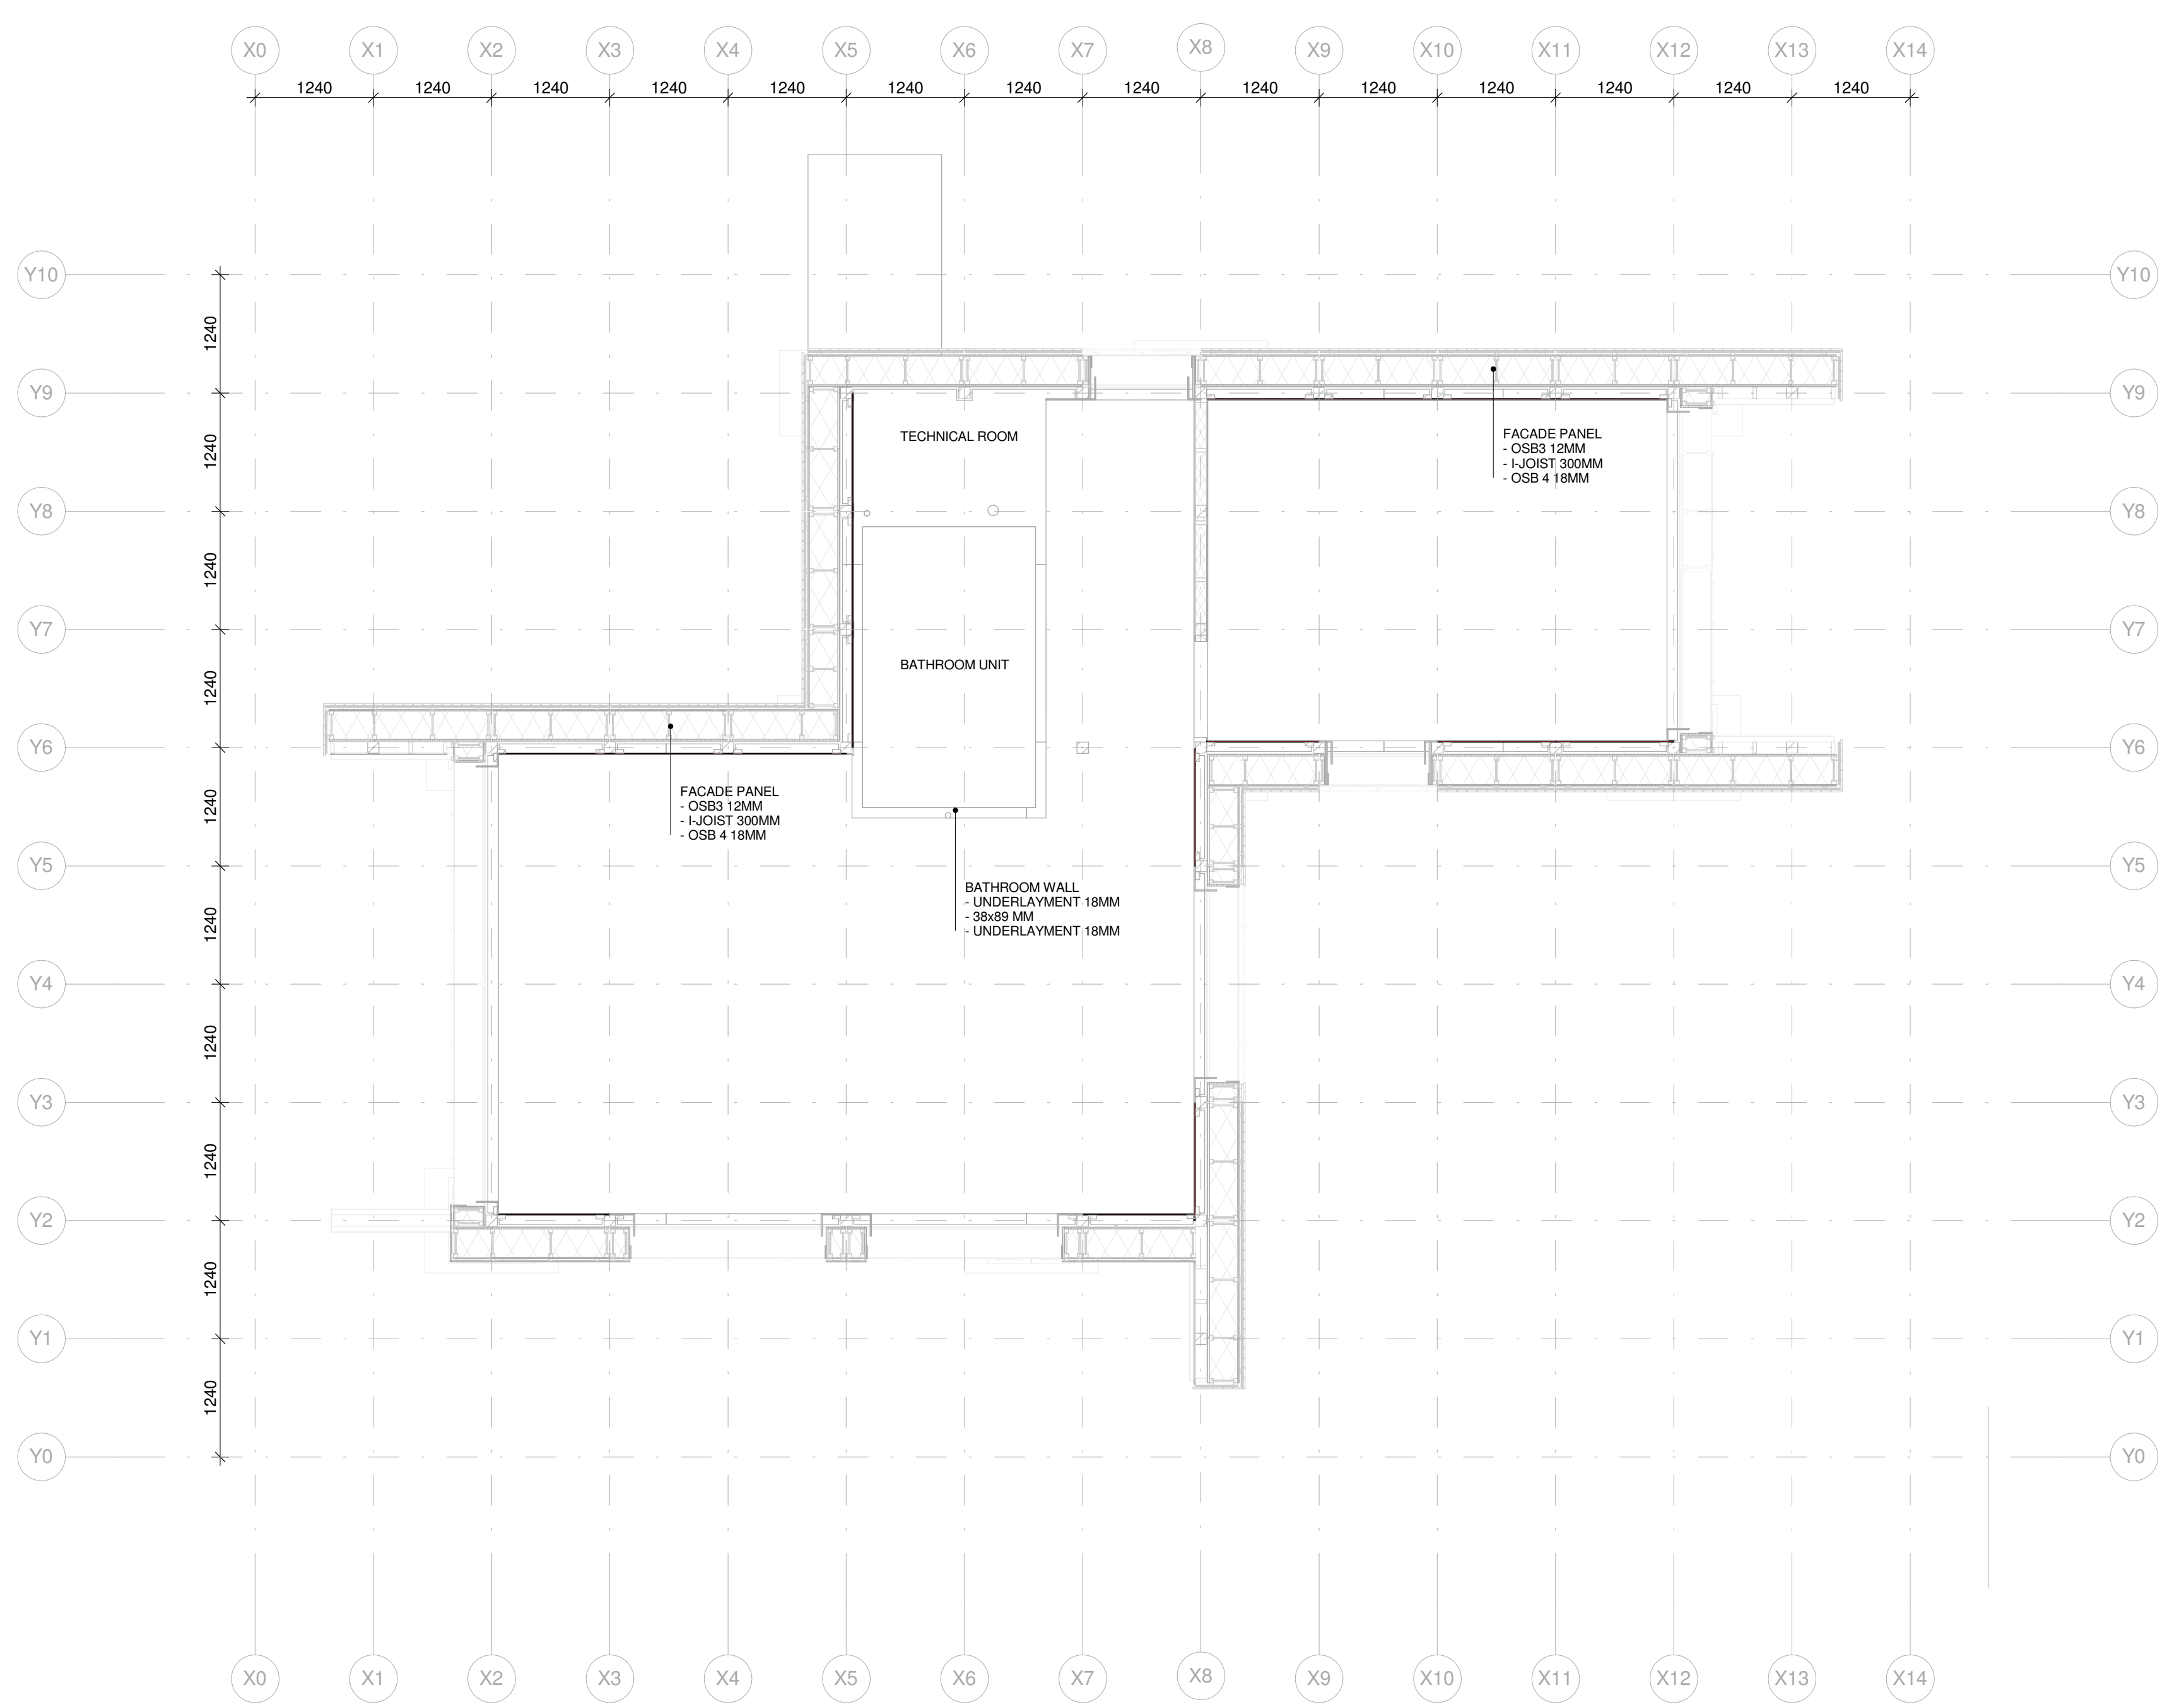

With the plywood (12 mm) inner walls the stability of the structure is maintained. These walls provide the connection between the Suteki columns.


WALL FRAMING PLAN
1 : 50

1 2 3 4 5 6 7



TEAM NAME: Selficient
ADDRESS: Padualaan 99
3584 CH Utrecht
CONTACT: info@selficient.org
www.selficient.org

CONSULTANTS
ARCHITECTURE
ENGINEERS
LANDSCAPING
SAFETY FIRST CODE CONSULTANTS

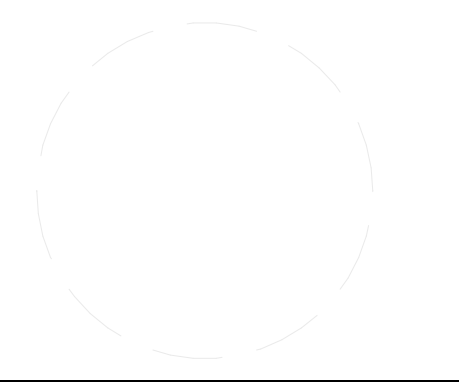

CLIENT
U.S. DEPARTMENT OF ENERGY
SOLAR DECATHLON 2017
WWW.SOLARDECATHLON.GOV




MARK	DATE	DESCRIPTION
0	17-11-2016	90% revision

LOT NUMBER: 106
DRAWN BY: SELFICIENT
CHECKED BY: Selficient
COPYRIGHT: NONE; PROJECT IS PUBLIC DOMAIN
SCALE: 1 : 50

SHEET TITLE
WALL FRAMING PLAN

S-211

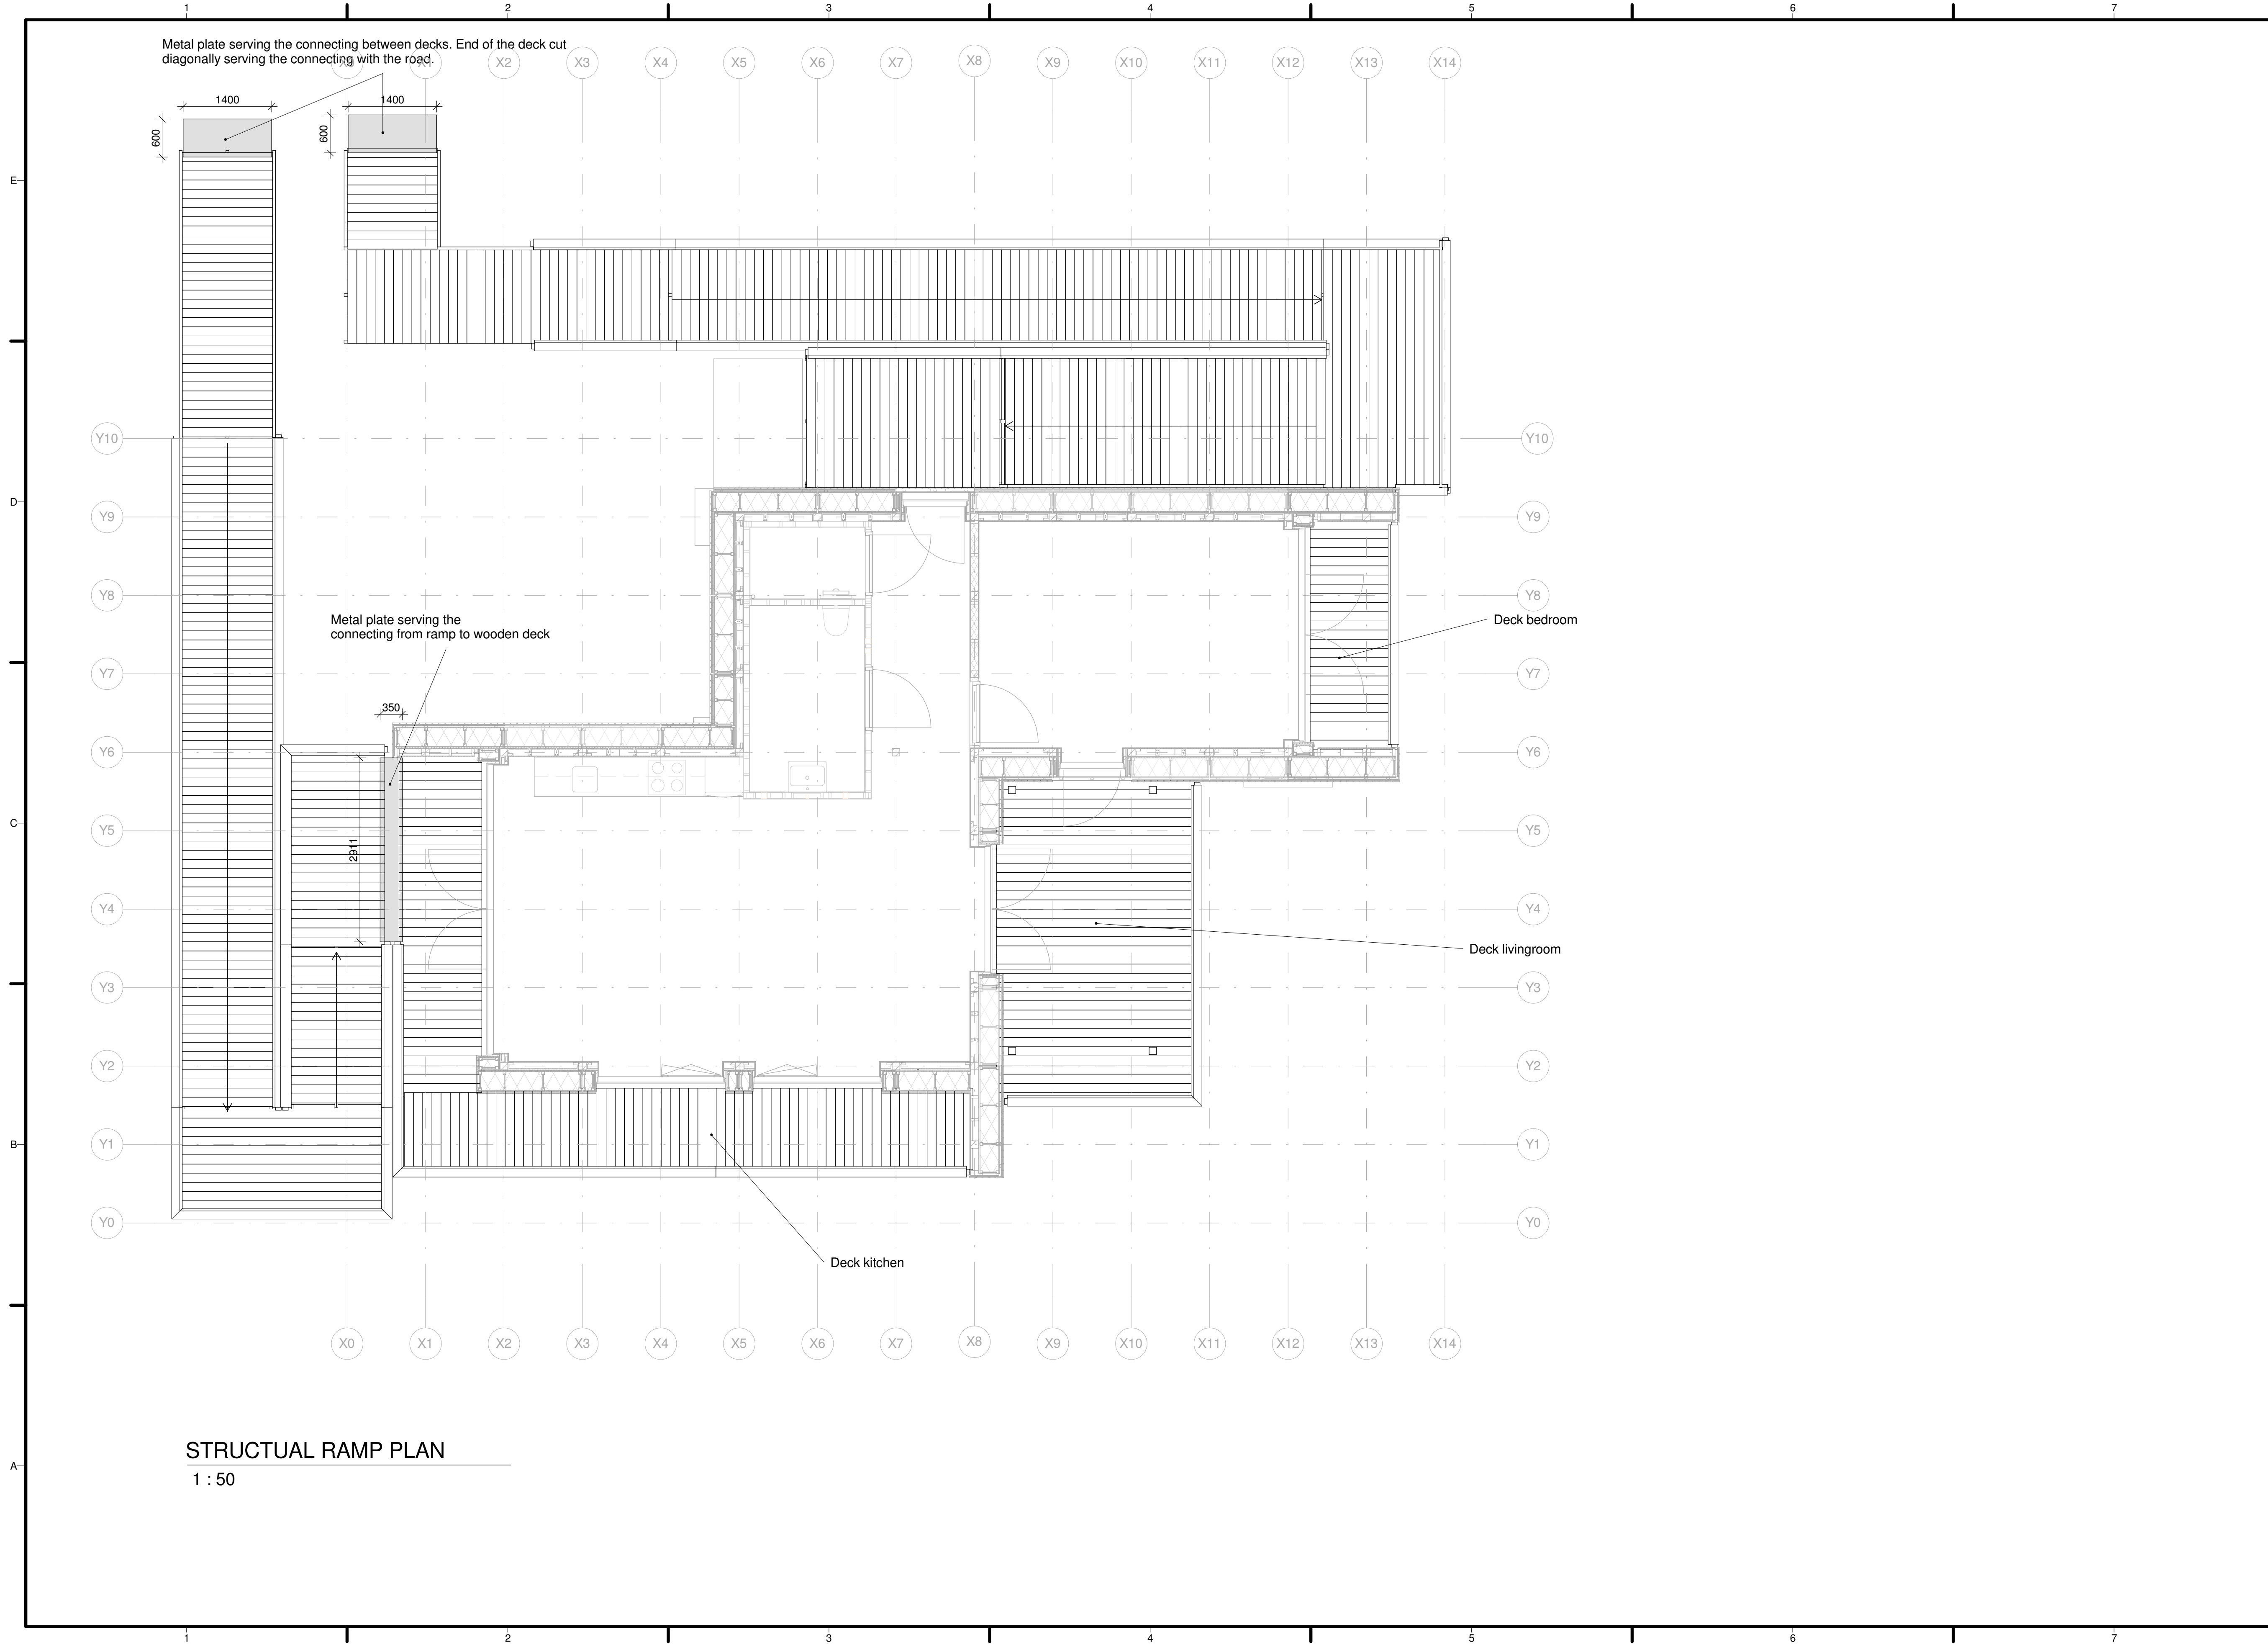

STRUCTURAL RAMP PLAN
1 : 50



TEAM NAME: Selficient
 ADDRESS: Padualaan 99
 3584 CH Utrecht
 CONTACT: info@selficient.org
 www.selficient.org

CONSULTANTS
 ARCHITECTURE
 ENGINEERS
 LANDSCAPING
 SAFETY FIRST CODE CONSULTANTS

CLIENT
 U.S. DEPARTMENT OF ENERGY
 SOLAR DECATHLON 2017
 WWW.SOLARDECATHLON.GOV



0	17-11-2016	90% revision
---	------------	--------------

MARK	DATE	DESCRIPTION
------	------	-------------


LOT NUMBER: 106
 DRAWN BY: Author
 CHECKED BY: Selficient
 COPYRIGHT: NONE; PROJECT IS PUBLIC DOMAIN

SCALE: 1 : 50

SHEET TITLE

STRUCTURAL RAMP PLAN

S-212

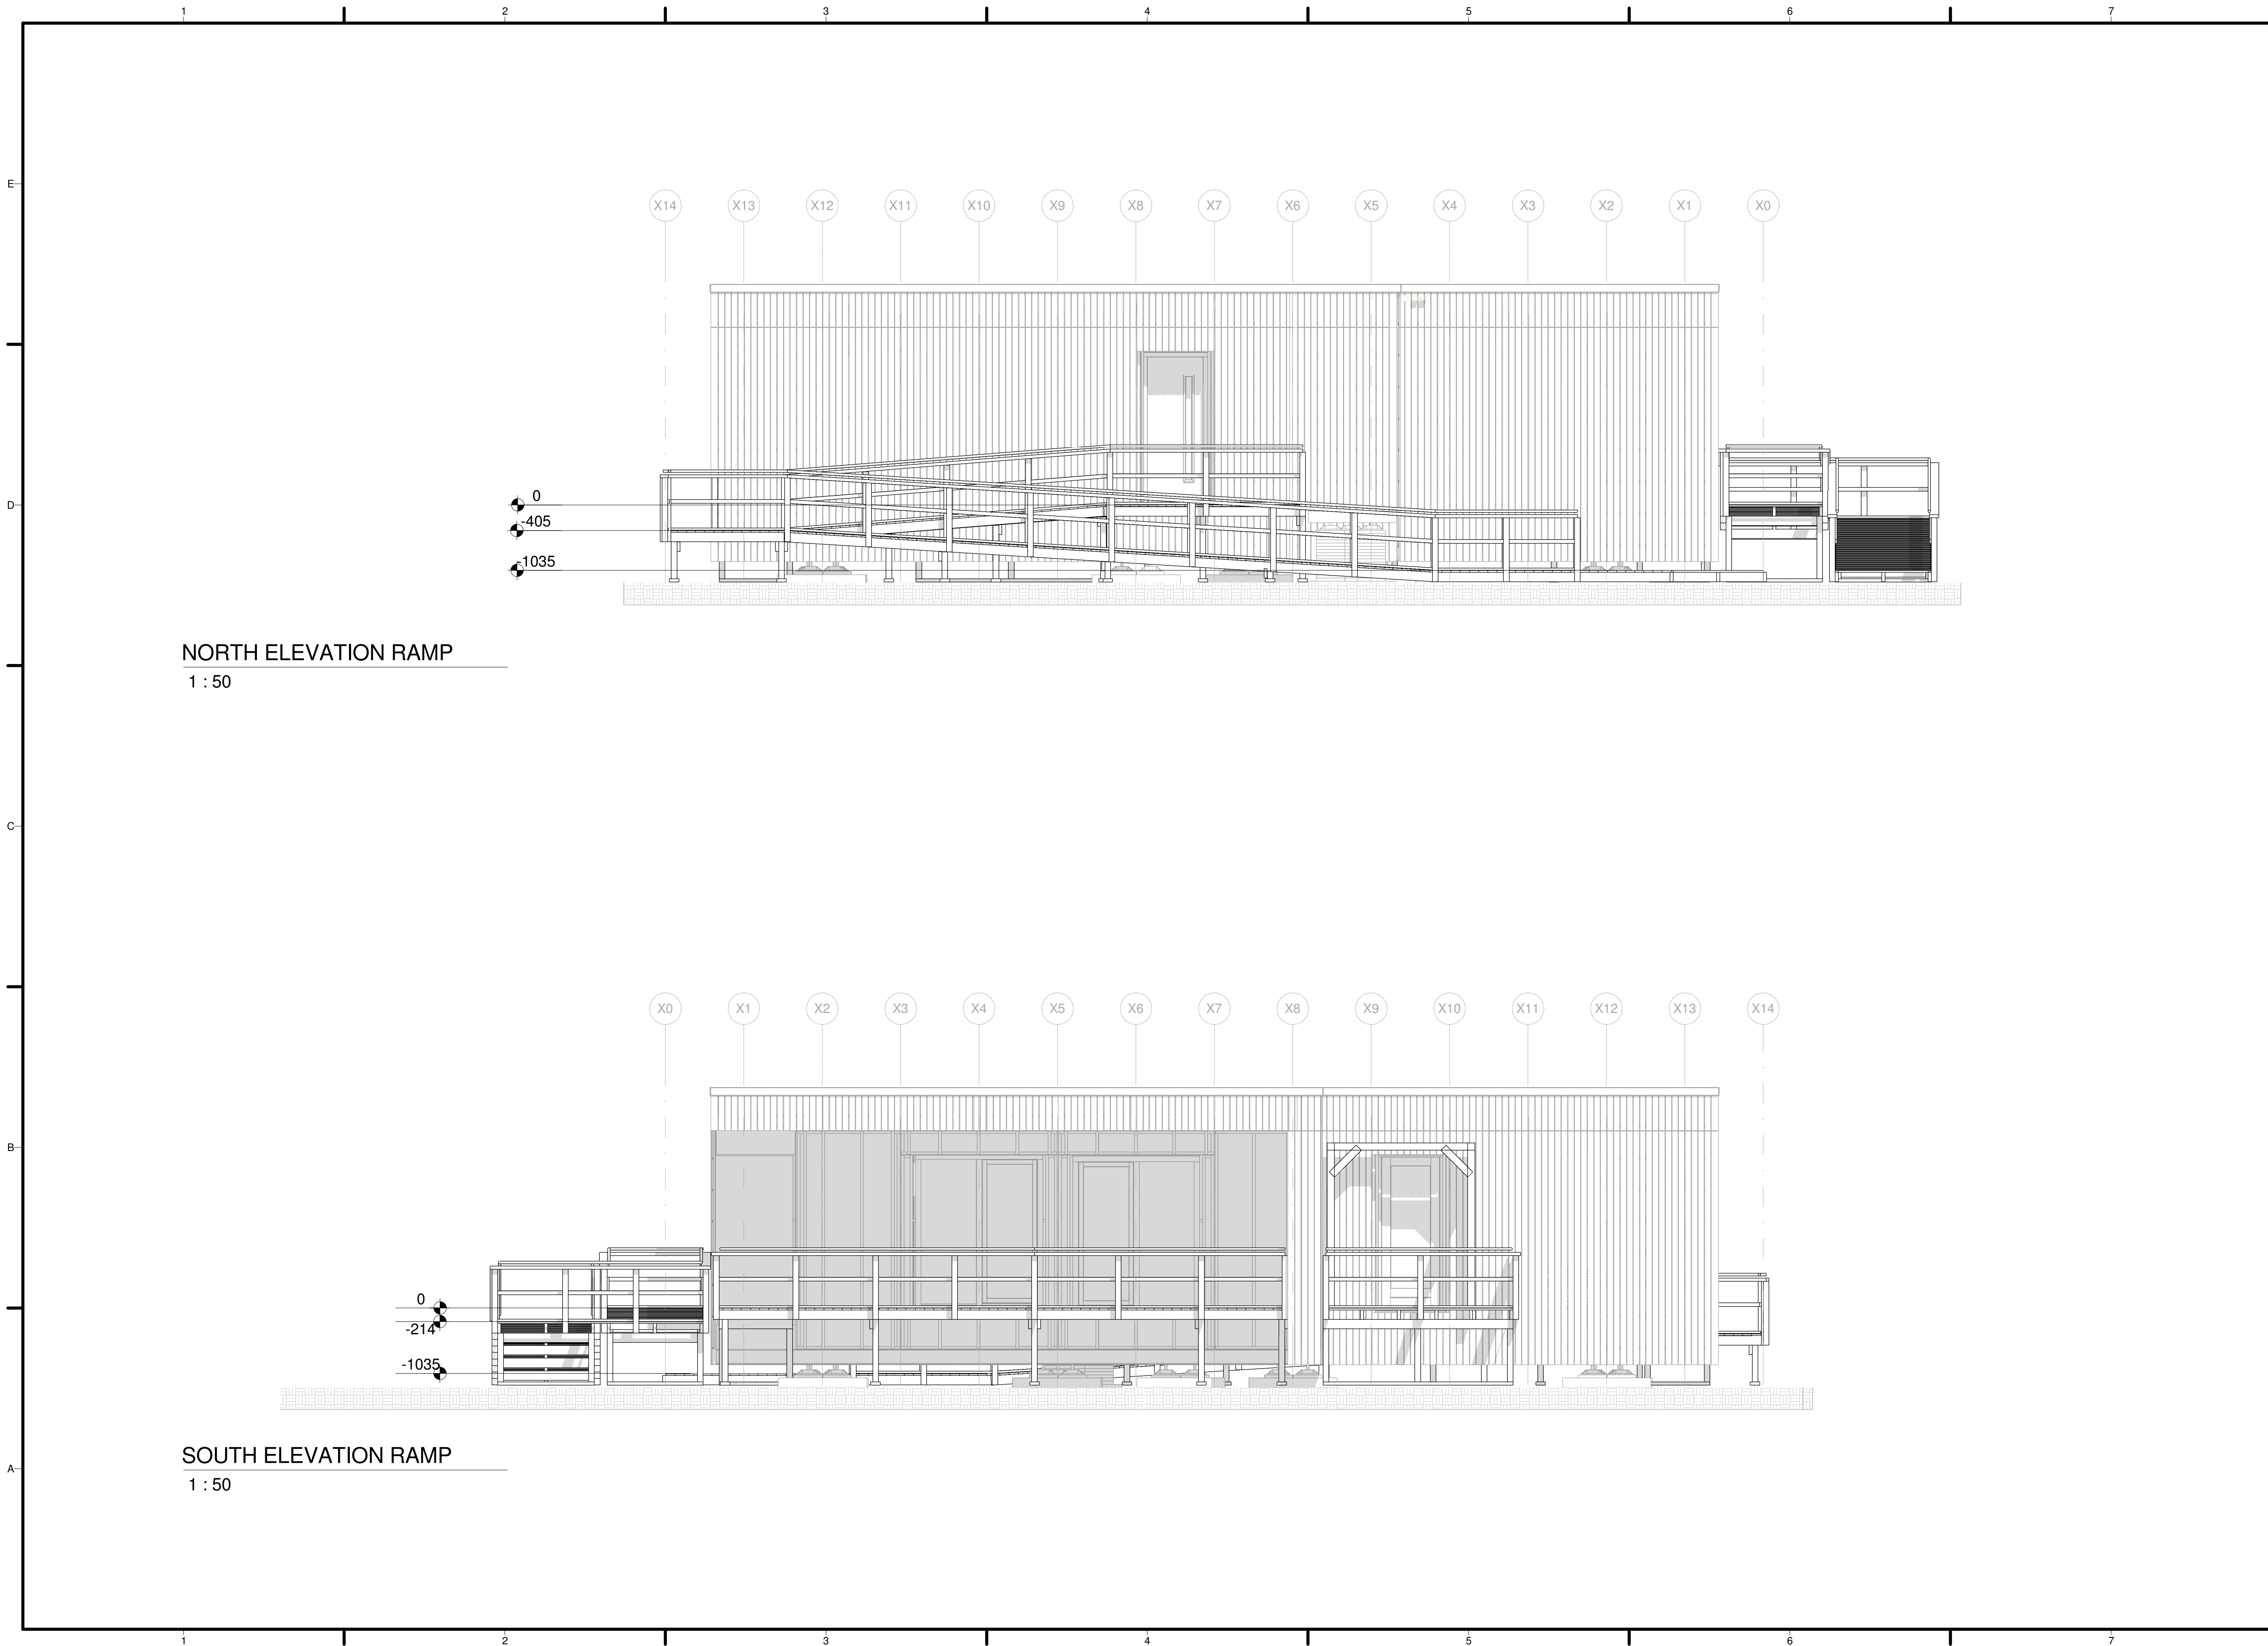

NORTH ELEVATION RAMP
1 : 50

SOUTH ELEVATION RAMP
1 : 50



TEAM NAME: Selficient
 ADDRESS: Padualaan 99
 3584 CH Utrecht
 CONTACT: info@selficient.org
 www.selficient.org

CONSULTANTS
 ARCHITECTURE
 ENGINEERS
 LANDSCAPING
 SAFETY FIRST CODE CONSULTANTS



CLIENT
 U.S. DEPARTMENT OF ENERGY
 SOLAR DECATHLON 2017
 WWW.SOLARDECATHLON.GOV




MARK	DATE	DESCRIPTION
0	17-11-2016	90% revision

LOT NUMBER: 106
 DRAWN BY: SELFICIENT
 CHECKED BY: Selficient
 COPYRIGHT: NONE; PROJECT IS PUBLIC DOMAIN

SCALE: 1 : 50
 SHEET TITLE

RAMP ELEVATIONS

S-300

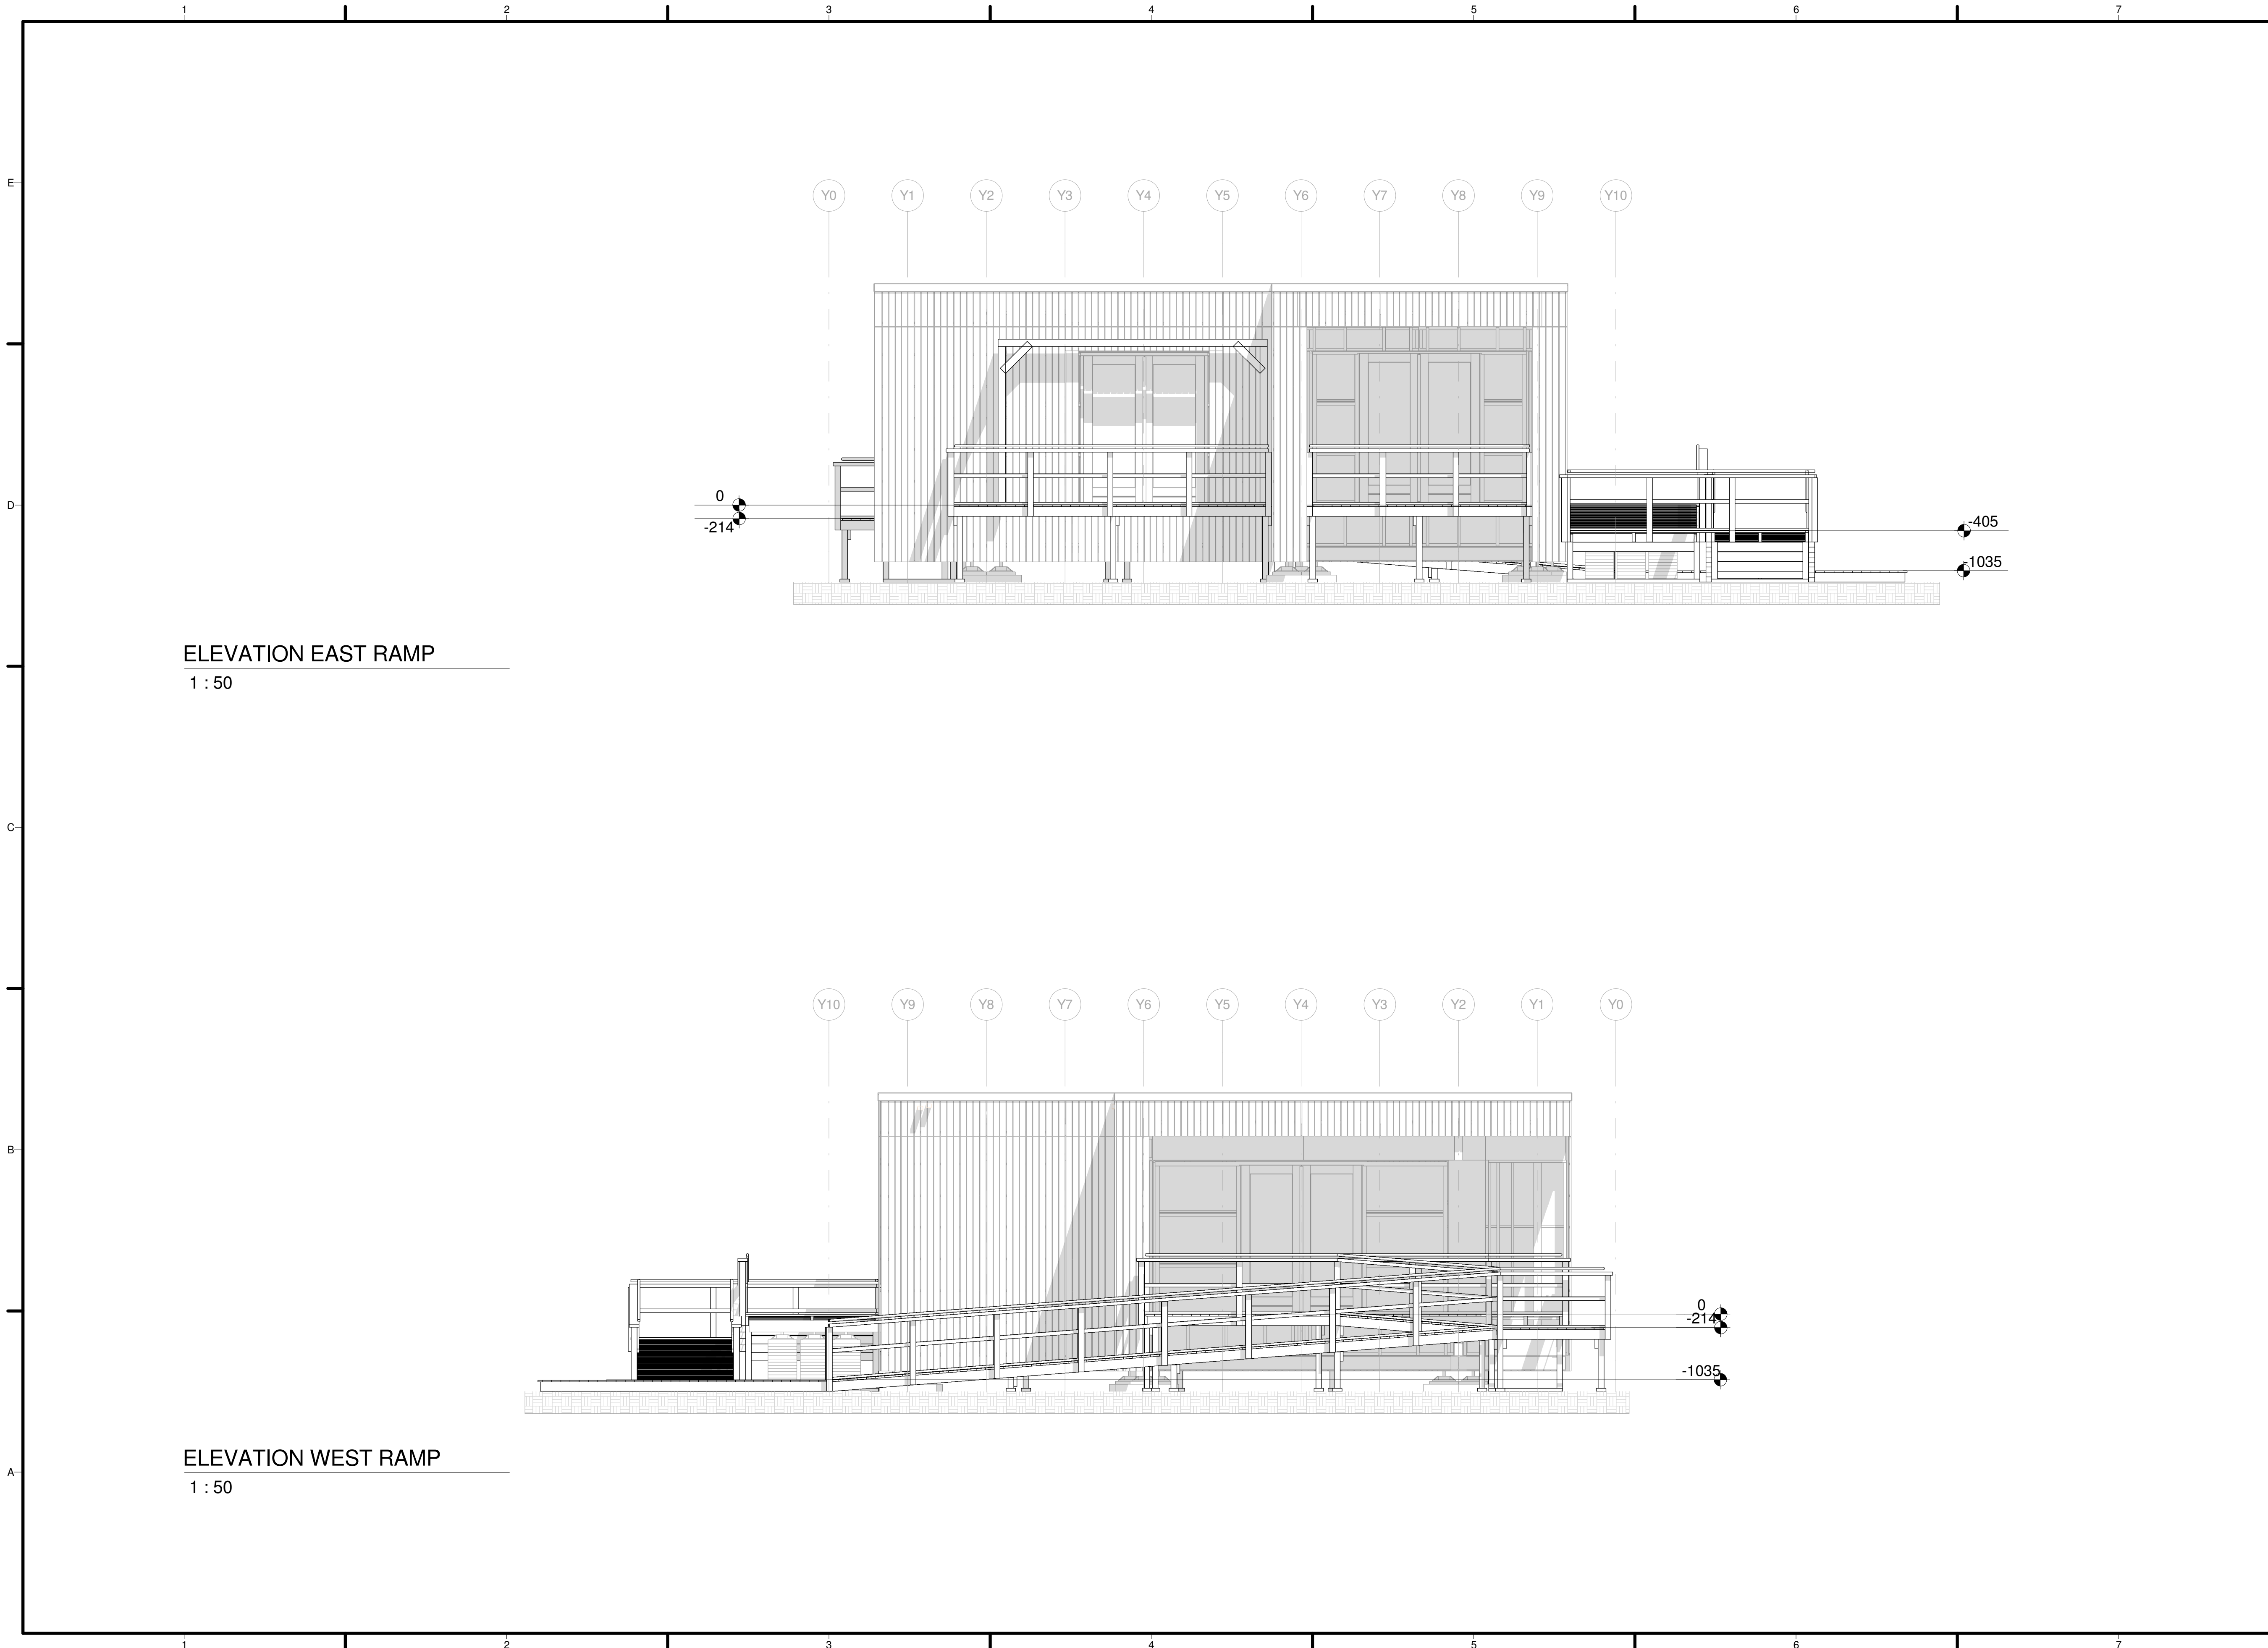

ELEVATION EAST RAMP
1 : 50

ELEVATION WEST RAMP
1 : 50



TEAM NAME: Selficient
 ADDRESS: Padualaan 99
 3584 CH Utrecht
 CONTACT: info@selficient.org
 www.selficient.org

CONSULTANTS
 ARCHITECTURE
 ENGINEERS
 LANDSCAPING
 SAFETY FIRST CODE CONSULTANTS

CLIENT
 U.S. DEPARTMENT OF ENERGY
 SOLAR DECATHLON 2017
 WWW.SOLARDECATHLON.GOV



MARK	DATE	DESCRIPTION
0	17-11-2016	90% revision

LOT NUMBER: 106
 DRAWN BY: SELFICIENT
 CHECKED BY: Selficient
 COPYRIGHT: NONE; PROJECT IS PUBLIC DOMAIN

SCALE: 1 : 50

SHEET TITLE

RAMP ELEVATIONS

S-301



TEAM NAME: Selficient
 ADDRESS: Padualaan 99
 3584 CH Utrecht
 CONTACT: info@selficient.org
 www.selficient.org

CONSULTANTS
 ARCHITECTURE
 ENGINEERS
 LANDSCAPING
 SAFETY FIRST CODE CONSULTANTS

CLIENT
 U.S. DEPARTMENT OF ENERGY
 SOLAR DECATHLON 2017
 WWW.SOLARDECATHLON.GOV



0	17-11-2016	90% revision
---	------------	--------------


MARK	DATE	DESCRIPTION
------	------	-------------

LOT NUMBER: 106
 DRAWN BY: Author
 CHECKED BY: Selficient
 COPYRIGHT: NONE; PROJECT IS PUBLIC DOMAIN


SCALE: 1 : 50

SHEET TITLE
STRUCTUAL SECTIONS


S-350

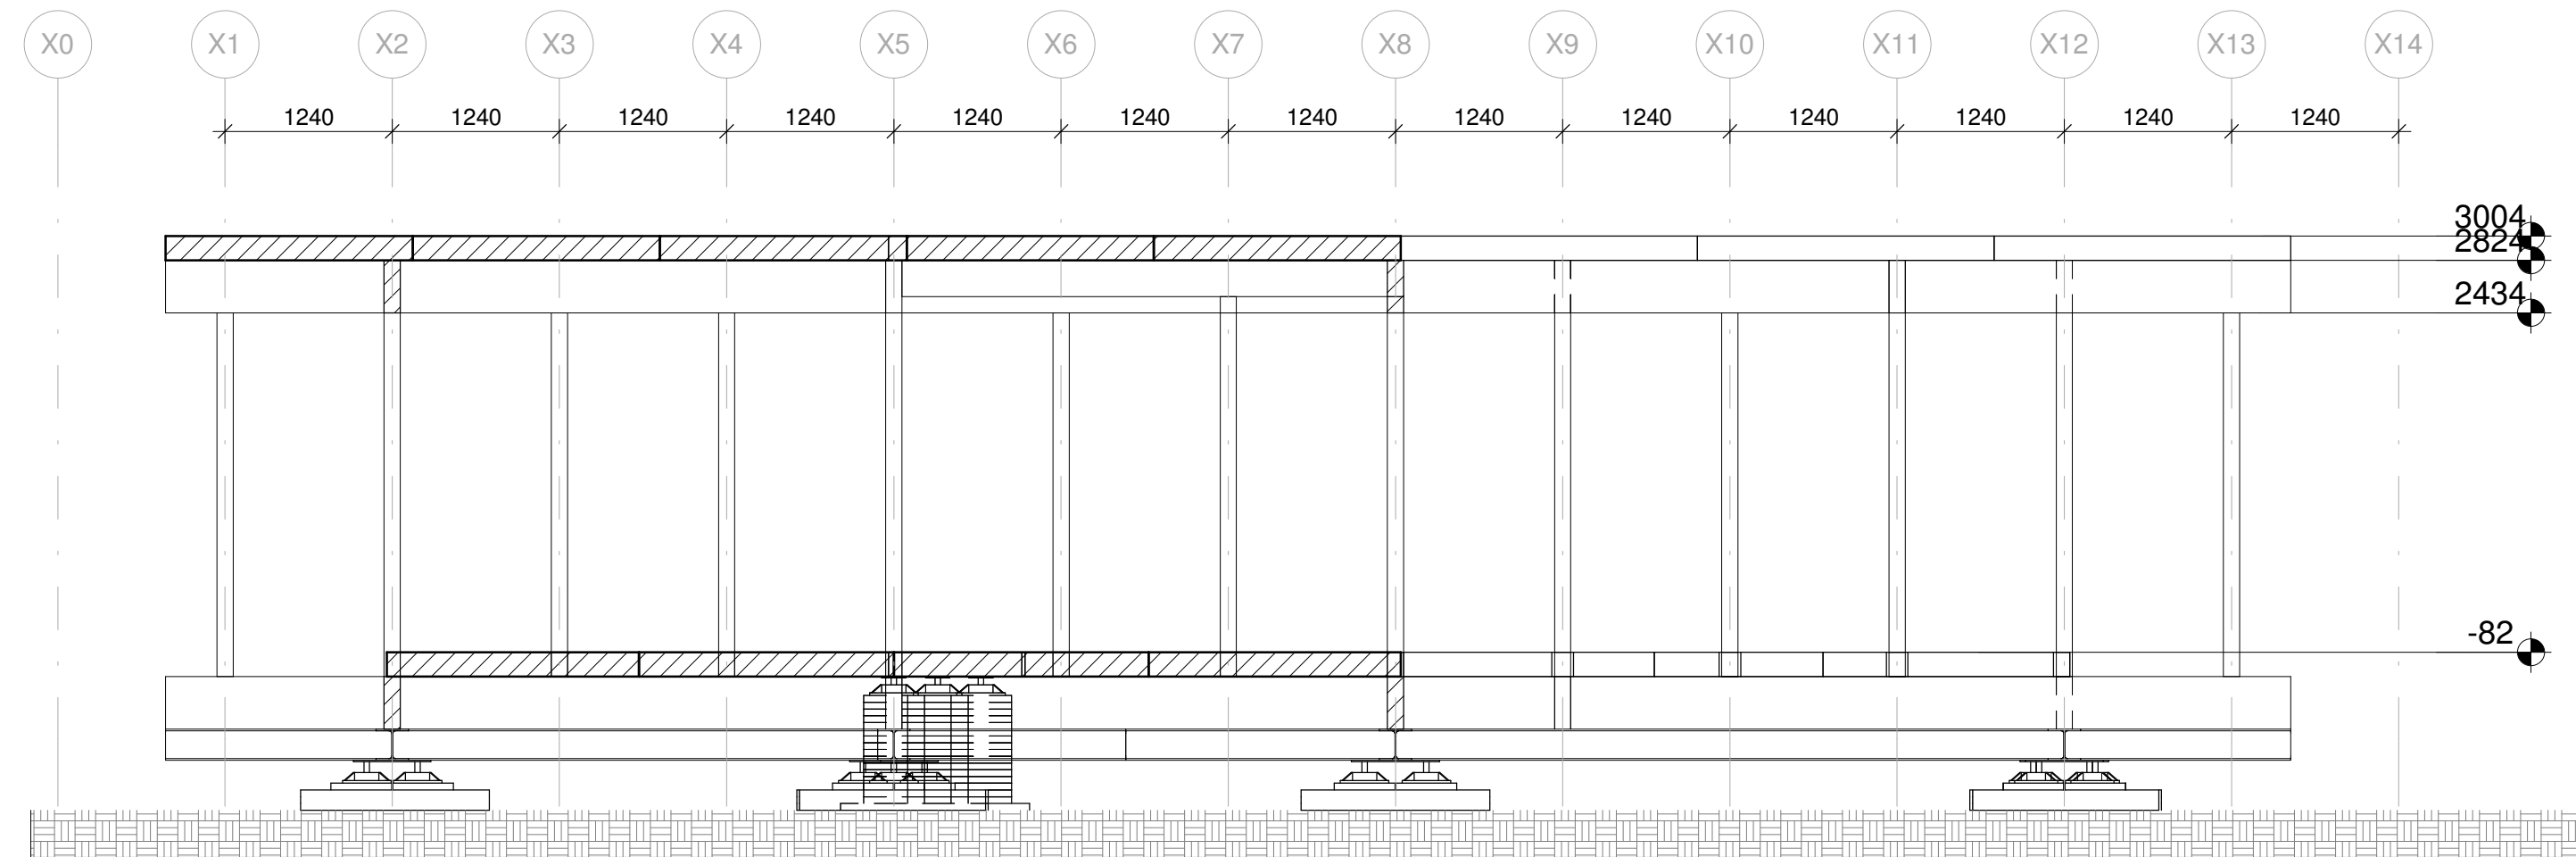

STRUCTUAL SECTION A
 1 : 50

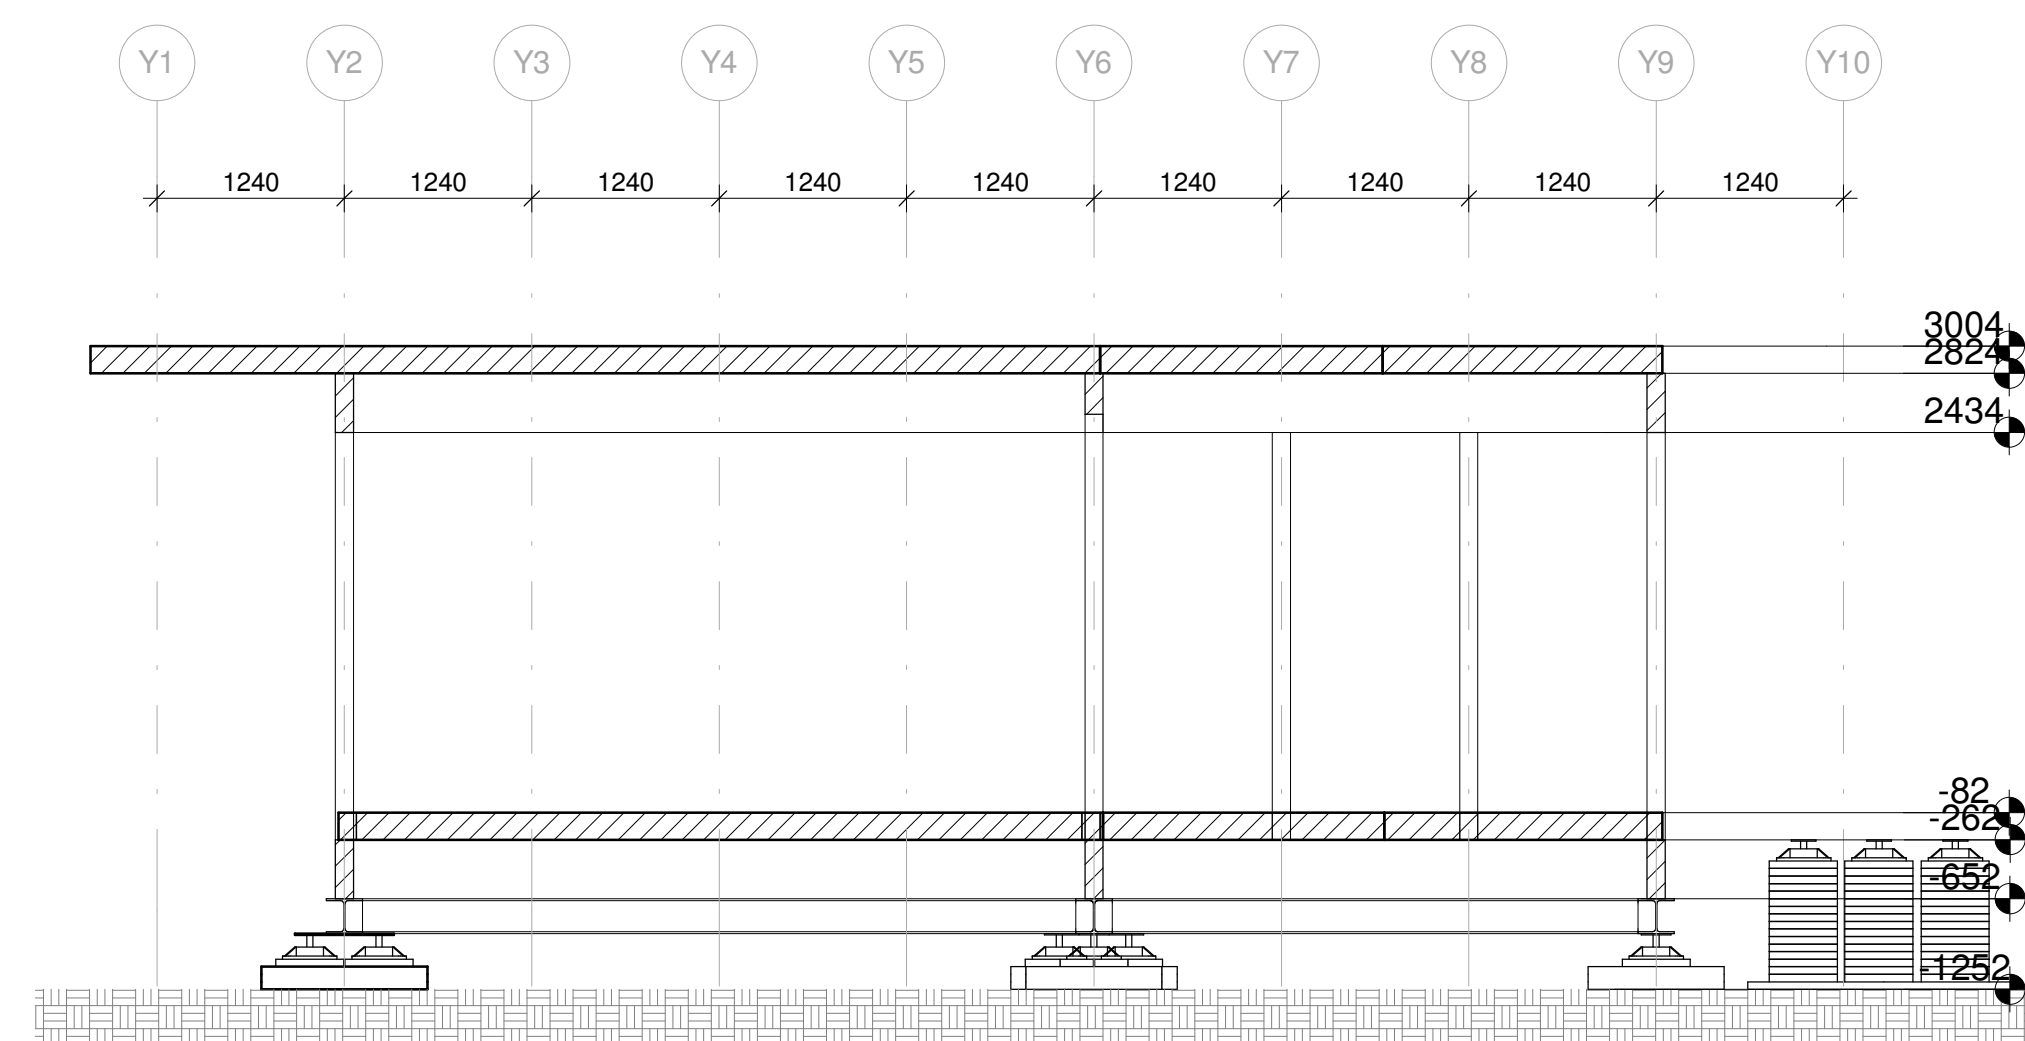


STRUCTUAL SECTION B
 1 : 50

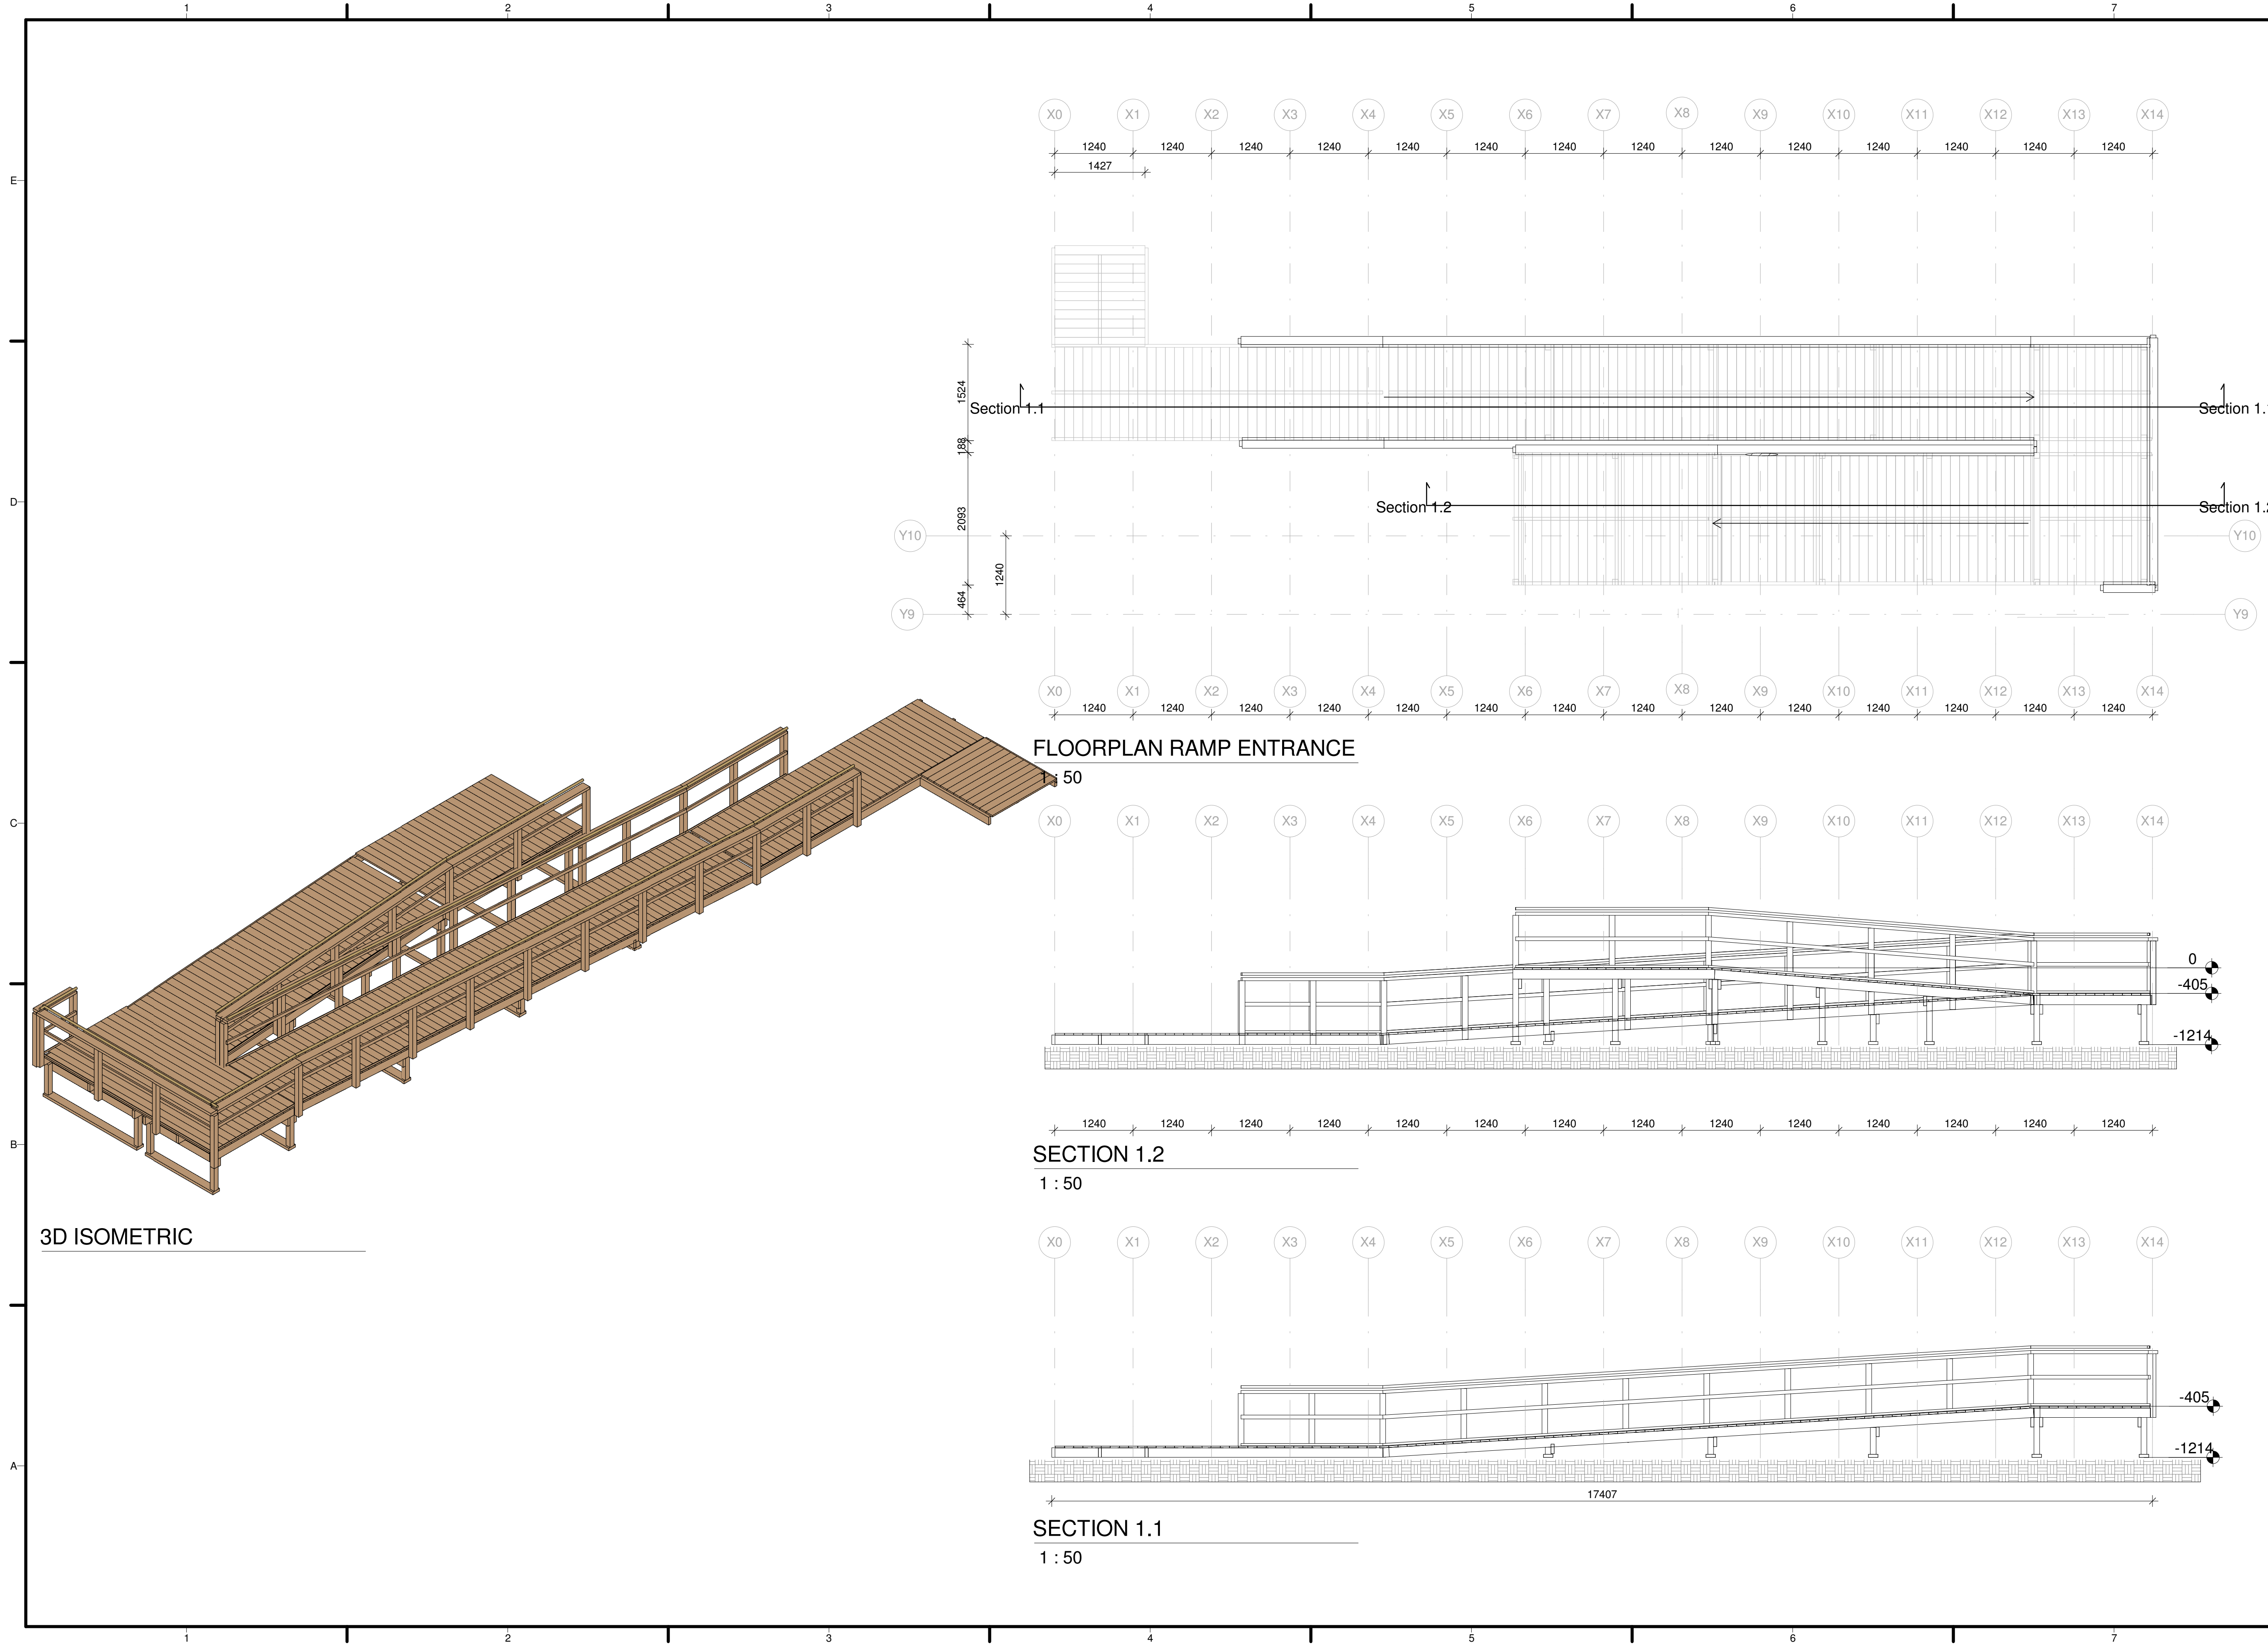

TEAM NAME: Selficient
 ADDRESS: Padualaan 99
 3584 CH Utrecht
 CONTACT: info@selficient.org
 www.selficient.org

CONSULTANTS
 ARCHITECTURE
 ENGINEERS
 LANDSCAPING
 SAFETY FIRST CODE CONSULTANTS

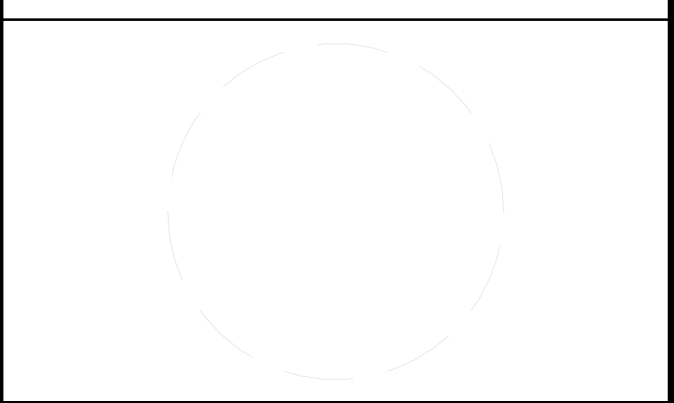

CLIENT
 U.S. DEPARTMENT OF ENERGY
 SOLAR DECATHLON 2017
 WWW.SOLARDECATHLON.GOV



0	17-11-2016	90% revision
---	------------	--------------


MARK	DATE	DESCRIPTION
LOT NUMBER:	106	
DRAWN BY:	Author	
CHECKED BY:	Selficient	
COPYRIGHT:	NONE; PROJECT IS PUBLIC DOMAIN	

SCALE: 1 : 50

SHEET TITLE

STRUCTURAL RAMP OVERVIEW ENTRANCE

S-360

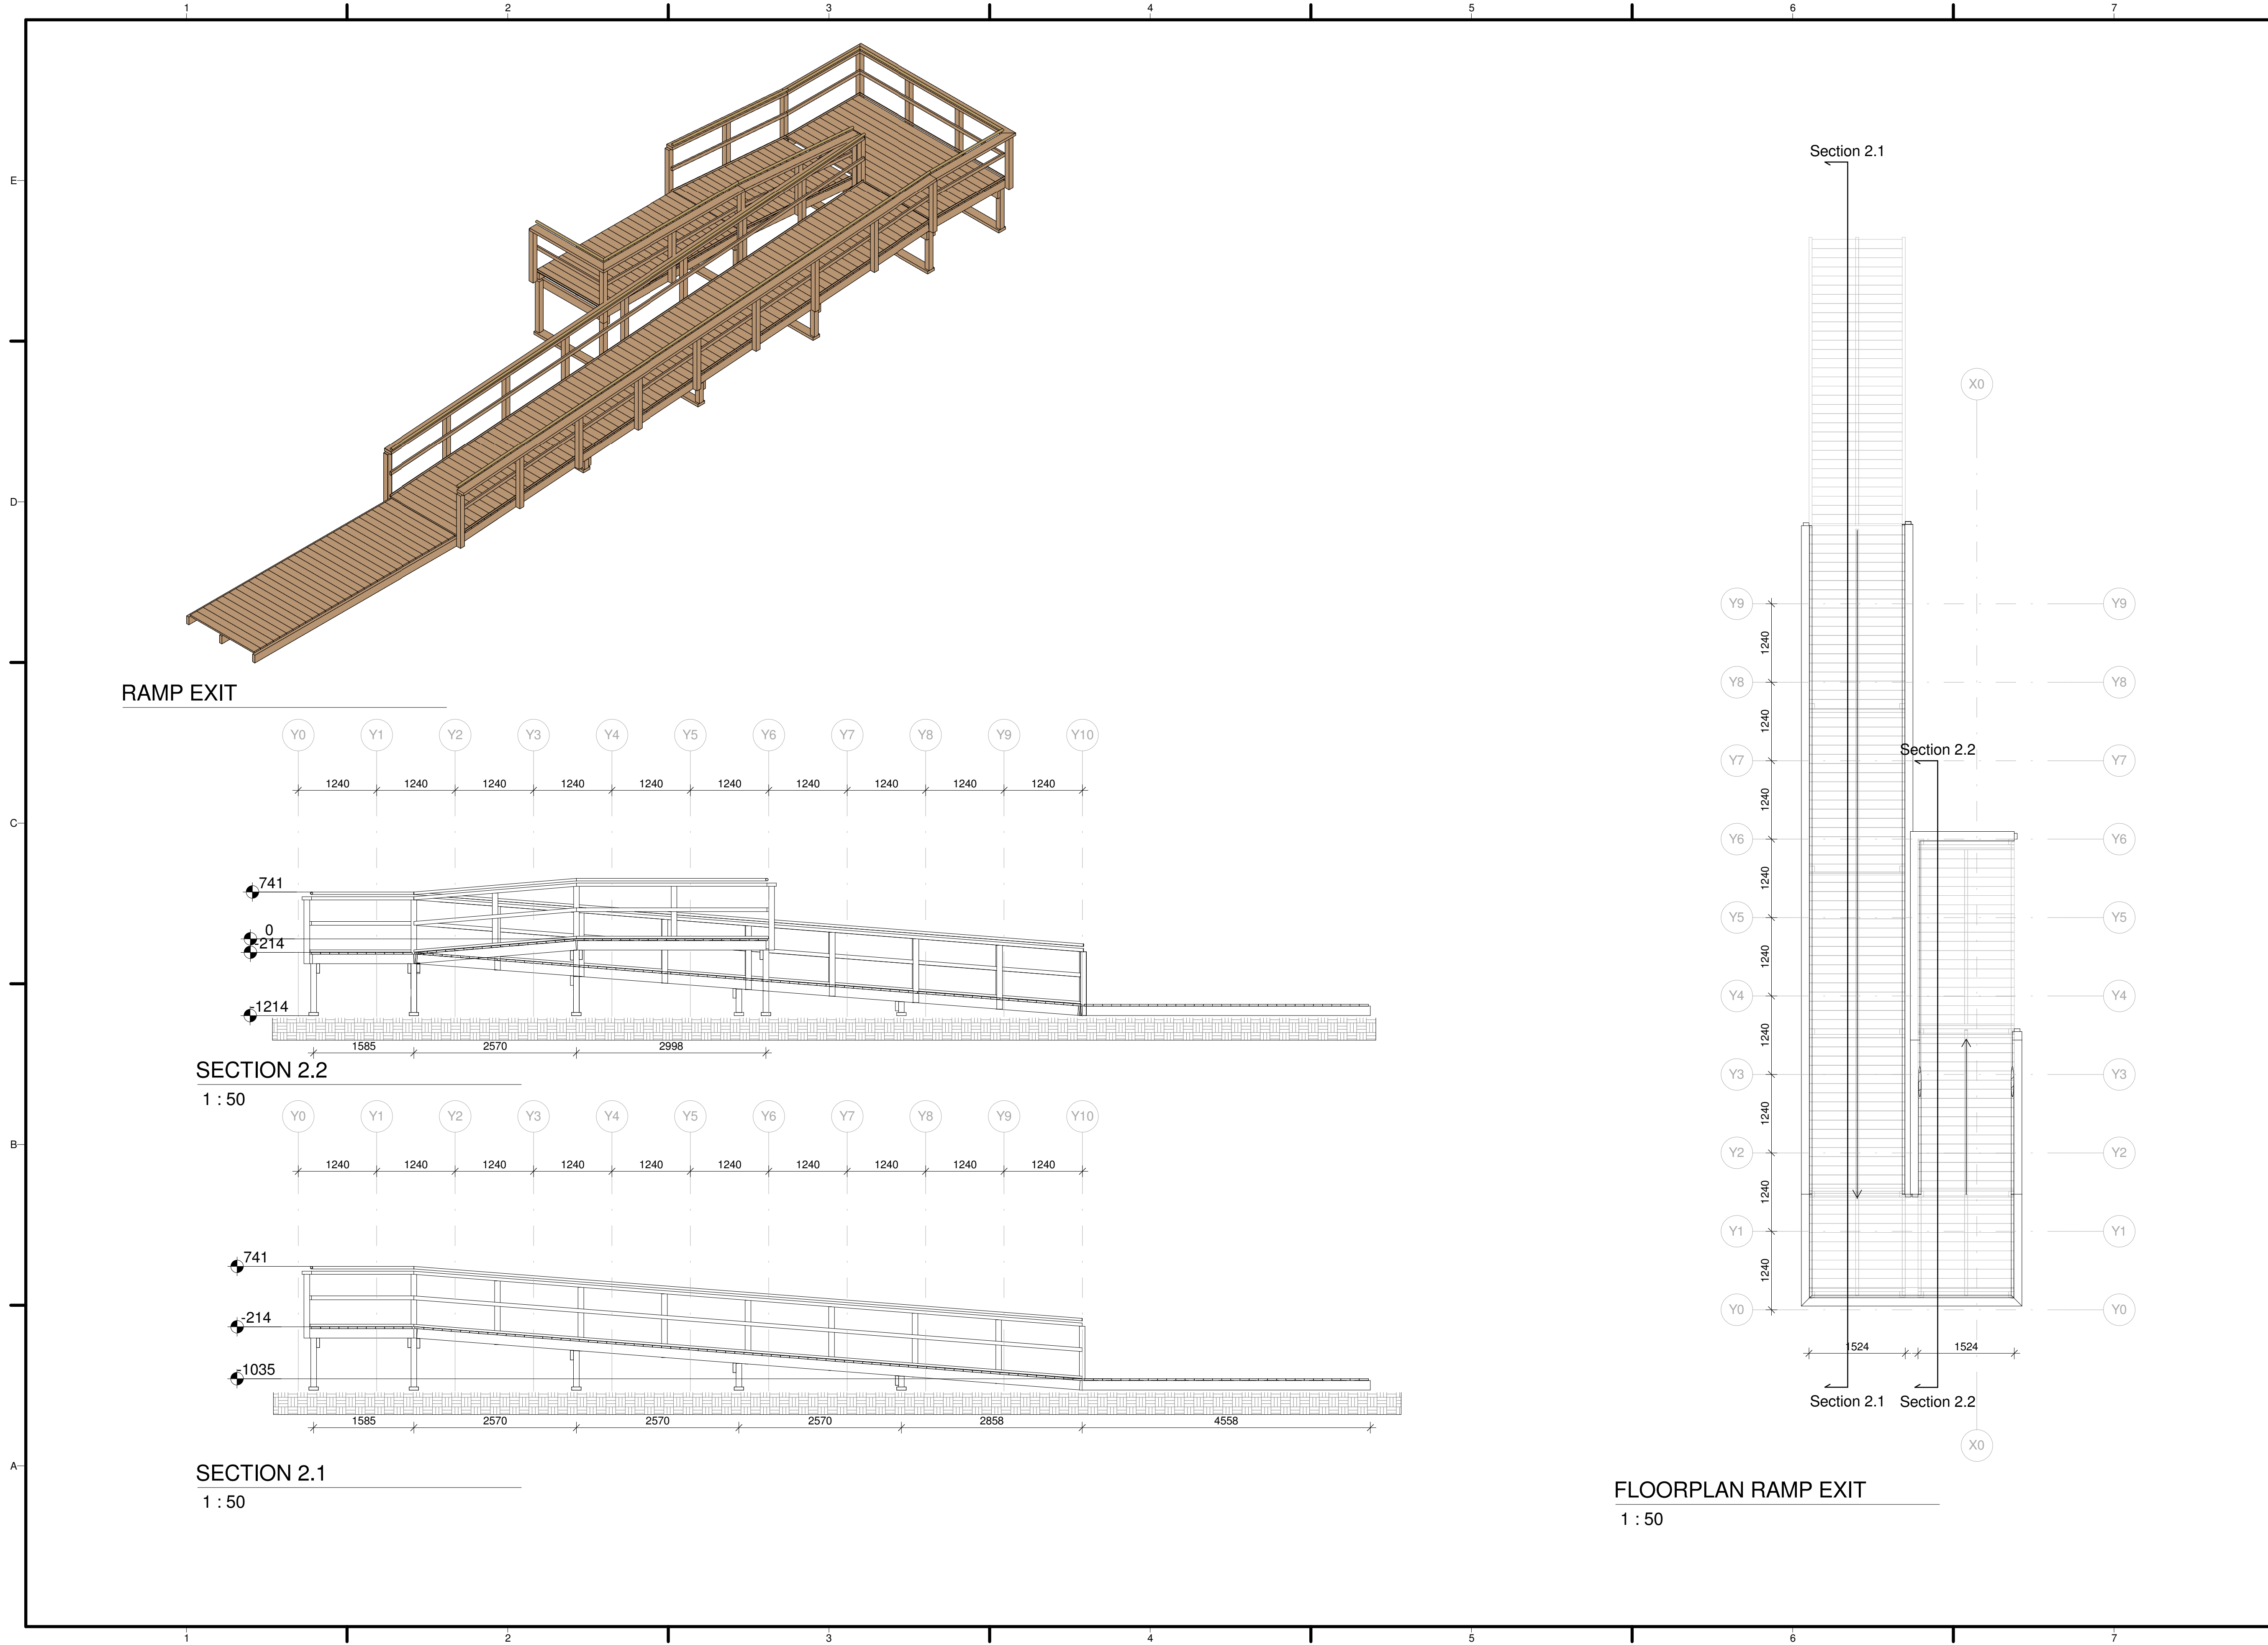

TEAM NAME: Selficient
 ADDRESS: Padualaan 99
 3584 CH Utrecht
 CONTACT: info@selficient.org
 www.selficient.org

CONSULTANTS
 ARCHITECTURE
 ENGINEERS
 LANDSCAPING
 SAFETY FIRST CODE CONSULTANTS

CLIENT
 U.S. DEPARTMENT OF ENERGY
 SOLAR DECATHLON 2017
 WWW.SOLARDECATHLON.GOV




MARK	DATE	DESCRIPTION
0	17-11-2016	90% revision

LOT NUMBER: 106
 DRAWN BY: Author
 CHECKED BY: Selficient
 COPYRIGHT: NONE; PROJECT IS PUBLIC DOMAIN


SCALE: 1 : 50
 SHEET TITLE

STRUCTURAL RAMP OVERVIEW EXIT


S-361

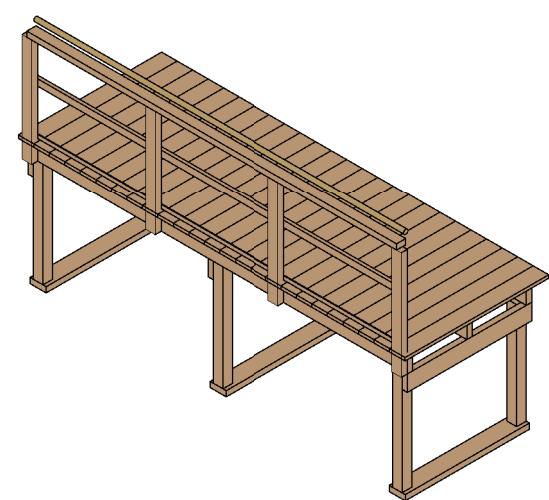


DECK BEDROOM

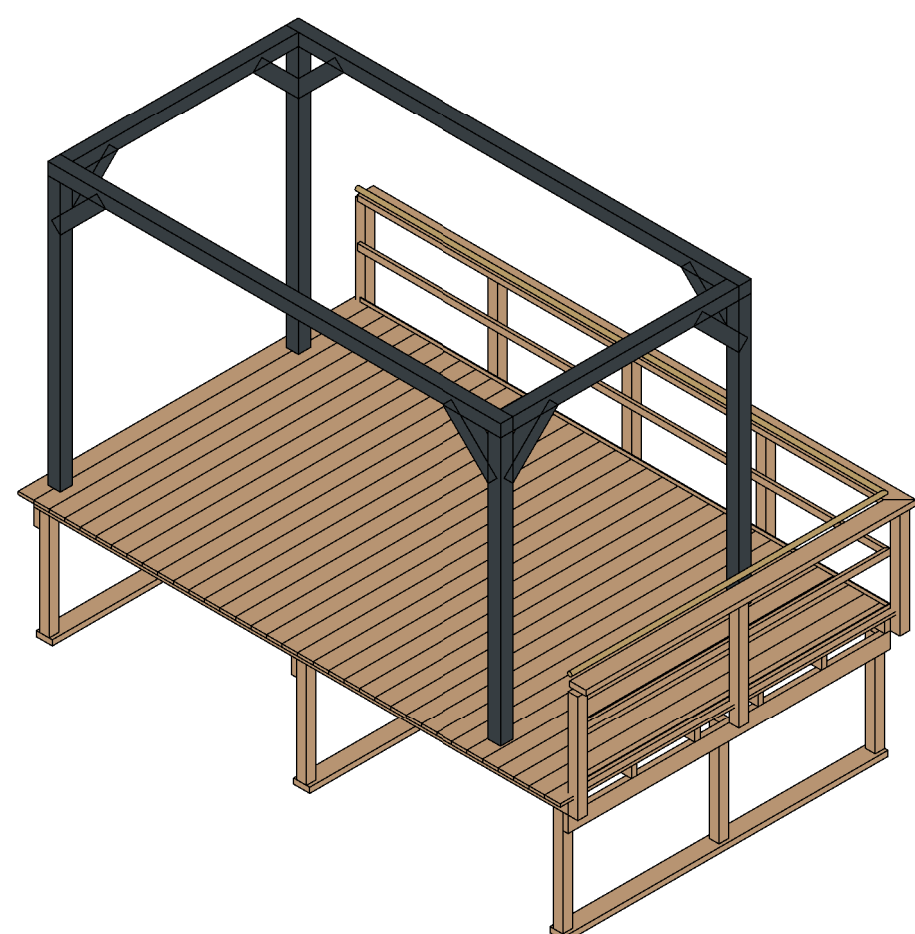


DECK LIVINGROOM

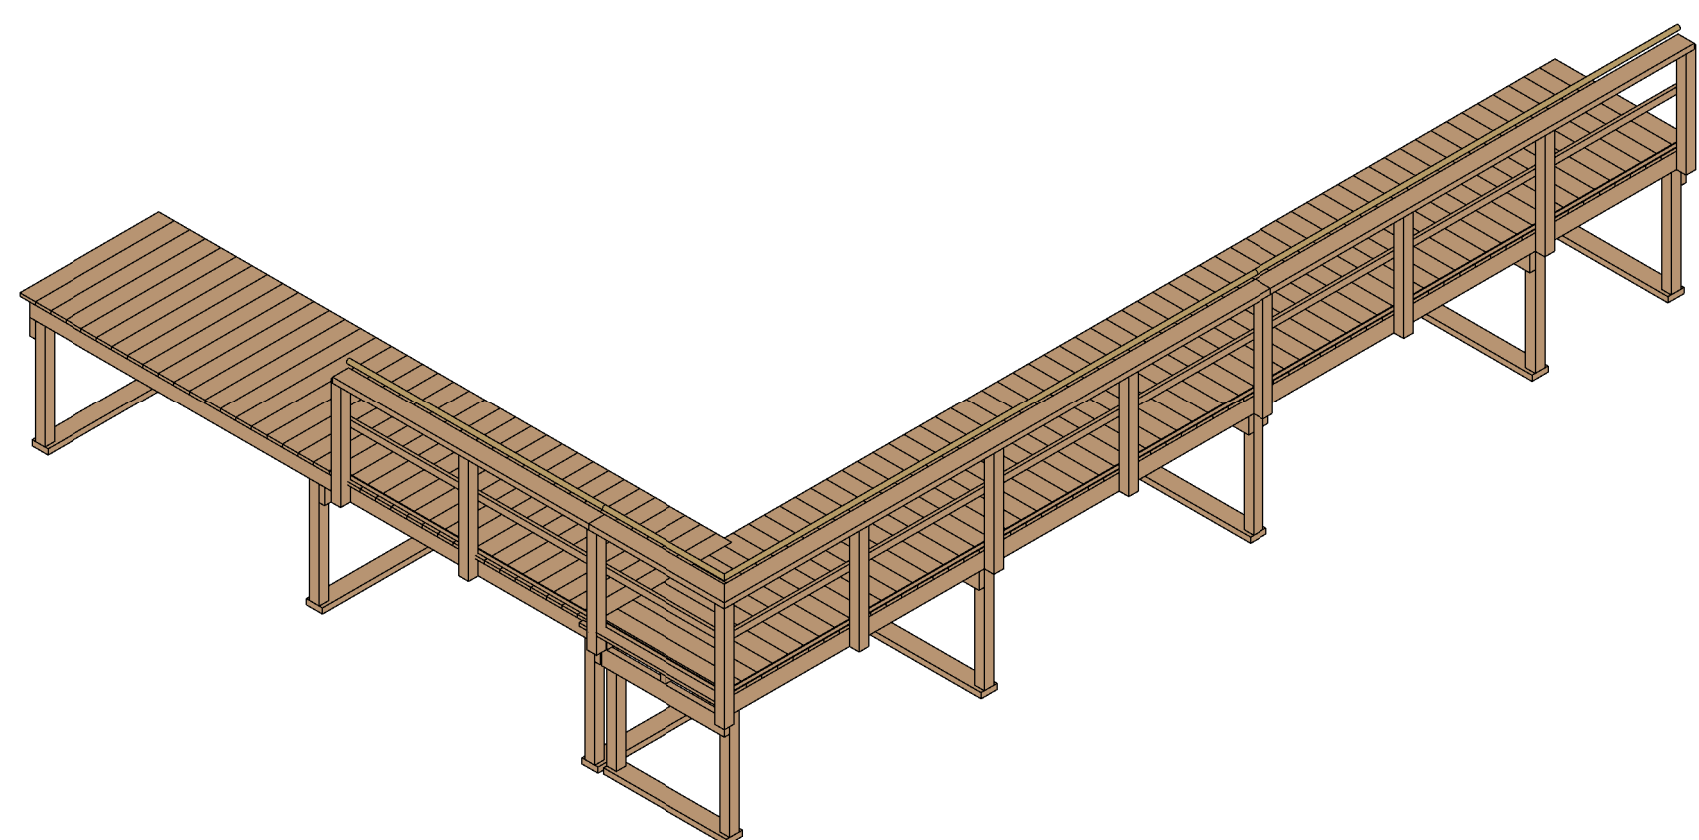


DECK KITCHEN

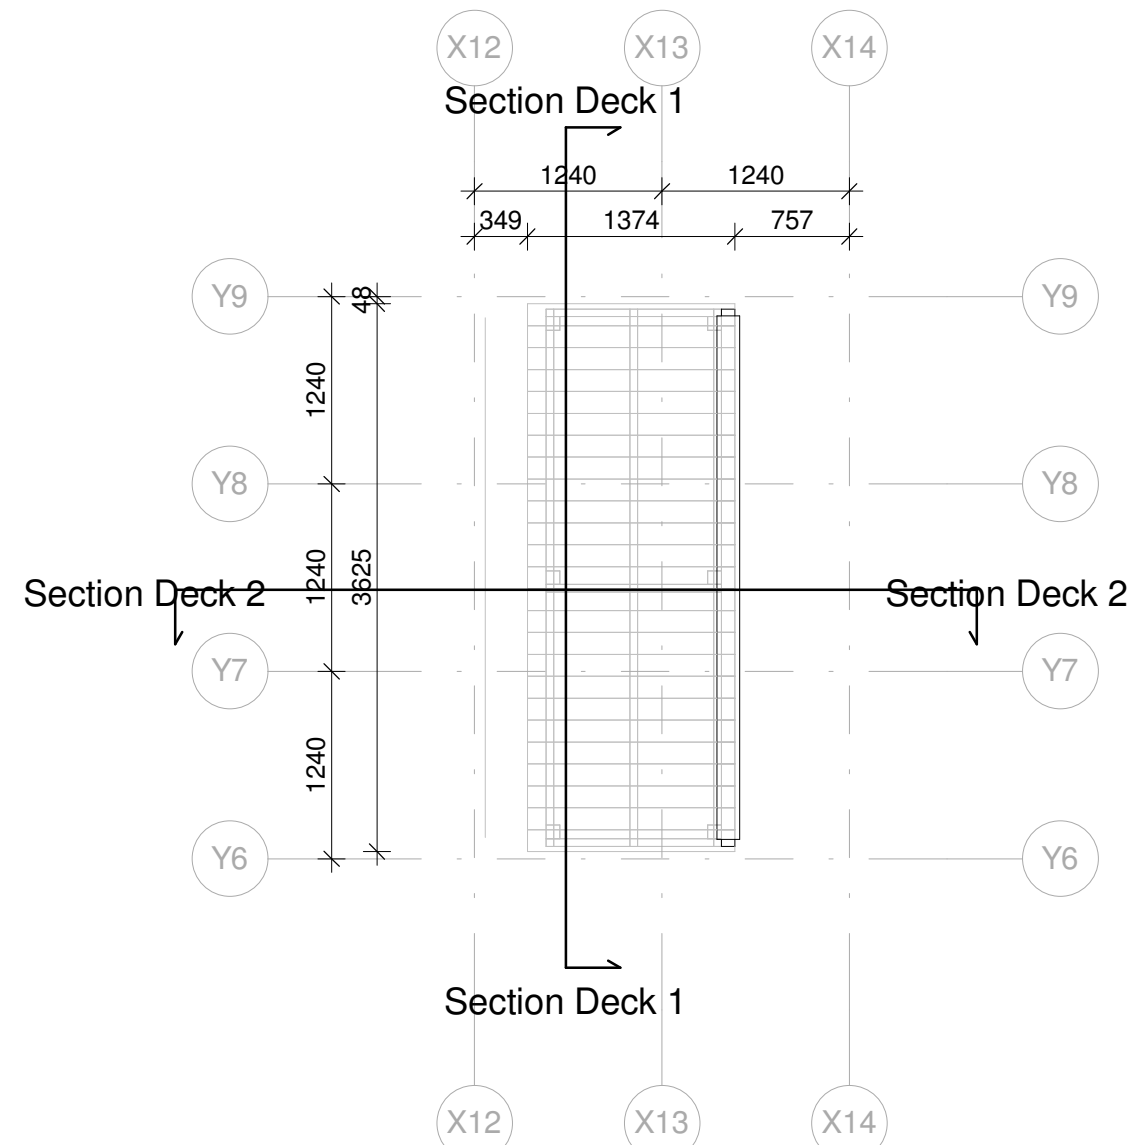


FLOORPLAN DECK BEDROOM
1 : 50

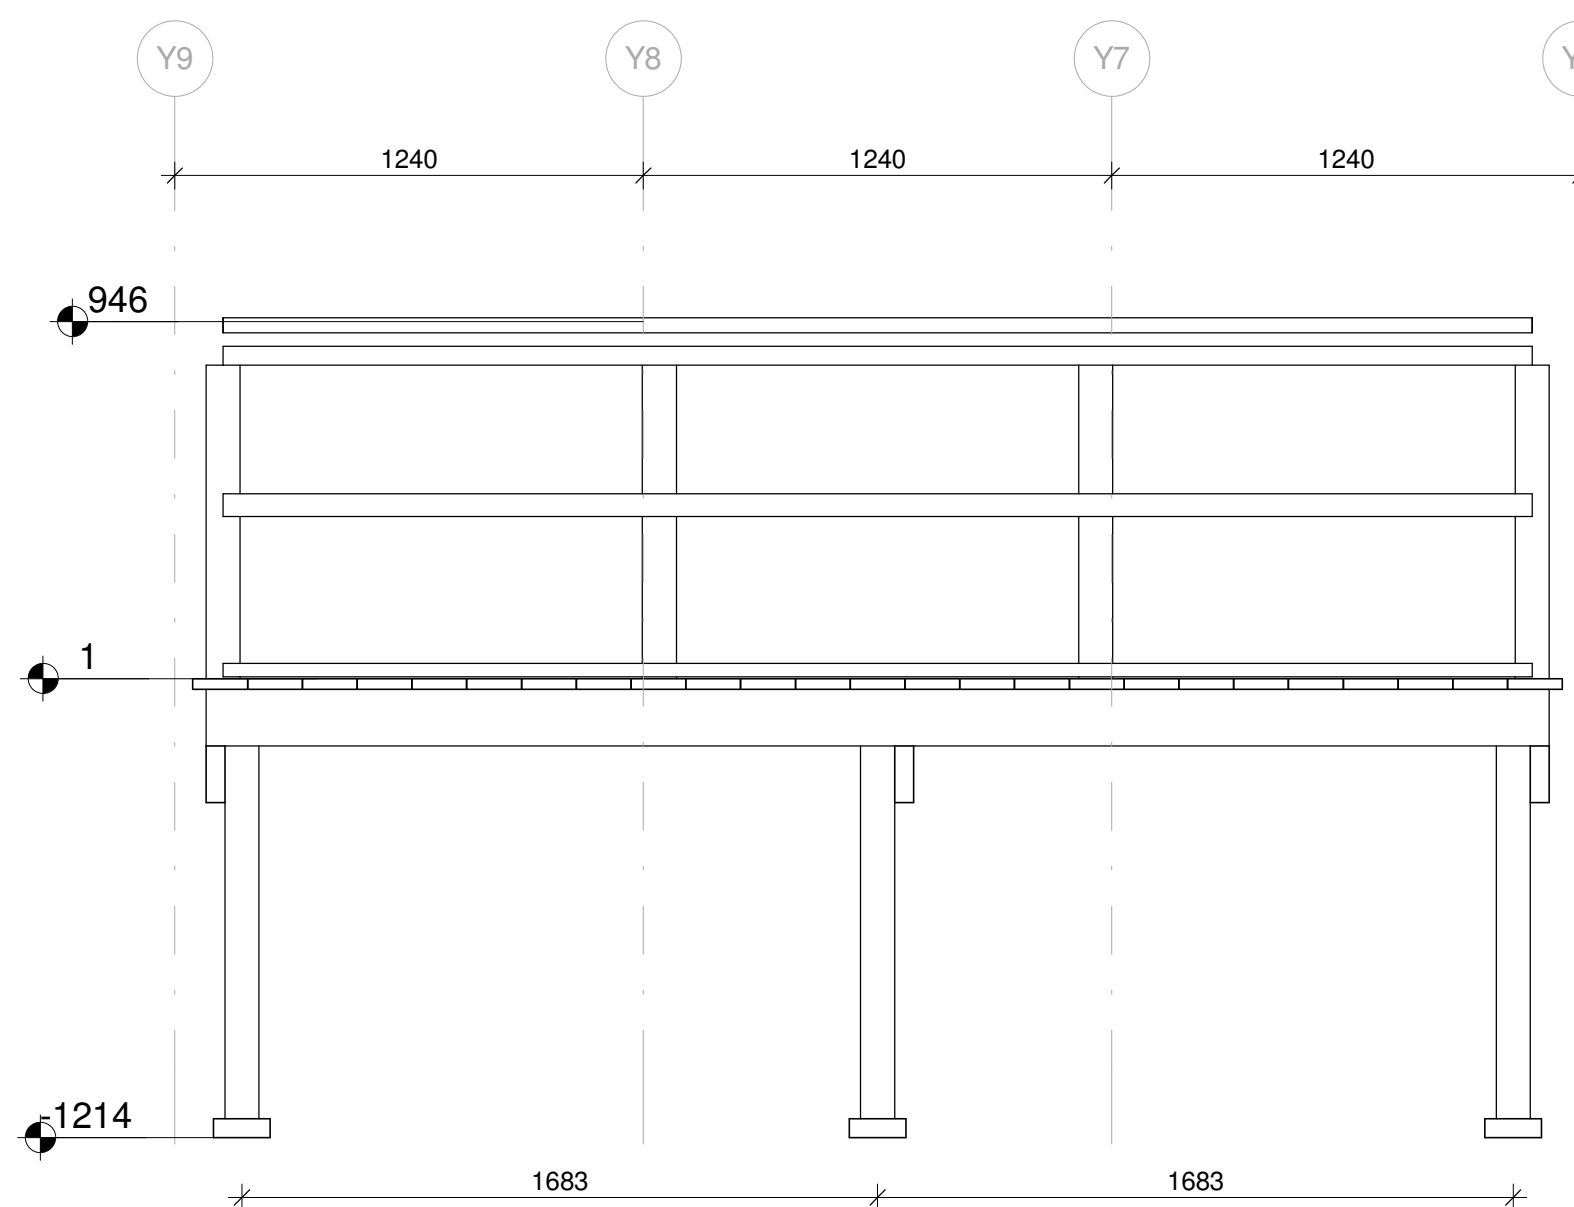


SECTION DECK BEDROOM
1 : 20

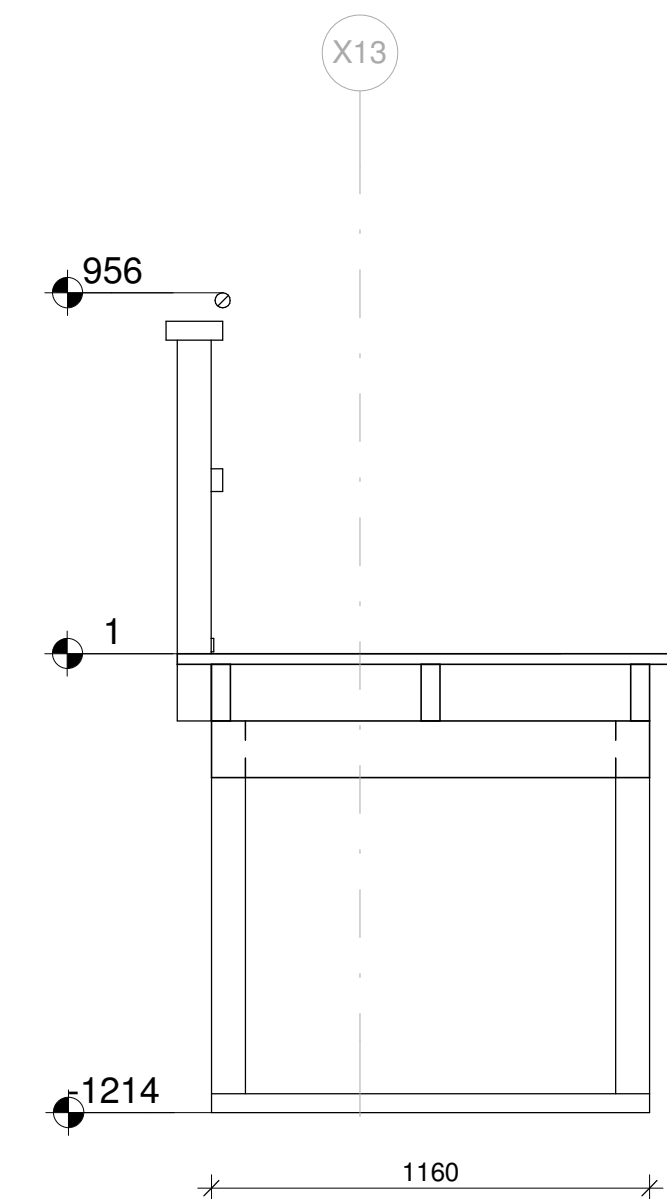

SECTION DECK BEDROOM
1 : 20

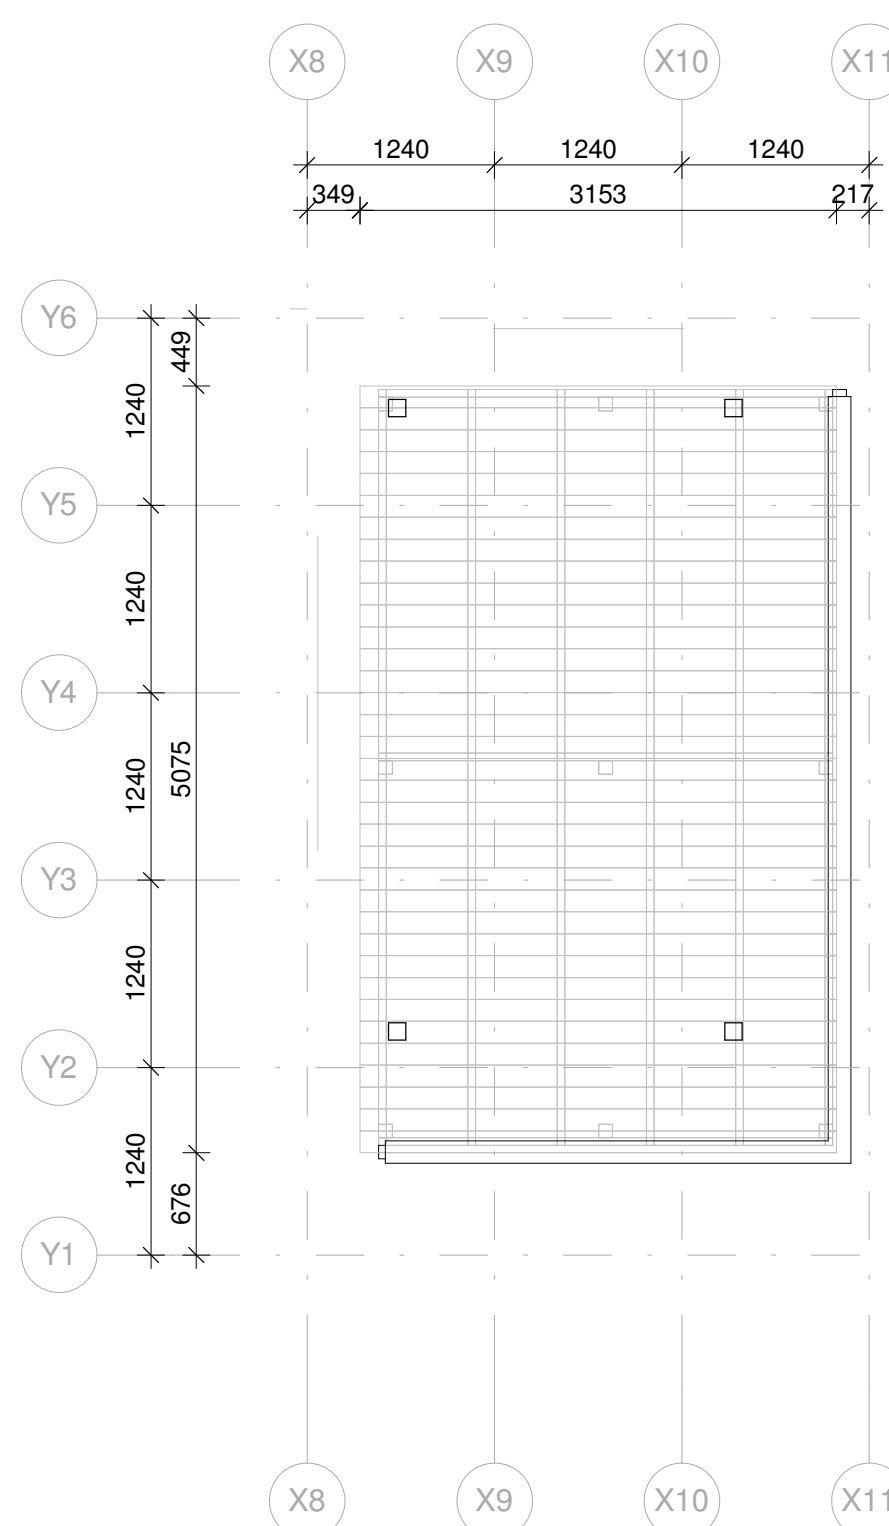

FLOORPLAN DECK LIVINGROOM
1 : 50

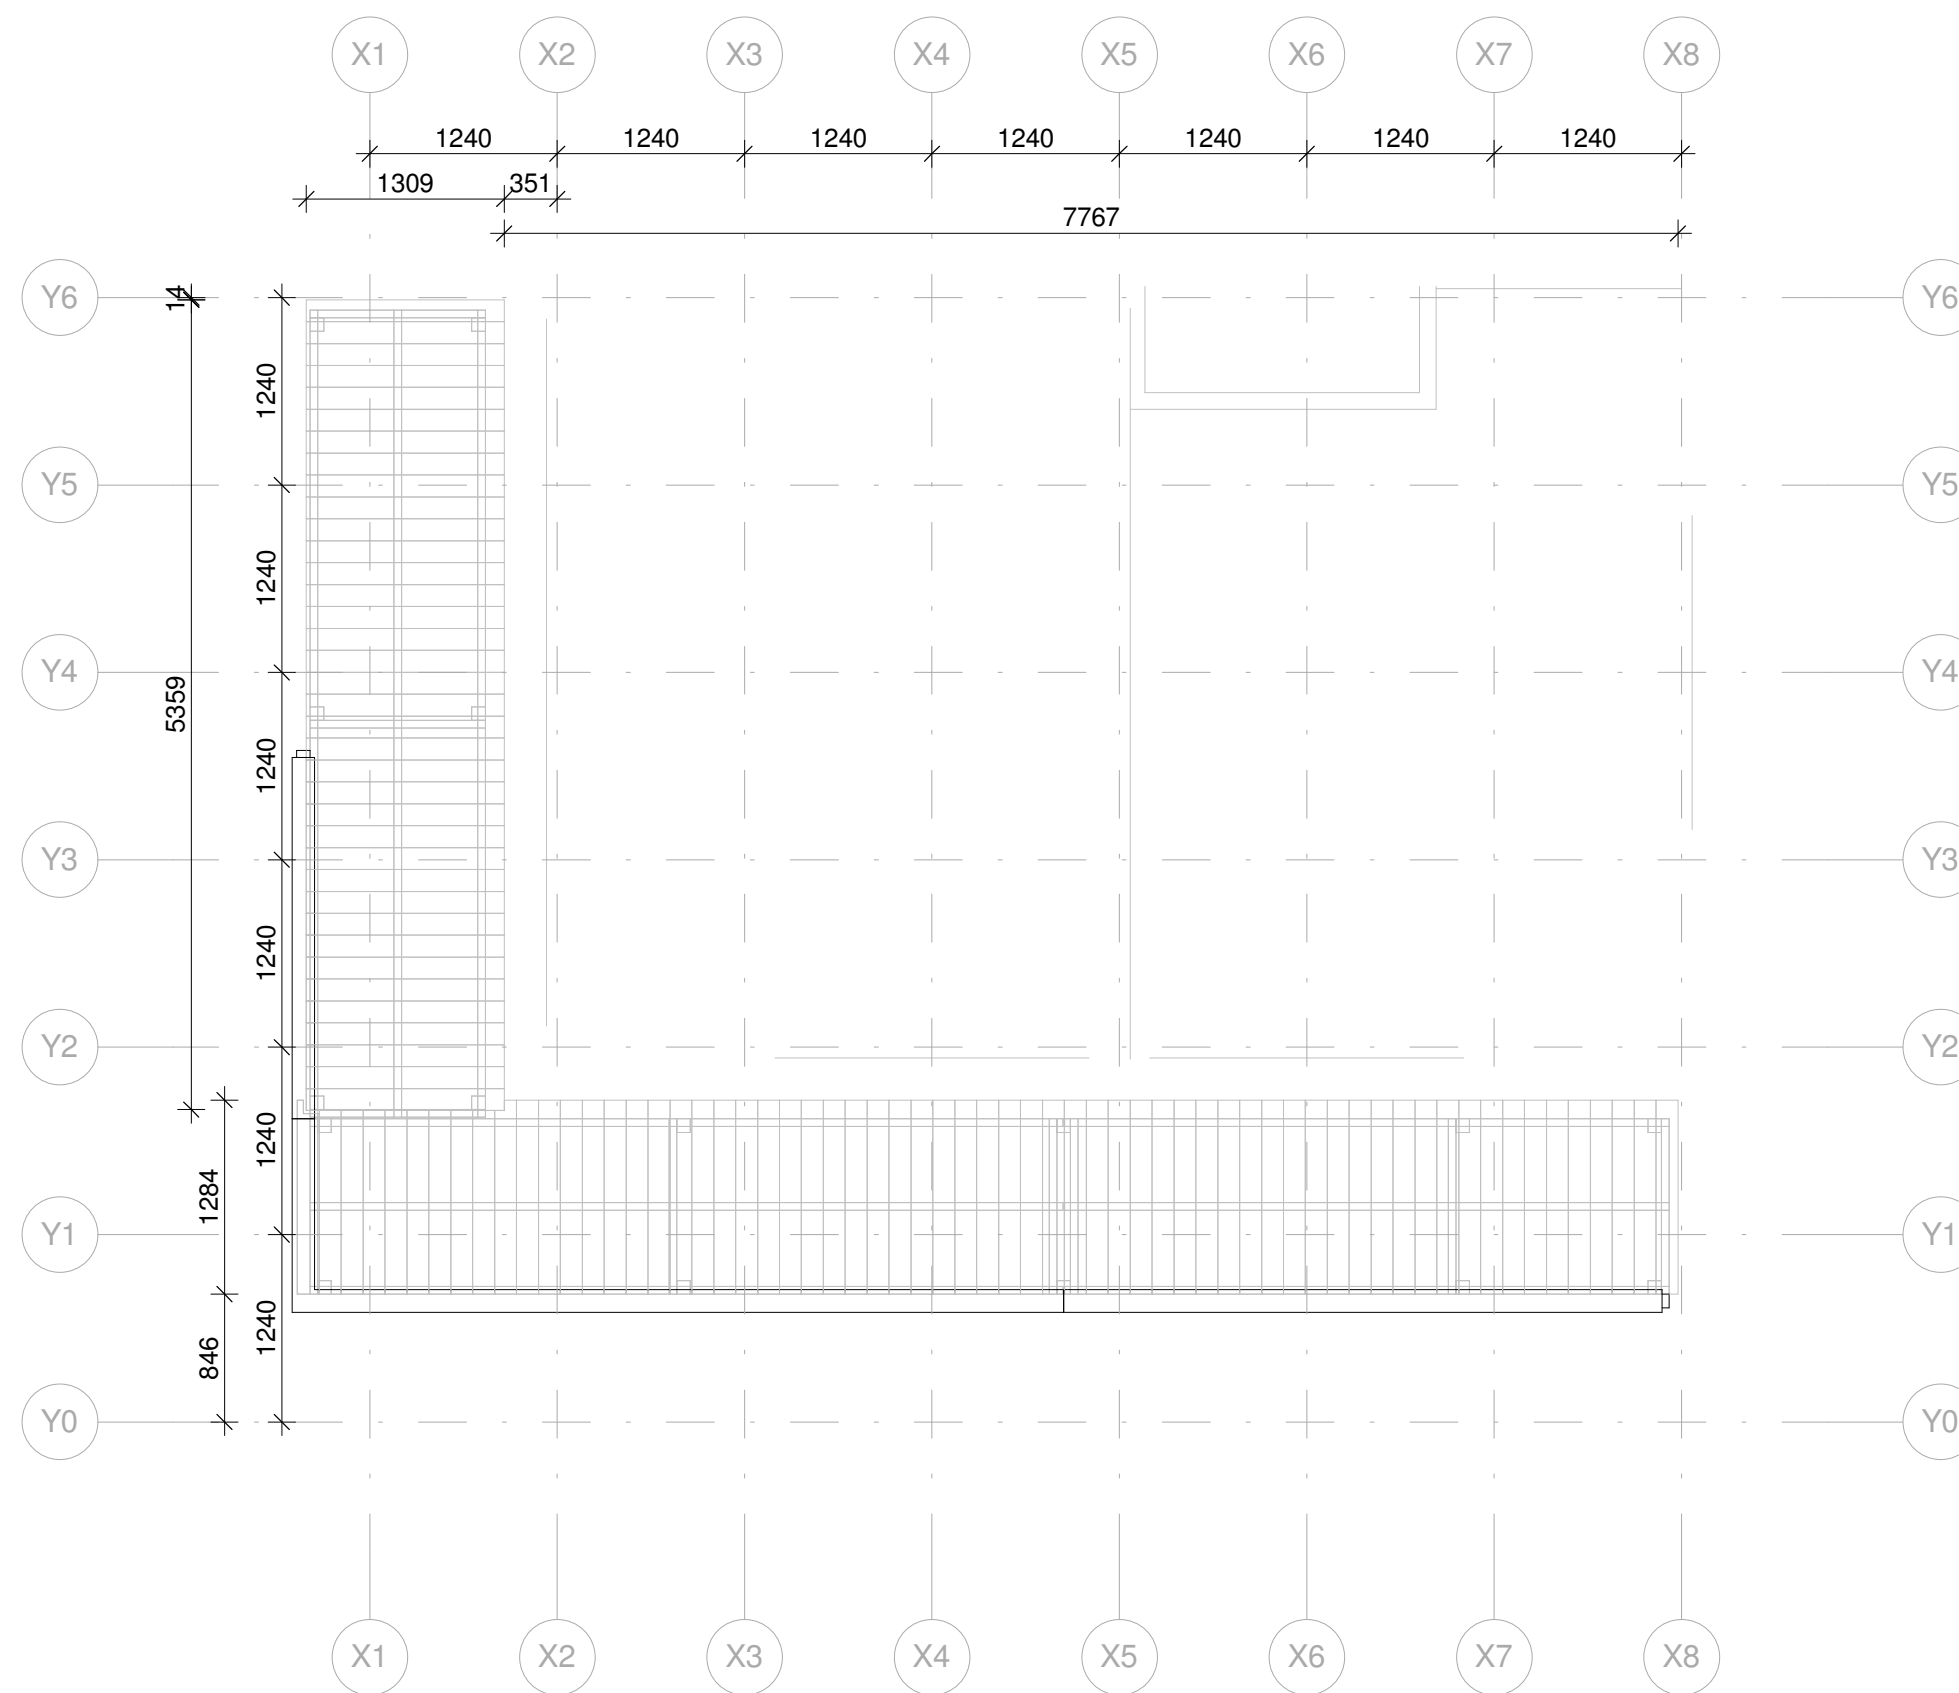

FLOORPLAN DECK KITCHEN
1 : 50



TEAM NAME: Selficient
ADDRESS: Padualaan 99
3584 CH Utrecht
CONTACT: info@selficient.org
www.selficient.org

CONSULTANTS
ARCHITECTURE
ENGINEERS
LANDSCAPING
SAFETY FIRST CODE CONSULTANTS

CLIENT
U.S. DEPARTMENT OF ENERGY
SOLAR DECATHLON 2017
WWW.SOLARDECATHLON.GOV



0	17-11-2016	90% revision
---	------------	--------------

MARK	DATE	DESCRIPTION
------	------	-------------

LOT NUMBER: 106
DRAWN BY: Author
CHECKED BY: Selficient
COPYRIGHT: NONE; PROJECT IS PUBLIC DOMAIN

SCALE: As indicated

SHEET TITLE


STRUCTURAL DECK OVERVIEW

S-362



TEAM NAME: Selficient
 ADDRESS: Padualaan 99
 3584 CH Utrecht
 CONTACT: info@selficient.org
 www.selficient.org

CONSULTANTS
 ARCHITECTURE
 ENGINEERS
 LANDSCAPING
 SAFETY FIRST CODE CONSULTANTS

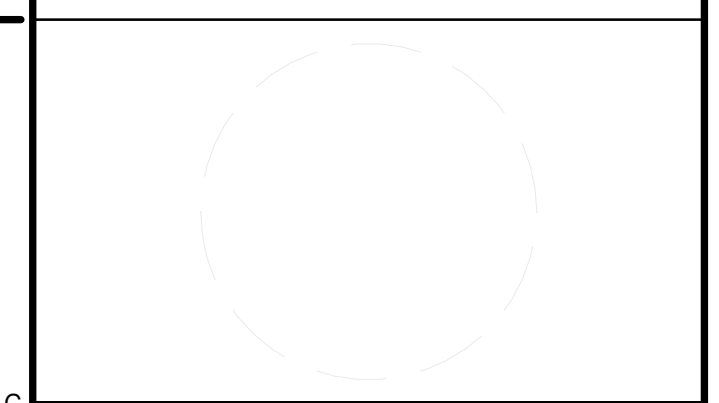

CLIENT
 U.S. DEPARTMENT OF ENERGY
 SOLAR DECATHLON 2017
 WWW.SOLARDECATHLON.GOV







MARK	DATE	DESCRIPTION
0	17-11-2016	90% revision



LOT NUMBER: 106
 DRAWN BY: R. Bultman
 CHECKED BY: Selficient
 COPYRIGHT: NONE; PROJECT IS PUBLIC DOMAIN
 SCALE: 1:5

SHEET TITLE
 RAMP PLAN DETAIL


S-400

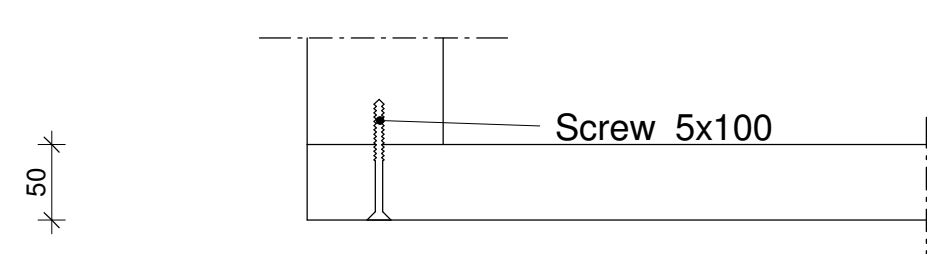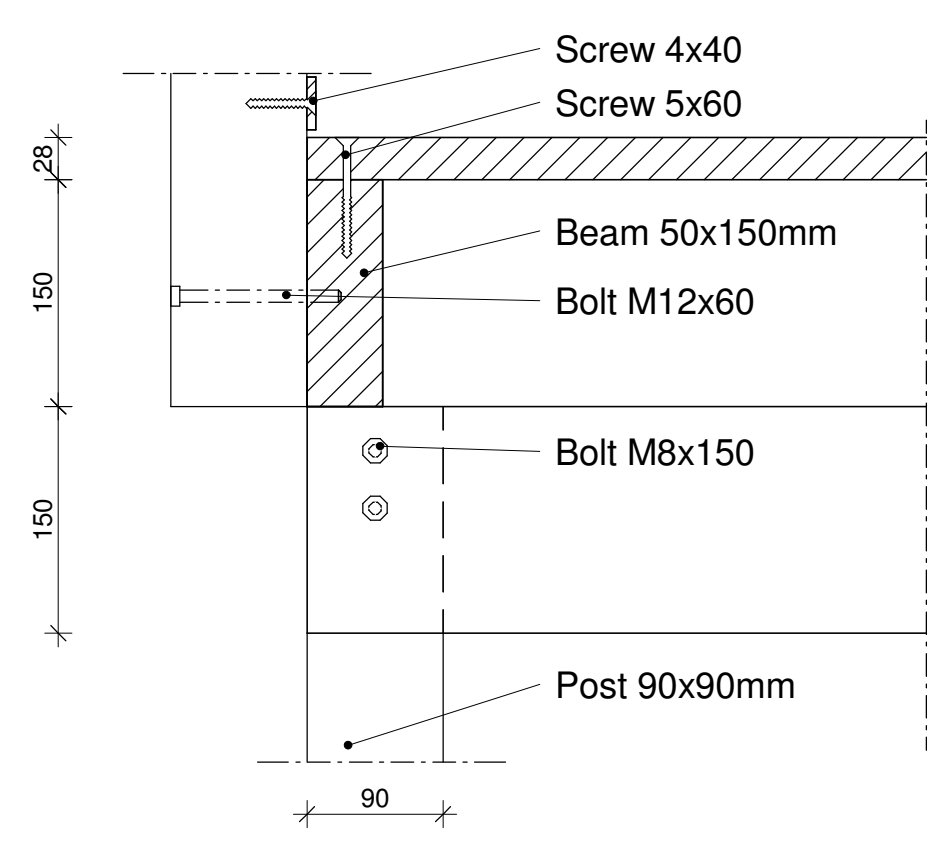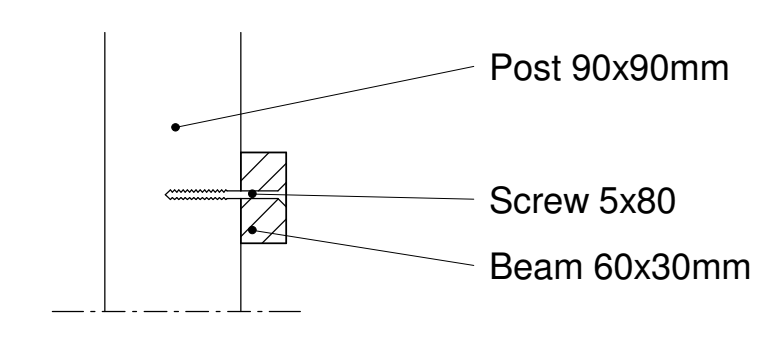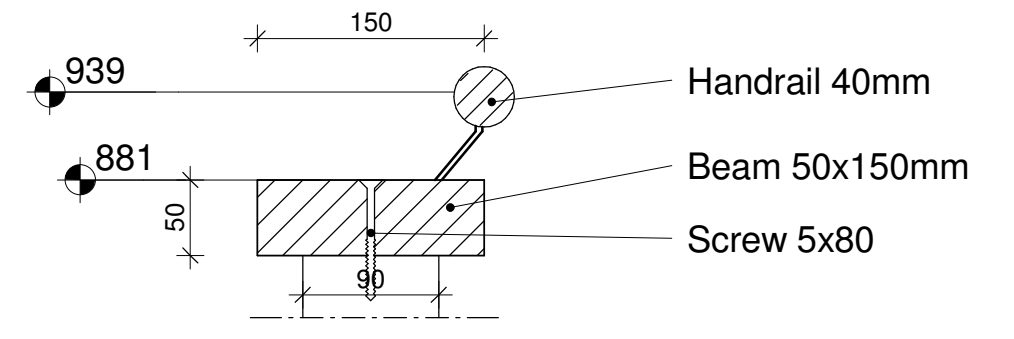


RAMP DETAIL 1
 1:5

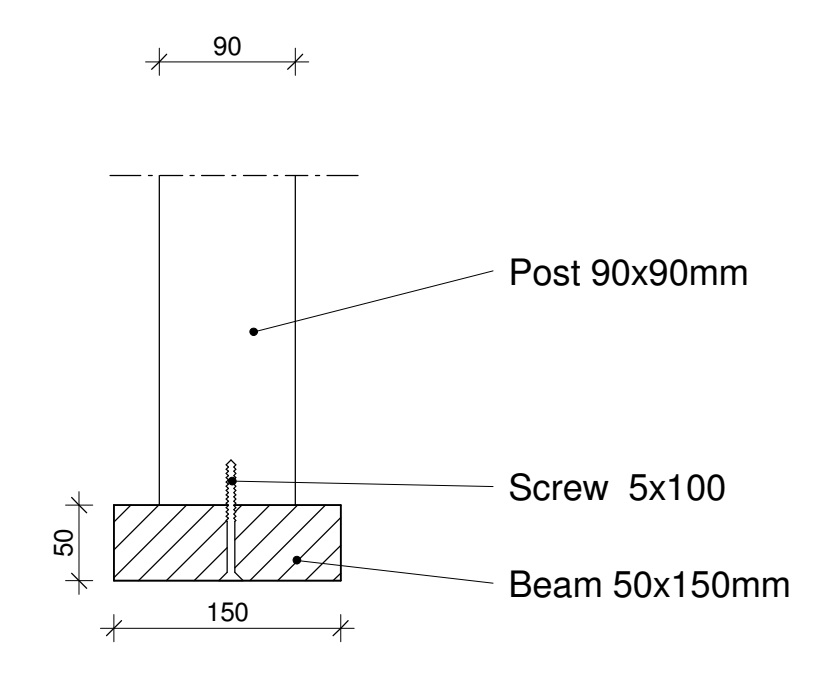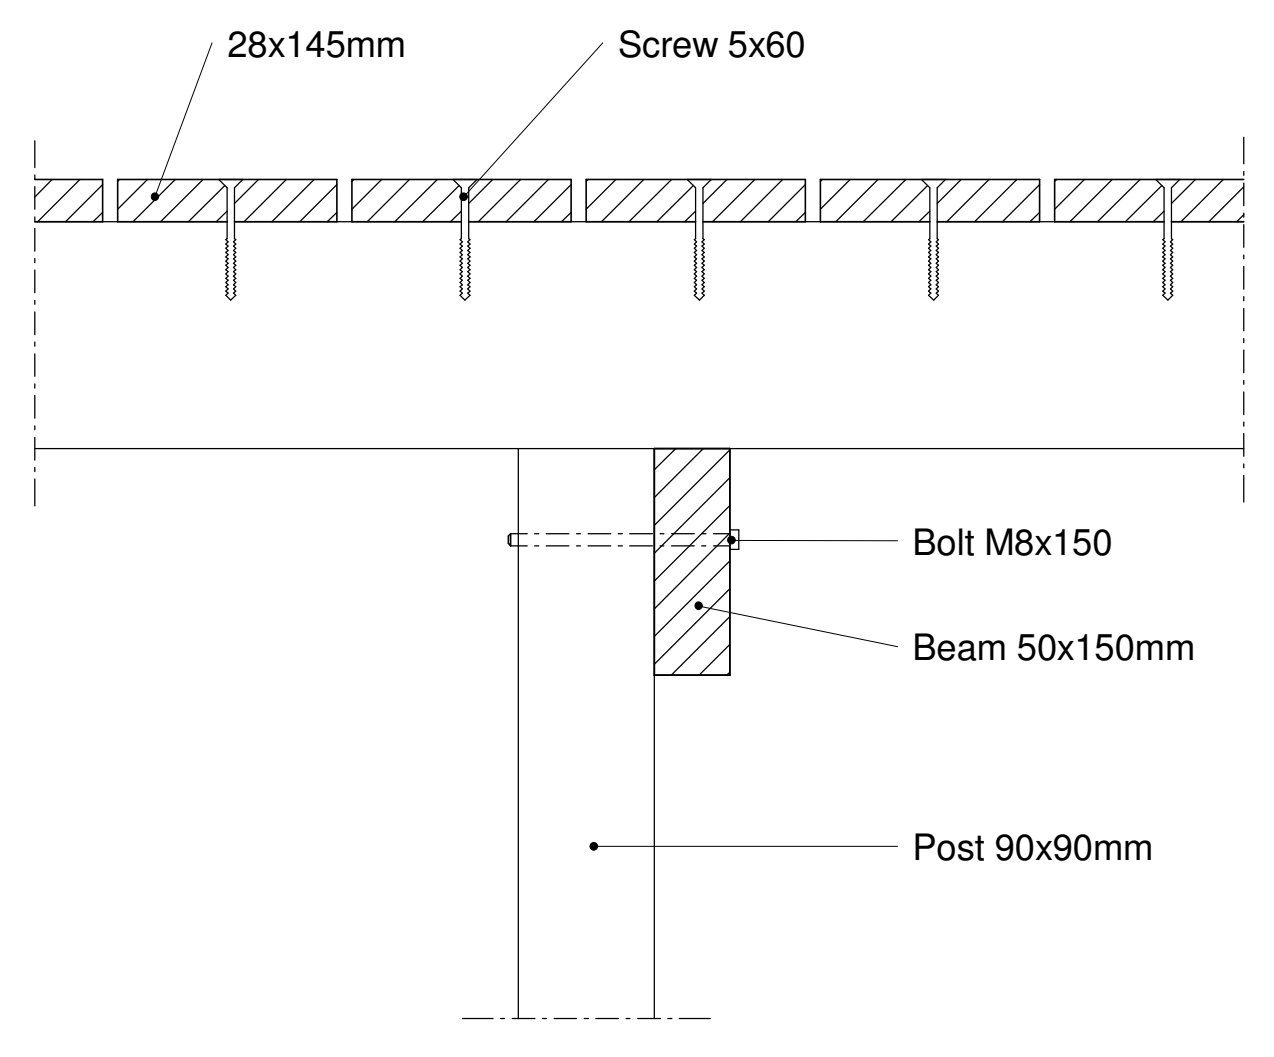

RAMP DETAIL 2
 1:5

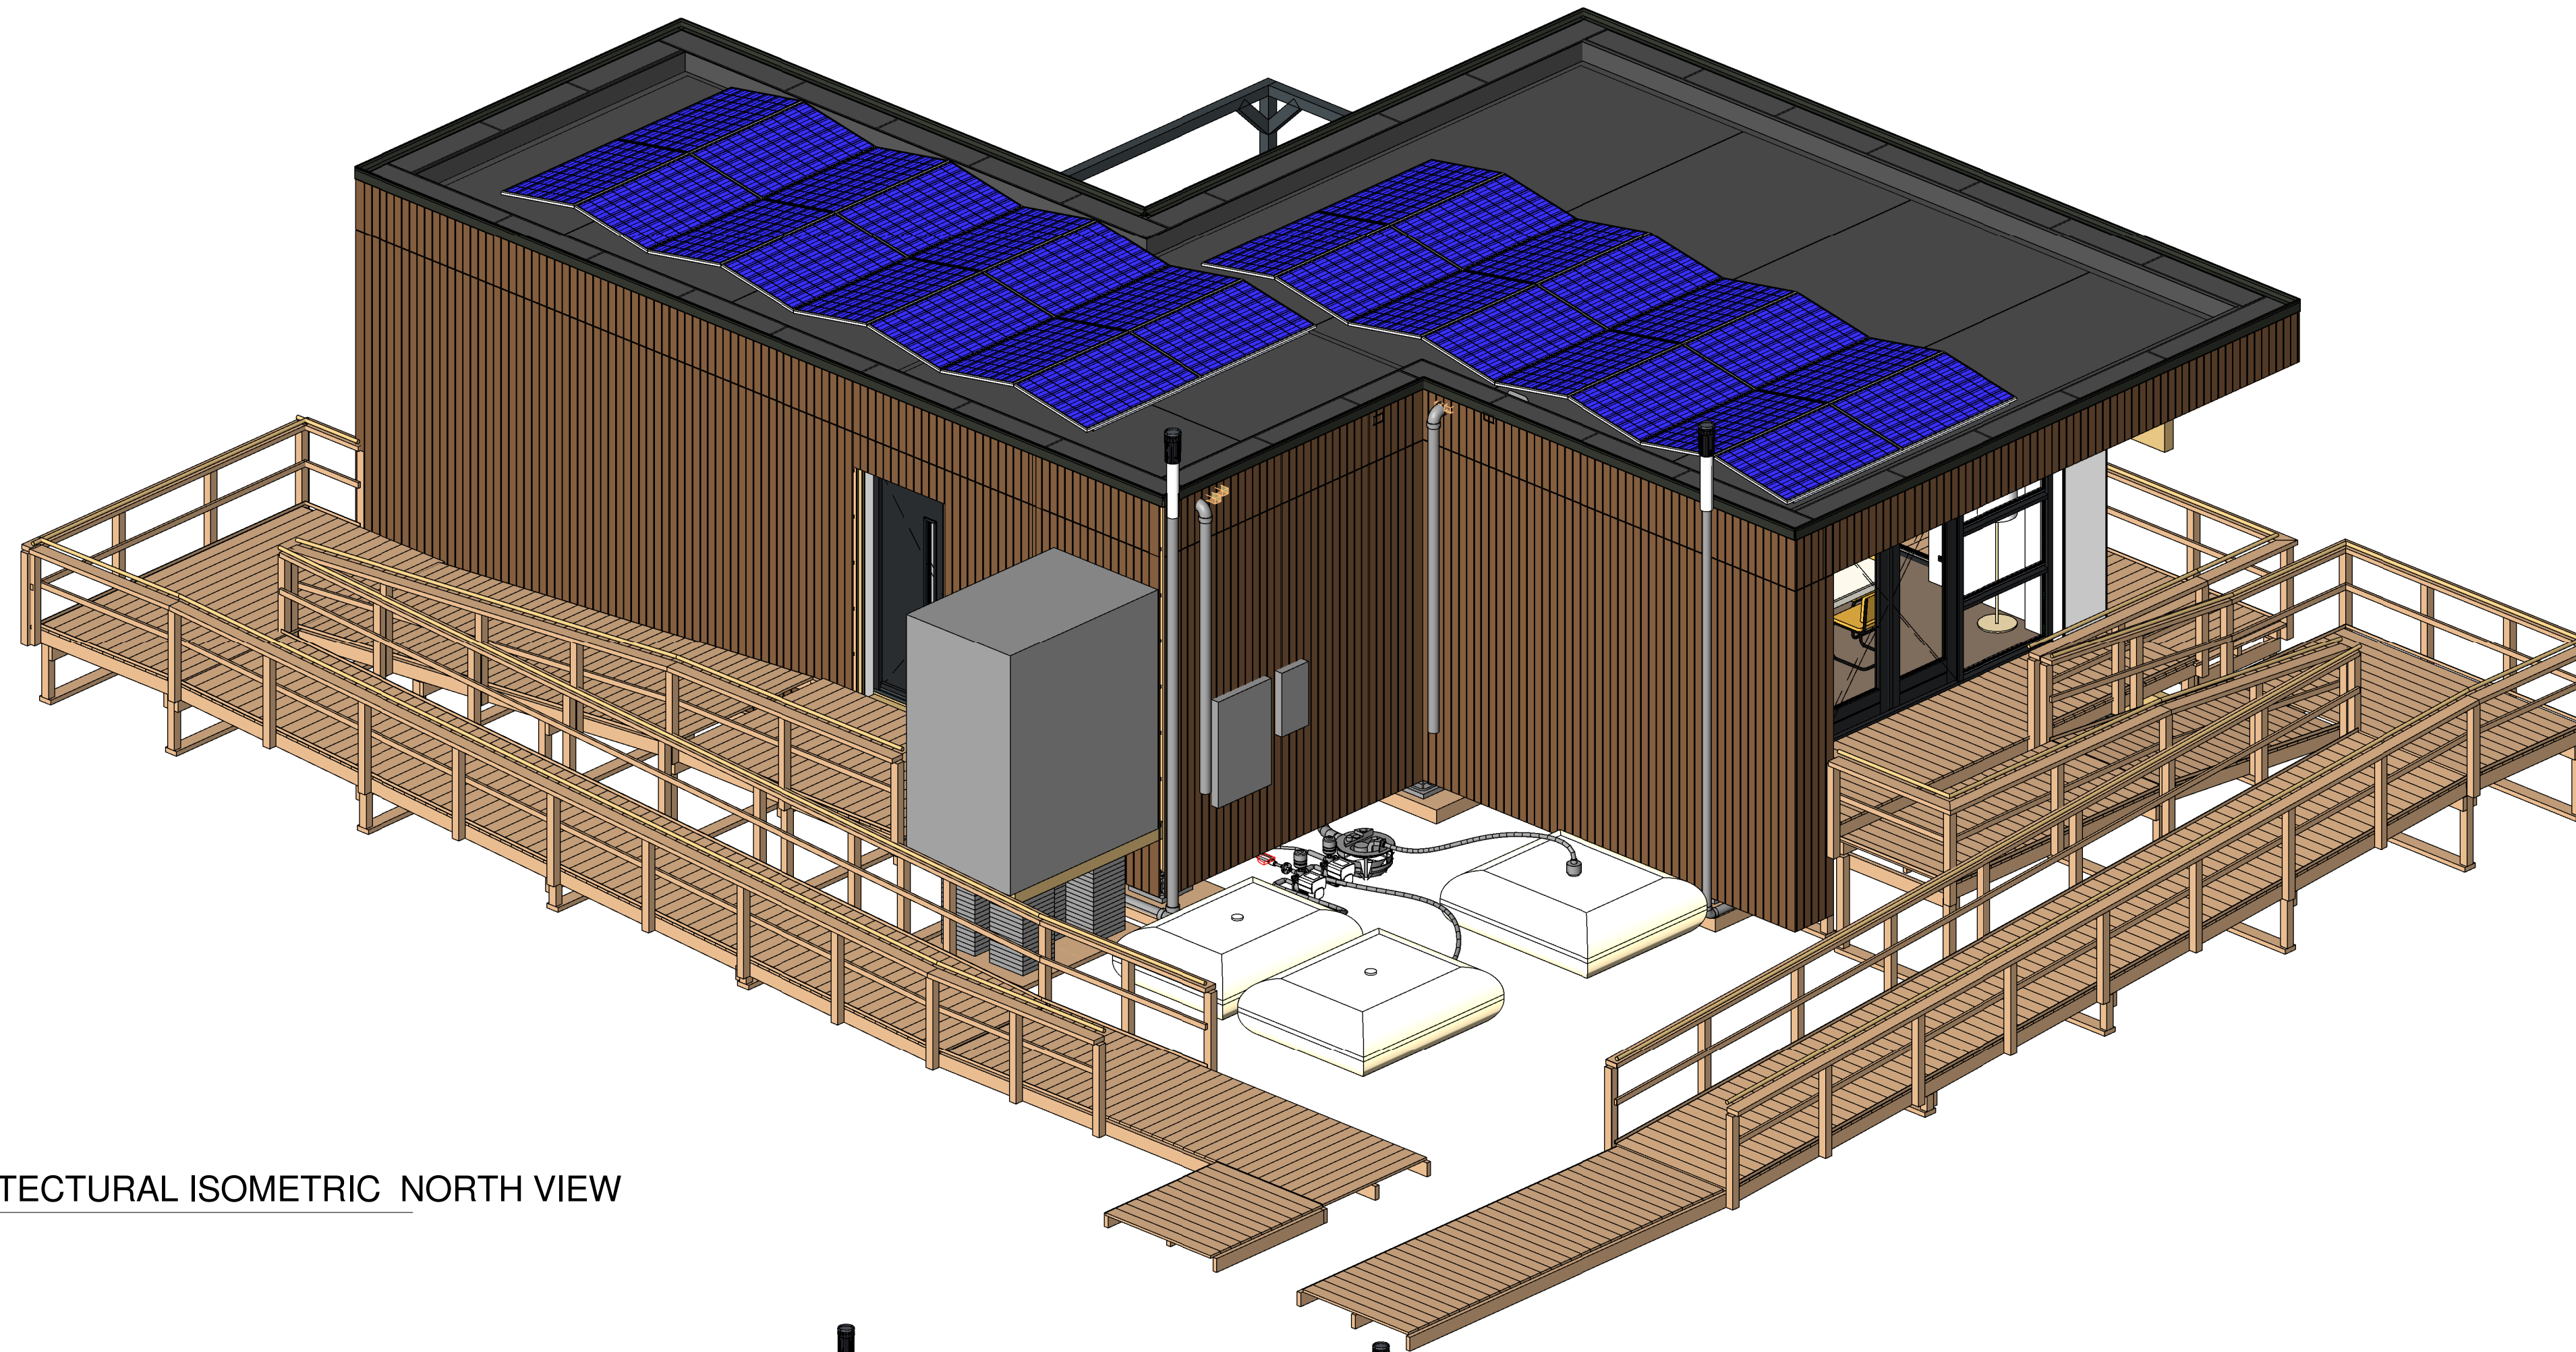

ARCHITECTURAL ISOMETRIC NORTH VIEW

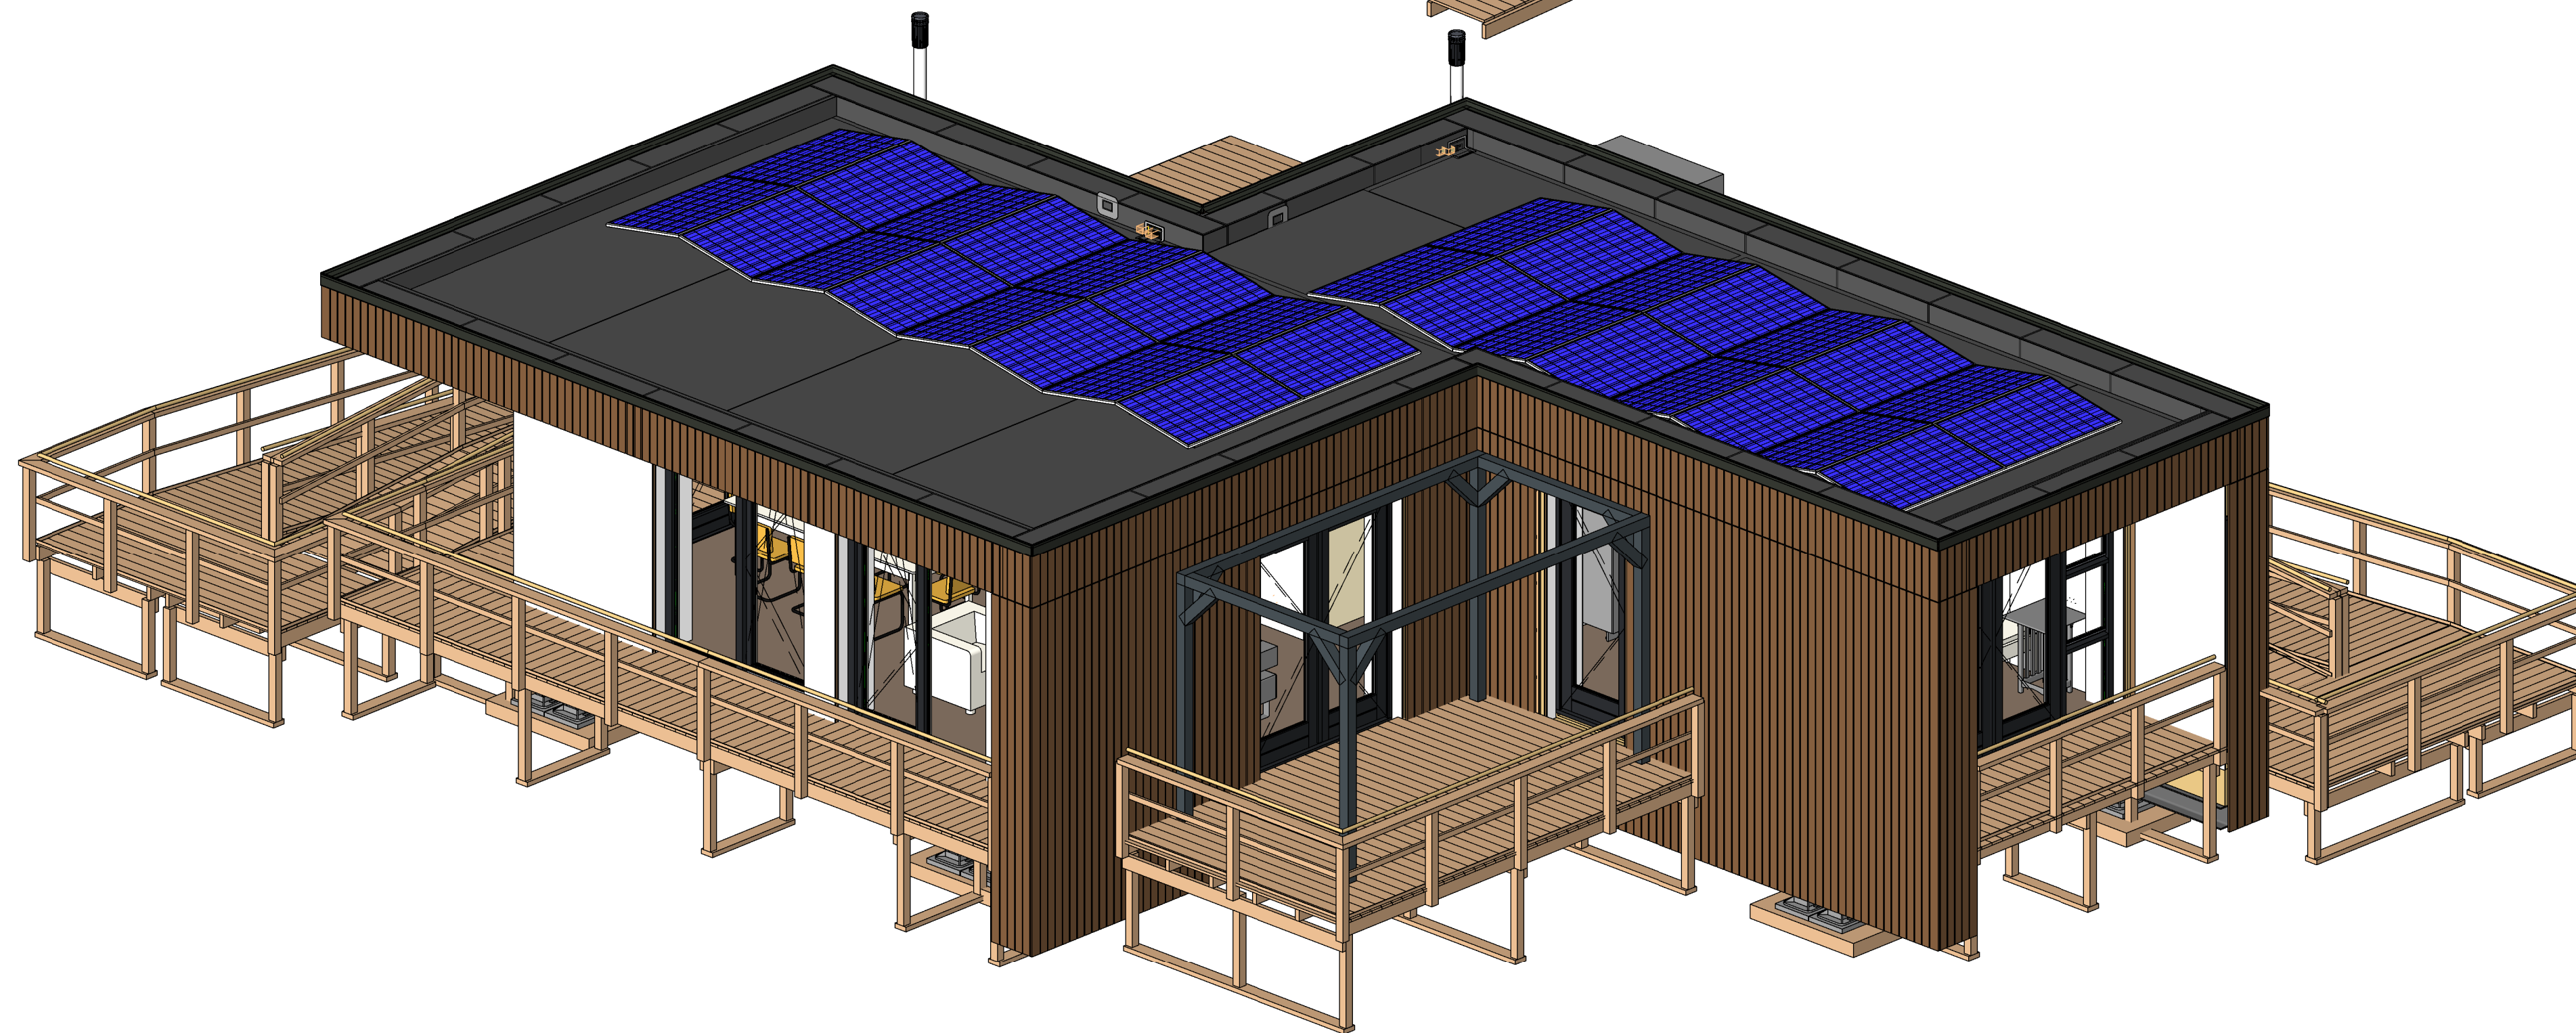

ARCHITECTURAL ISOMETRIC SOUTH VIEW



TEAM NAME: Selficient
 ADDRESS: Padualaan 99
 3584 CH Utrecht
 CONTACT: info@selficient.org
 www.selficient.org

CONSULTANTS
 ARCHITECTURE
 ENGINEERS
 LANDSCAPING
 SAFETY FIRST CODE CONSULTANTS

CLIENT
 U.S. DEPARTMENT OF ENERGY
 SOLAR DECATHLON 2017
 WWW.SOLARDECATHLON.GOV



0 17-11-2016 90% revision


MARK	DATE	DESCRIPTION
------	------	-------------

LOT NUMBER: 106
 DRAWN BY: Author
 CHECKED BY: Selficient
 COPYRIGHT: NONE; PROJECT IS PUBLIC DOMAIN

SCALE:
 SHEET TITLE

ARCHITECTURAL
 ISOMETRIC

A-100

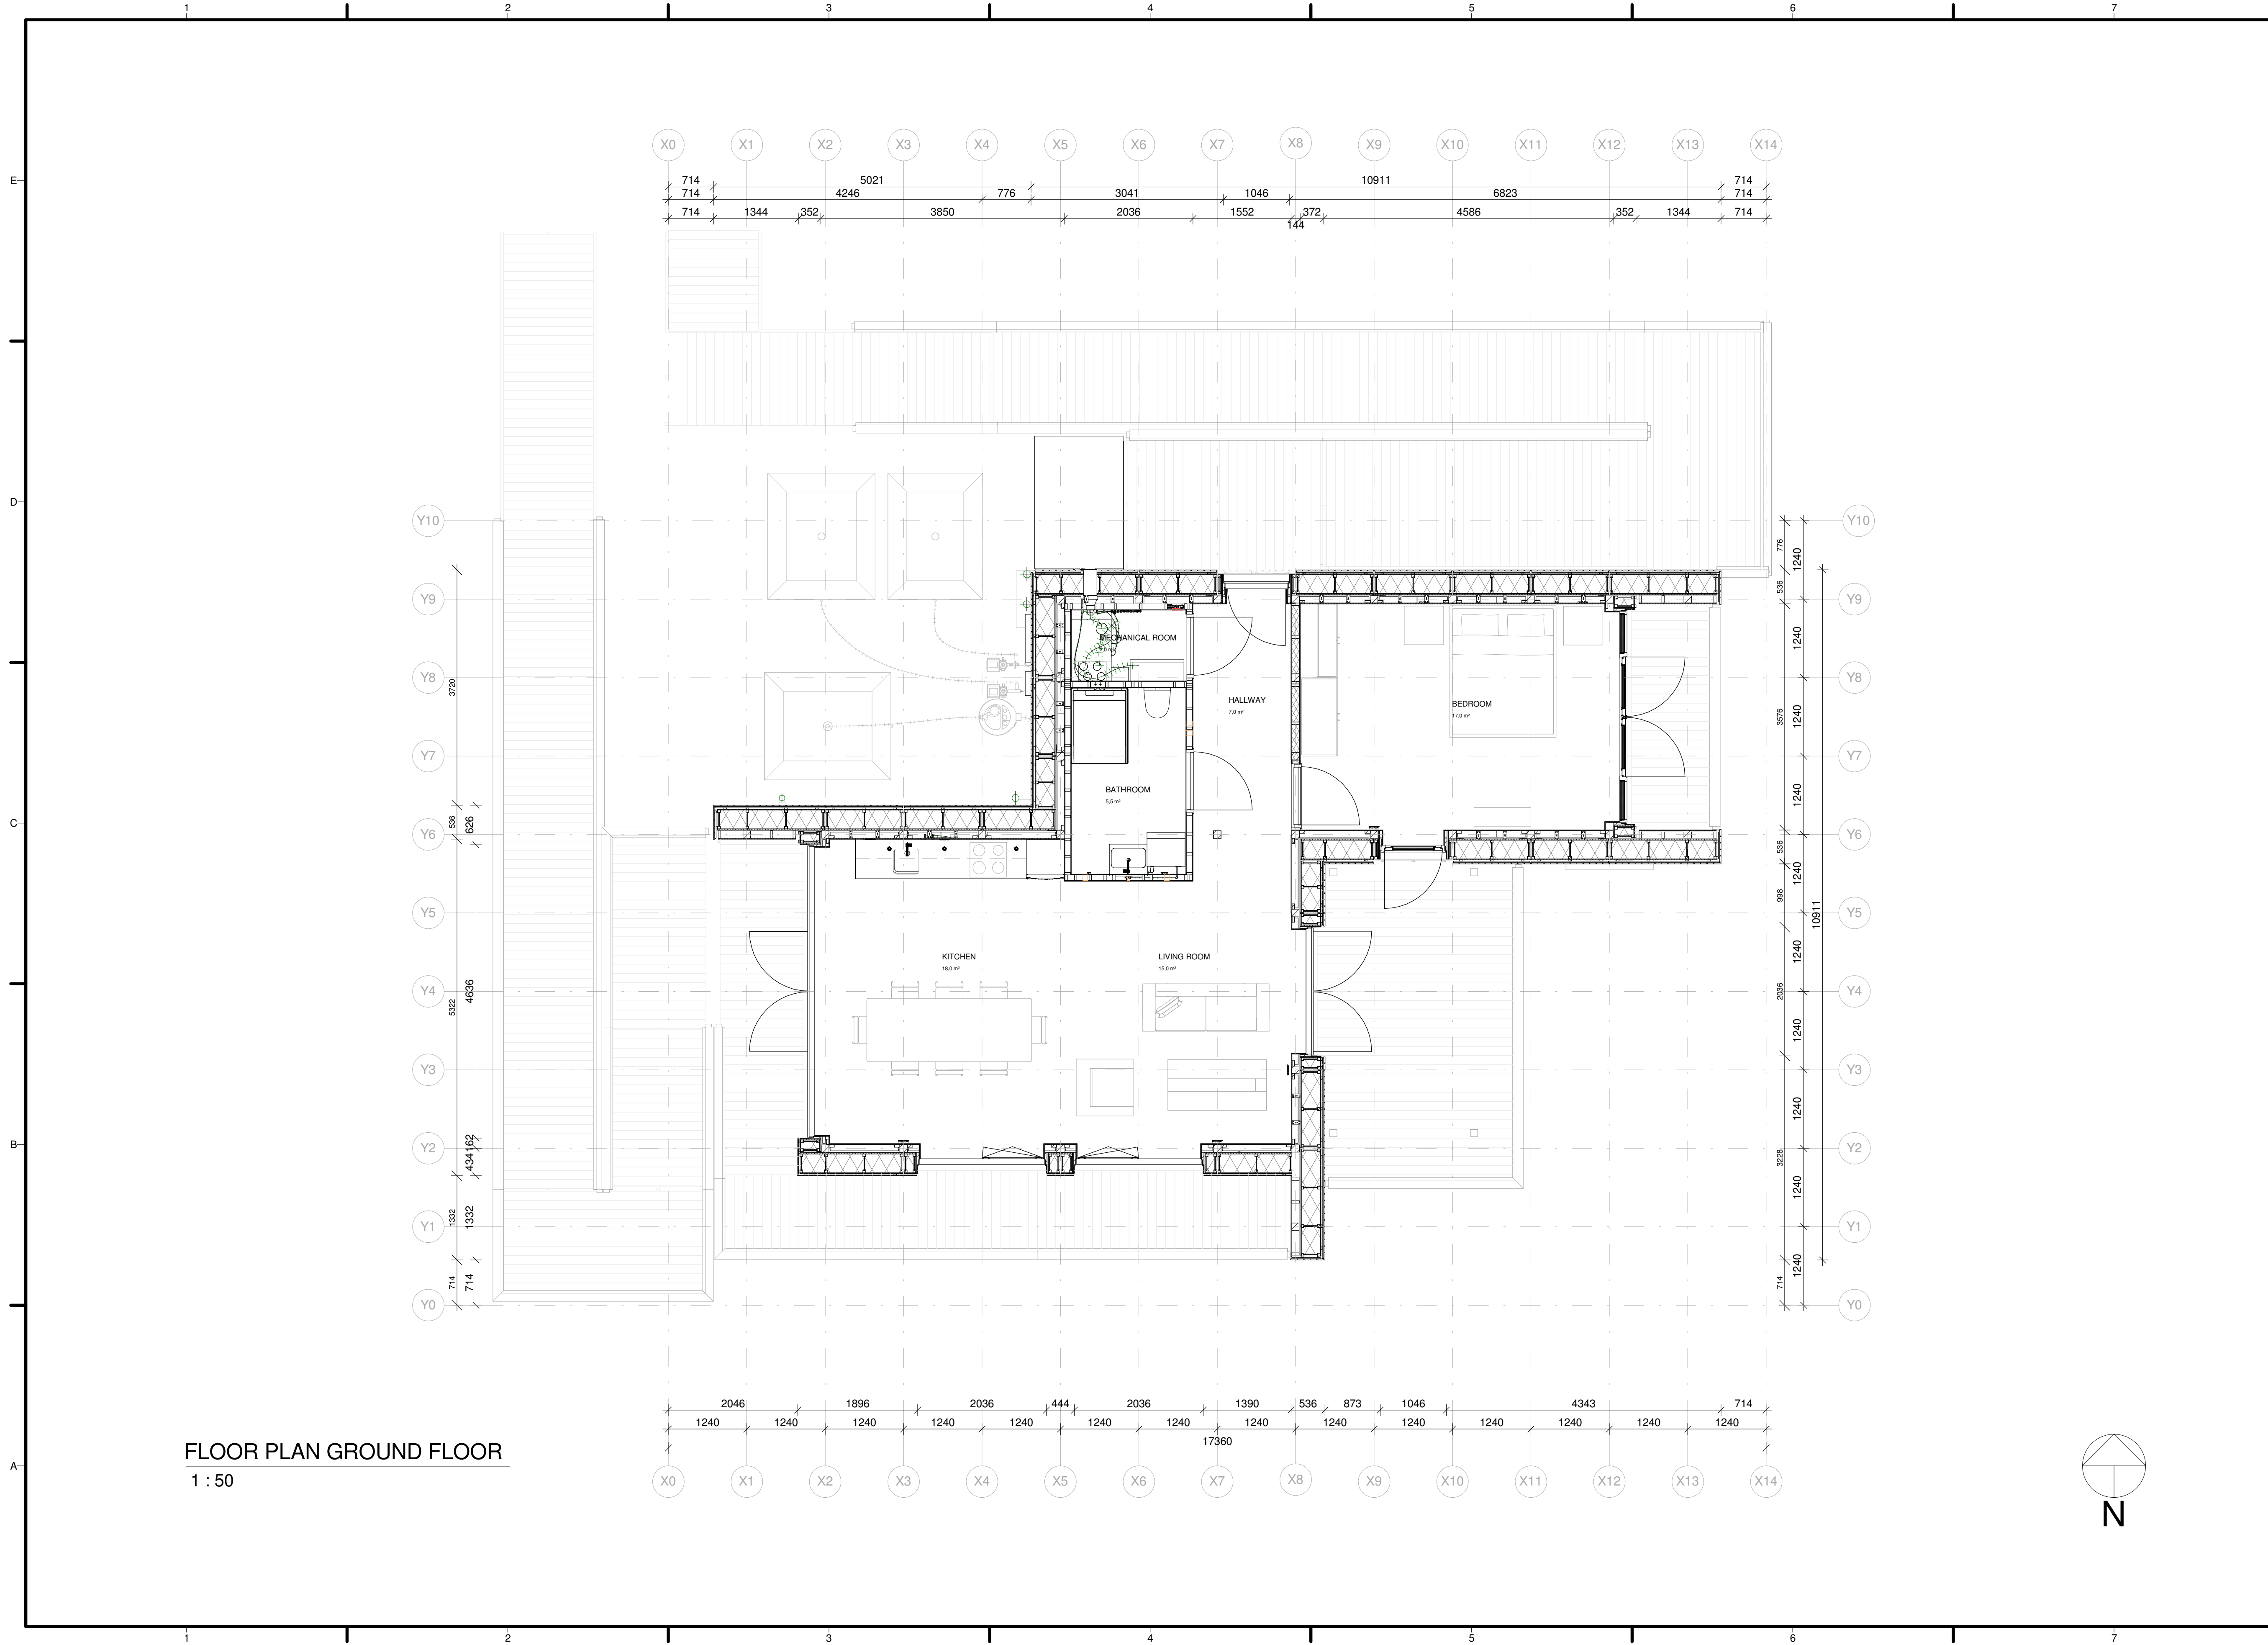

FLOOR PLAN GROUND FLOOR
1 : 50



TEAM NAME: Selficient
 ADDRESS: Padualaan 99
 3584 CH Utrecht
 CONTACT: info@selficient.org
 www.selficient.org

CONSULTANTS
 ARCHITECTURE
 ENGINEERS
 LANDSCAPING
 SAFETY FIRST CODE CONSULTANTS

CLIENT
 U.S. DEPARTMENT OF ENERGY
 SOLAR DECATHLON 2017
 WWW.SOLARDECATHLON.GOV




MARK	DATE	DESCRIPTION
0	17-11-2016	90% revision

LOT NUMBER: 106
 DRAWN BY: Author
 CHECKED BY: Selficient
 COPYRIGHT: NONE; PROJECT IS PUBLIC DOMAIN

SCALE: 1 : 50

SHEET TITLE
 FLOOR PLAN GROUND FLOOR

A-200

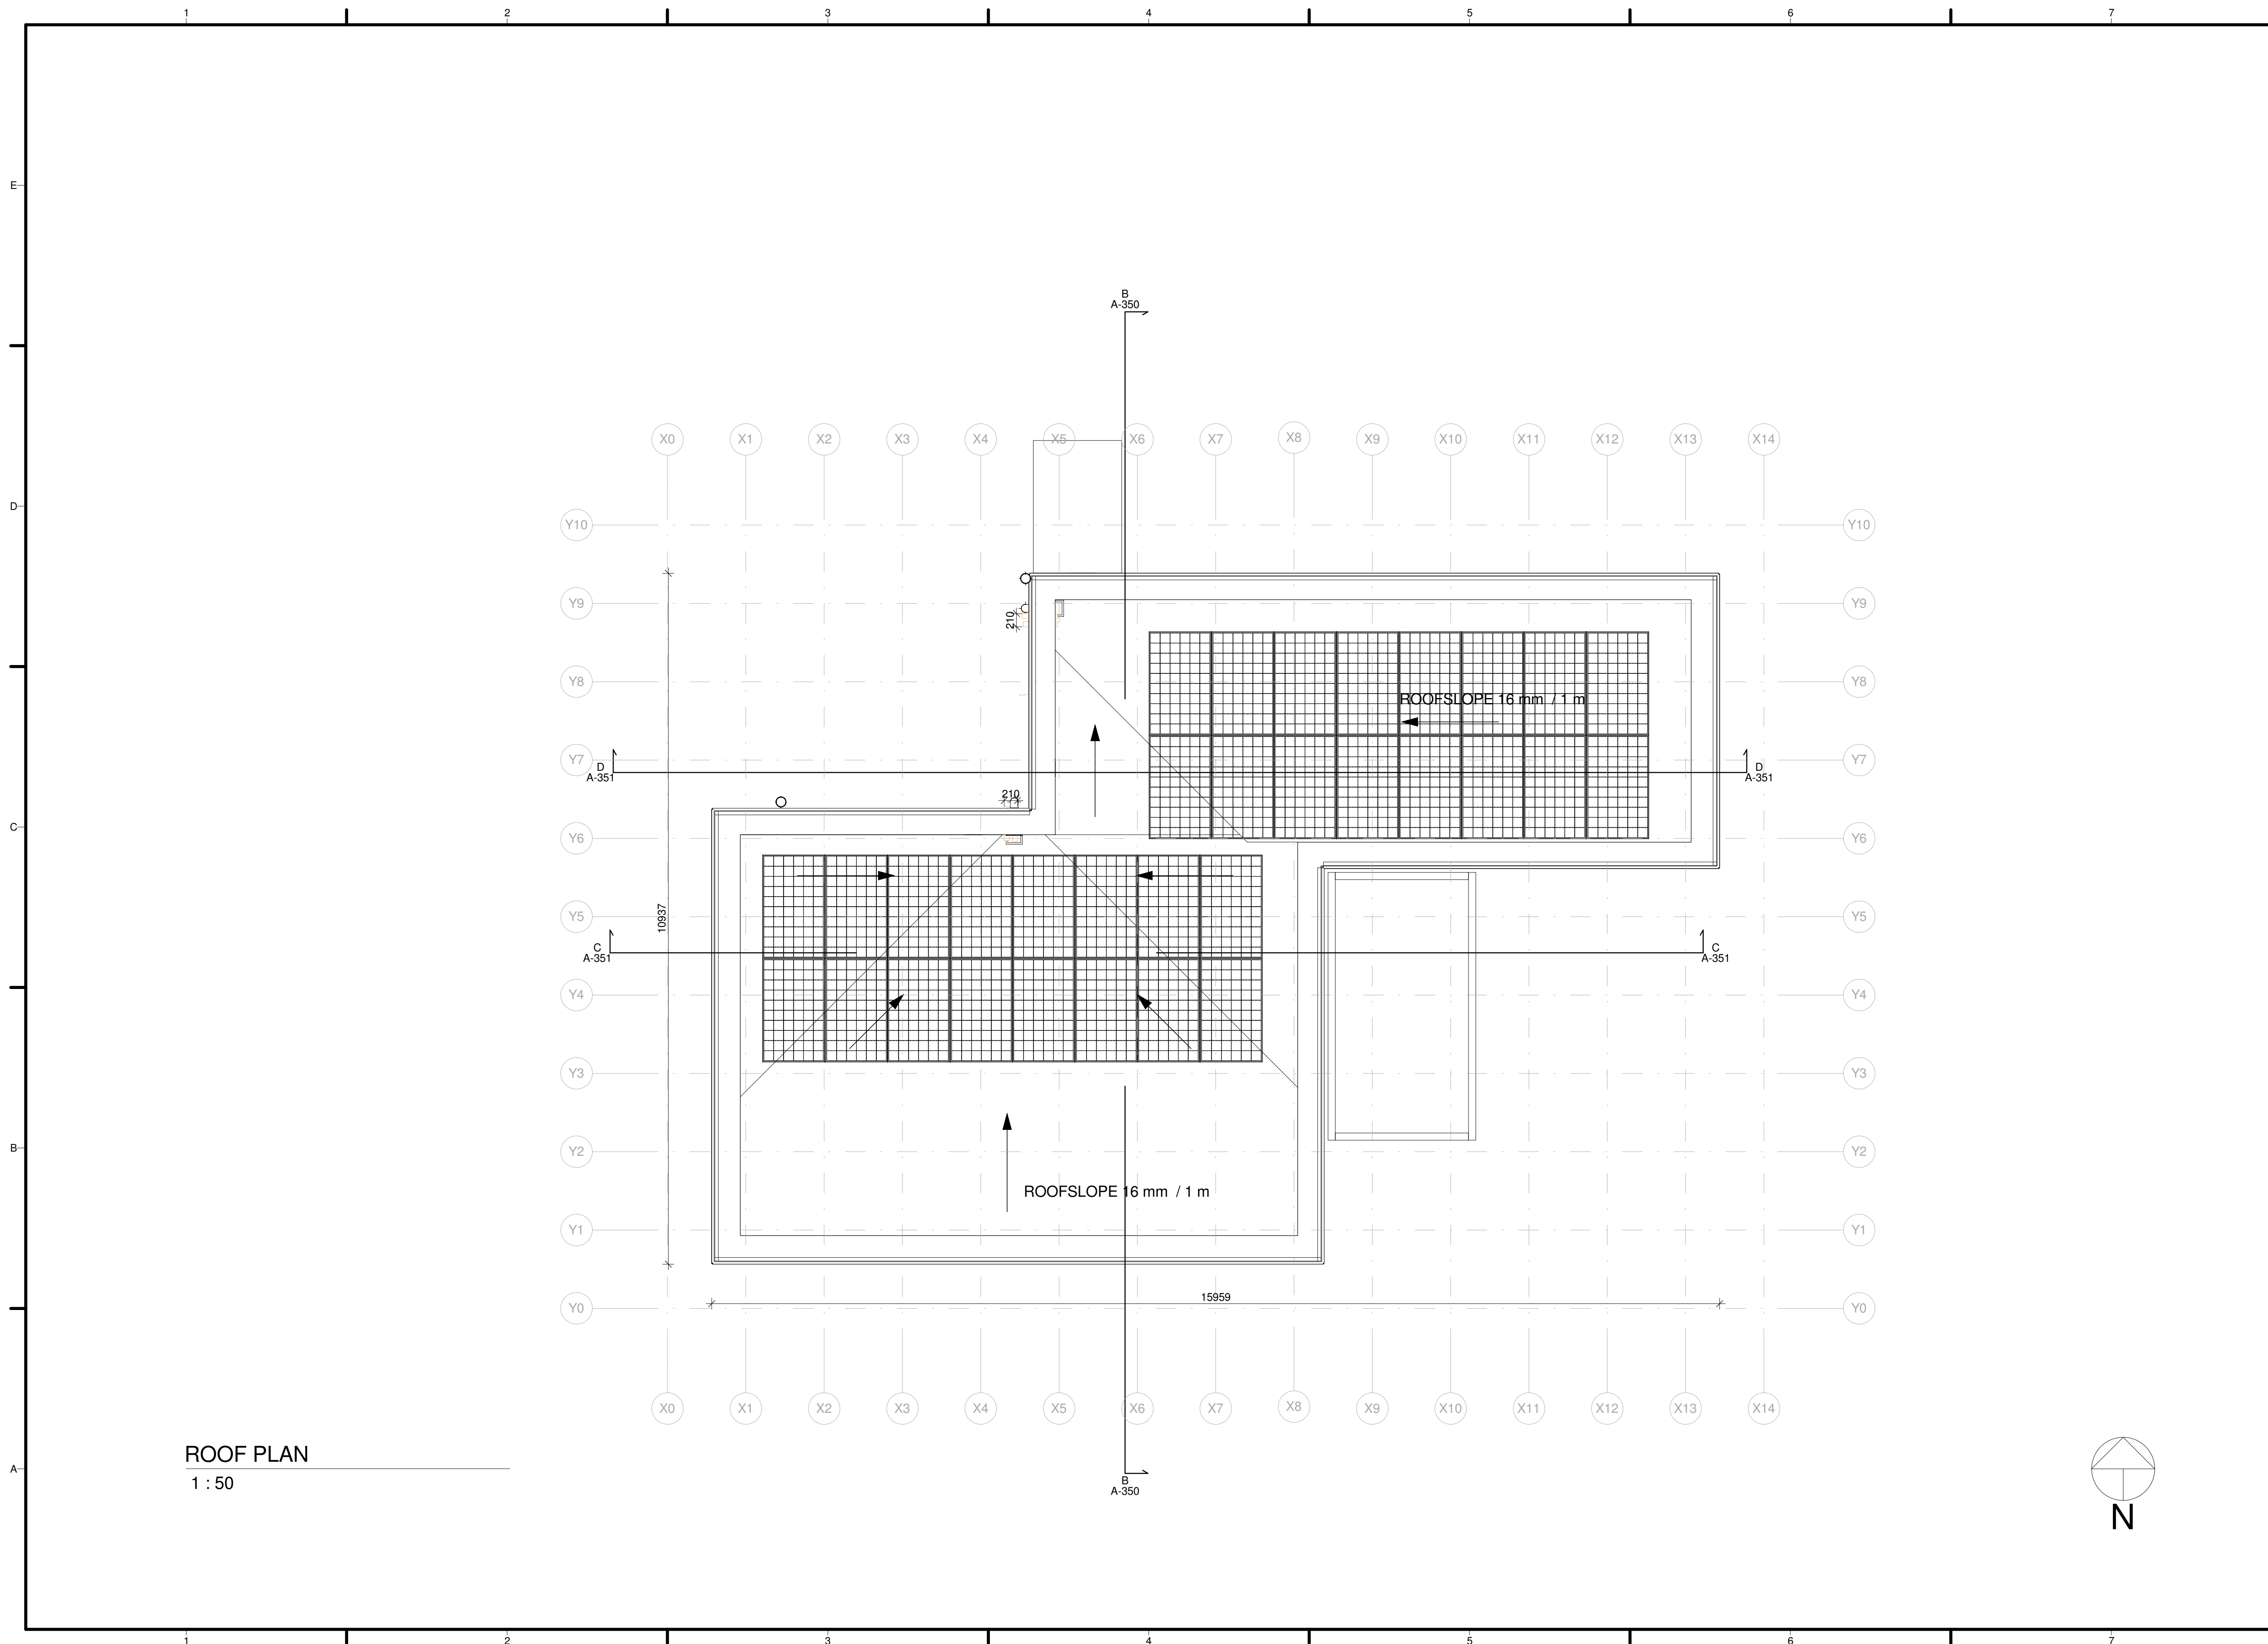

ROOF PLAN
1 : 50



TEAM NAME: Selficient
 ADDRESS: Padualaan 99
 3584 CH Utrecht
 CONTACT: info@selficient.org
 www.selficient.org

CONSULTANTS
 ARCHITECTURE
 ENGINEERS
 LANDSCAPING
 SAFETY FIRST CODE CONSULTANTS



CLIENT
 U.S. DEPARTMENT OF ENERGY
 SOLAR DECATHLON 2017
 WWW.SOLARDECATHLON.GOV



0	17-11-2016	90% revision

MARK	DATE	DESCRIPTION
------	------	-------------


LOT NUMBER: 106
 DRAWN BY: Author
 CHECKED BY: Selficient
 COPYRIGHT: NONE; PROJECT IS PUBLIC DOMAIN

SCALE: 1 : 50

SHEET TITLE

ROOF PLAN





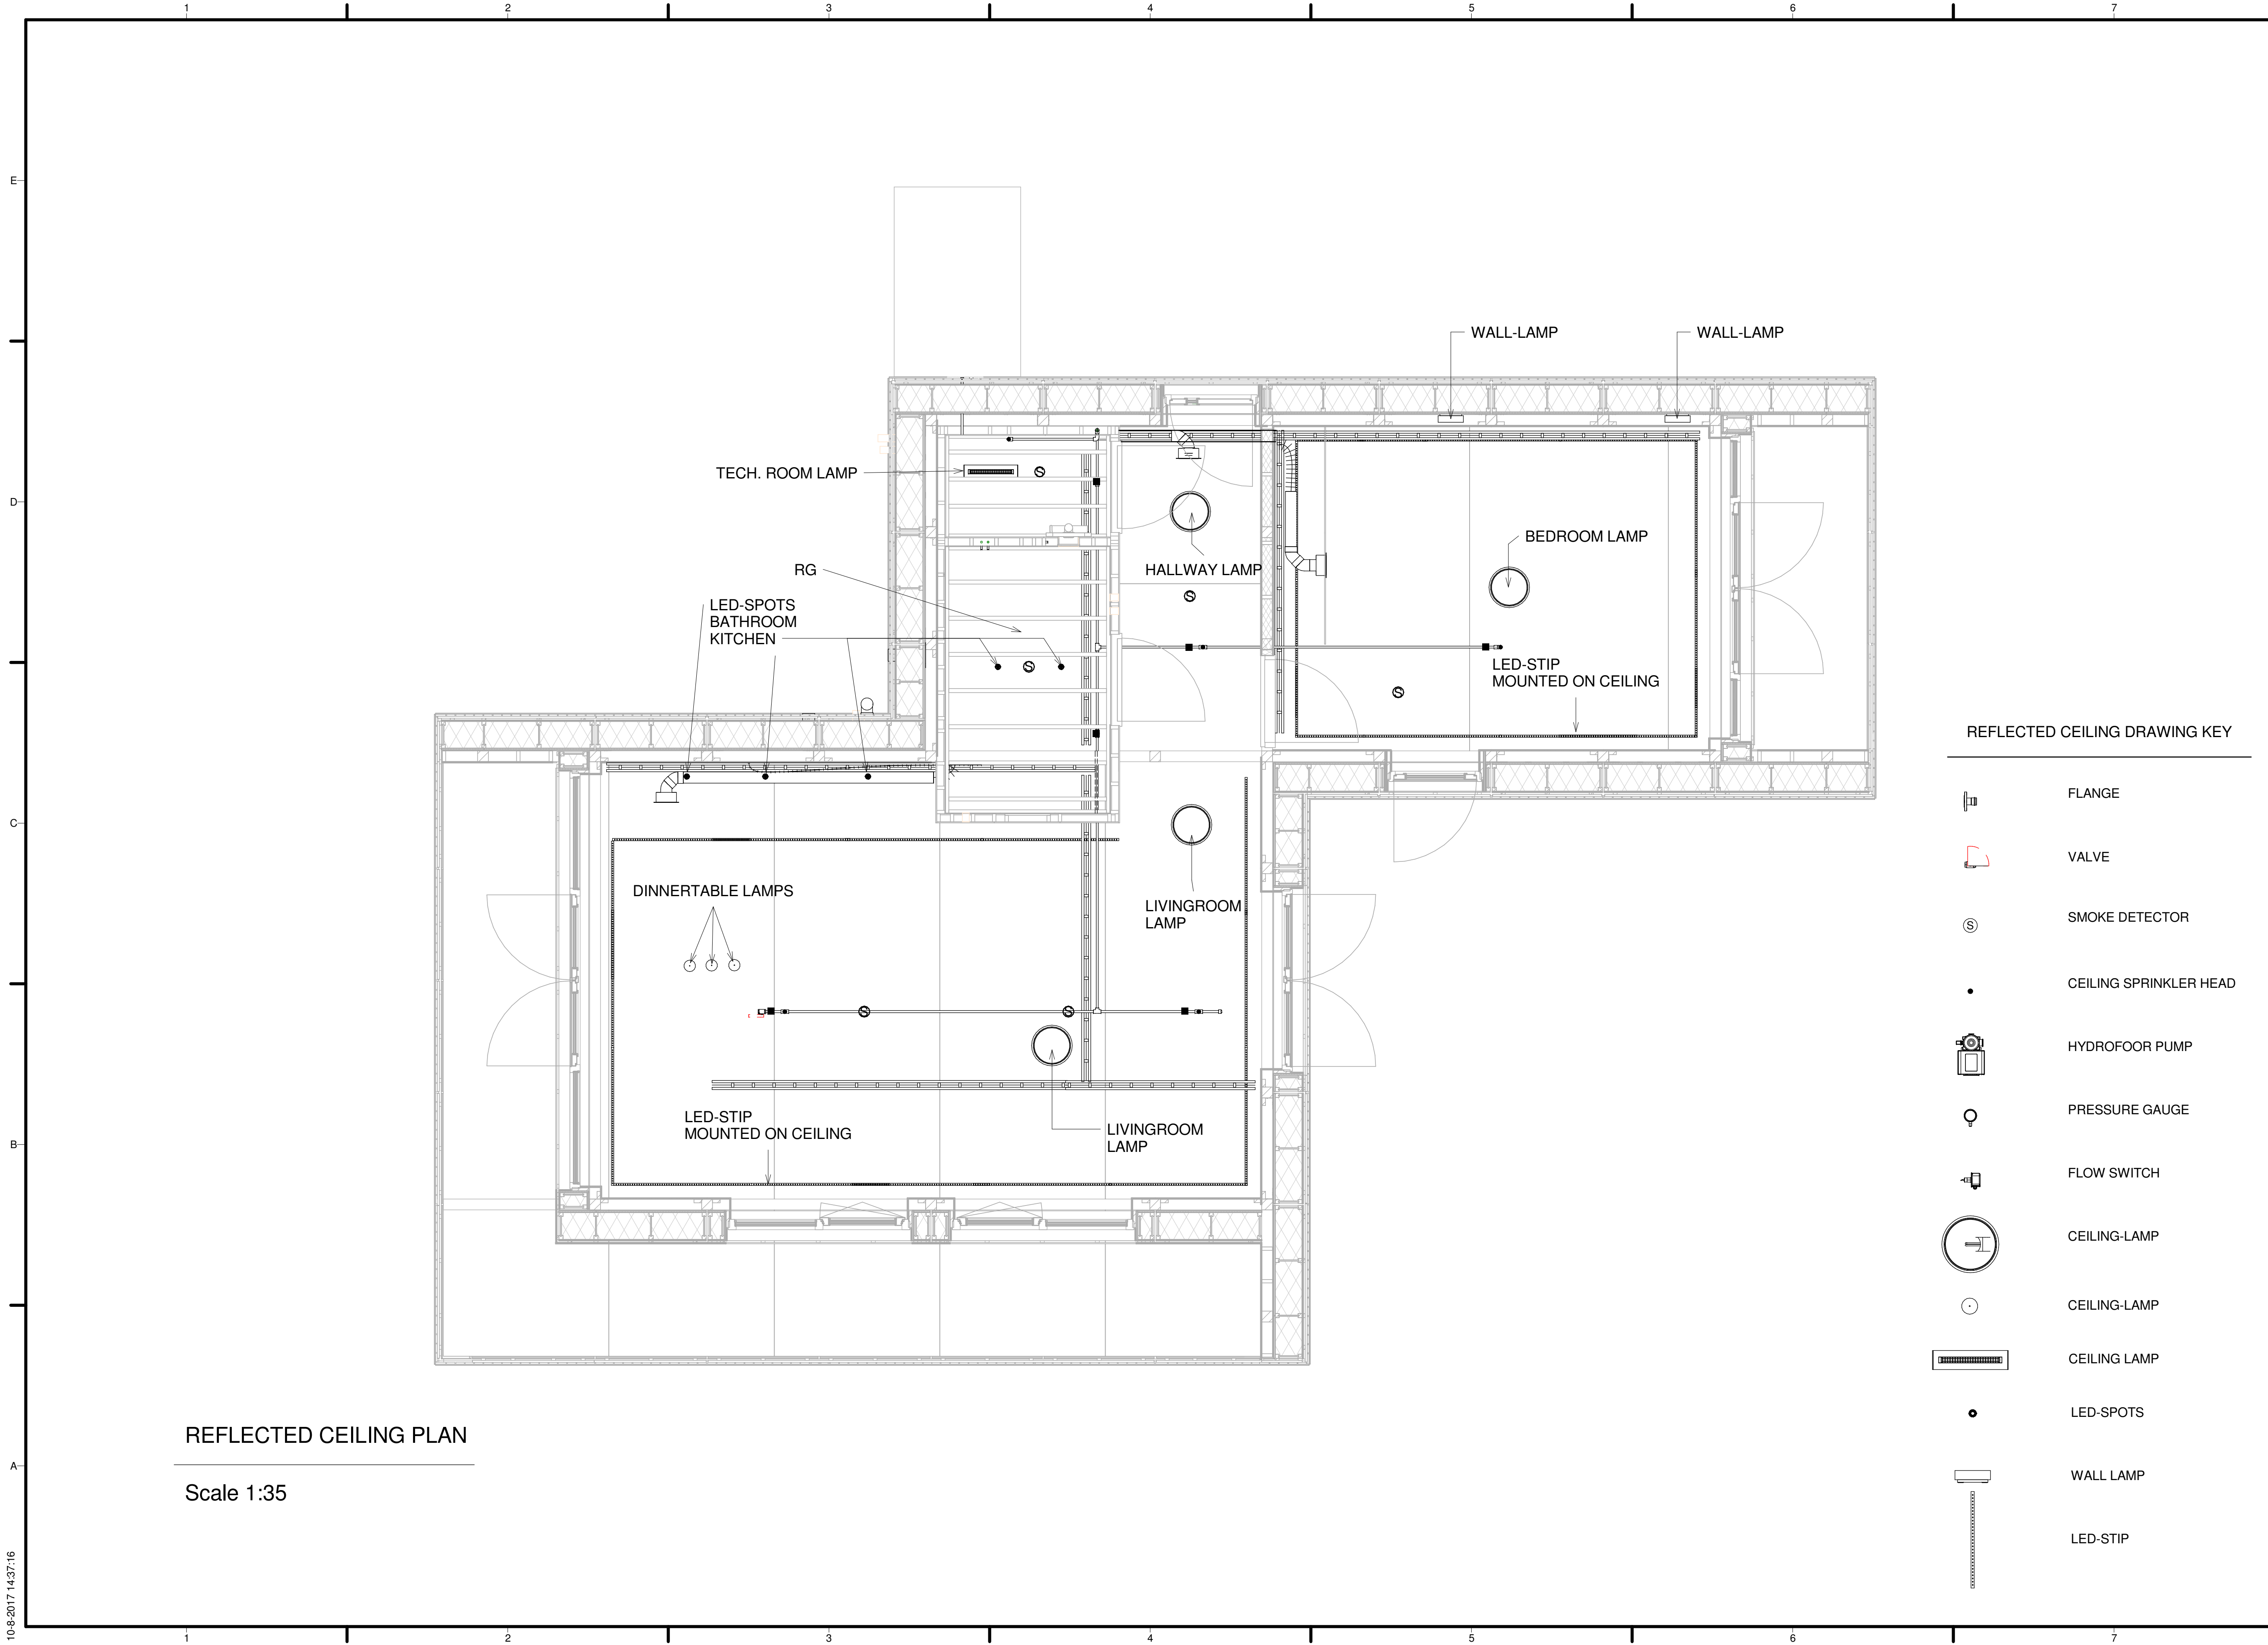



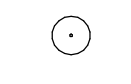
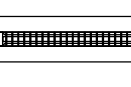



A-201

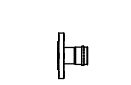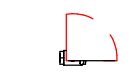

REFLECTED CEILING PLAN

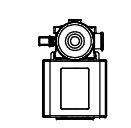Scale 1:35

REFLECTED CEILING DRAWING KEY

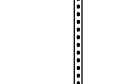-  FLANGE
-  VALVE
-  SMOKE DETECTOR
-  CEILING SPRINKLER HEAD
-  HYDROFOOR PUMP
-  PRESSURE GAUGE
-  FLOW SWITCH
-  CEILING-LAMP
-  CEILING-LAMP
-  CEILING LAMP
-  LED-SPOTS
-  WALL LAMP
-  LED-STIP



TEAM NAME: Selficient
 ADDRESS: Padualaan 99
 3584CH Utrecht
 The Netherlands
 CONTACT: info@selficient.org
 www.selficient.org

CONSULTANTS
 ARCHITECTURE
 ENGINEERS
 LANDSCAPING
 SAFETY FIRST CODE CONSULTANTS

CLIENT
 U.S. DEPARTMENT OF ENERGY
 SOLAR DECATHLON 2017
 WWW.SOLARDECATHLON.GOV



Rev.	DATE	DESCRIPTION
Rev.00	02-24-2017	ADD. CEILING PLAN
Rev.01	08-08-2017	UPDATED CEILING PLAN

LOT NUMBER: 106
 DRAWN BY: Kars Slagter
 CHECKED BY: Remco Polle
 COPYRIGHT: NONE; PROJECT IS PUBLIC DOMAIN

SHEET TITLE
 REFLECTED CEILING PLAN

A-202

10-8-2017 14:37:16

TEAM NAME: Selficient
 ADDRESS: Padualaan 99
 3584 CH Utrecht
 CONTACT: info@selficient.org
 www.selficient.org

CONSULTANTS
 ARCHITECTURE
 ENGINEERS
 LANDSCAPING
 SAFETY FIRST CODE CONSULTANTS

CLIENT
 U.S. DEPARTMENT OF ENERGY
 SOLAR DECATHLON 2017
 WWW.SOLARDECATHLON.GOV



0	17-11-2016	90% revision
---	------------	--------------

MARK	DATE	DESCRIPTION
------	------	-------------


LOT NUMBER: 106
 DRAWN BY: Author
 CHECKED BY: Selficient
 COPYRIGHT: NONE; PROJECT IS PUBLIC DOMAIN

SCALE: 1 : 50


SHEET TITLE

ELEVATIONS

A-300

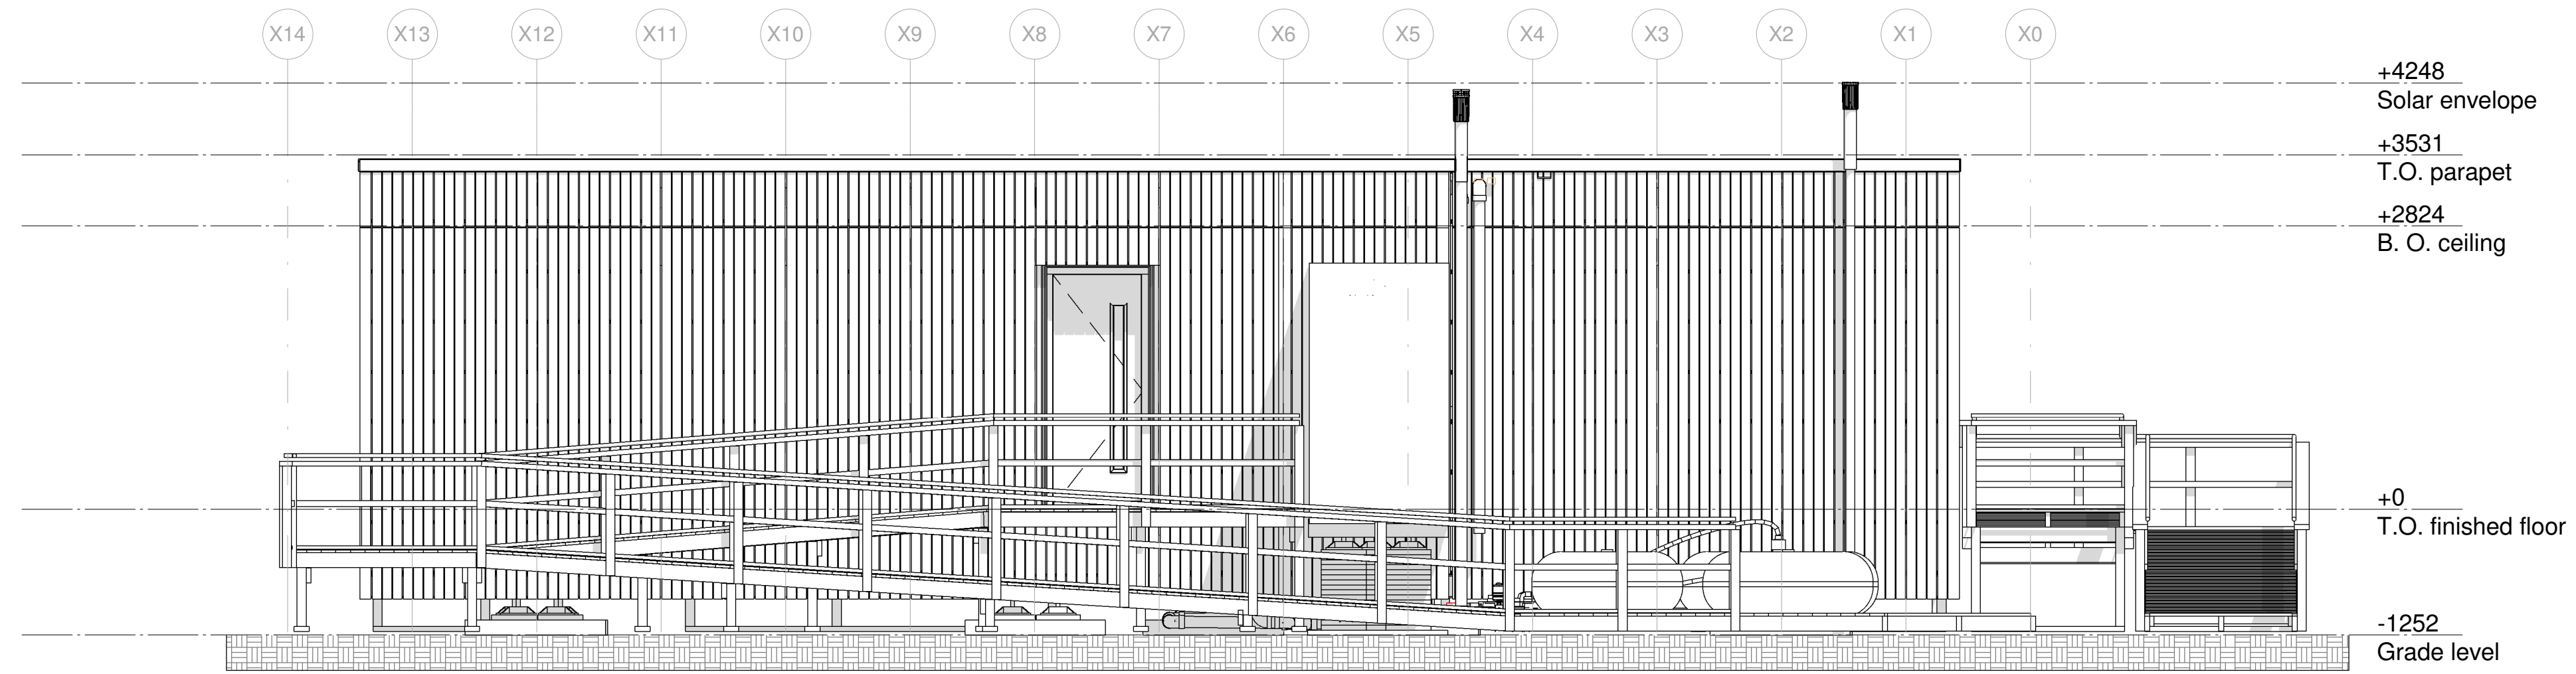

NORTH ELEVATION
 1 : 50

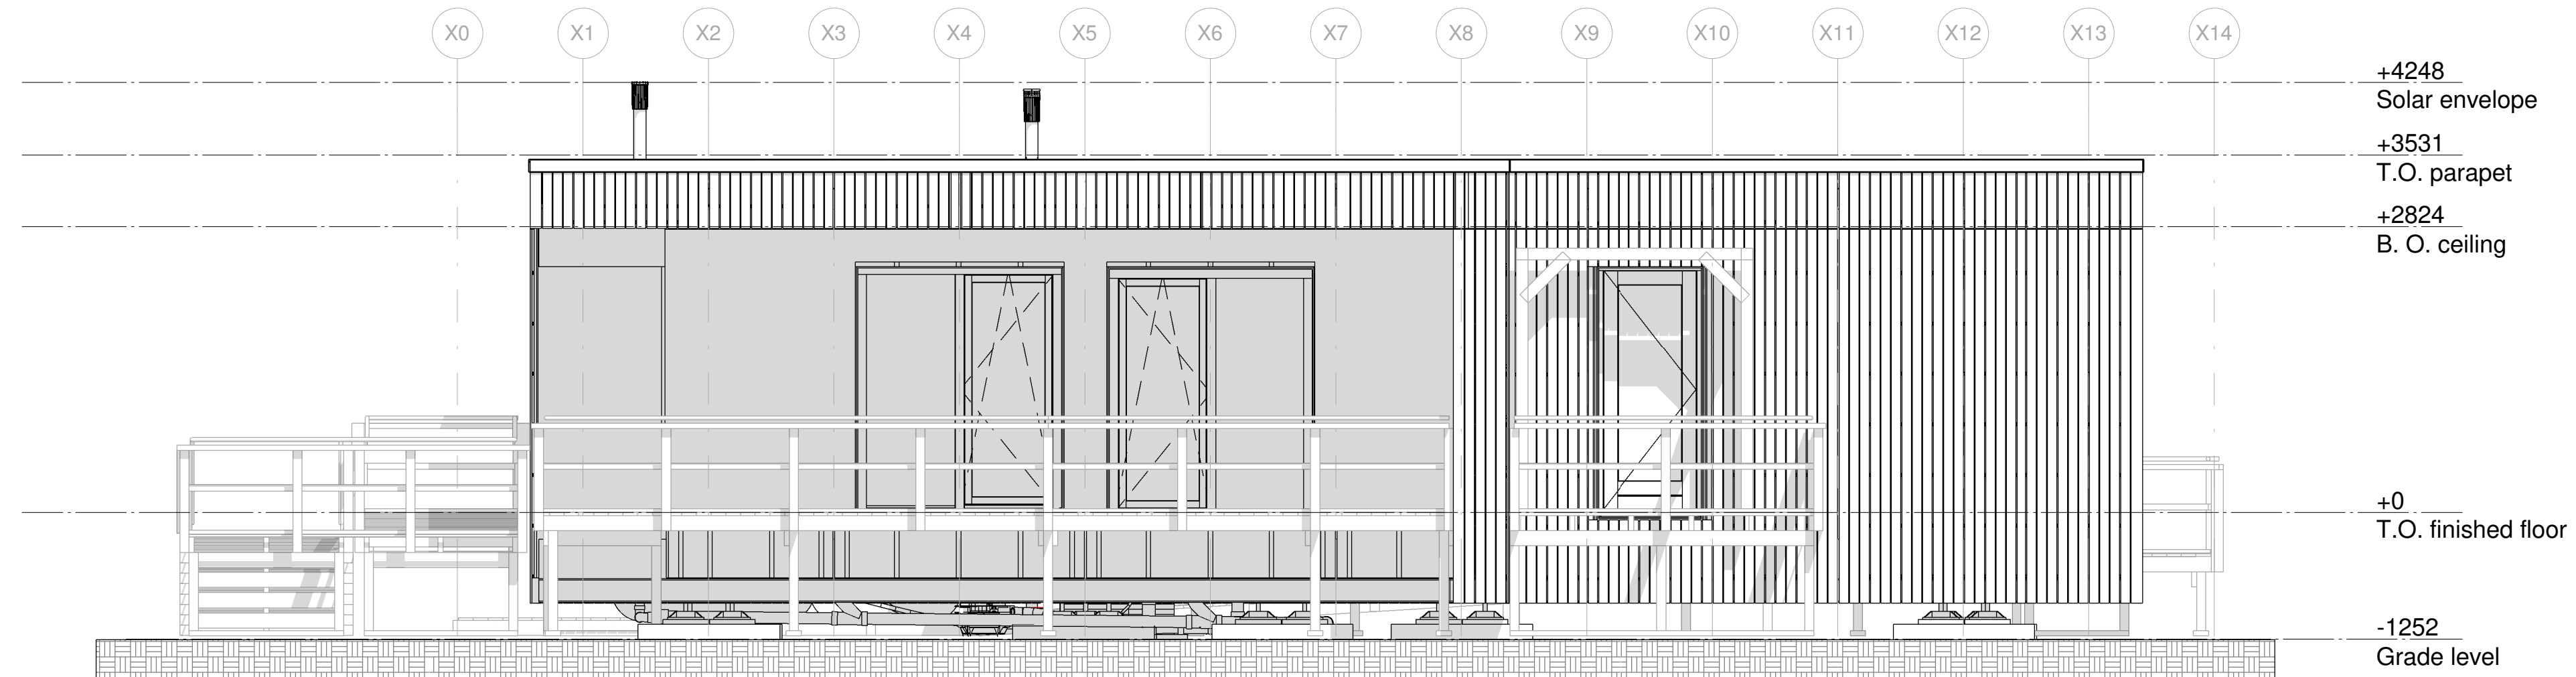

SOUTH ELEVATION
 1 : 50



EAST ELEVATION
1 : 50

WEST ELEVATION
1 : 50



TEAM NAME: Selficient
 ADDRESS: Padualaan 99
 3584 CH Utrecht
 CONTACT: info@selficient.org
 www.selficient.org

CONSULTANTS
 ARCHITECTURE
 ENGINEERS
 LANDSCAPING
 SAFETY FIRST CODE CONSULTANTS

CLIENT
 U.S. DEPARTMENT OF ENERGY
 SOLAR DECATHLON 2017
 WWW.SOLARDECATHLON.GOV



0	17-11-2016	90% revision
---	------------	--------------

MARK	DATE	DESCRIPTION
------	------	-------------

LOT NUMBER: 106
 DRAWN BY: Author
 CHECKED BY: Selficient
 COPYRIGHT: NONE; PROJECT IS PUBLIC DOMAIN

SCALE: 1 : 50

SHEET TITLE
ELEVATIONS

A-301

TEAM NAME: Selficient
ADDRESS: Padualaan 99
3584 CH Utrecht
CONTACT: info@selficient.org
www.selficient.org

CONSULTANTS
ARCHITECTURE
ENGINEERS
LANDSCAPING
SAFETY FIRST CODE CONSULTANTS

CLIENT
U.S. DEPARTMENT OF ENERGY
SOLAR DECATHLON 2017
WWW.SOLARDECATHLON.GOV




0	17-11-2016	90% revision

MARK	DATE	DESCRIPTION


LOT NUMBER: 106
DRAWN BY: Author
CHECKED BY: Selficient
COPYRIGHT: NONE; PROJECT IS PUBLIC DOMAIN
SCALE: 1 : 50

SHEET TITLE
SECTION VIEW A & B

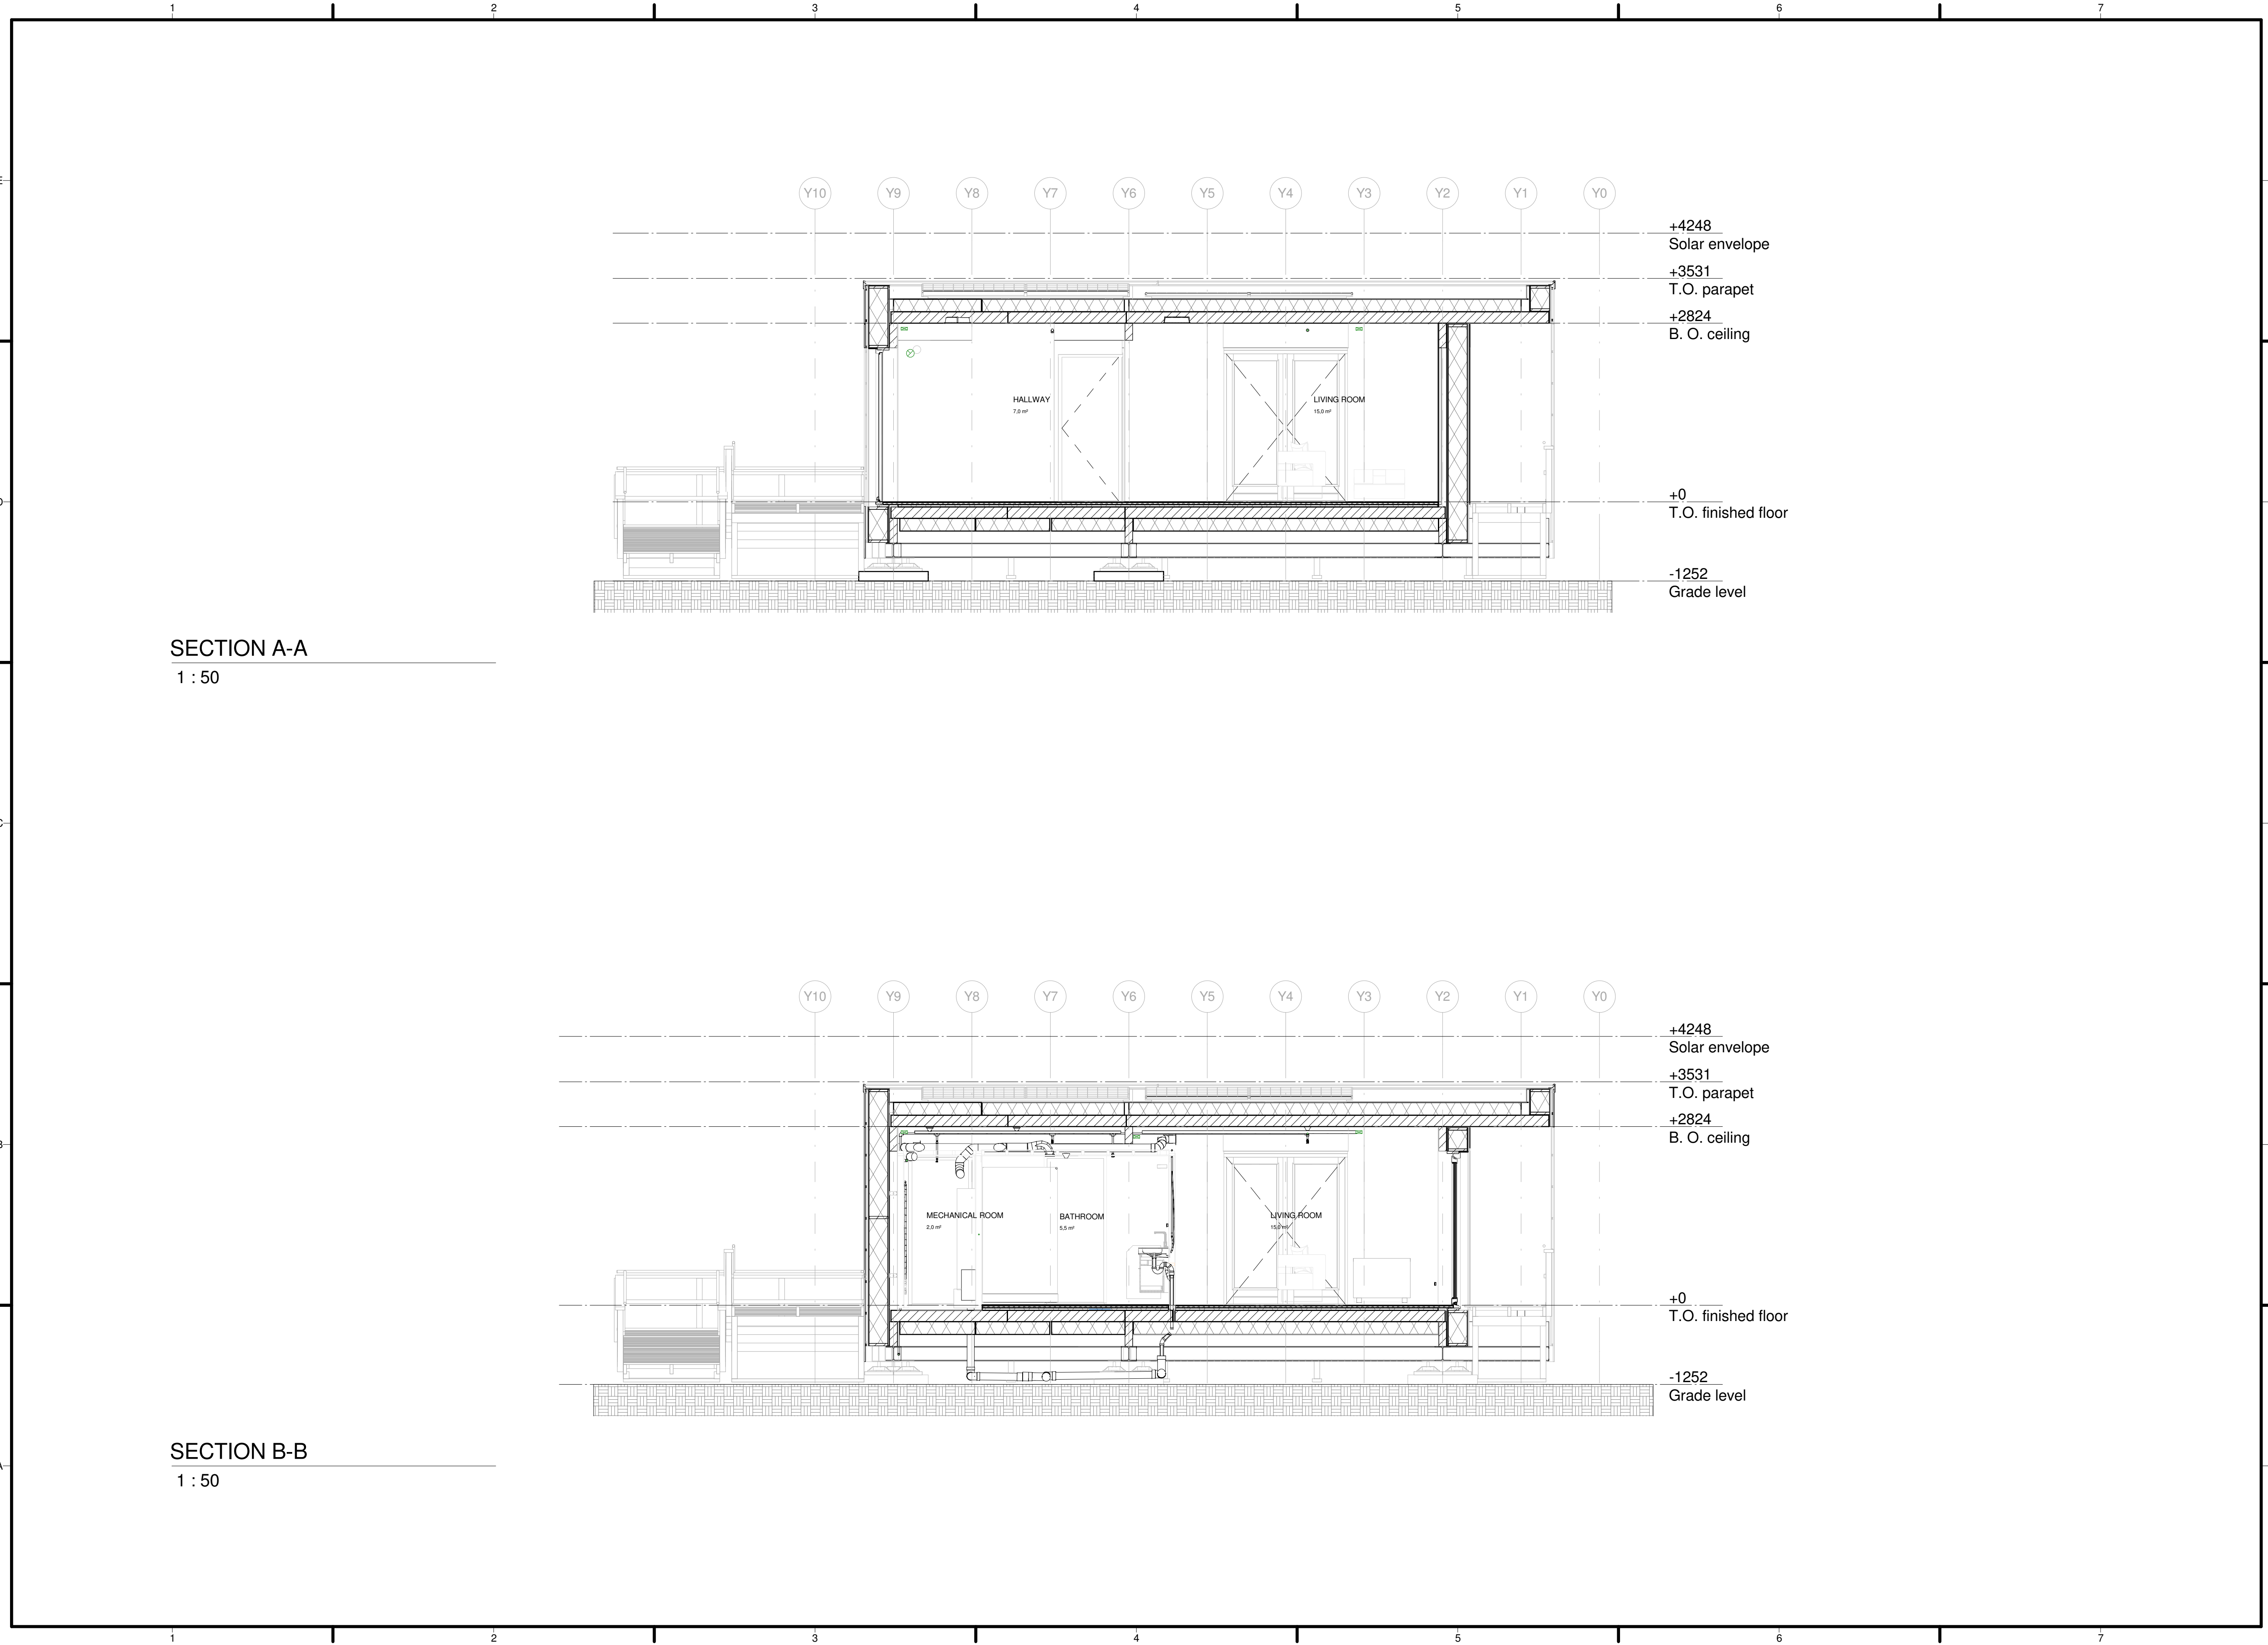


SECTION A-A
1 : 50

SECTION B-B
1 : 50

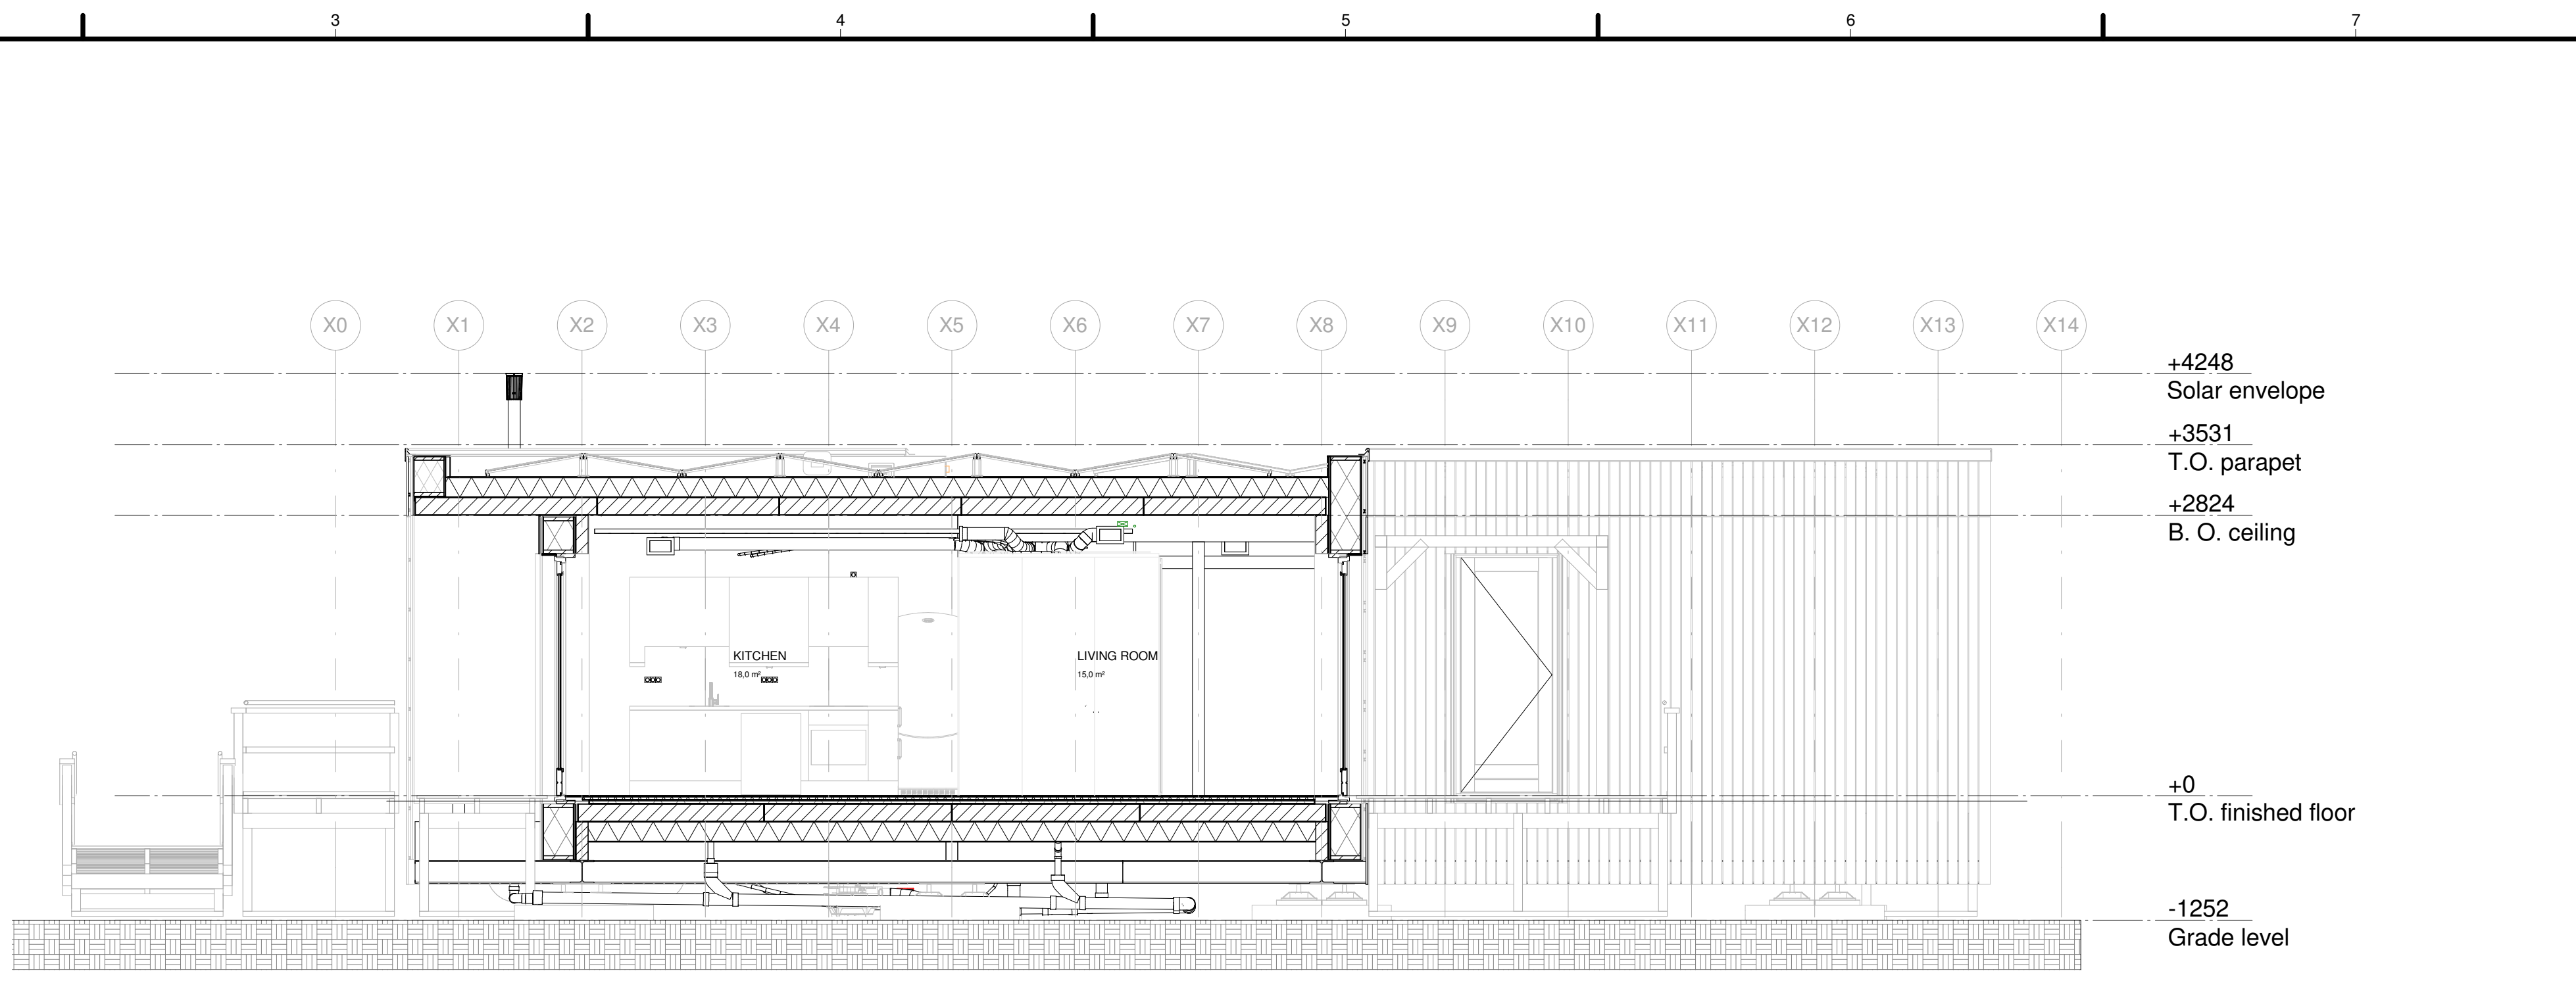

SECTION C-C
1:50

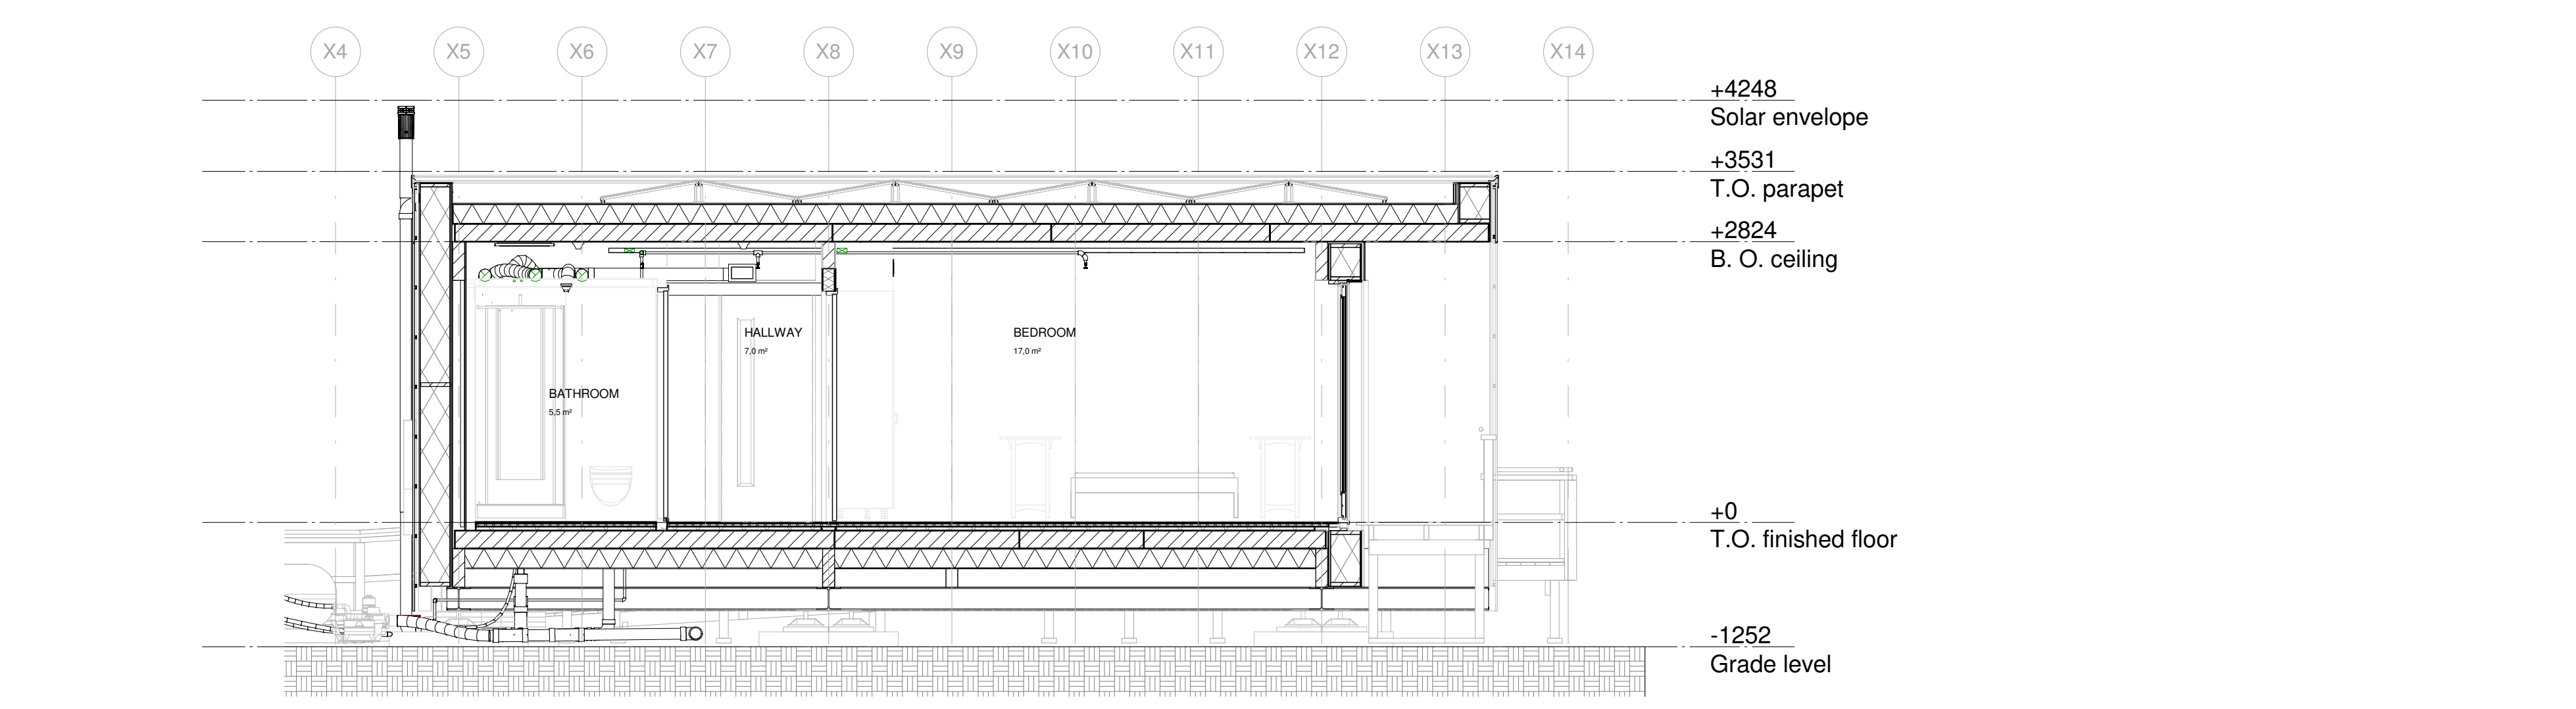


SECTION D-D
1:50



TEAM NAME: Selficient
ADDRESS: Padualaan 99 3584 CH Utrecht
CONTACT: info@selficient.org www.selficient.org

CONSULTANTS
ARCHITECTURE
ENGINEERS
LANDSCAPING
SAFETY FIRST CODE CONSULTANTS

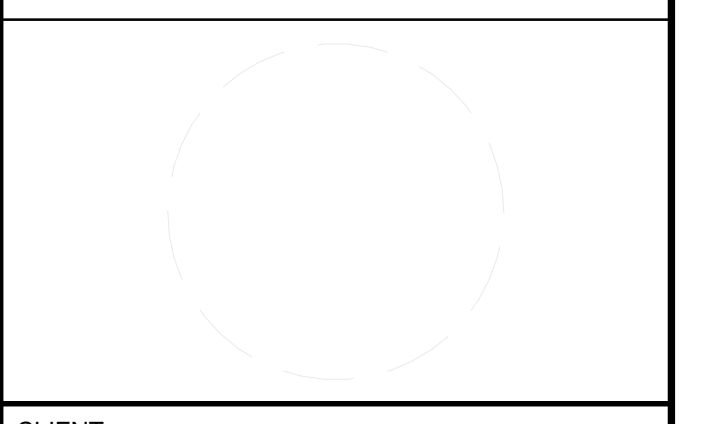

CLIENT
U.S. DEPARTMENT OF ENERGY
SOLAR DECATHLON 2017
WWW.SOLARDECATHLON.GOV




MARK	DATE	DESCRIPTION
0	17-11-2016	90% revision

LOT NUMBER: 106
DRAWN BY: Author
CHECKED BY: Selficient
COPYRIGHT: NONE; PROJECT IS PUBLIC DOMAIN
SCALE: 1:50
SHEET TITLE

SECTION VIEW C & D

A-351

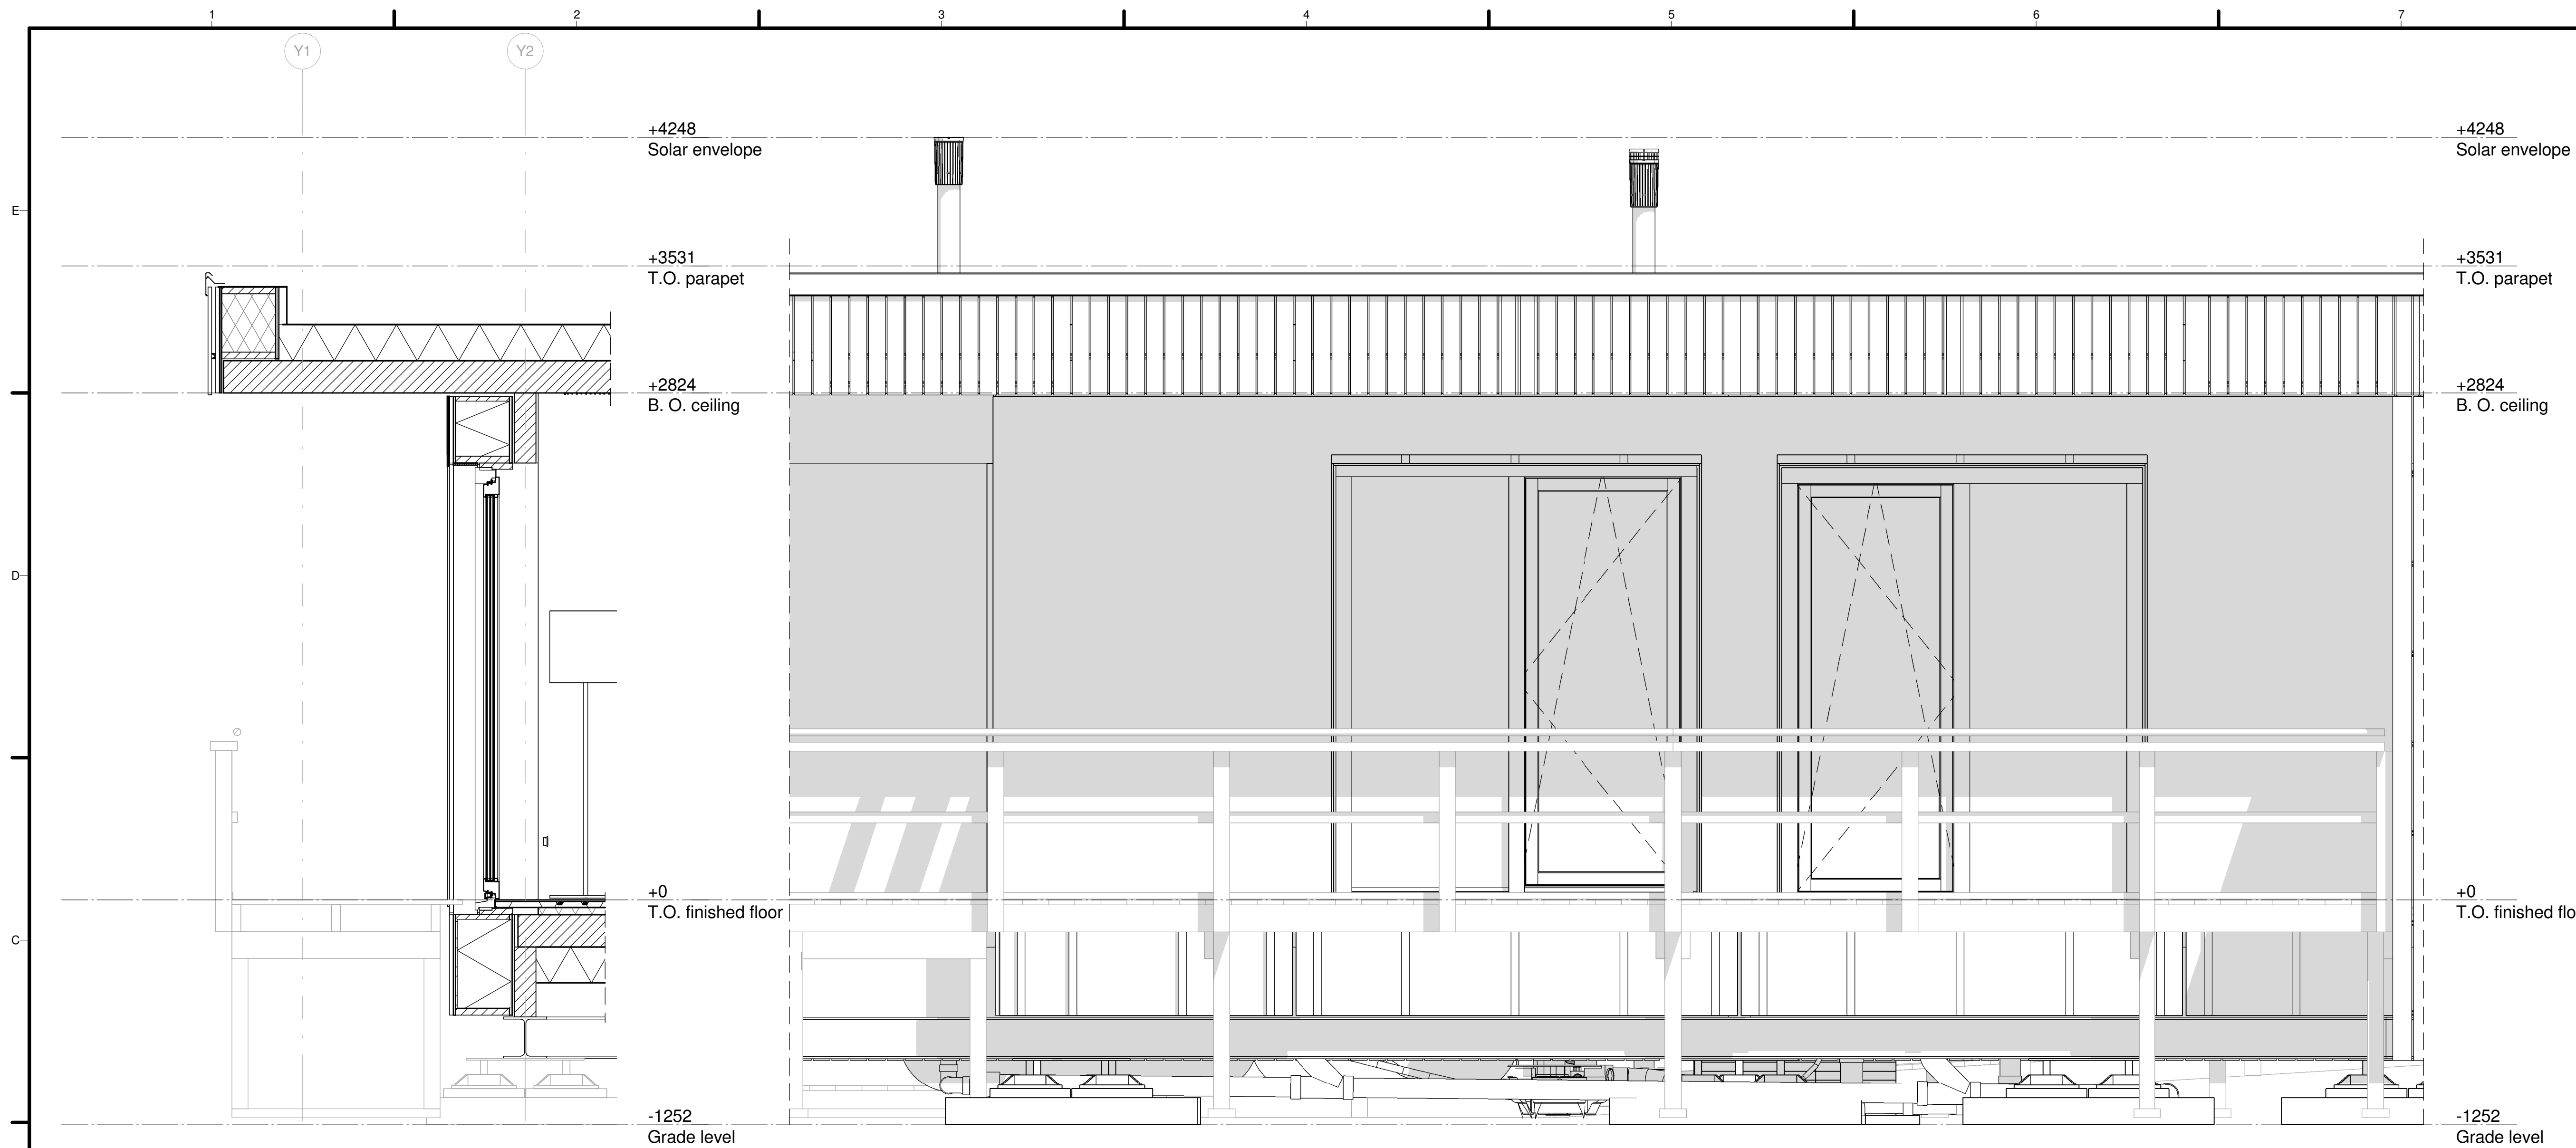


SECTION FRAGMENT 01

1 : 20

ELEVATION FRAGMENT 01

1 : 20

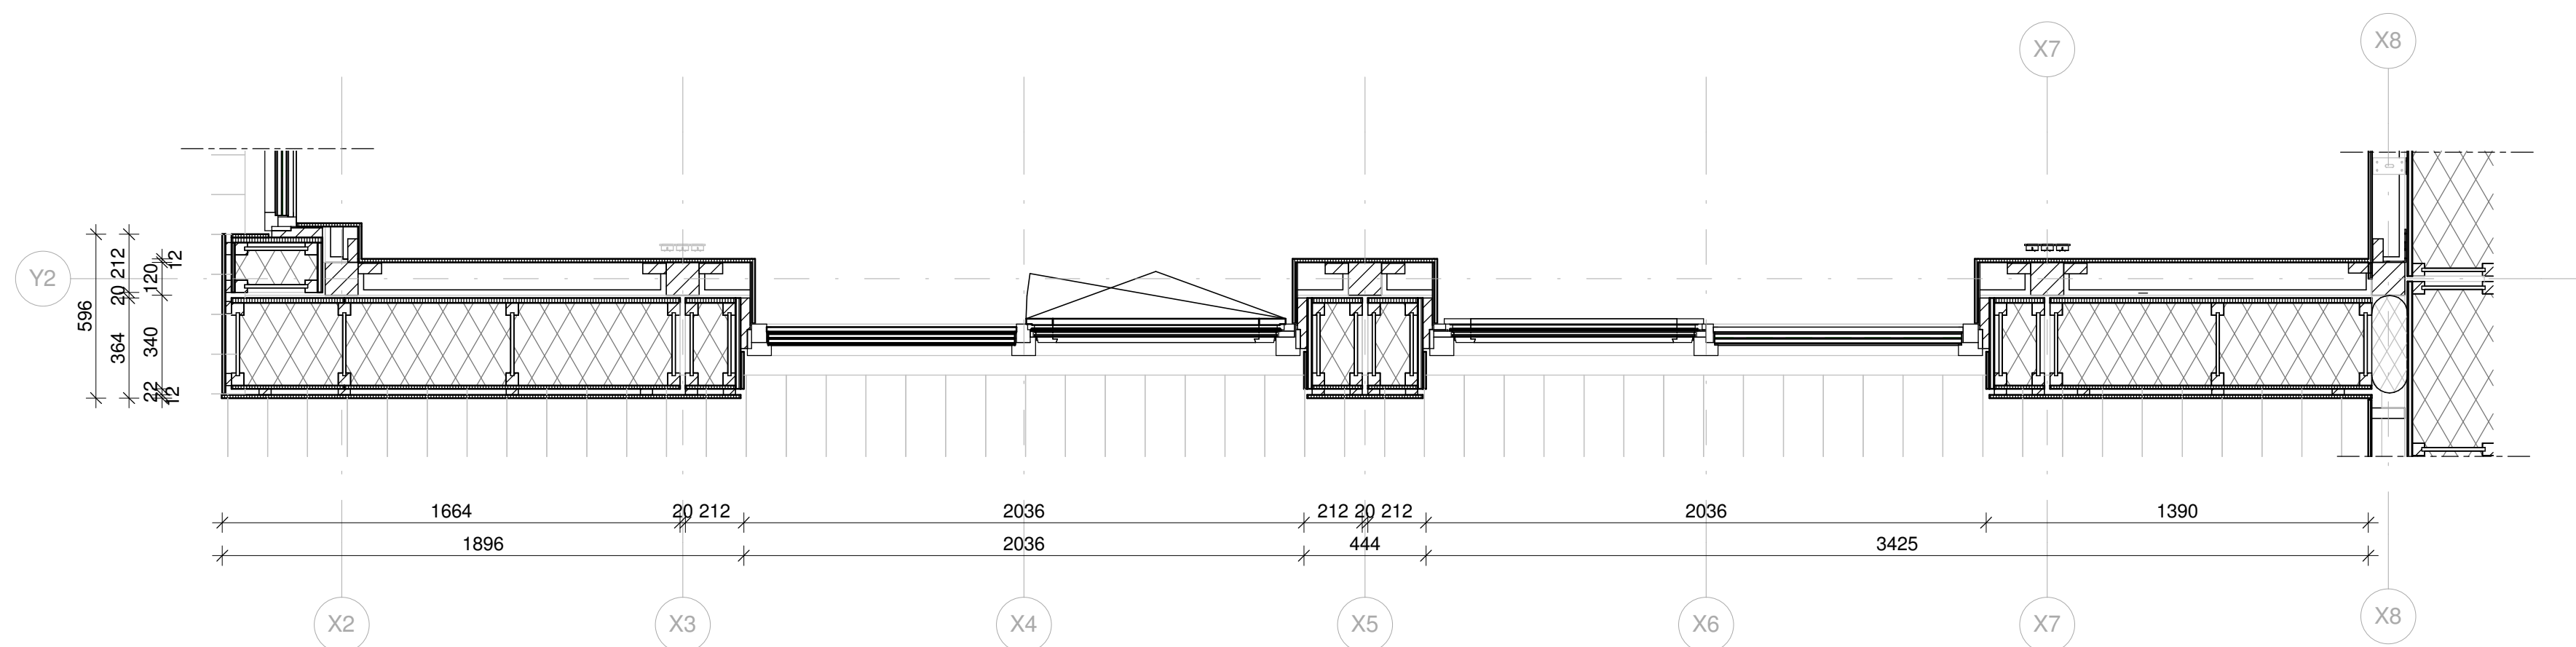

FLOOR PLAN ELEVATION 01

1 : 20



TEAM NAME: Selficient
 ADDRESS: Padualaan 99
 3584 CH Utrecht
 CONTACT: info@selficient.org
 www.selficient.org

CONSULTANTS
 ARCHITECTURE
 ENGINEERS
 LANDSCAPING
 SAFETY FIRST CODE CONSULTANTS

CLIENT
 U.S. DEPARTMENT OF ENERGY
 SOLAR DECATHLON 2017
 WWW.SOLARDECATHLON.GOV



0	17-11-2016	90% revision
---	------------	--------------

MARK	DATE	DESCRIPTION
------	------	-------------


LOT NUMBER: 106
 DRAWN BY: Author
 CHECKED BY: Selficient
 COPYRIGHT: NONE; PROJECT IS PUBLIC DOMAIN

SCALE: 1 : 20

SHEET TITLE


FACADE FRAGMENT 01

A-360

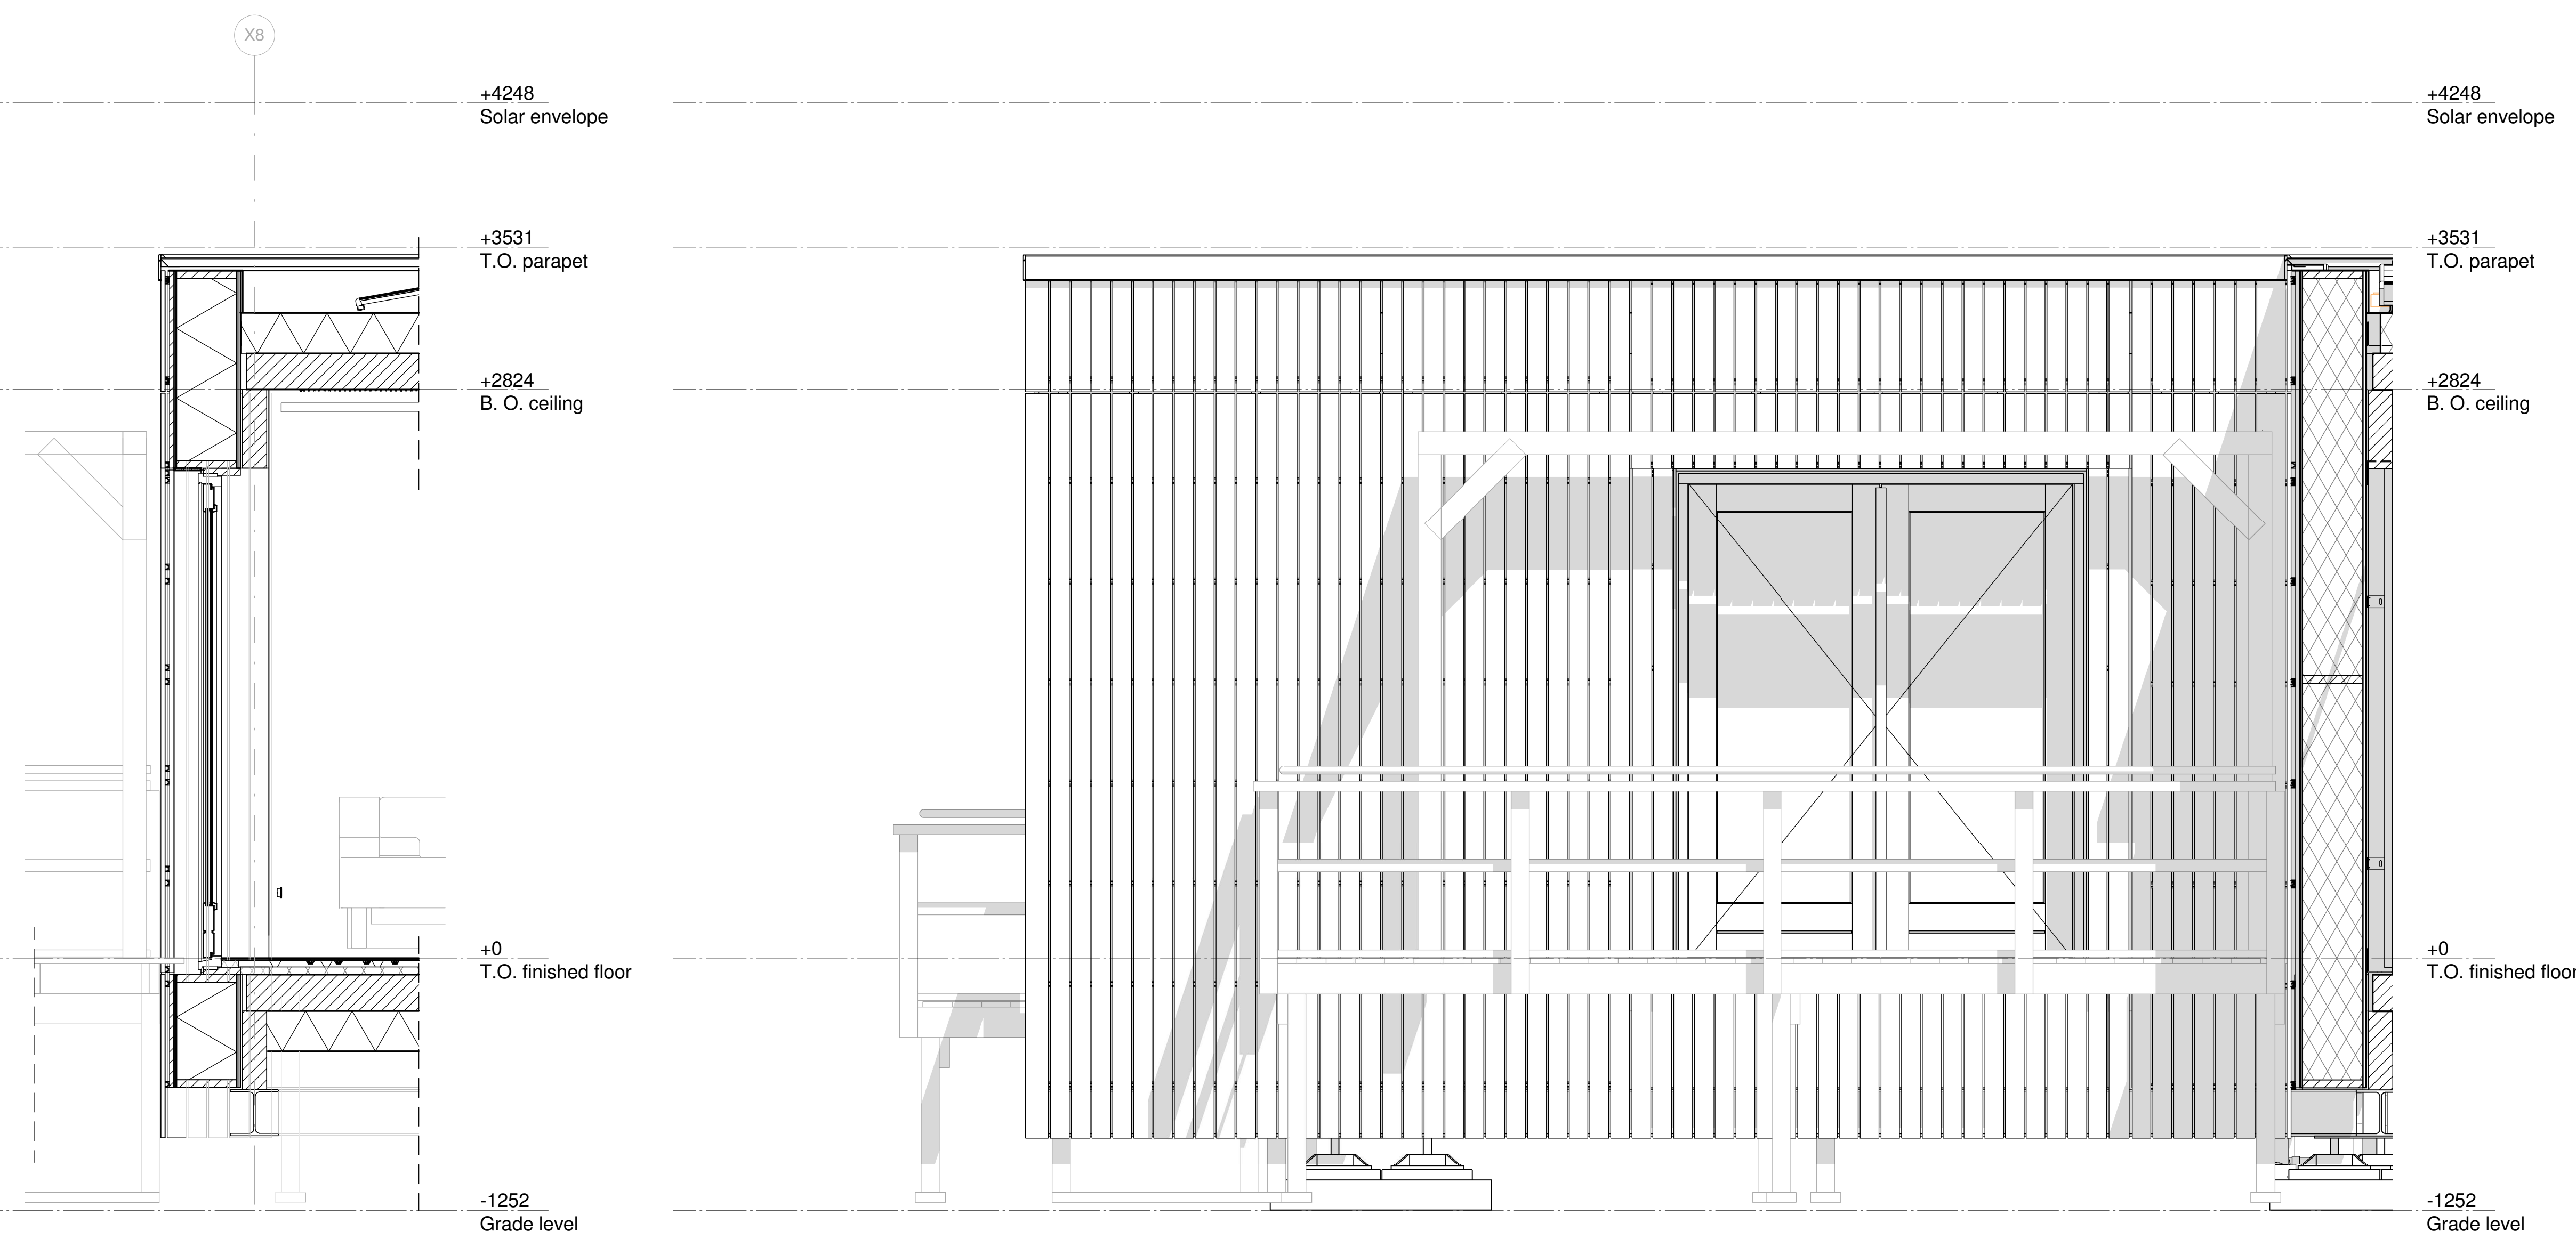

SECTION FRAGMENT 02
1 : 20

ELEVATION FRAGMENT 02
1 : 20

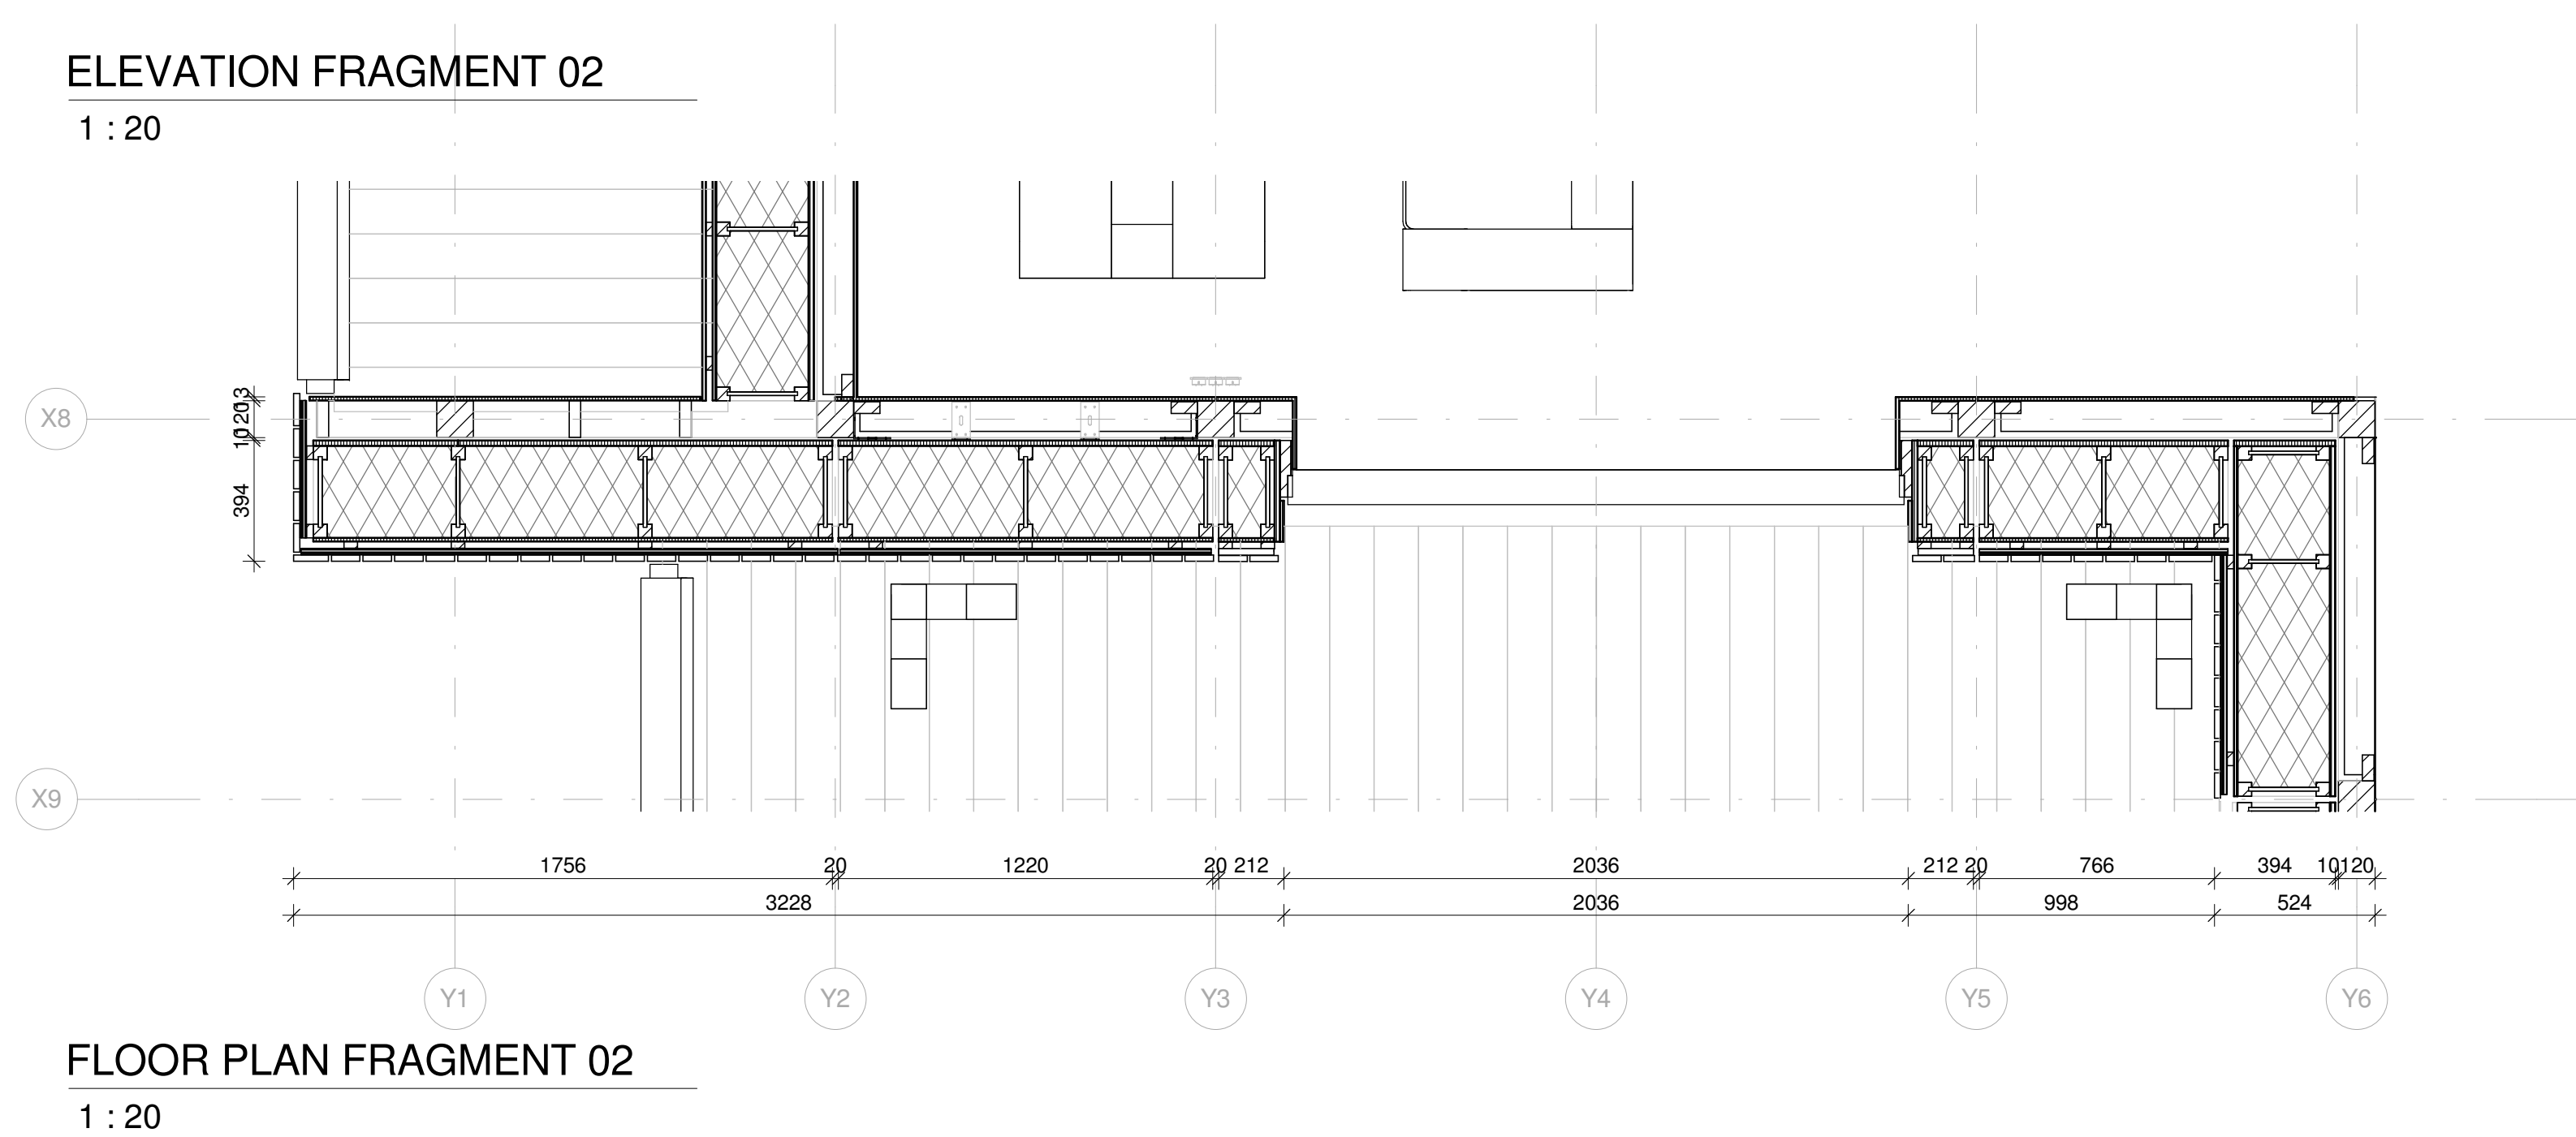

FLOOR PLAN FRAGMENT 02
1 : 20



TEAM NAME: Selficient
 ADDRESS: Padualaan 99
 3584 CH Utrecht
 CONTACT: info@selficient.org
 www.selficient.org

CONSULTANTS
 ARCHITECTURE
 ENGINEERS
 LANDSCAPING
 SAFETY FIRST CODE CONSULTANTS

CLIENT
 U.S. DEPARTMENT OF ENERGY
 SOLAR DECATHLON 2017
 WWW.SOLARDECATHLON.GOV




MARK	DATE	DESCRIPTION
0	17-11-2016	90% revision

LOT NUMBER: 106
 DRAWN BY: Author
 CHECKED BY: Selficient
 COPYRIGHT: NONE; PROJECT IS
 PUBLIC DOMAIN

SCALE: 1 : 20


SHEET TITLE
FACADE FRAGMENT 02

A-361

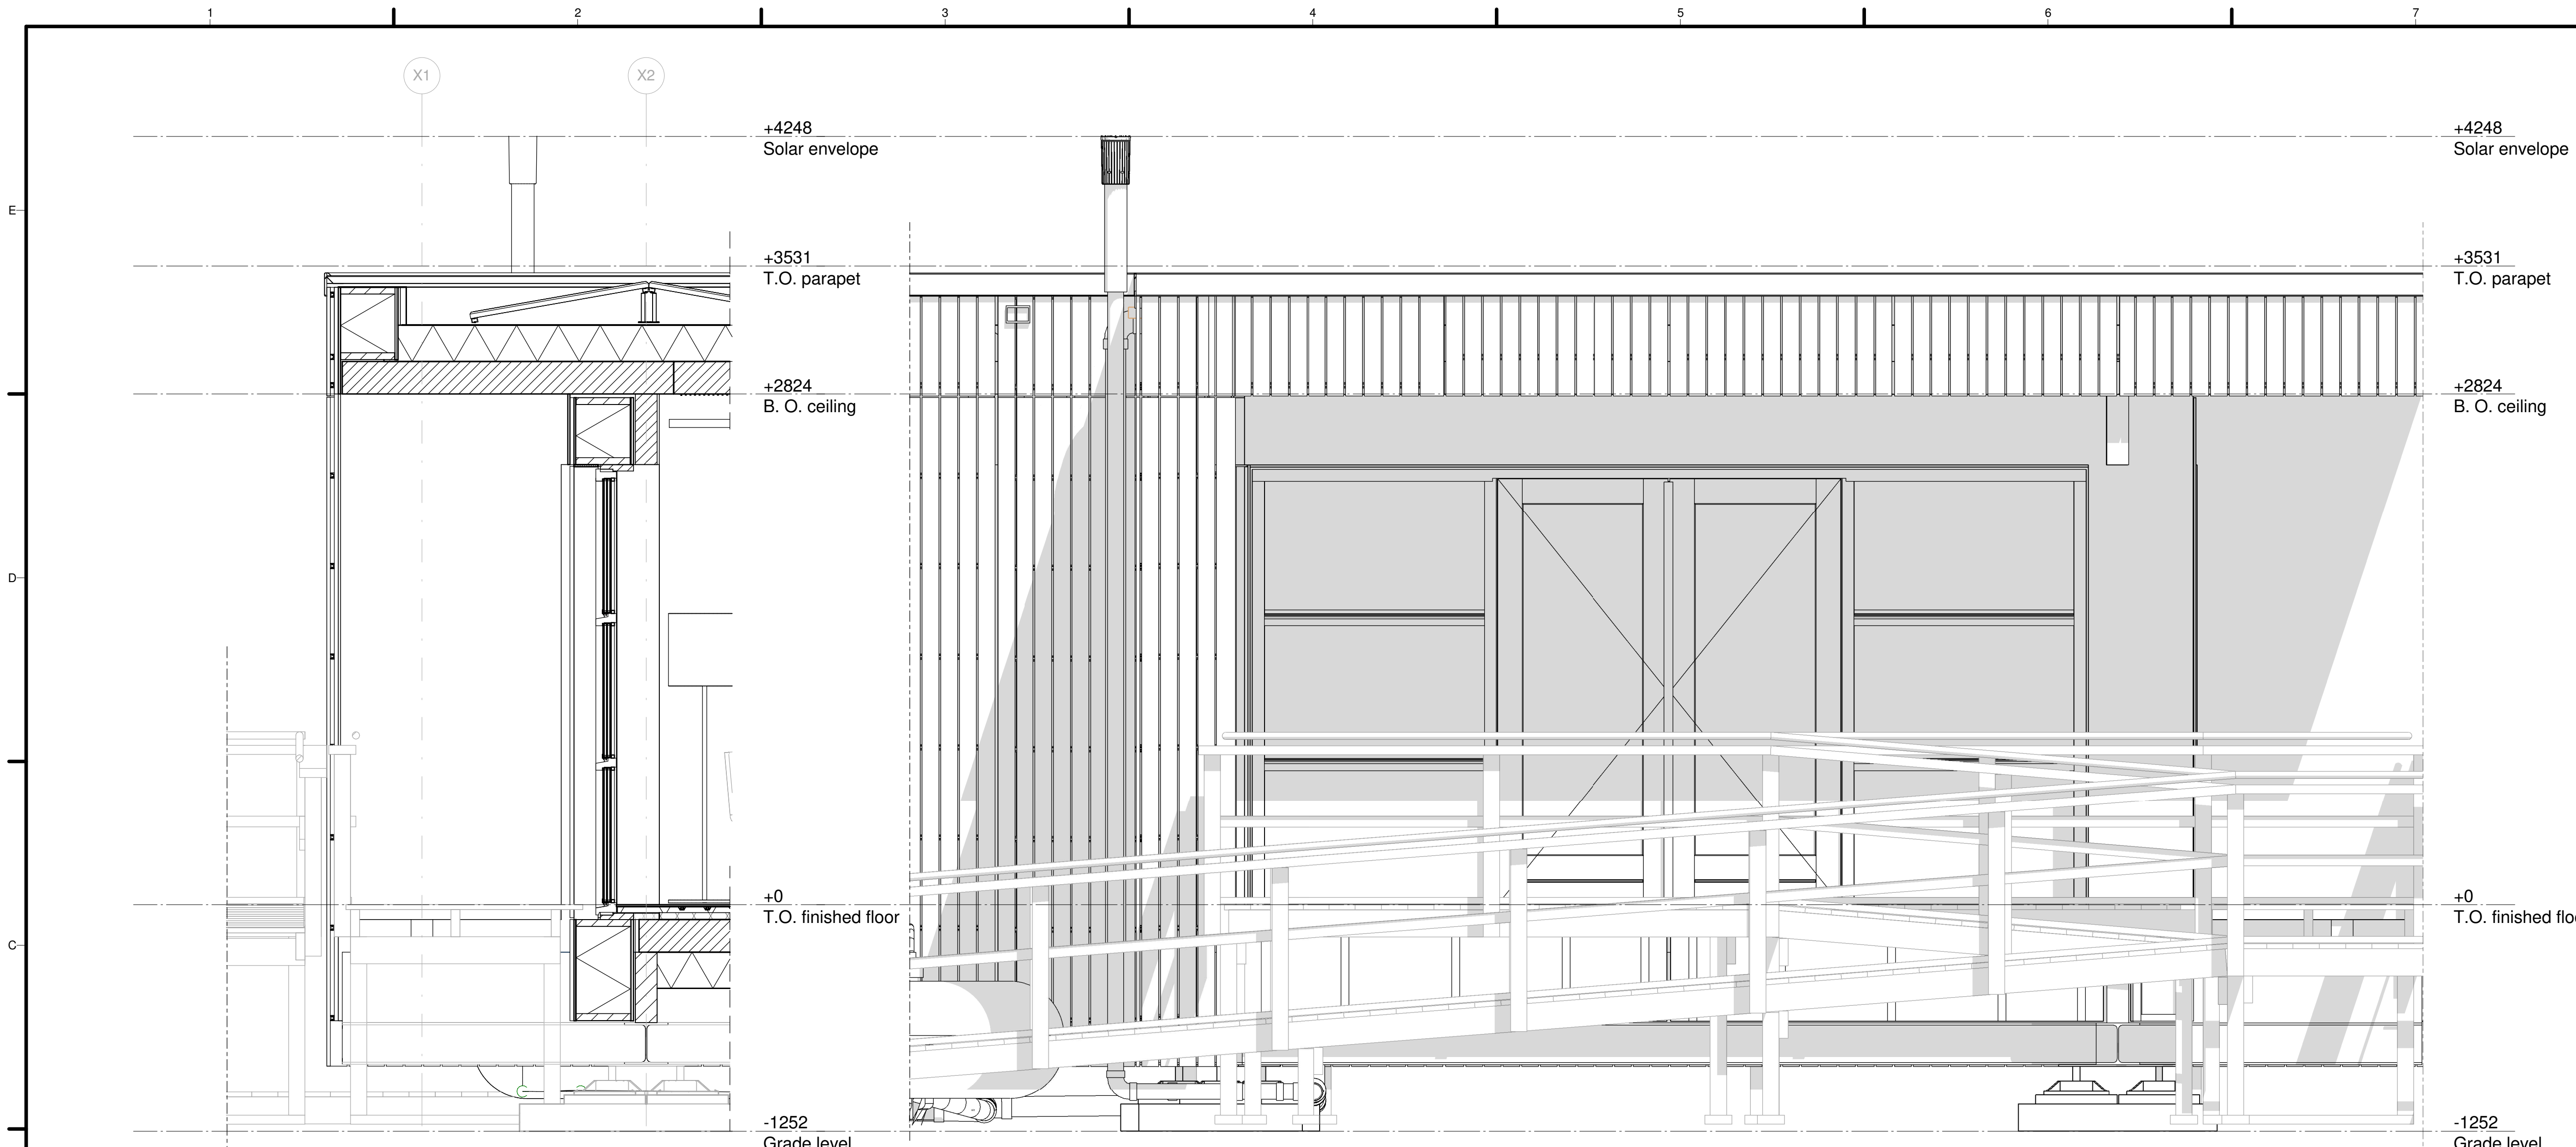

SECTION FRAGMENT 03
1 : 20

ELEVATION FRAGMENT 03
1 : 20

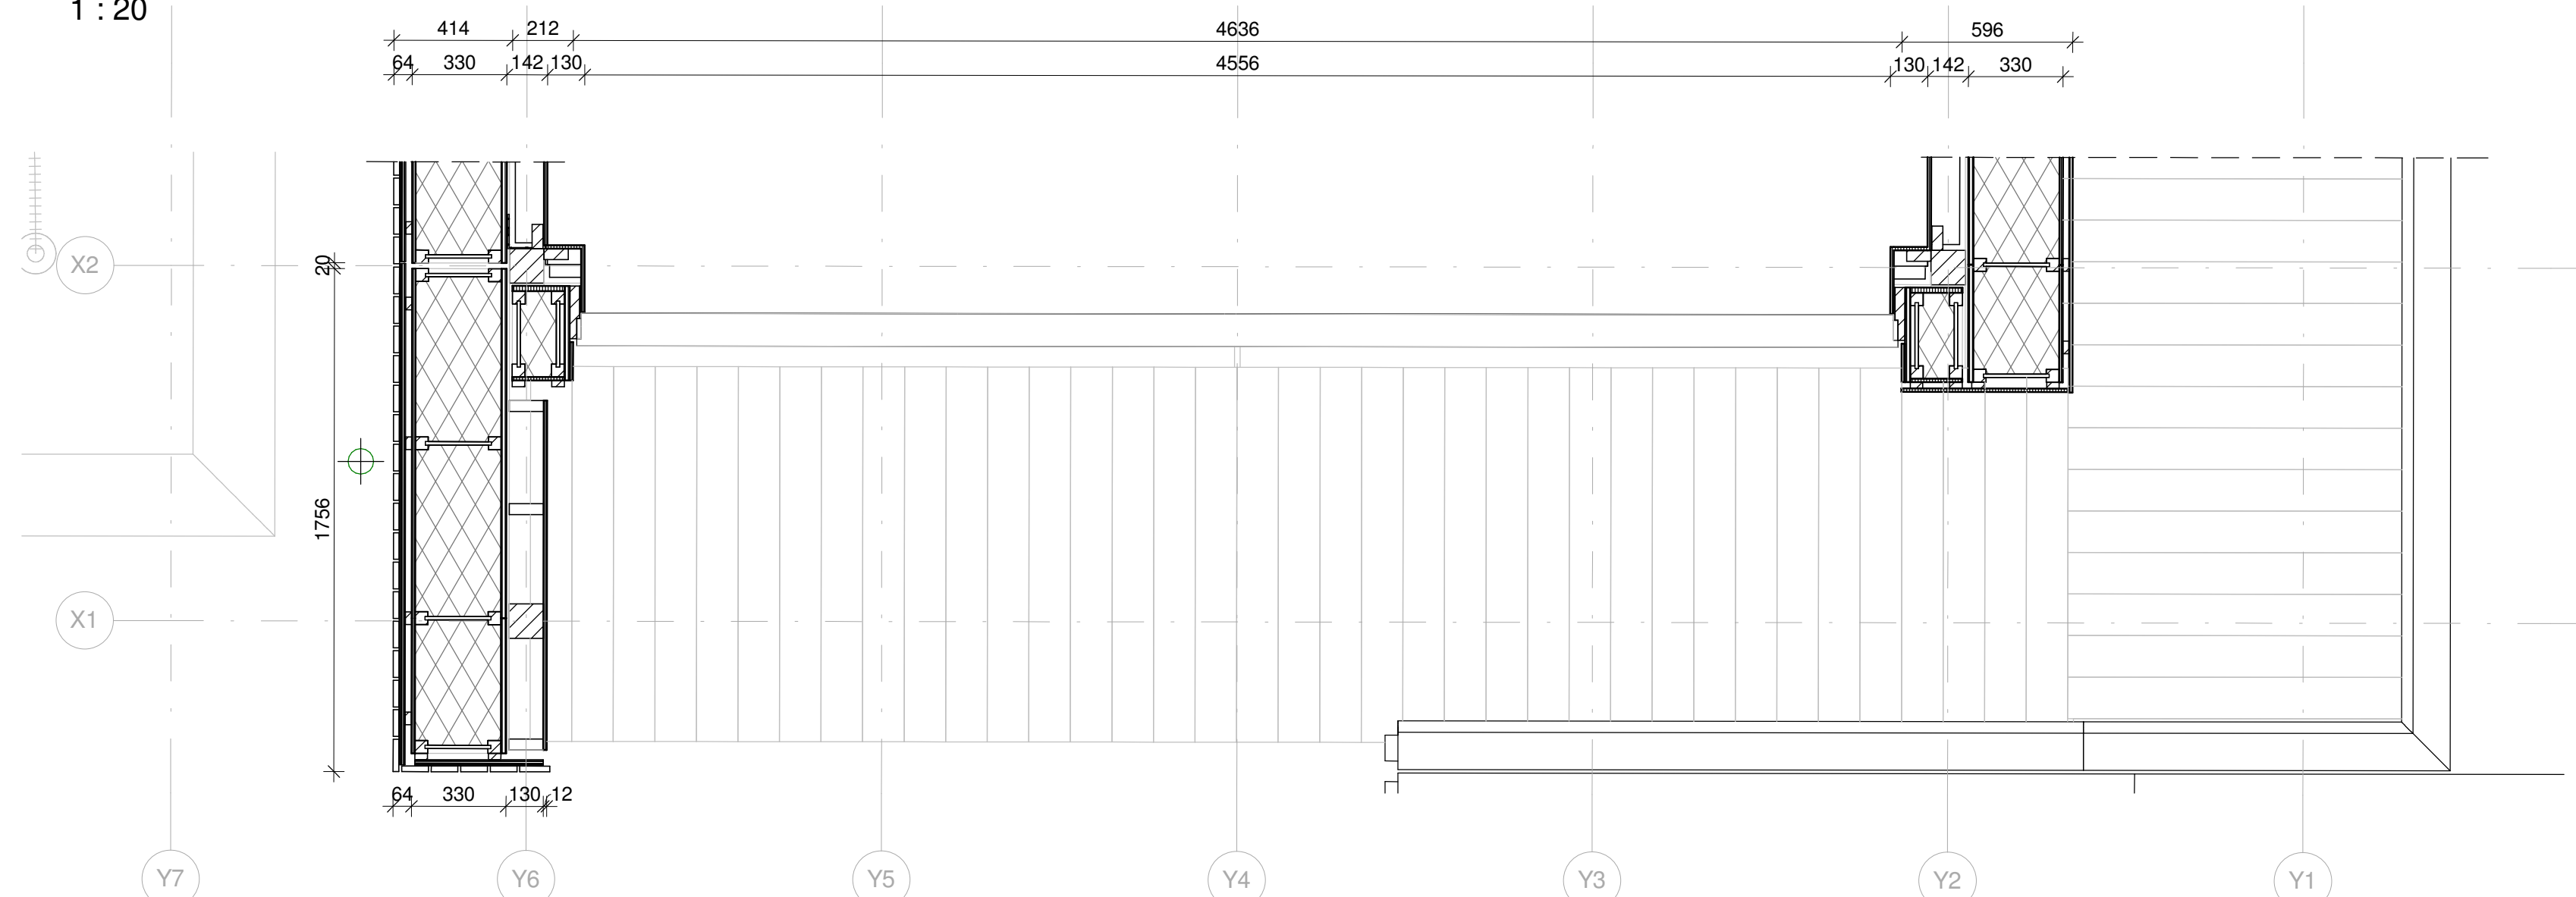

FLOOR PLAN FRAGMENT 03
1 : 20

SELFICIENT

TEAM NAME: Selficient
 ADDRESS: Padualaan 99, 3584 CH Utrecht
 CONTACT: info@selficient.org, www.selficient.org

CONSULTANTS
 ARCHITECTURE
 ENGINEERS
 LANDSCAPING
 SAFETY FIRST CODE CONSULTANTS

CLIENT
 U.S. DEPARTMENT OF ENERGY
 SOLAR DECATHLON 2017
 WWW.SOLARDECATHLON.GOV

U.S. DEPARTMENT OF ENERGY
SOLAR DECATHLON


MARK	DATE	DESCRIPTION
0	17-11-2016	90% revision

LOT NUMBER: 106
 DRAWN BY: Author
 CHECKED BY: Selficient
 COPYRIGHT: NONE; PROJECT IS PUBLIC DOMAIN

SCALE: 1 : 20


SHEET TITLE
FACADE FRAGMENT 03

A-362

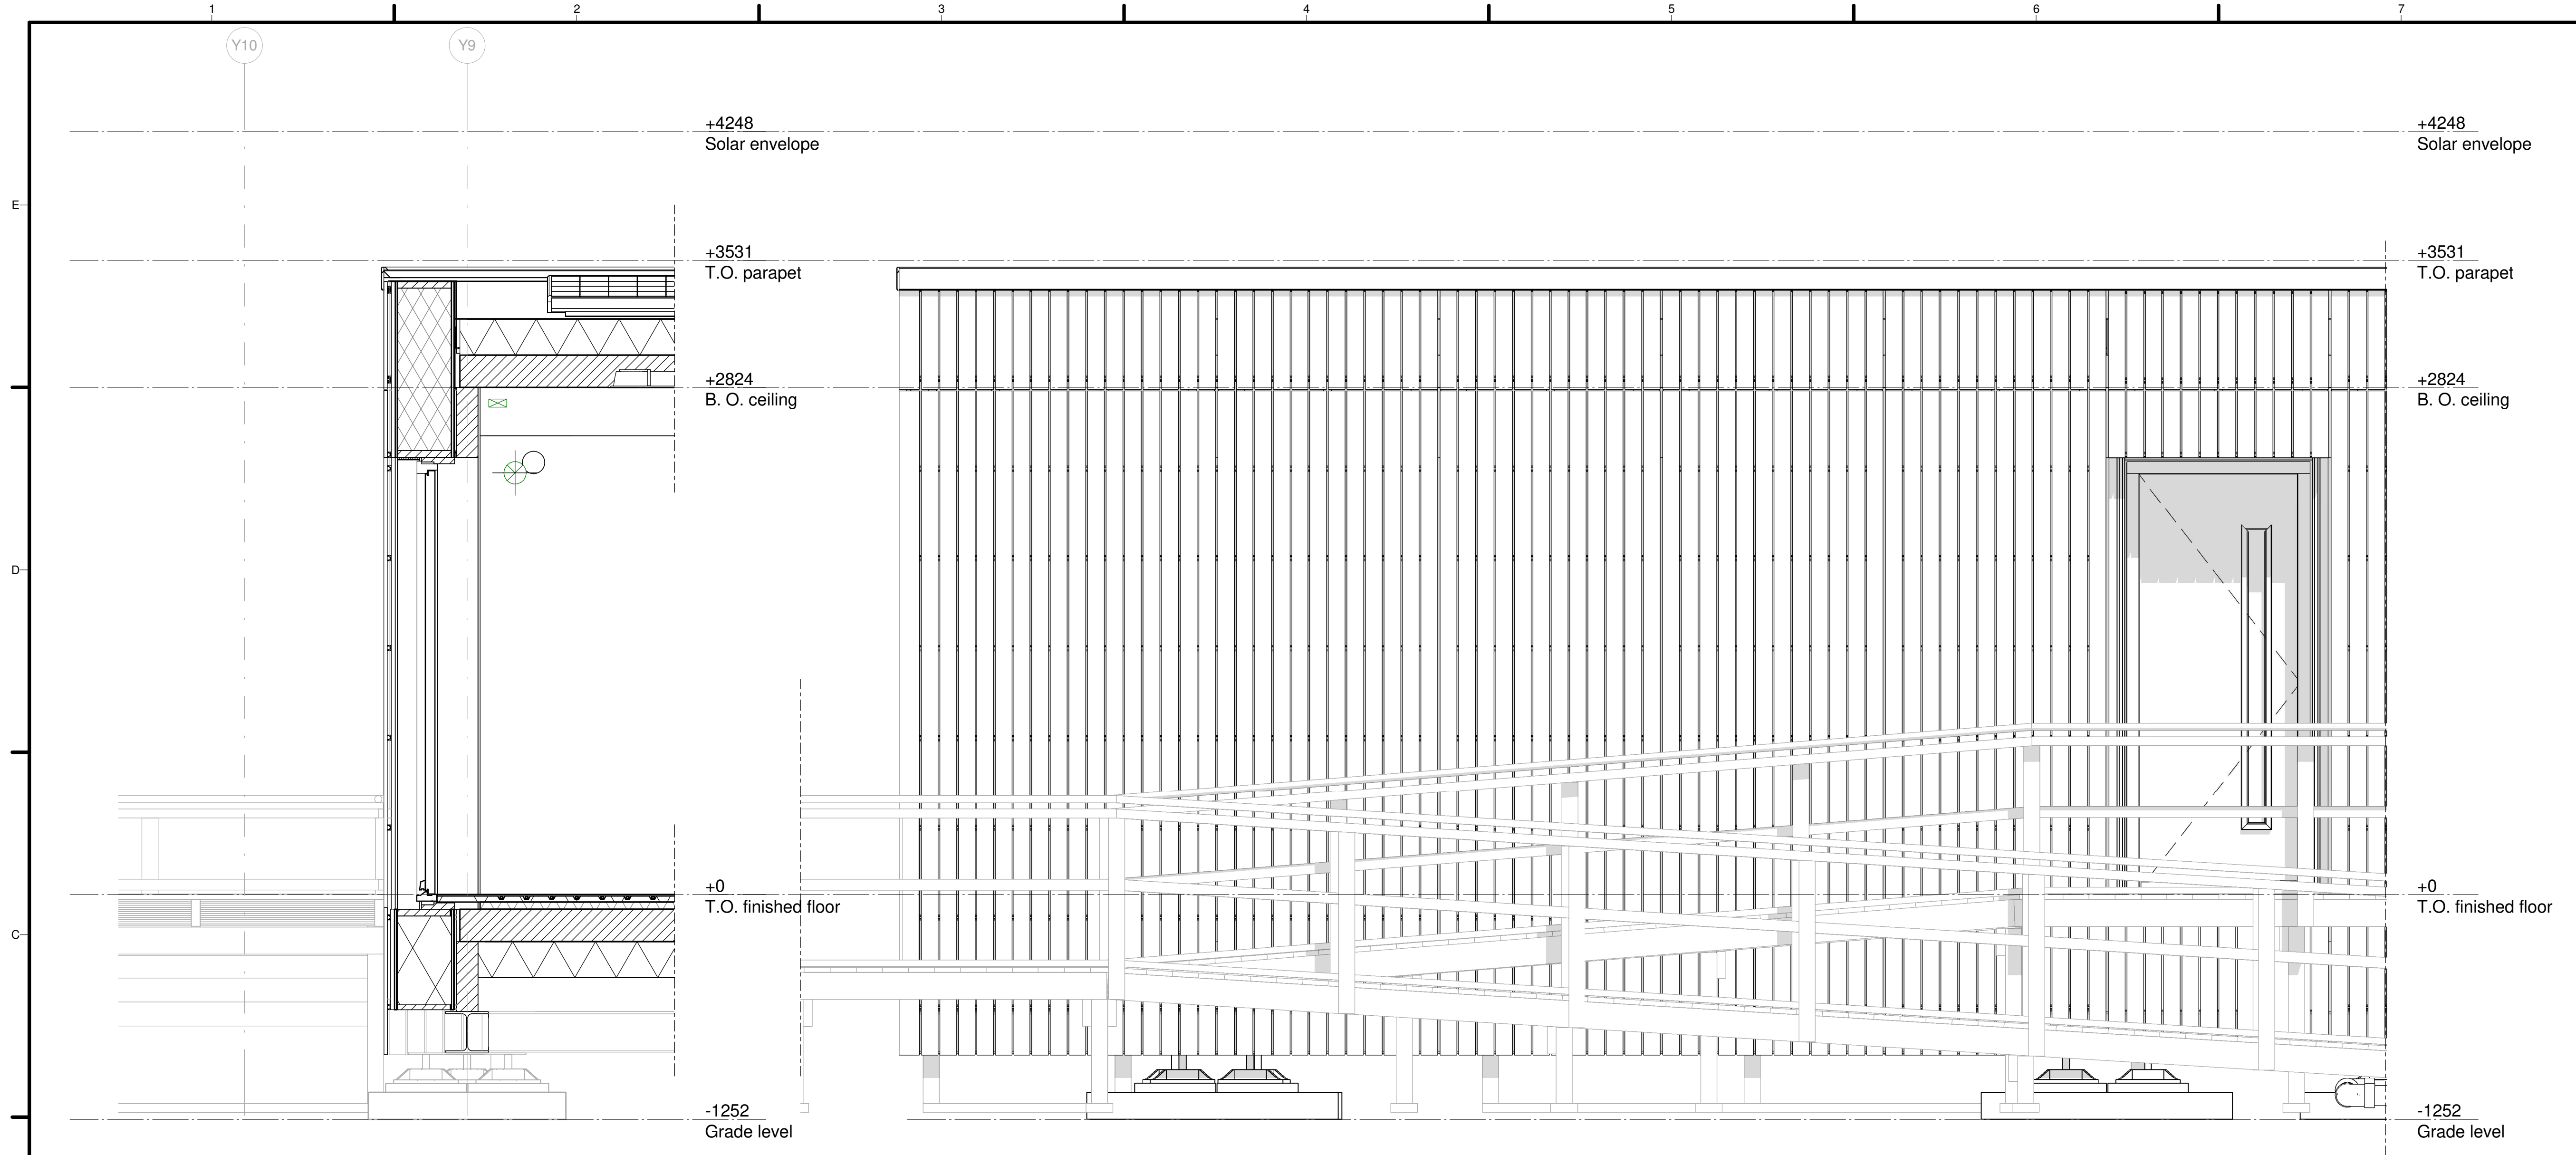

SECTION FRAGMENT 04
1 : 20

ELEVATION FRAGMENT 04
1 : 20

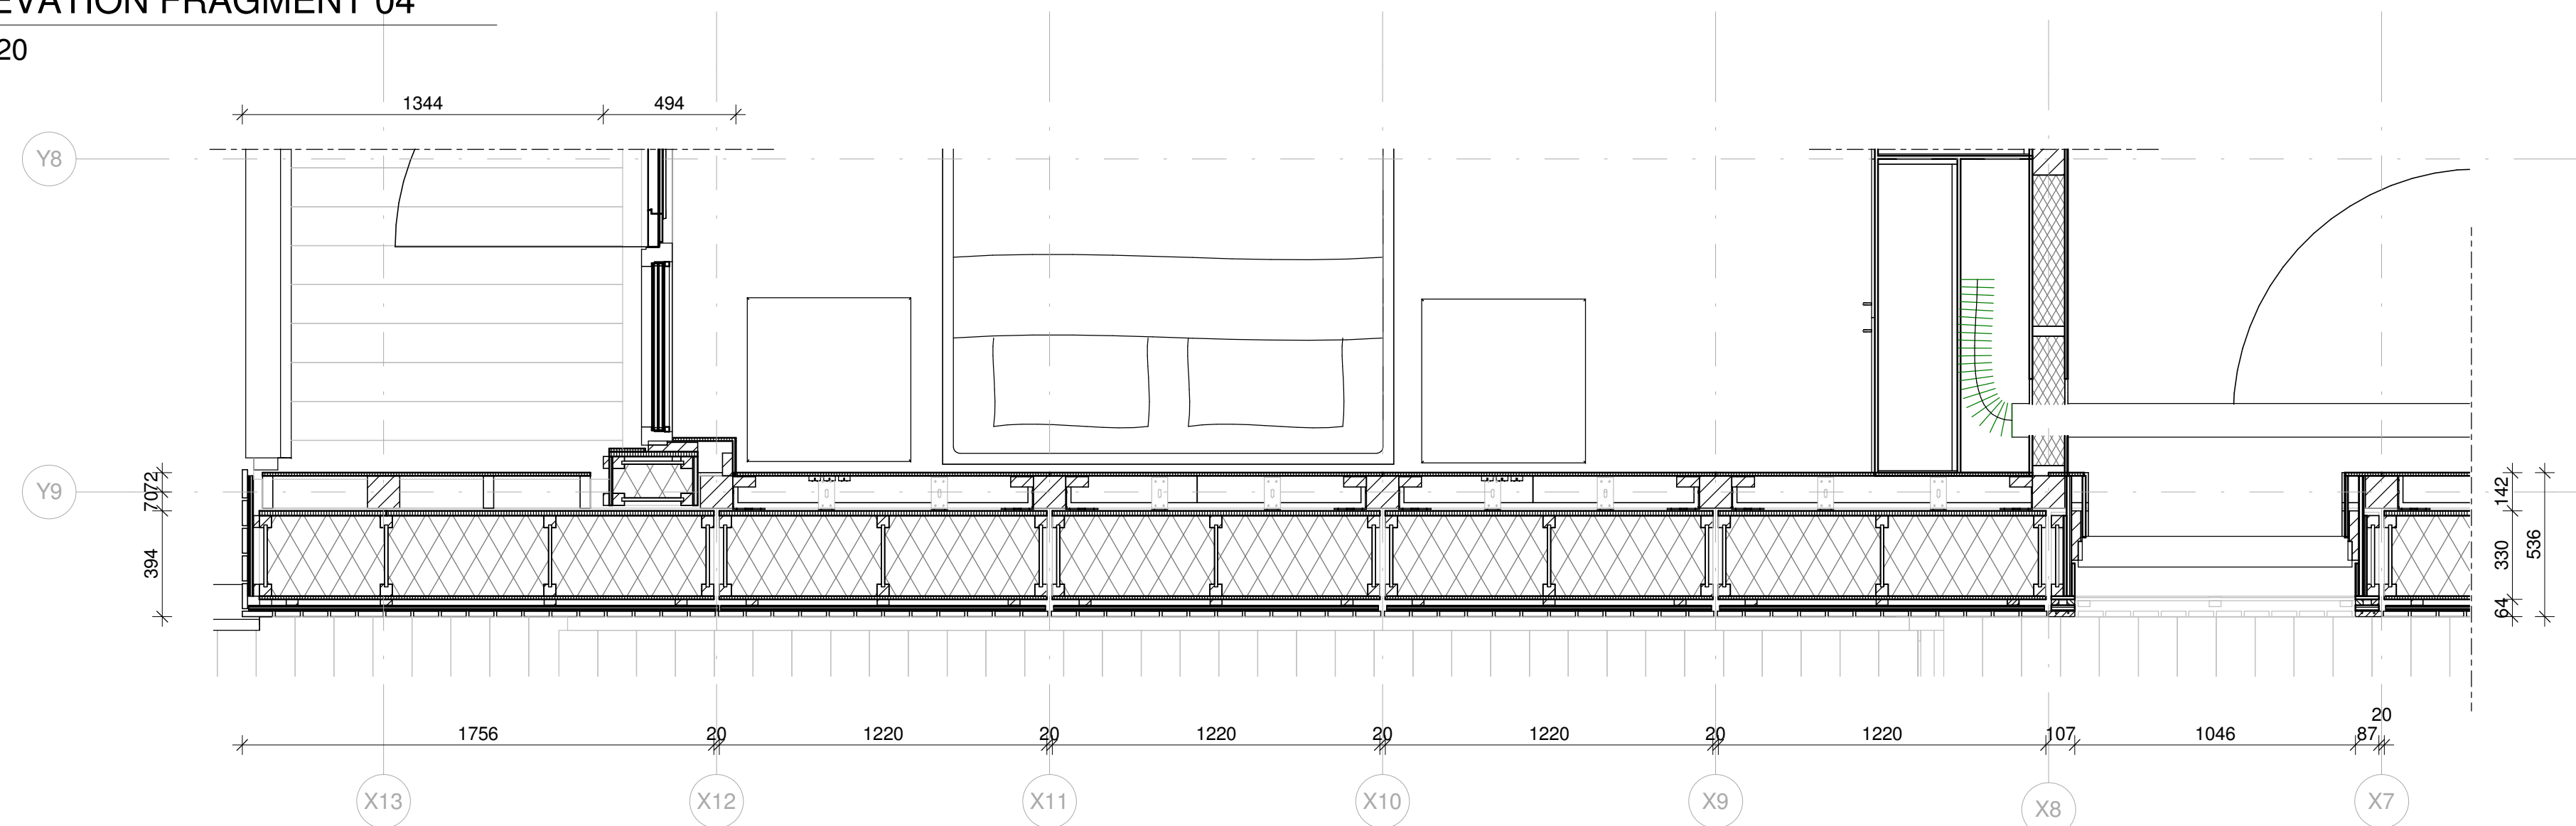

FLOOR PLAN FRAGMENT 04
1 : 20



TEAM NAME: Selficient
ADDRESS: Padualaan 99
3584 CH Utrecht
CONTACT: info@selficient.org
www.selficient.org

CONSULTANTS
ARCHITECTURE
ENGINEERS
LANDSCAPING
SAFETY FIRST CODE CONSULTANTS

CLIENT
U.S. DEPARTMENT OF ENERGY
SOLAR DECATHLON 2017
WWW.SOLARDECATHLON.GOV



0	17-11-2016	90% revision
---	------------	--------------

MARK	DATE	DESCRIPTION


LOT NUMBER: 106
DRAWN BY: Author
CHECKED BY: Selficient
COPYRIGHT: NONE; PROJECT IS PUBLIC DOMAIN

SCALE: 1 : 20


SHEET TITLE

FACADE FRAGMENT 04

A-363

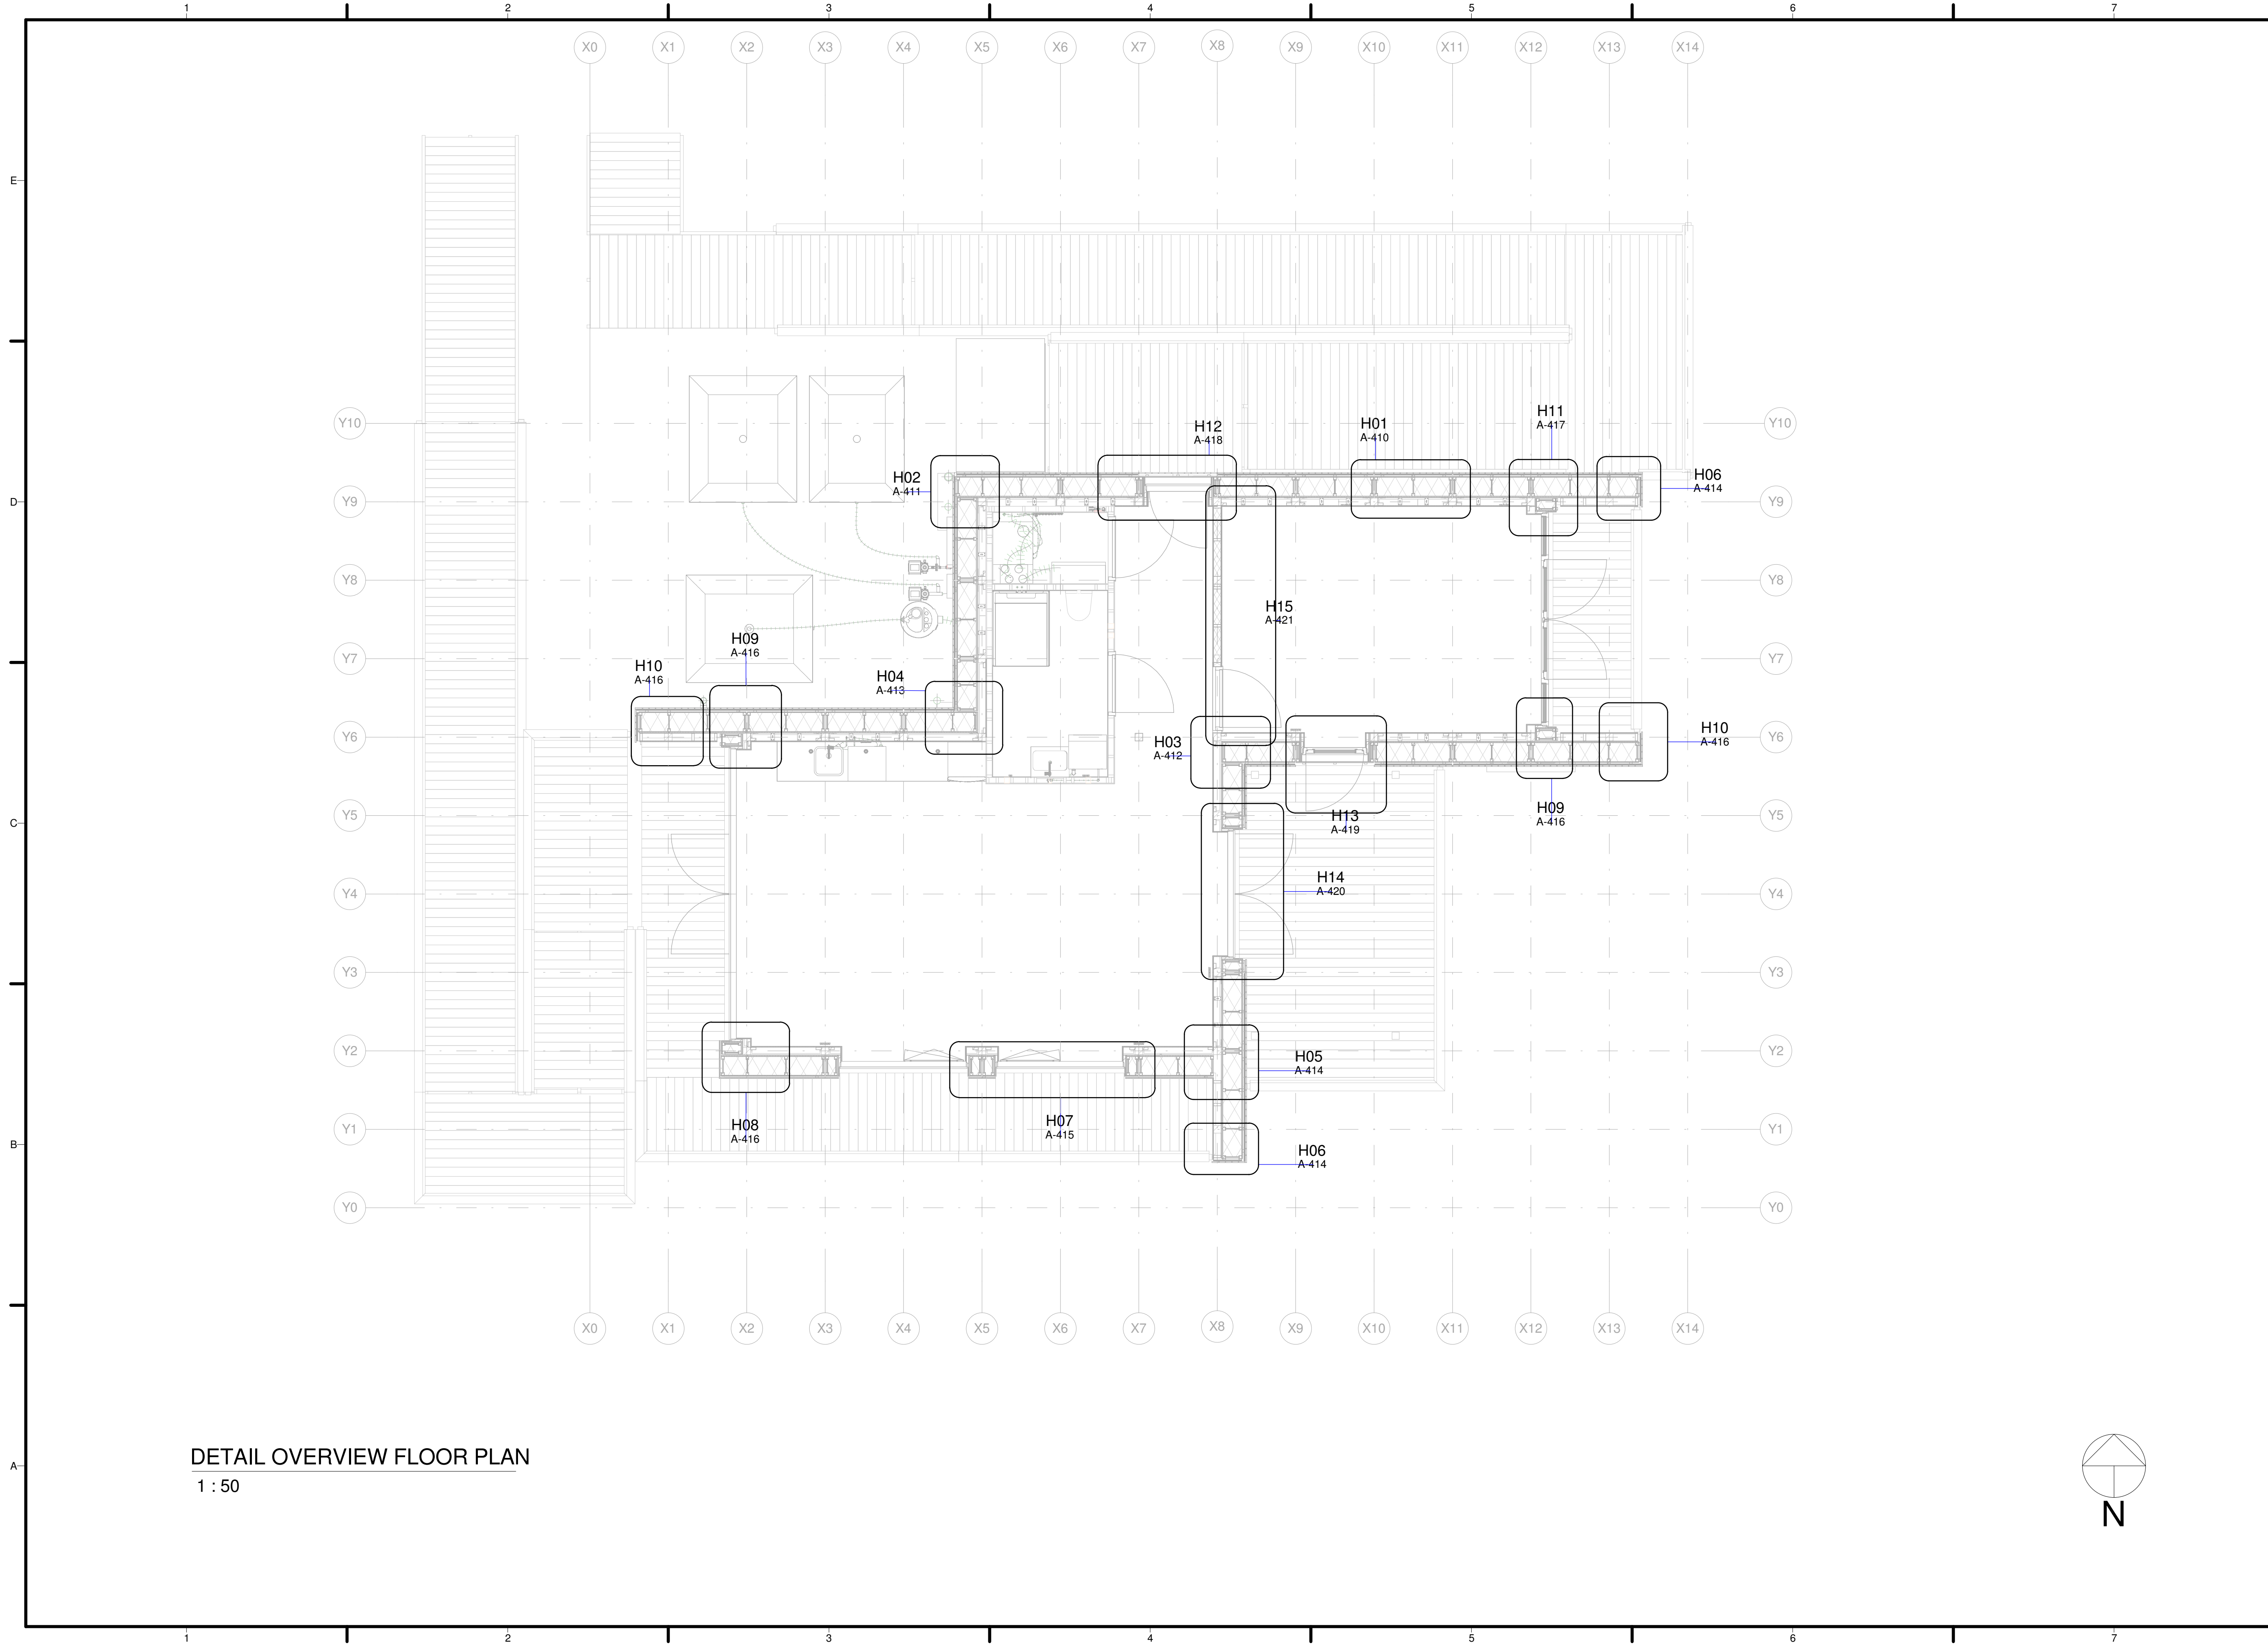


DETAIL OVERVIEW FLOOR PLAN
1 : 50

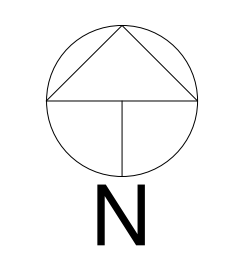

TEAM NAME: Selficient
 ADDRESS: Padualaan 99
 3584 CH Utrecht
 CONTACT: info@selficient.org
 www.selficient.org

CONSULTANTS
 ARCHITECTURE
 ENGINEERS
 LANDSCAPING
 SAFETY FIRST CODE CONSULTANTS

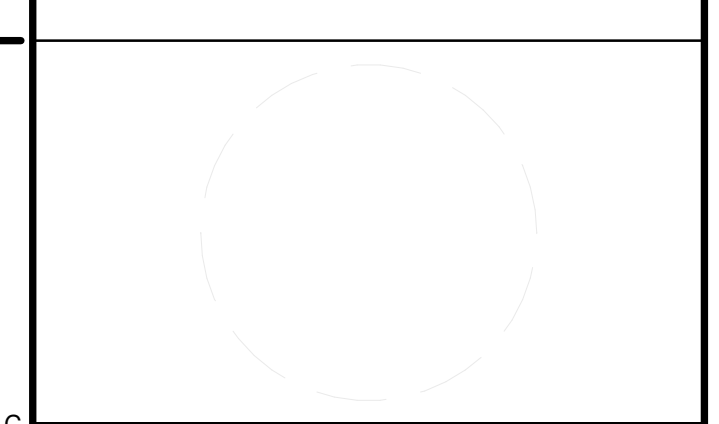

CLIENT
 U.S. DEPARTMENT OF ENERGY
 SOLAR DECATHLON 2017
 WWW.SOLARDECATHLON.GOV



MARK	DATE	DESCRIPTION
0	17-11-2016	90% revision

LOT NUMBER: 106
 DRAWN BY: Author
 CHECKED BY: Selficient
 COPYRIGHT: NONE; PROJECT IS PUBLIC DOMAIN
 SCALE: 1 : 50
 SHEET TITLE

DETAIL OVERVIEW FLOOR PLAN

A-400

TEAM NAME: Selficient
 ADDRESS: Padualaan 99
 3584 CH Utrecht
 CONTACT: info@selficient.org
 www.selficient.org

CONSULTANTS
 ARCHITECTURE
 ENGINEERS
 LANDSCAPING
 SAFETY FIRST CODE CONSULTANTS

CLIENT
 U.S. DEPARTMENT OF ENERGY
 SOLAR DECATHLON 2017
 WWW.SOLARDECATHLON.GOV



0	17-11-2016	90% revision
---	------------	--------------

MARK	DATE	DESCRIPTION
------	------	-------------


LOT NUMBER: 106
 DRAWN BY: Author
 CHECKED BY: Selficient
 COPYRIGHT: NONE; PROJECT IS PUBLIC DOMAIN

SCALE: 1 : 50


SHEET TITLE

DETAIL OVERVIEW
 ELEVATIONS

A-401

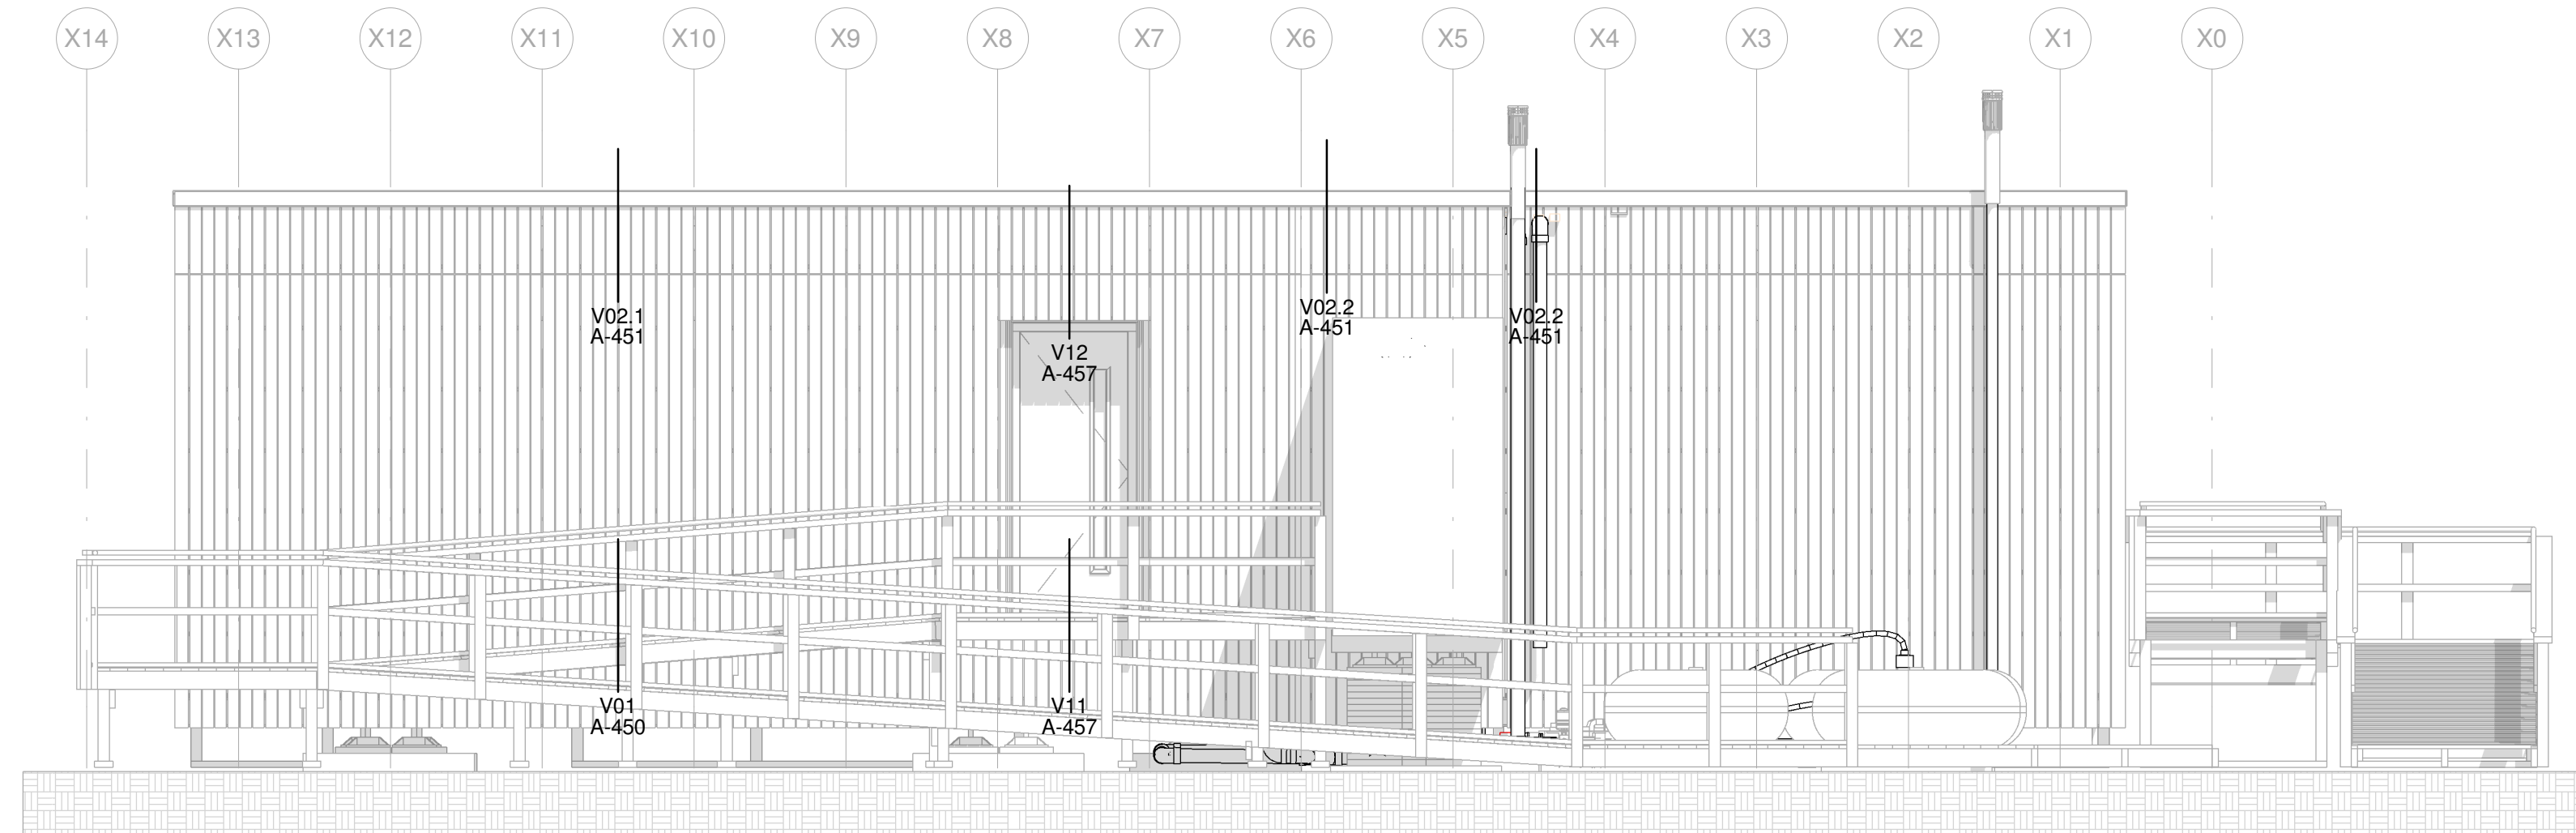

NORTH ELEVATION
 1 : 50

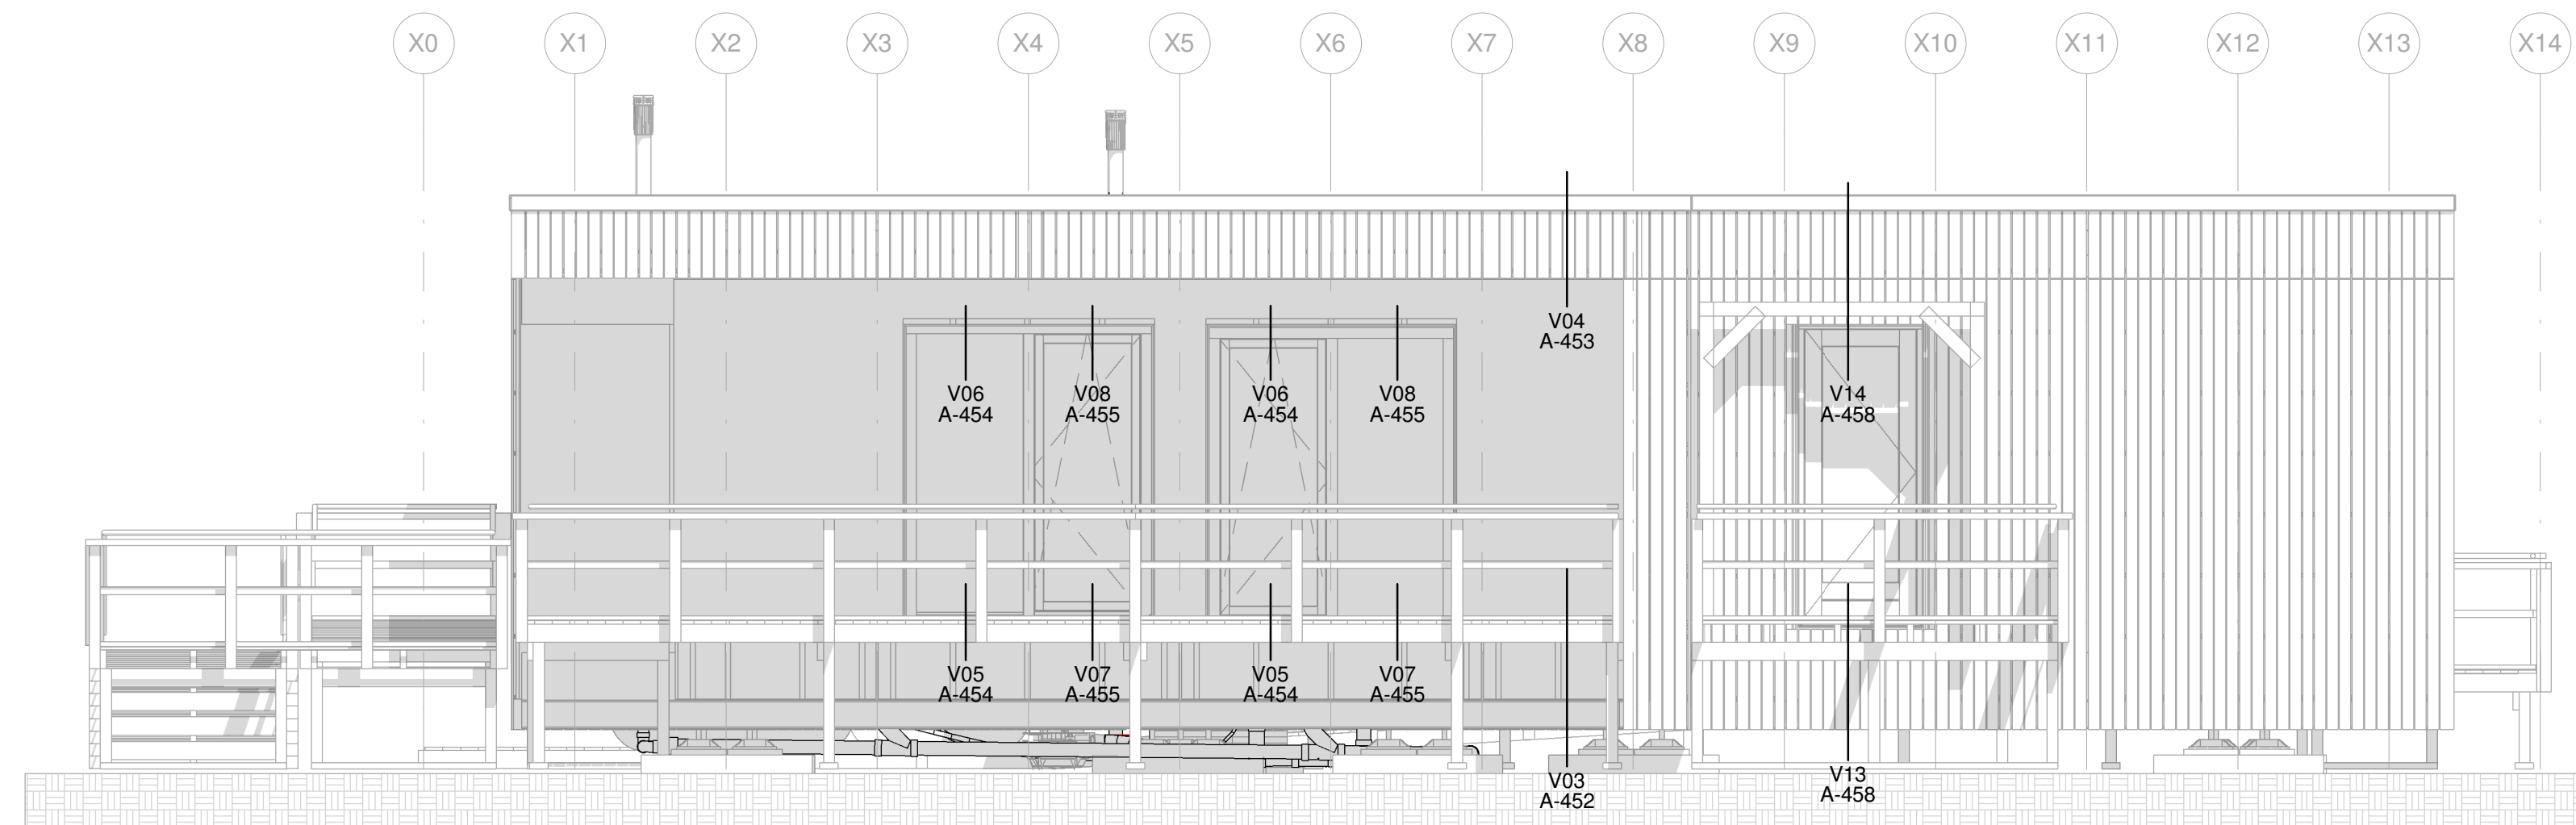

SOUTH ELEVATION
 1 : 50



TEAM NAME: Selficient
 ADDRESS: Padualaan 99
 3584 CH Utrecht
 CONTACT: info@selficient.org
 www.selficient.org

CONSULTANTS
 ARCHITECTURE
 ENGINEERS
 LANDSCAPING
 SAFETY FIRST CODE CONSULTANTS



CLIENT
 U.S. DEPARTMENT OF ENERGY
 SOLAR DECATHLON 2017
 WWW.SOLARDECATHLON.GOV



0	17-11-2016	90% revision
---	------------	--------------


MARK	DATE	DESCRIPTION

SCALE: 1 : 50


SHEET TITLE

DETAIL OVERVIEW
 ELEVATIONS

A-402

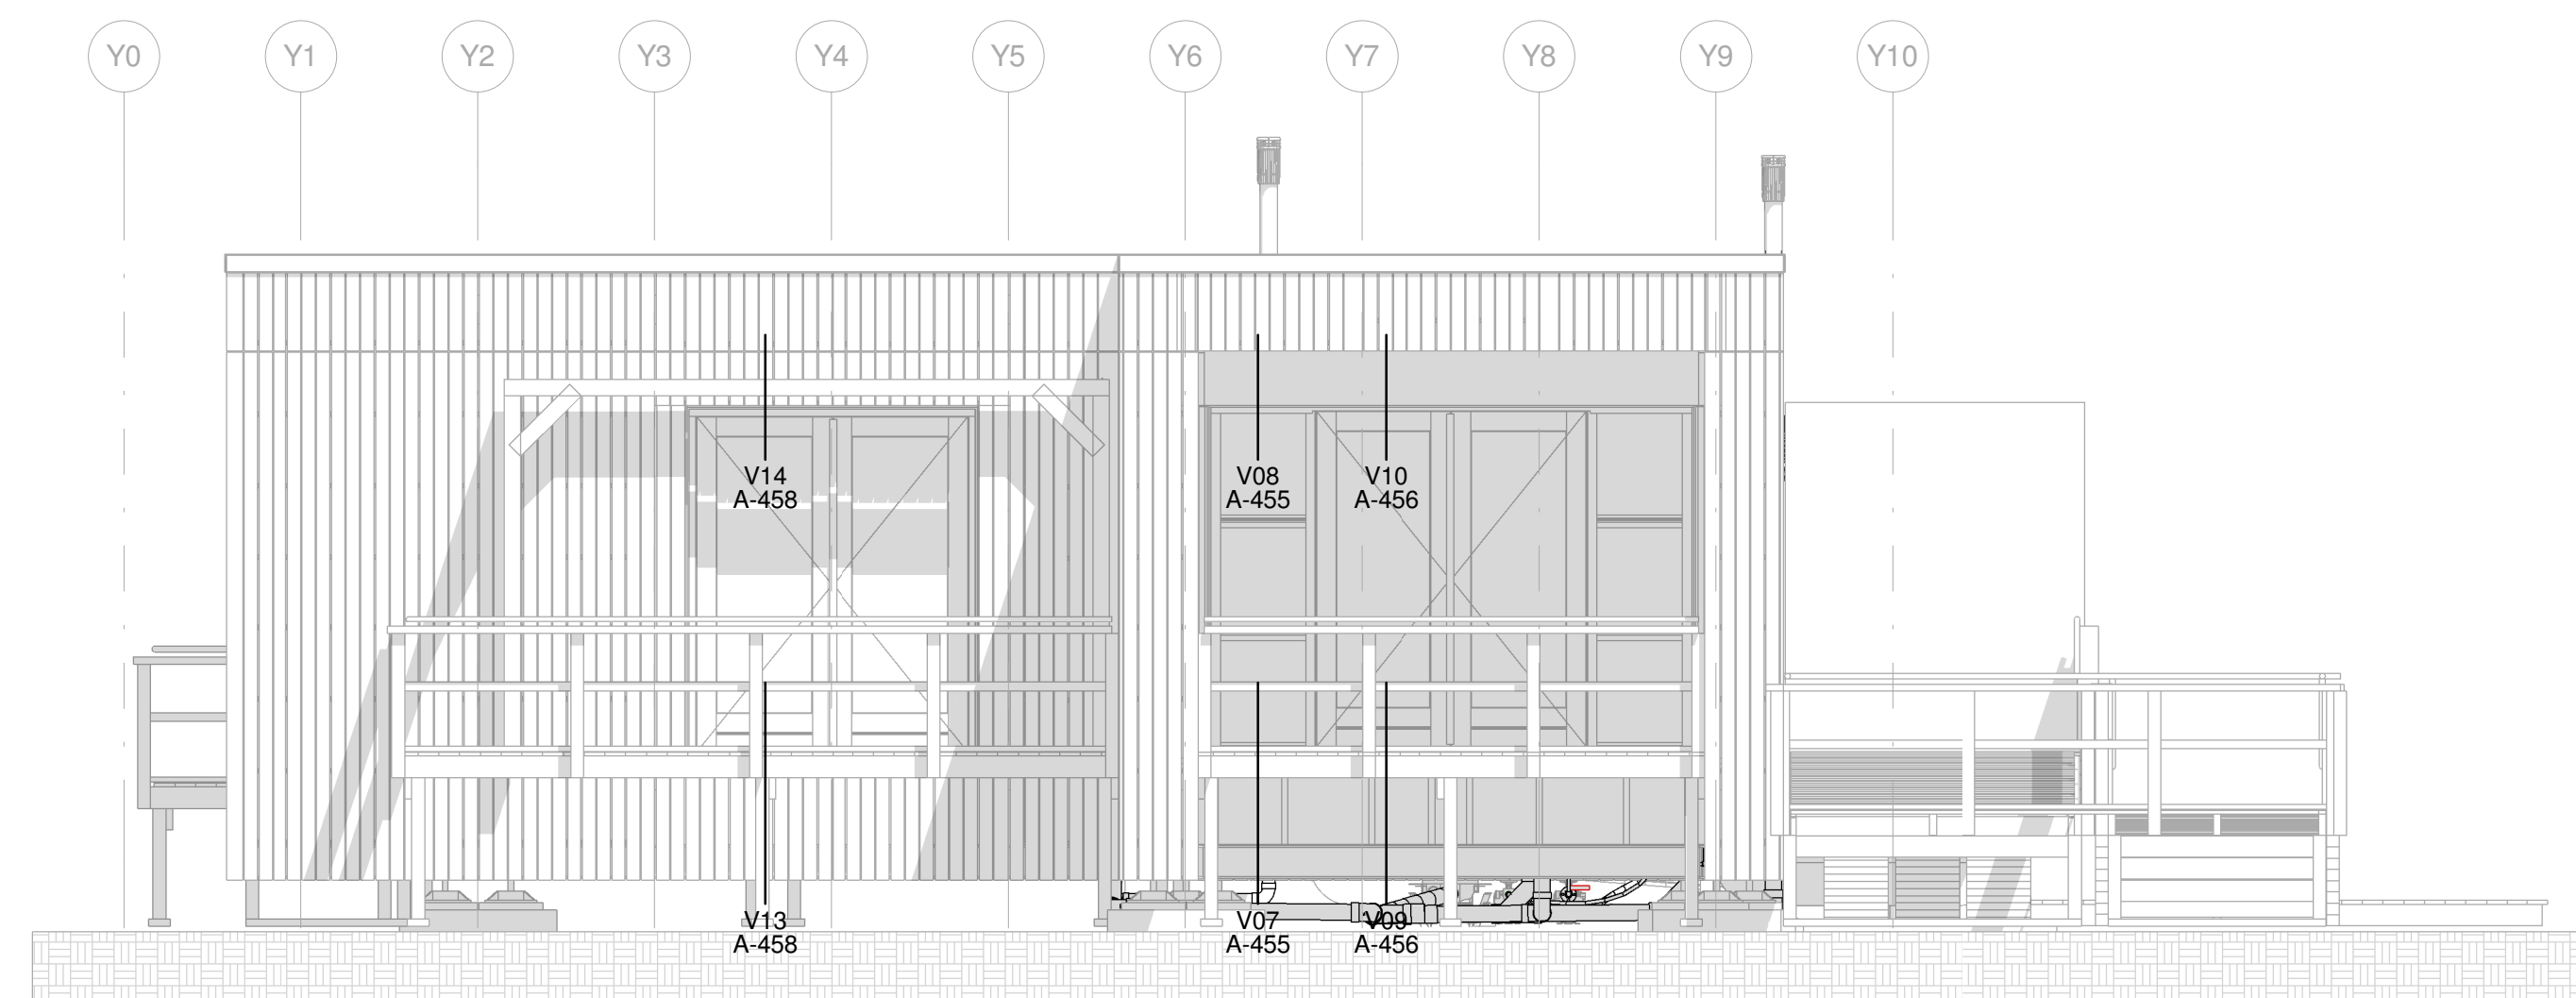

EAST ELEVATION
 1 : 50

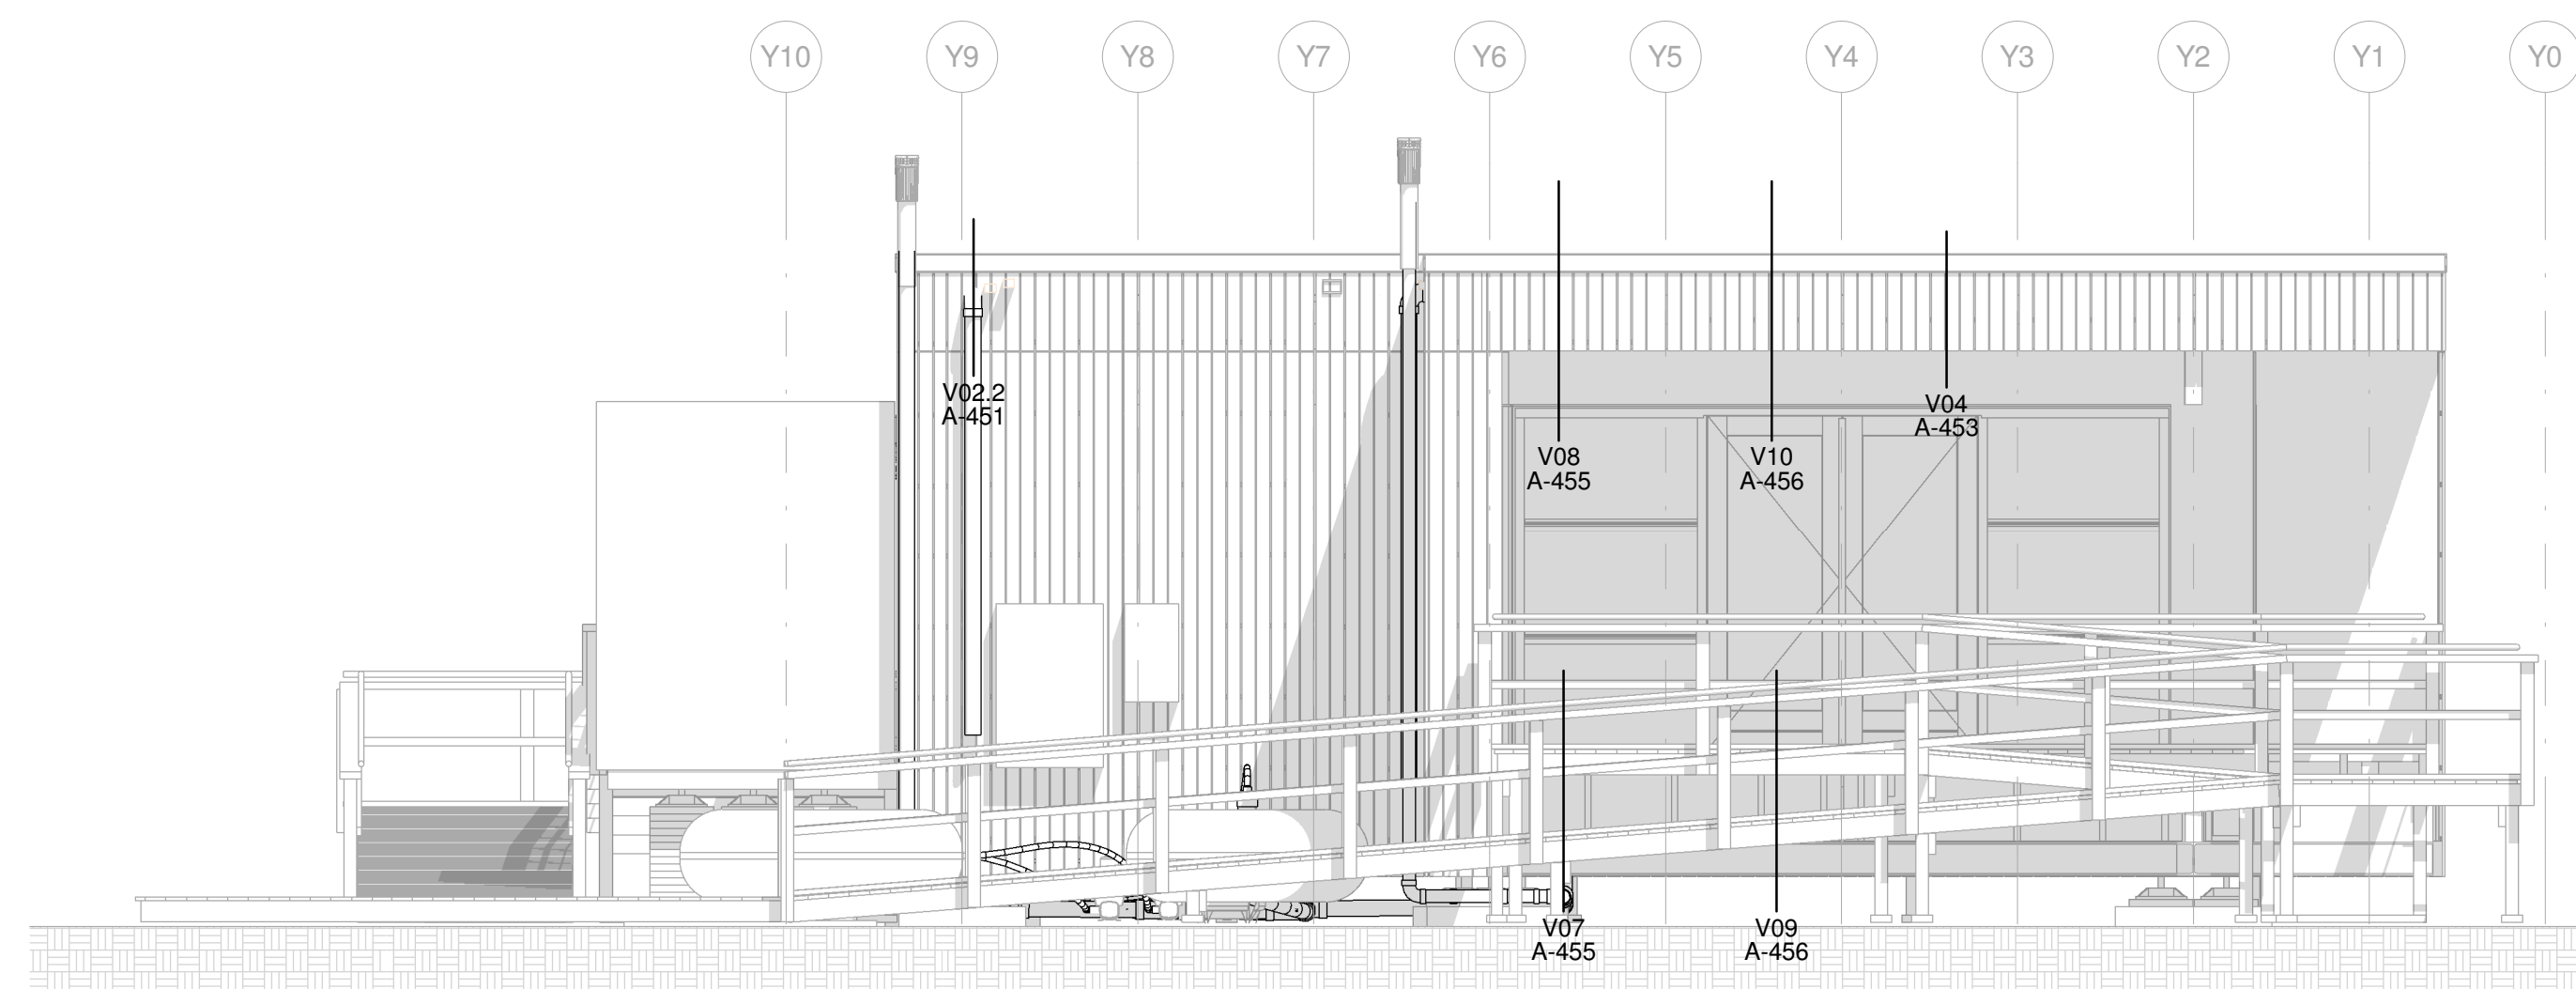

WEST ELEVATION
 1 : 50

TEAM NAME: Selficient
 ADDRESS: Padualaan 99
 3584 CH Utrecht
 CONTACT: info@selficient.org
 www.selficient.org

CONSULTANTS
 ARCHITECTURE
 ENGINEERS
 LANDSCAPING
 SAFETY FIRST CODE CONSULTANTS

CLIENT
 U.S. DEPARTMENT OF ENERGY
 SOLAR DECATHLON 2017
 WWW.SOLARDECATHLON.GOV




MARK	DATE	DESCRIPTION
0	17-11-2016	90% revision


LOT NUMBER: 106
 DRAWN BY: Author
 CHECKED BY: Selficient
 COPYRIGHT: NONE; PROJECT IS PUBLIC DOMAIN

SCALE: 1 : 5


SHEET TITLE
**DETAIL H01 -
 CONNECTION FACADE
 PANELS**

A-410

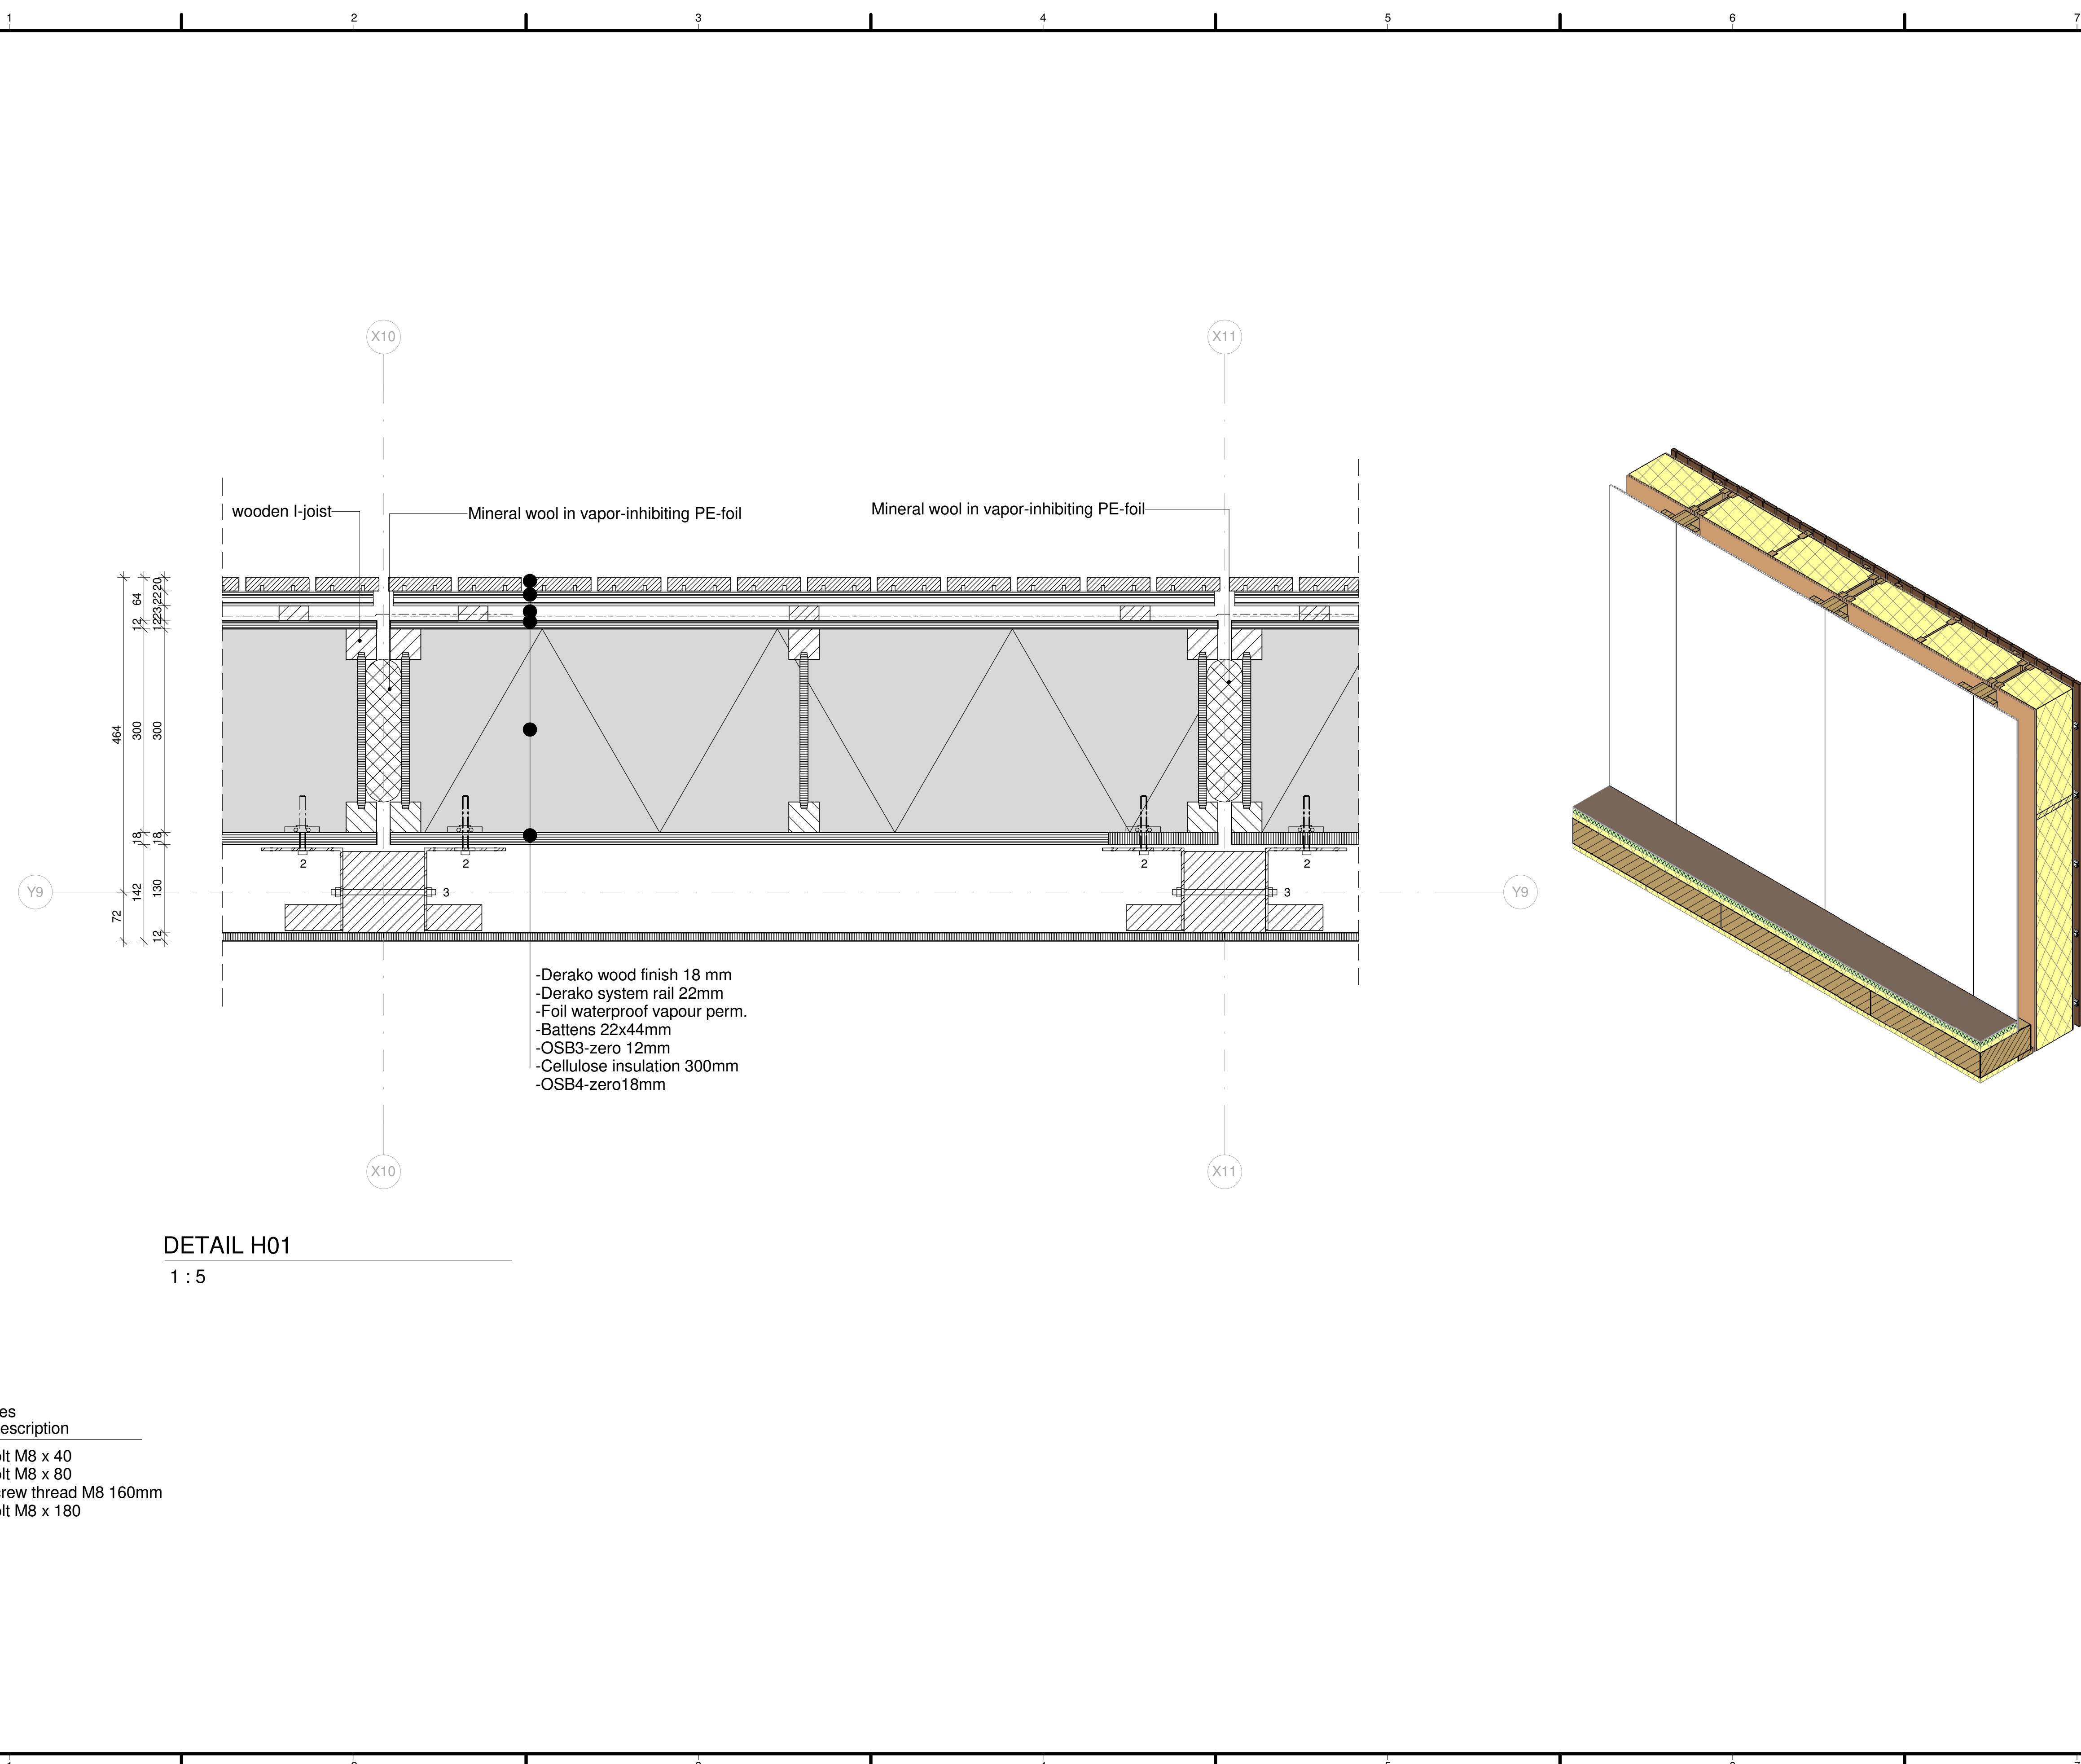

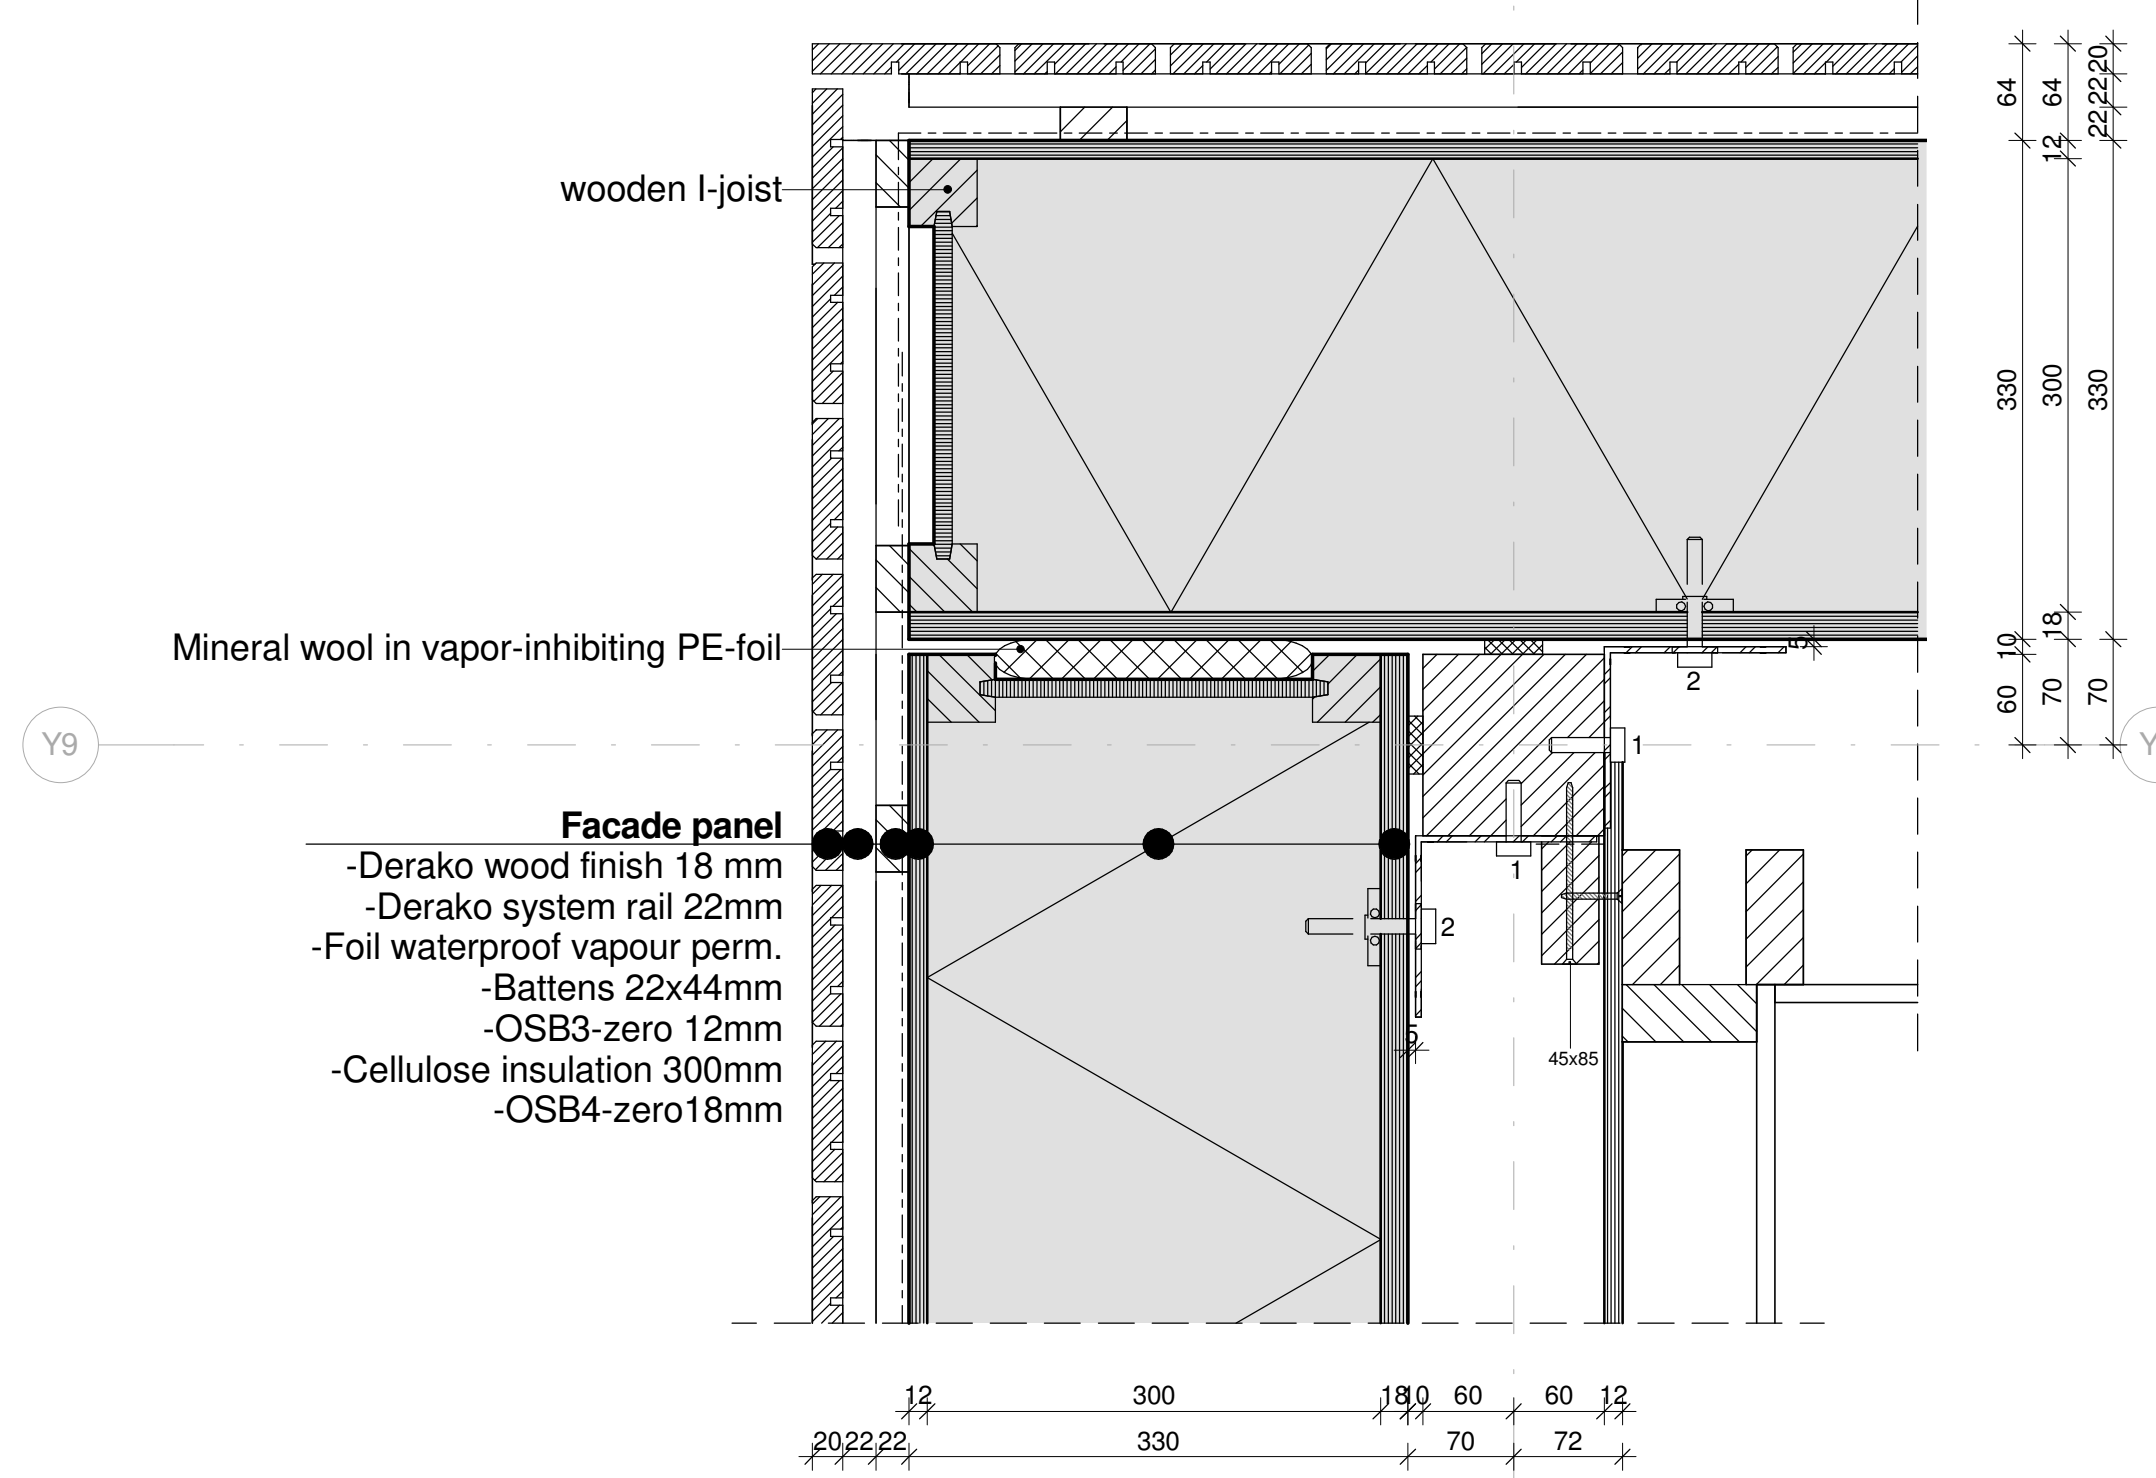

DETAIL H02
 1 : 5

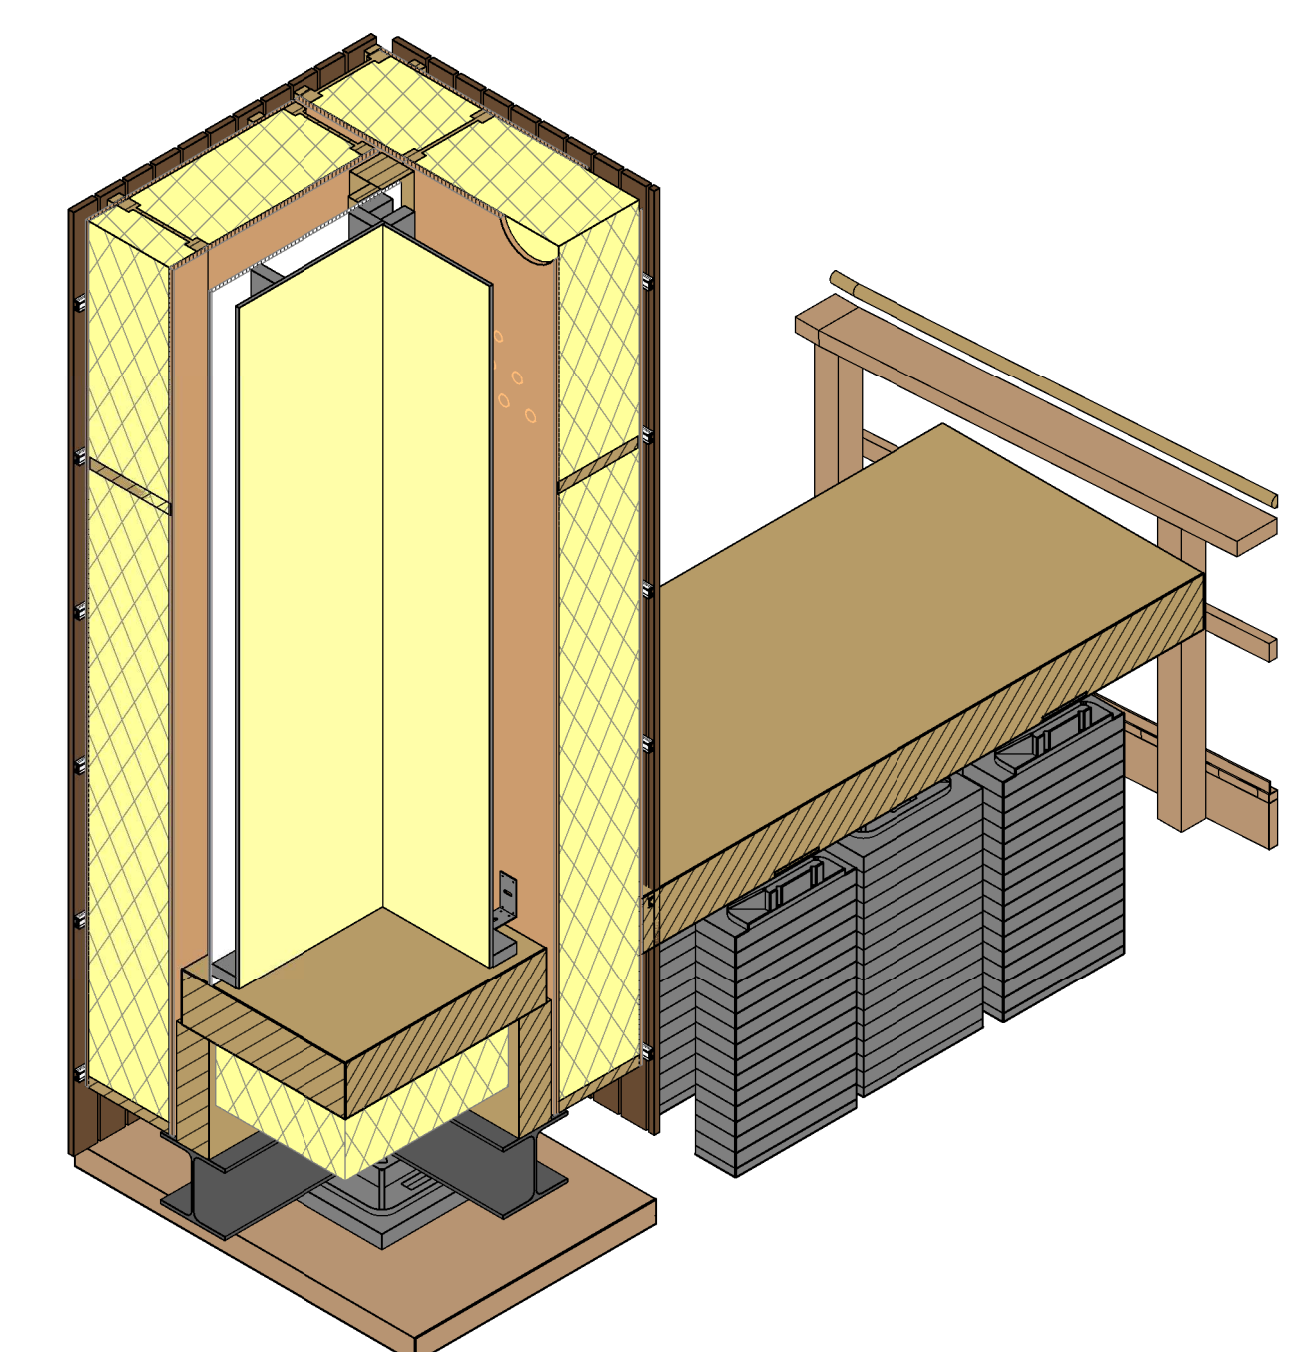

Bolt types

NR.	Description
1	Bolt M8 x 40
2	Bolt M8 x 80
3	Screw thread M8 160mm
4	Bolt M8 x 180

TEAM NAME: Selficient
 ADDRESS: Padualaan 99
 3584 CH Utrecht
 CONTACT: info@selficient.org
 www.selficient.org

CONSULTANTS
 ARCHITECTURE
 ENGINEERS
 LANDSCAPING
 SAFETY FIRST CODE CONSULTANTS

CLIENT
 U.S. DEPARTMENT OF ENERGY
 SOLAR DECATHLON 2017
 WWW.SOLARDECATHLON.GOV



0	17-11-2016	90% revision
---	------------	--------------


MARK	DATE	DESCRIPTION
------	------	-------------

LOT NUMBER: 106
 DRAWN BY: Author
 CHECKED BY: Selficient
 COPYRIGHT: NONE; PROJECT IS PUBLIC DOMAIN

SCALE: 1 : 5

SHEET TITLE

DETAIL H03 -
 CONNECTION INSIDE
 CORNER FACADE
 PANELS
A-412

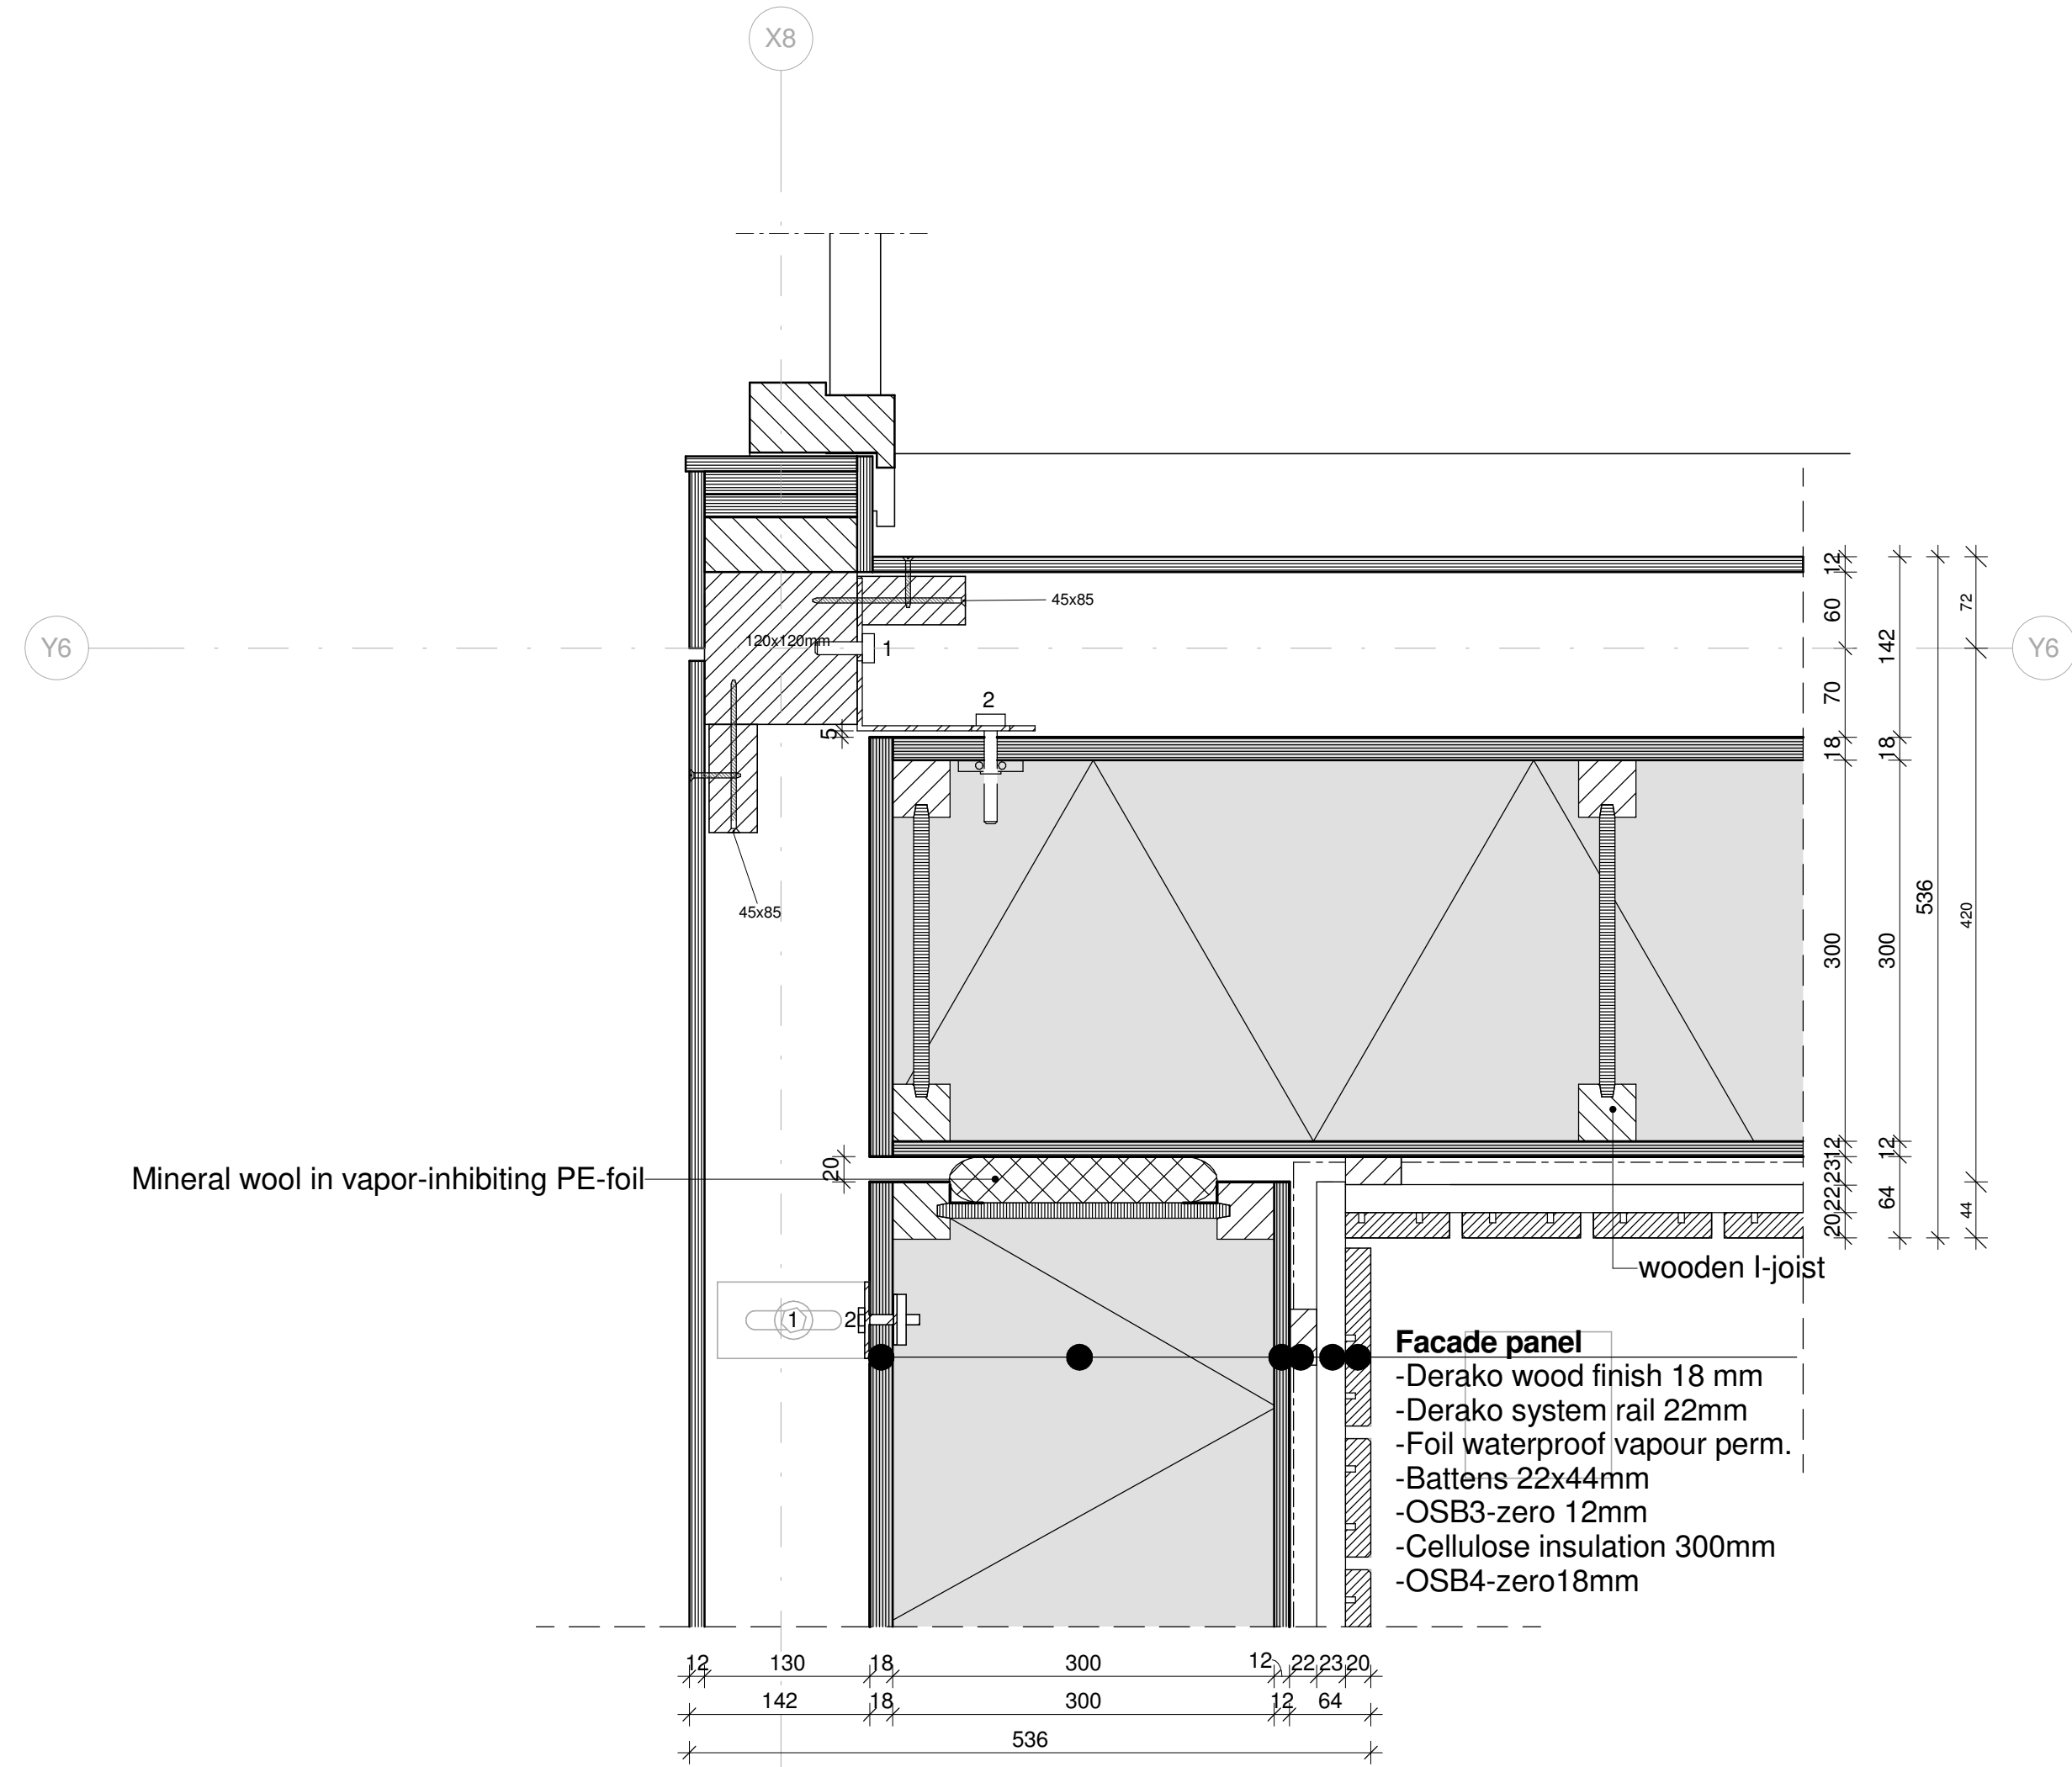


DETAIL H03

1 : 5

Bolt types

NR.	Description
1	Bolt M8 x 40
2	Bolt M8 x 80
3	Screw thread M8 160mm
4	Bolt M8 x 180

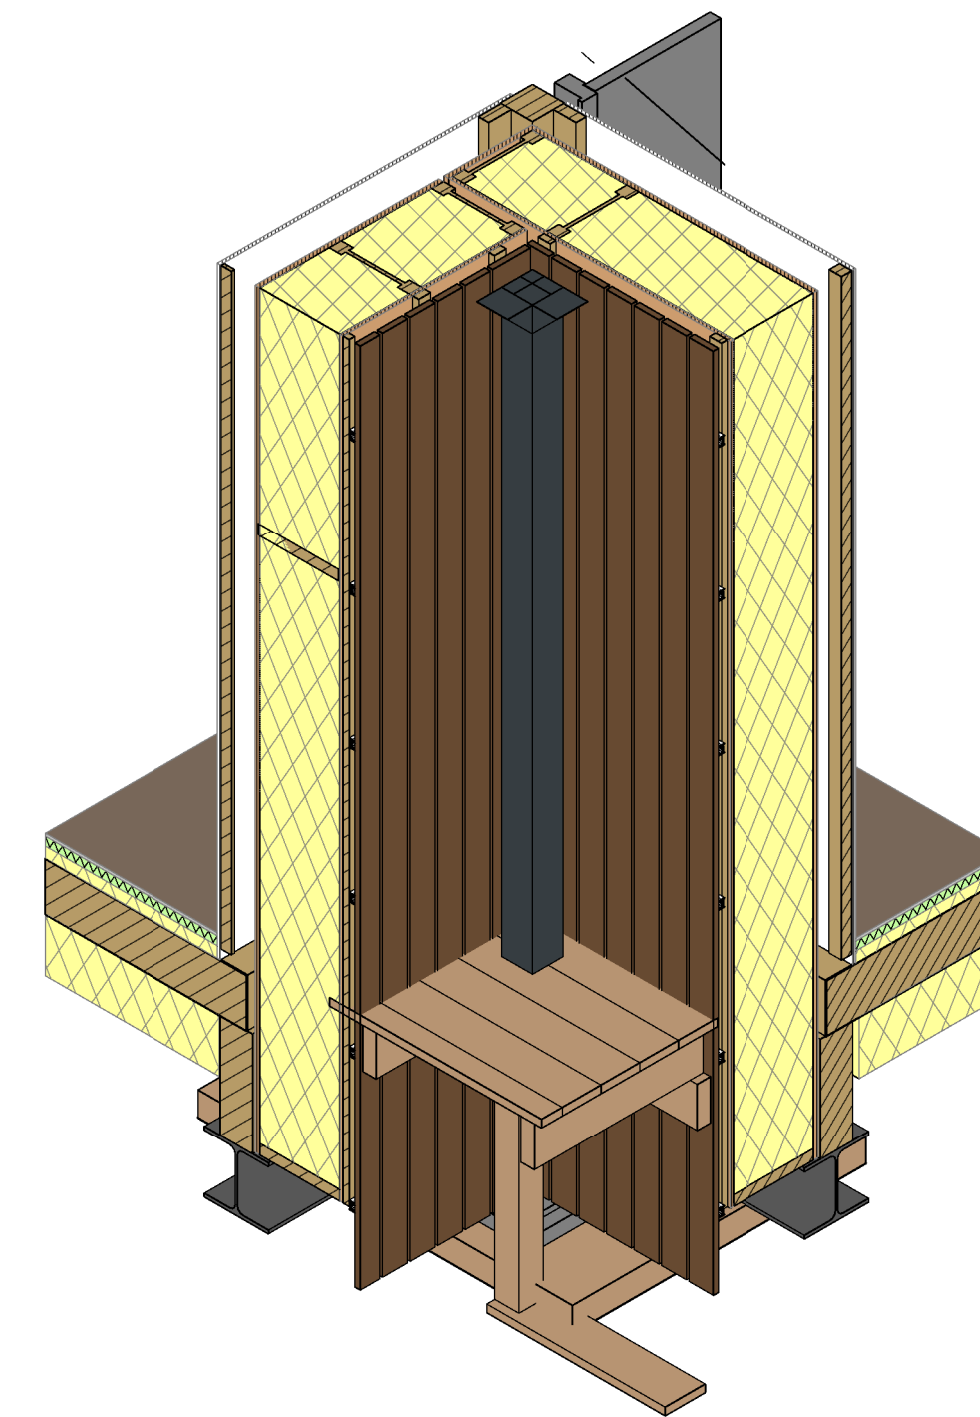



TEAM NAME: Selficient
 ADDRESS: Padualaan 99
 3584 CH Utrecht
 CONTACT: info@selficient.org
 www.selficient.org

CONSULTANTS
 ARCHITECTURE
 ENGINEERS
 LANDSCAPING
 SAFETY FIRST CODE CONSULTANTS

CLIENT
 U.S. DEPARTMENT OF ENERGY
 SOLAR DECATHLON 2017
 WWW.SOLARDECATHLON.GOV





MARK	DATE	DESCRIPTION
0	17-11-2016	90% revision

LOT NUMBER: 106
 DRAWN BY: Author
 CHECKED BY: Selficient
 COPYRIGHT: NONE; PROJECT IS PUBLIC DOMAIN

SCALE: 1:5

SHEET TITLE


DETAIL H04 -
 CONNECTION INSIDE
 CORNER FACADE
 PANELS
A-413

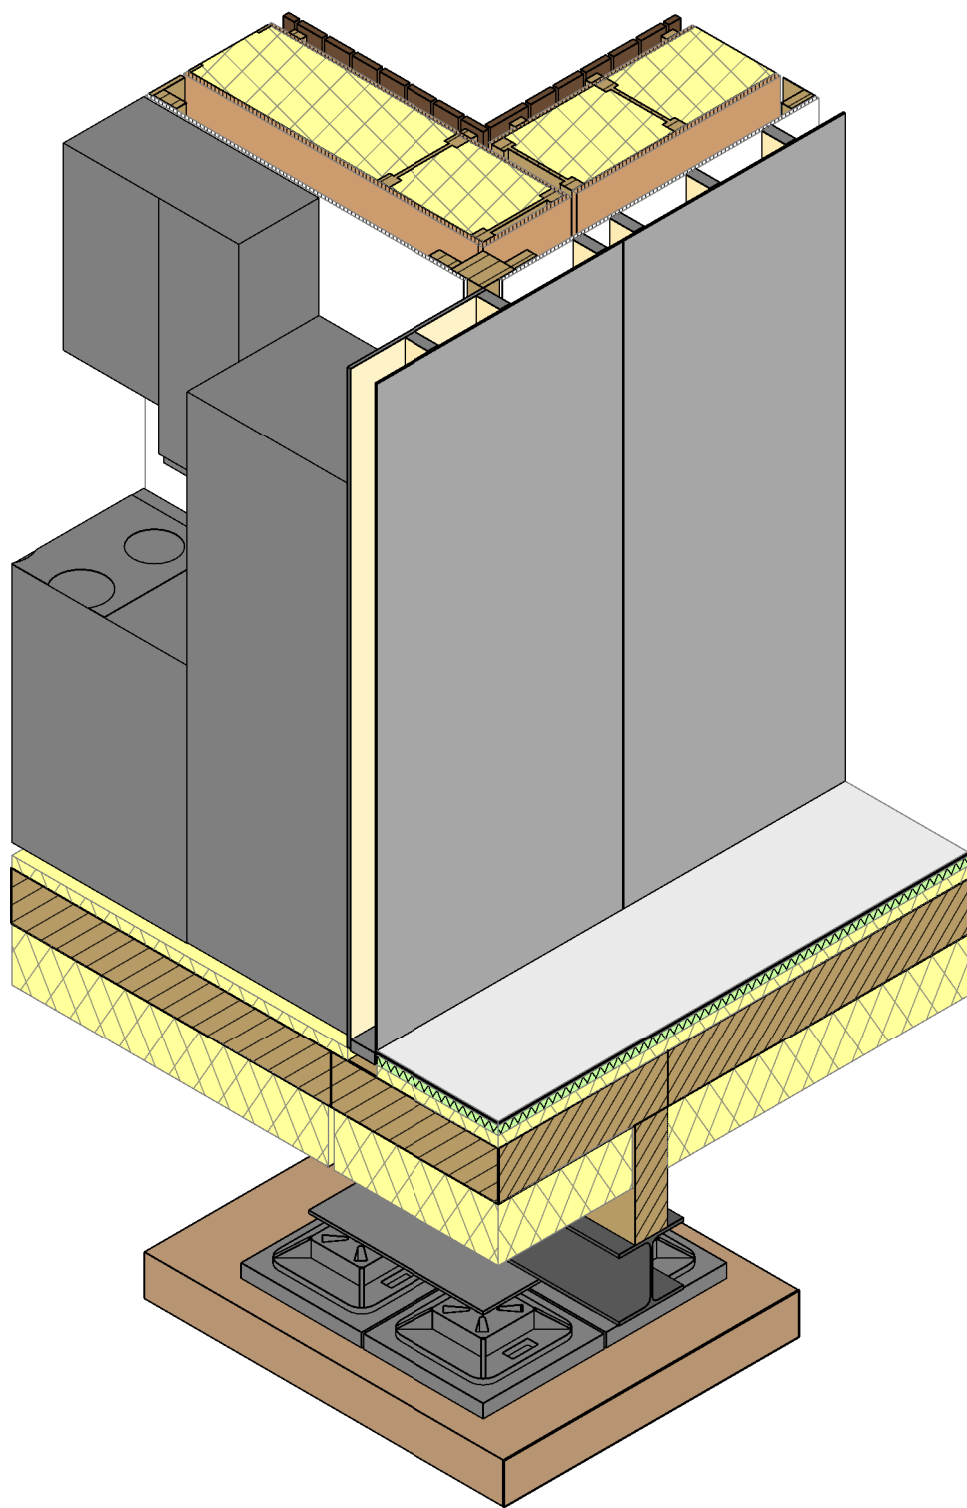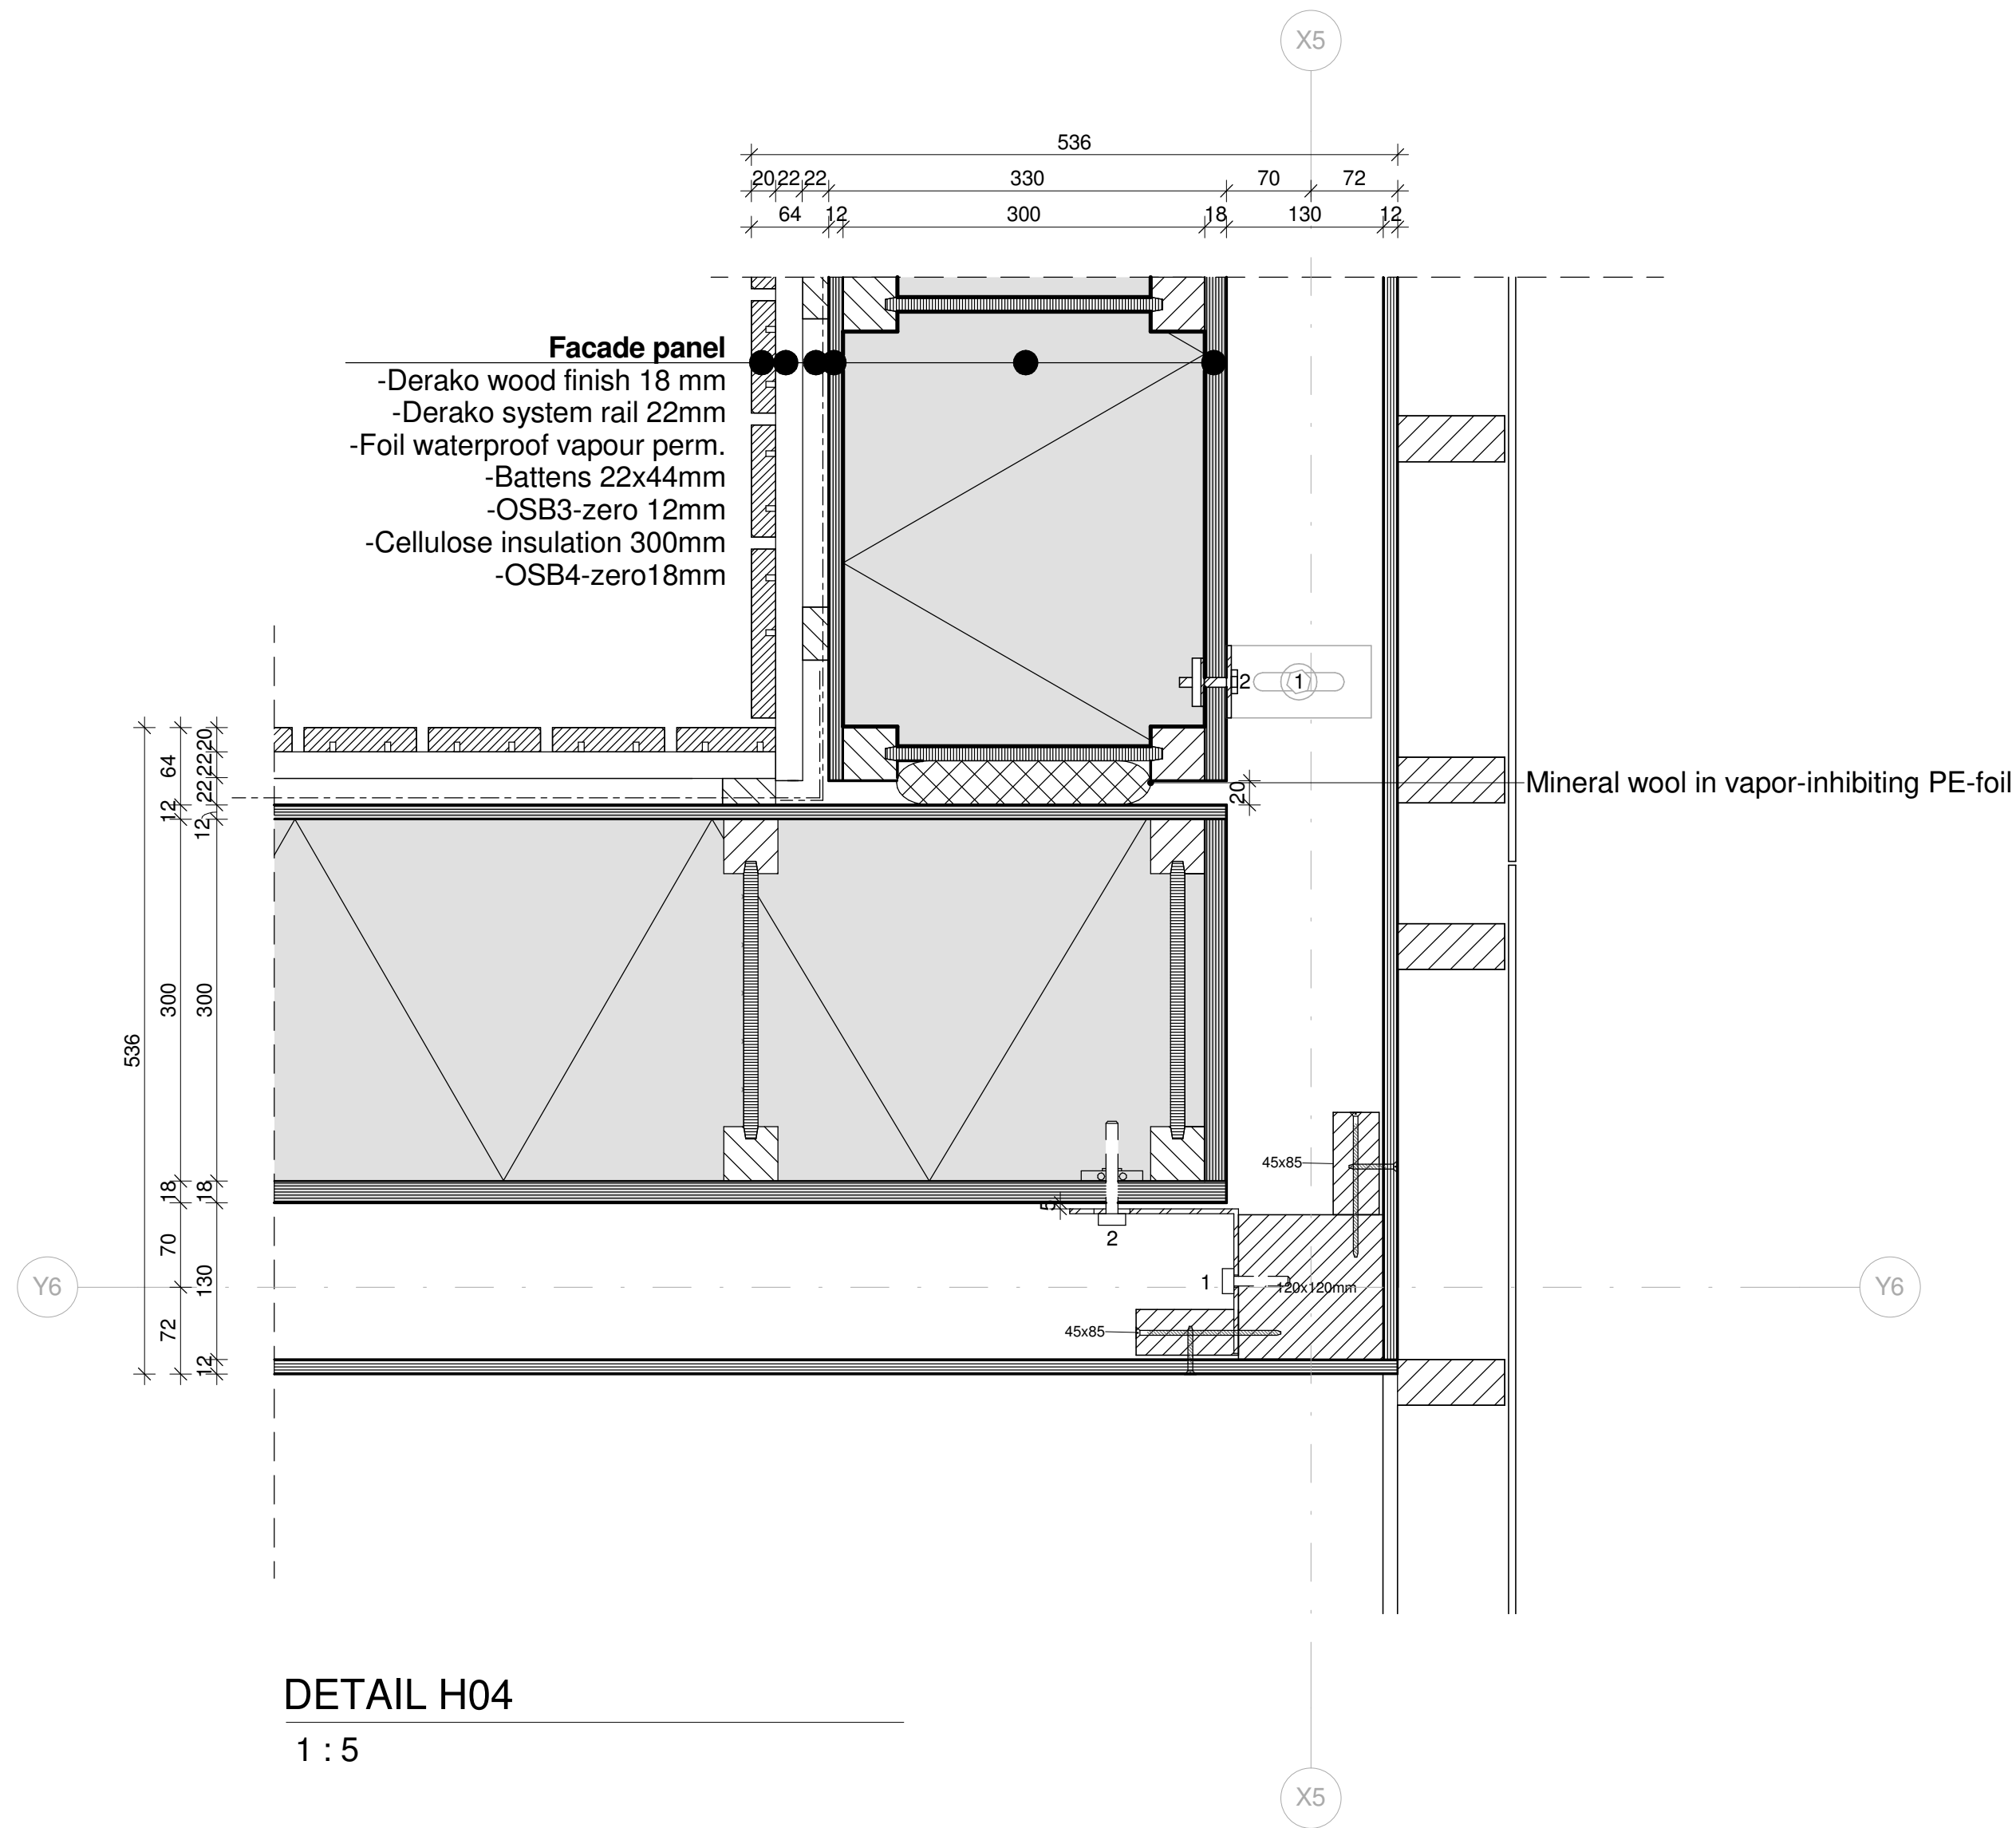

Bolt types

NR.	Description
1	Bolt M8 x 40
2	Bolt M8 x 80
3	Screw thread M8 160mm
4	Bolt M8 x 180

DETAIL H04
 1:5

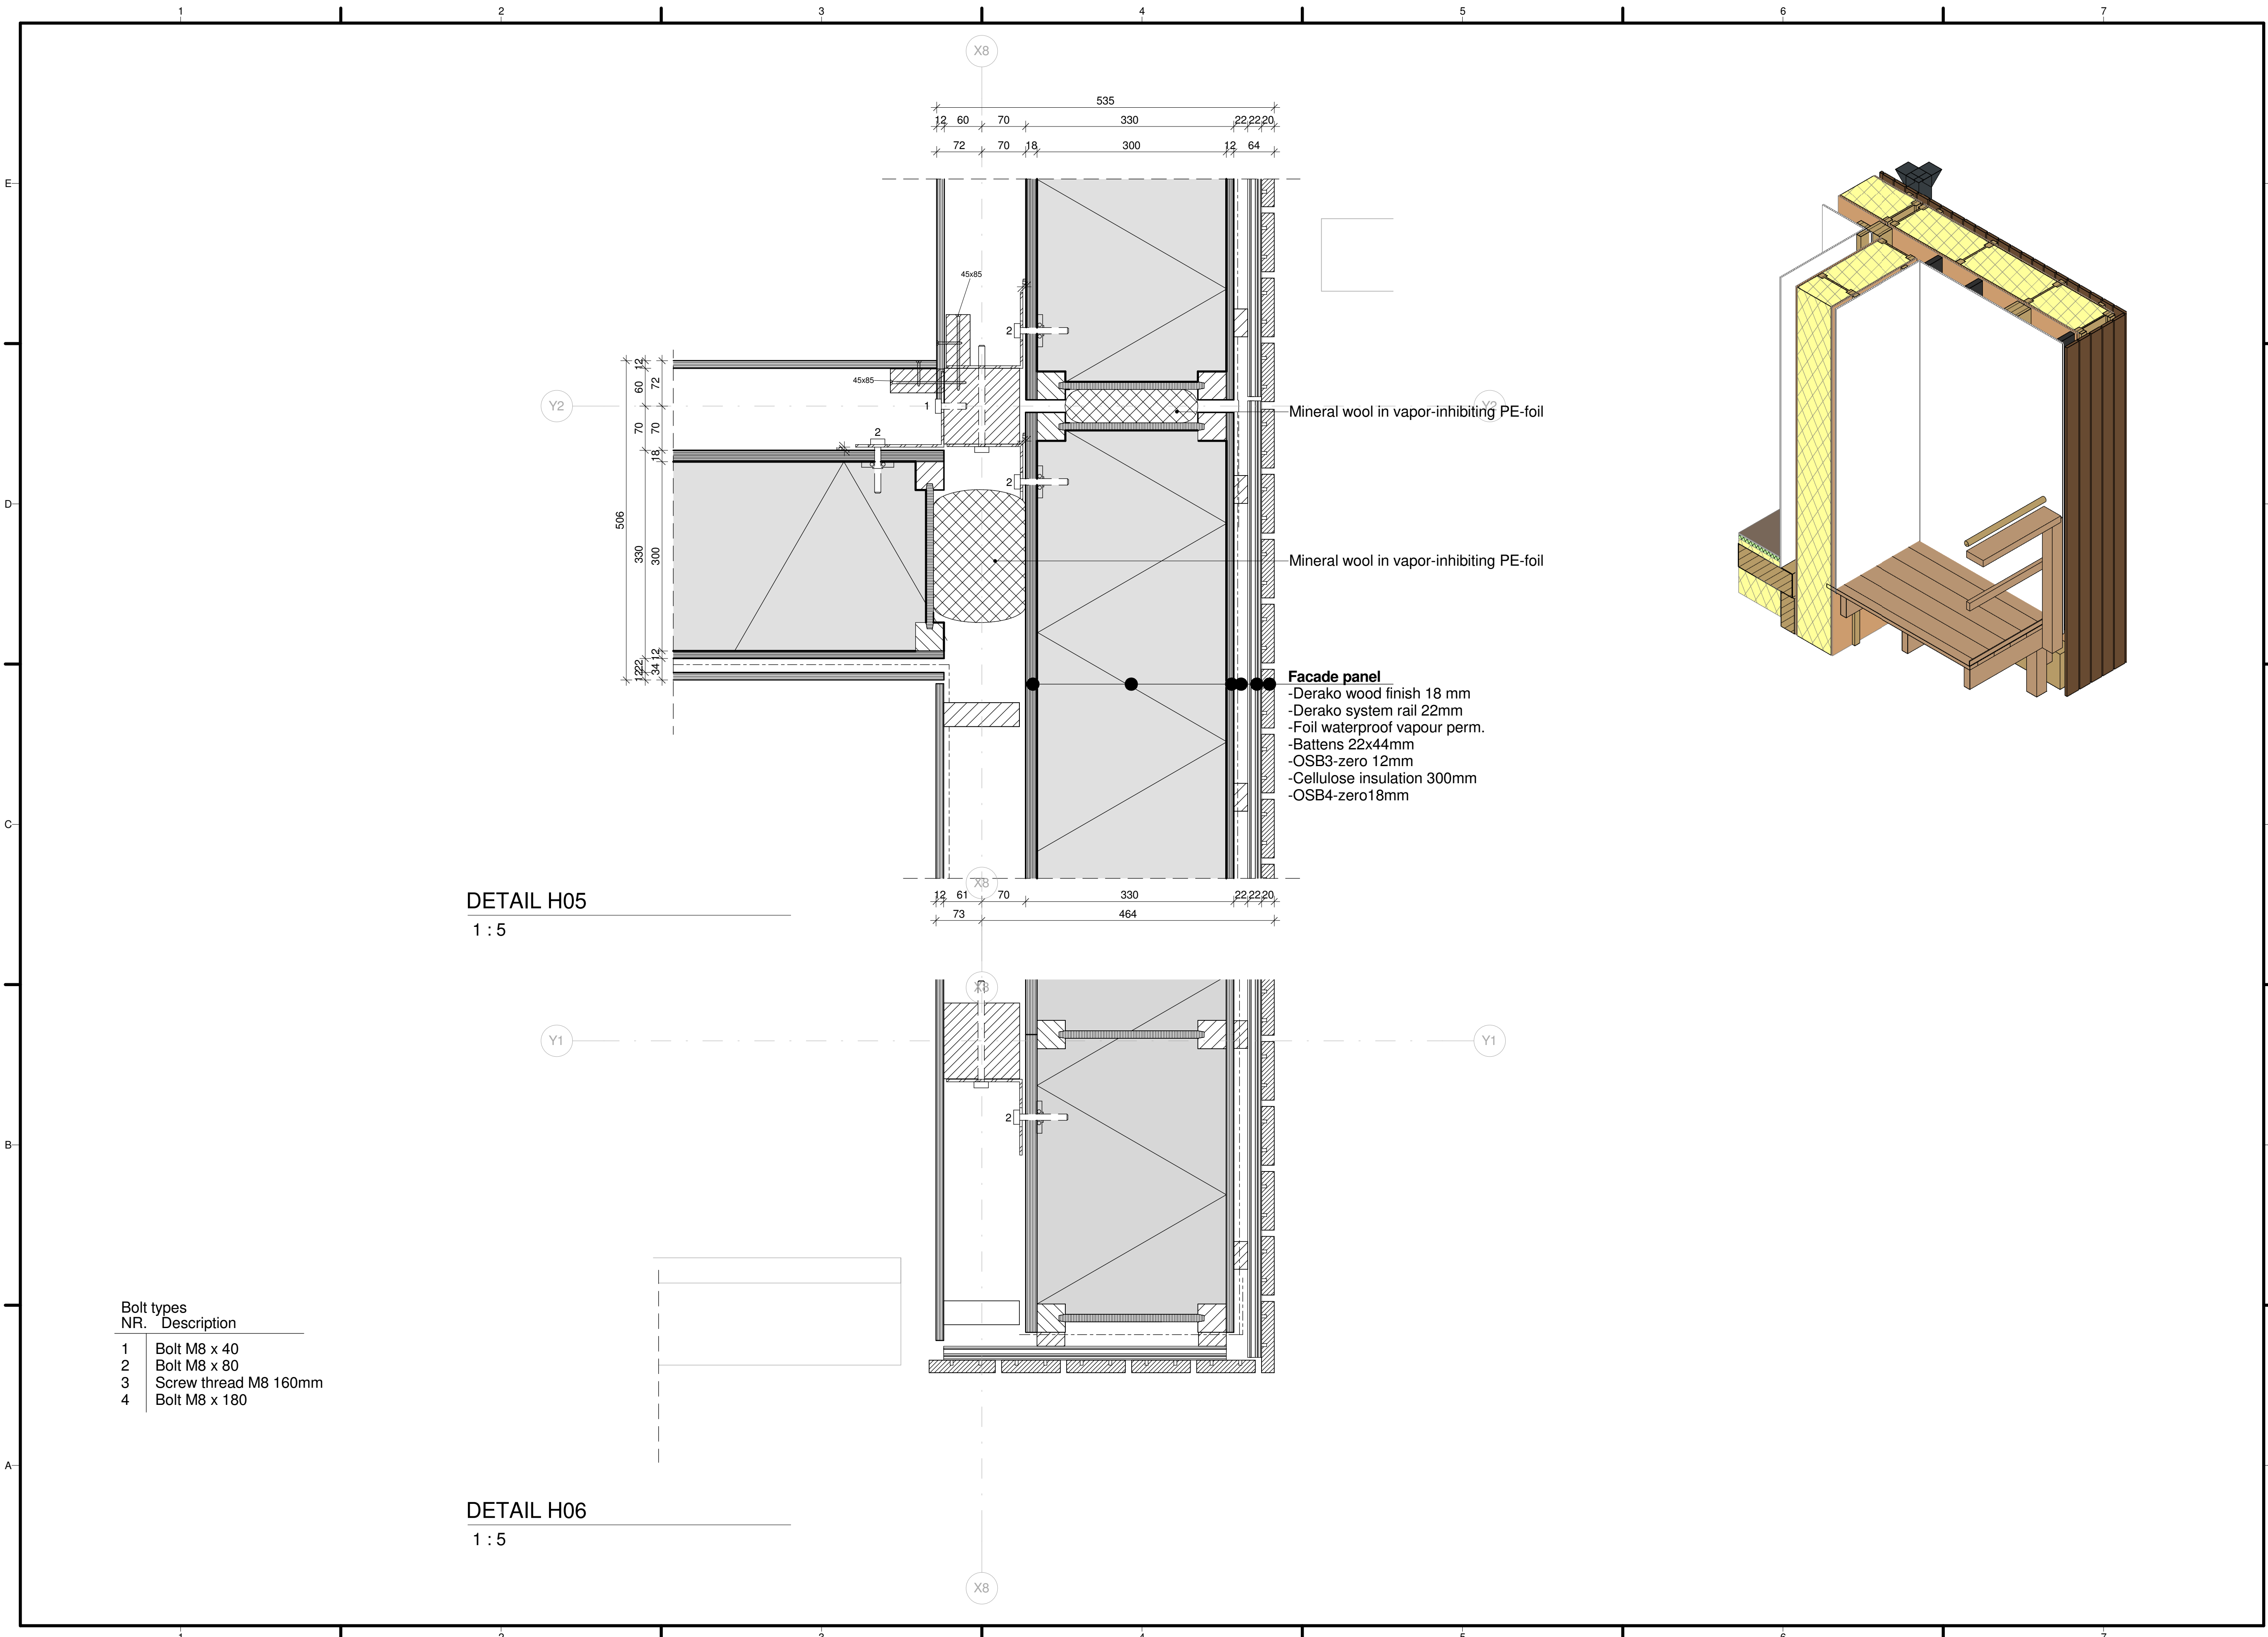

TEAM NAME: Selficient
 ADDRESS: Padualaan 99
 3584 CH Utrecht
 CONTACT: info@selficient.org
 www.selficient.org

CONSULTANTS
 ARCHITECTURE
 ENGINEERS
 LANDSCAPING
 SAFETY FIRST CODE CONSULTANTS

CLIENT
 U.S. DEPARTMENT OF ENERGY
 SOLAR DECATHLON 2017
 WWW.SOLARDECATHLON.GOV



0	17-11-2016	90% revision
---	------------	--------------

MARK	DATE	DESCRIPTION
------	------	-------------



LOT NUMBER: 106
 DRAWN BY: Author
 CHECKED BY: Selficient
 COPYRIGHT: NONE; PROJECT IS PUBLIC DOMAIN

SCALE: 1 : 5

SHEET TITLE

DETAIL H07 -
 CONNECTION
 TILT-TURN WINDOW

A-415

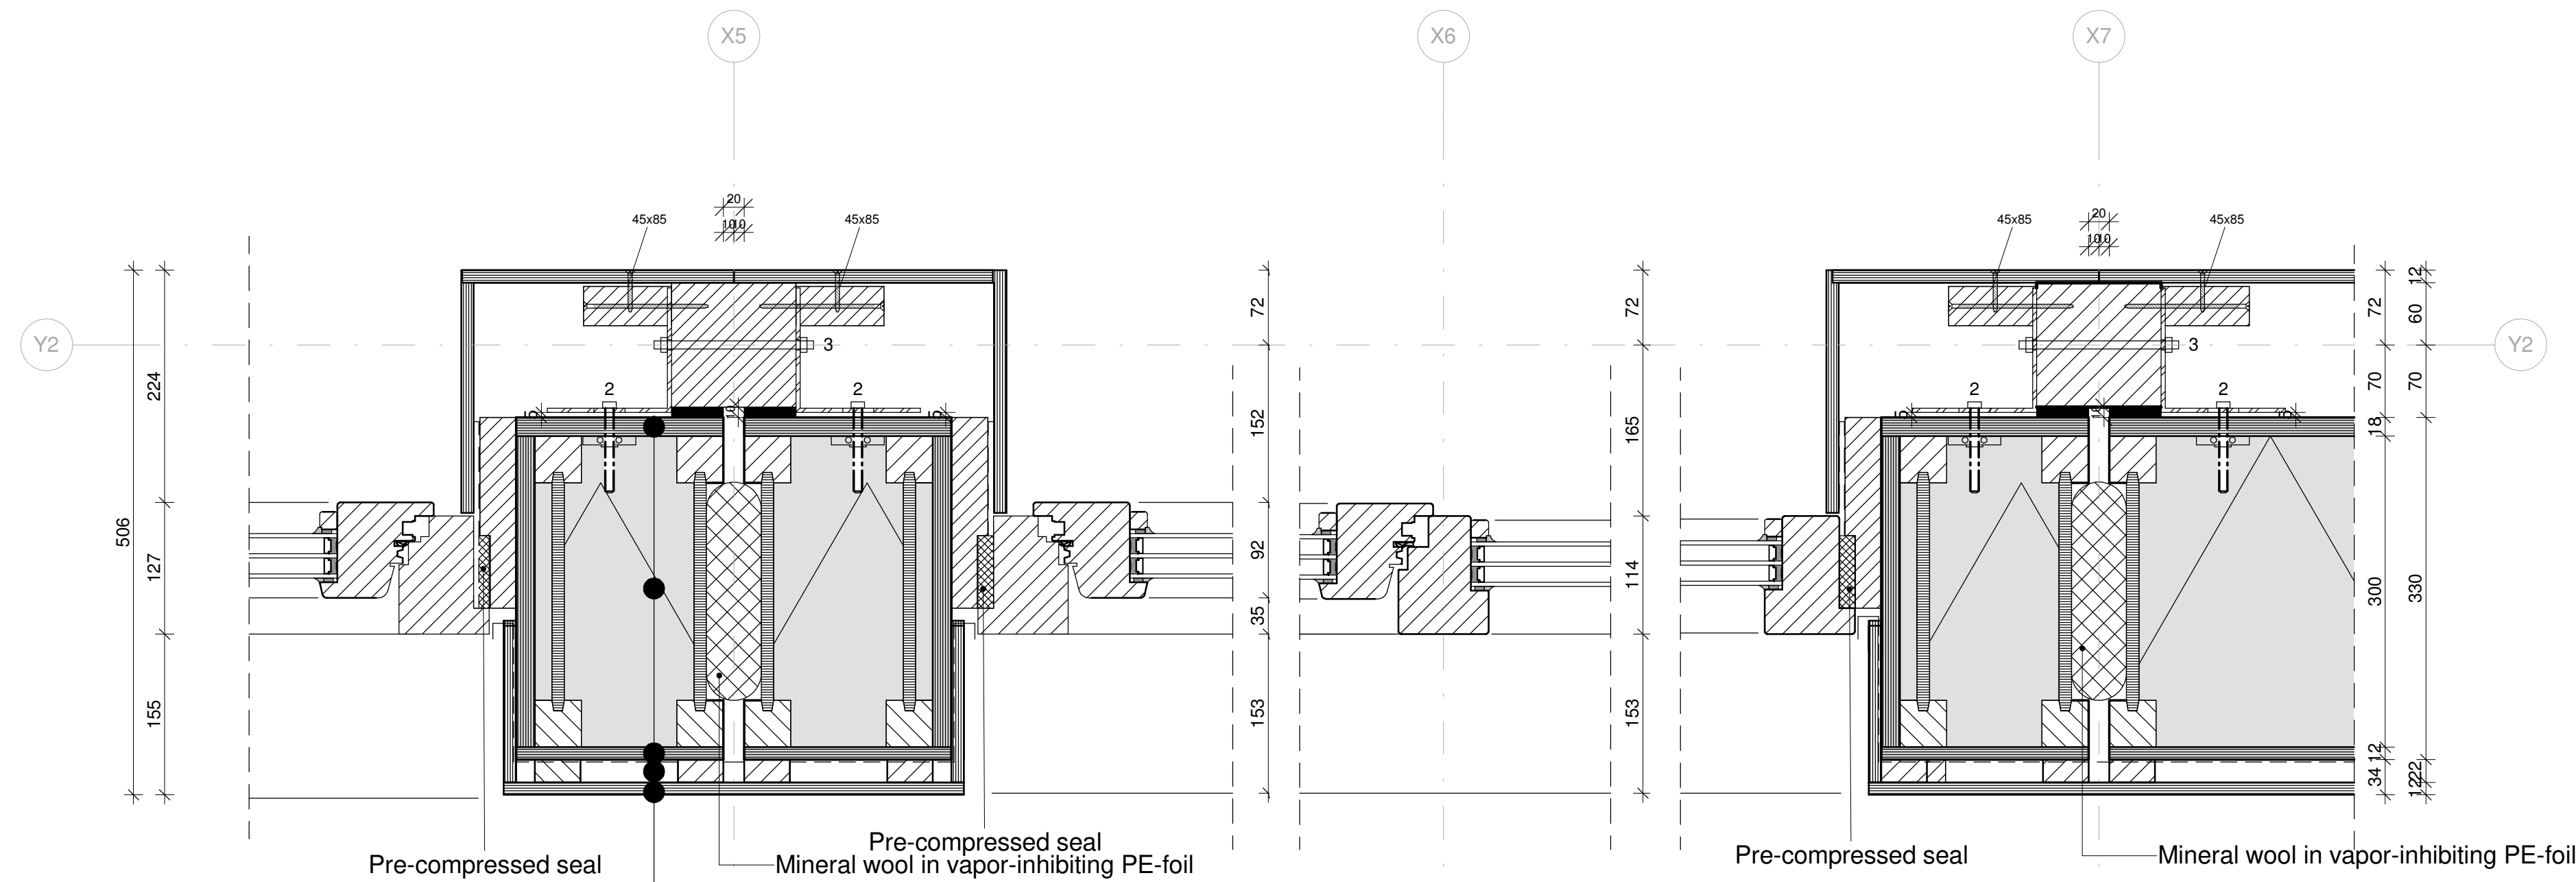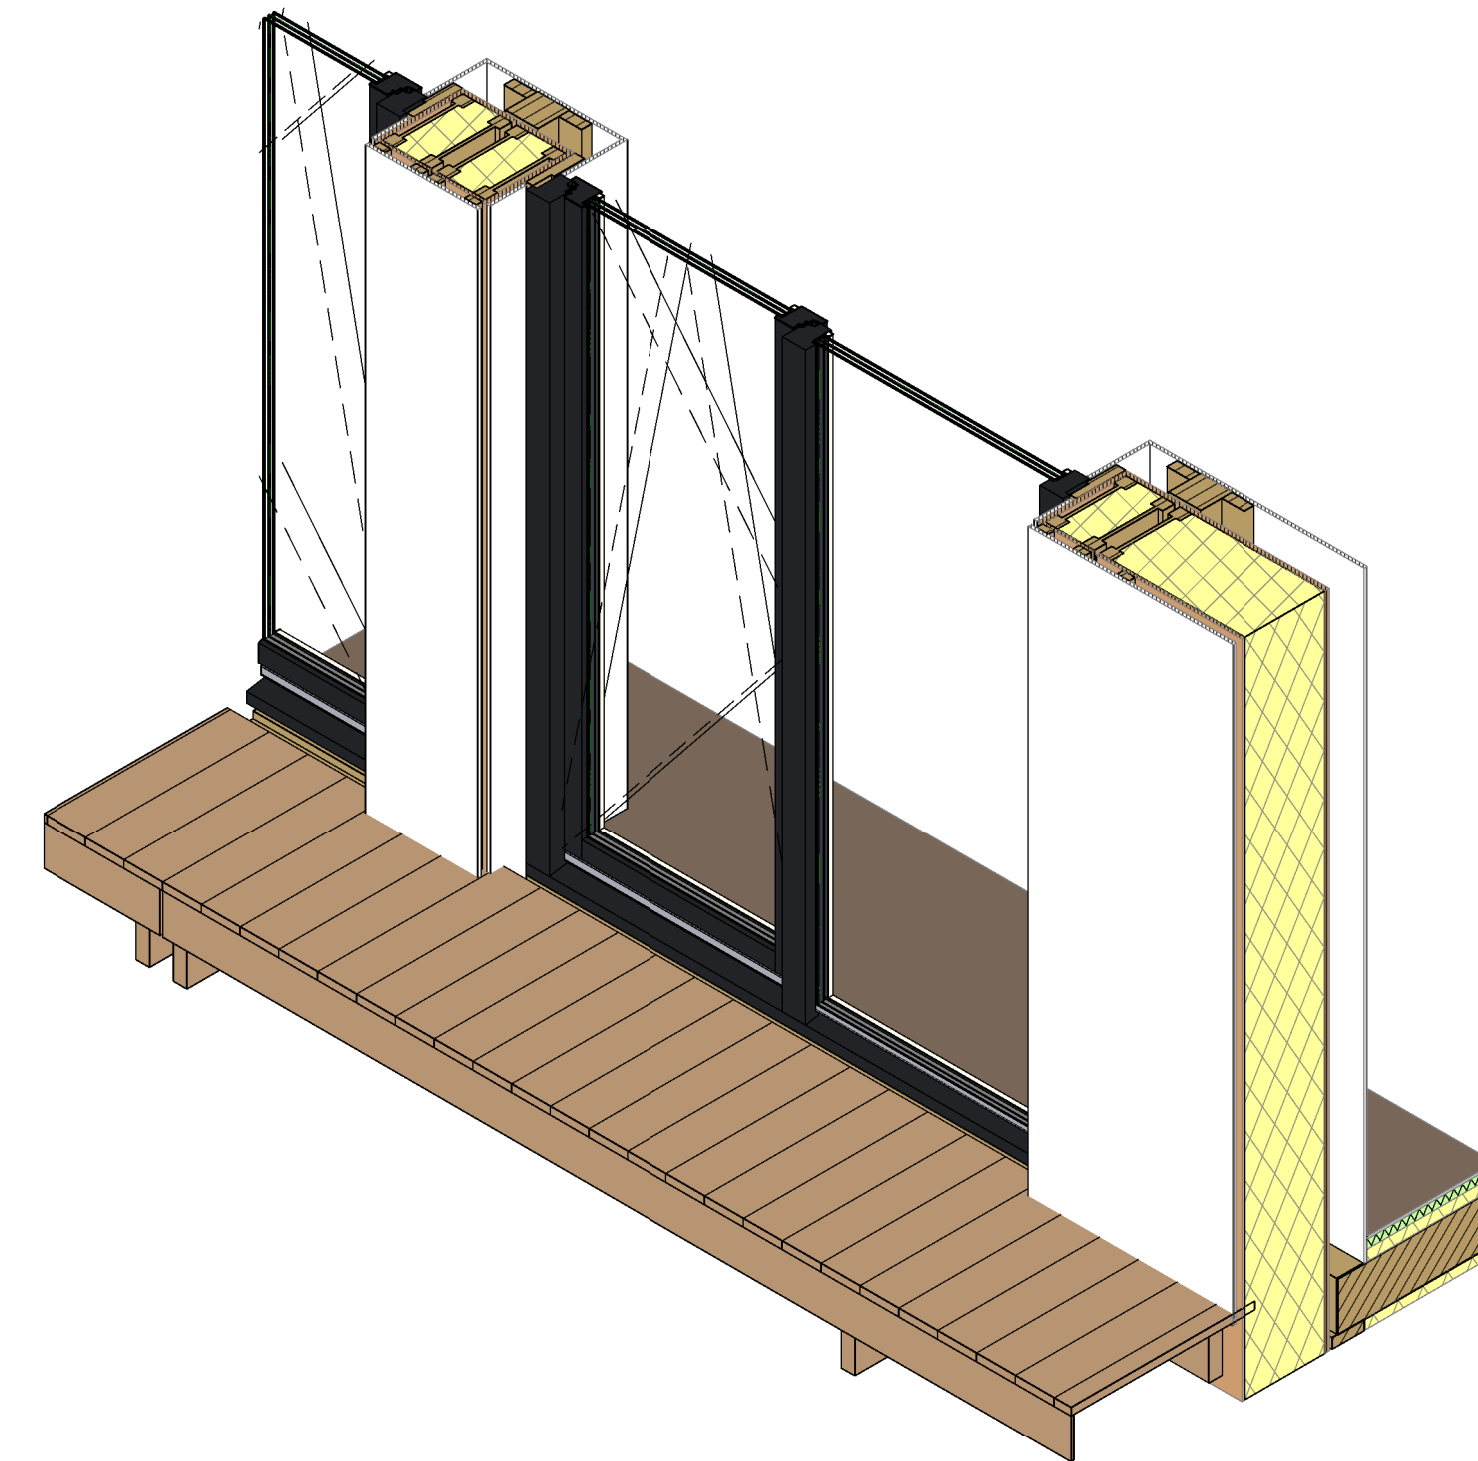

DETAIL H07
 1 : 5

FACADE PANEL
 -Plywood Okoume 12mm
 -Battens 22x44mm
 -Foil waterproof vapour perm.
 -OSB3-zero 12mm
 -Cellulose insulation I-JOISTS
 steicowall SW45ISO 300mm
 -OSB4-zero18mm

Bolt types	
NR.	Description
1	Bolt M8 x 40
2	Bolt M8 x 80
3	Screw thread M8 160mm
4	Bolt M8 x 180


MARK	DATE	DESCRIPTION
0	17-11-2016	90% revision

LOT NUMBER:	106
DRAWN BY:	Author
CHECKED BY:	Selficient
COPYRIGHT:	NONE; PROJECT IS PUBLIC DOMAIN

SCALE: 1 : 5

SHEET TITLE


DETAIL H08-H09-H10 -
 CONNECTION
 DINING/BED ROOM
 WINDOW/DOOR
A-416

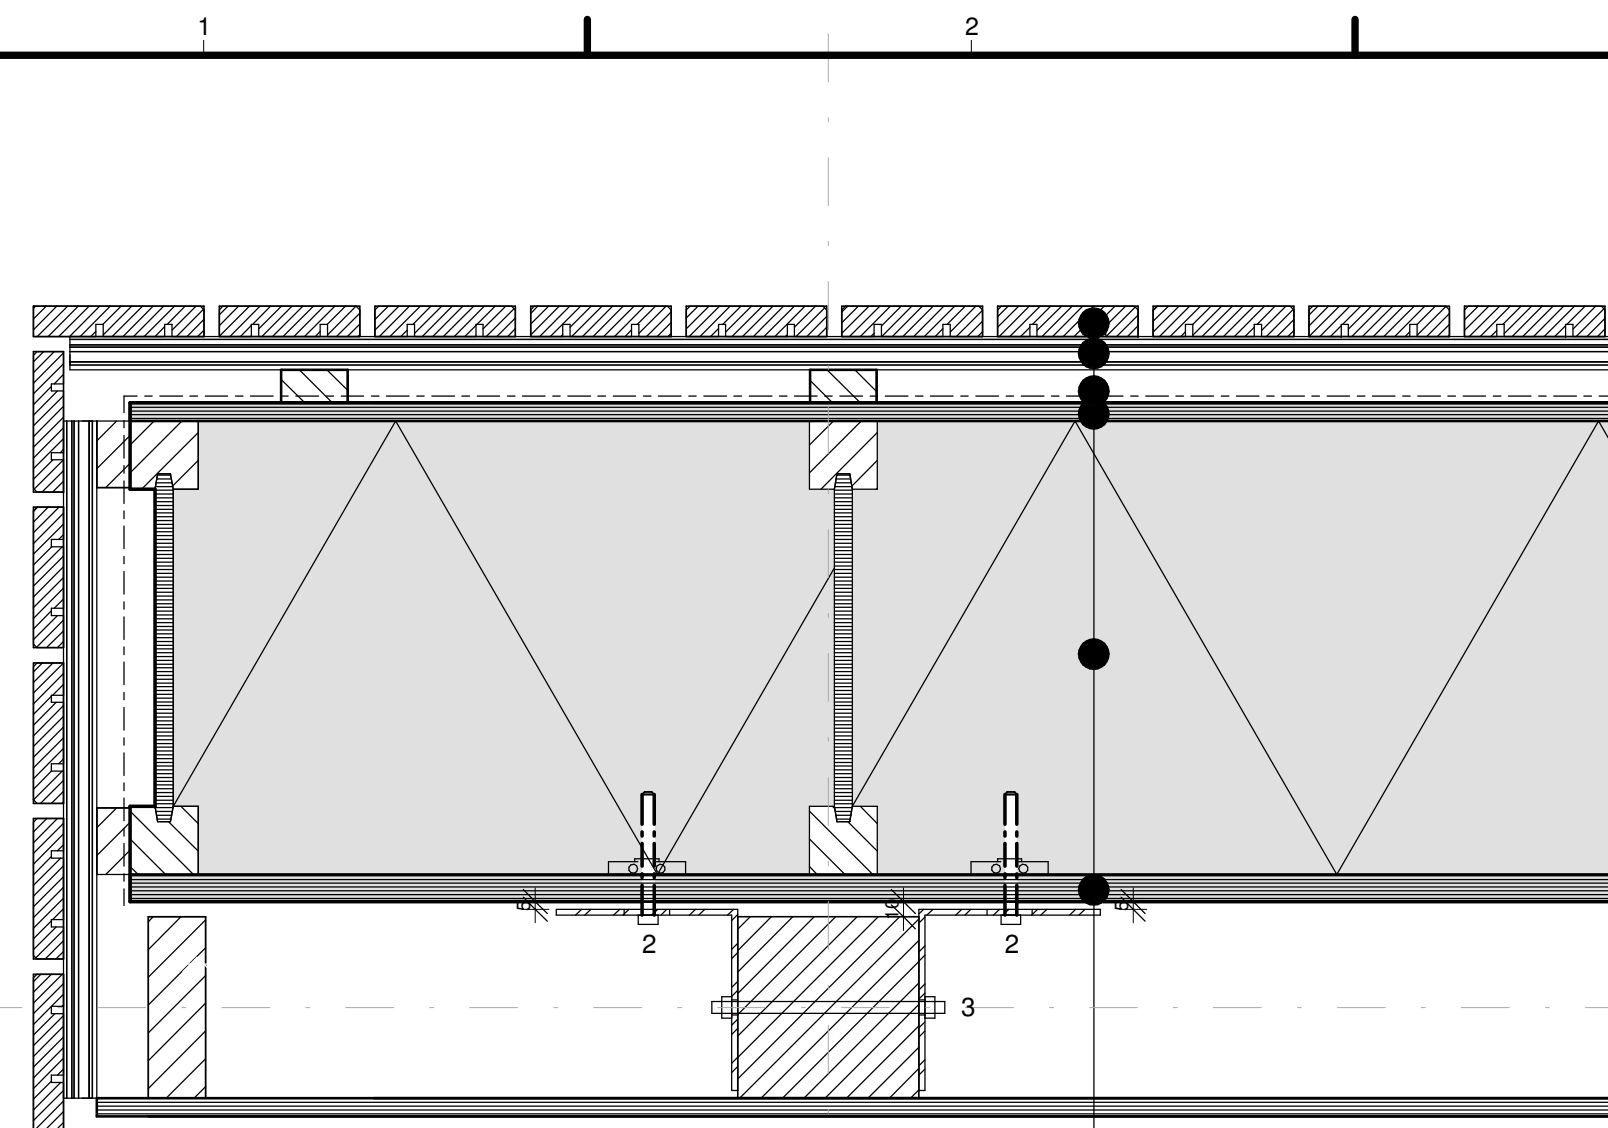

Facade panel
 -Derako wood finish 18 mm
 -Derako system rail 22mm
 -Foil waterproof vapour perm.
 -Battens 22x44mm
 -OSB3-zero 12mm
 -Cellulose insulation 300mm
 -OSB4-zero18mm

DETAIL H10


1 : 5

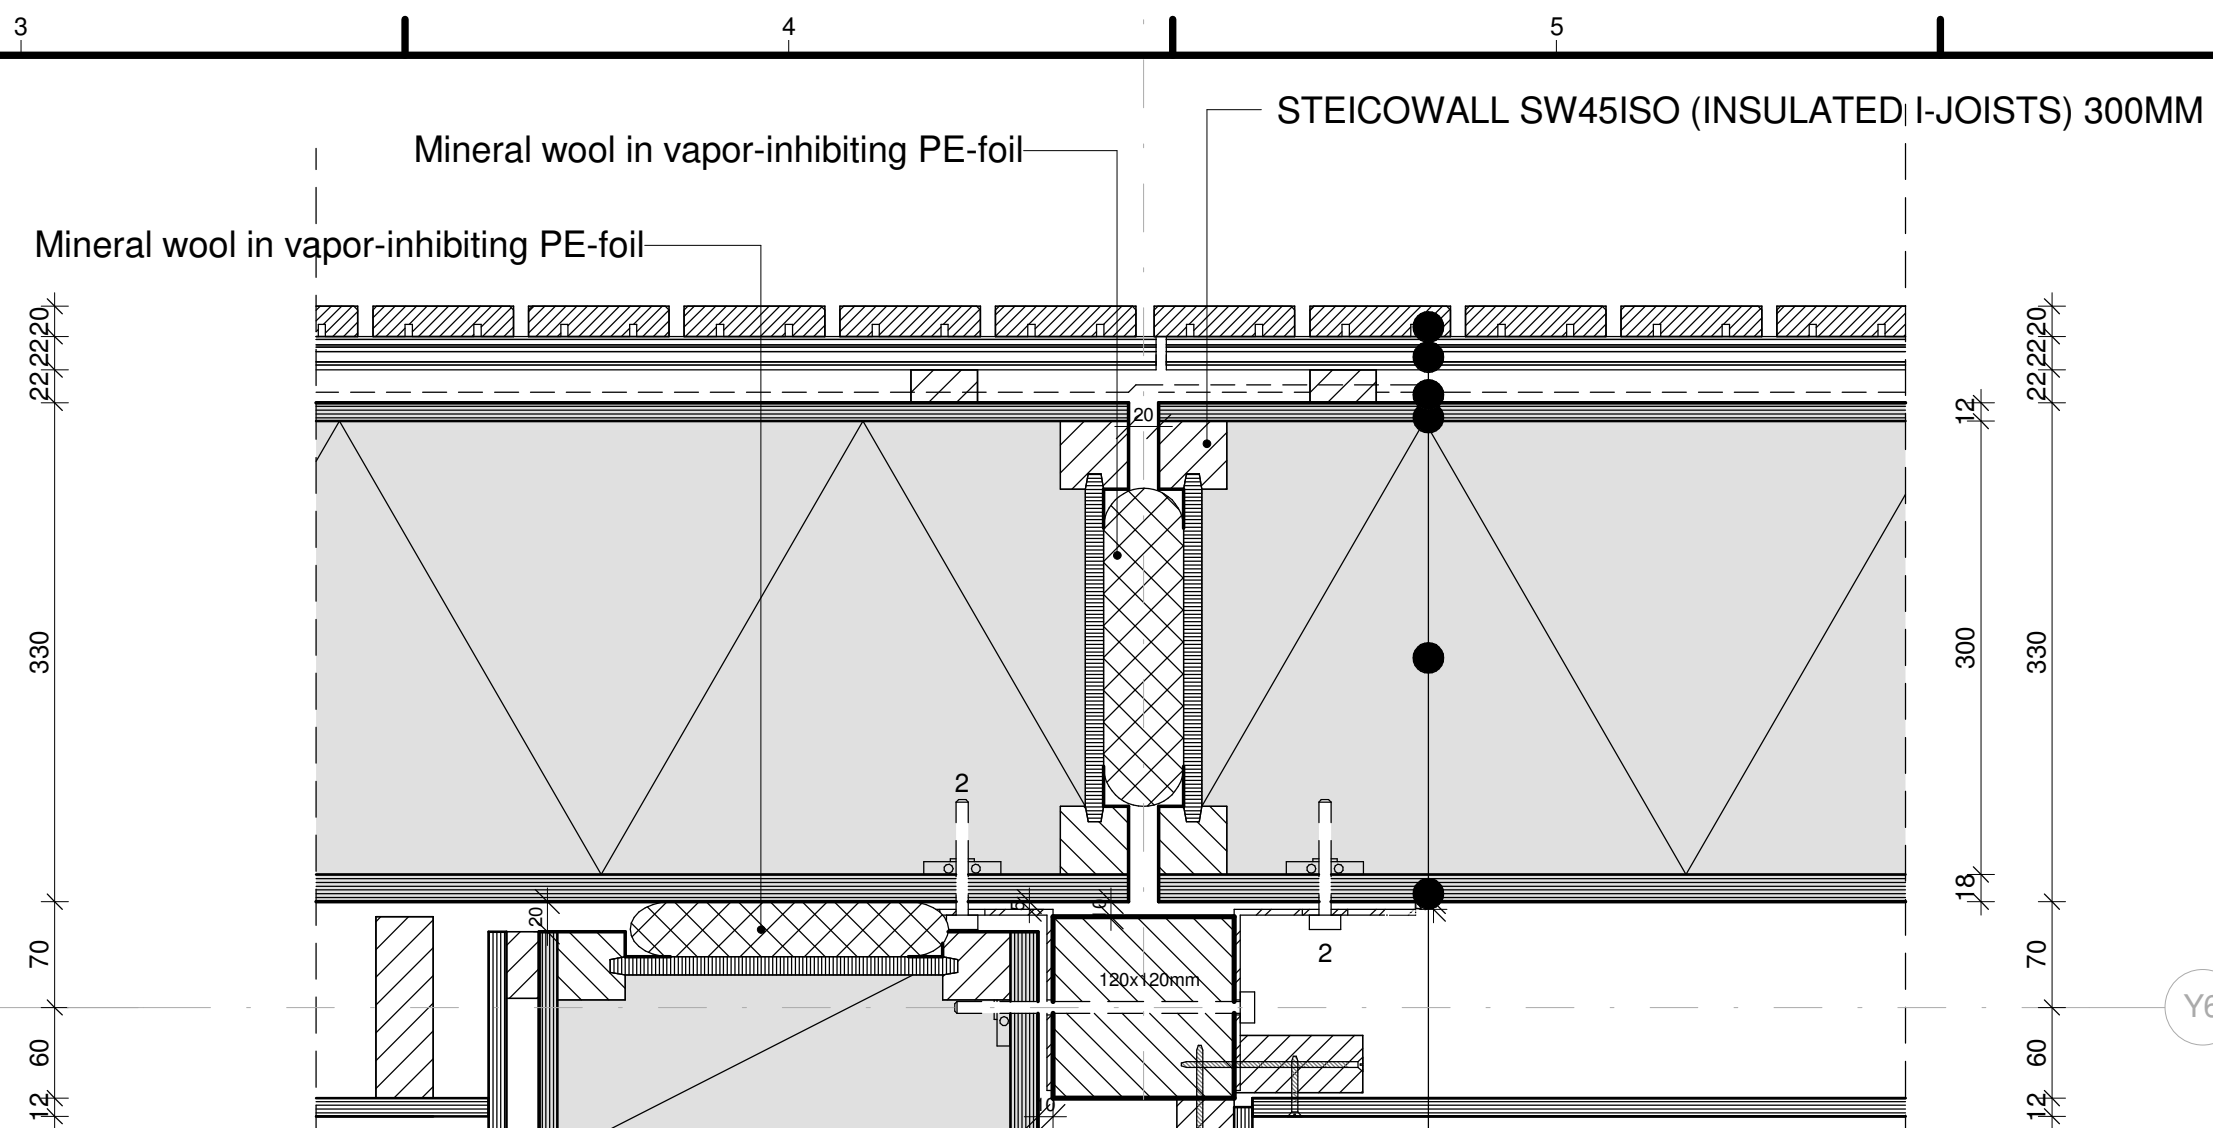

Facade panel
 -Derako wood finish 18 mm
 -Derako system rail 22mm
 -Foil waterproof vapour perm.
 -Battens 22x44mm
 -OSB3-zero 12mm
 -Cellulose insulation 300mm
 -OSB4-zero18mm

DETAIL H09

1 : 5

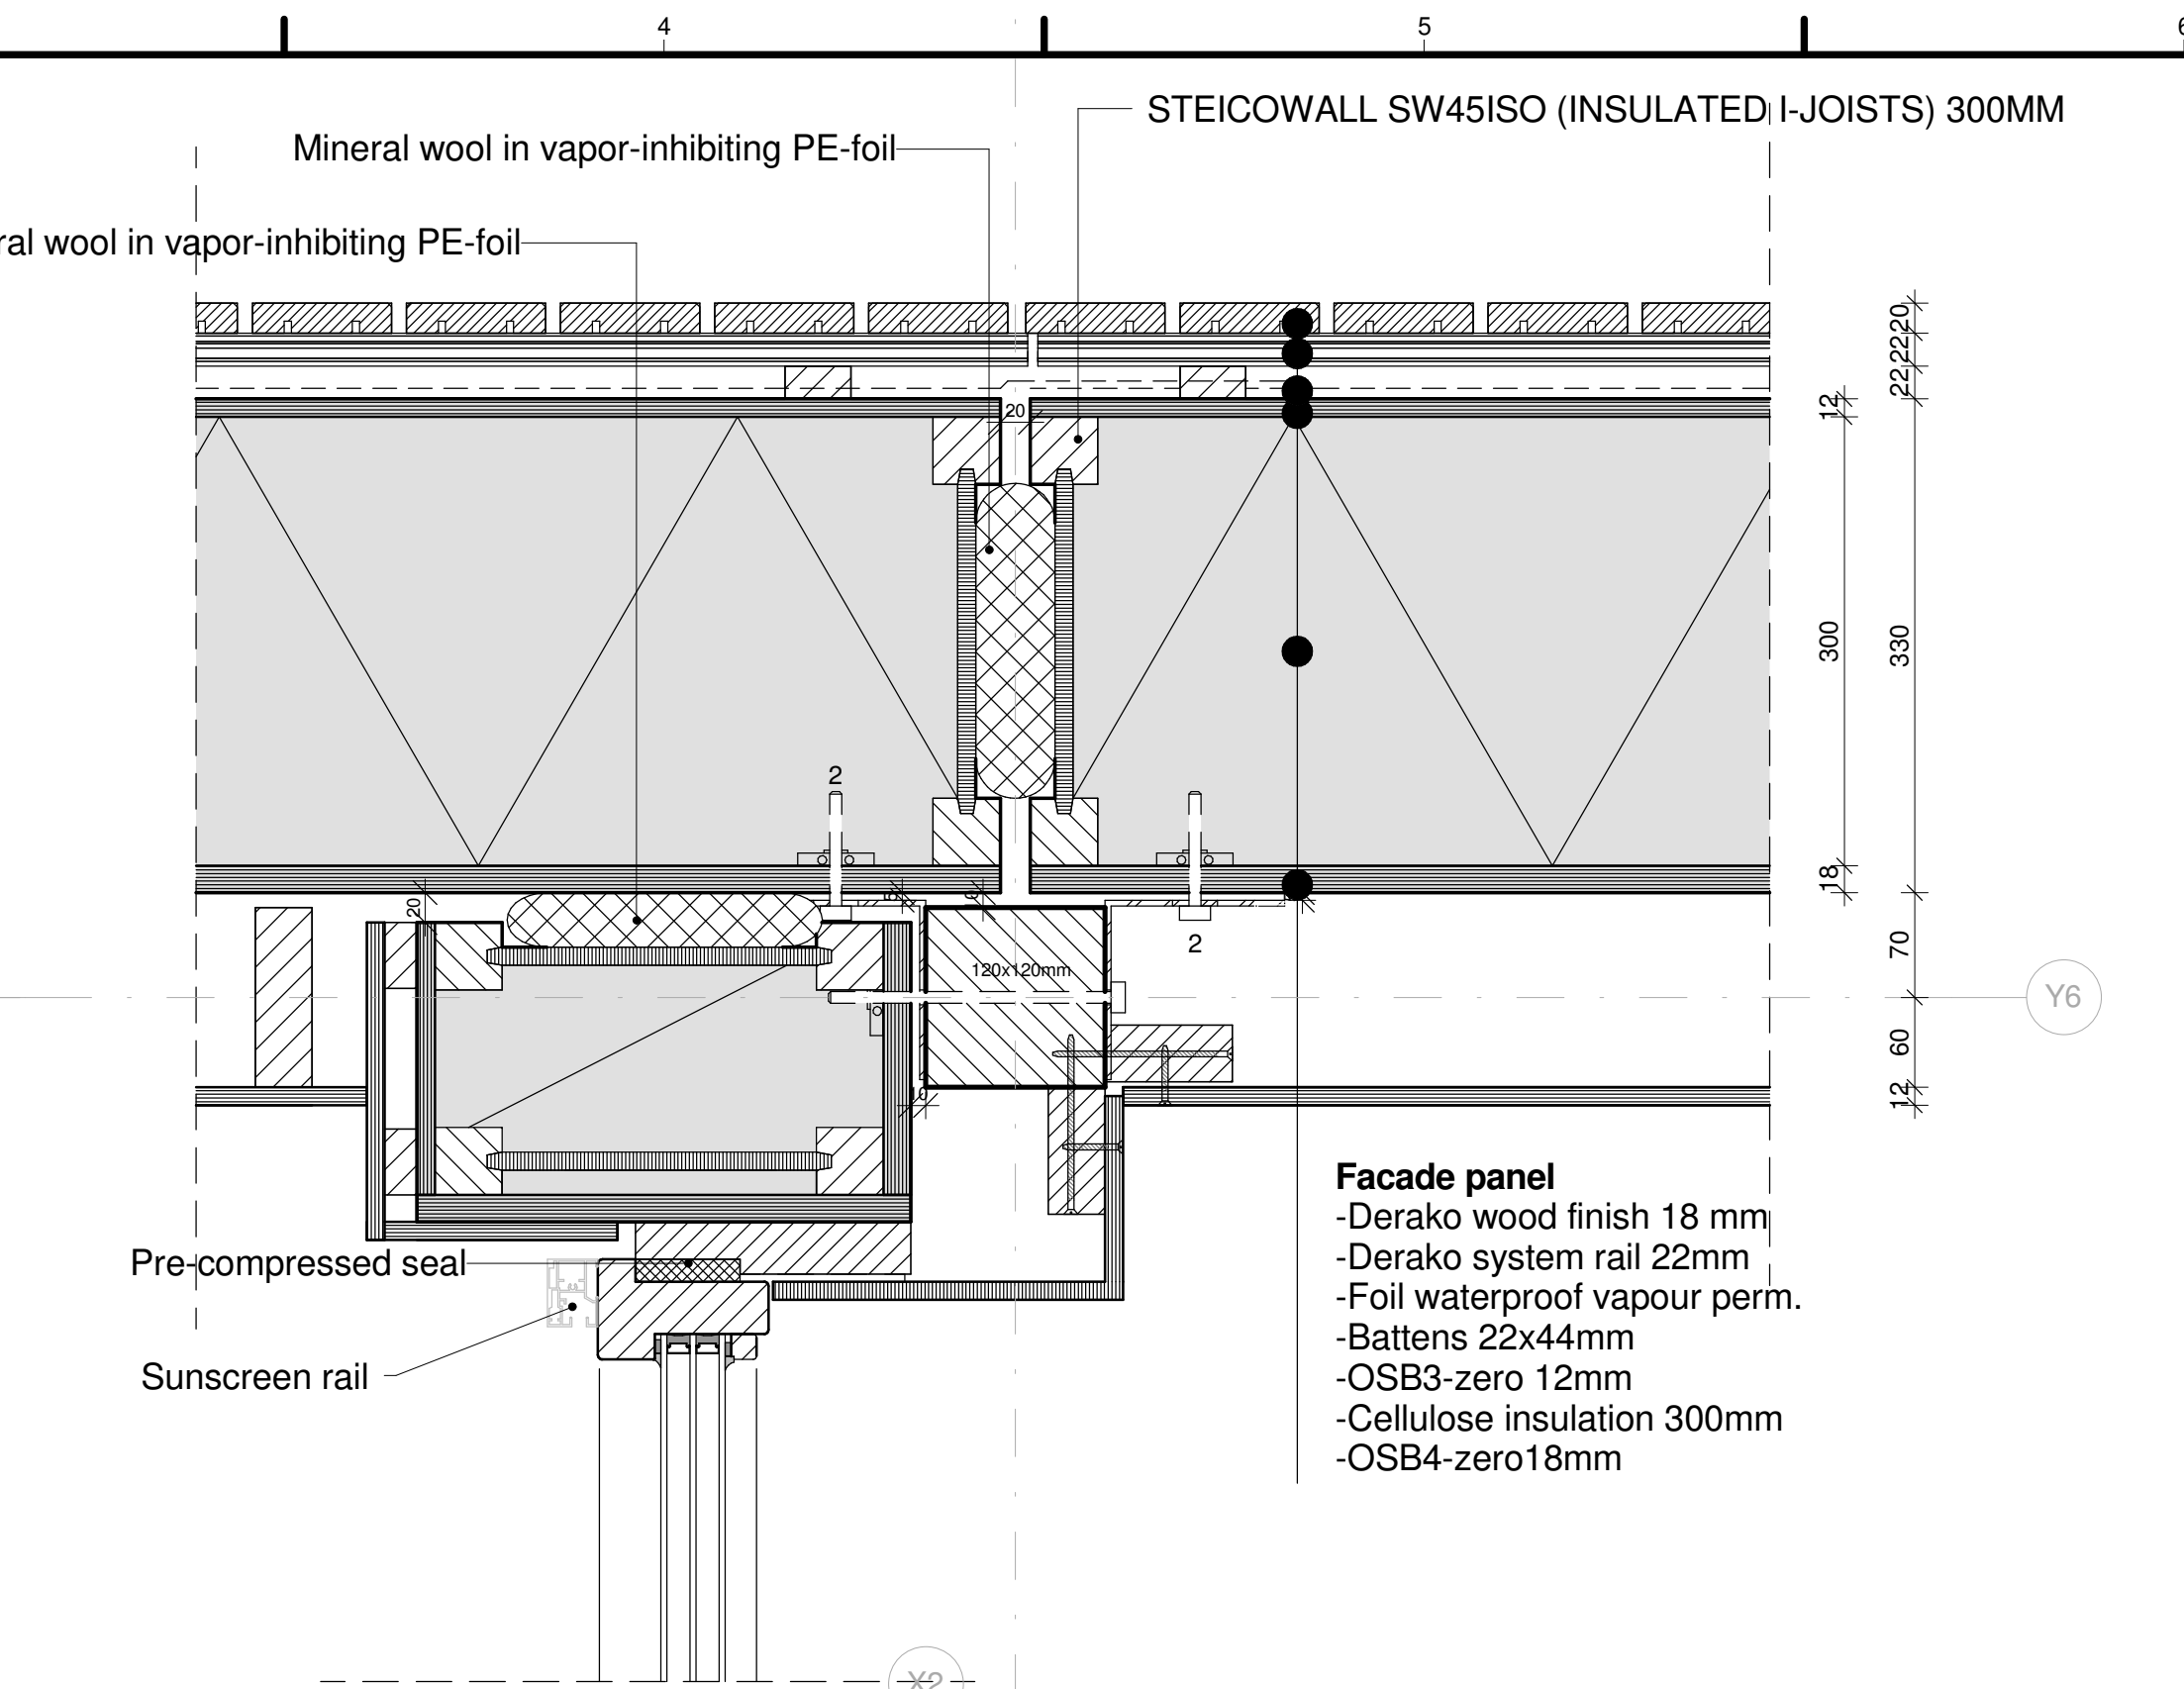



FACADE PANEL
 -Plywood Okoume 12mm
 -Battens 22x44mm
 -Foil waterproof vapour perm.
 -OSB3-zero 12mm
 -Cellulose insulation I-JOISTS
 steicowall SW45ISO 300mm
 -OSB4-zero18mm

DETAIL H08

1 : 5

Bolt types

NR.	Description
1	Bolt M8 x 40
2	Bolt M8 x 80
3	Screw thread M8 160mm
4	Bolt M8 x 180

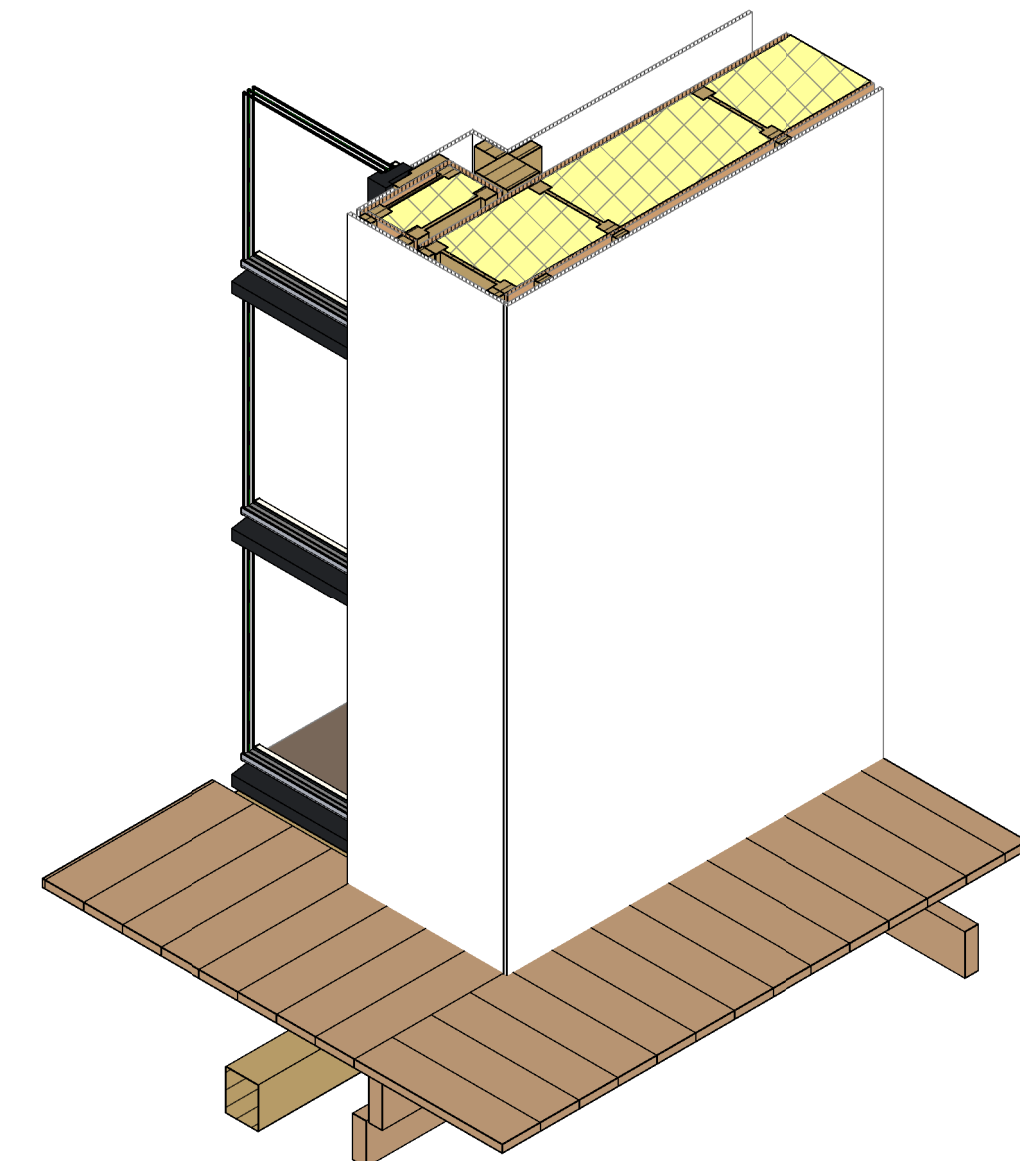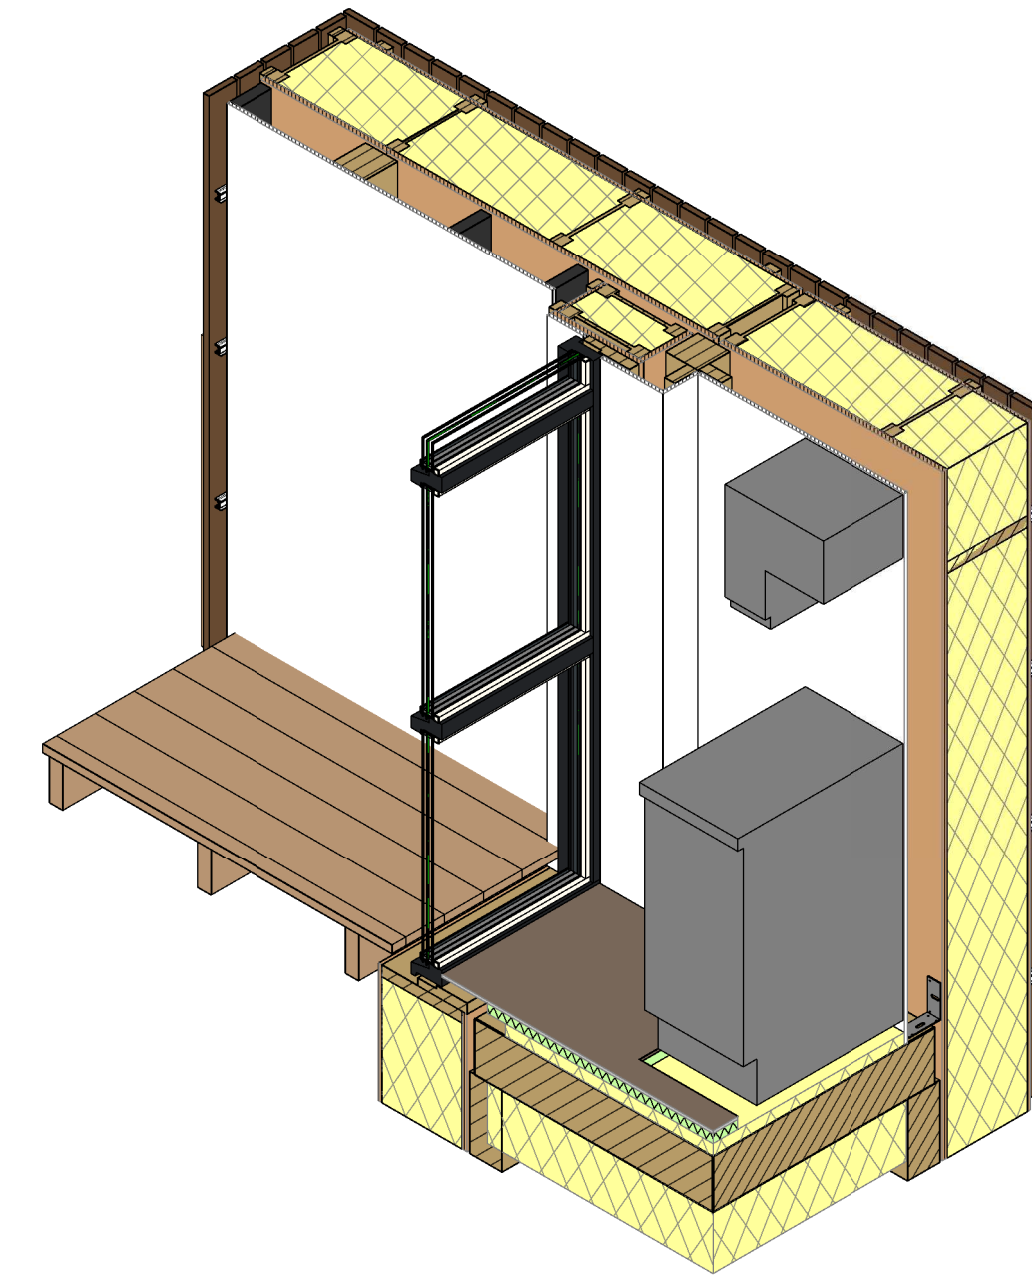

TEAM NAME: Selficient
 ADDRESS: Padualaan 99
 3584 CH Utrecht
 CONTACT: info@selficient.org
 www.selficient.org

CONSULTANTS
 ARCHITECTURE
 ENGINEERS
 LANDSCAPING
 SAFETY FIRST CODE CONSULTANTS

CLIENT
 U.S. DEPARTMENT OF ENERGY
 SOLAR DECATHLON 2017
 WWW.SOLARDECATHLON.GOV



0	17-11-2016	90% revision
---	------------	--------------

MARK	DATE	DESCRIPTION
------	------	-------------


LOT NUMBER:	106
DRAWN BY:	Author
CHECKED BY:	Selficient
COPYRIGHT:	NONE; PROJECT IS PUBLIC DOMAIN

SCALE: 1 : 5

SHEET TITLE

DETAIL H12 -
 CONNECTION FRONT
 DOOR

A-418

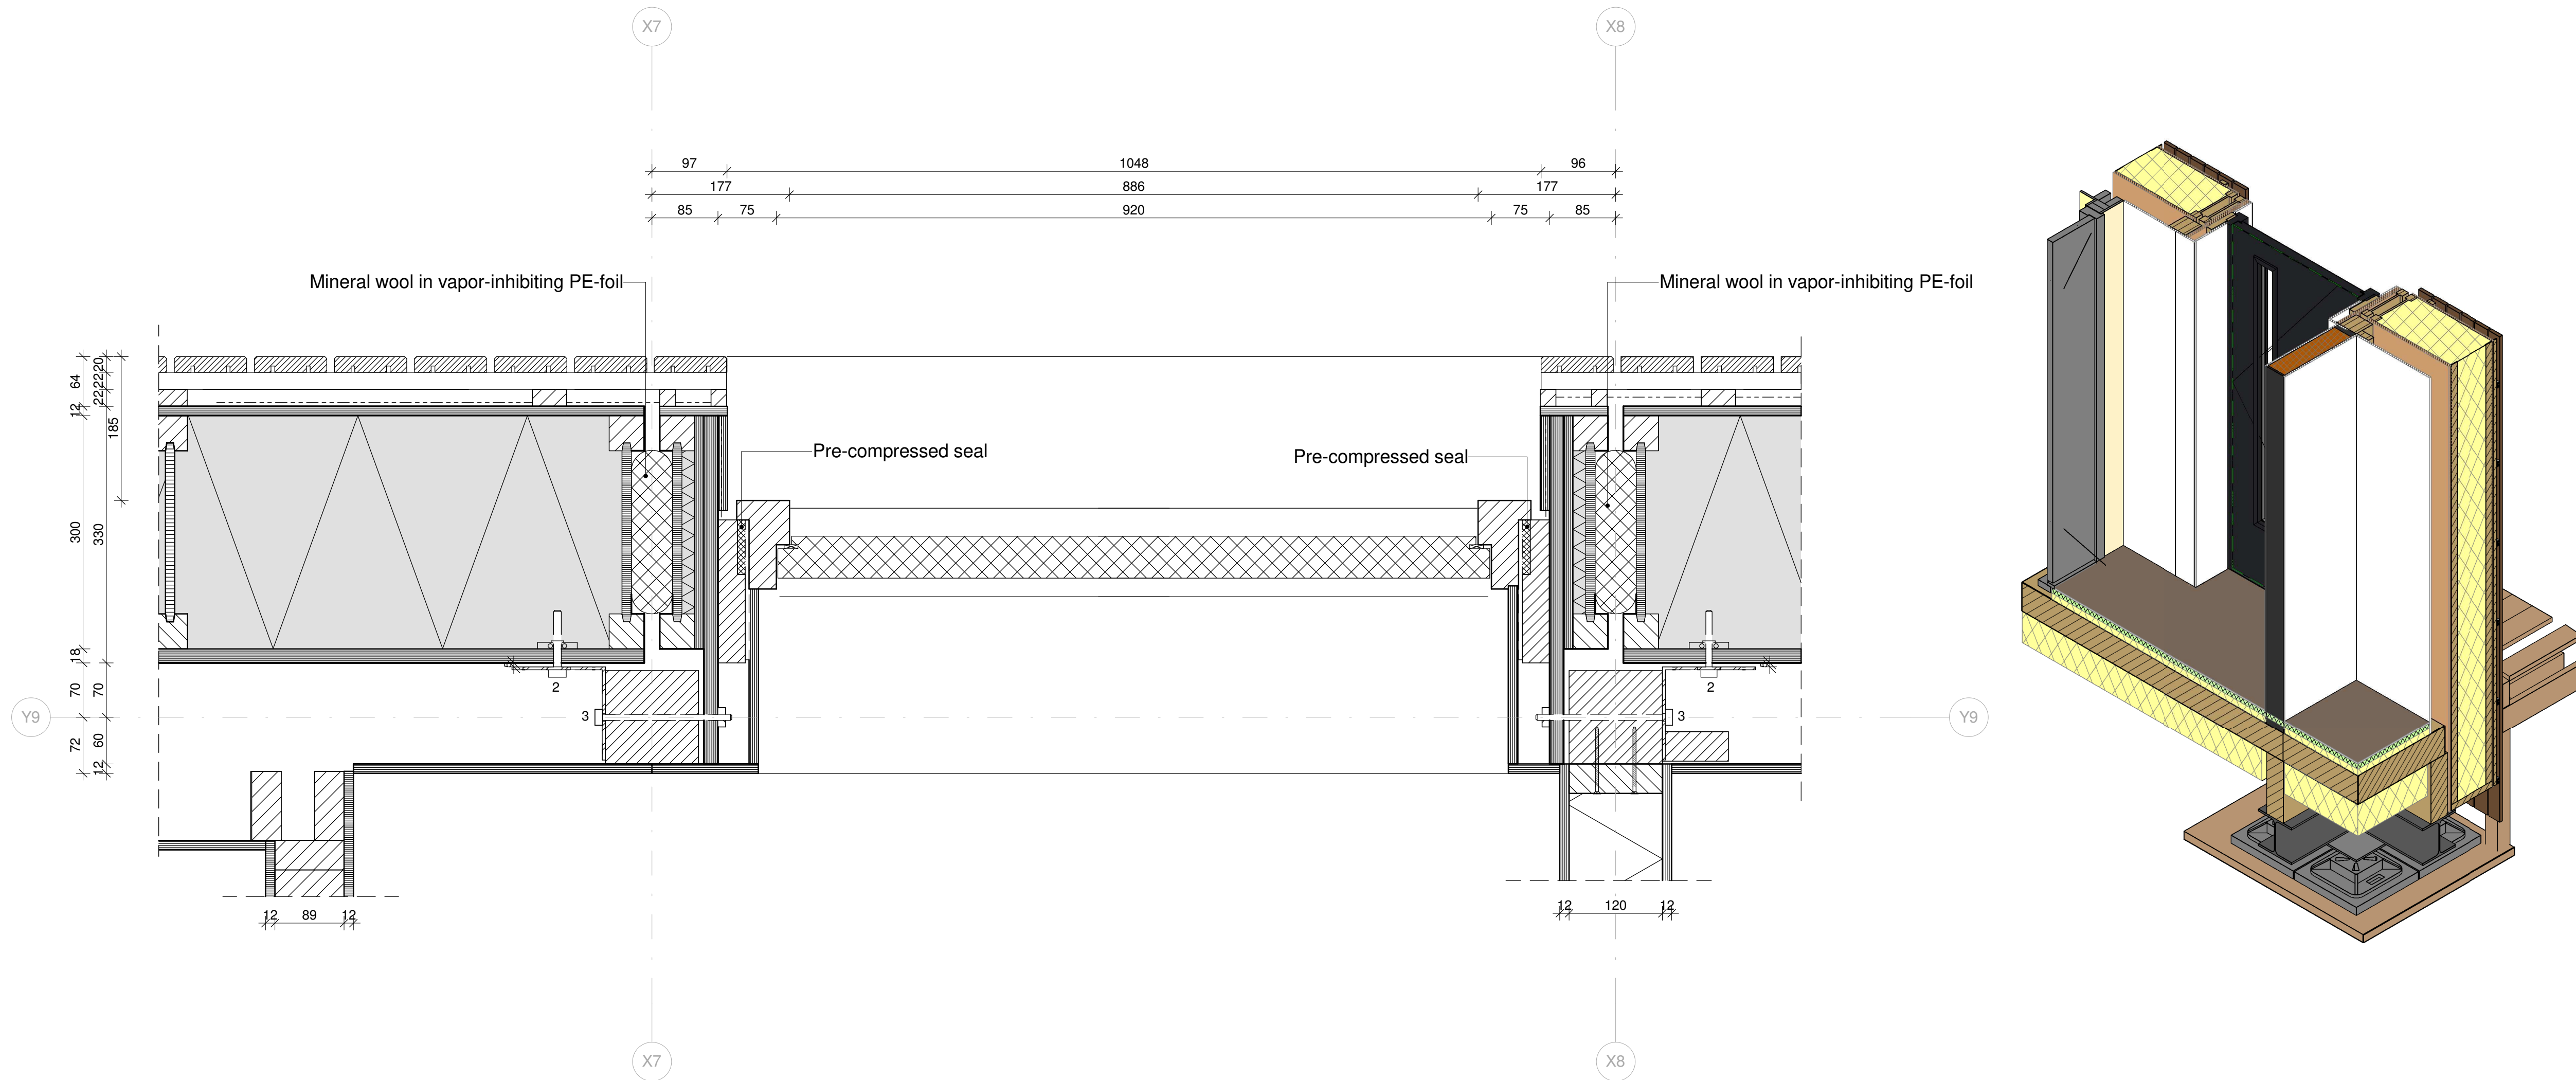

DETAIL H12
 1 : 5

Bolt types

NR.	Description
1	Bolt M8 x 40
2	Bolt M8 x 80
3	Screw thread M8 160mm
4	Bolt M8 x 180

TEAM NAME: Selficient
 ADDRESS: Padualaan 99
 3584 CH Utrecht
 CONTACT: info@selficient.org
 www.selficient.org

CONSULTANTS
 ARCHITECTURE
 ENGINEERS
 LANDSCAPING
 SAFETY FIRST CODE CONSULTANTS

CLIENT
 U.S. DEPARTMENT OF ENERGY
 SOLAR DECATHLON 2017
 WWW.SOLARDECATHLON.GOV



0	17-11-2016	90% revision
---	------------	--------------

MARK	DATE	DESCRIPTION
------	------	-------------



LOT NUMBER: 106
 DRAWN BY: Author
 CHECKED BY: Selficient
 COPYRIGHT: NONE; PROJECT IS PUBLIC DOMAIN

SCALE: 1 : 5

SHEET TITLE

DETAIL H13 -
 CONNECTION
 BEDROOM DOOR


A-419

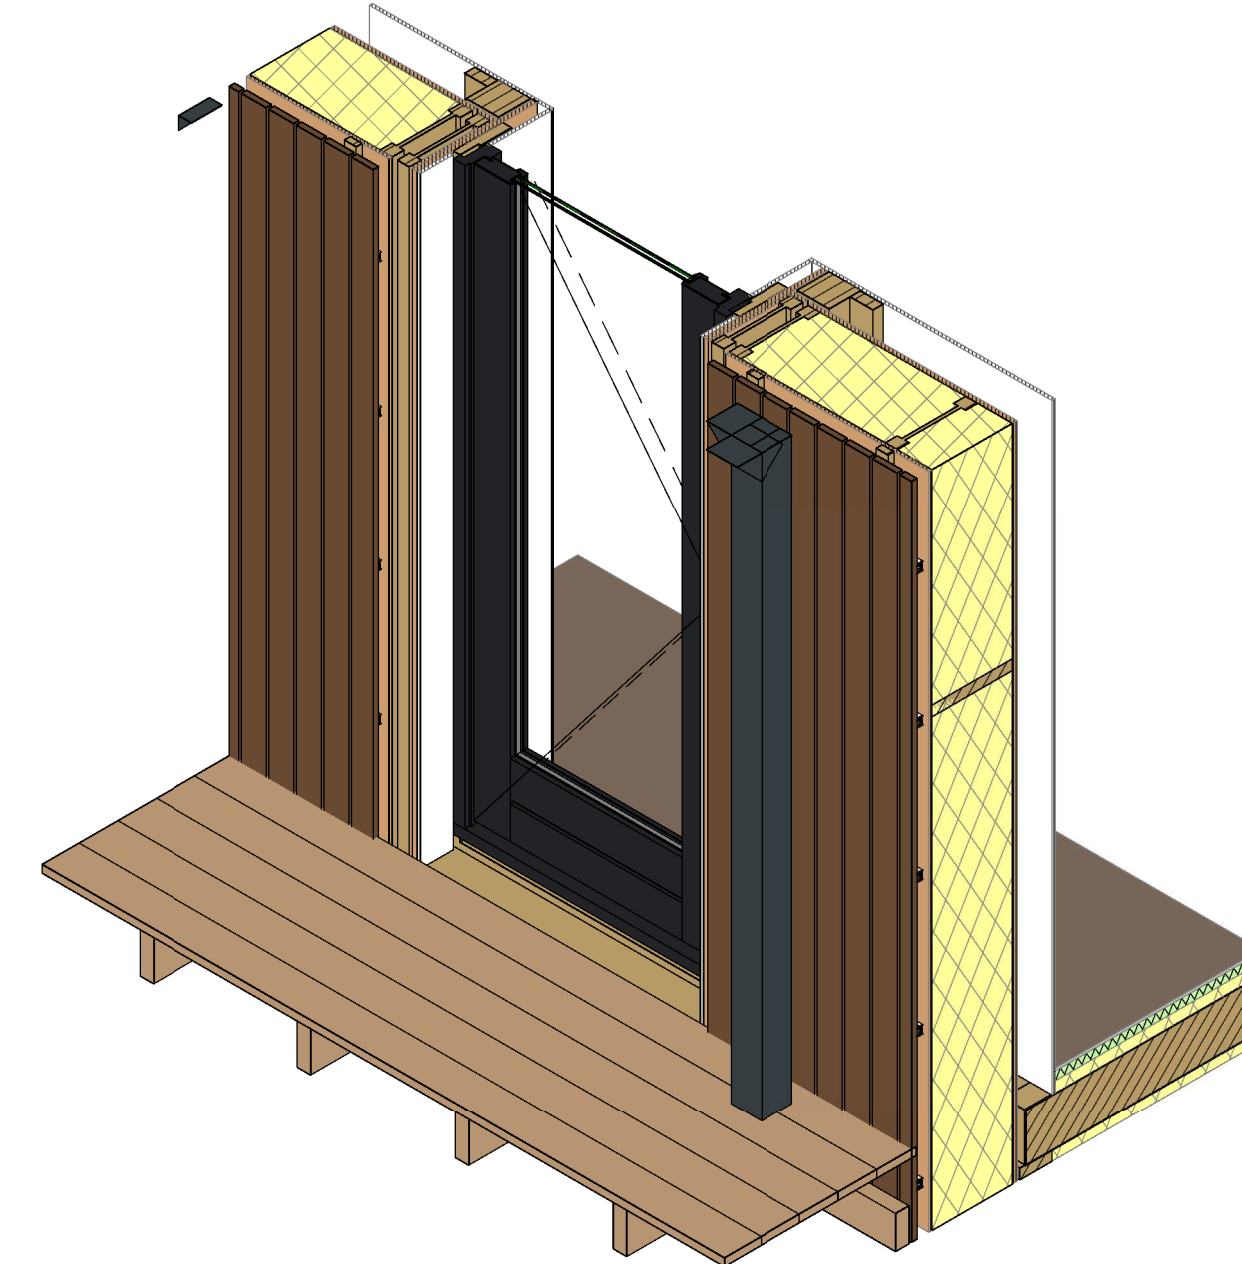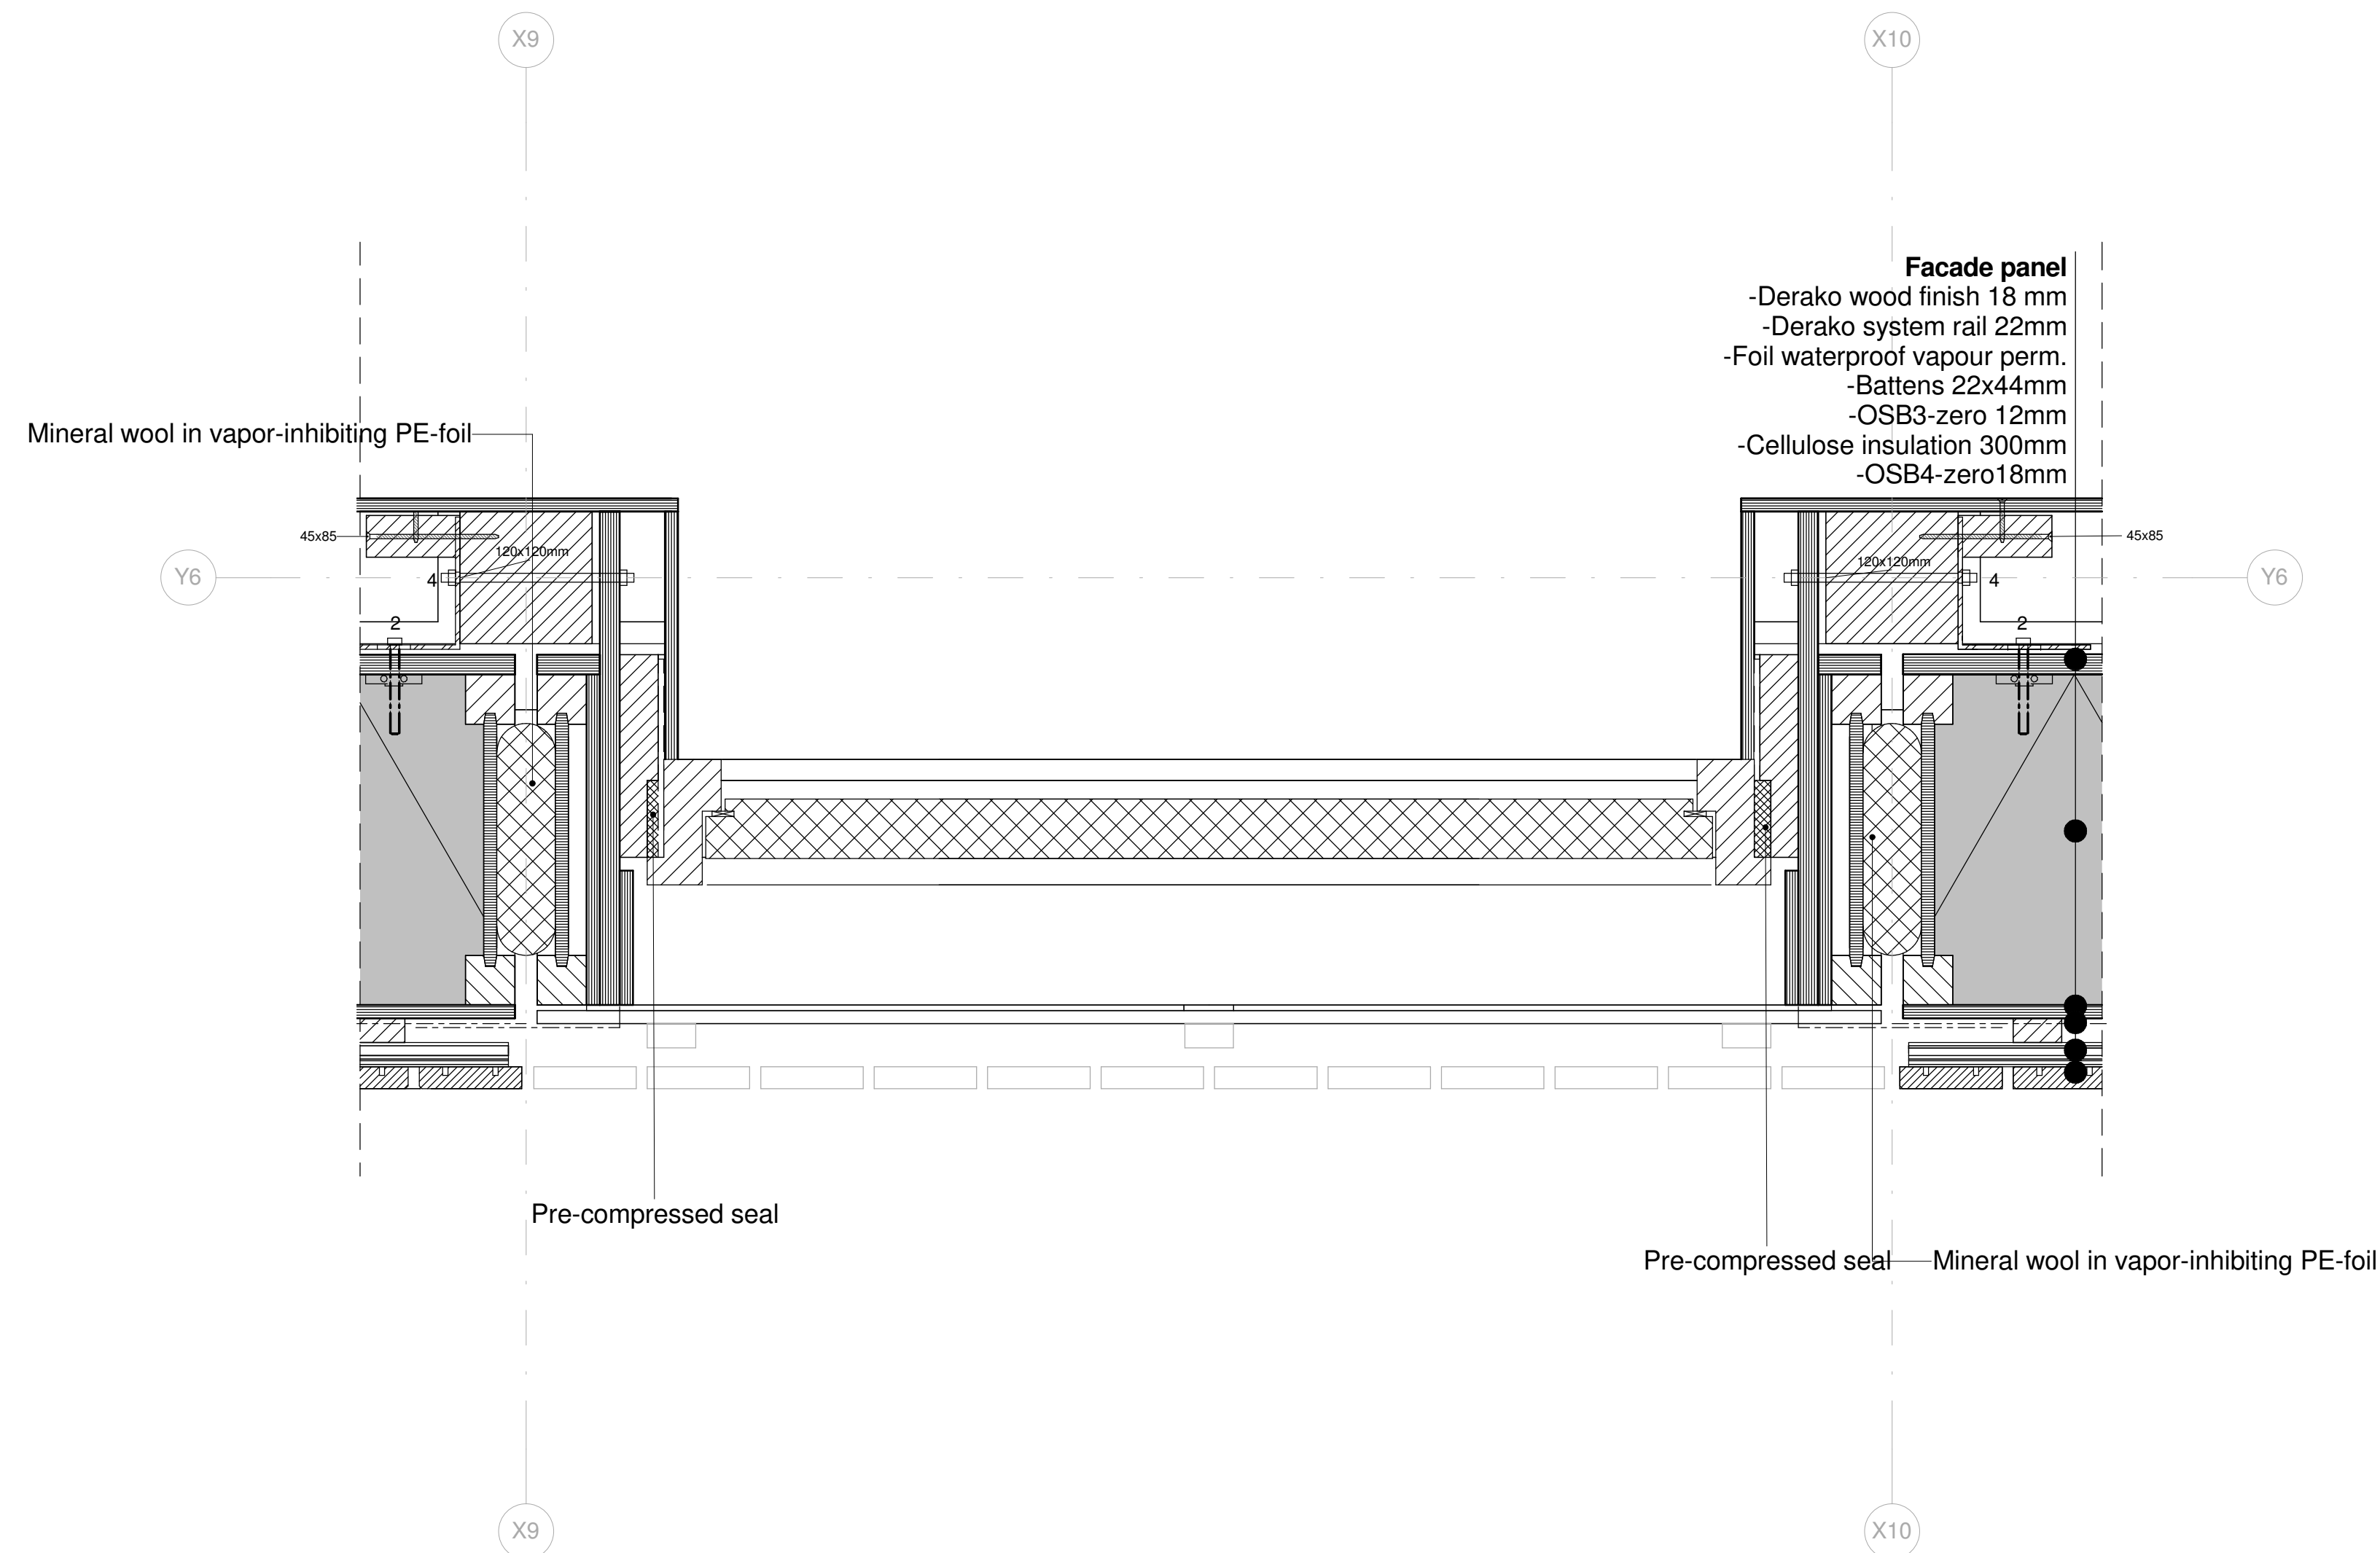

DETAIL H13
 1 : 5

Bolt types

NR.	Description
1	Bolt M8 x 40
2	Bolt M8 x 80
3	Screw thread M8 160mm
4	Bolt M8 x 180

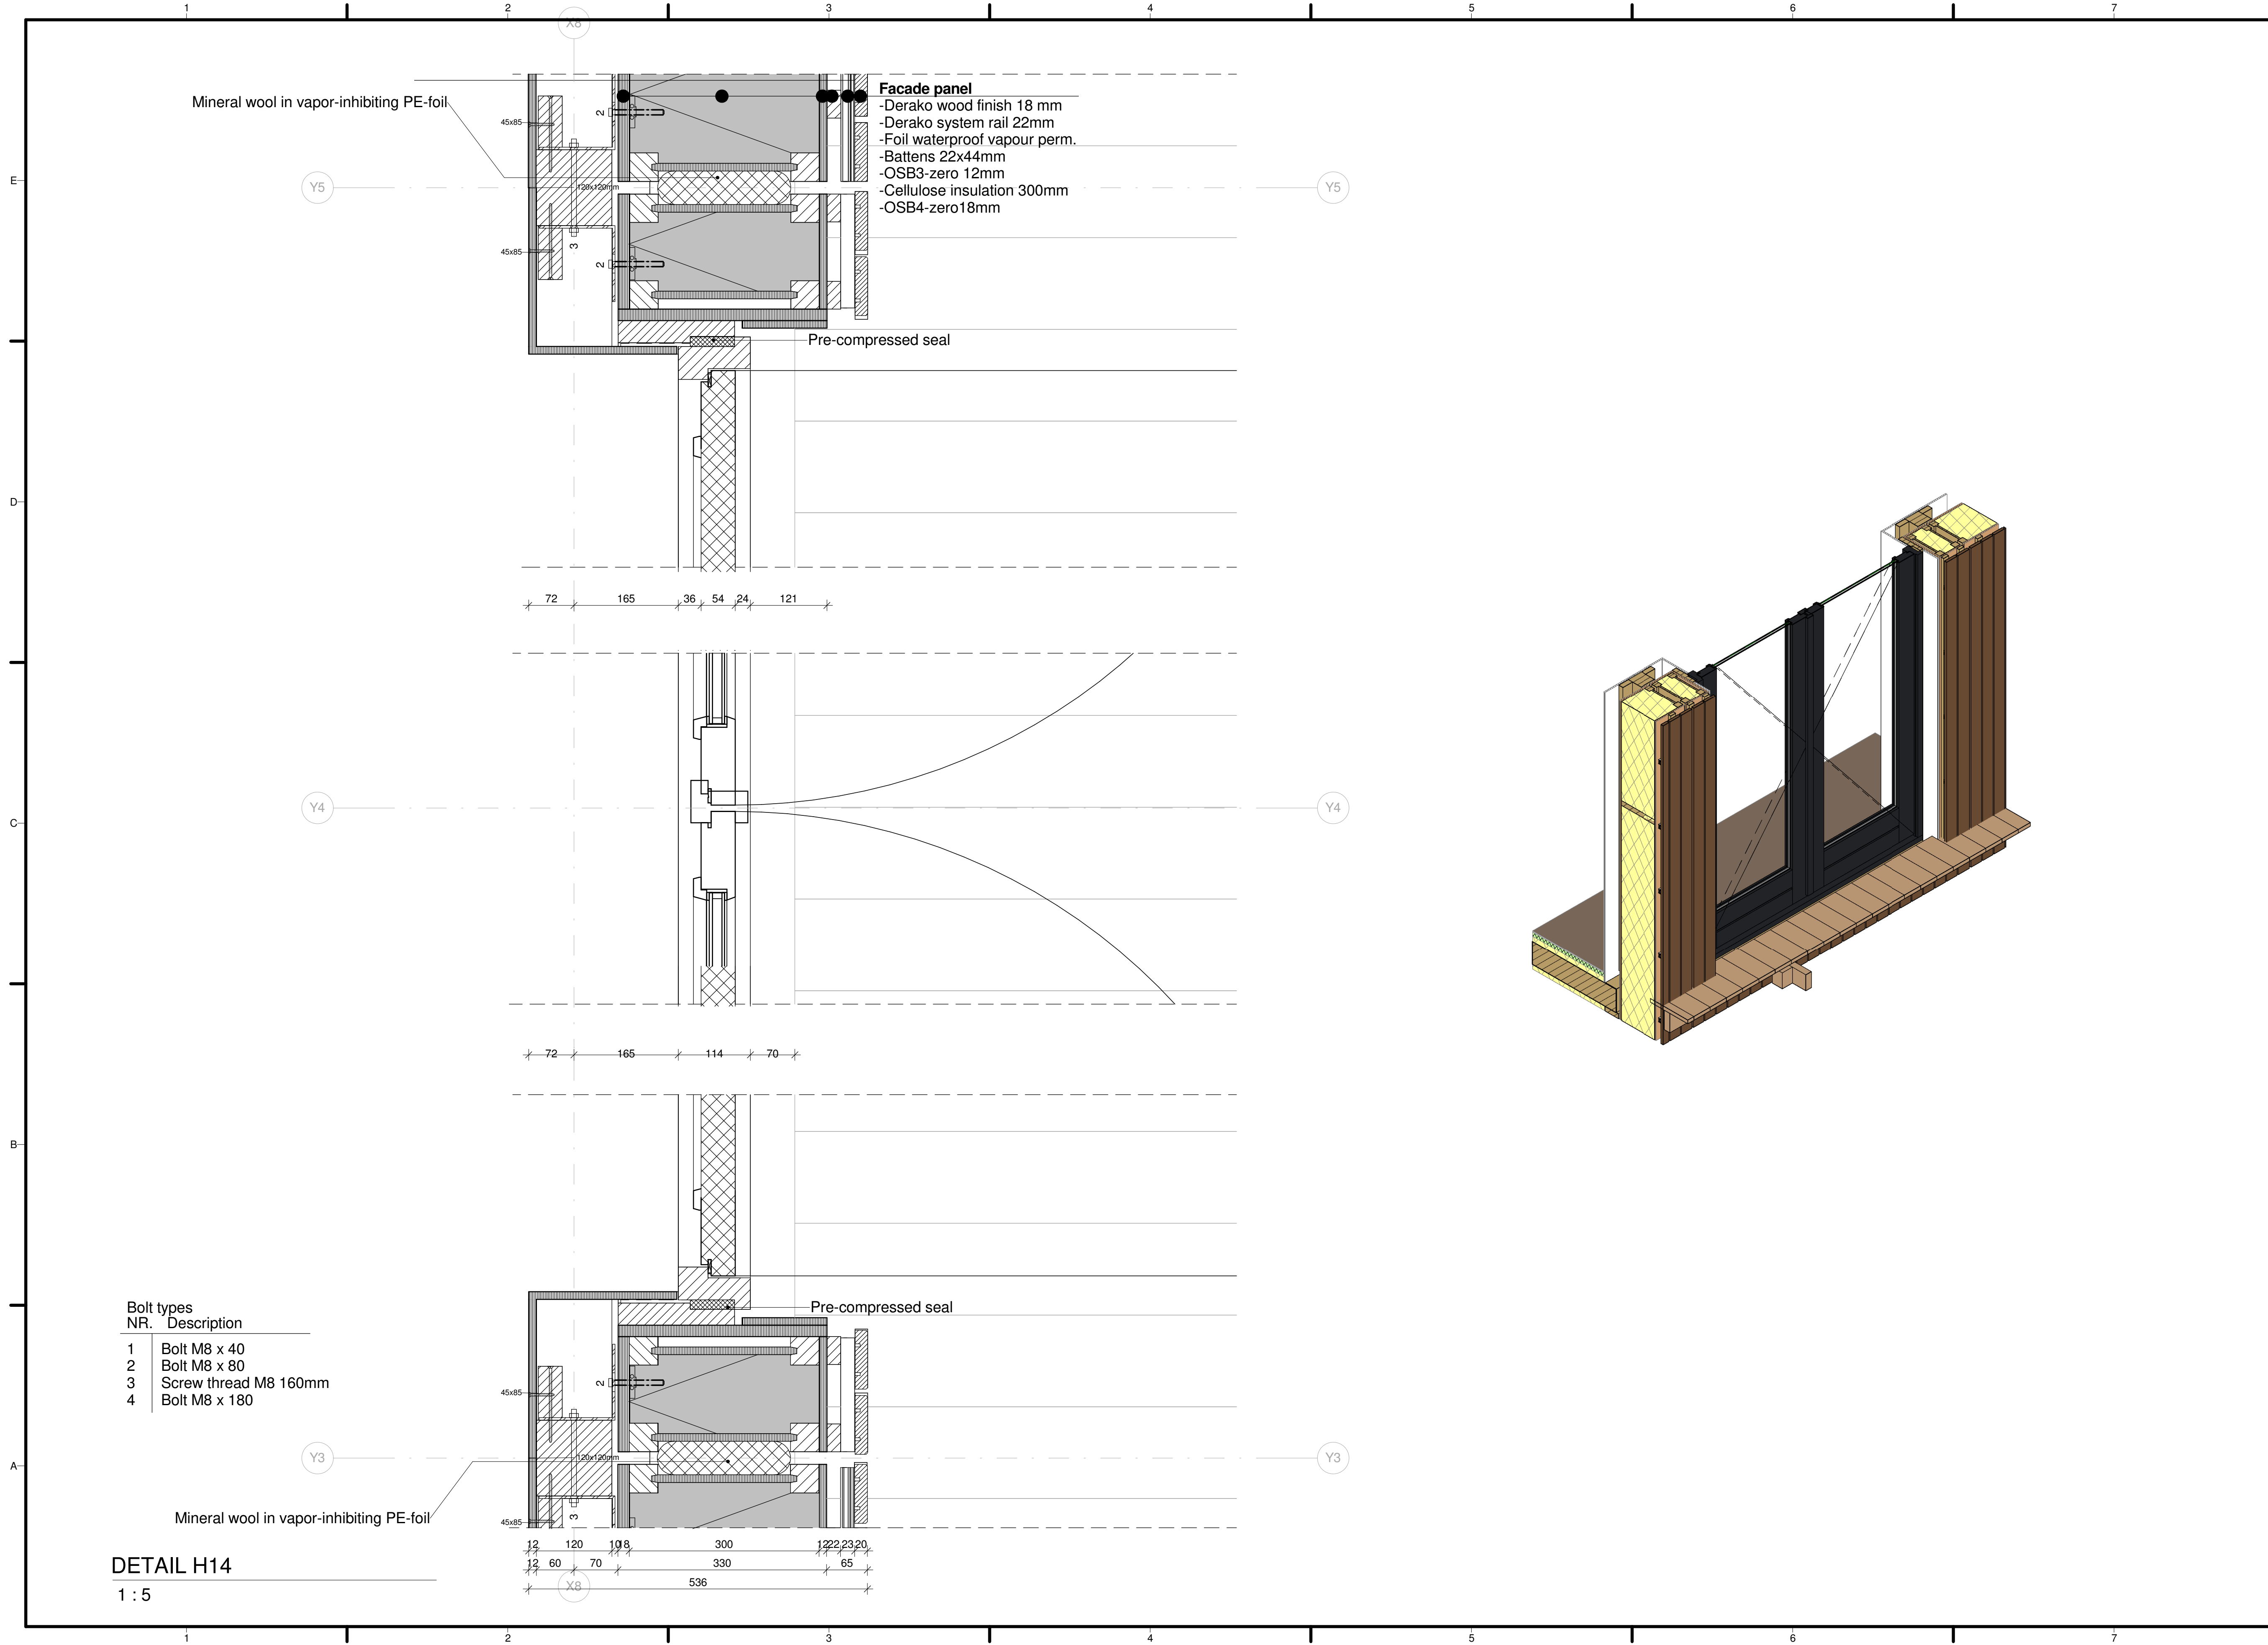

TEAM NAME: Selficient
 ADDRESS: Padualaan 99
 3584 CH Utrecht
 CONTACT: info@selficient.org
 www.selficient.org

CONSULTANTS
 ARCHITECTURE
 ENGINEERS
 LANDSCAPING
 SAFETY FIRST CODE CONSULTANTS

CLIENT
 U.S. DEPARTMENT OF ENERGY
 SOLAR DECATHLON 2017
 WWW.SOLARDECATHLON.GOV



MARK	DATE	DESCRIPTION
0	17-11-2016	90% revision


LOT NUMBER: 106
 DRAWN BY: Author
 CHECKED BY: Selficient
 COPYRIGHT: NONE; PROJECT IS PUBLIC DOMAIN

SCALE: 1 : 5

SHEET TITLE

DETAIL H14 -
 CONNECTION
 LIVINGROOM DOOR

A-420

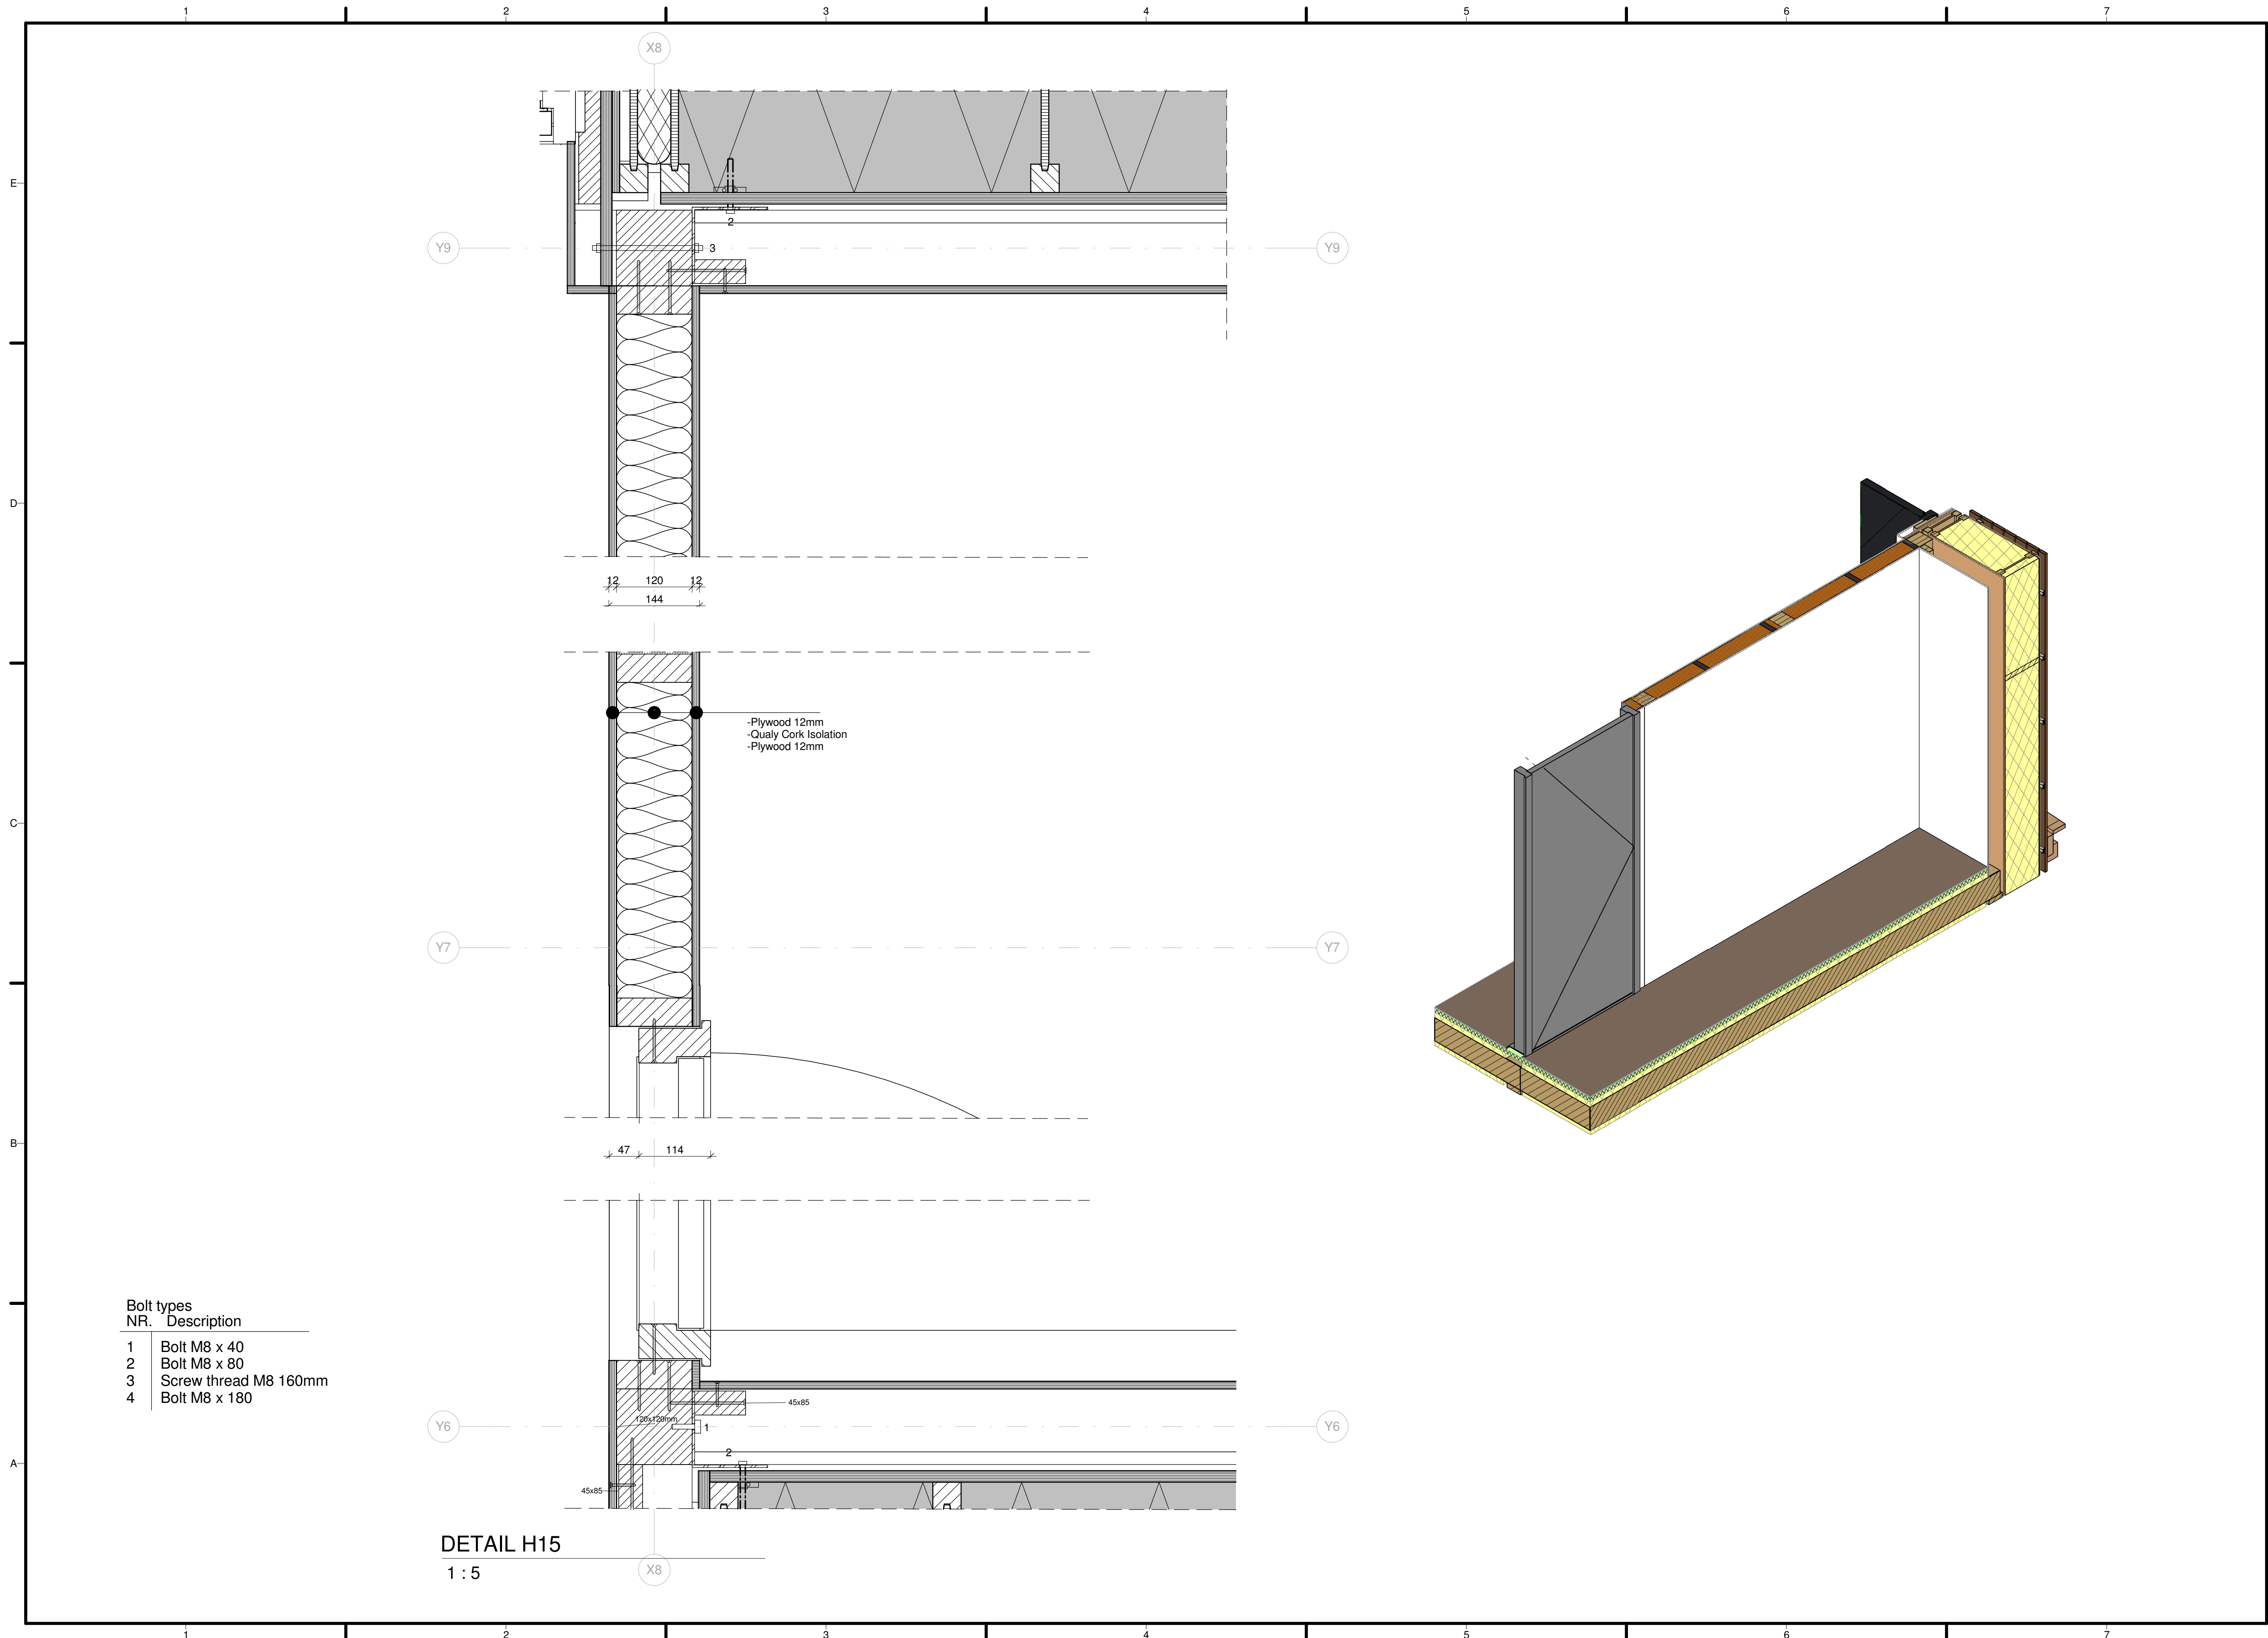

TEAM NAME: Selficient
 ADDRESS: Padualaan 99
 3584 CH Utrecht
 CONTACT: info@selficient.org
 www.selficient.org

CONSULTANTS
 ARCHITECTURE
 ENGINEERS
 LANDSCAPING
 SAFETY FIRST CODE CONSULTANTS

CLIENT
 U.S. DEPARTMENT OF ENERGY
 SOLAR DECATHLON 2017
 WWW.SOLARDECATHLON.GOV



MARK	DATE	DESCRIPTION
0	17-11-2016	90% revision

LOT NUMBER: 106
 DRAWN BY: SELFICIENT
 CHECKED BY: Selficient
 COPYRIGHT: NONE; PROJECT IS PUBLIC DOMAIN
 SCALE: 1 : 5

SHEET TITLE
**DETAIL H15 - INTERIOR
 WALL/DOOR**

A-421


MARK	DATE	DESCRIPTION
0	17-11-2016	90% revision

LOT NUMBER: 106
 DRAWN BY: SELFICIENT
 CHECKED BY: Selficient
 COPYRIGHT: NONE; PROJECT IS PUBLIC DOMAIN

SCALE: 1 : 5
 SHEET TITLE


DETAIL V02 - CONNECTION ROOF EAVES

A-451

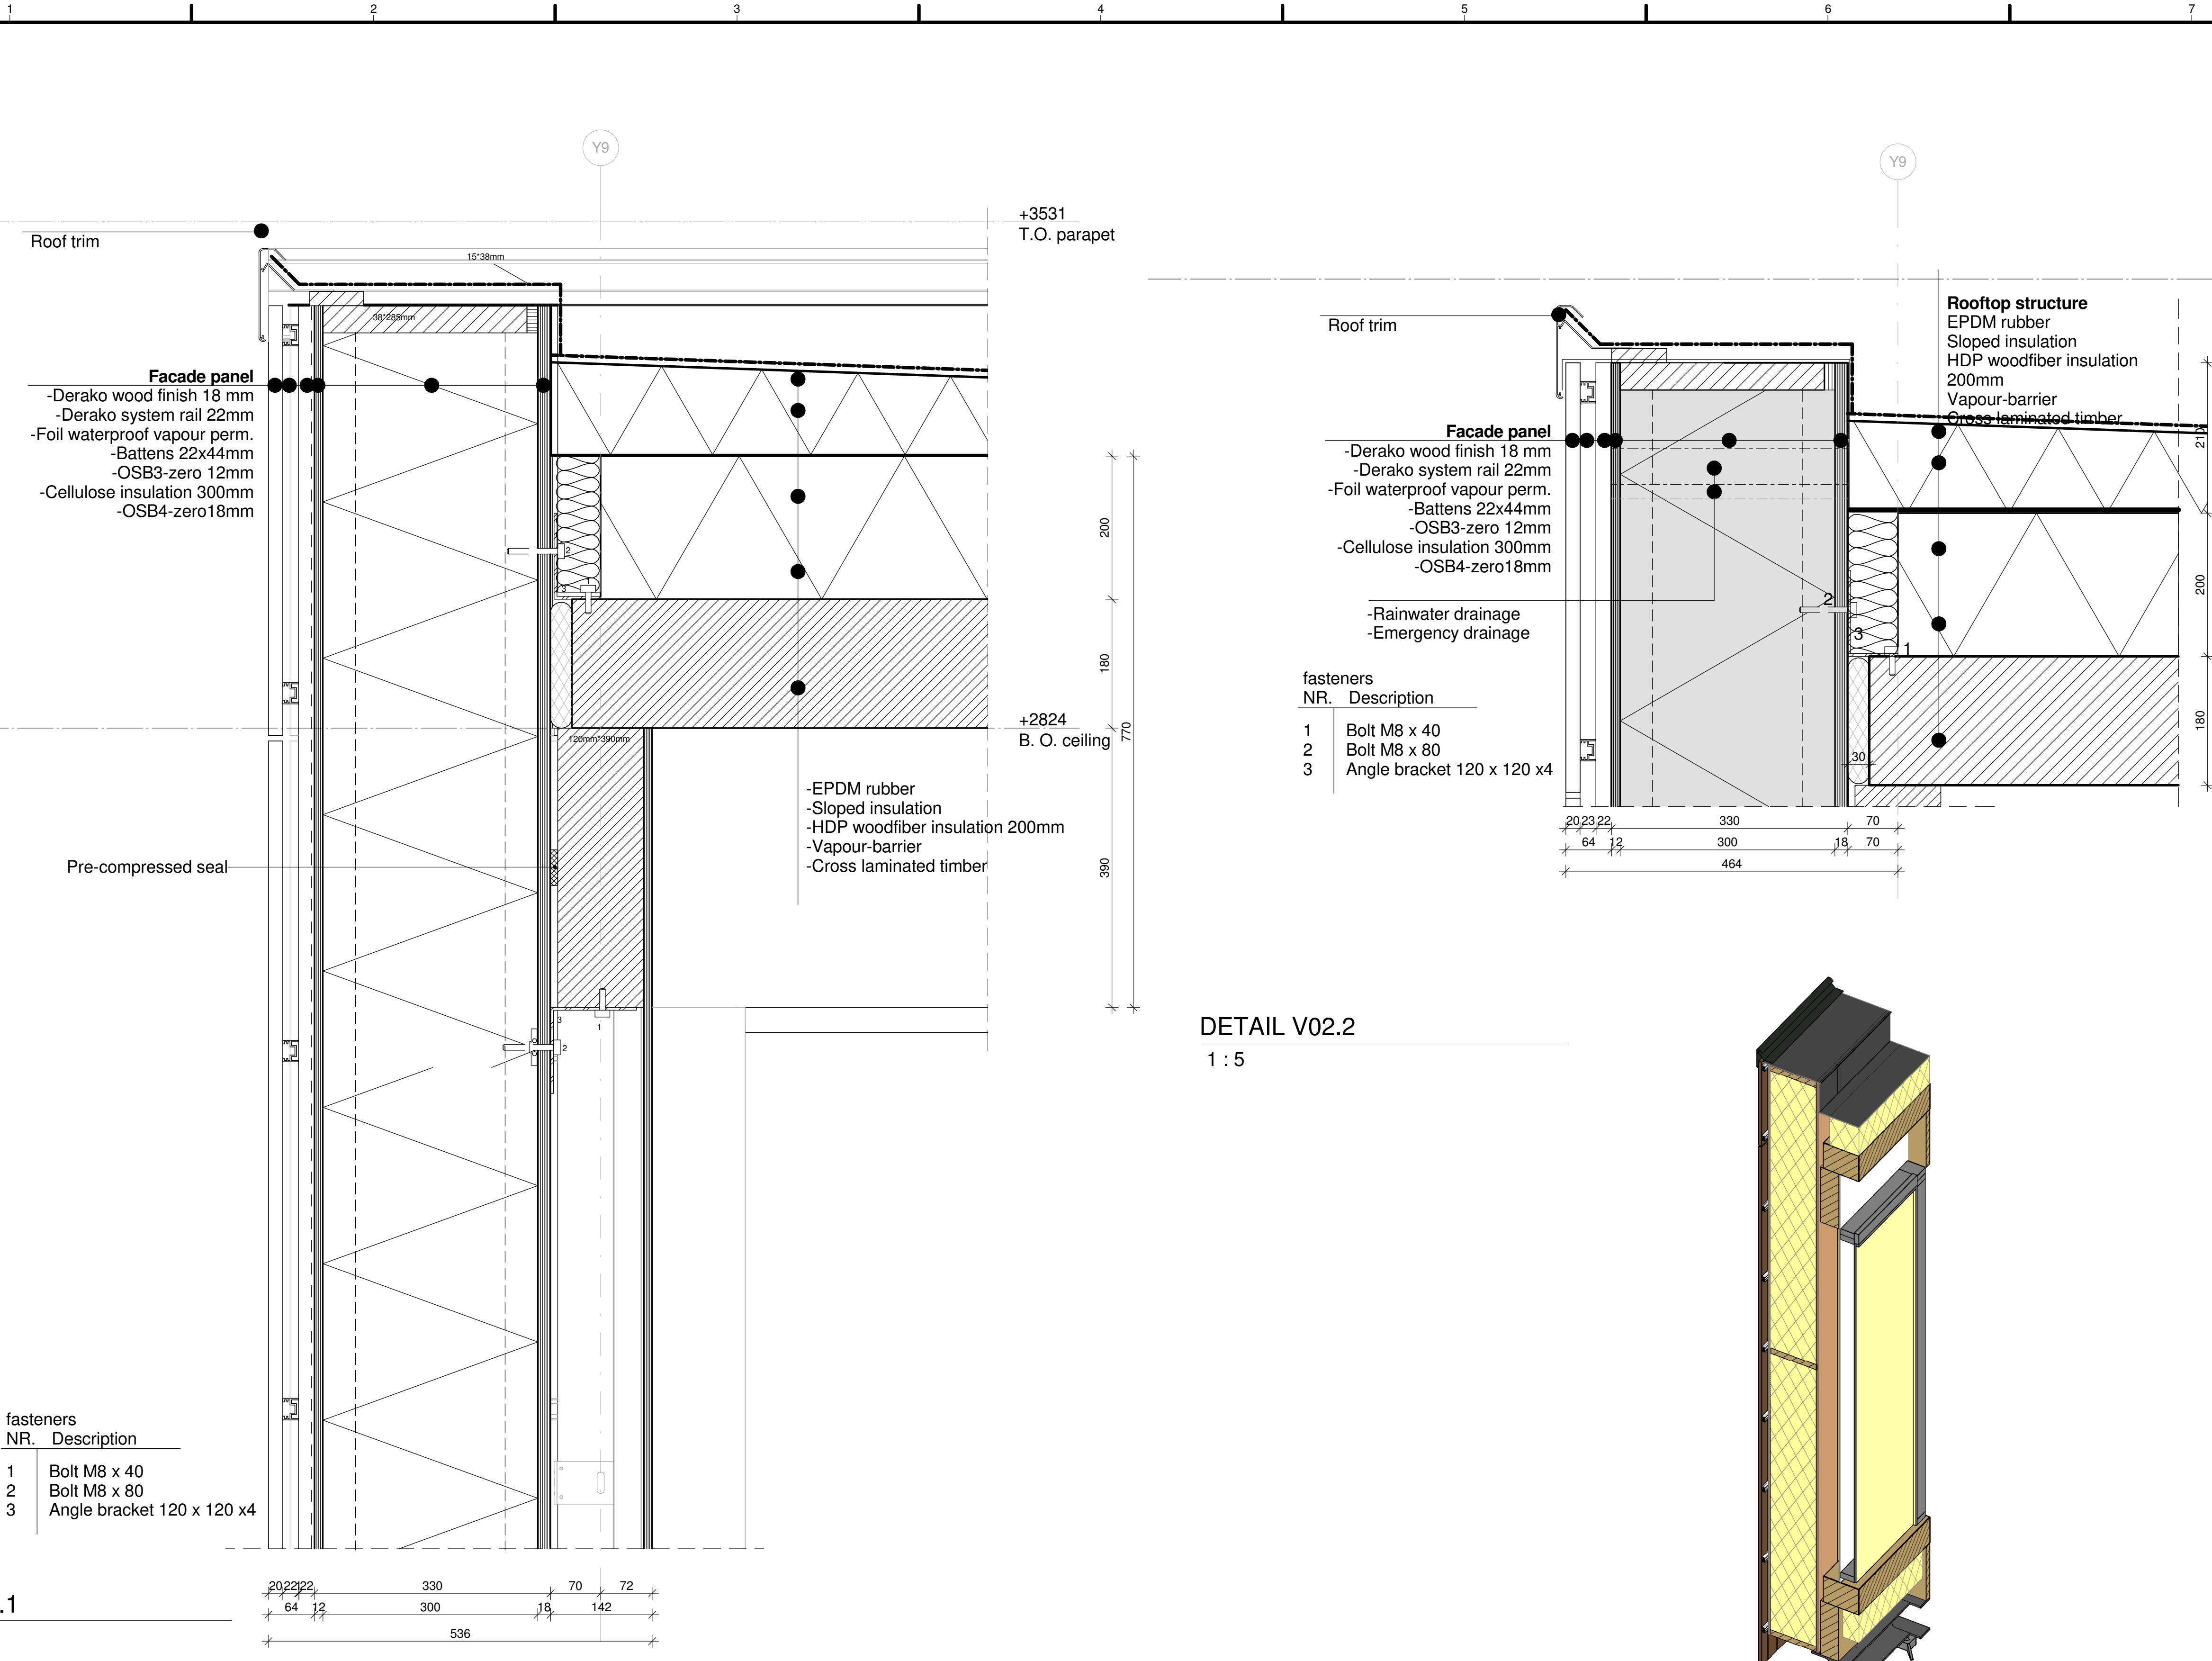

DETAIL V02.1
 1 : 5

DETAIL V02.2
 1 : 5

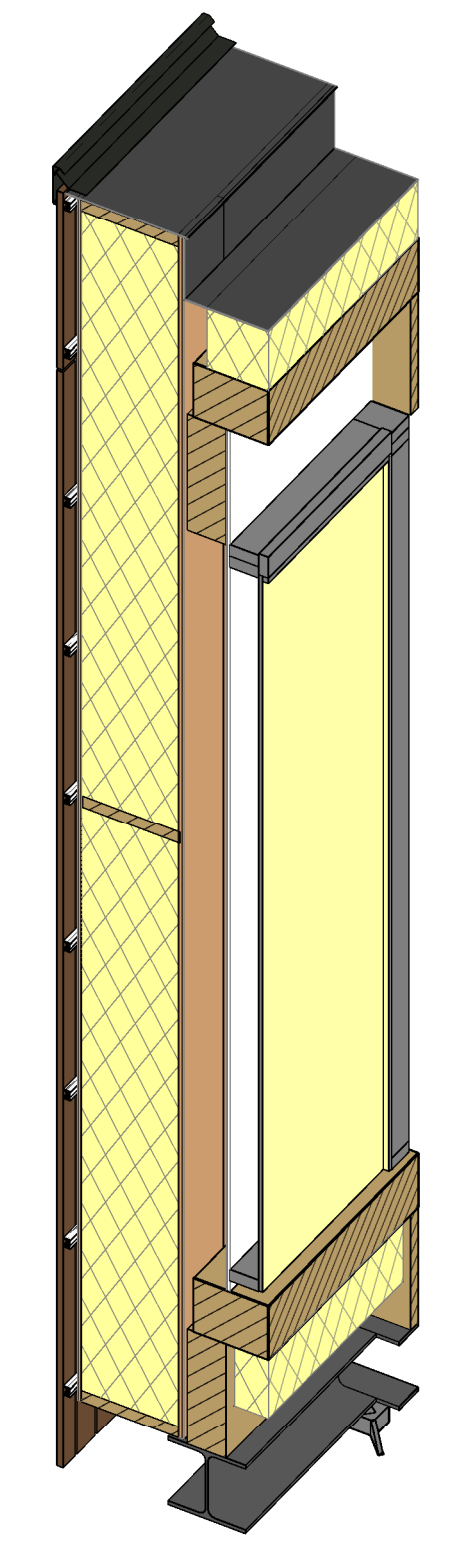

TEAM NAME: Selficient
 ADDRESS: Padualaan 99
 3584 CH Utrecht
 CONTACT: info@selficient.org
 www.selficient.org

CONSULTANTS
 ARCHITECTURE
 ENGINEERS
 LANDSCAPING
 SAFETY FIRST CODE CONSULTANTS

CLIENT
 U.S. DEPARTMENT OF ENERGY
 SOLAR DECATHLON 2017
 WWW.SOLARDECATHLON.GOV



0	17-11-2016	90% revision
---	------------	--------------



MARK	DATE	DESCRIPTION
------	------	-------------

LOT NUMBER: 106
 DRAWN BY: SELFICIENT
 CHECKED BY: Selficient
 COPYRIGHT: NONE; PROJECT IS PUBLIC DOMAIN

SCALE: 1 : 5

SHEET TITLE



DETAIL V03 -
 CONNECTION
 FOUNDATION AT
 OVERHANG
A-452

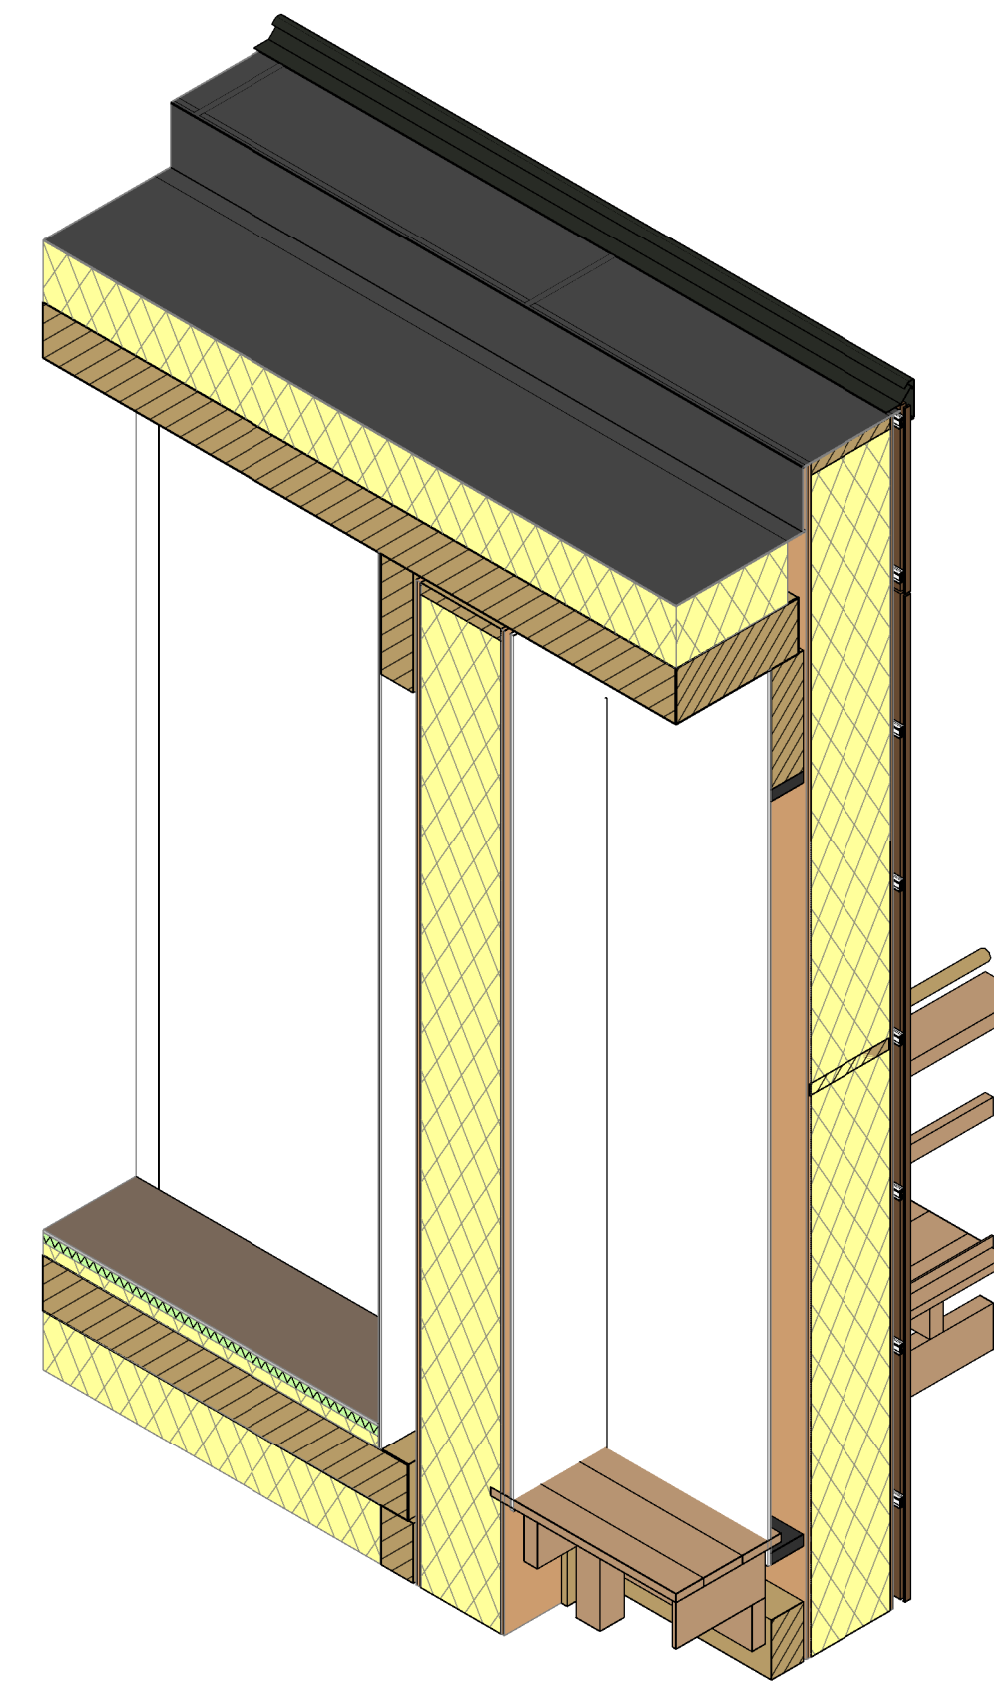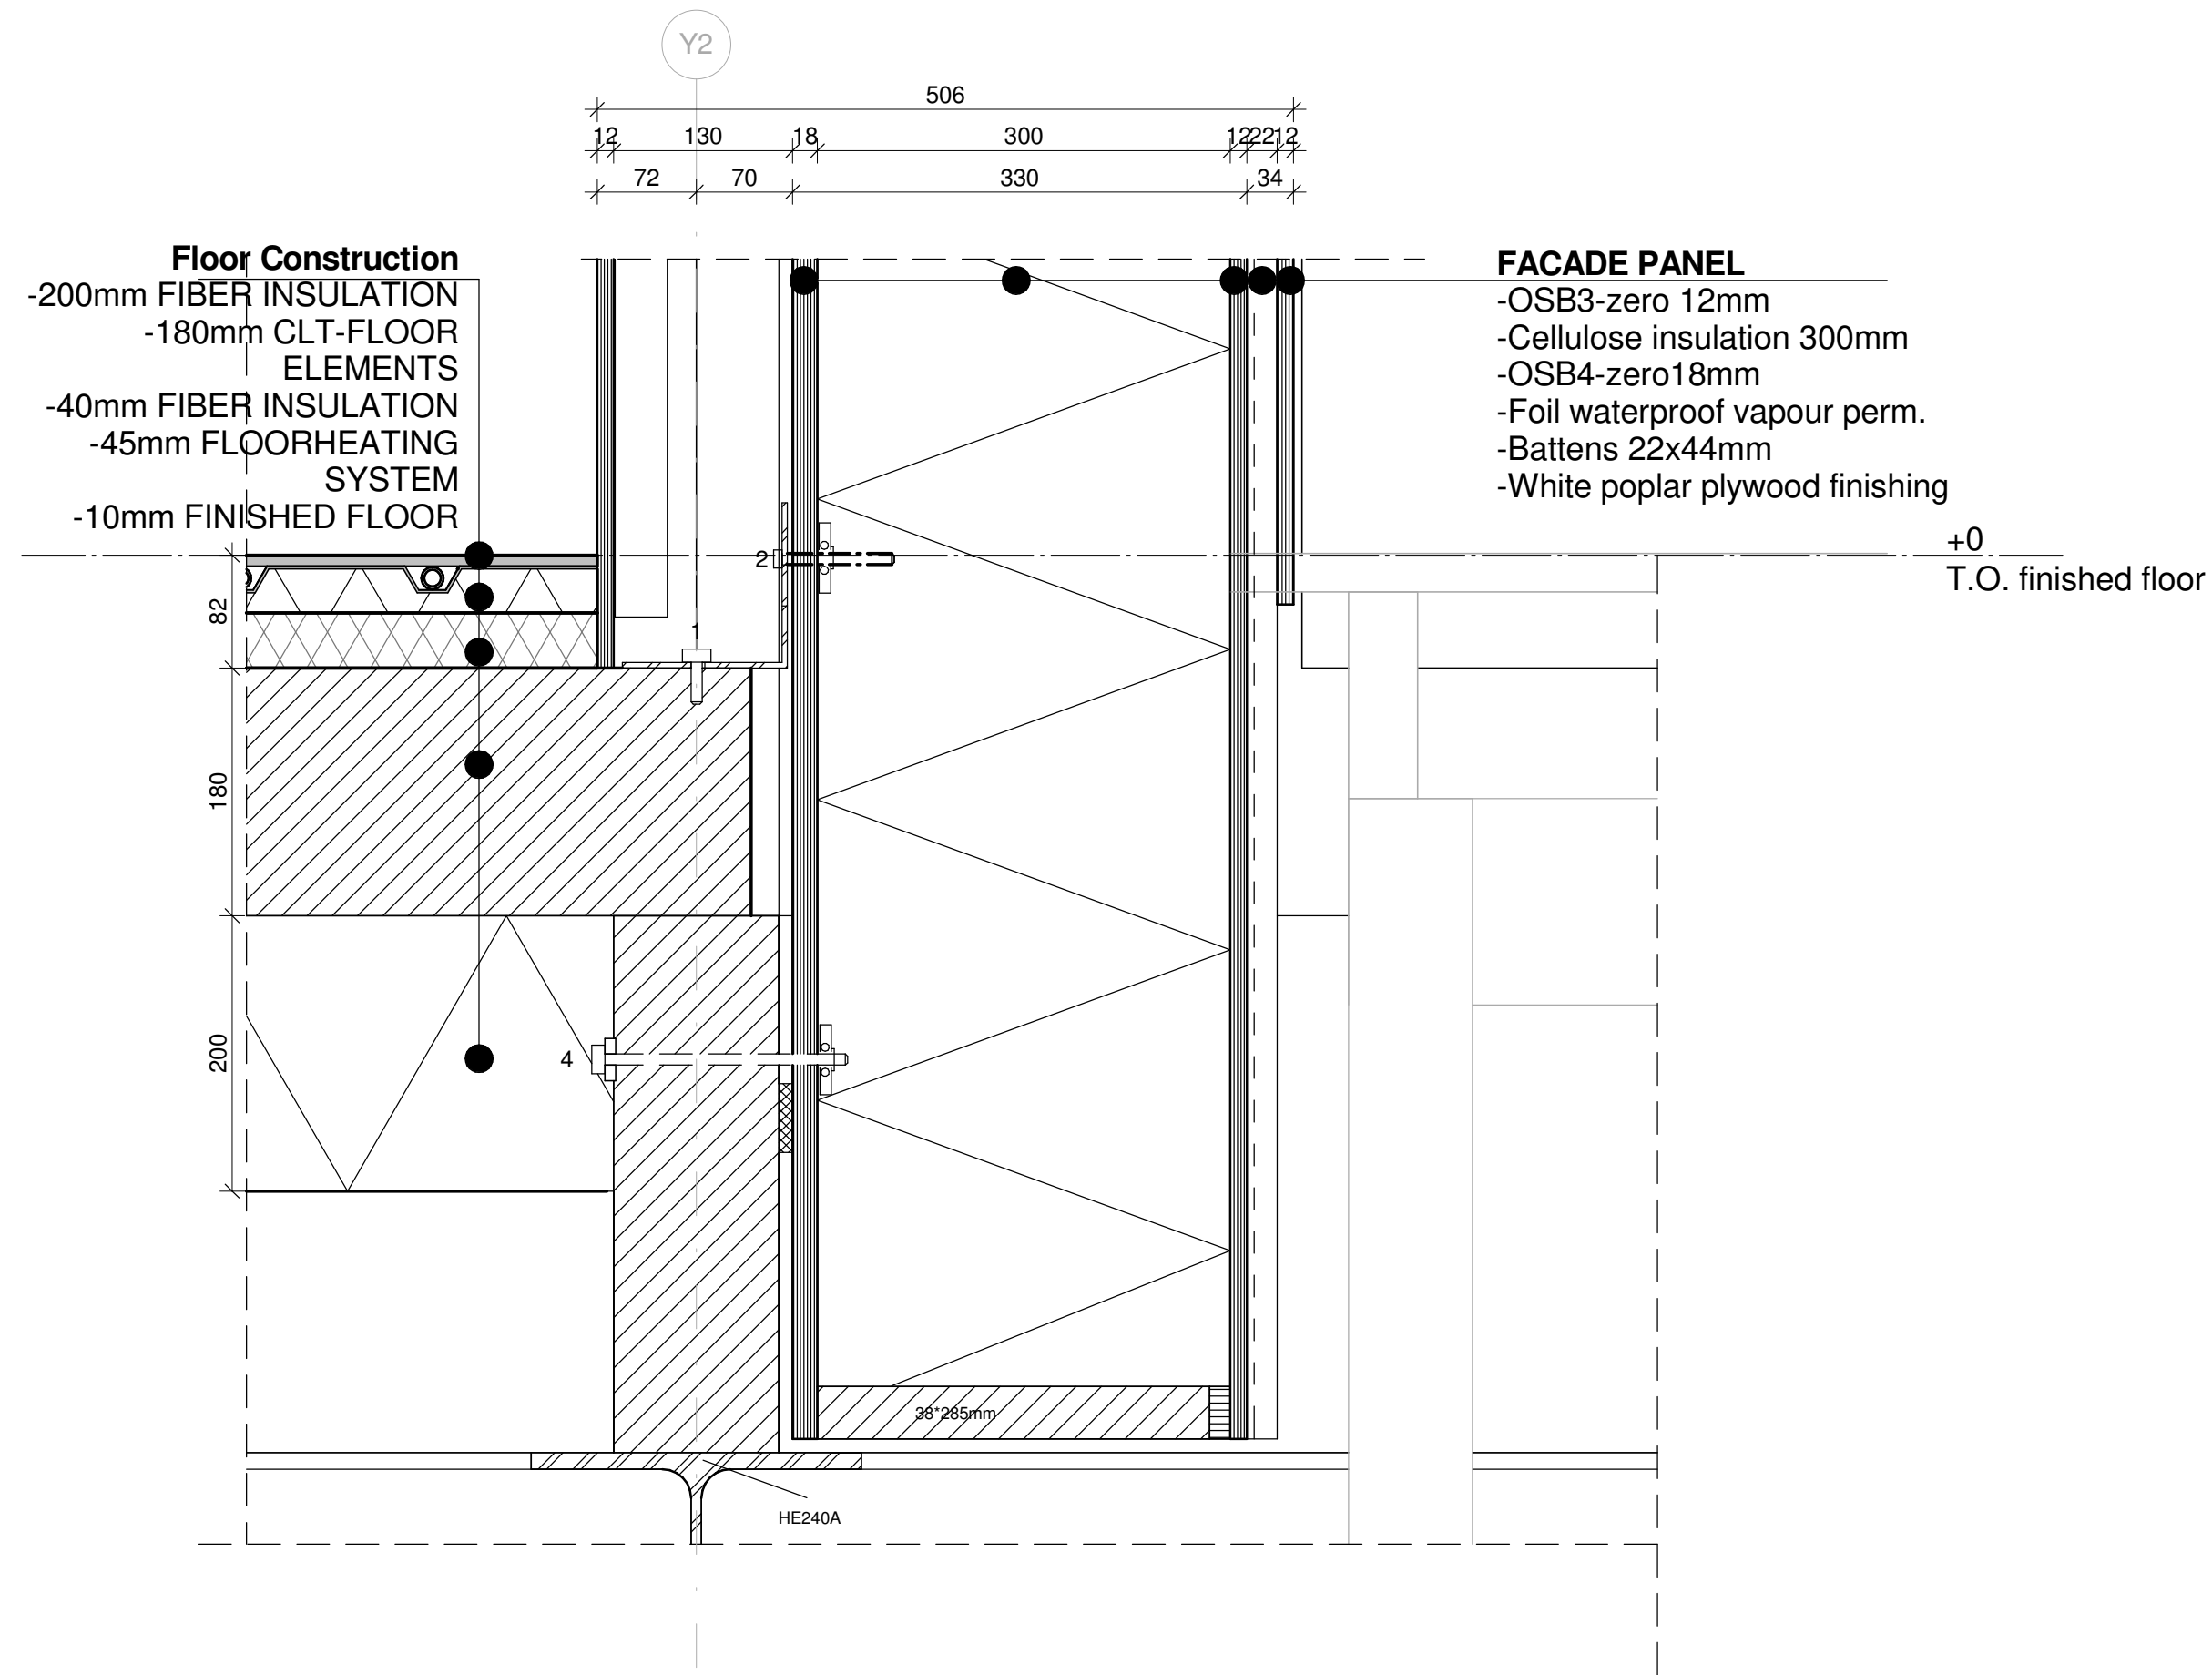

DETAIL V03
 1 : 5

Bolt types

NR.	Description
1	Bolt M8 x 40
2	Bolt M8 x 80
3	Screw thread M8 160mm
4	Bolt M8 x 180

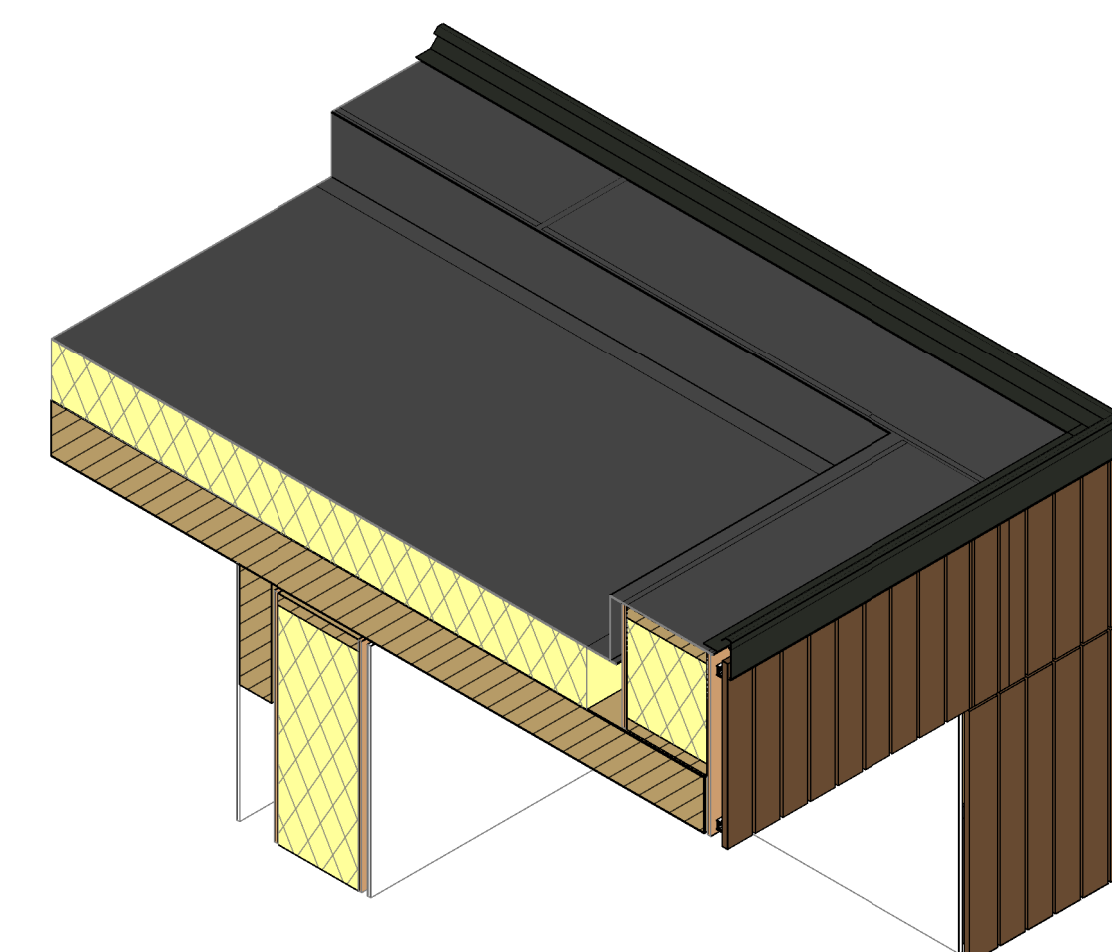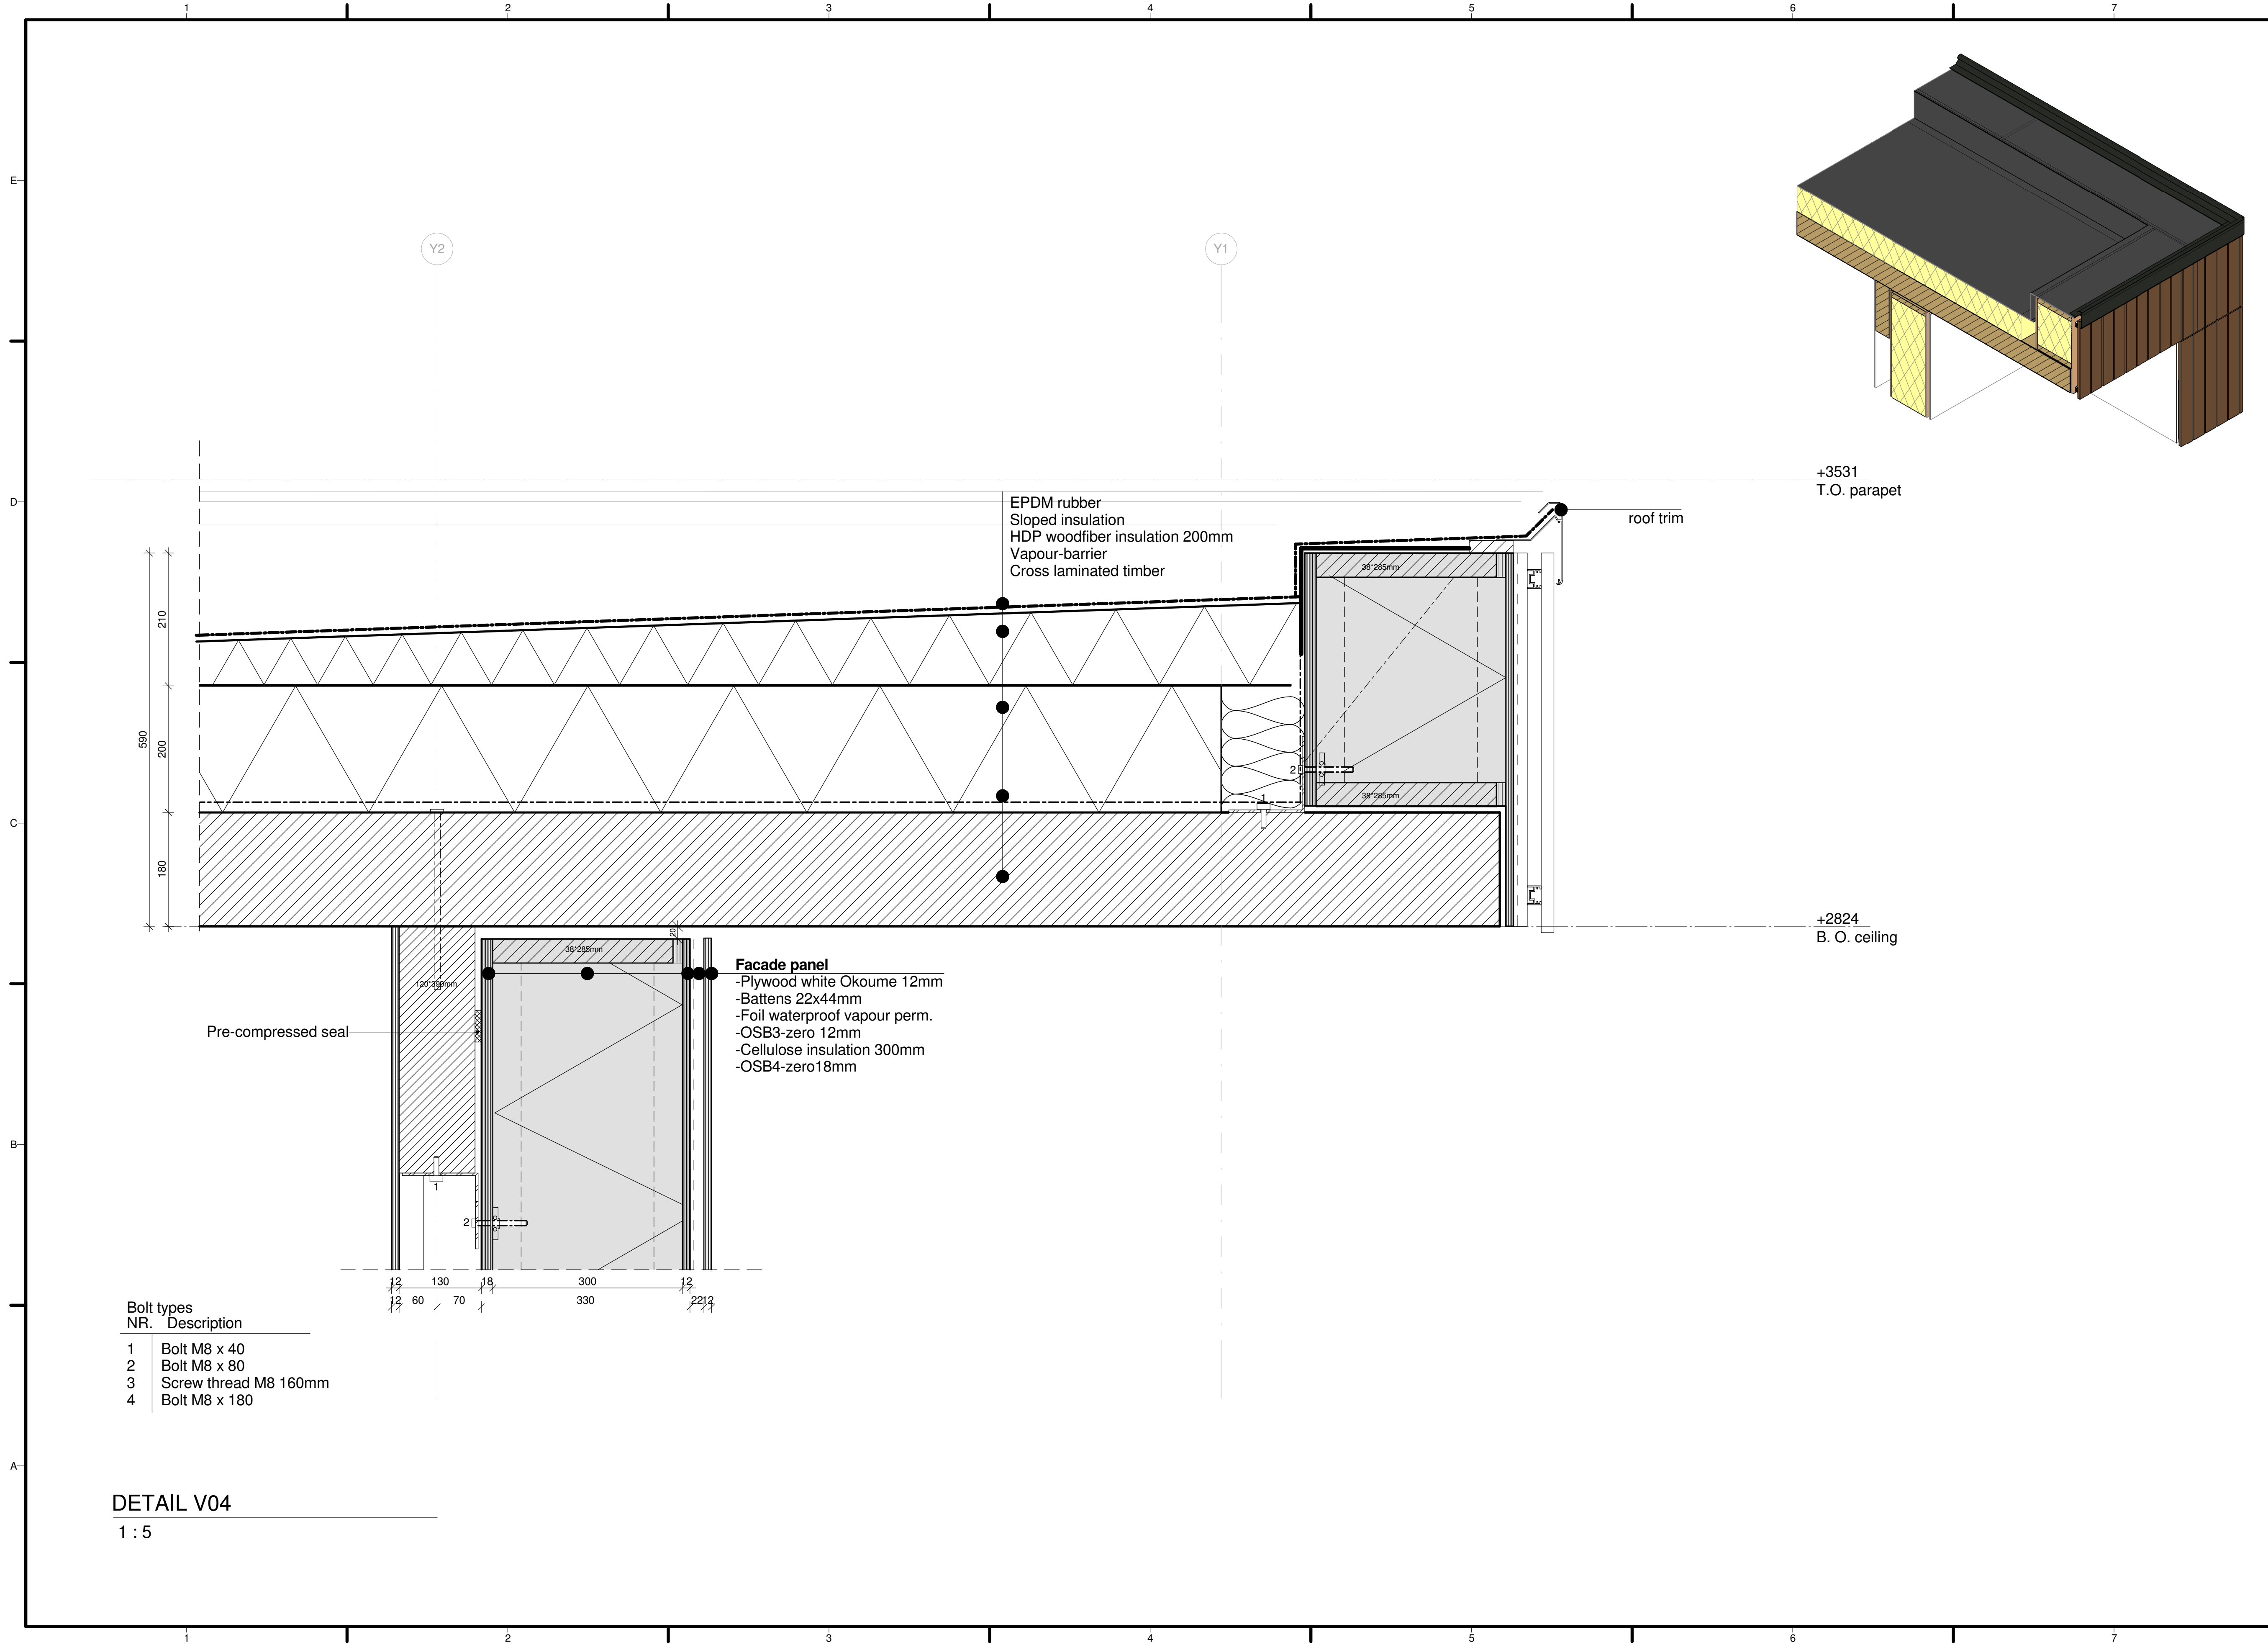

TEAM NAME: Selficient
 ADDRESS: Padualaan 99
 3584 CH Utrecht
 CONTACT: info@selficient.org
 www.selficient.org

CONSULTANTS
 ARCHITECTURE
 ENGINEERS
 LANDSCAPING
 SAFETY FIRST CODE CONSULTANTS

CLIENT
 U.S. DEPARTMENT OF ENERGY
 SOLAR DECATHLON 2017
 WWW.SOLARDECATHLON.GOV



0	17-11-2016	90% revision
---	------------	--------------

MARK	DATE	DESCRIPTION
------	------	-------------

LOT NUMBER: 106
 DRAWN BY: Author
 CHECKED BY: Selficient
 COPYRIGHT: NONE; PROJECT IS PUBLIC DOMAIN

SCALE: 1 : 5

SHEET TITLE

DETAIL V04 -
 CONNECTION EAVES
 AT OVERHANG



A-453

Bolt types

NR.	Description
1	Bolt M8 x 40
2	Bolt M8 x 80
3	Screw thread M8 160mm
4	Bolt M8 x 180


DETAIL V04
 1 : 5

12	130	18	300	12
12	60	70	330	2212

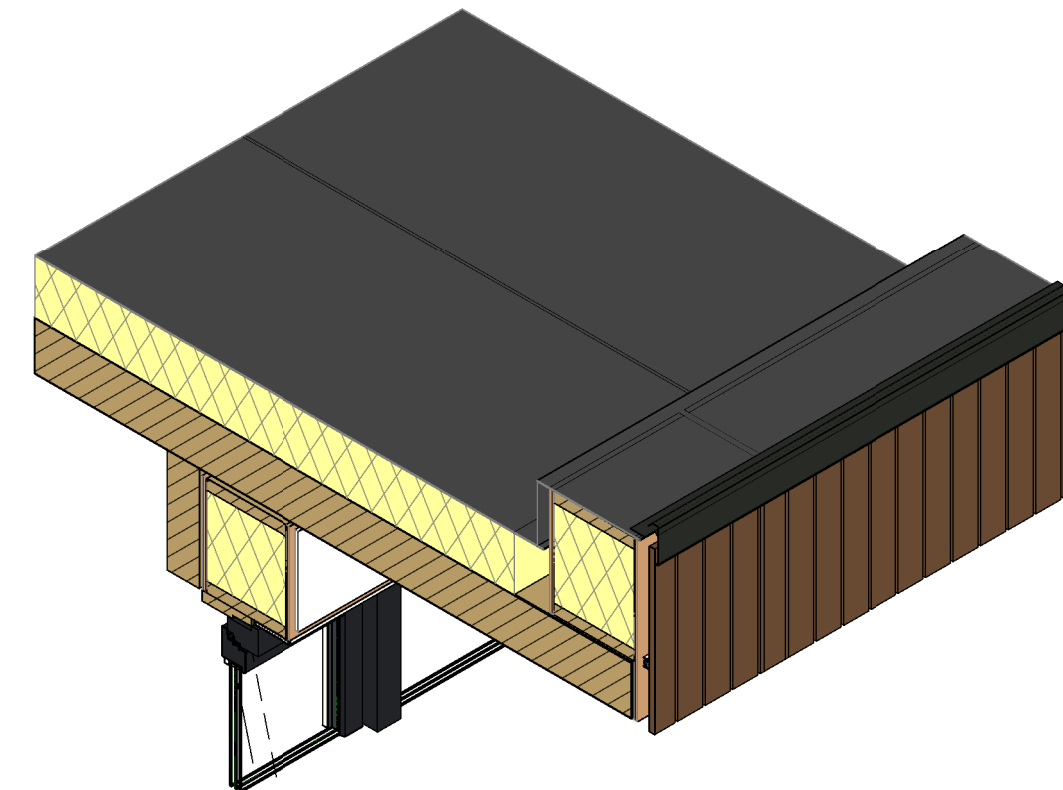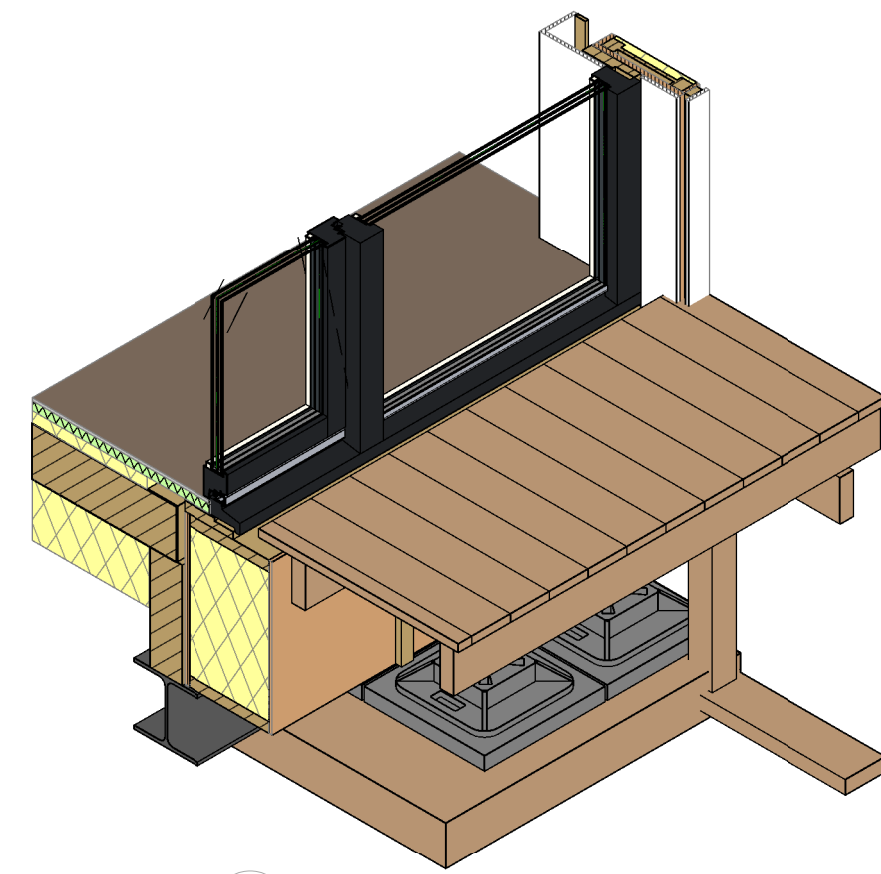


Floor Construction
 -200mm FIBER INSULATION
 -180mm CLT-FLOOR
 ELEMENTS
 -40mm FIBER INSULATION
 -45mm FLOORHEATING
 SYSTEM
 -10mm FINISHED FLOOR

60 383
 70 18 300 12

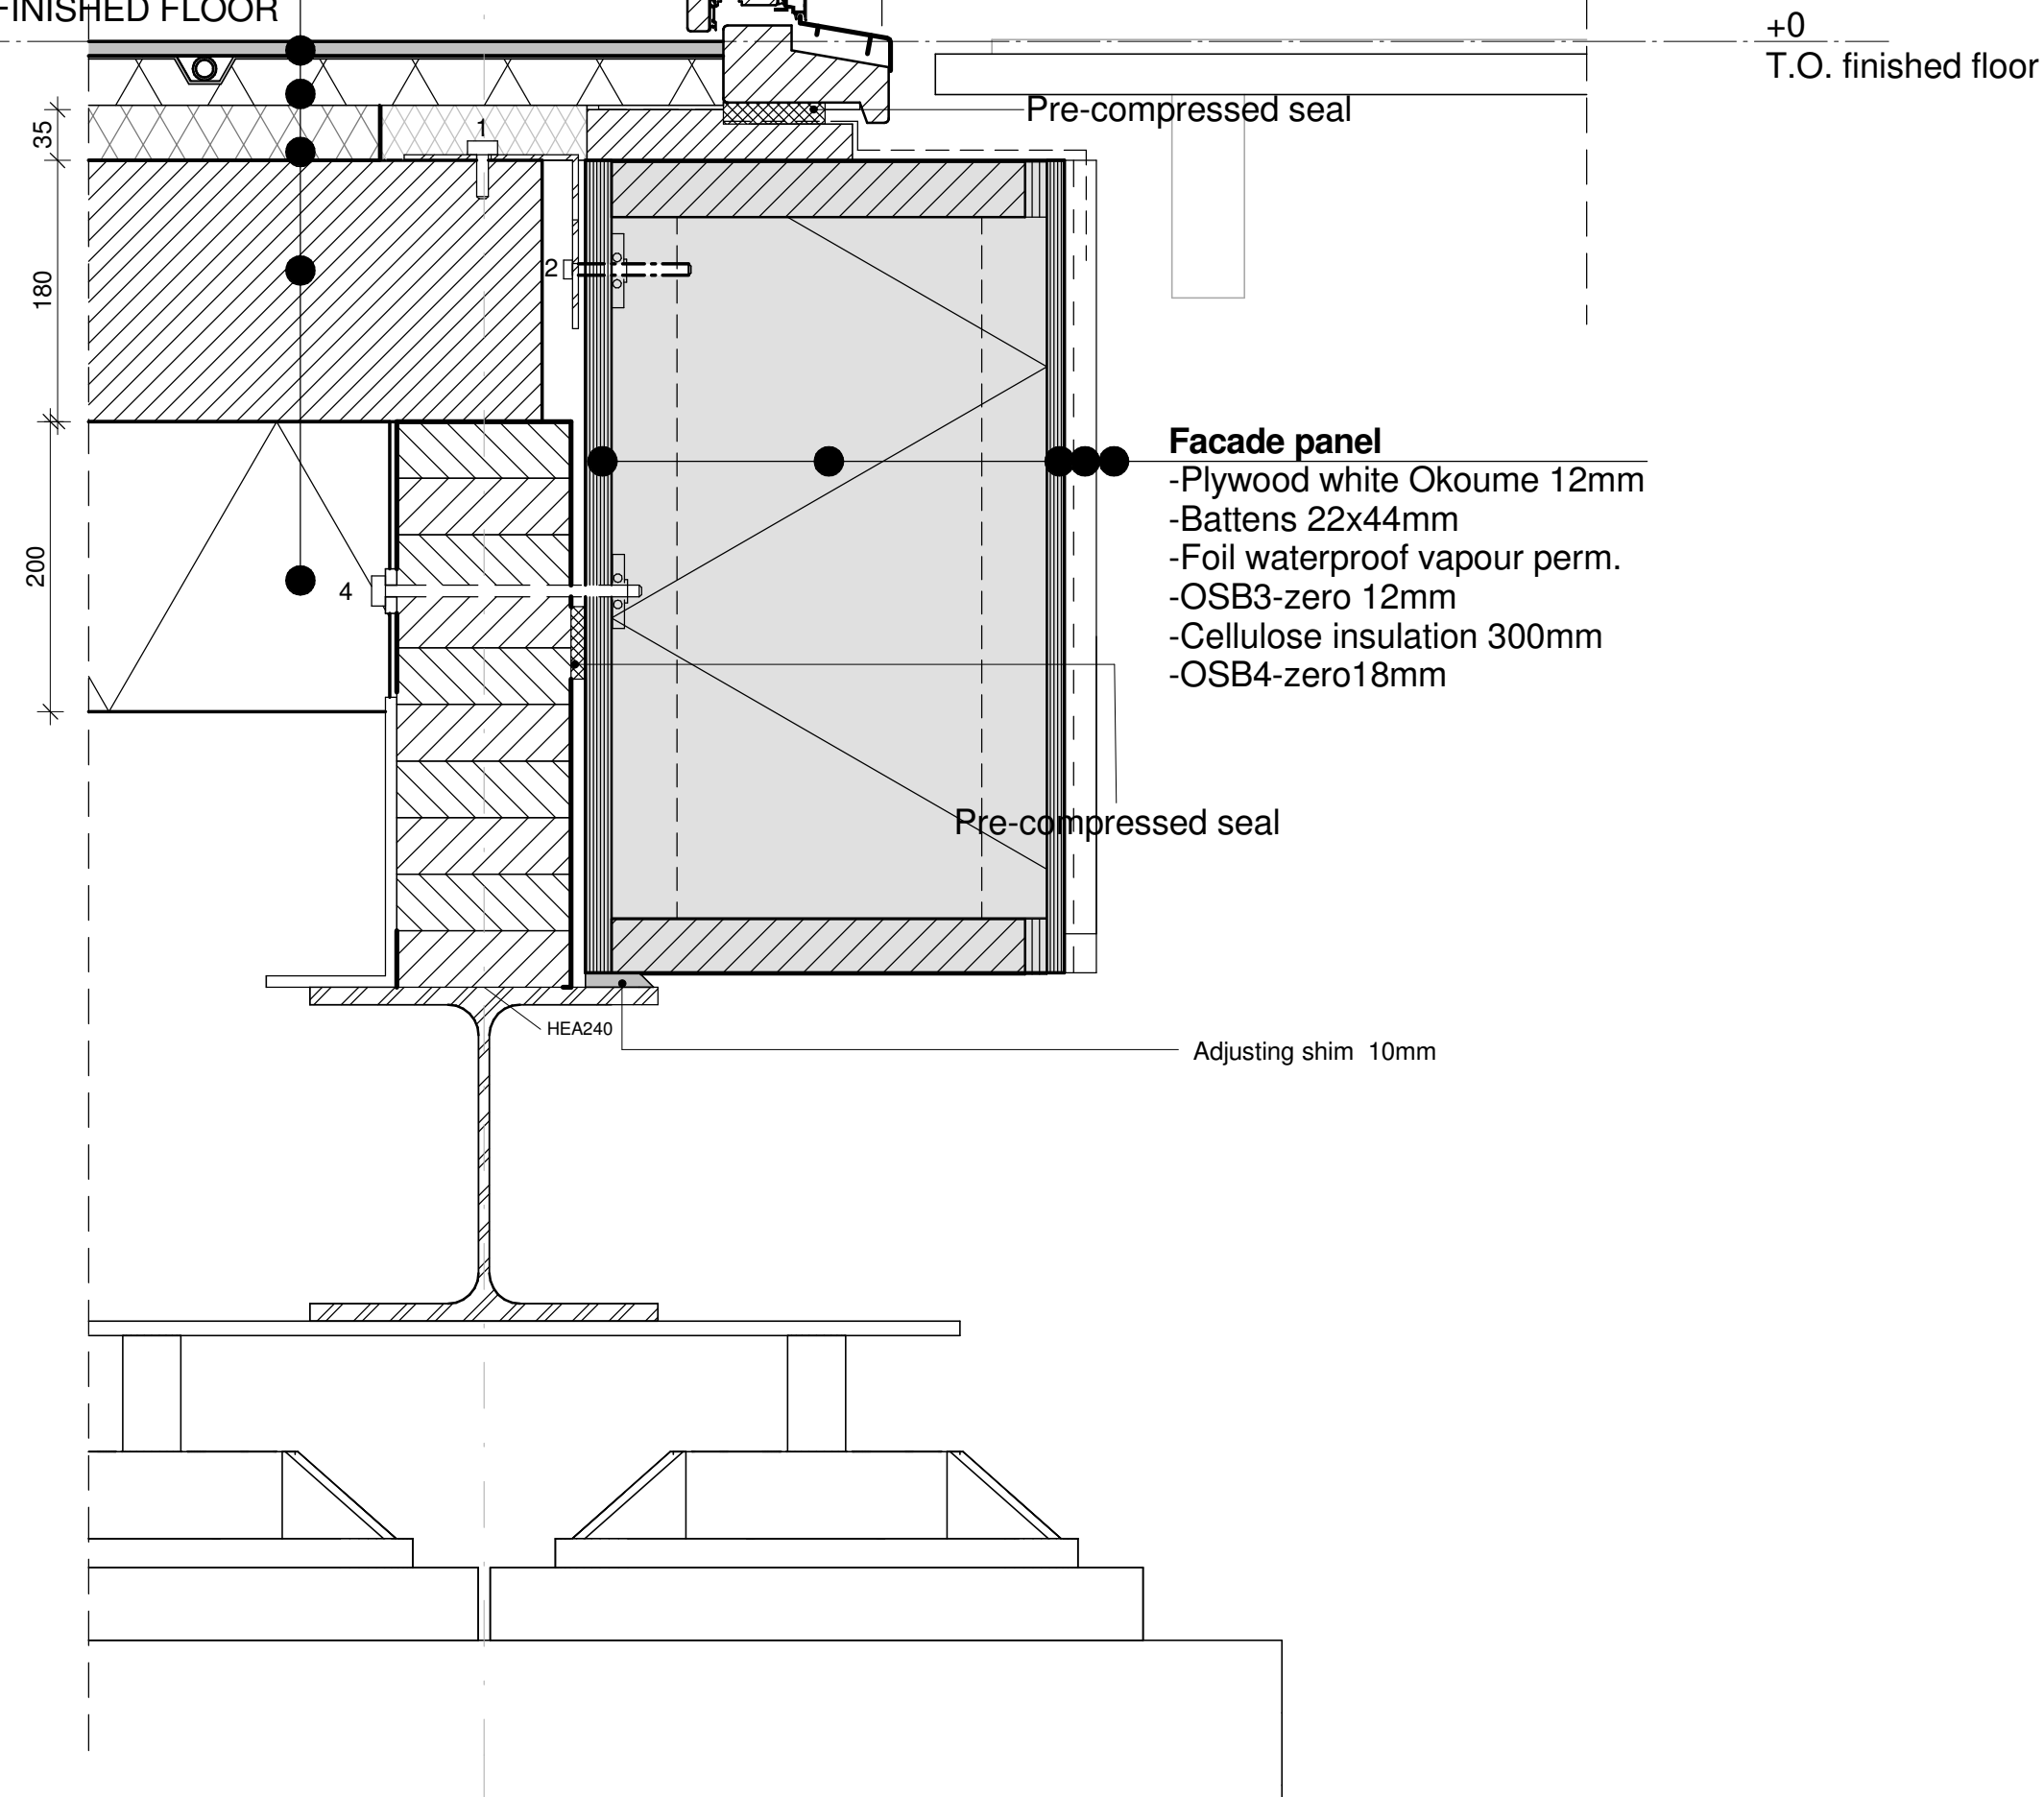

Facade panel
 -Plywood white Okoume 12mm
 -Battens 22x44mm
 -Foil waterproof vapour perm.
 -OSB3-zero 12mm
 -Cellulose insulation 300mm
 -OSB4-zero18mm

Rooftop structure
 EPDM rubber
 Sloped insulation
 HDP woodfiber insulation
 200mm
 Vapour-barrier
 Cross laminated timber

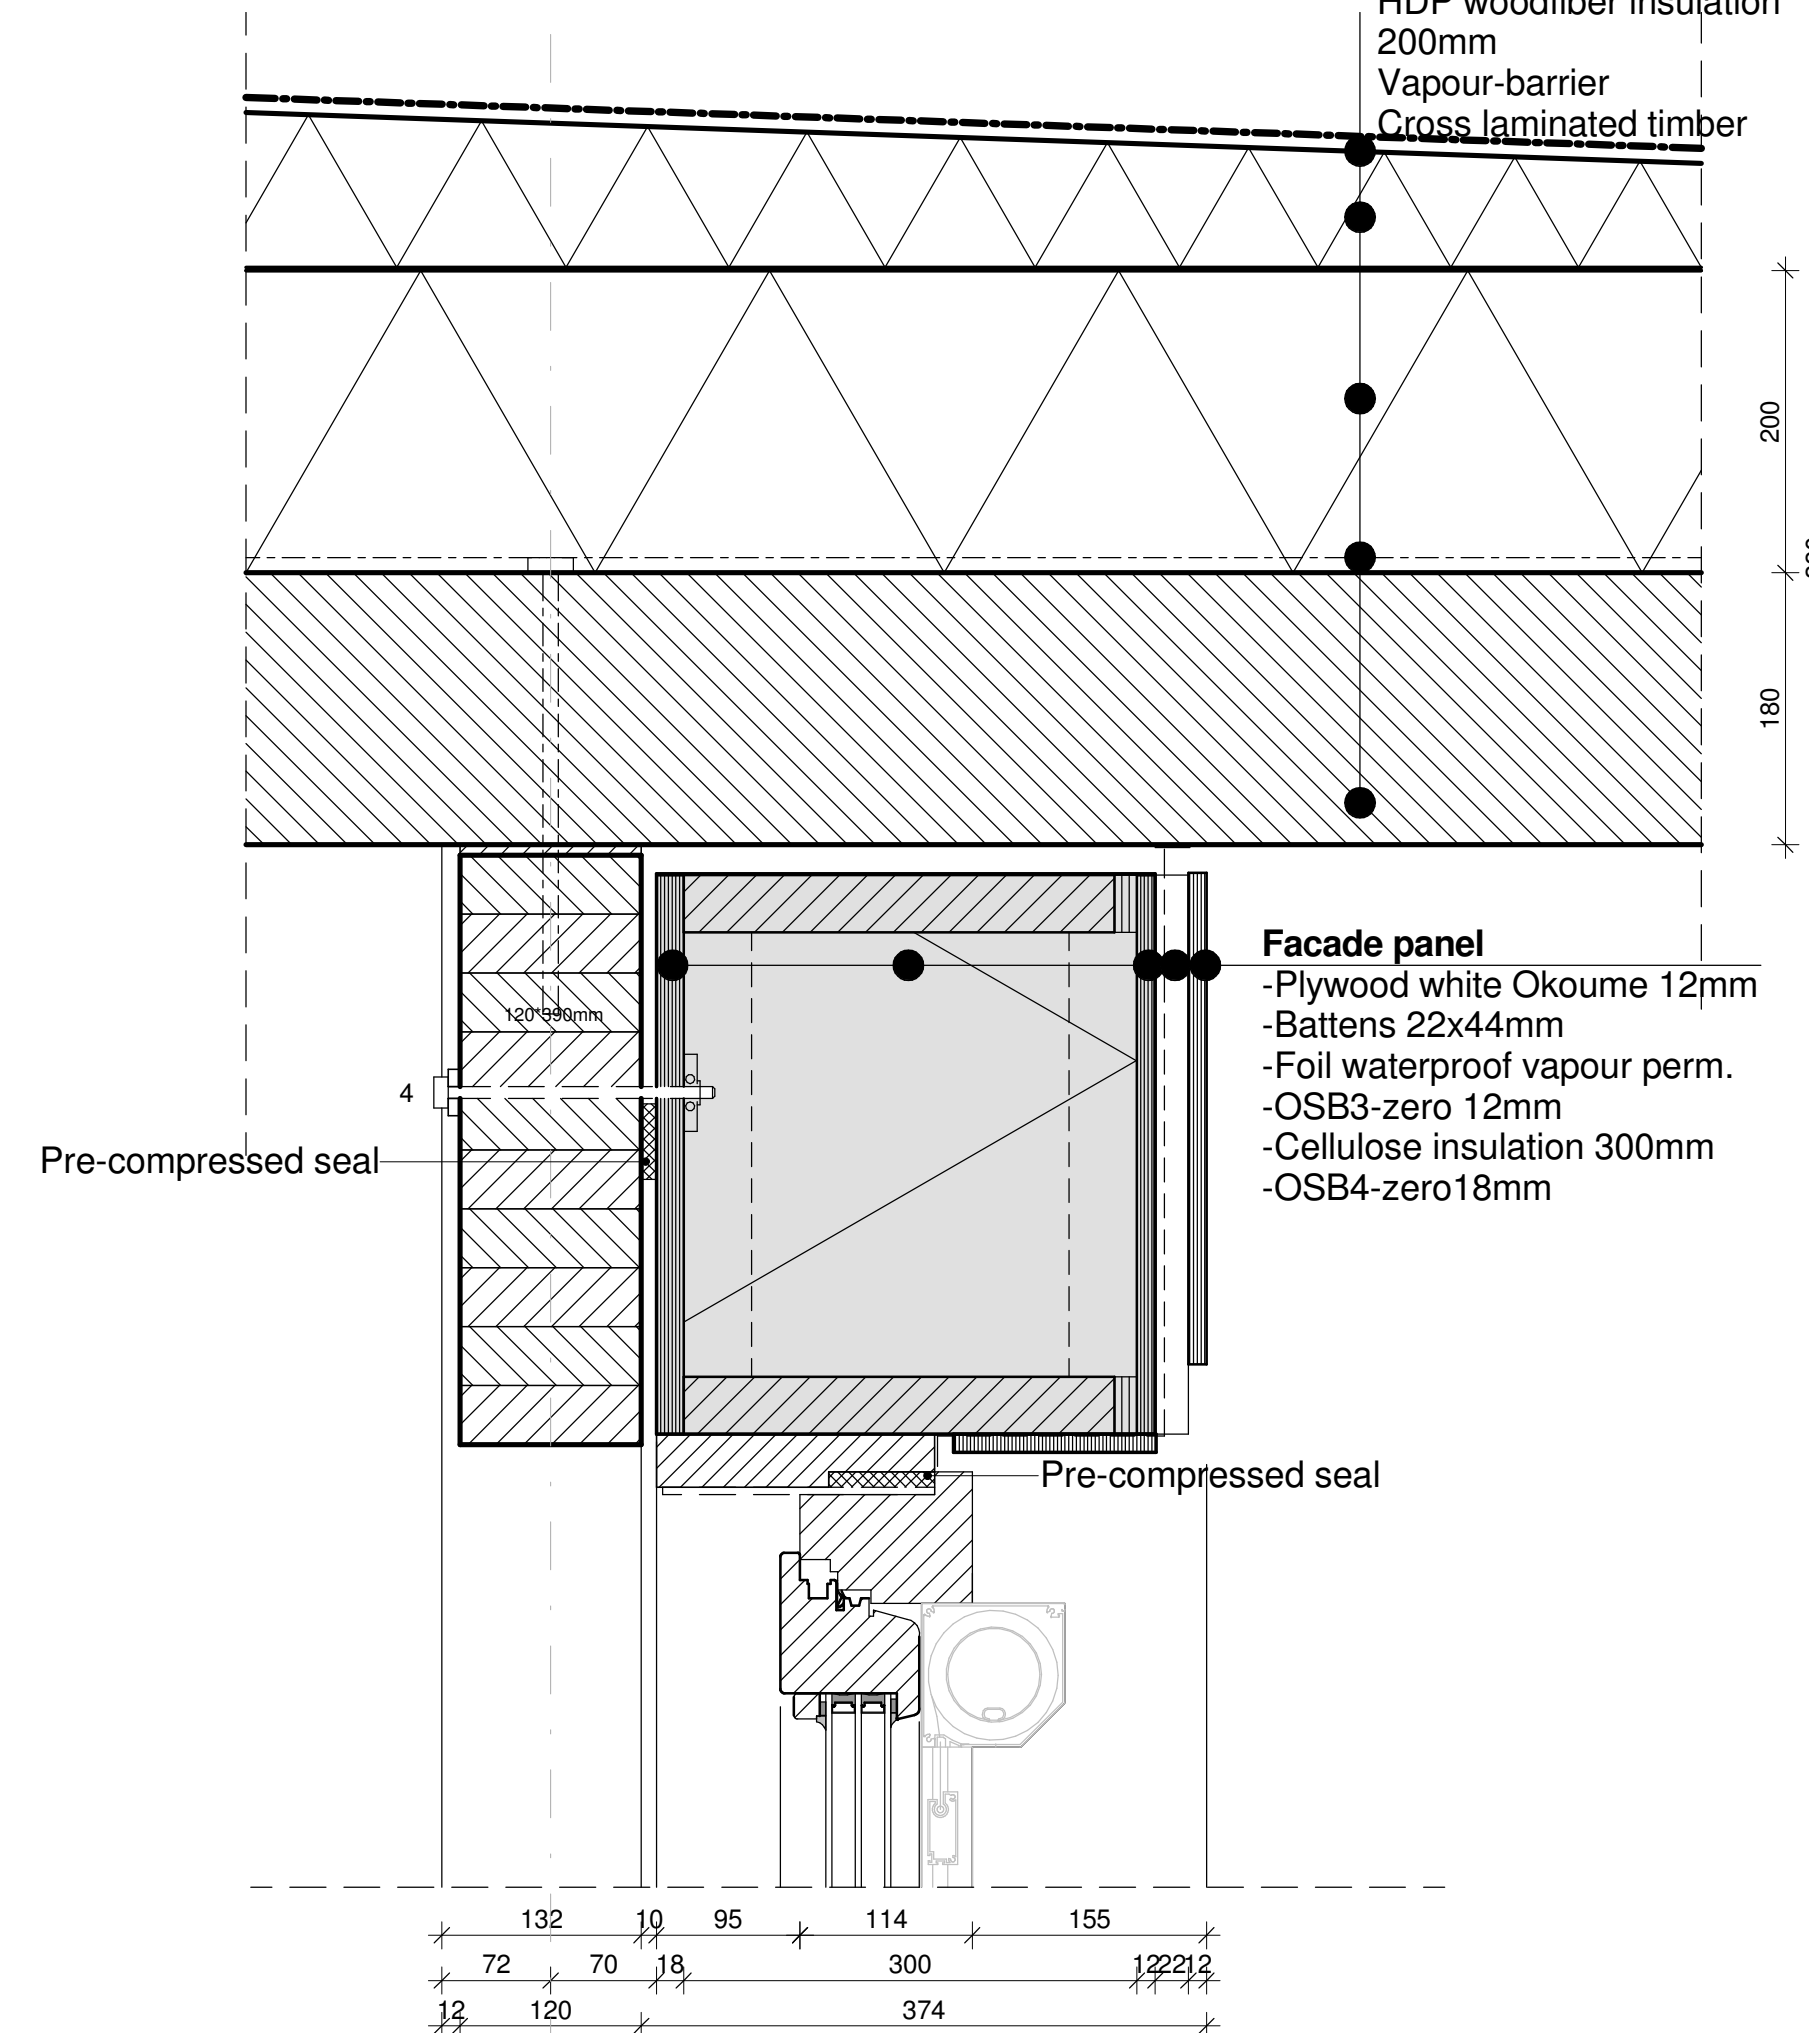

Facade panel
 -Plywood white Okoume 12mm
 -Battens 22x44mm
 -Foil waterproof vapour perm.
 -OSB3-zero 12mm
 -Cellulose insulation 300mm
 -OSB4-zero18mm

Bolt types

NR.	Description
1	Bolt M8 x 40
2	Bolt M8 x 80
3	Screw thread M8 160mm
4	Bolt M8 x 180

DETAIL V05
 1 : 5

DETAIL V06
 1 : 5

132 10 95 114 155
 72 70 18 300 122 12
 12 120 374

TEAM NAME: Selficient
 ADDRESS: Padualaan 99
 3584 CH Utrecht
 CONTACT: info@selficient.org
 www.selficient.org

CONSULTANTS
 ARCHITECTURE
 ENGINEERS
 LANDSCAPING
 SAFETY FIRST CODE CONSULTANTS

CLIENT
 U.S. DEPARTMENT OF ENERGY
 SOLAR DECATHLON 2017
 WWW.SOLARDECATHLON.GOV



0	17-11-2016	90% revision
---	------------	--------------

MARK	DATE	DESCRIPTION
------	------	-------------



LOT NUMBER: 106
 DRAWN BY: SELFICIENT
 CHECKED BY: Selficient
 COPYRIGHT: NONE; PROJECT IS PUBLIC DOMAIN

SCALE: 1 : 5

SHEET TITLE



DETAIL V07-V08 -
 CONNECTION WINDOW

A-455

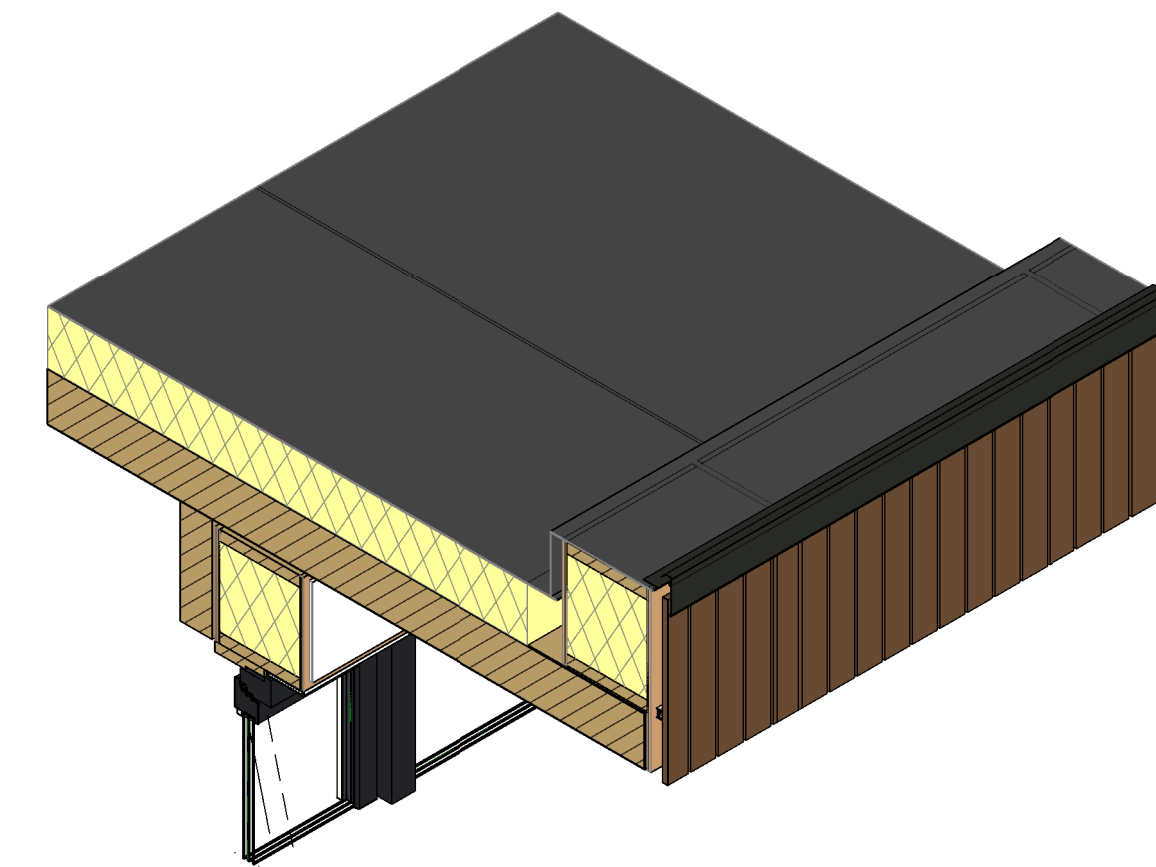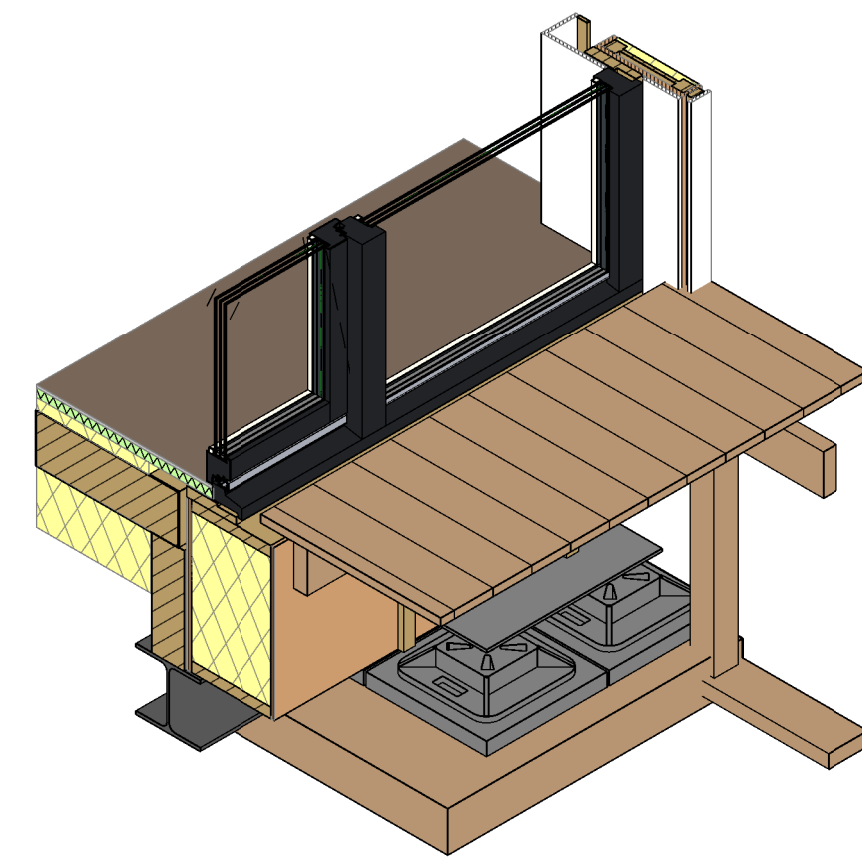

Floor Construction
 -200mm FIBER INSULATION
 -180mm CLT-FLOOR
 ELEMENTS
 -40mm FIBER INSULATION
 -45mm FLOORHEATING
 SYSTEM
 -10mm FINISHED FLOOR

Rooftop structure
 EPDM rubber
 Sloped insulation
 HDP woodfiber insulation
 200mm
 Vapour-barrier
 Cross laminated timber


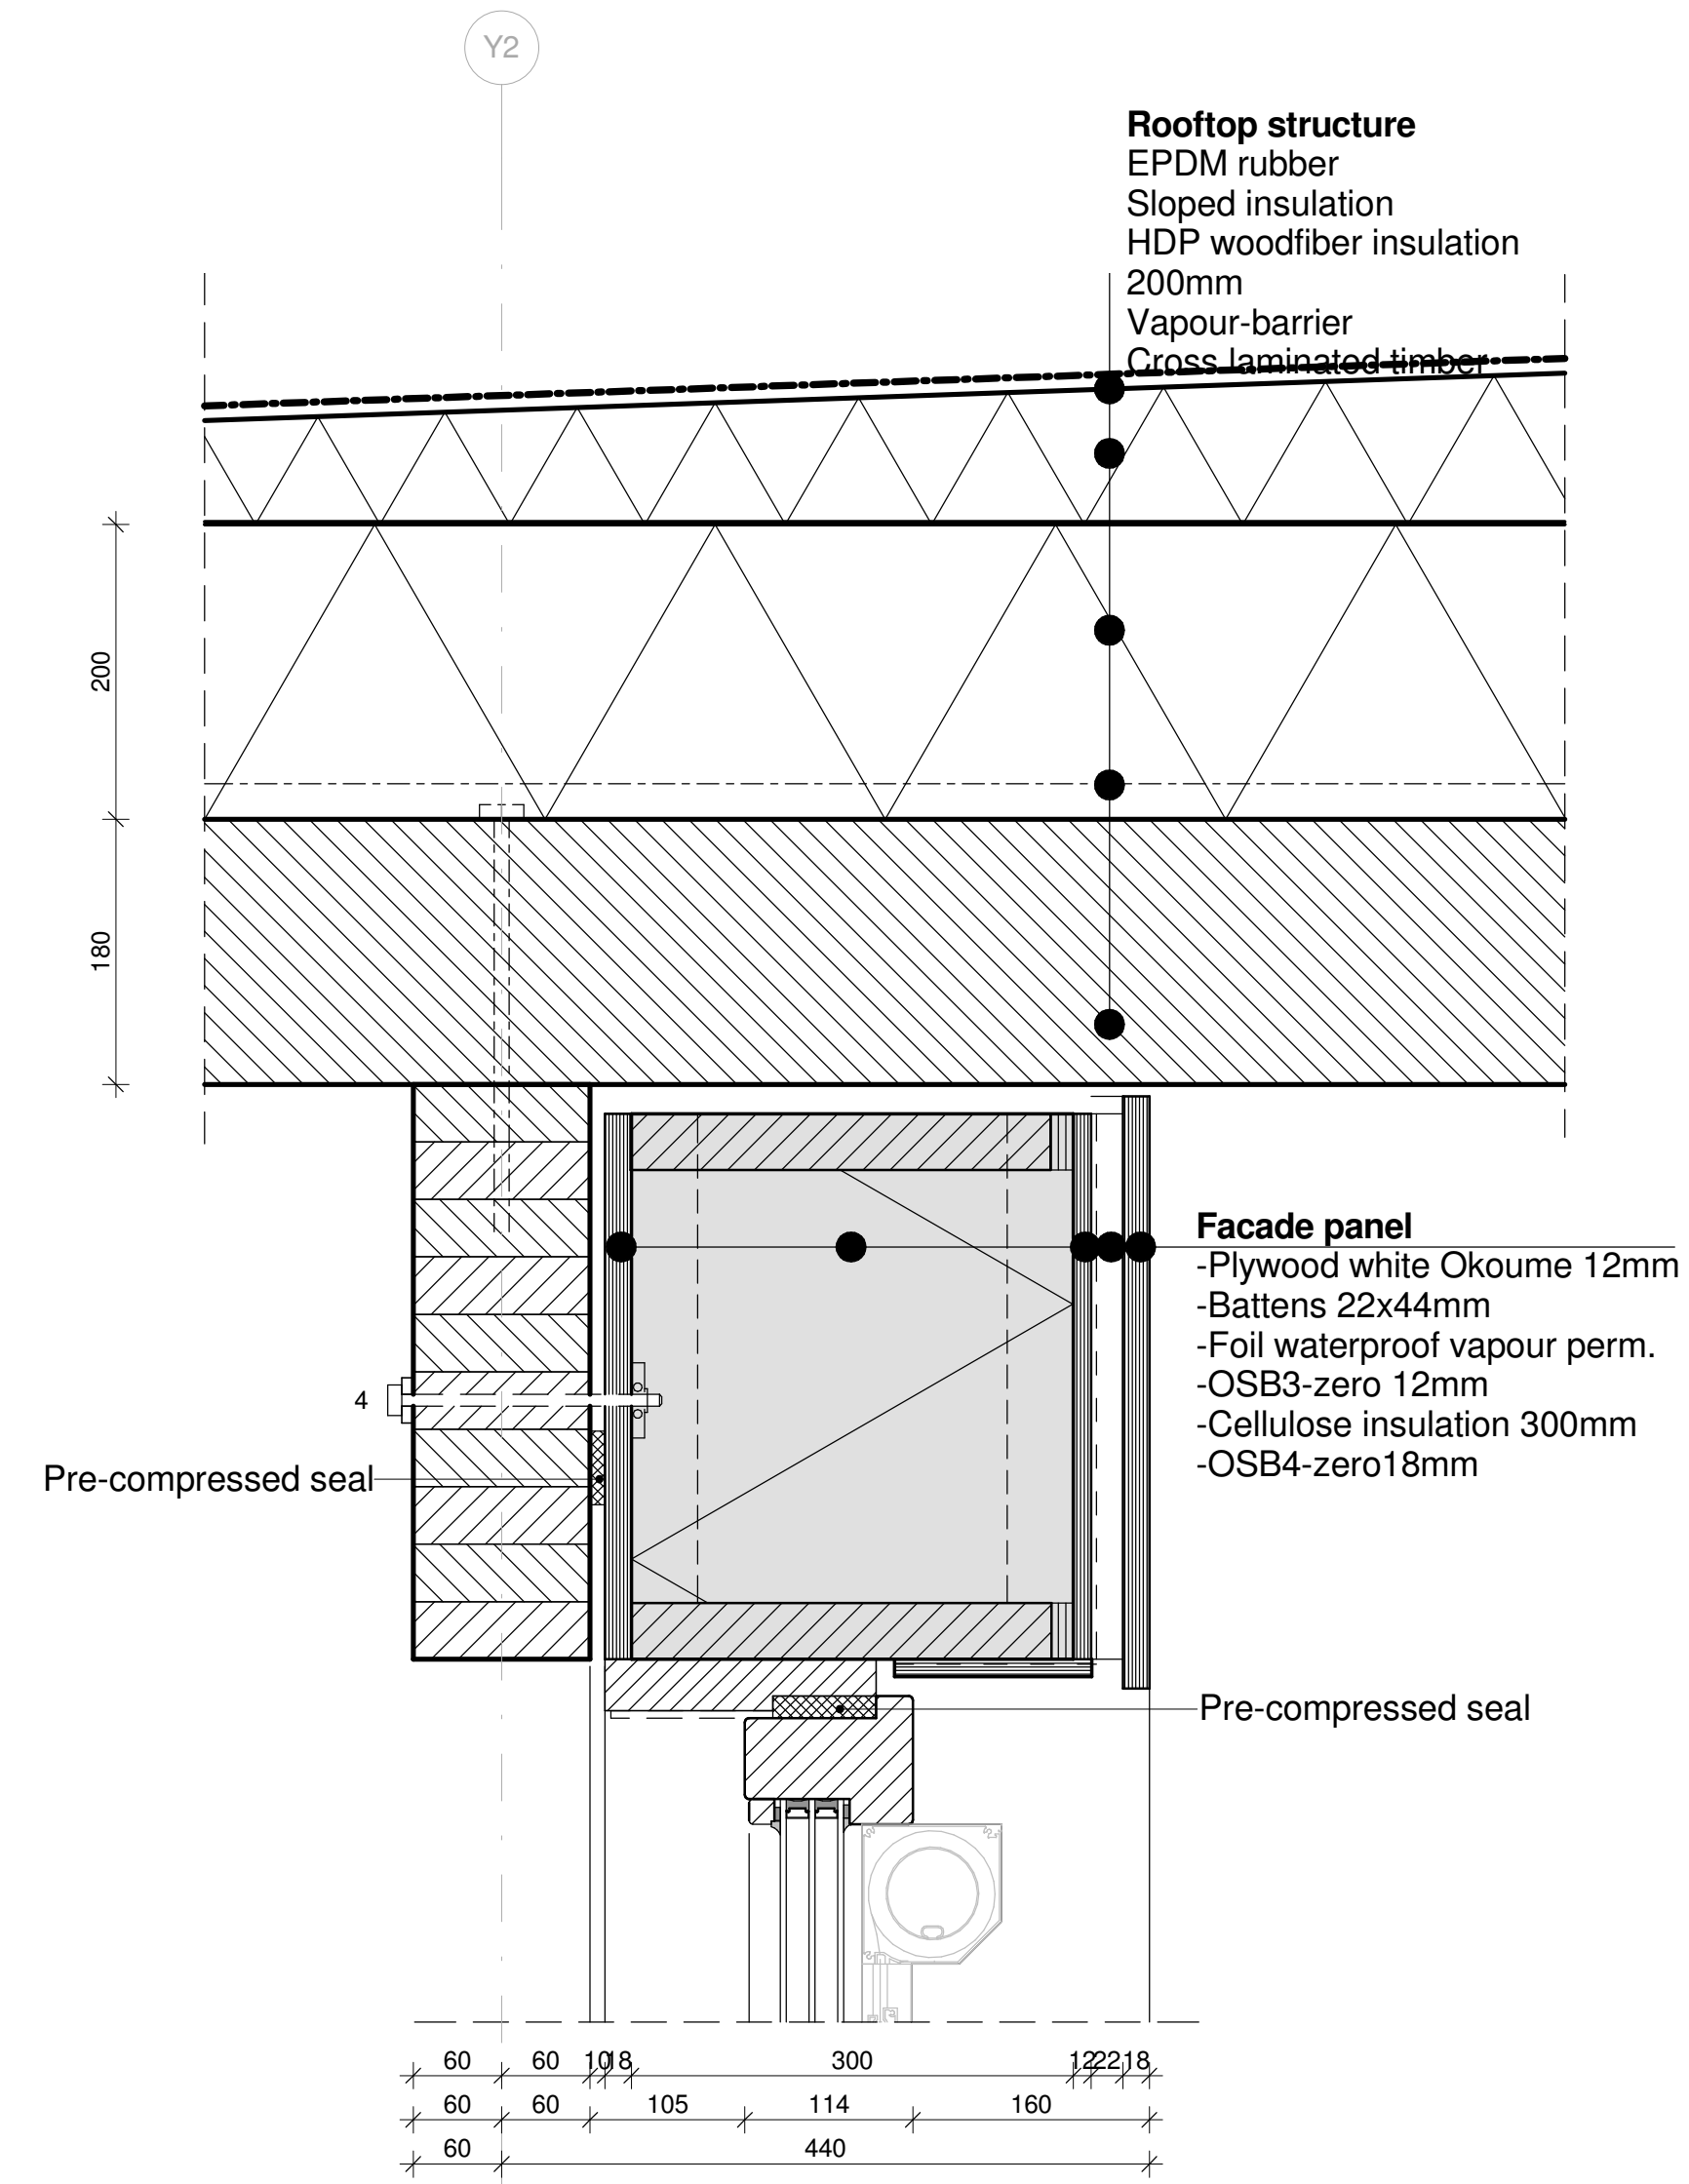
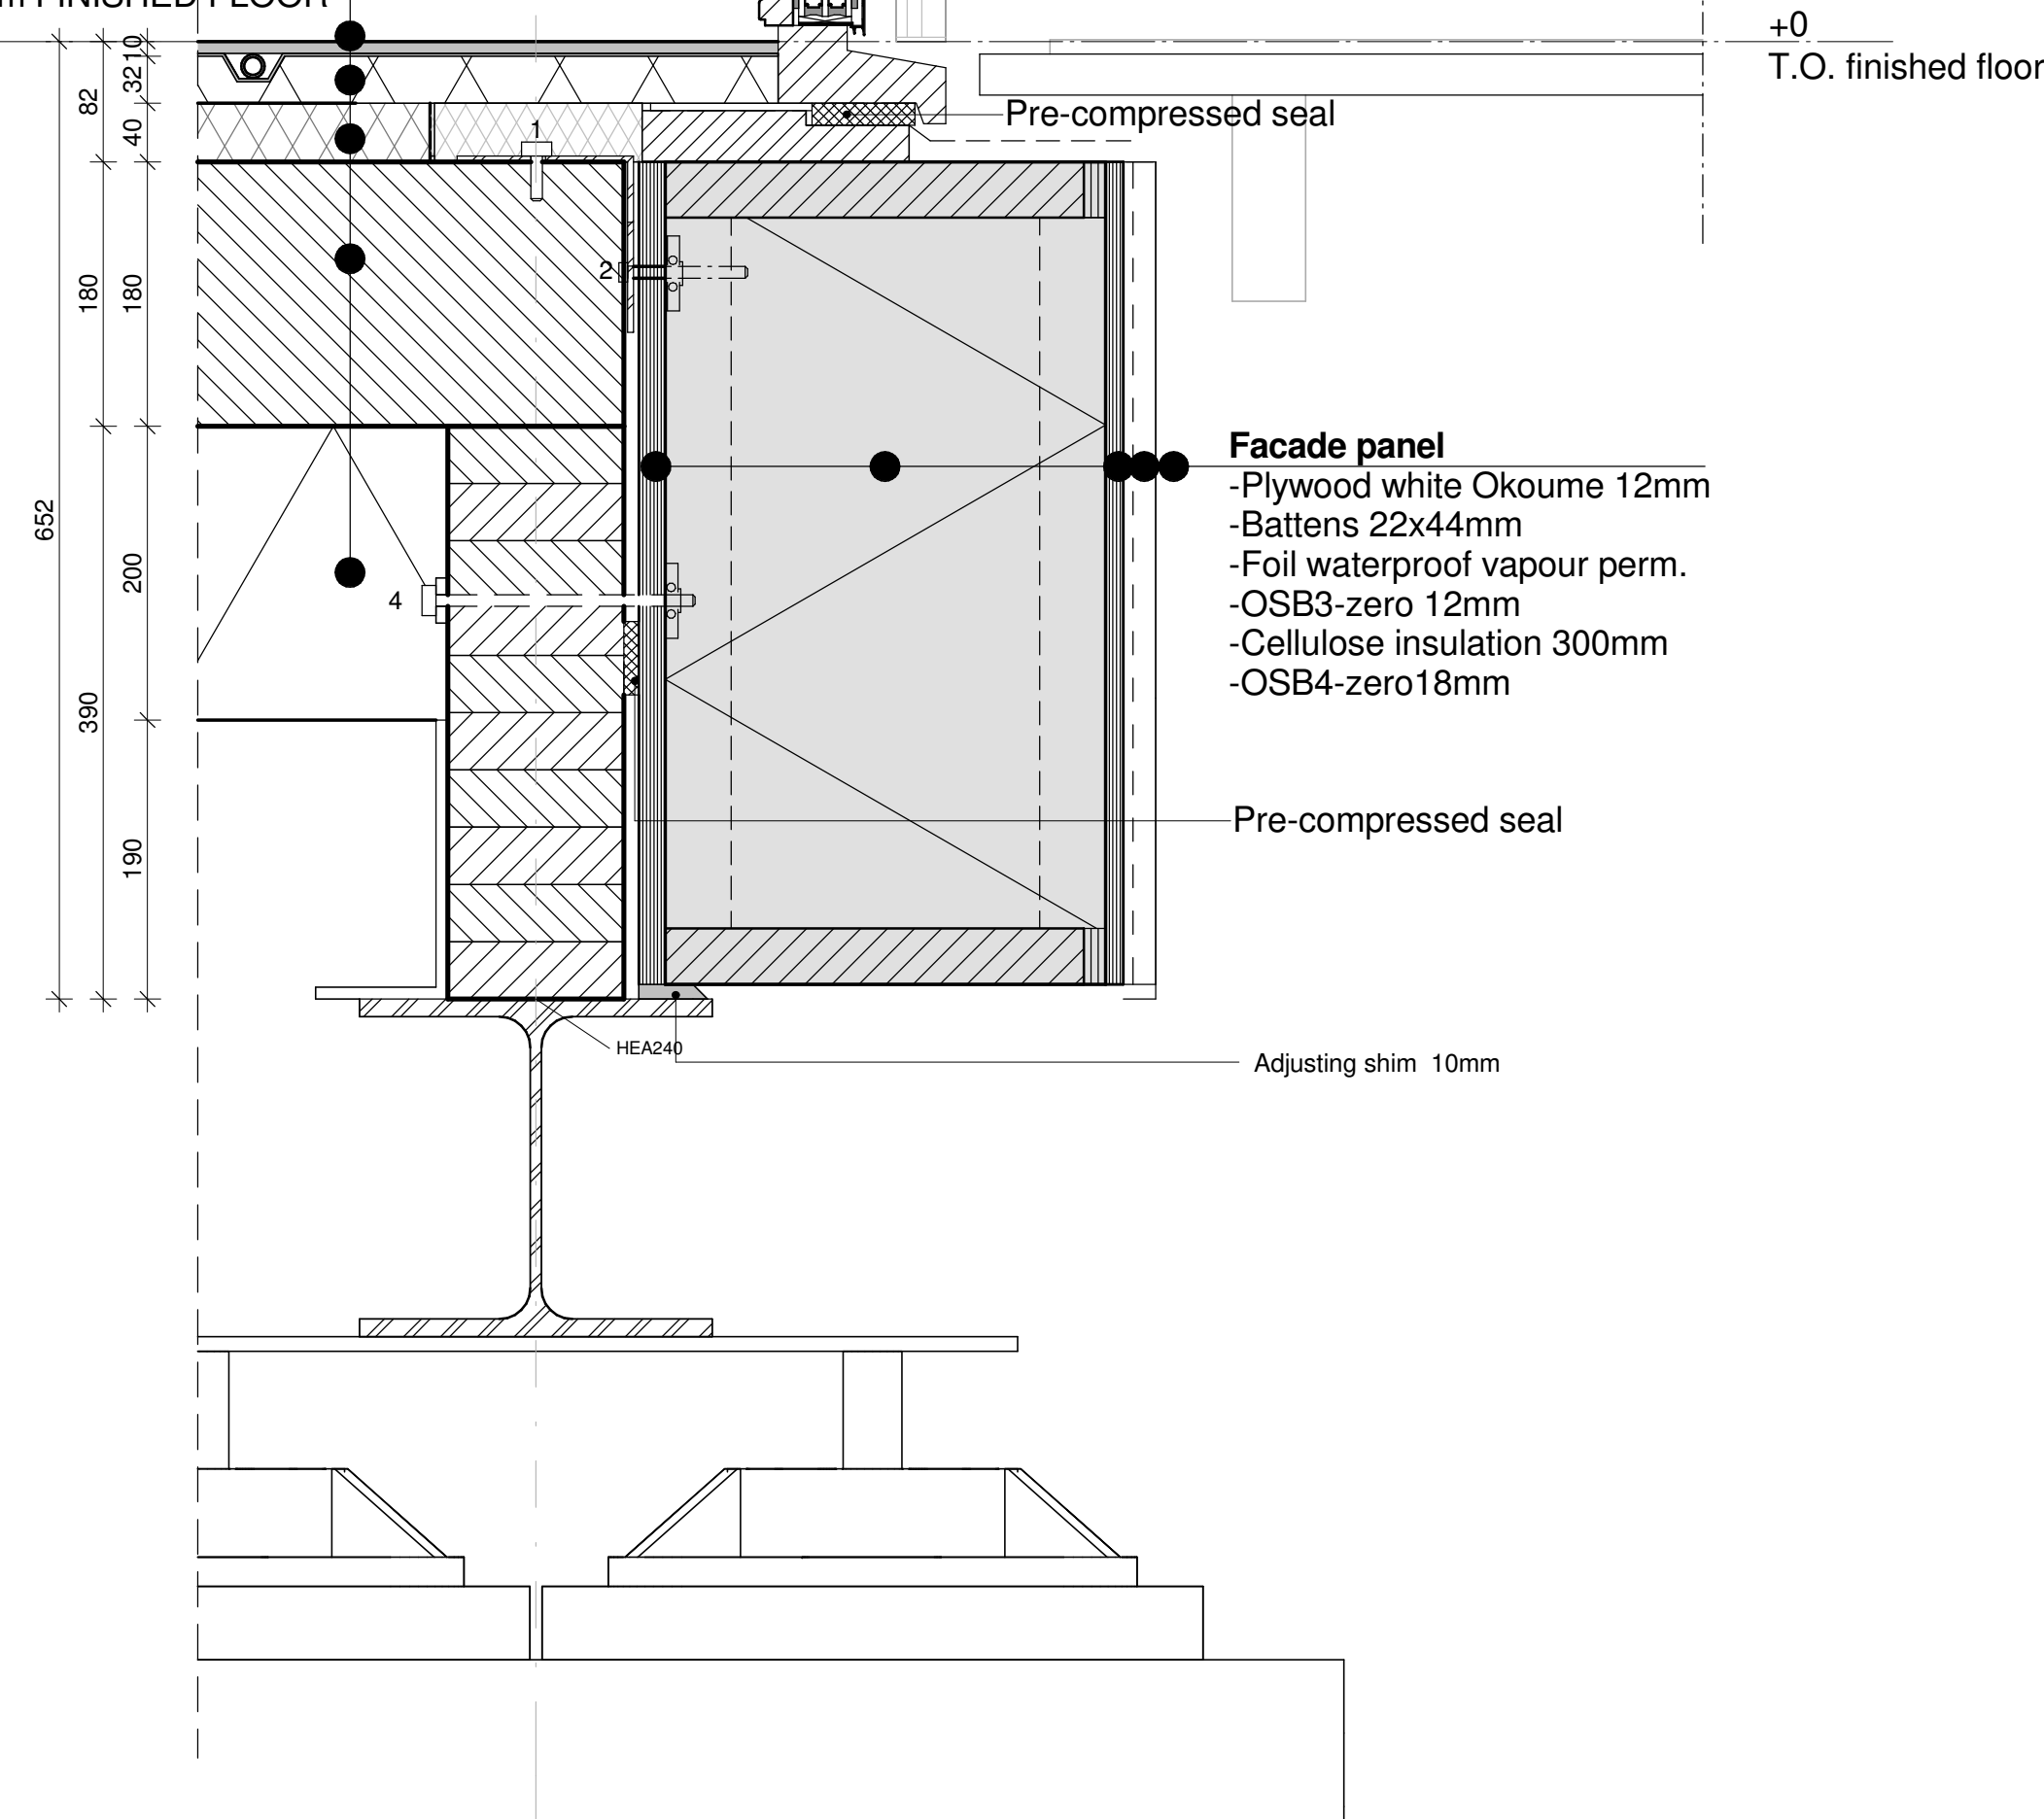


Bolt types

NR.	Description
1	Bolt M8 x 40
2	Bolt M8 x 80
3	Screw thread M8 160mm
4	Bolt M8 x 180

DETAIL V07
 1 : 5



DETAIL V08
 1 : 5

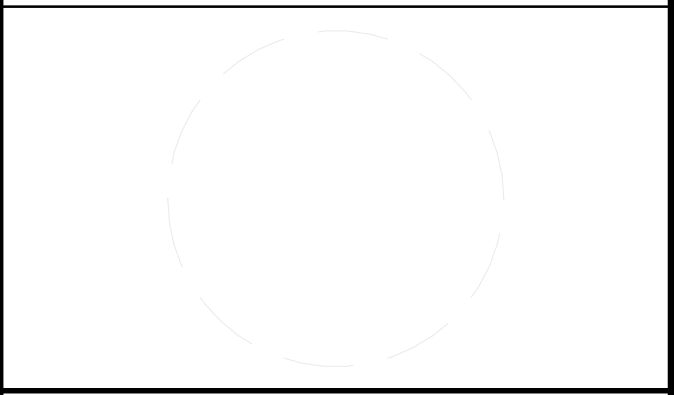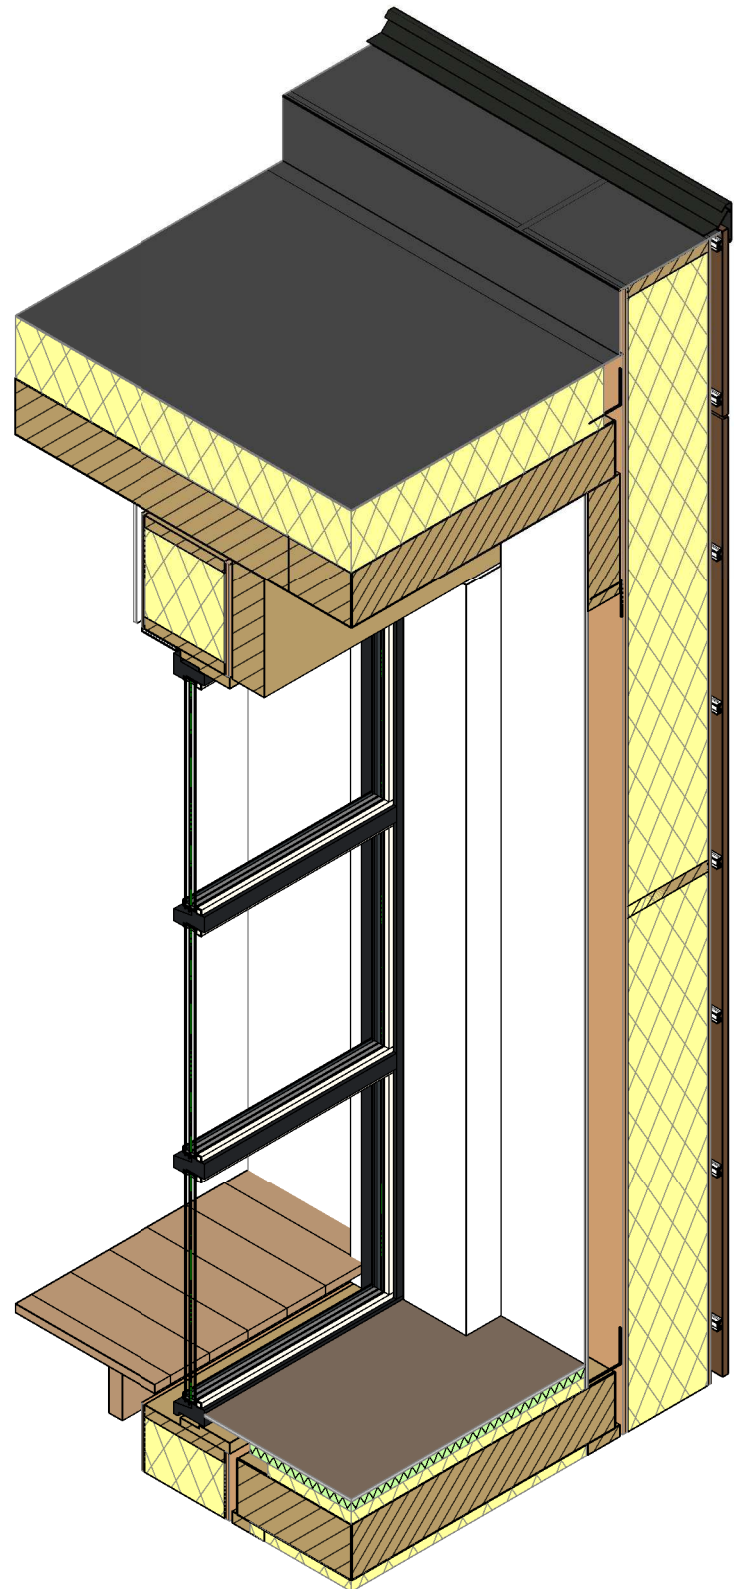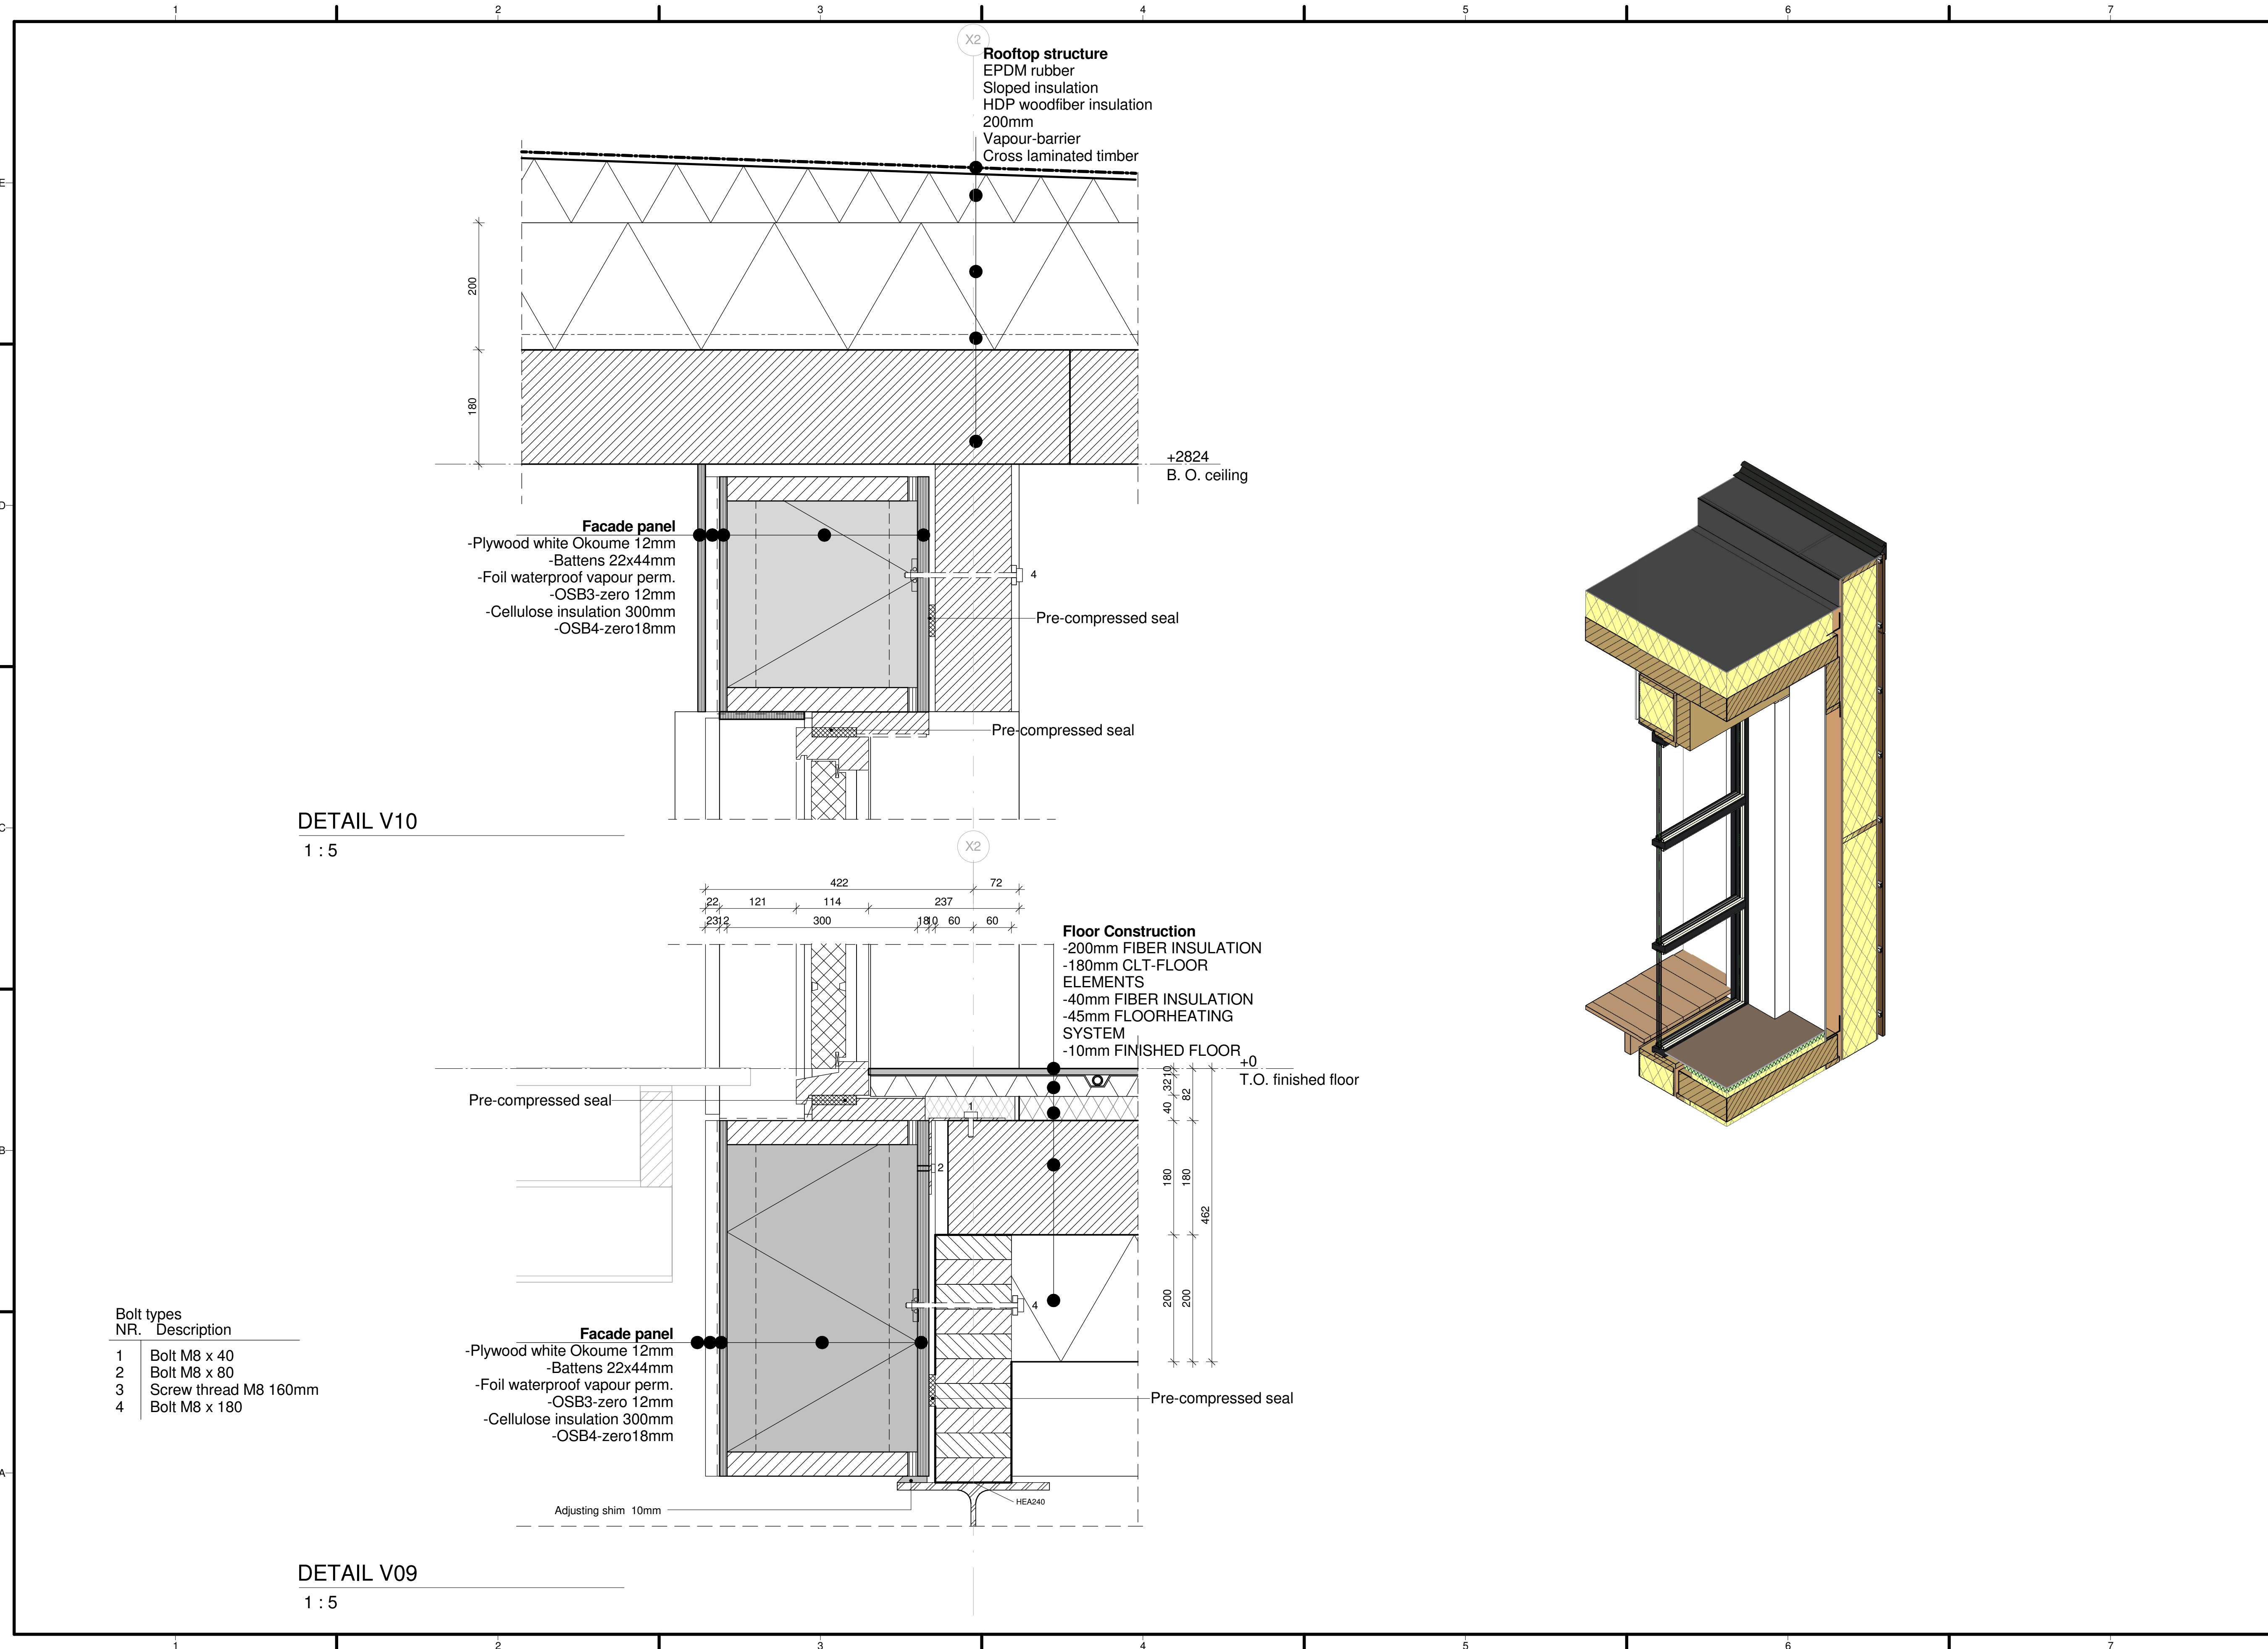

MARK	DATE	DESCRIPTION
0	17-11-2016	90% revision

LOT NUMBER: 106
 DRAWN BY: SELFICIENT
 CHECKED BY: Selficient
 COPYRIGHT: NONE; PROJECT IS PUBLIC DOMAIN
 SCALE: 1 : 5

SHEET TITLE
**DETAIL V09-V10 -
 CONNECTION
 DINING/BEDROOM
 WINDOW/DOOR
 A-456**

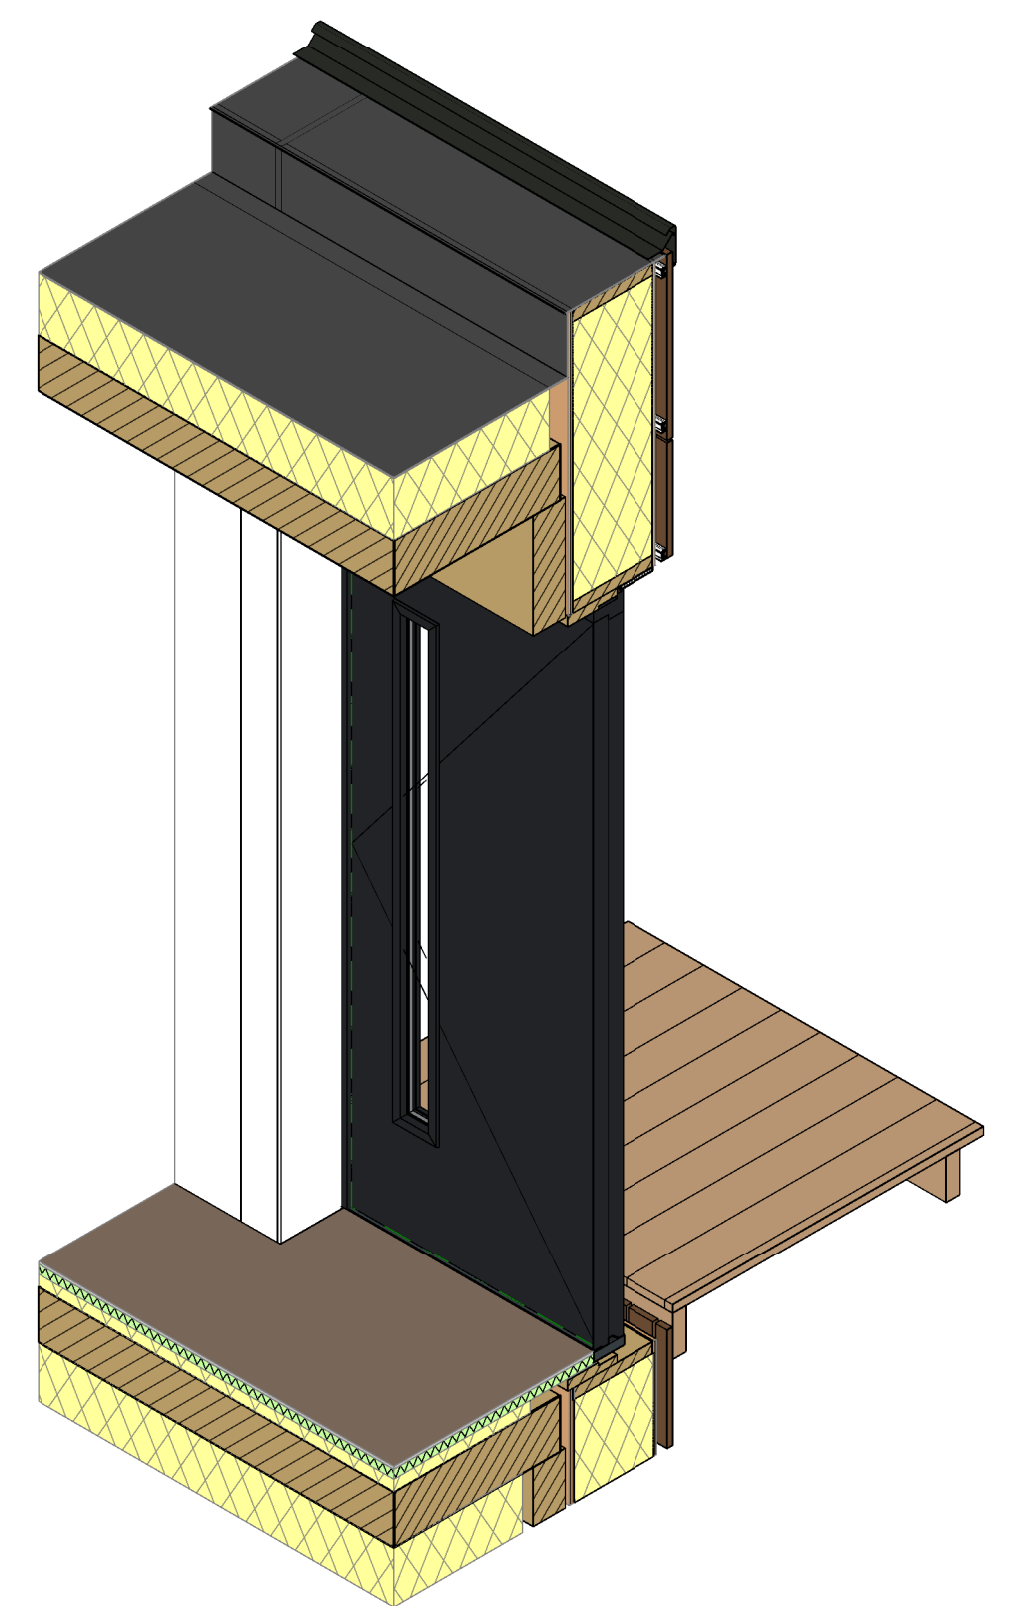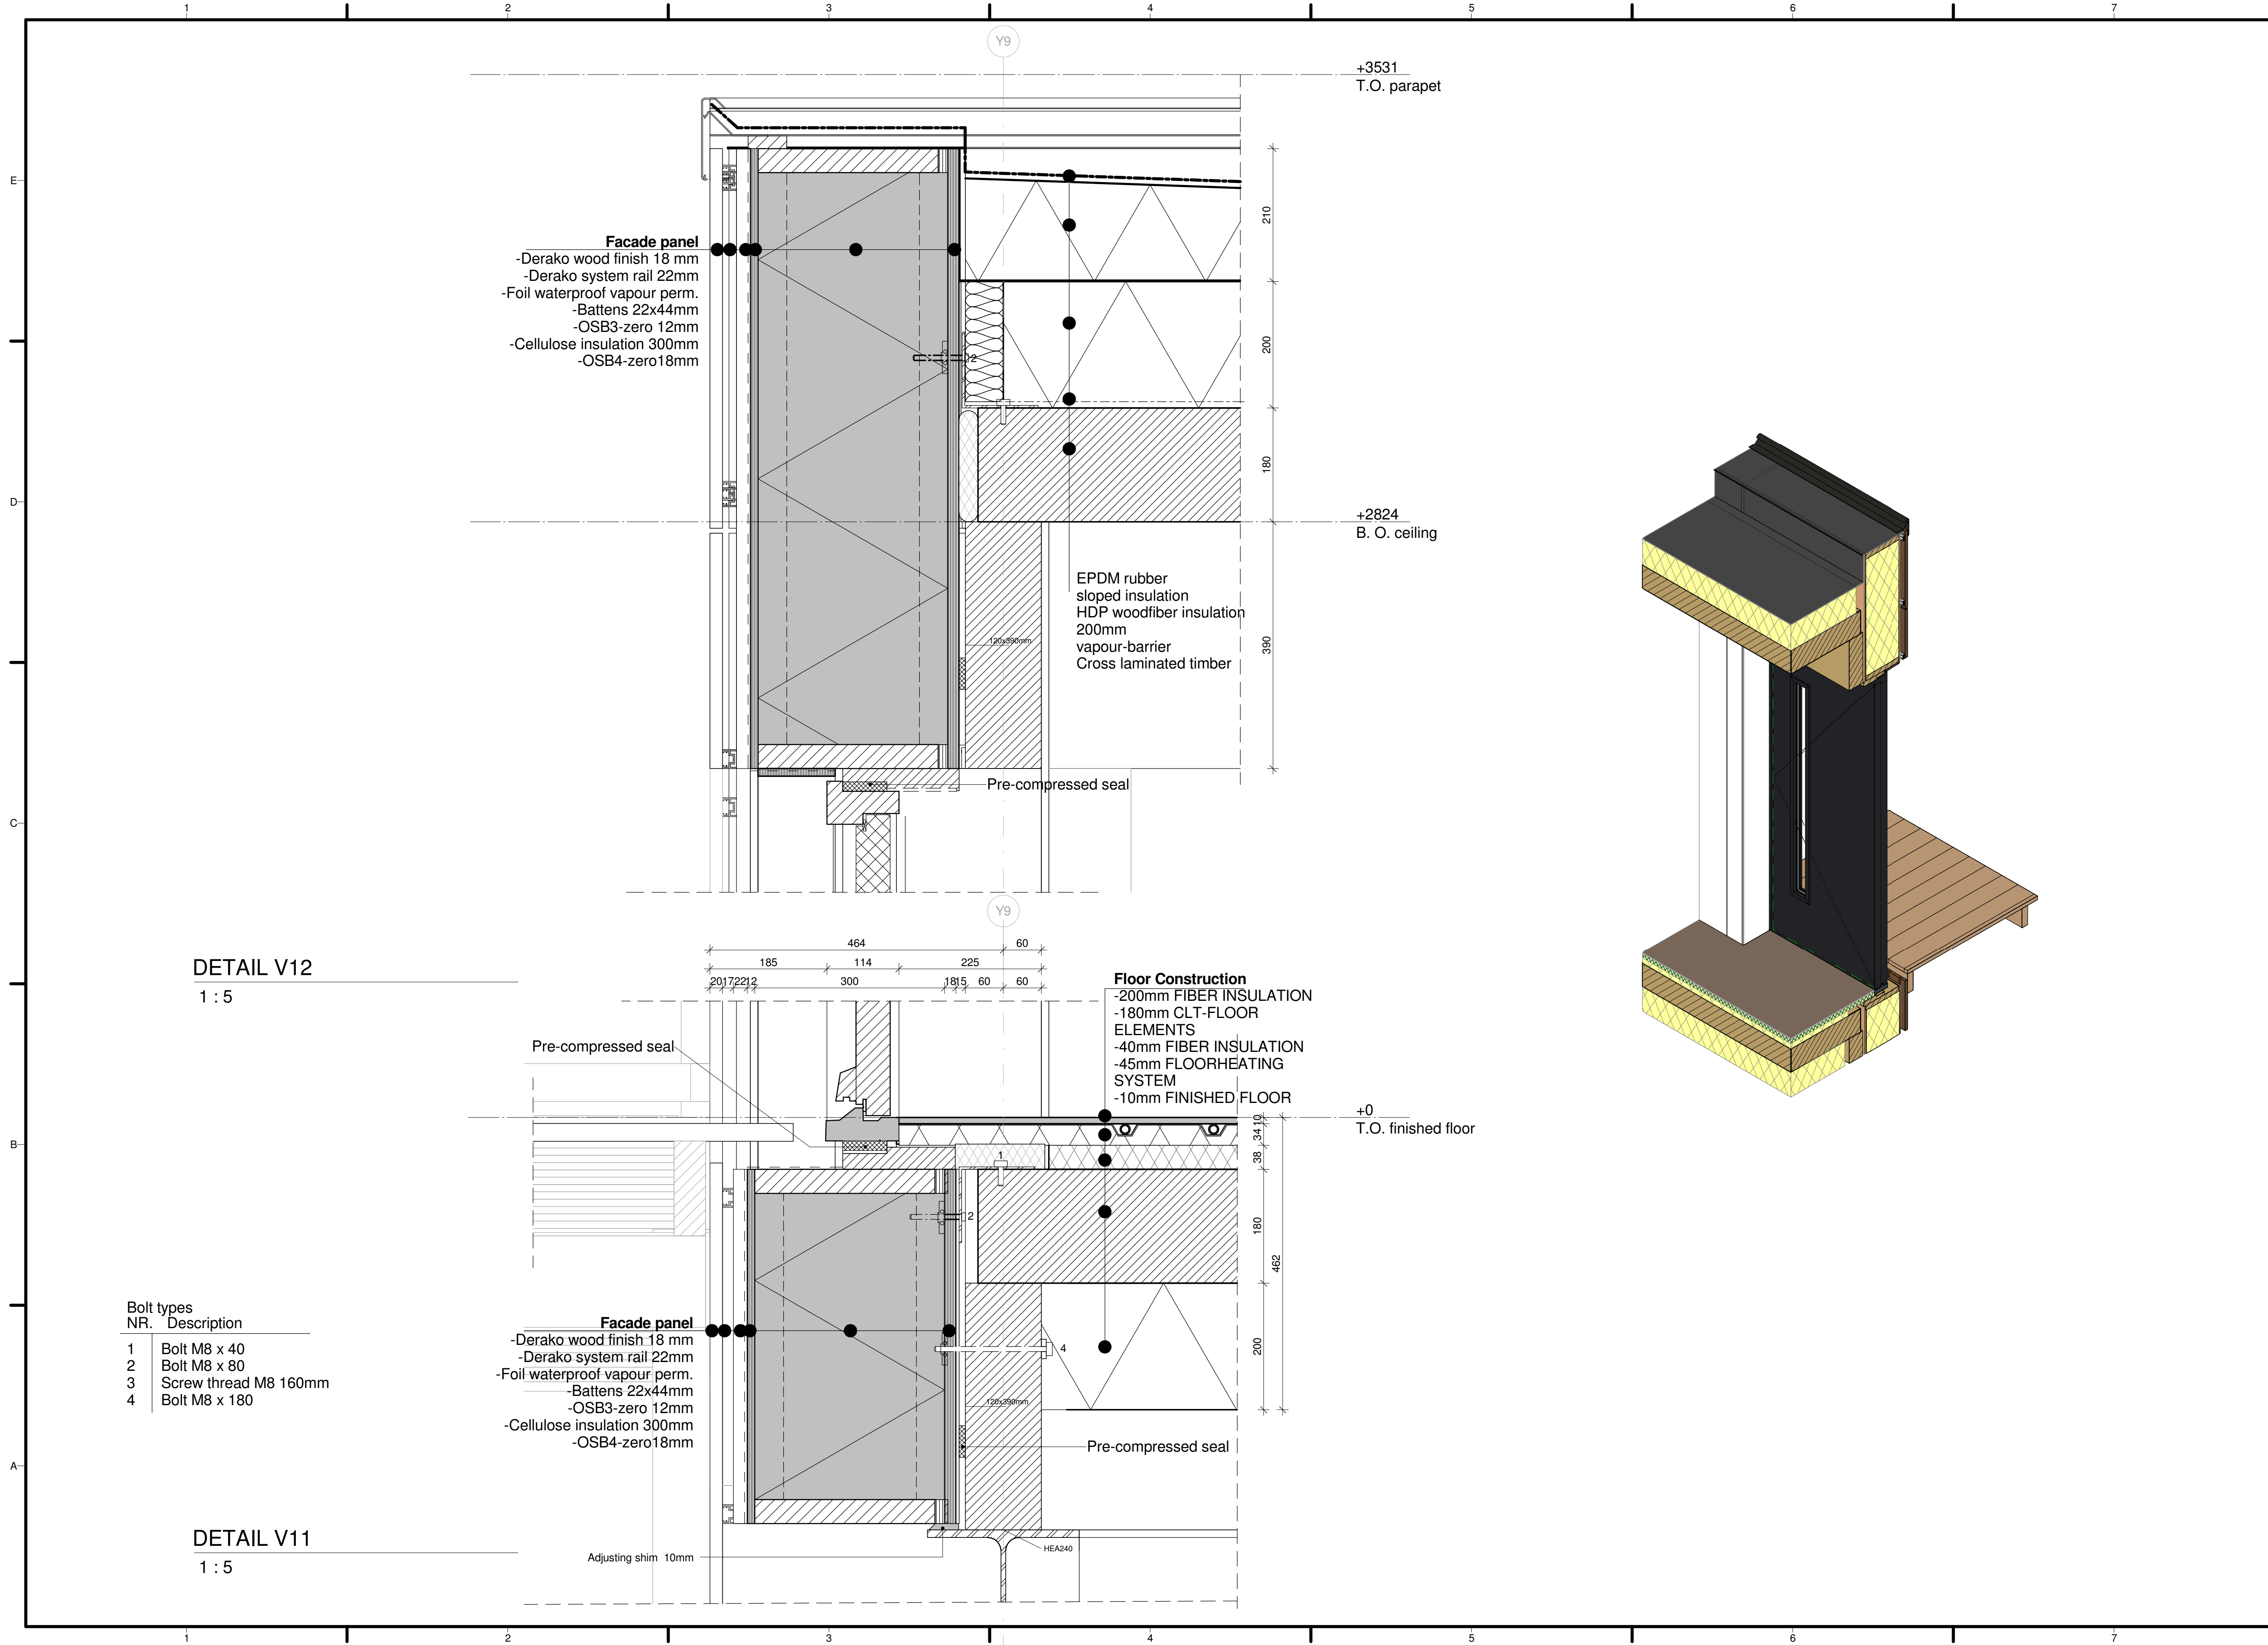

TEAM NAME: Selficient
ADDRESS: Padualaan 99
3584 CH Utrecht
CONTACT: info@selficient.org
www.selficient.org

CONSULTANTS
ARCHITECTURE
ENGINEERS
LANDSCAPING
SAFETY FIRST CODE CONSULTANTS

CLIENT
U.S. DEPARTMENT OF ENERGY
SOLAR DECATHLON 2017
WWW.SOLARDECATHLON.GOV



0	17-11-2016	90% revision
---	------------	--------------

MARK	DATE	DESCRIPTION
------	------	-------------




LOT NUMBER: 106
DRAWN BY: SELFICIENT
CHECKED BY: Selficient
COPYRIGHT: NONE; PROJECT IS PUBLIC DOMAIN

SCALE: 1 : 5


SHEET TITLE

DETAIL V11-V12 -
CONNECTION FRONT
DOOR

A-457

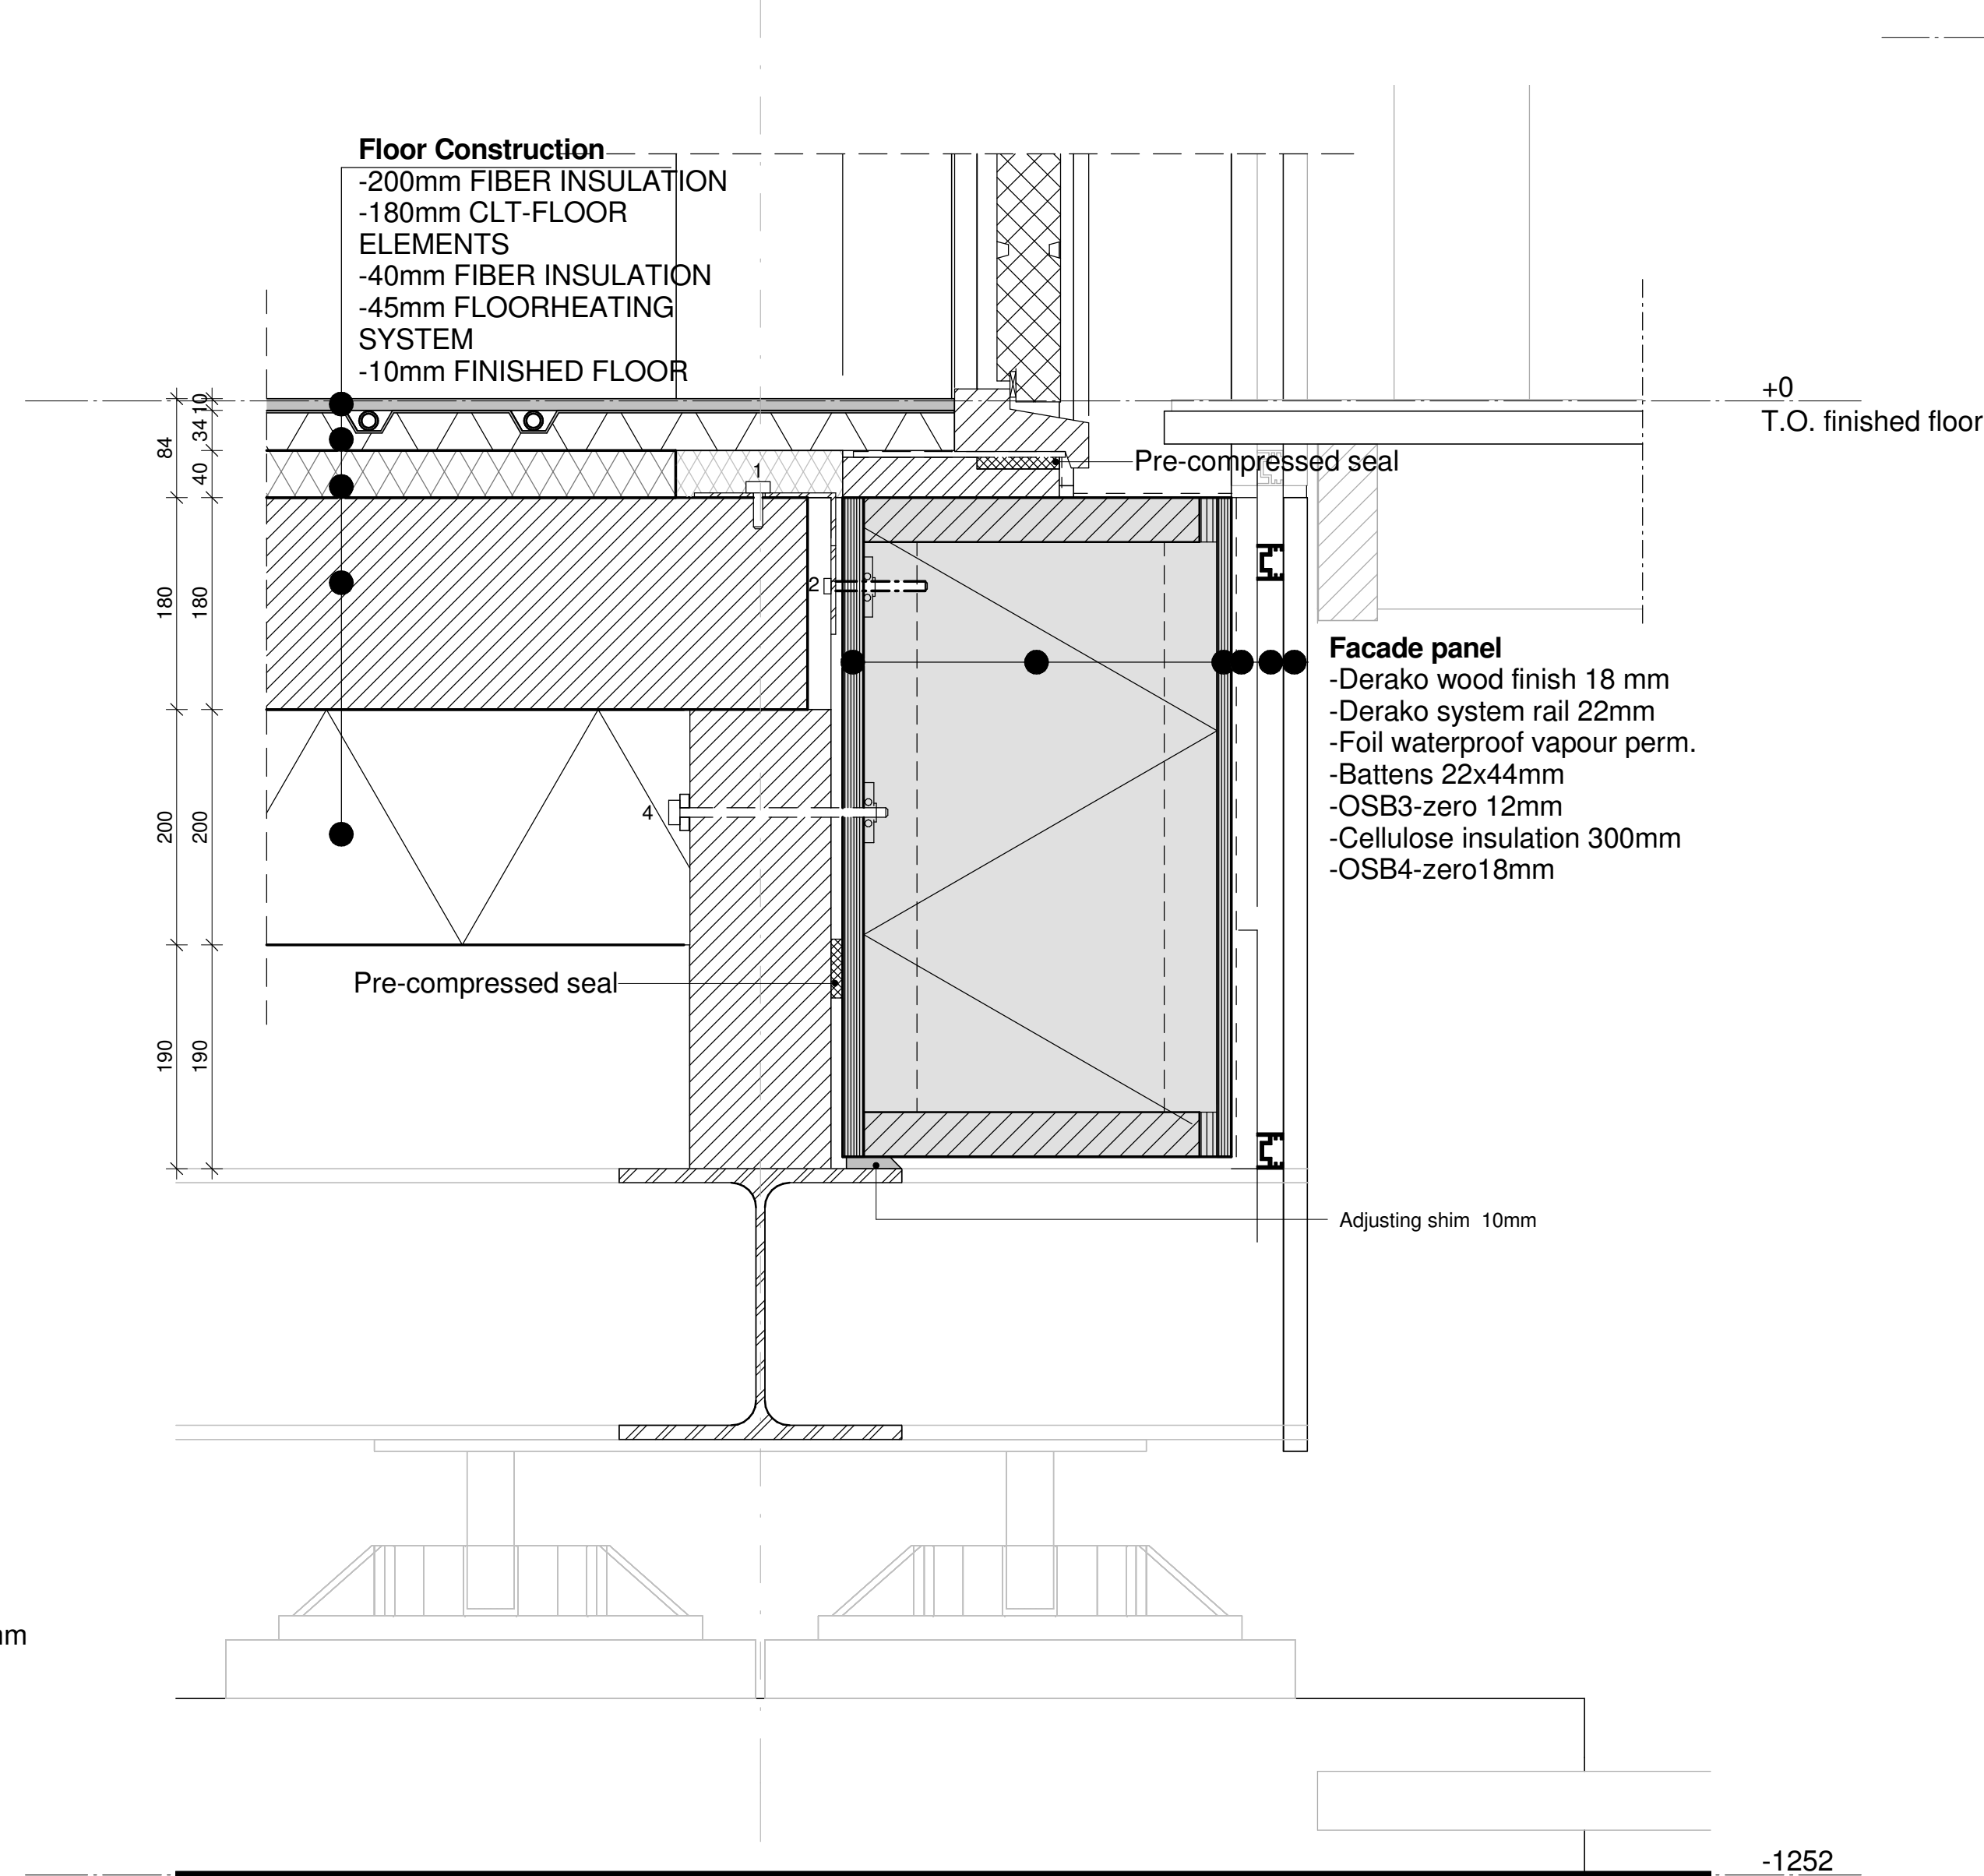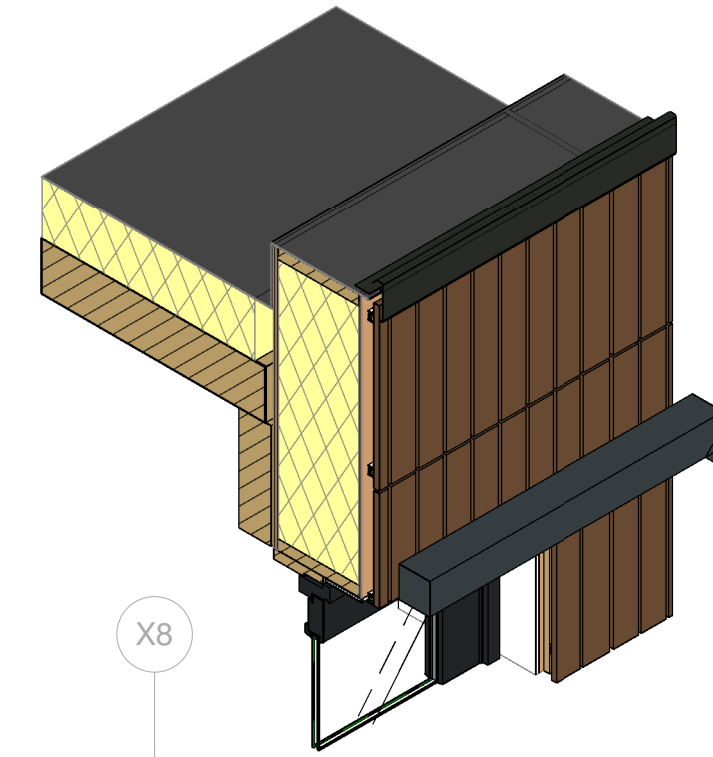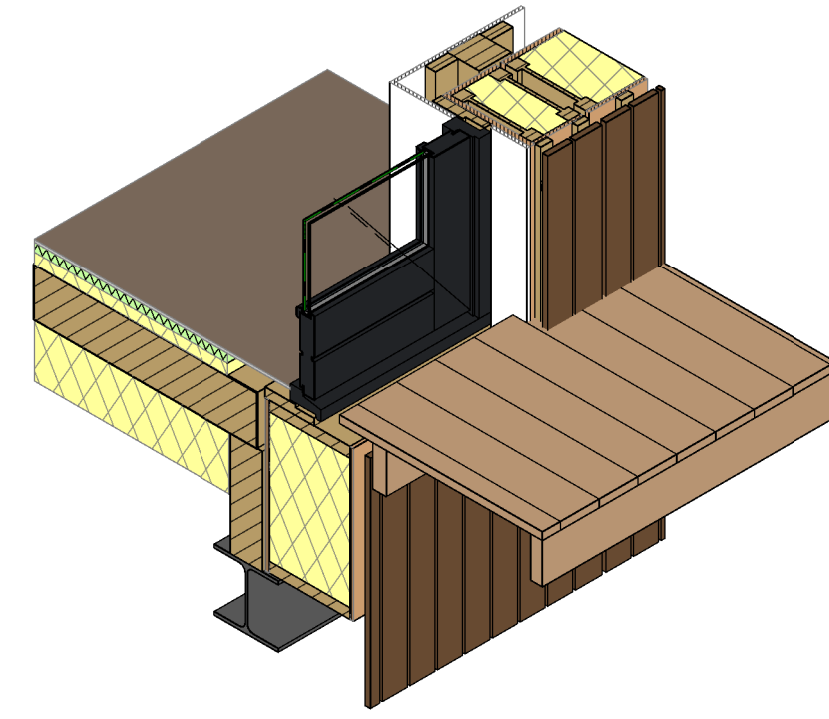

DETAIL V13
 1 : 5

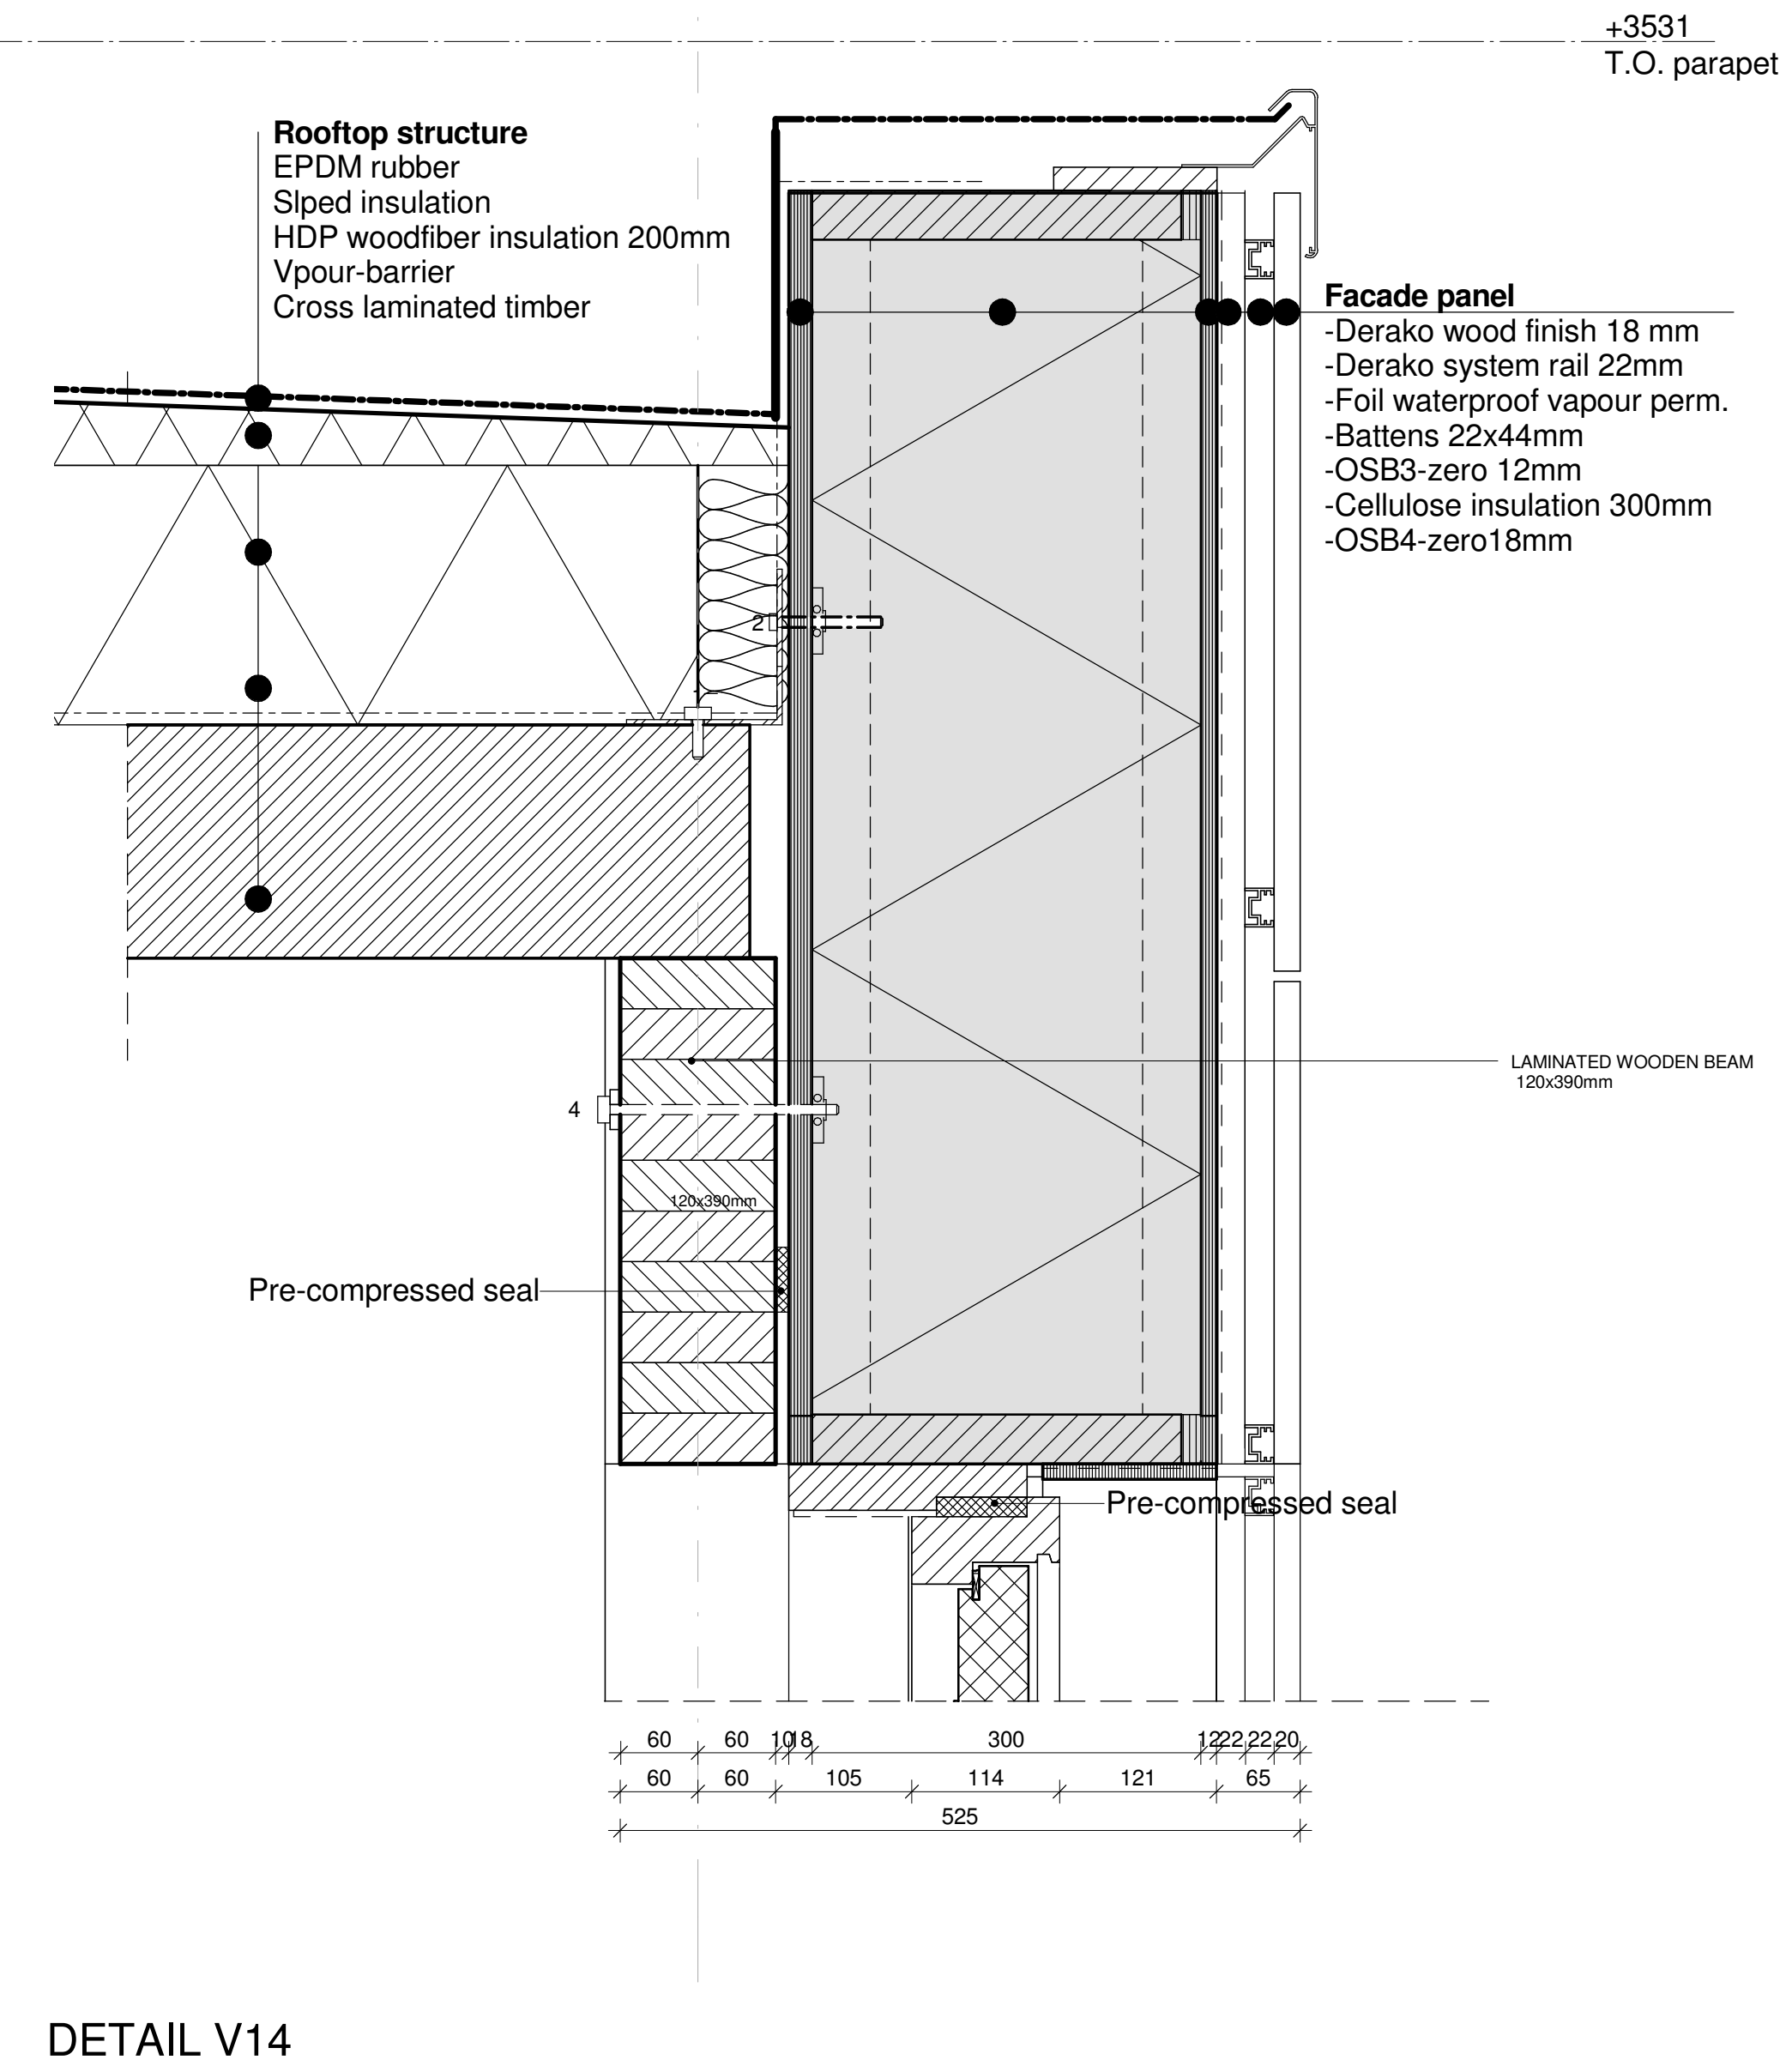


DETAIL V14
 1 : 5

Bolt types

NR.	Description
1	Bolt M8 x 40
2	Bolt M8 x 80
3	Screw thread M8 160mm
4	Bolt M8 x 180

TEAM NAME: Selficient
 ADDRESS: Padualaan 99
 3584 CH Utrecht
 CONTACT: info@selficient.org
 www.selficient.org

CONSULTANTS
 ARCHITECTURE
 ENGINEERS
 LANDSCAPING
 SAFETY FIRST CODE CONSULTANTS

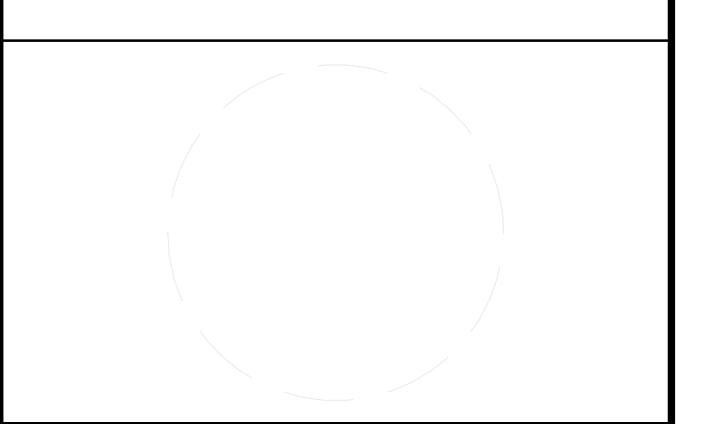

CLIENT
 U.S. DEPARTMENT OF ENERGY
 SOLAR DECATHLON 2017
 WWW.SOLARDECATHLON.GOV



0	17-11-2016	90% revision
---	------------	--------------

MARK	DATE	DESCRIPTION
------	------	-------------



LOT NUMBER: 106
 DRAWN BY: Author
 CHECKED BY: Selficient
 COPYRIGHT: NONE; PROJECT IS PUBLIC DOMAIN


SCALE: 1:5

SHEET TITLE

DETAIL V15 -
 CONNECTION
 INTERIOR WALL/DOOR


A-459

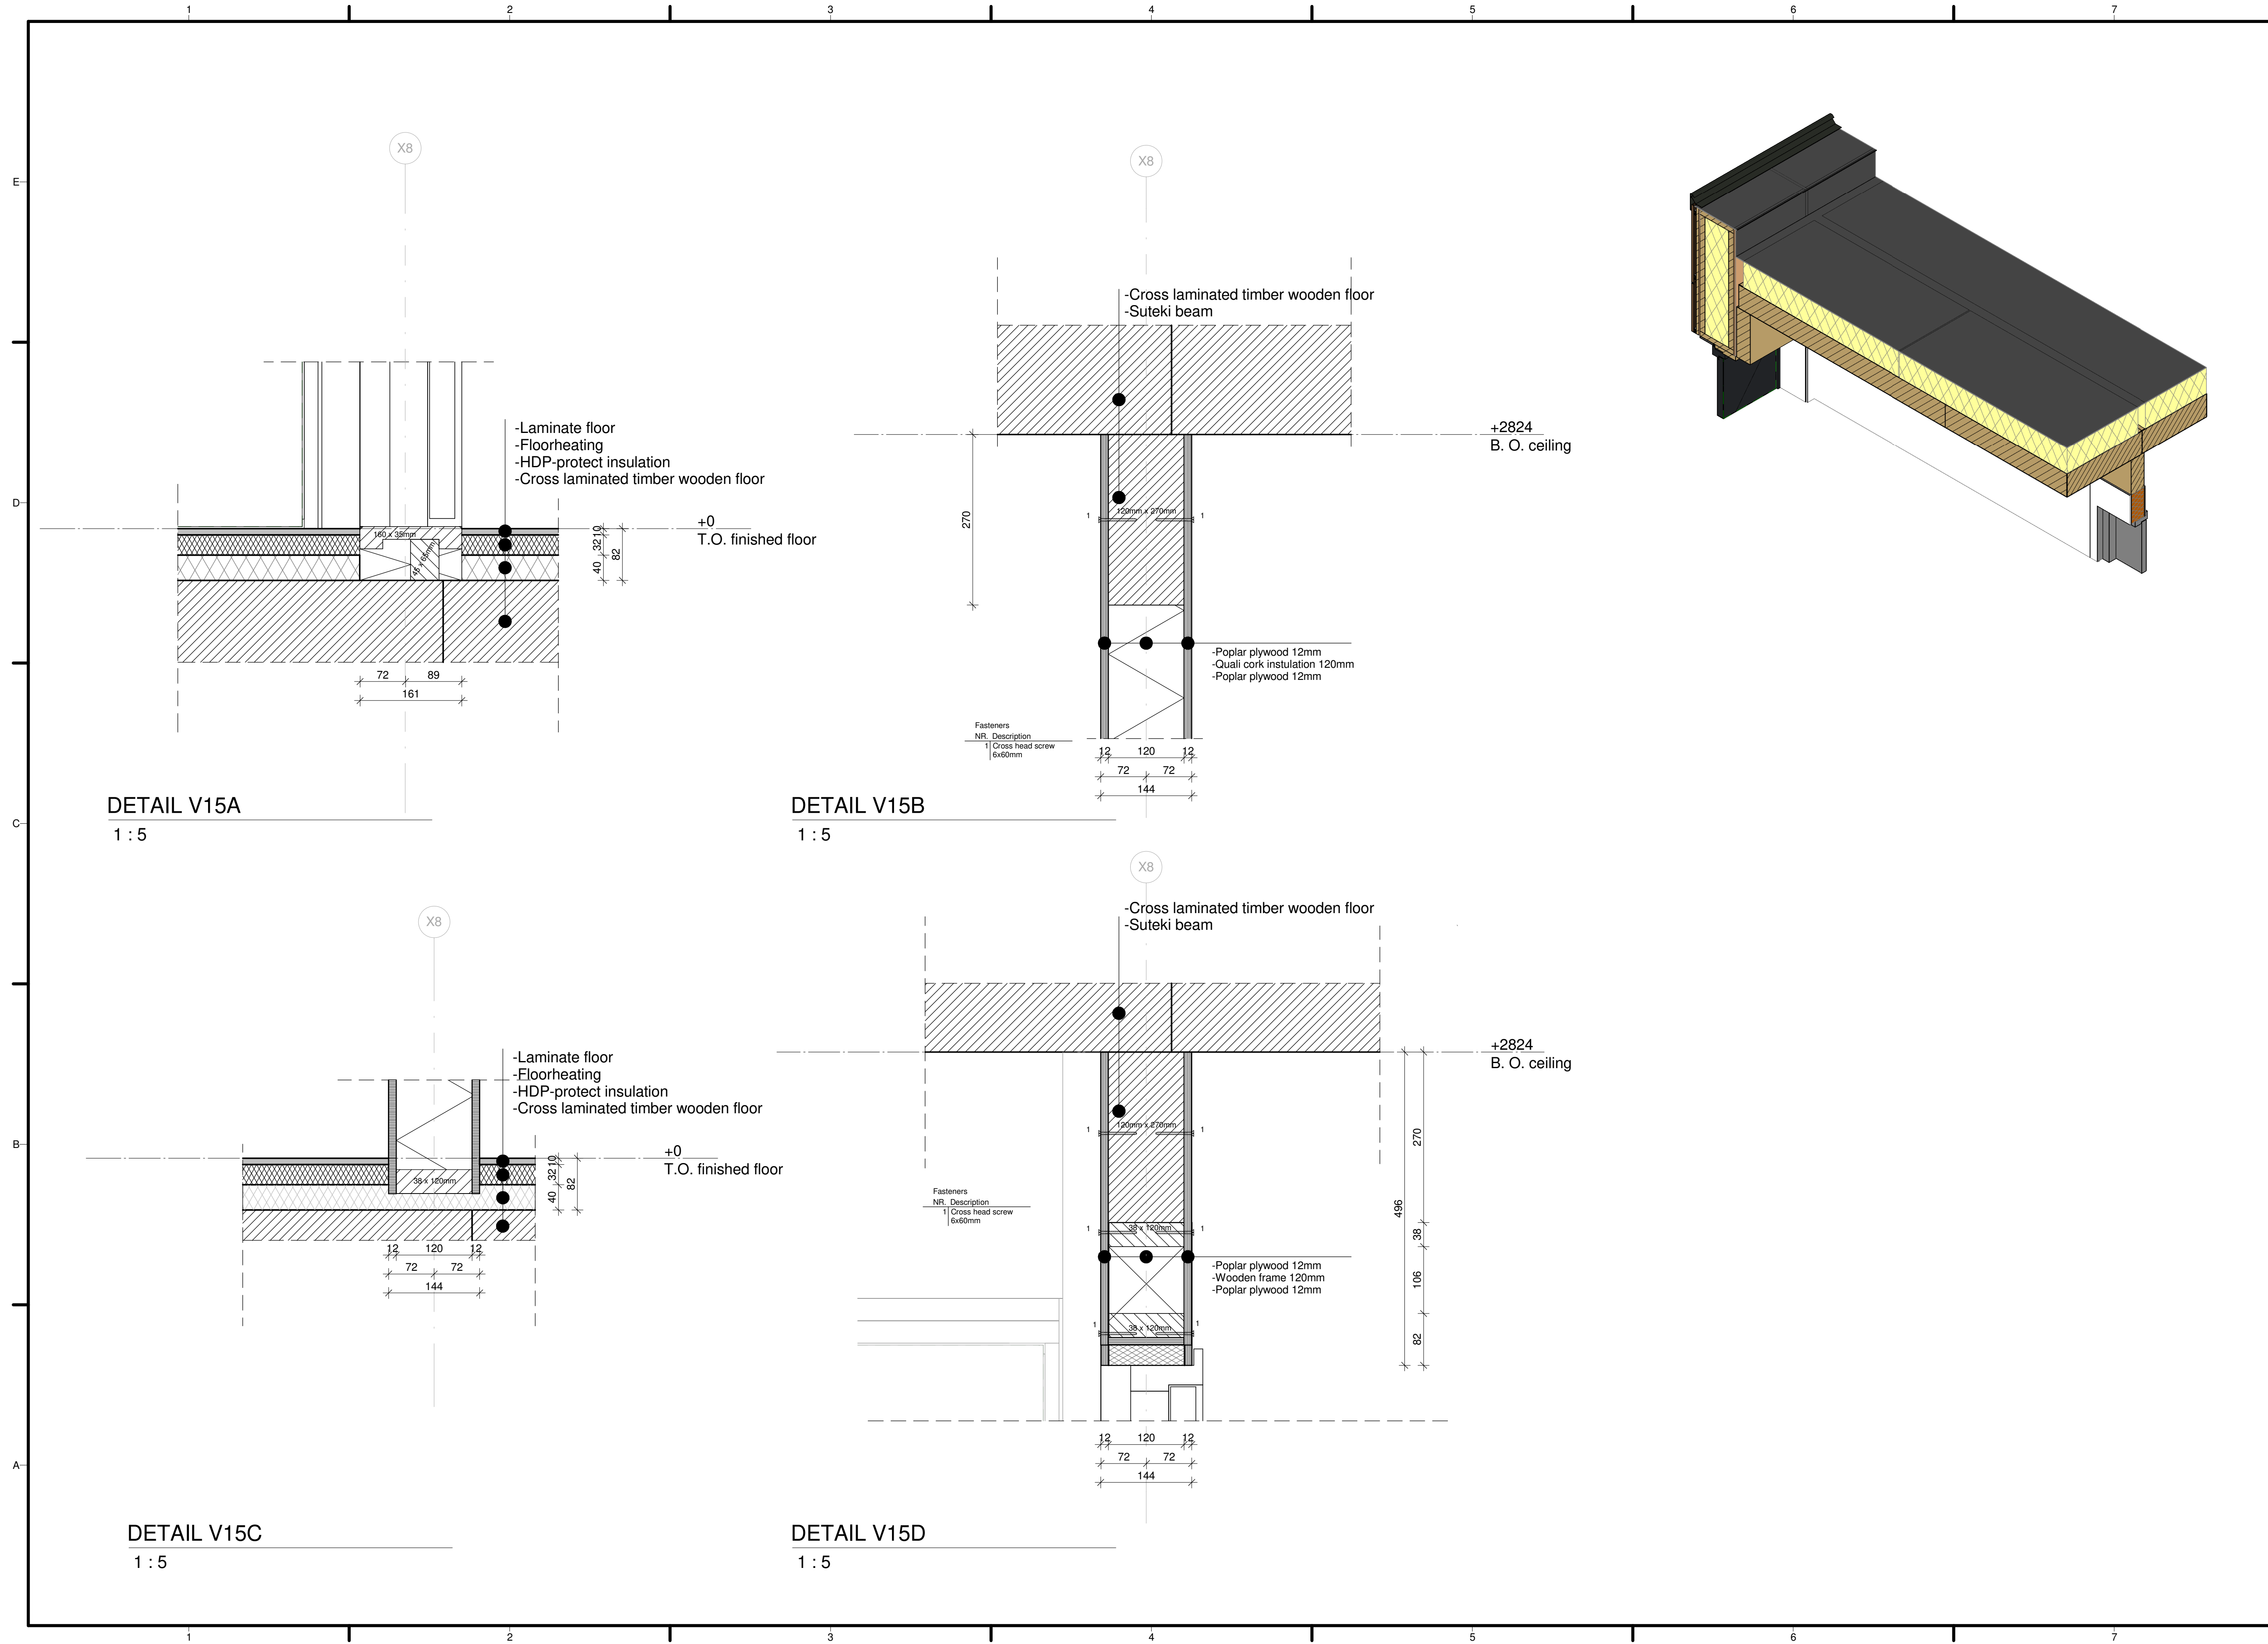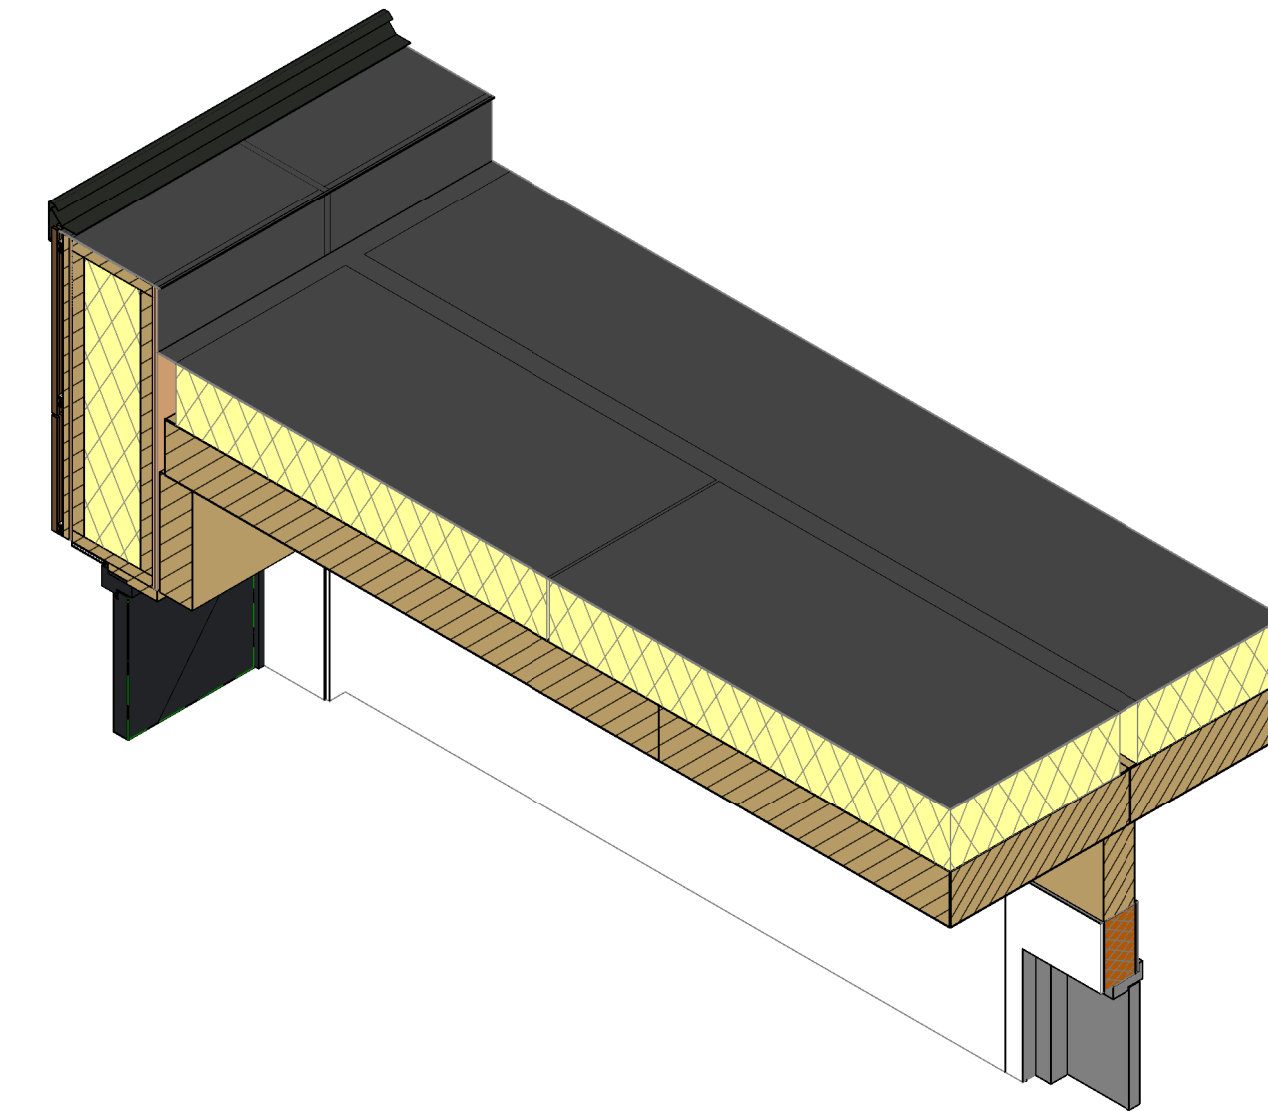

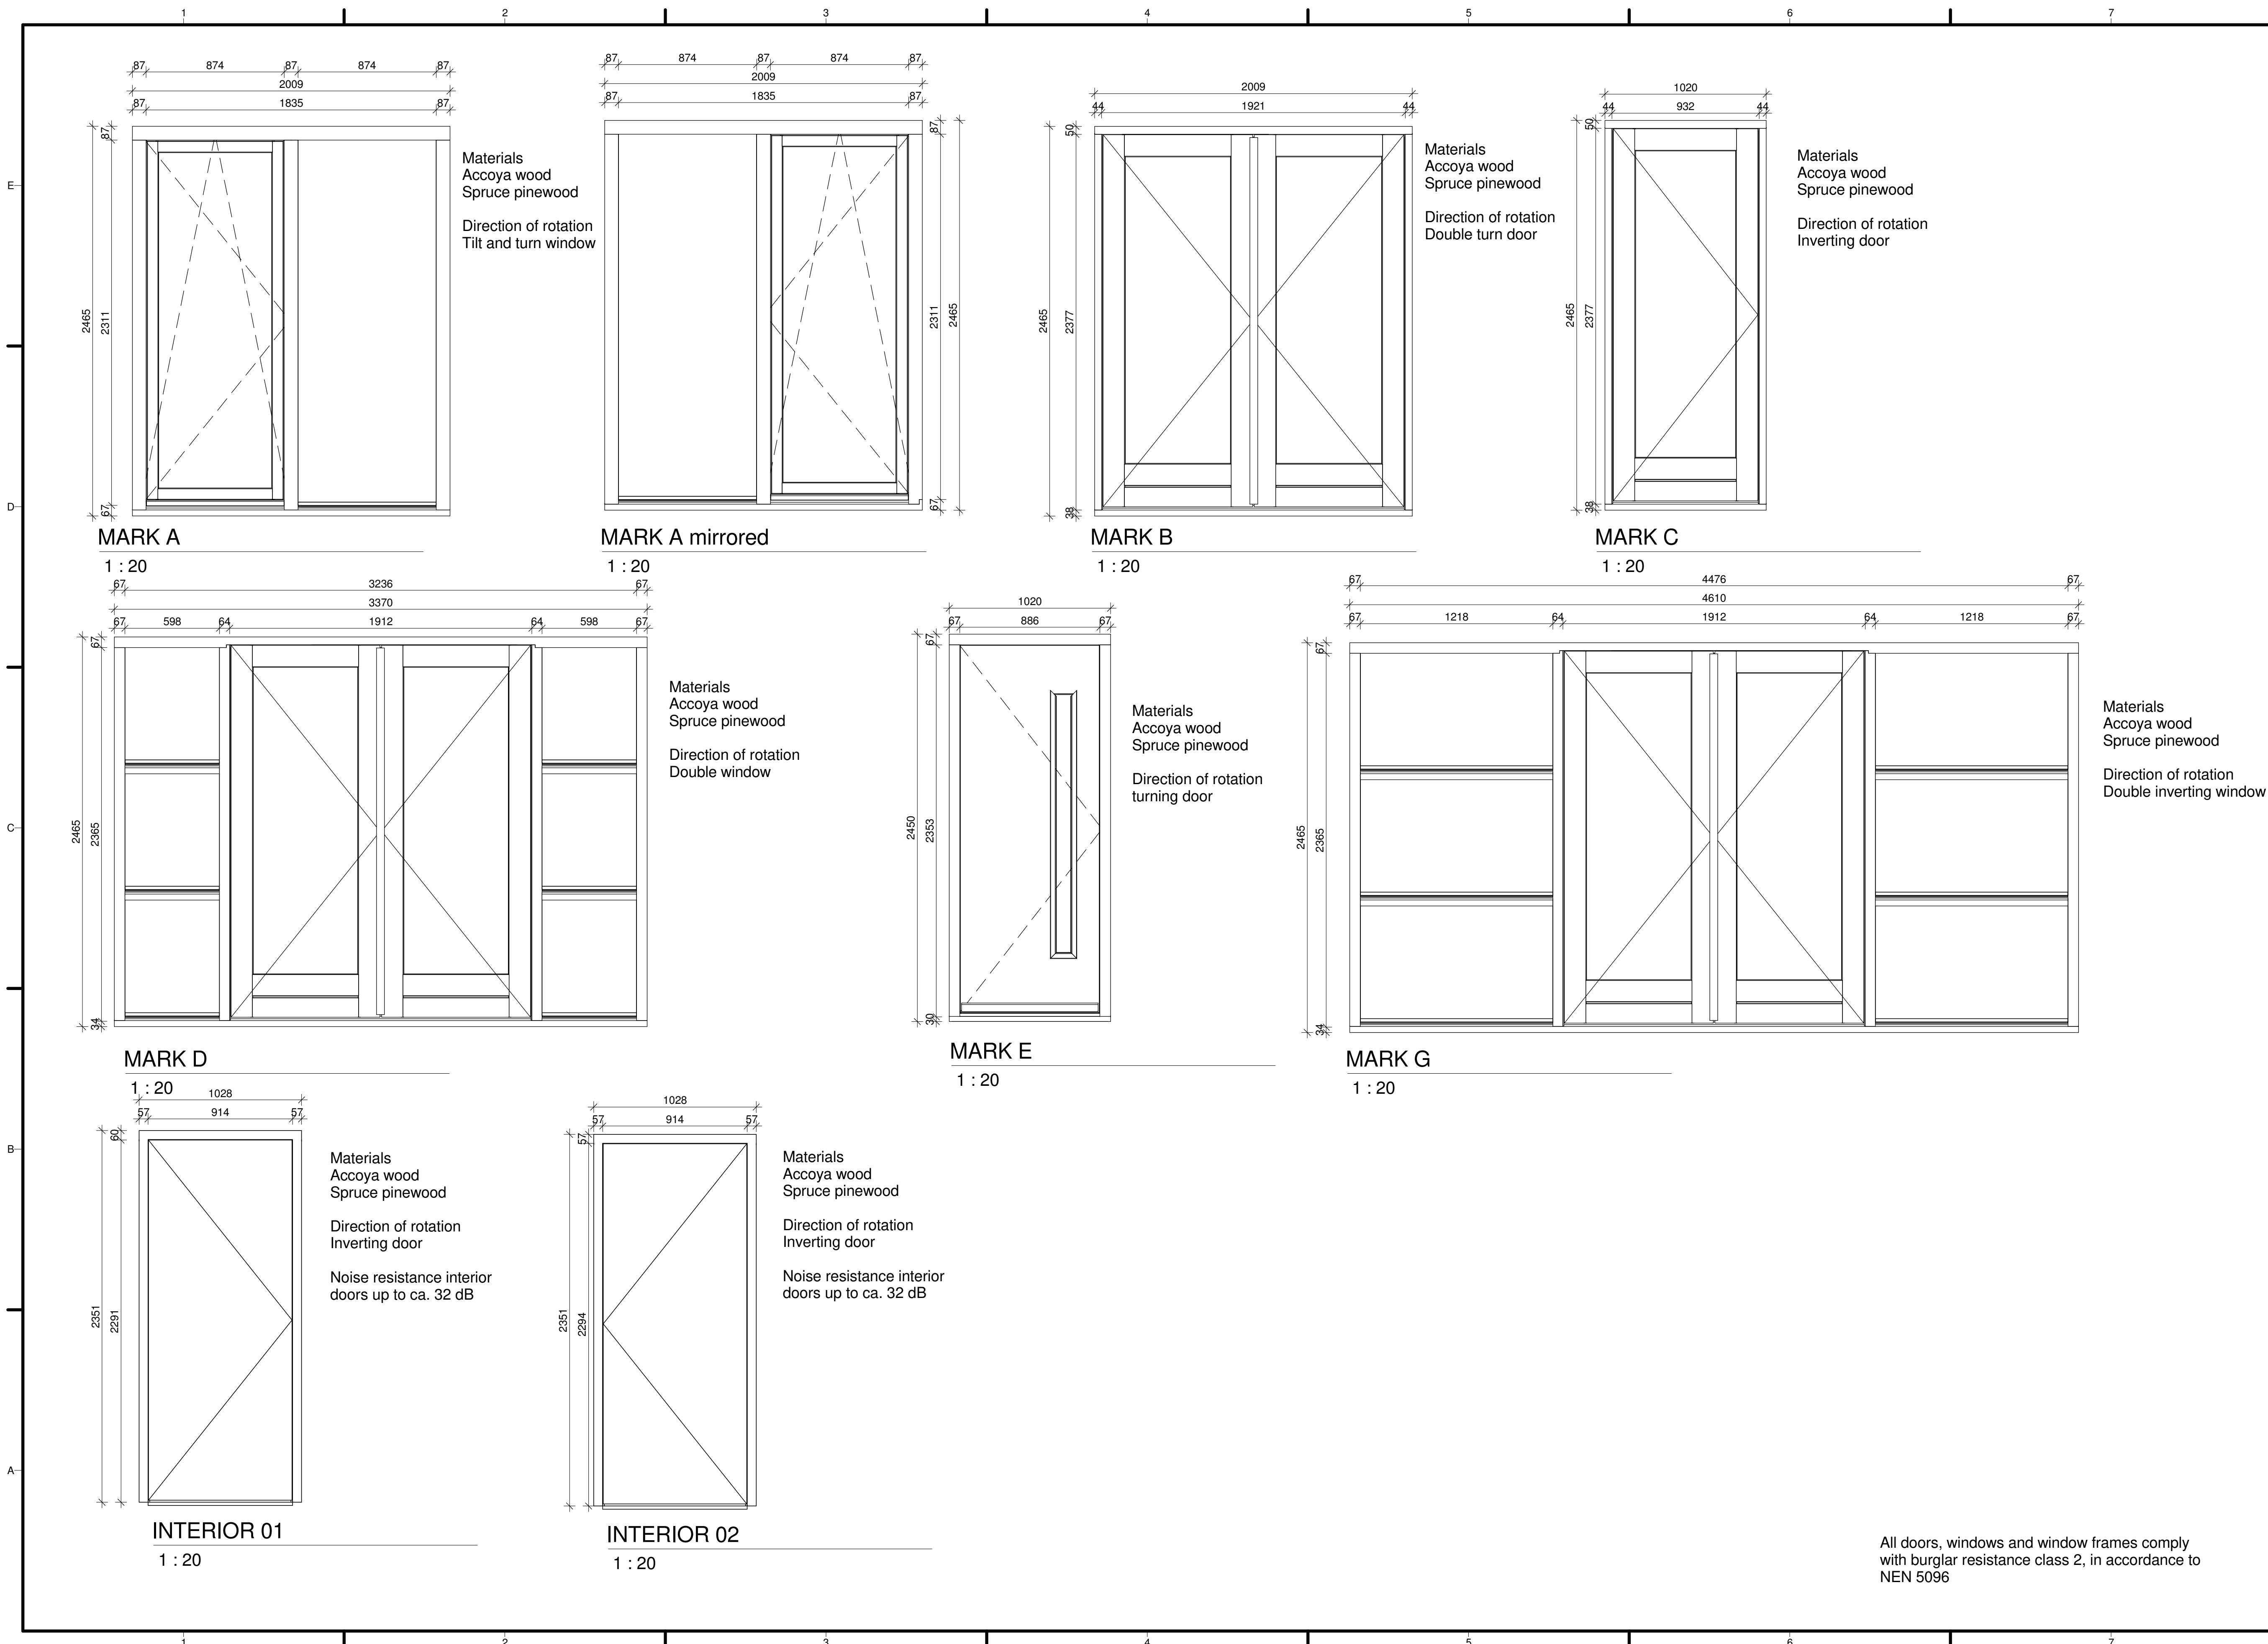

TEAM NAME: Selficient
ADDRESS: Padualaan 99, 3584 CH Utrecht
CONTACT: info@selficient.org, www.selficient.org

CONSULTANTS
ARCHITECTURE
ENGINEERS
LANDSCAPING
SAFETY FIRST CODE CONSULTANTS

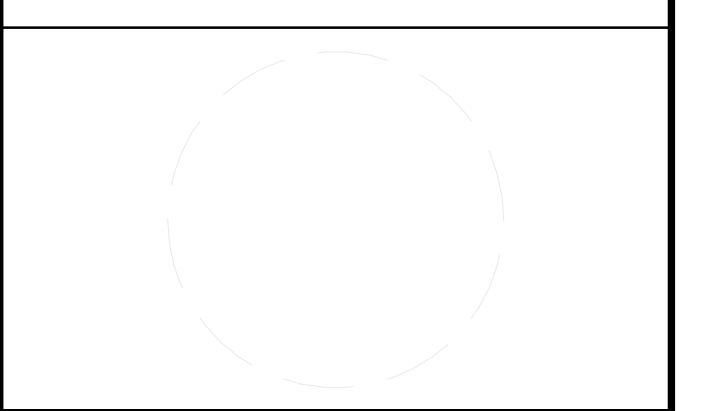

CLIENT
U.S. DEPARTMENT OF ENERGY
SOLAR DECATHLON 2017
WWW.SOLARDECATHLON.GOV



0	17-11-2016	90% revision
---	------------	--------------

MARK	DATE	DESCRIPTION

LOT NUMBER: 106
DRAWN BY: SELFICIENT
CHECKED BY: Selficient
COPYRIGHT: NONE; PROJECT IS PUBLIC DOMAIN

SCALE: 1 : 20
SHEET TITLE

WINDOW & DOOR SCHEDULE

A-500

All doors, windows and window frames comply with burglar resistance class 2, in accordance to NEN 5096

TEAM NAME: Selficient
 ADDRESS: Padualaan 99
 3584 CH Utrecht
 CONTACT: info@selficient.org
 www.selficient.org

CONSULTANTS
 ARCHITECTURE
 ENGINEERS
 LANDSCAPING
 SAFETY FIRST CODE CONSULTANTS

CLIENT
 U.S. DEPARTMENT OF ENERGY
 SOLAR DECATHLON 2017
 WWW.SOLARDECATHLON.GOV



MARK	DATE	DESCRIPTION
0	17-11-2016	90% revision


LOT NUMBER: 106
 DRAWN BY: Author
 CHECKED BY: Selficient
 COPYRIGHT: NONE; PROJECT IS PUBLIC DOMAIN

SCALE: 1:20


SHEET TITLE

BATHROOM
 ELEVATIONS


A-601

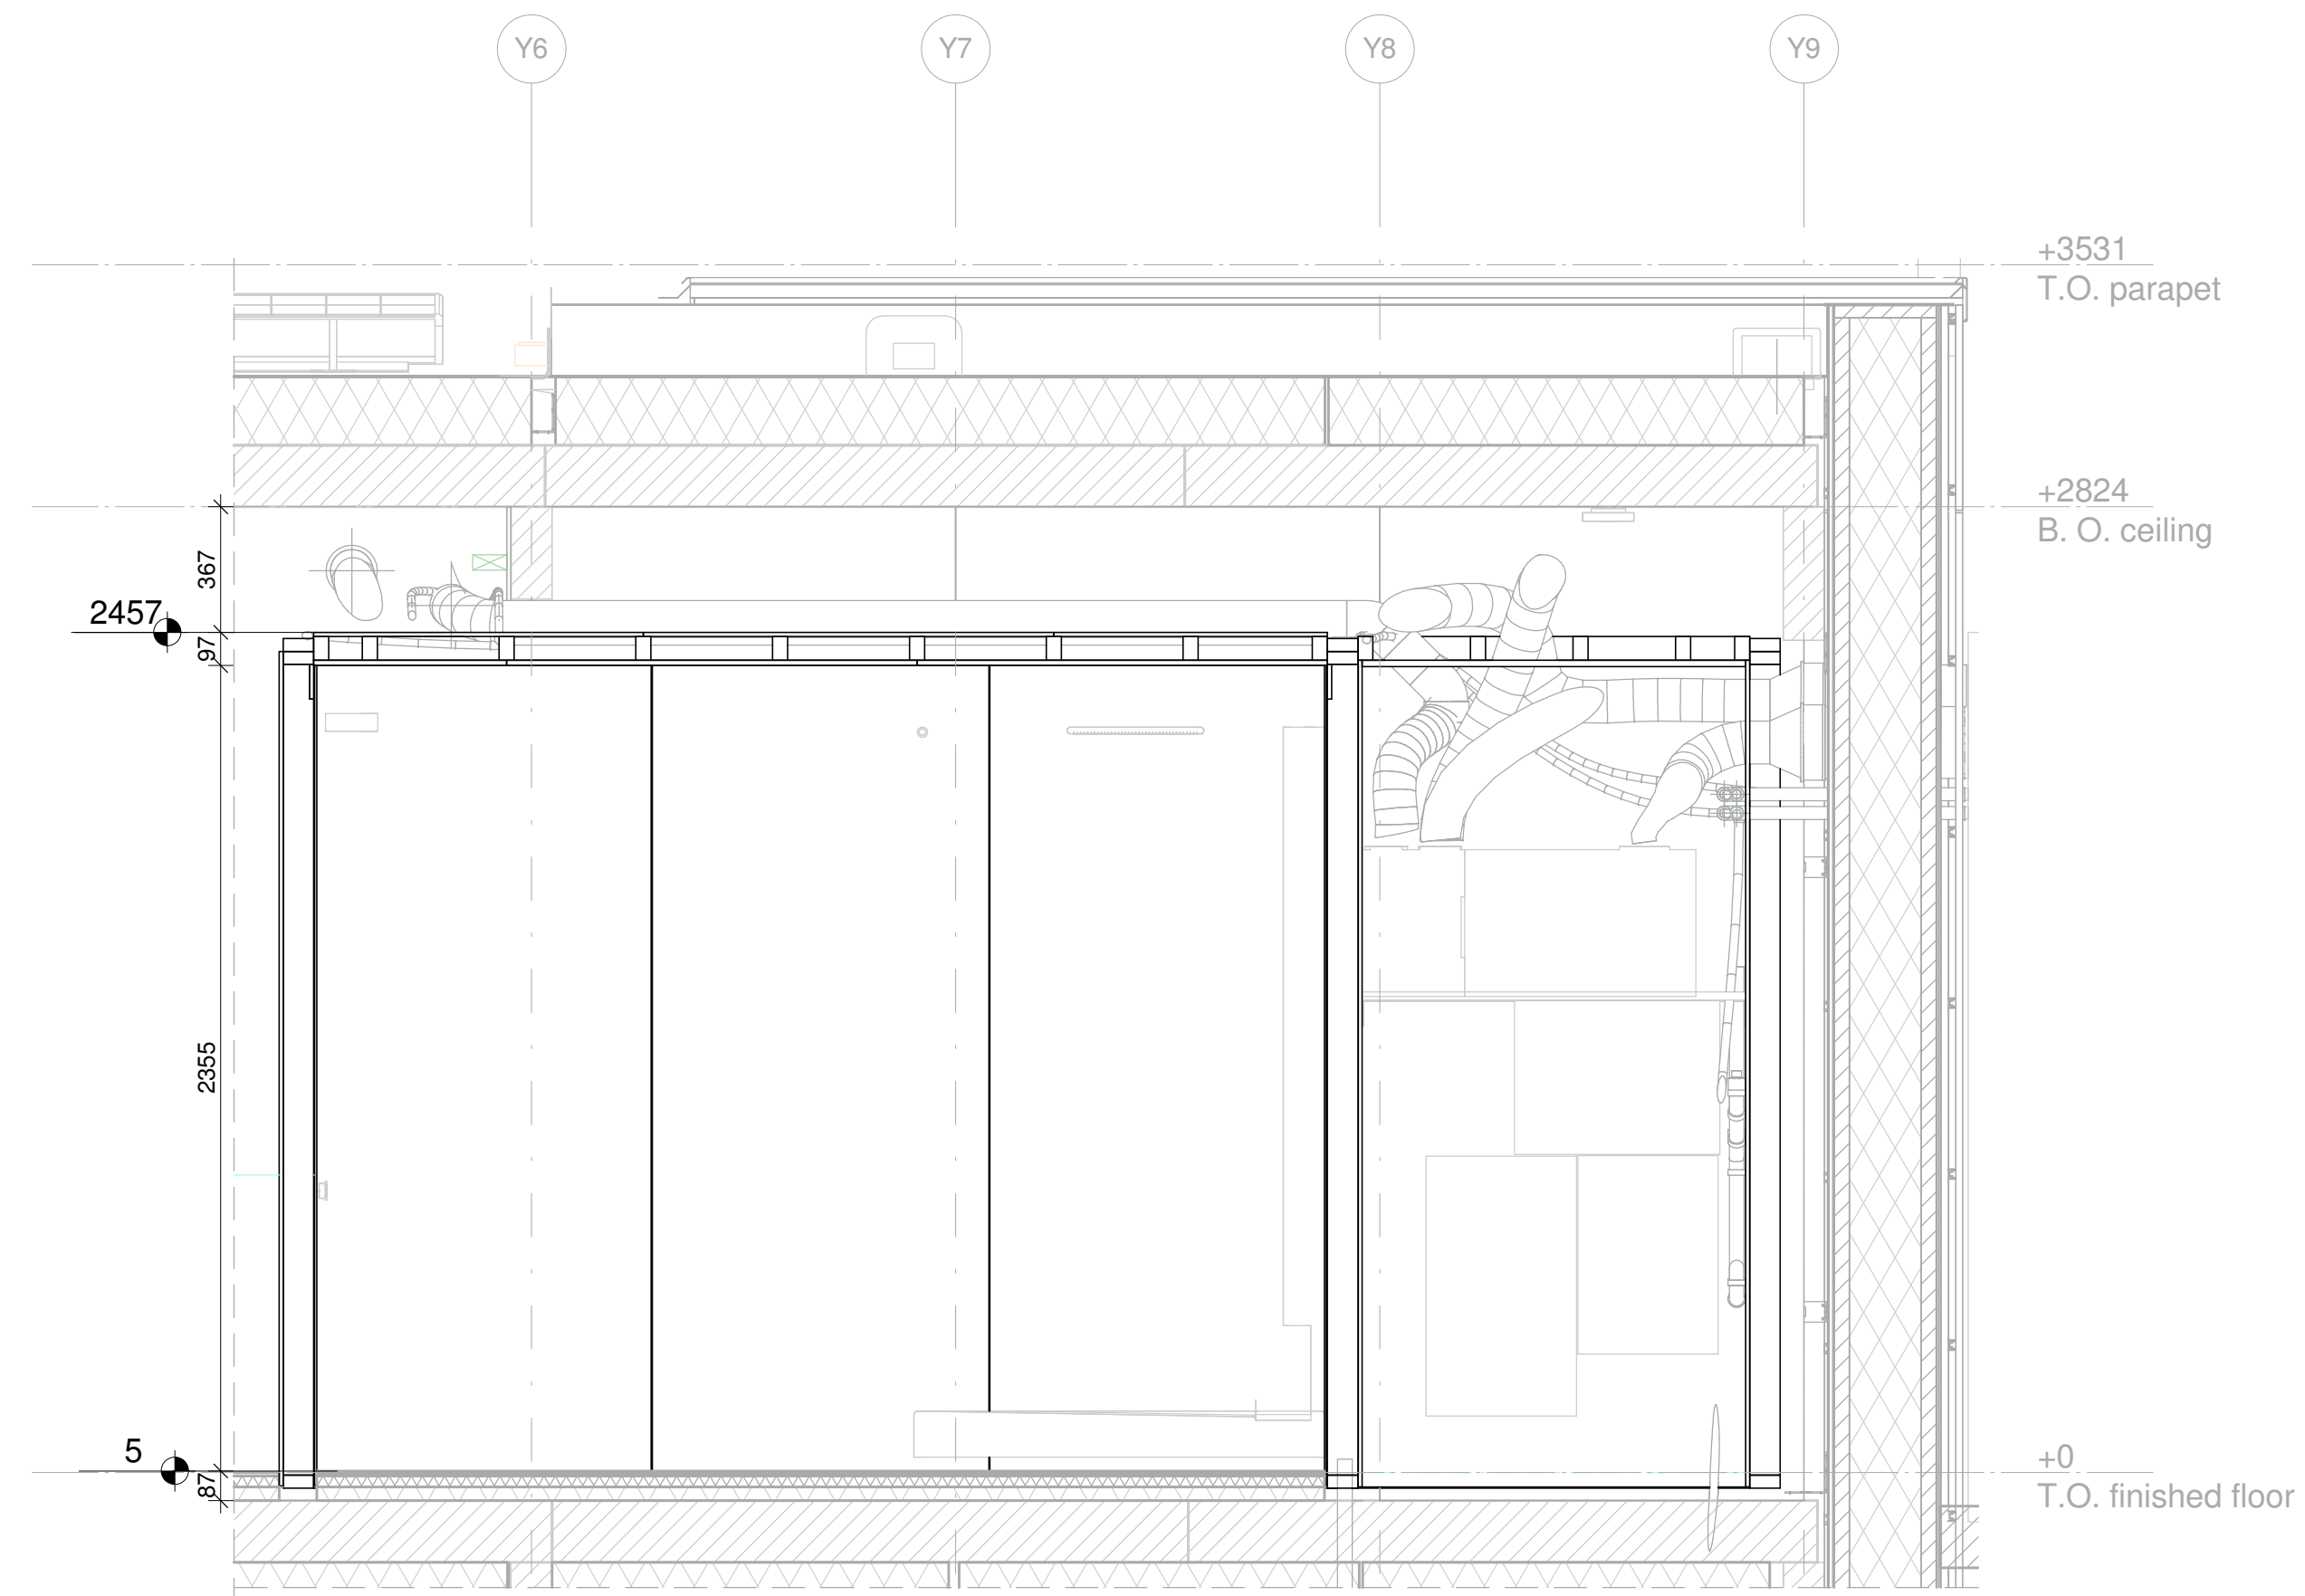


SECTION A-A
 1:20

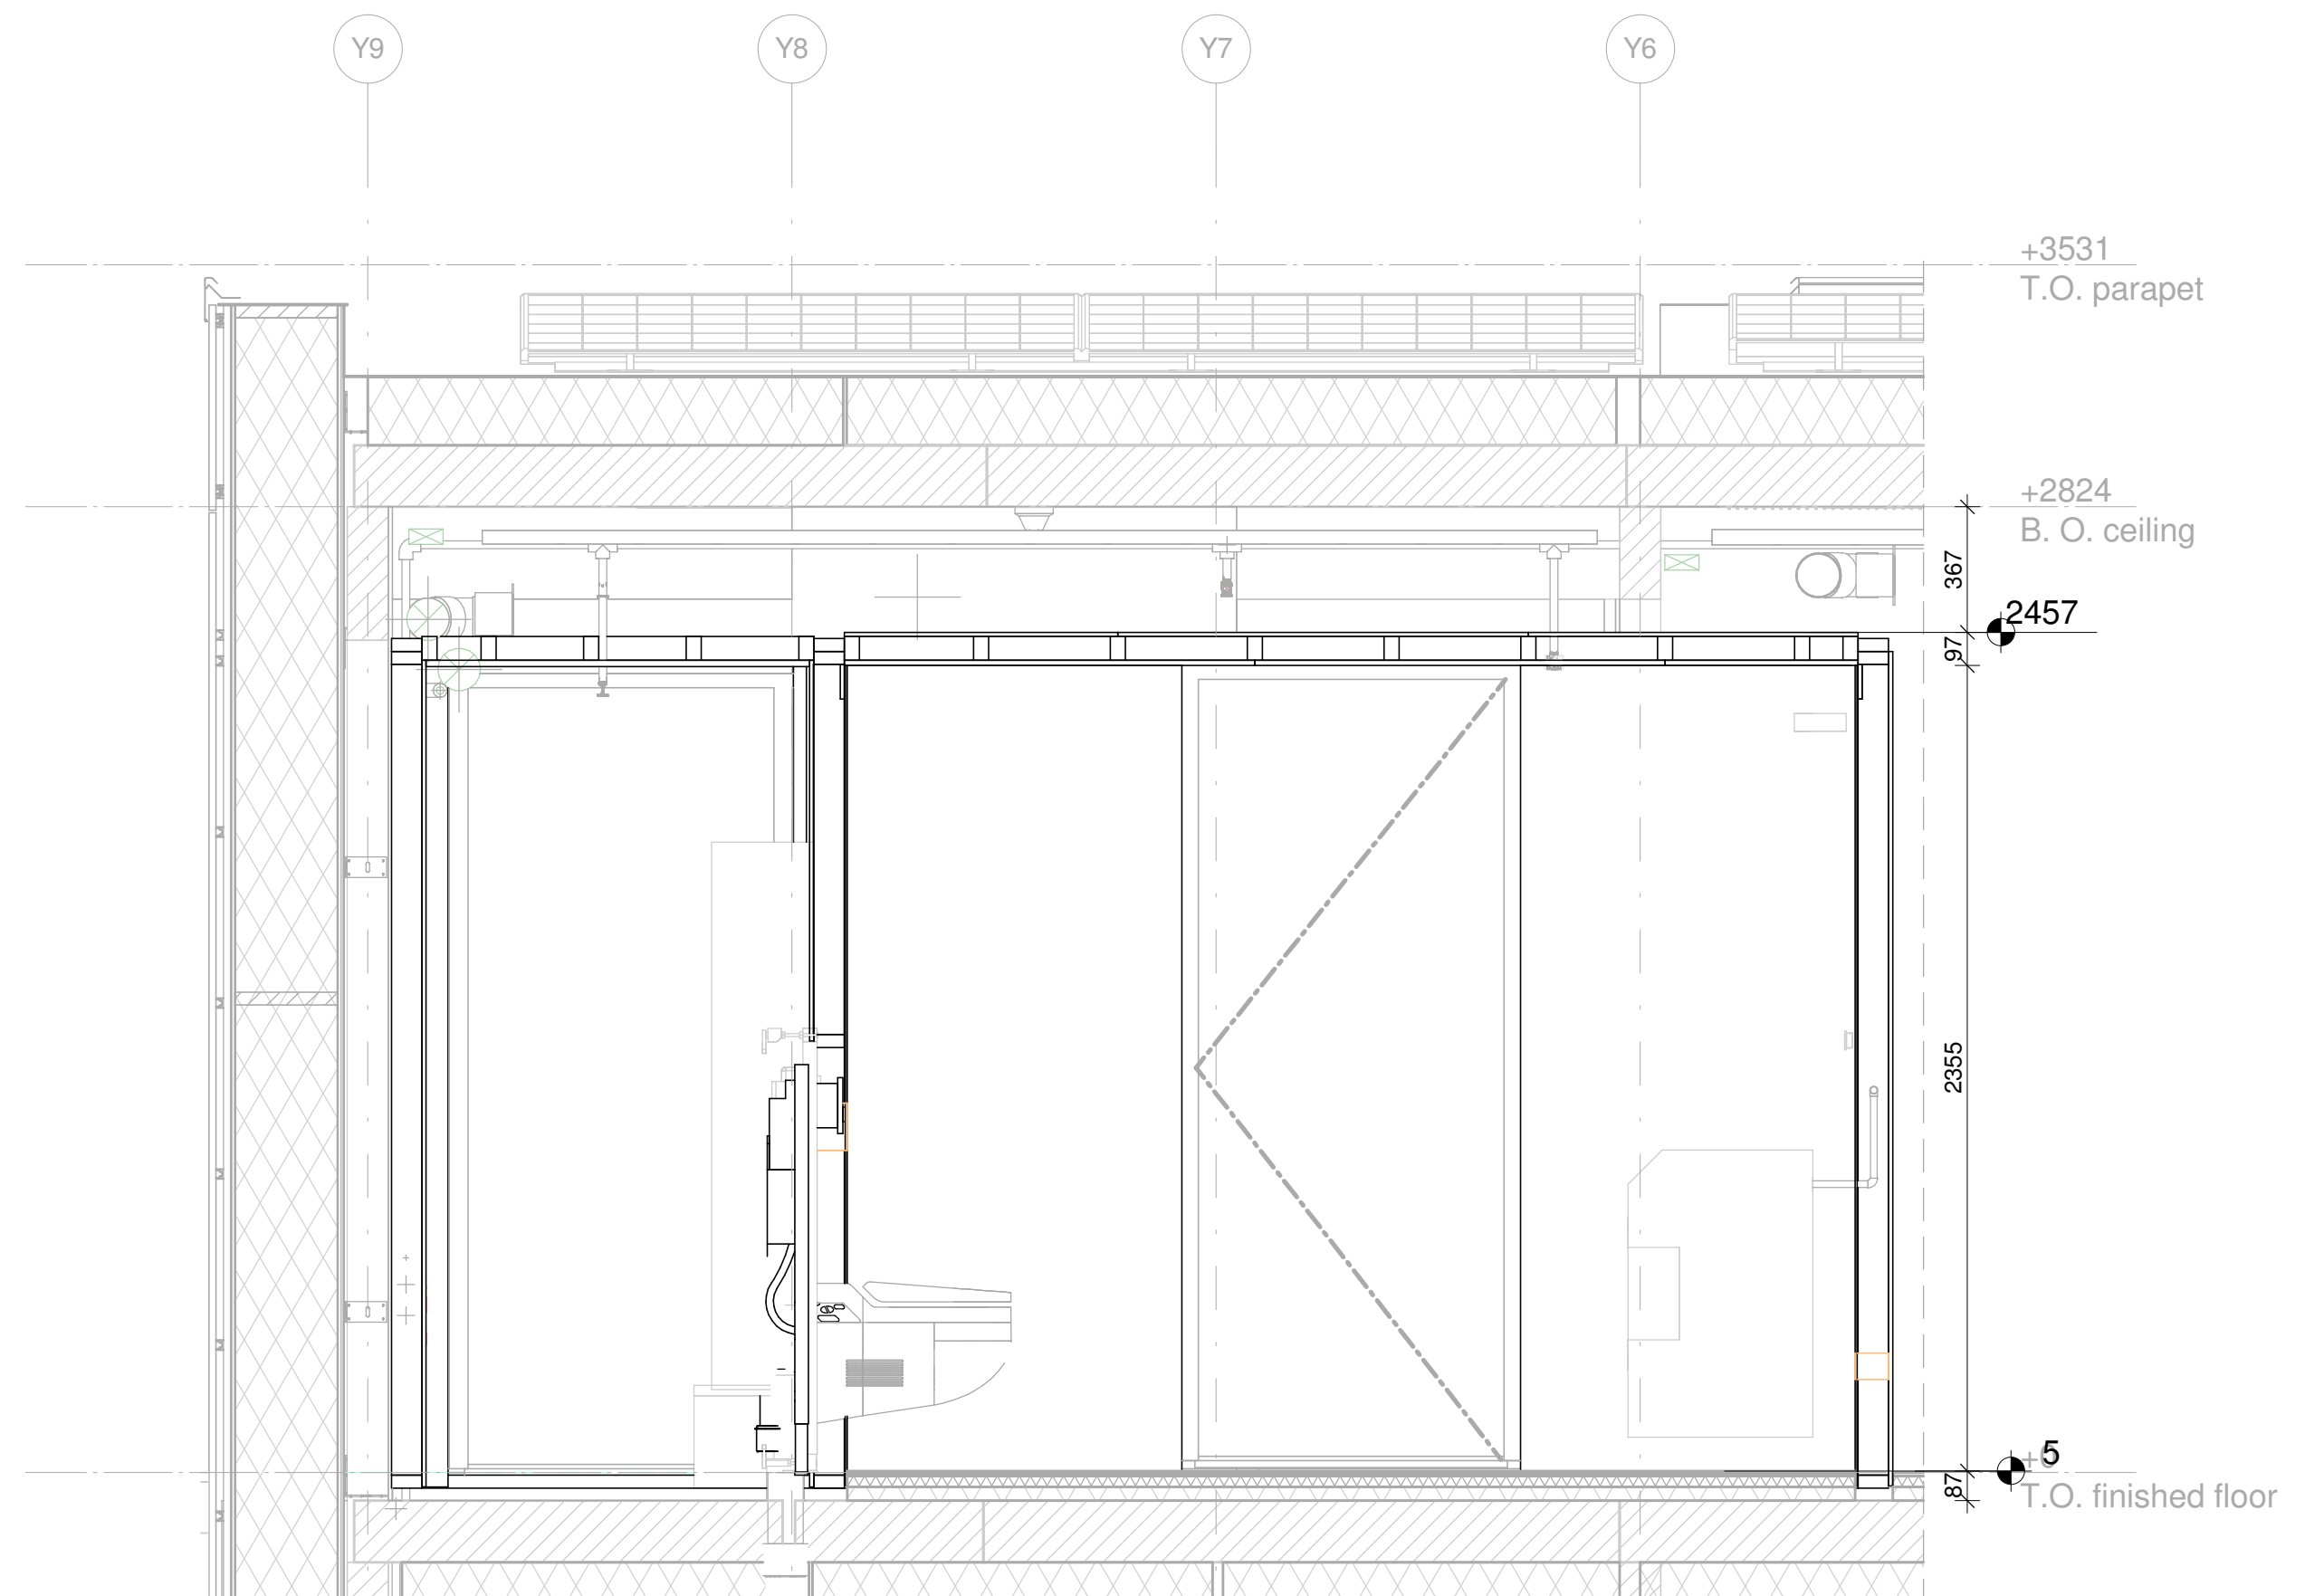


SECTION C-C
 1:20

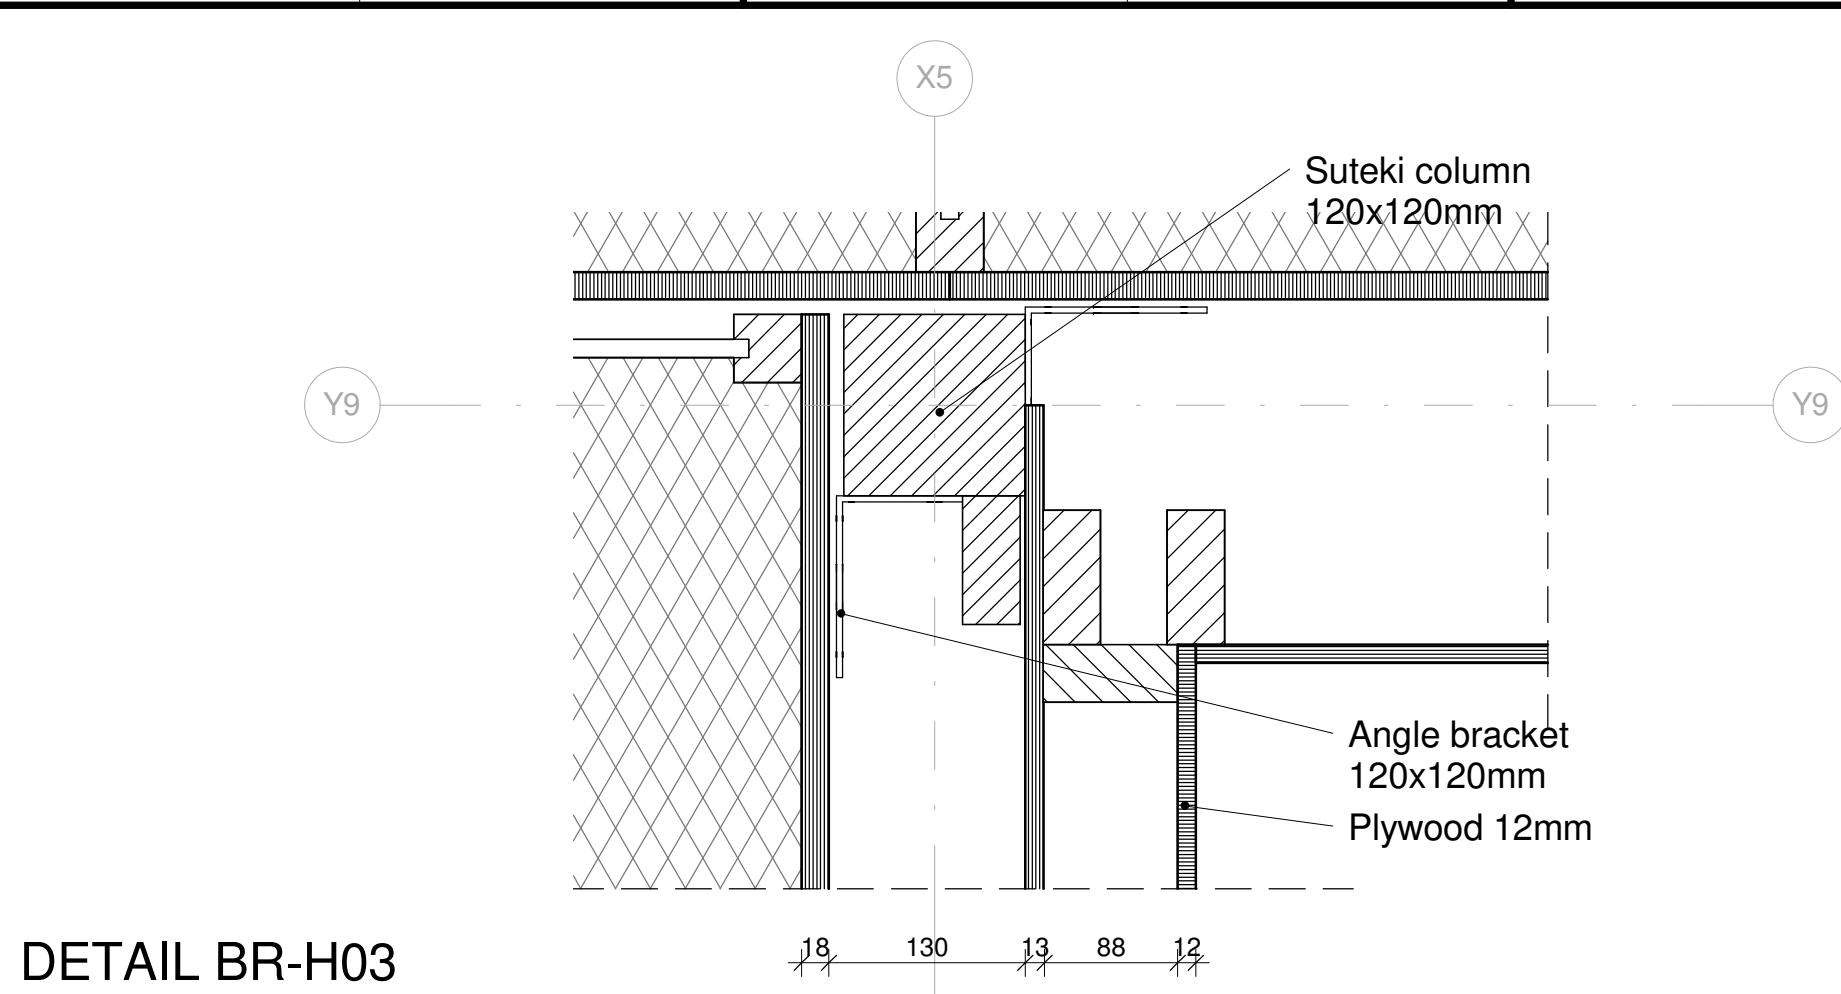


DETAIL BR-H03
1 : 5

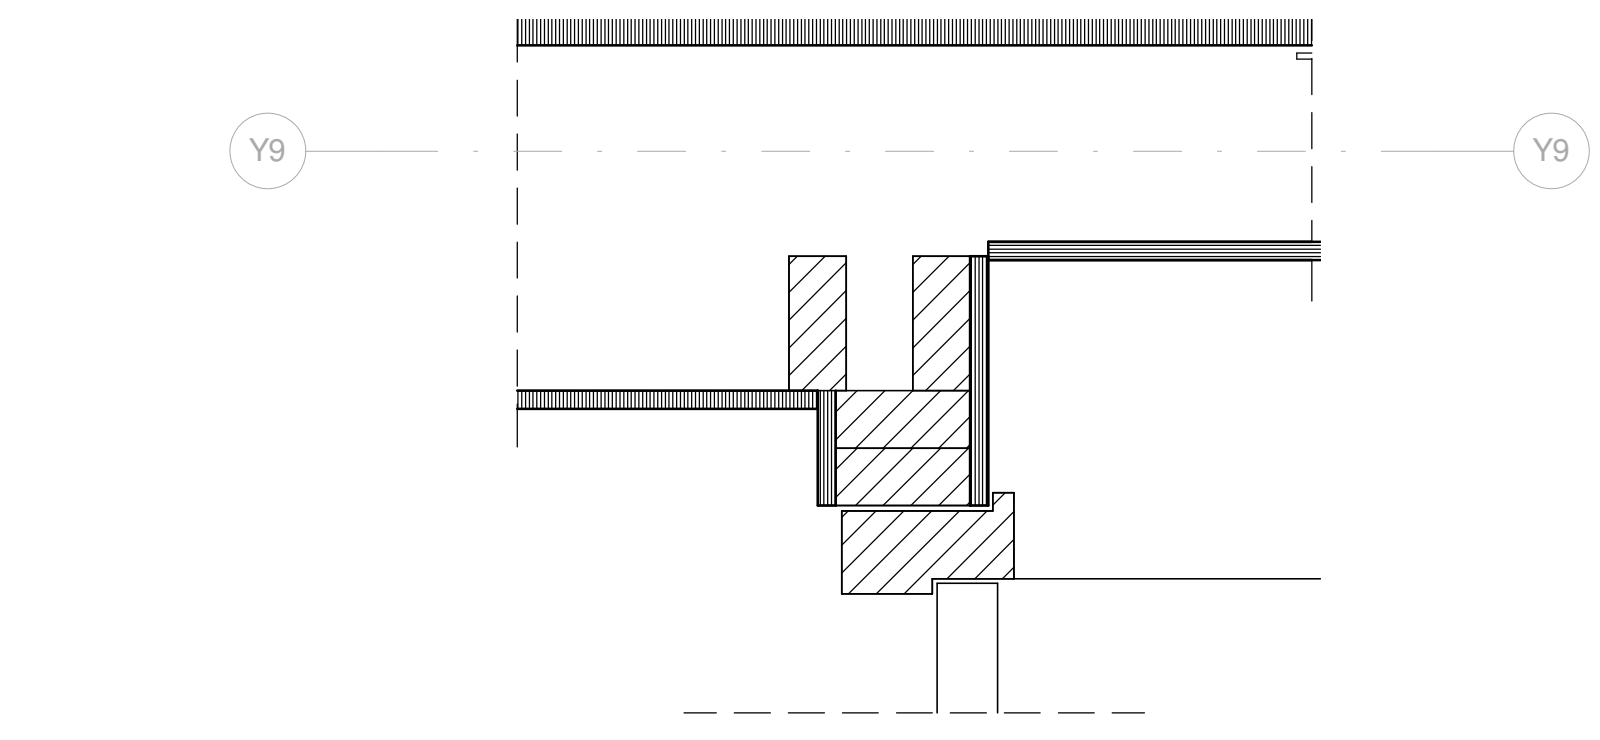


DETAIL BR-H04
1 : 5

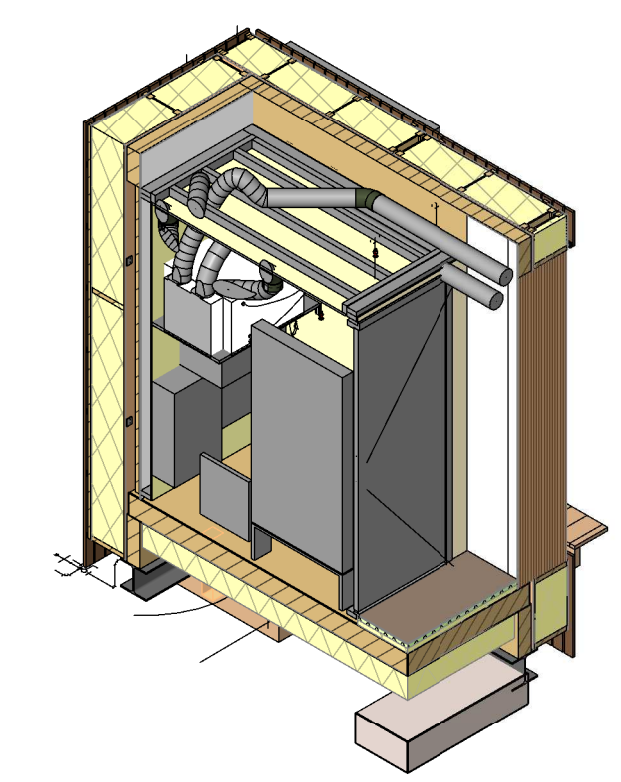


TECHINCAL ROOM 3D SECTION

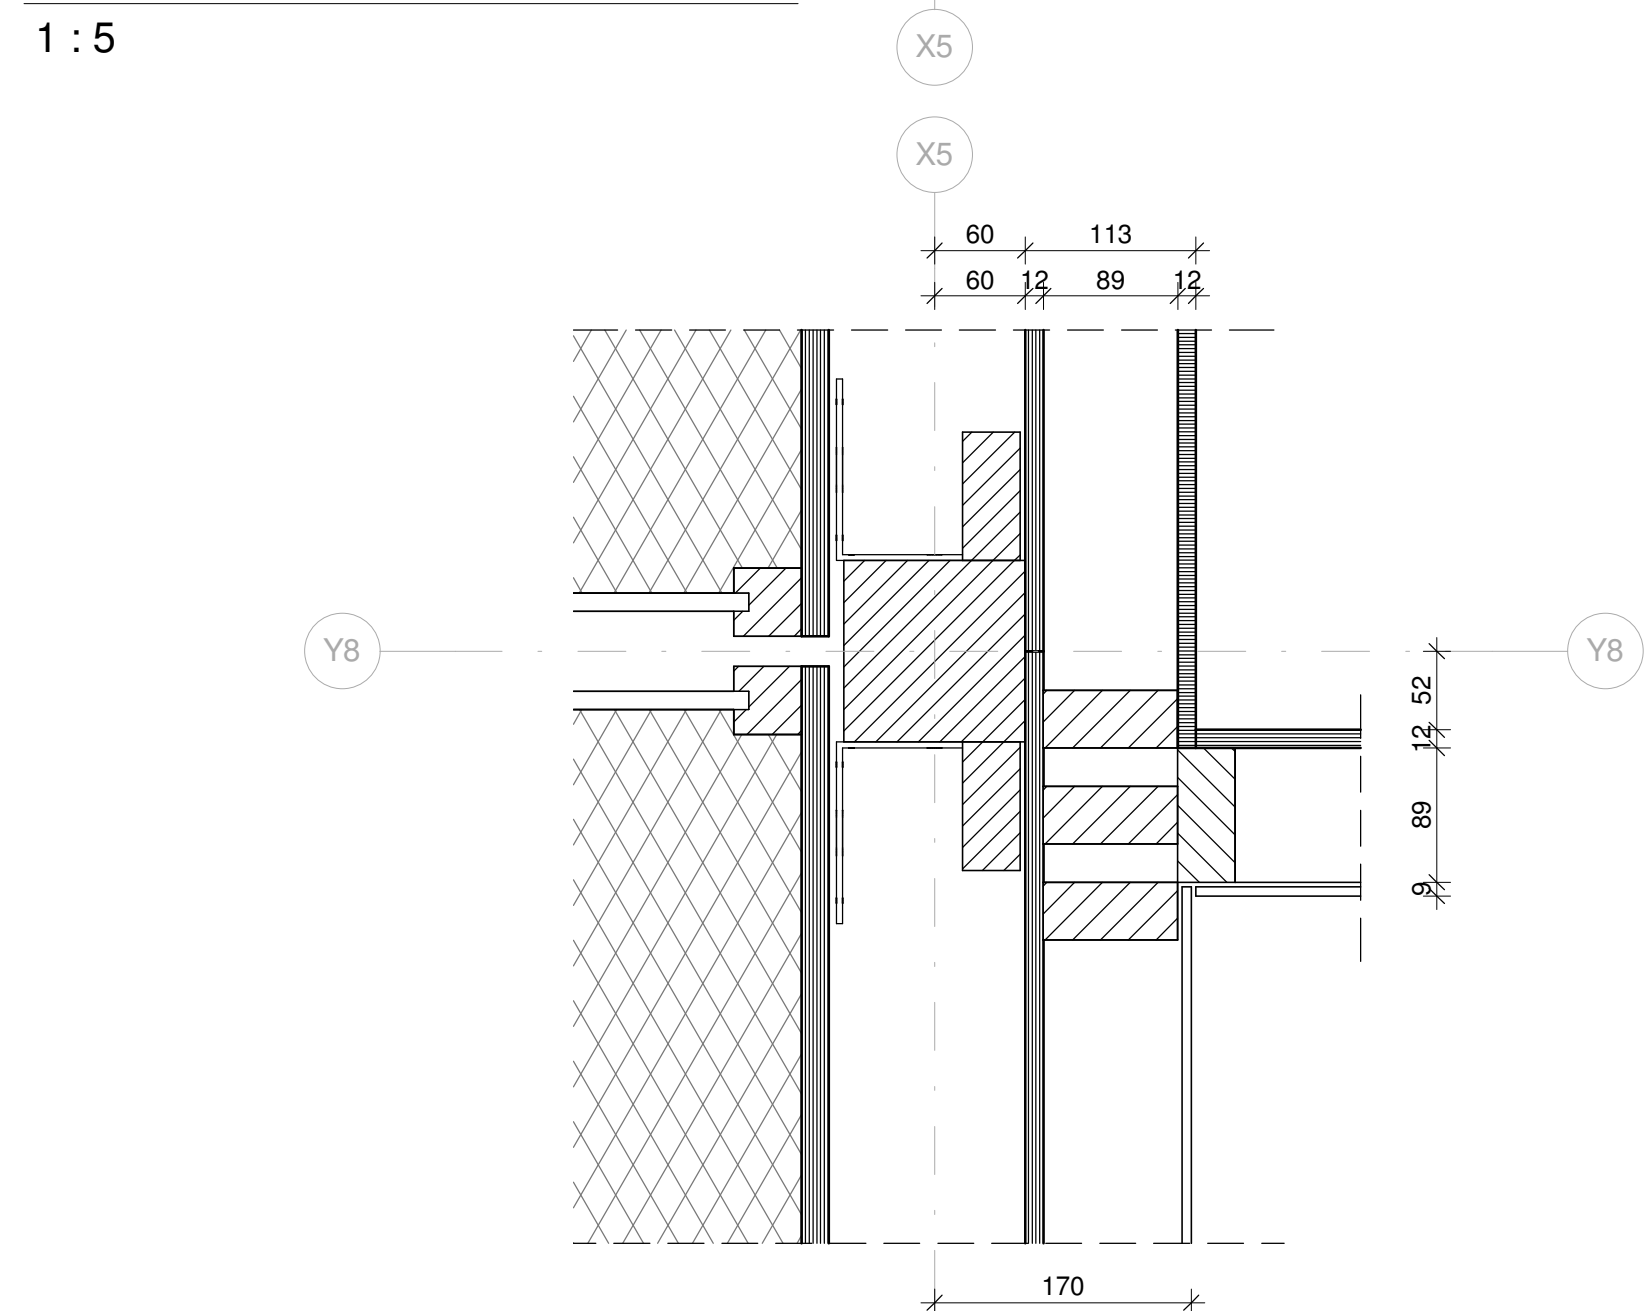


DETAIL BR-H02
1 : 5

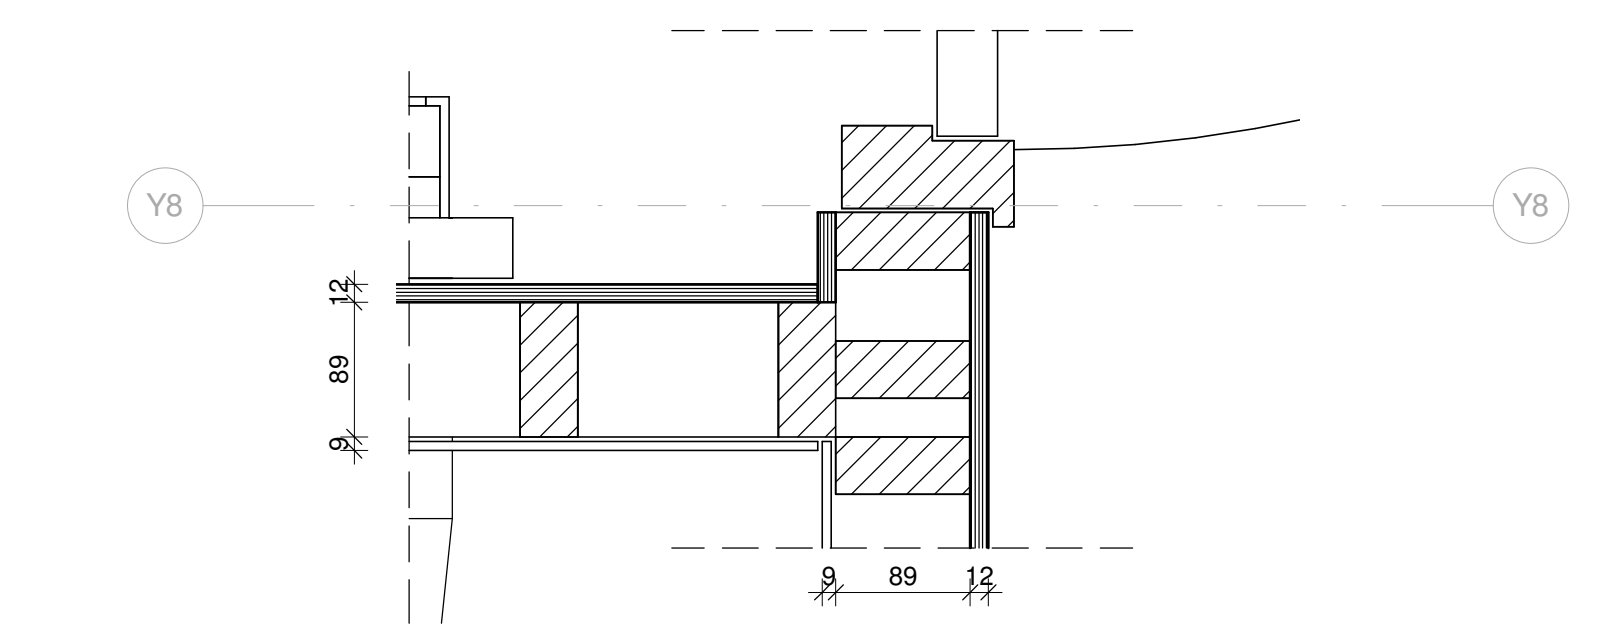


DETAIL BR-H05
1 : 5

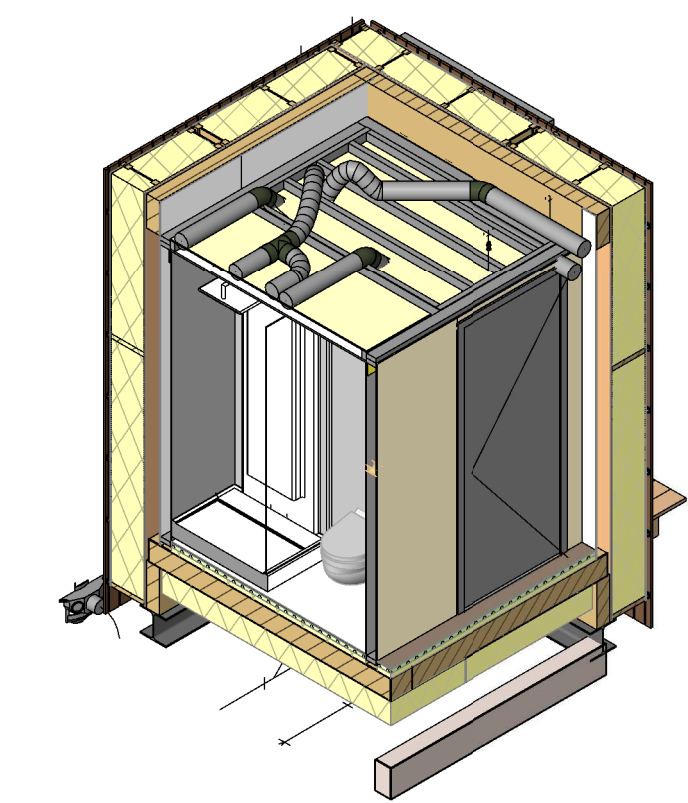


BATHROOM 3D SECION A-A

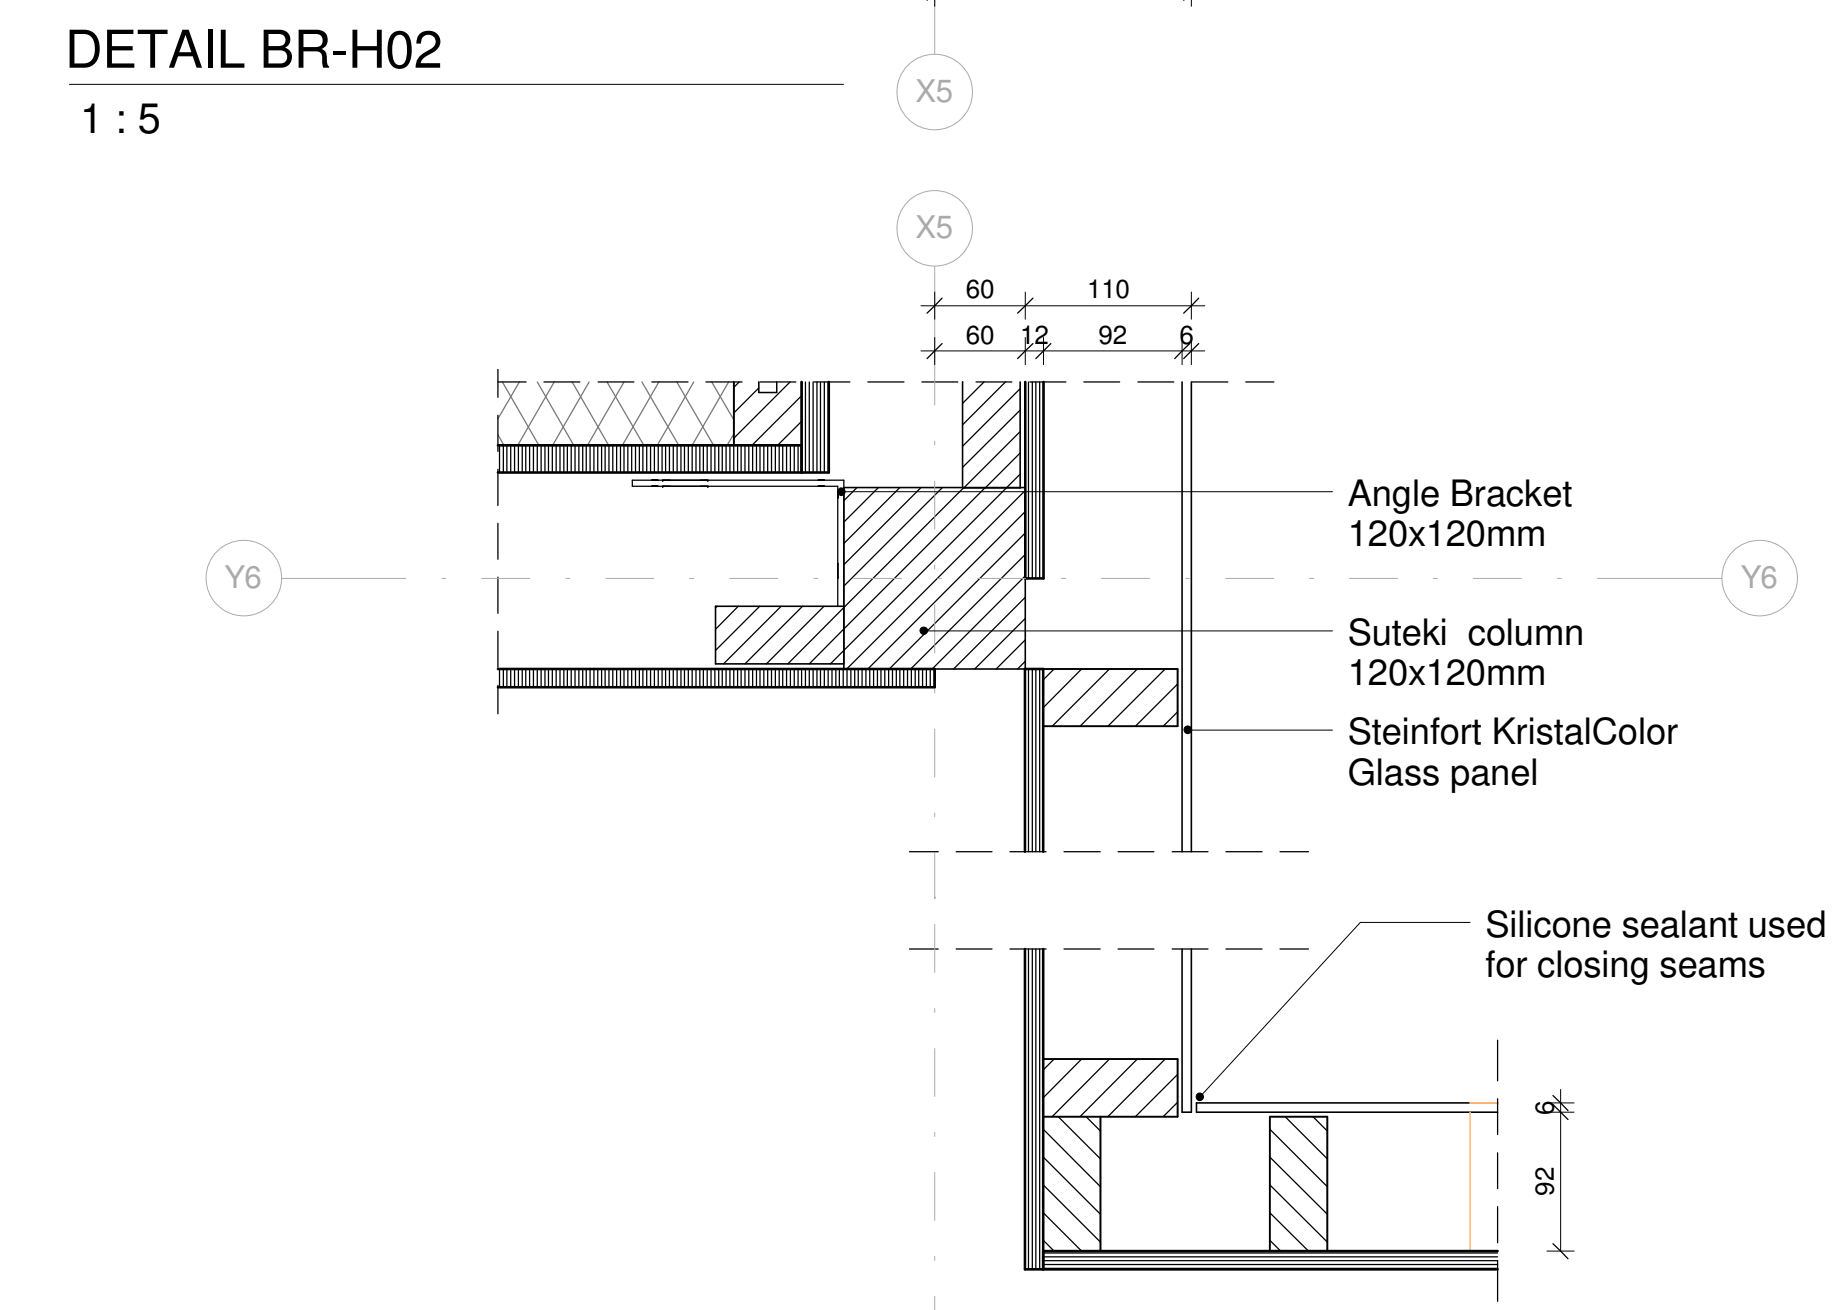

DETAIL BR-H01
1 : 5

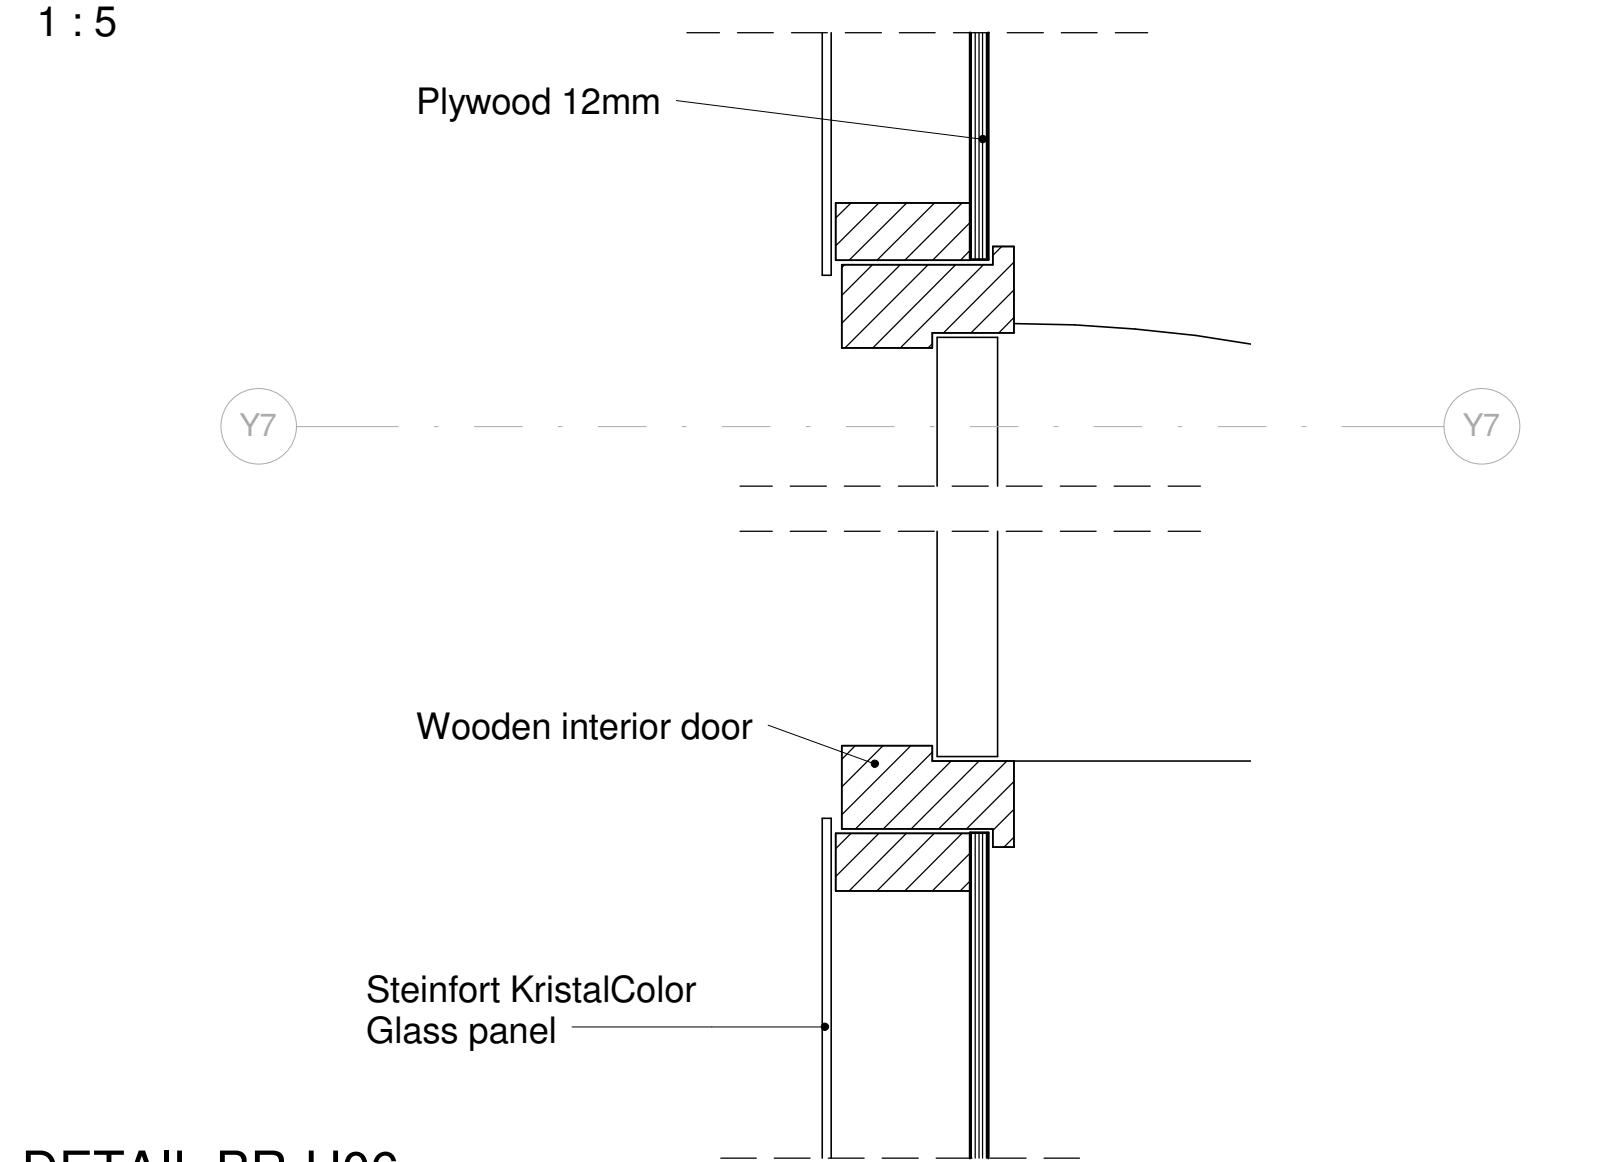

DETAIL BR-H06
1 : 5

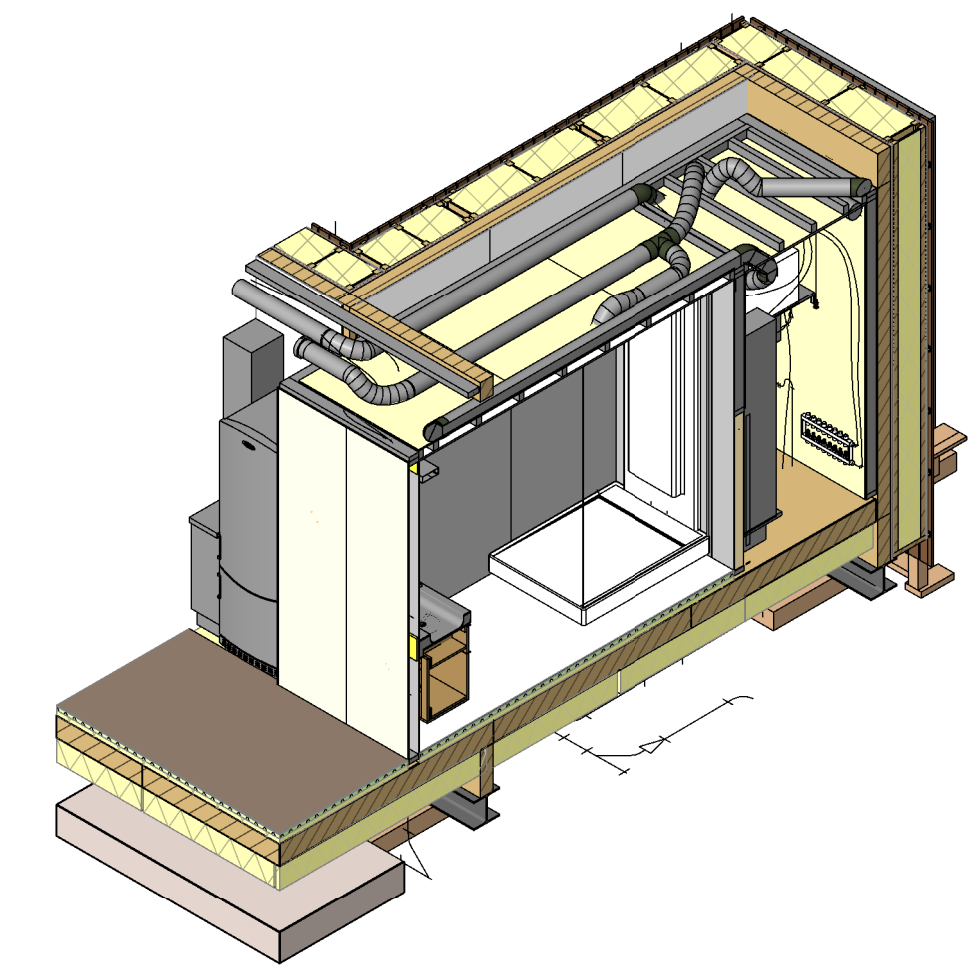

BATHROOM AND TECHNICAL ROOM 3D SECTION B-B

DETAIL BR-H07
1 : 5



TEAM NAME: Selficient
ADDRESS: Padualaan 99
3584 CH Utrecht
CONTACT: info@selficient.org
www.selficient.org

CONSULTANTS
ARCHITECTURE
ENGINEERS
LANDSCAPING
SAFETY FIRST CODE CONSULTANTS

CLIENT
U.S. DEPARTMENT OF ENERGY
SOLAR DECATHLON 2017
WWW.SOLARDECATHLON.GOV



MARK	DATE	DESCRIPTION
0	17-11-2016	90% revision

LOT NUMBER: 106
DRAWN BY: SELFICIENT
CHECKED BY: Selficient
COPYRIGHT: NONE; PROJECT IS PUBLIC DOMAIN

SCALE: 1 : 5
SHEET TITLE

BATHROOM-MODULE
DETAILS HORIZONTAL

A-602

TEAM NAME: Selficient
 ADDRESS: Padualaan 99
 3584 CH Utrecht
 CONTACT: info@selficient.org
 www.selficient.org

CONSULTANTS
 ARCHITECTURE
 ENGINEERS
 LANDSCAPING
 SAFETY FIRST CODE CONSULTANTS

CLIENT
 U.S. DEPARTMENT OF ENERGY
 SOLAR DECATHLON 2017
 WWW.SOLARDECATHLON.GOV



MARK	DATE	DESCRIPTION
0	17-11-2016	90% revision

MARK	DATE	DESCRIPTION
0	17-11-2016	90% revision


LOT NUMBER: 106
 DRAWN BY: SELFICIENT
 CHECKED BY: Selficient
 COPYRIGHT: NONE; PROJECT IS PUBLIC DOMAIN

SCALE: 1 : 5


SHEET TITLE

BATHROOM-MODULE
 DETAILS VERTICAL


A-603

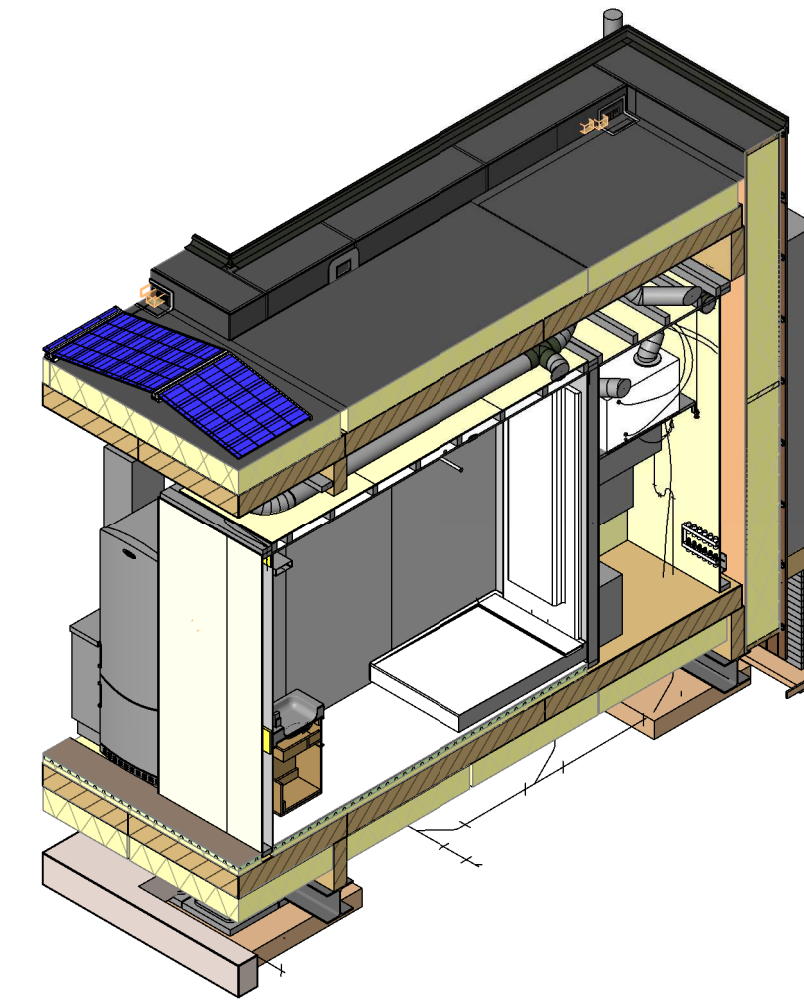


BATHROOMD 3D SECTION C-C

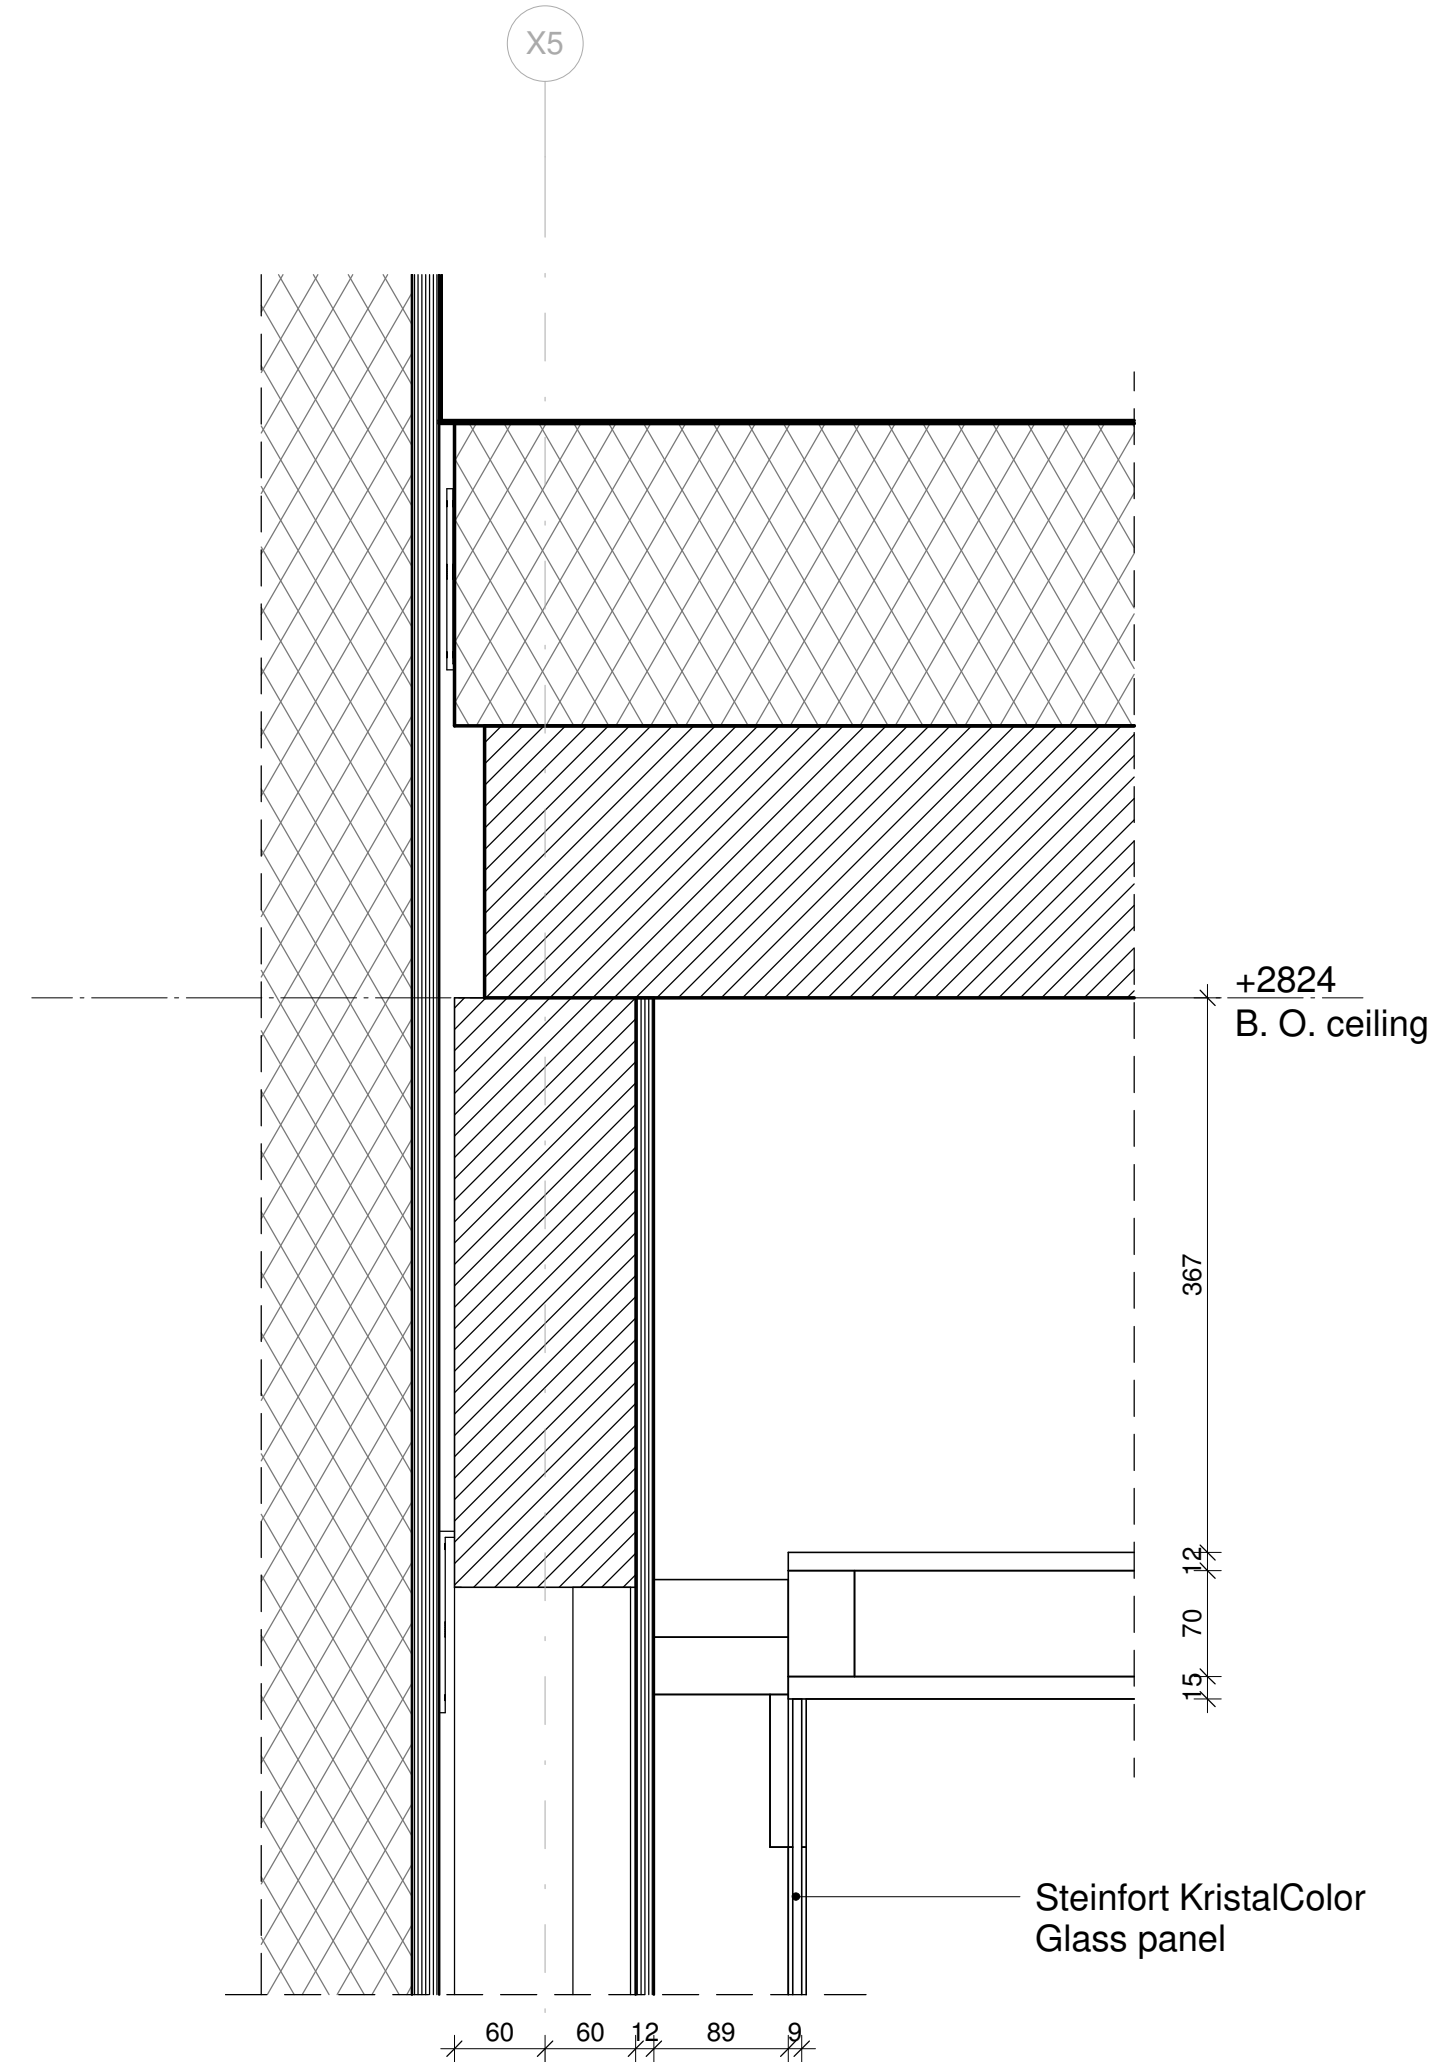


DETBAIL BR-V03
 1 : 5

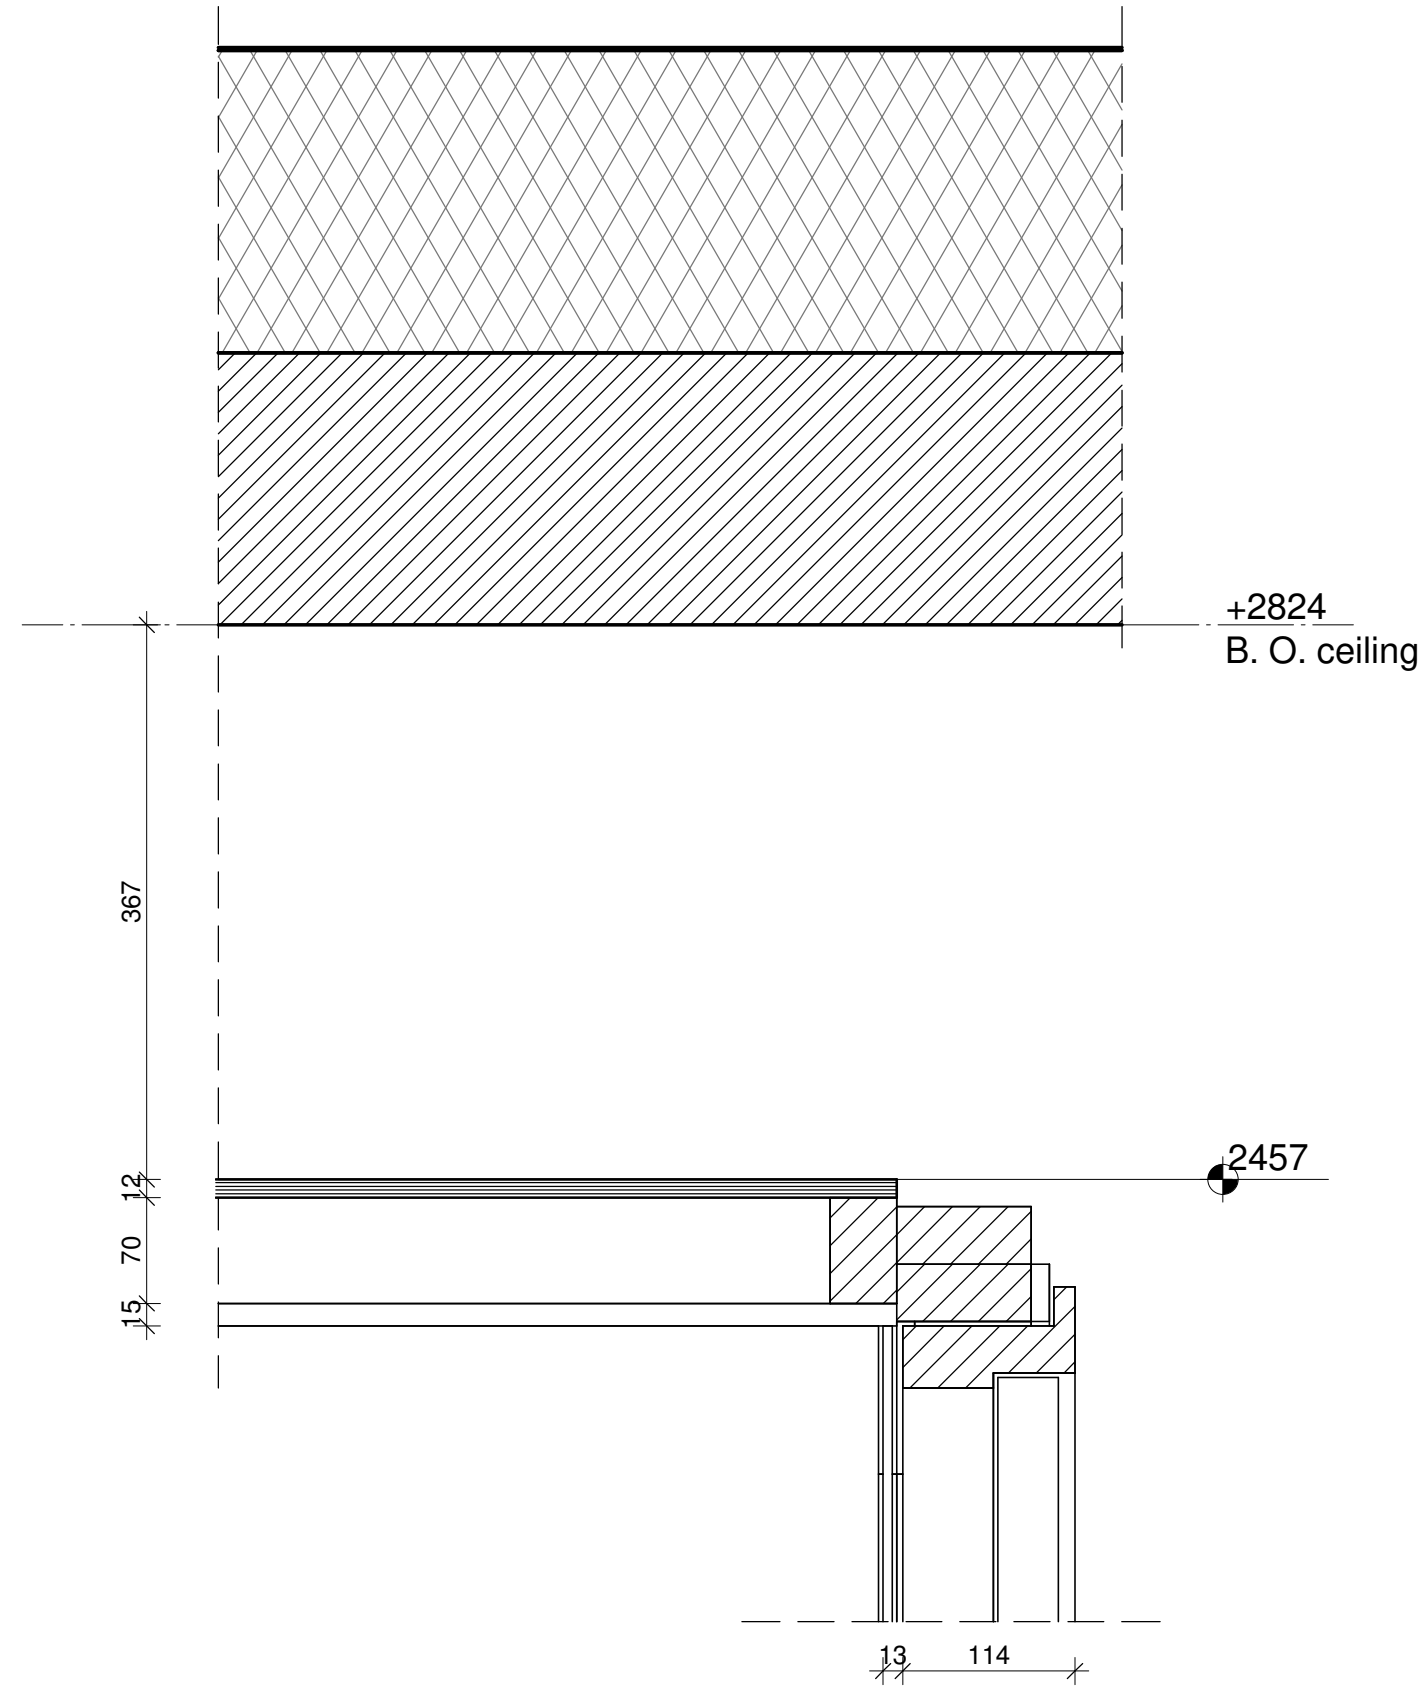


DETAIL BR-V04
 1 : 5

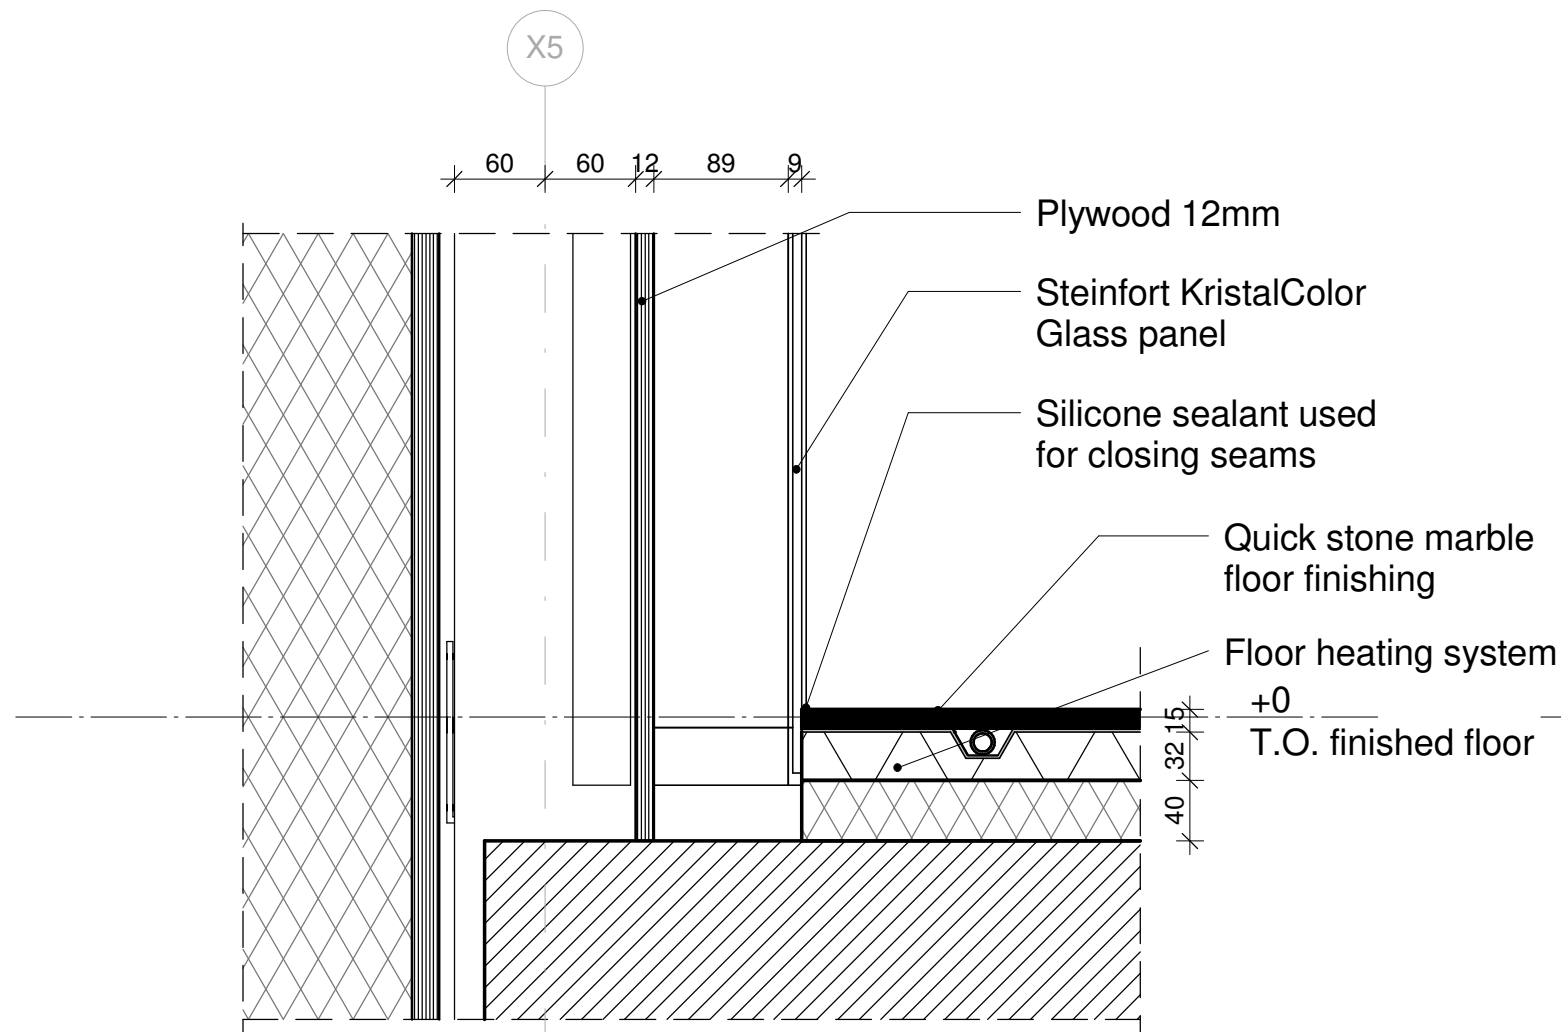

DETAIL BR-V02
 1 : 5

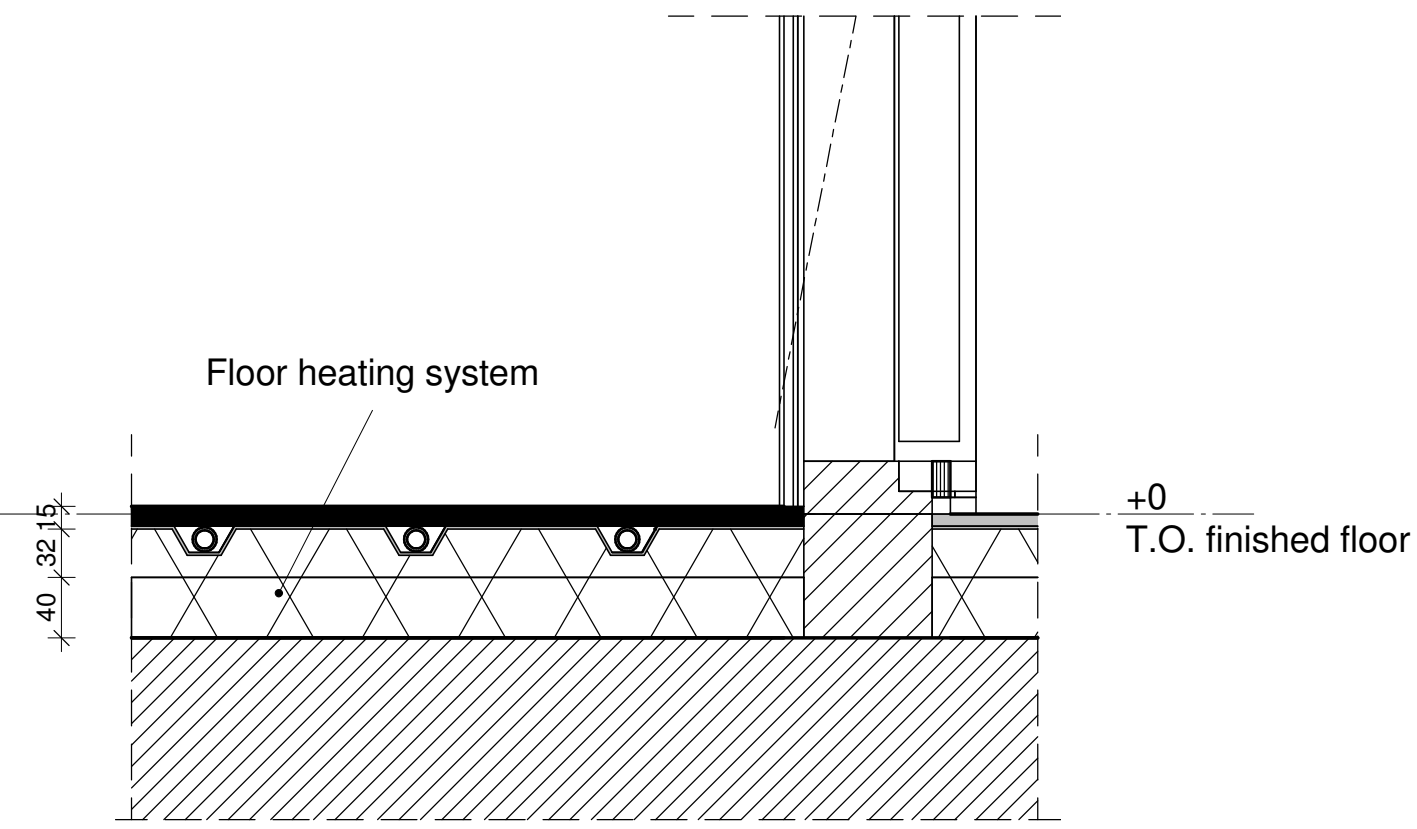

DETAIL BR-V01
 1 : 5

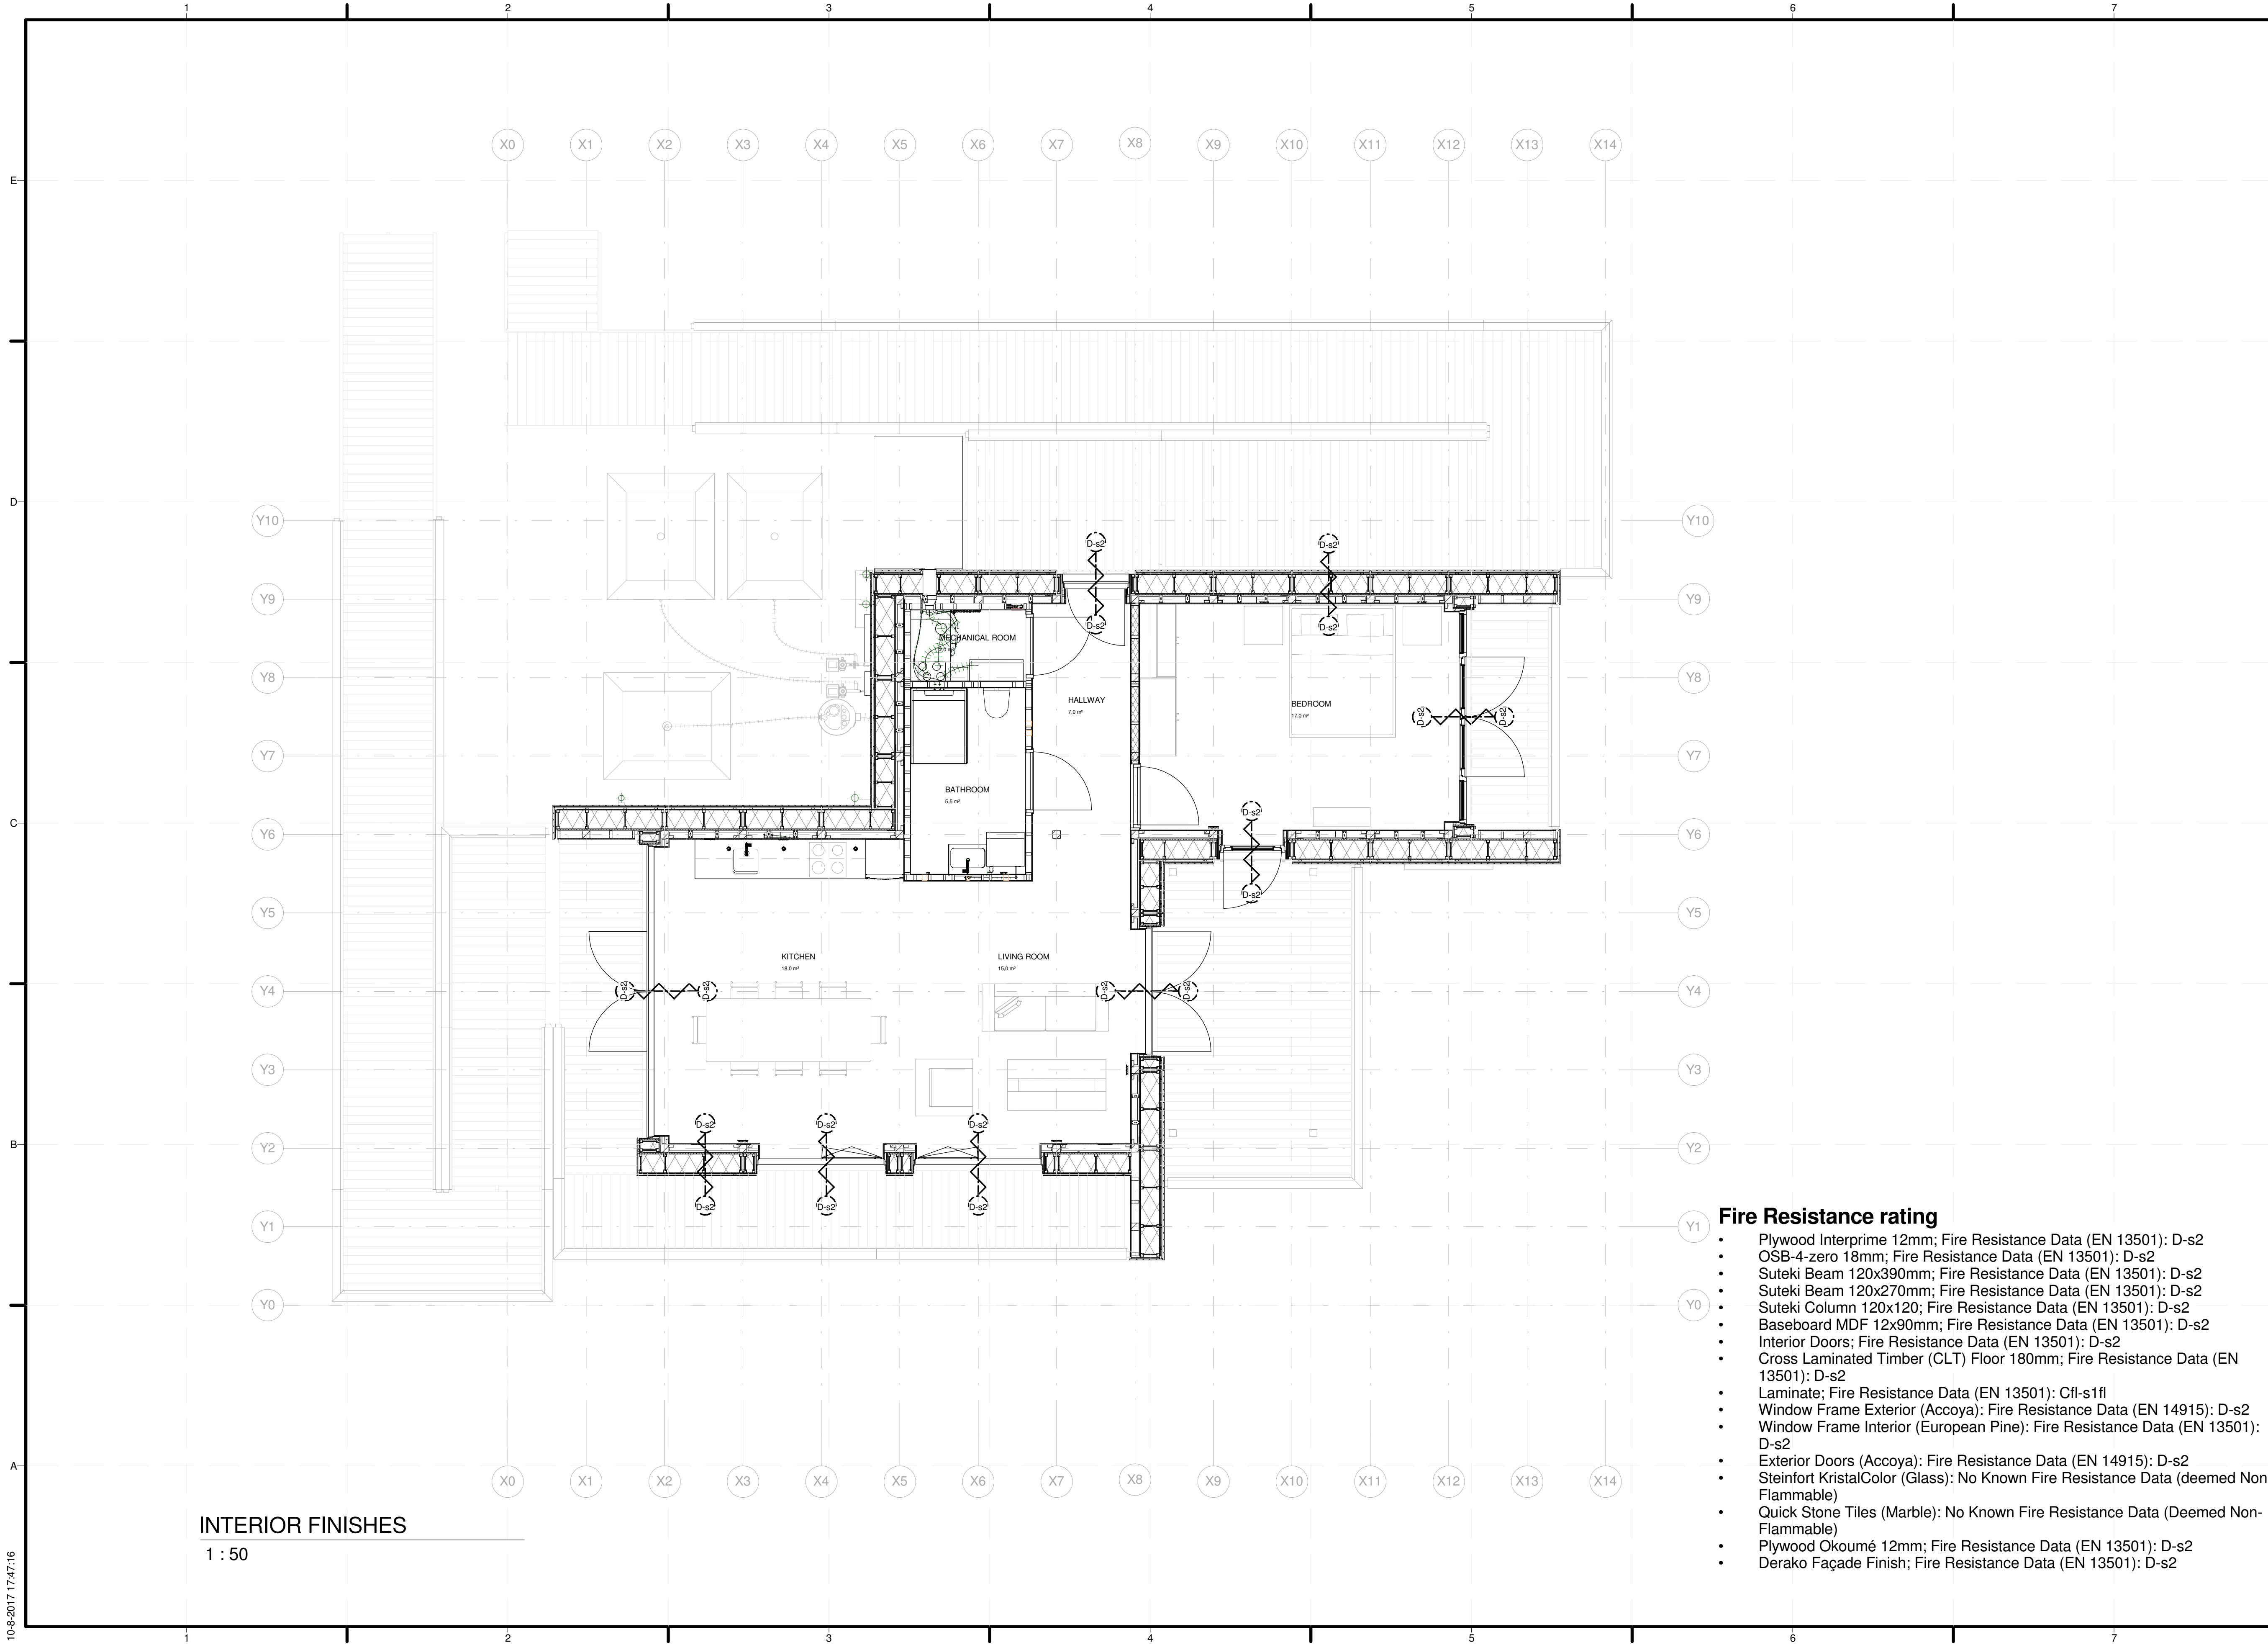

INTERIOR FINISHES

1 : 50

10-8-2017 17:47:16



TEAM NAME: Selficient
 ADDRESS: Padualaan 99
 3584 CH Utrecht
 CONTACT: info@selficient.org
 www.selficient.org

CONSULTANTS
 FANTASTIC ARCHITECTURE
 AMAZING ENGINEERS
 PERFECT LANDSCAPING
 SAFETY FIRST CODE CONSULTANTS

CLIENT
 U.S. DEPARTMENT OF ENERGY
 SOLAR DECATHLON 2013
 WWW.SOLARDECATHLON.GOV



MARK	DATE	DESCRIPTION


LOT NUMBER:	106
DRAWN BY:	Author
CHECKED BY:	Checker
COPYRIGHT:	NONE; PROJECT IS PUBLIC DOMAIN

SHEET TITLE
INTERIOR FINISHES

I-200


Fire Resistance rating

- Plywood Interprime 12mm; Fire Resistance Data (EN 13501): D-s2
- OSB-4-zero 18mm; Fire Resistance Data (EN 13501): D-s2
- Suteki Beam 120x390mm; Fire Resistance Data (EN 13501): D-s2
- Suteki Beam 120x270mm; Fire Resistance Data (EN 13501): D-s2
- Suteki Column 120x120; Fire Resistance Data (EN 13501): D-s2
- Baseboard MDF 12x90mm; Fire Resistance Data (EN 13501): D-s2
- Interior Doors; Fire Resistance Data (EN 13501): D-s2
- Cross Laminated Timber (CLT) Floor 180mm; Fire Resistance Data (EN 13501): D-s2
- Laminate; Fire Resistance Data (EN 13501): Cfl-s1fl
- Window Frame Exterior (Accoya); Fire Resistance Data (EN 14915): D-s2
- Window Frame Interior (European Pine); Fire Resistance Data (EN 13501): D-s2
- Exterior Doors (Accoya); Fire Resistance Data (EN 14915): D-s2
- Steinfot KristalColor (Glass); No Known Fire Resistance Data (deemed Non-Flammable)
- Quick Stone Tiles (Marble); No Known Fire Resistance Data (Deemed Non-Flammable)
- Plywood Okoumé 12mm; Fire Resistance Data (EN 13501): D-s2
- Derako Façade Finish; Fire Resistance Data (EN 13501): D-s2

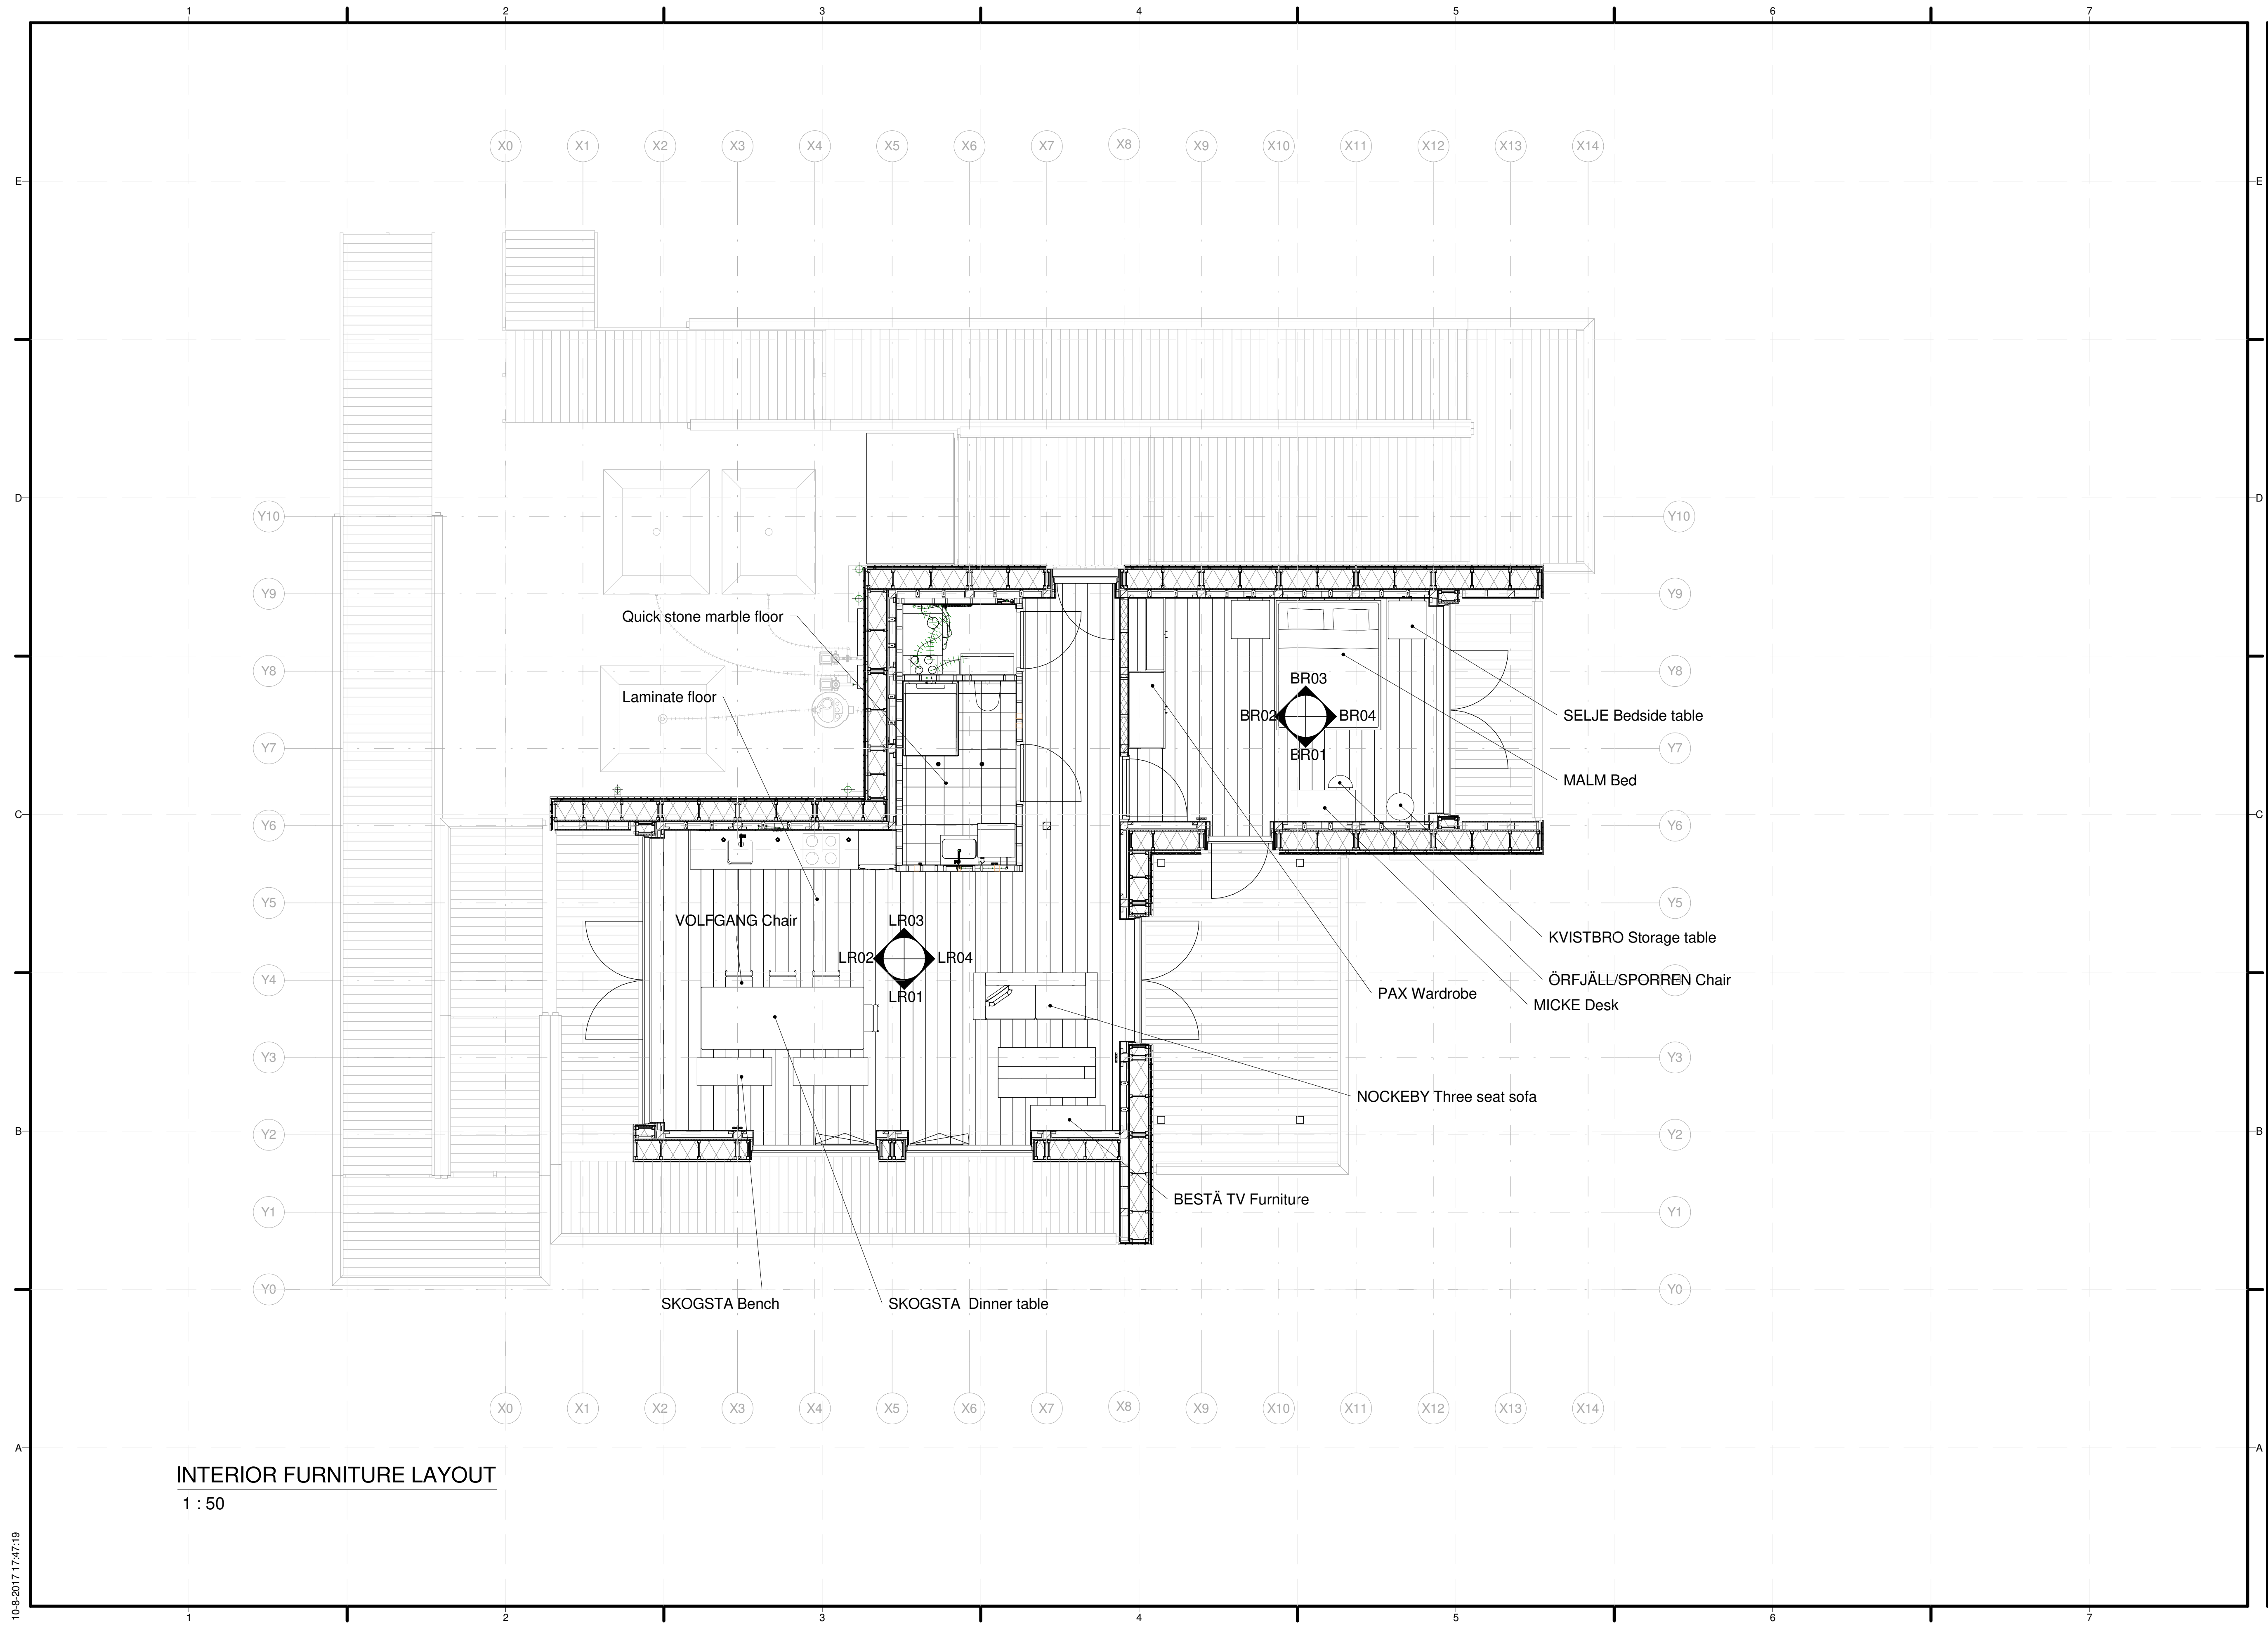

TEAM NAME: Selficient
 ADDRESS: Padualaan 99
 3584 CH Utrecht
 CONTACT: info@selficient.org
 www.selficient.org

CONSULTANTS
 FANTASTIC ARCHITECTURE
 AMAZING ENGINEERS
 PERFECT LANDSCAPING
 SAFETY FIRST CODE CONSULTANTS

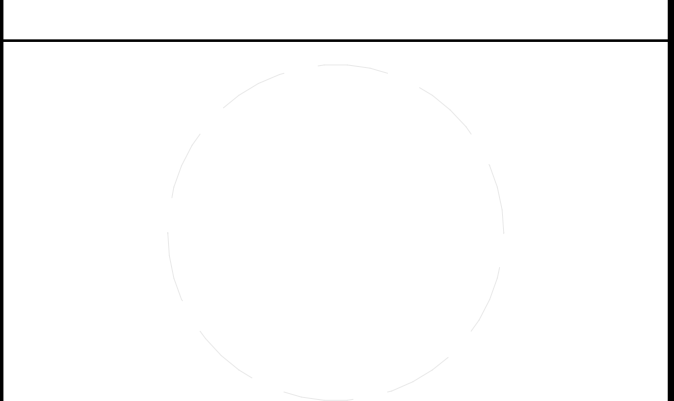

CLIENT
 U.S. DEPARTMENT OF ENERGY
 SOLAR DECATHLON 2013
 WWW.SOLARDECATHLON.GOV




MARK	DATE	DESCRIPTION

SHEET TITLE

INTERIOR FURNITURE LAYOUT

I-201

INTERIOR FURNITURE LAYOUT
 1 : 50

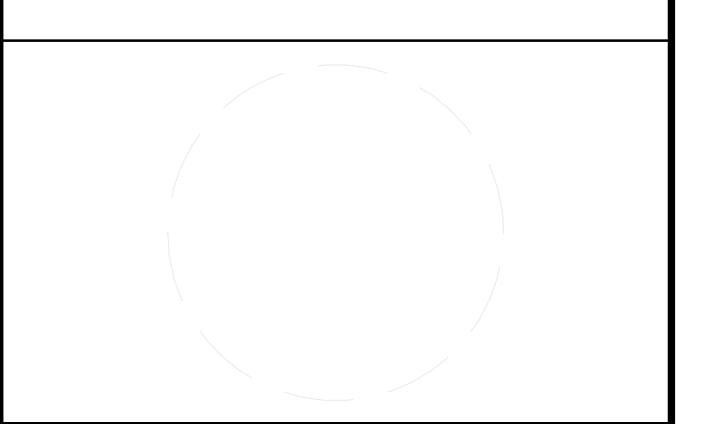









MARK	DATE	DESCRIPTION
0	17-11-2016	90% revision

LOT NUMBER: 106
 DRAWN BY: Author
 CHECKED BY: Selficient
 COPYRIGHT: NONE; PROJECT IS PUBLIC DOMAIN

SCALE: 1 : 50
 SHEET TITLE

INTERIOR ELEVATIONS

I-300

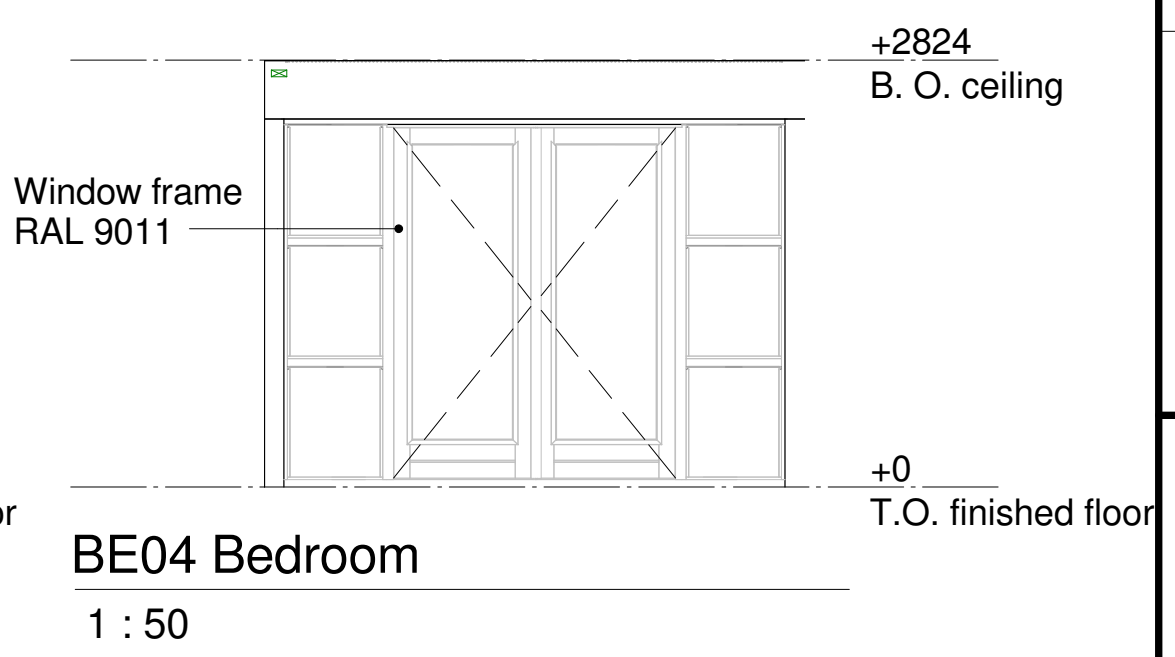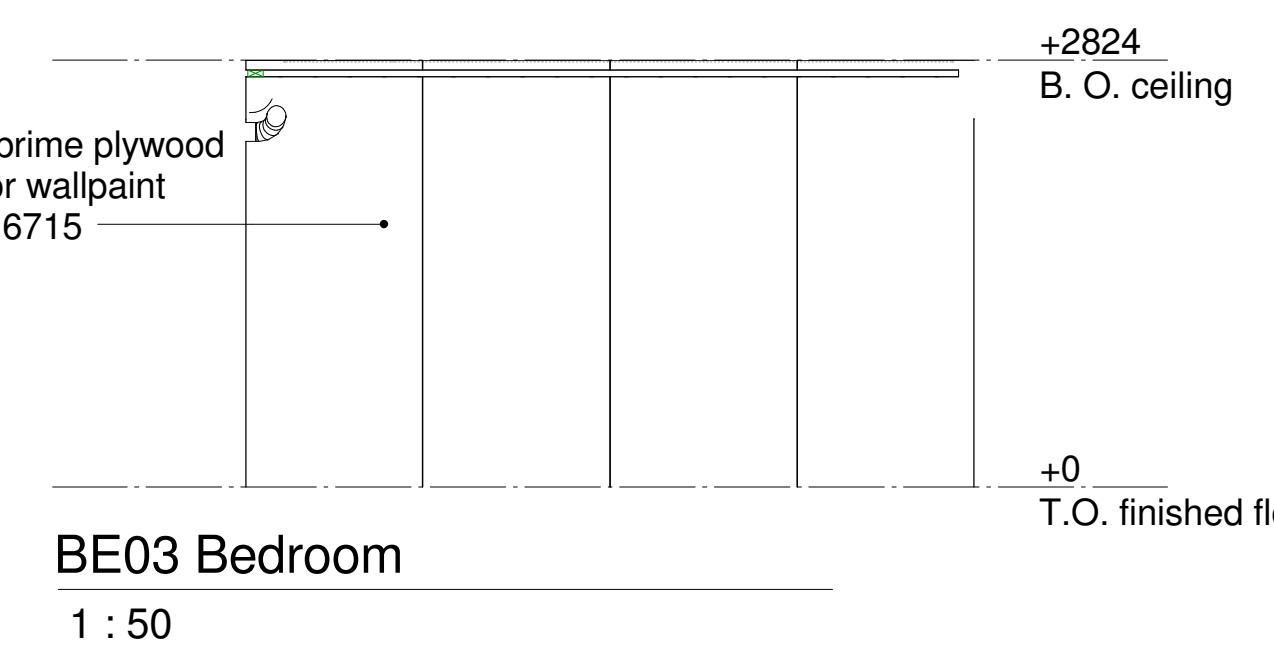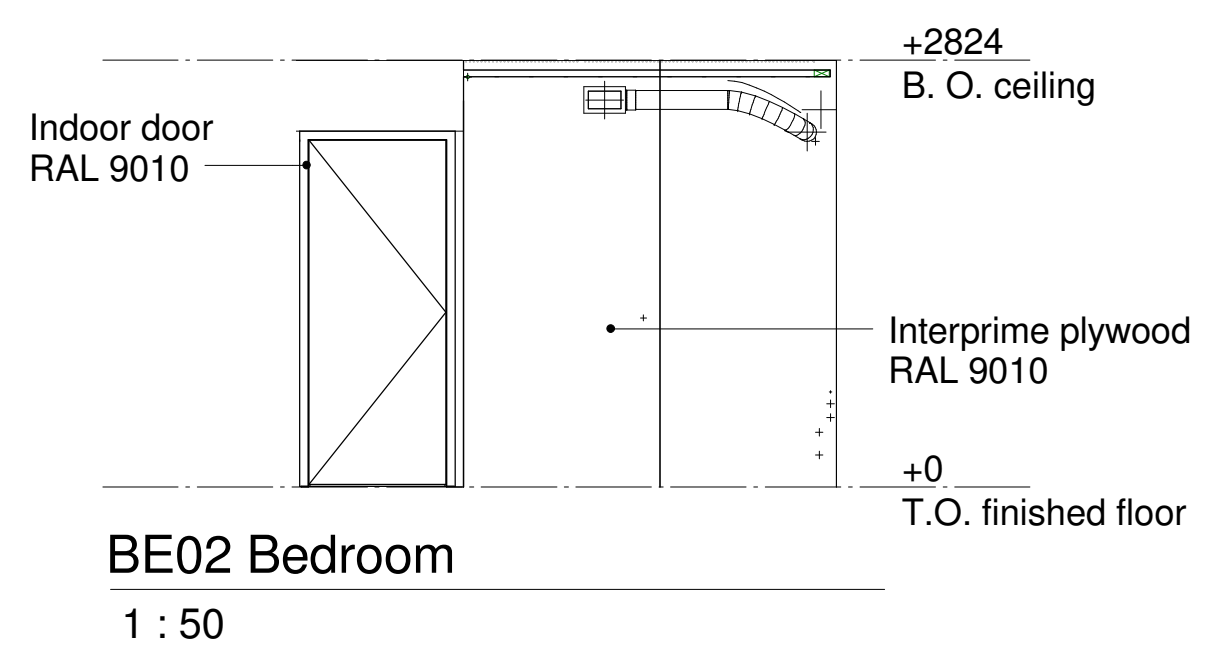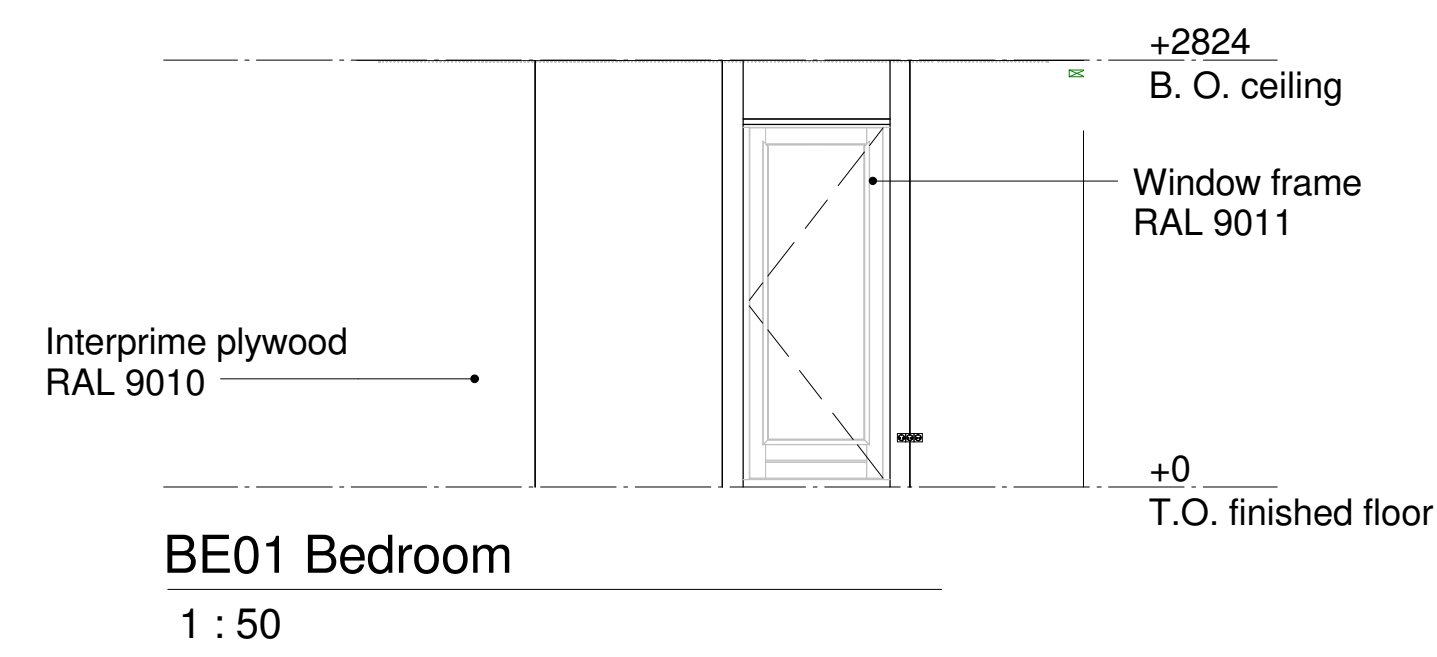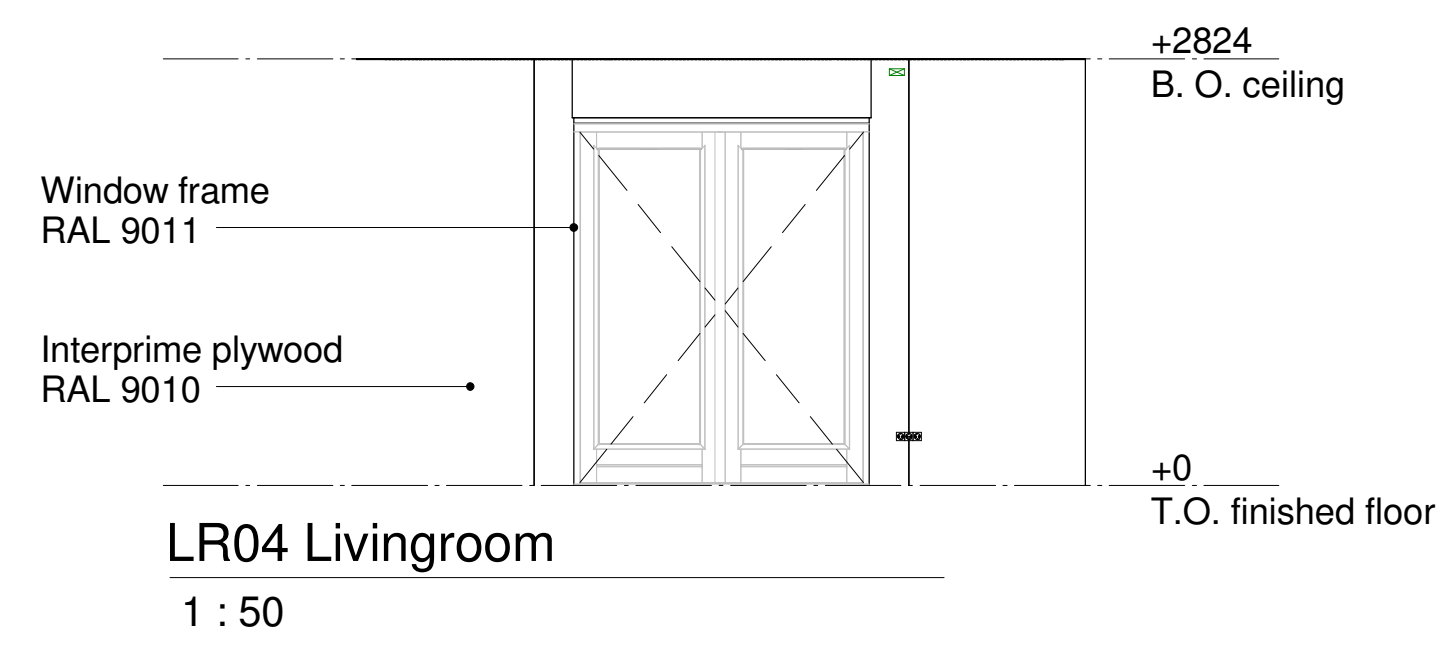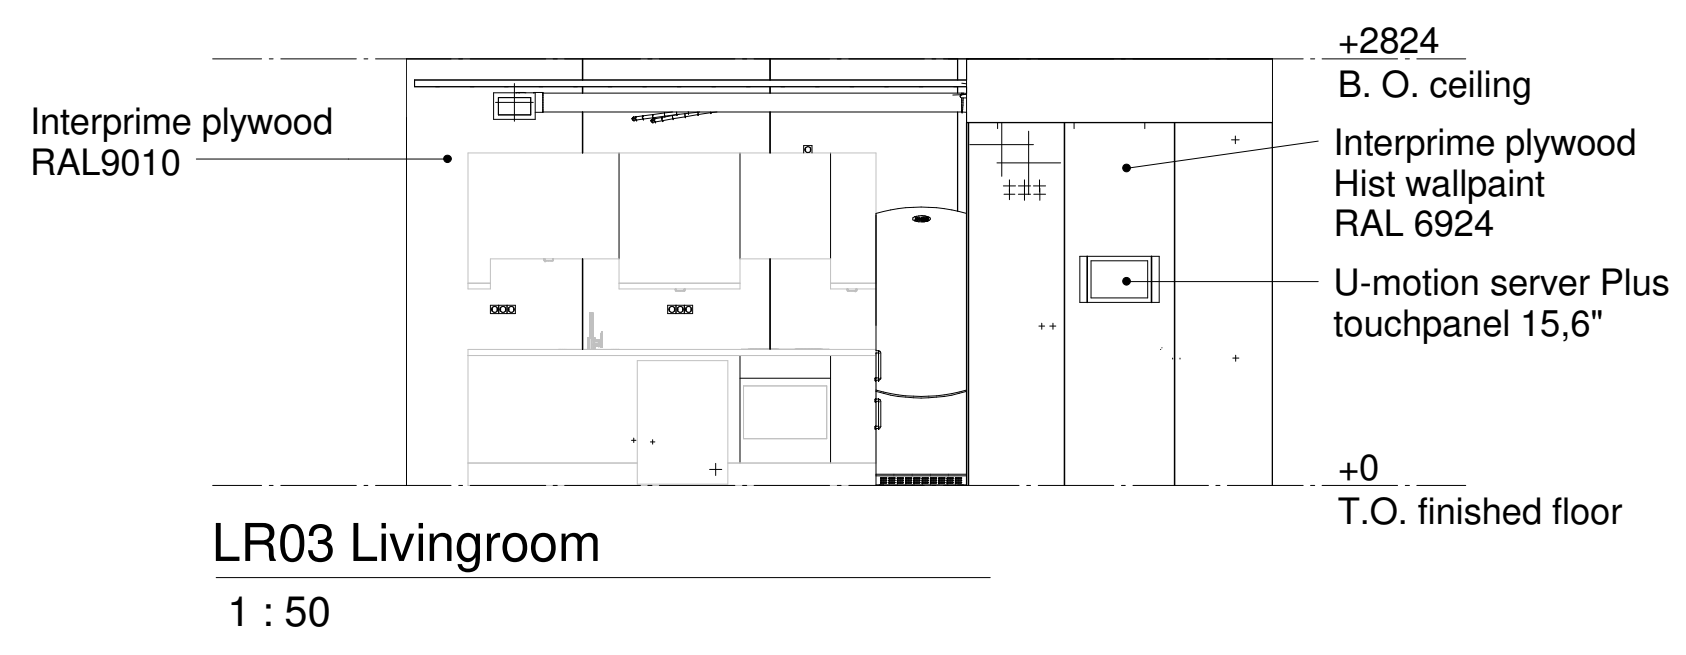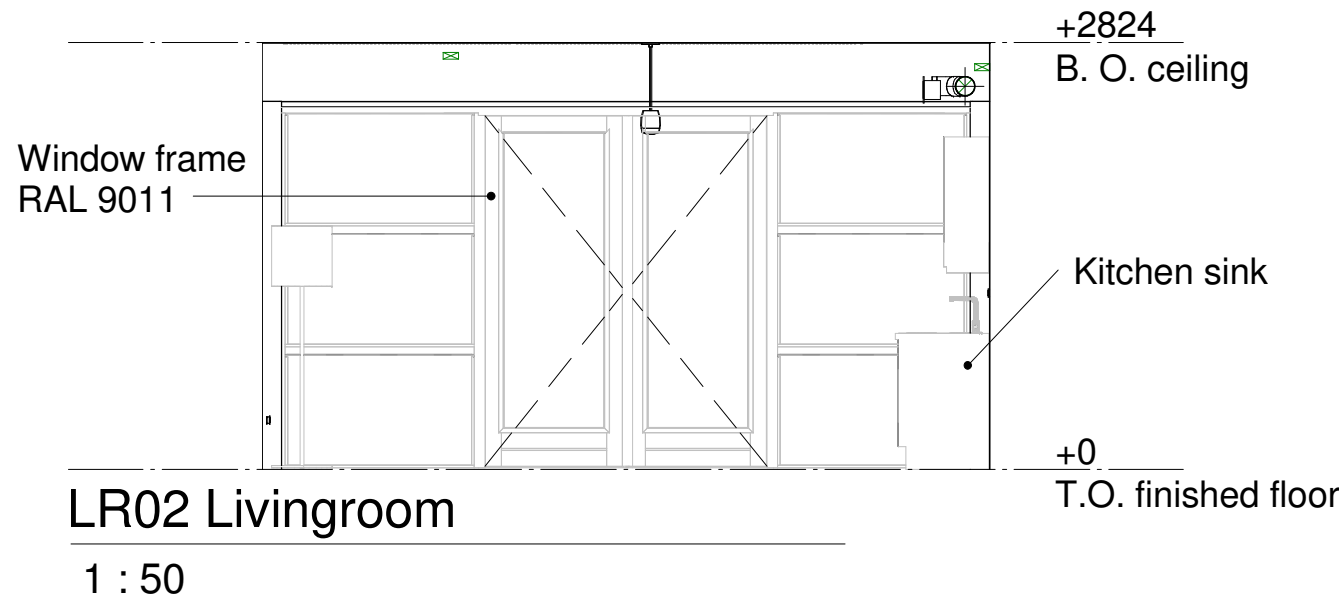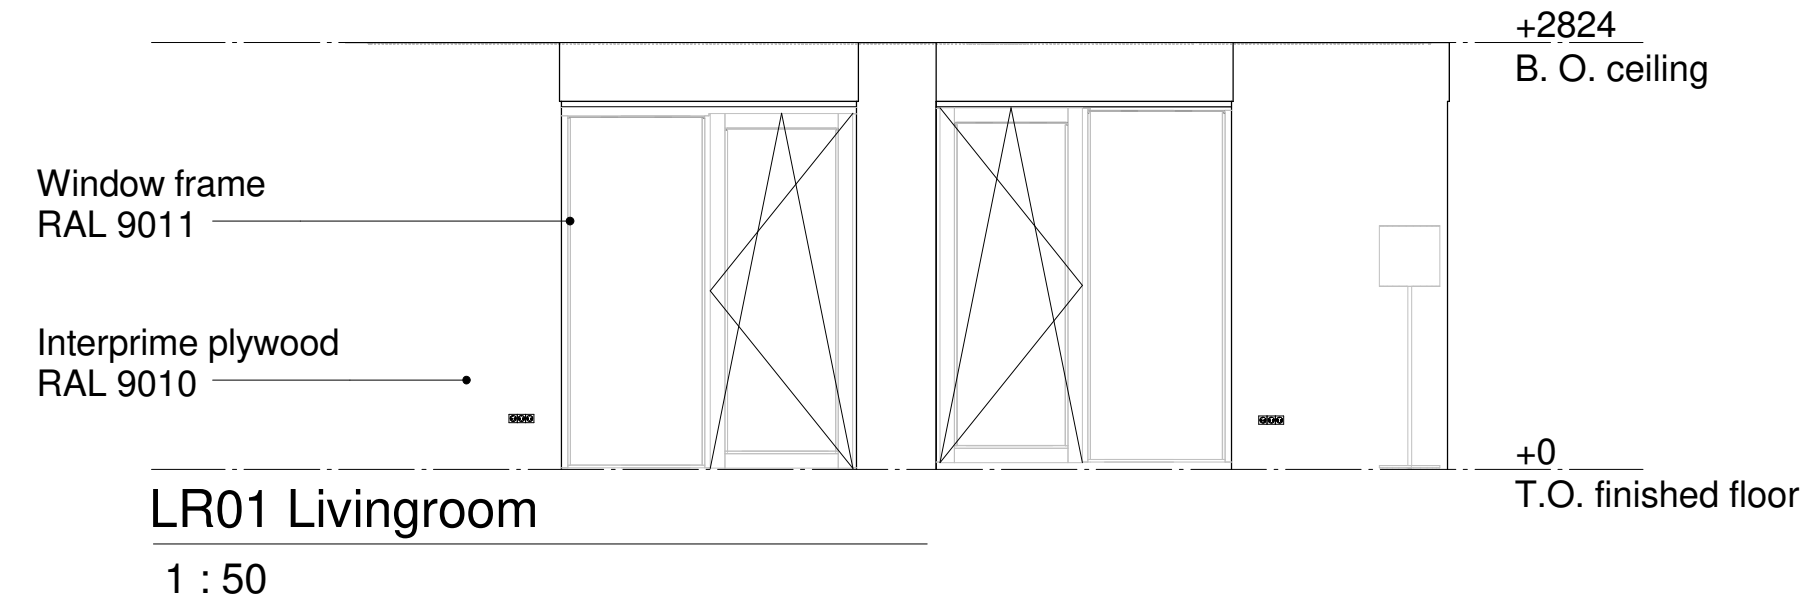

Building Code & Mechanical notes

SD 2017 Buildingcode 11-02-2016 Building Planning and Construction Section 3.0

3-1 Fire protection and Prevention.

a. Fire Protection Plan

Each team shall provide a fire protection plan. This plan shall indicate the location of fire extinguishers, how egress will be made from the unit, and who will be responsible (i.e., the team's health and safety officer) for public-tour fire safety during the event. A written operations plan for team-facilitated orderly and quick evacuation and fire mitigation shall be included. Successful demonstration of the plan shall be required before any public tour of the building will be permitted.

b. Each house shall be required to have smoke alarms per IRC requirements and a fire extinguisher with a minimum Underwriters Laboratory (UL) rating of 2A-10BC. Smoke alarms shall be connected to the AC voltage side of the inverter and provided with independent power, i.e., battery backup integral with the alarm. All alarms shall be interconnected and all shall sound when one is activated (IRC, Sec. R314).

c. Carbon monoxide alarms are required for houses provided with fuel burning appliances or attached garages. Fuel burning appliances are prohibited per Solar Decathlon rules. Carbon monoxide alarms shall be required per IRC Section R315 for any attached garage, even those used exclusively for an electrical vehicle.

3-11 Fire Sprinkler System.

2015 IRC Section R313 requires fire-suppression sprinkler systems in all single-family dwellings. All buildings shall be provided with fire sprinklers designed in accordance with IRC Section P2904 or NFPA 13D. Such systems shall be fully operational during the public exhibit and competition. Each dwelling shall be individually required to provide site-stored fire water for sprinkler operations based on the sprinkler system design demand plus any residual volume necessary to keep the pump primed. Each dwelling's sprinkler shall be required to be provided with a pump capable of the pressure and volume required for the fire sprinkler design. The pump shall be mounted on a portable skid and shall be pretested and demonstrated to be functional at the minimum required fire sprinkler design pressure prior to arriving at the event site. Pumps used for fire sprinklers may be dedicated to the fire sprinkler system or may be used for both domestic and fire system purposes. All valves provided between the fire water supply source and each individual fire sprinkler shall be of a type that can be locked in the open (on) position. Teams shall provide the means to ensure that the valves are locked open during the duration of the public exhibit.

A test and drain valve shall be placed in an accessible location at the most remote point of the sprinkler system. This valve will be used to assist in charging the system with water, and will be operated by the team during the inspection period to demonstrate that the sprinkler system is charged and that the pump used for sprinkler pressurization is operating correctly.

SD 2017 DD Guidance 2016-09-09 Fire Protection

The International Residential Code ensures the safety of students and the general public through a combination of active and passive fire protection features.

Surface Spread of Flame and Accelerated Combustion Potential

IRC Section R302.9 regulates flame spread and smoke development. All wall and ceiling finishes must meet a minimum flame spread of 200 and SD of 450 using the ASTM E84 test methodology. Plywood and other wood finishes (other than window, door, baseboard, and chair rail trim) must comply with these requirements. If an outer plywood veneer is less than 1/28" (0.91mm) (common for most hardwood surfaced plywood materials), then the core materials will be regulated. Fabrics and other adhered wall coverings must also be demonstrated to pass the ASTM E84 test if they exceed 1/28" (0.91mm) thickness.

Active Fire Protection

- FIRE SPRINKLER SYSTEM: Provide FULL details on the MANDATORY fire sprinkler system. This should be provided in accordance with IRC Section P2904 or NFPA 13-D. Indicate source of team provided water supply for operation of the system while placed on temporary display. Provide diagram from water supply tank, to the pump, to the riser, and to the branch piping. The diagram should state pipe diameters and materials used. Provide a cut sheet for the sprinkler head(s) selected. Indicate the minimum pump pressure setting necessary for minimum operation pressure. Provide a reflected ceiling plan with all sprinkler heads indicated in relation to below ceiling level mounted luminaires, ceiling fans, beams, soffits or other potential obstructions. Indicate any heat producing sources such as HVAC heating vents, ranges and ovens. Indicate head offset distances to be provided.
- SMOKE ALARM LOCATIONS: Smoke alarms are required in all sleeping areas and at point immediately outside the sleeping areas. IRC Section R313.4 requires the alarms to be installed in accordance with NFPA 72. Nearly all US produced smoke alarms contain instructions based on NFPA 72 criteria. Pay particular attention to placement of the detectors relative to the intersection between the wall and the ceiling.
- SMOKE ALARM POWER REQUIREMENTS: Smoke alarms shall have their primary power source from the AC side of the inverters. Internal battery back-up shall be provided internal to the detection device. Combination household fire alarm systems shall be specifically approved prior to installation. Please provide full details on any system proposed OTHER THAN interconnected single station smoke alarms.

2015 International Residential Code Chapter 29 Water supply and distribution

P2904.1 General.

The design and installation of residential fire sprinkler systems shall be in accordance with NFPA 13D or Section P2904, which shall be considered equivalent to NFPA 13D. Partial residential sprinkler systems shall be permitted to be installed only in buildings not required to be equipped with a residential sprinkler system. Section P2904 shall apply to stand-alone and multipurpose wet-pipe sprinkler systems that do not include the use of antifreeze. A multipurpose fire sprinkler system shall provide domestic water to both fire sprinklers and plumbing fixtures. A stand-alone sprinkler system shall be separate and independent from the water distribution system. A backflow preventer shall not be required to separate a stand-alone sprinkler system from the water distribution system, merit of the detectors relative to the intersection between the wall and the ceiling.

- SMOKE ALARM POWER REQUIREMENTS: Smoke alarms shall have their primary power source from the AC side of the inverters. Internal battery back-up shall be provided internal to the detection device. Combination household fire alarm systems shall be specifically approved prior to installation. Please provide full details on any system proposed OTHER THAN interconnected single station smoke alarms.

P2904.1.1 Required sprinkler locations.

Sprinklers shall be installed to protect all areas of a dwelling unit.

- Exceptions:
- Attics, crawl spaces and normally unoccupied concealed spaces that do not contain fuel-fired appliances do not require sprinklers. In attics, crawl spaces and normally unoccupied concealed spaces that contain fuel-fired equipment, a sprinkler shall be installed above the equipment; however, sprinklers shall not be required in the remainder of the space.
 - Clothes closets, linen closets and pantries not exceeding 24 square feet (2.2 m²) in area, with the smallest dimension not greater than 3 feet (915 mm) and having wall and ceiling surfaces of gypsum board.
 - Bathrooms not more than 55 square feet (5.1 m²) in area.
 - Garages; carports; exterior porches; unheated entry areas, such as mud rooms, that are adjacent to an exterior door; and similar areas.

P2904.2 Sprinklers.

Sprinklers shall be new listed residential sprinklers and shall be installed in accordance with the sprinkler manufacturer's instructions.

P2904.2.1 Temperature rating and separation from heat sources.

Except as provided for in Section P2904.2.2, sprinklers shall have a temperature rating of not less than 135°F (57°C) and not more than 170°F (77°C). Sprinklers shall be separated from heat sources as required by the sprinkler manufacturer's installation instructions.

P2904.2.2 Intermediate temperature sprinklers.

Sprinklers shall have an intermediate temperature rating not less than 175°F (79°C) and not more than 225°F (107°C) where installed in the following locations:

- Directly under skylights, where the sprinkler is exposed to direct sunlight.
- In attics.
- In concealed spaces located directly beneath a roof.
- Within the distance to a heat source as specified in Table P2904.2.2.

TABLE P2904.2.2 LOCATIONS WHERE INTERMEDIATE TEMPERATURE SPRINKLERS ARE REQUIRED

HEAT SOURCE	RANGE OF DISTANCE FROM HEAT SOURCE WITHIN WHICH INTERMEDIATE TEMPERATURE SPRINKLERS ARE REQUIRED (ft./inches)			
	40 or less	41 to 75	76 to 100	101 to 150
Hearth, side of open or recessed fireplace	12 to 36			
Hearth, front of recessed fireplace	36 to 60			
Coal and wood burning stove	12 to 42			
Kitchen range top	9 to 18			
Oven	9 to 18			
Vent connector or chimney connector	9 to 18			
Heating duct, not insulated	9 to 18			
Hot water pipe, not insulated	6 to 12			
Side of ceiling or wall warm air register	12 to 24			
Front of wall mounted warm air register	18 to 36			
Water heater, furnace or boiler	3 to 6			
Luminaire up to 250 watts	3 to 6			
Luminaire 250 watts up to 499 watts	6 to 12			

P2904.2.3 Freezing areas.

Piping shall be protected from freezing as required by Section P2603.6. Where sprinklers are required in areas that are subject to freezing, dry-side-wall or dry-pendent sprinklers extending from a nonfreezing area into a freezing area shall be installed.

P2904.2.4 Sprinkler coverage.

Sprinkler coverage requirements and sprinkler obstruction requirements shall be in accordance with Sections P2904.2.4.1 and P2904.2.4.2.

P2904.2.4.1 Coverage area limit.

The area of coverage of a single sprinkler shall not exceed 400 square feet (37 m²) and shall be based on the sprinkler listing and the sprinkler manufacturer's installation instructions.

P2904.4.1 Determining required flow rate for each sprinkler.

The minimum required flow rate for each sprinkler shall be determined using the sprinkler manufacturer's published data for the specific sprinkler model based on all of the following:

- The area of coverage.
- The ceiling configuration.
- The temperature rating.
- Any additional conditions specified by the sprinkler manufacturer.

P2904.4.2 System design flow rate.

The design flow rate for the system shall be based on the following:

- The design flow rate for a room having only one sprinkler shall be the flow rate required for that sprinkler, as determined by Section P2904.4.1.
- The design flow rate for a room having two or more sprinklers shall be determined by identifying the sprinkler in that room with the highest required flow rate, based on Section P2904.4.1, and multiplying that flow rate by 2.
- Where the sprinkler manufacturer specifies different criteria for ceiling configurations that are not smooth, flat and horizontal, the required flow rate for that room shall comply with the sprinkler manufacturer's instructions.
- The design flow rate for the sprinkler system shall be the flow required by the room with the largest flow rate, based on Items 1, 2 and 3.
- For the purpose of this section, it shall be permissible to reduce the design flow rate for a room by subdividing the space into two or more rooms, where each room is evaluated separately with respect to the required design flow rate. Each room shall be bounded by walls and a ceiling. Openings in walls shall have a lintel not less than 8 inches (203 mm) in depth and each lintel shall form a solid barrier between the ceiling and the top of the opening.

P2904.5 Water supply.

The water supply shall provide not less than the required design flow rate for sprinklers in accordance with Section P2904.4.2 at a pressure not less than that used to comply with Section P2904.6.

P2904.5.1 Water supply from individual sources.

Where a dwelling unit water supply is from a tank system, a private well system or a combination of these, the available water supply shall be based on the minimum pressure control setting for the pump.

P2904.5.2 Required capacity.

The water supply shall have the capacity to provide the required design flow rate for sprinklers for a period of time as follows:

- Seven minutes for dwelling units one story in height and less than 2,000 square feet (186 m²) in area.
 - Ten minutes for dwelling units two or more stories in height or equal to or greater than 2,000 square feet (186 m²) in area.
- Where a well system, a water supply tank system or a combination thereof is used, any combination of well capacity and tank storage shall be permitted to meet the capacity requirement.

Water need for 10min of sprinkling.

Waterneed = 10min * (number of sprinklers * Flow of one sprinkler)
Waterneed = 10min * (2 * 13GPM)
Waterneed = 260G (984.2L)

Waterneed = 260G (984.2L) * safety
Waterneed = 260G (984.2L) * 20%
Waterneed = 312G (1180.8L)

Min flow pump

Min flow pump = number of sprinklers * flow one sprinkler
Min flow pump = 2 * 13 GPM (49.2 L/min)
Min flow pump = 26GPM (98.42 L/min)

P2904.6.1 Method of sizing pipe.

Piping supplying sprinklers shall be sized using the prescriptive method in Section P2904.6.2 or by hydraulic calculation in accordance with NFPA 13D. The minimum pipe size from the water supply source to any sprinkler shall be 3/4 inch (19 mm) nominal. Threaded adapter fittings at the point where sprinklers are attached to the piping shall be not less than 1/2 inch (13 mm) nominal.

P2904.6.2 Prescriptive pipe sizing method.

Pipe shall be sized by determining the available pressure to offset friction loss in piping and identifying a piping material, diameter and length using the equation in Section P2904.6.2.1 and the procedure in Section P2904.6.2.2.

TABLE P2904.6.2(1) WATER SERVICE PRESSURE LOSS (PLsvca), b Pipe shall be sized

FLOW RATE (gpm)	3/4-INCH WATER SERVICE PRESSURE LOSS (psi)				1-INCH WATER SERVICE PRESSURE LOSS (psi)				1 1/4-INCH WATER SERVICE PRESSURE LOSS (psi)			
	Length of water service pipe (feet)				Length of water service pipe (feet)				Length of water service pipe (feet)			
	40 or less	41 to 75	76 to 100	101 to 150	40 or less	41 to 75	76 to 100	101 to 150	40 or less	41 to 75	76 to 100	101 to 150
8	5.1	8.7	11.8	17.4	1.5	2.5	3.4	5.1	0.6	1.0	1.3	1.9
10	7.7	13.1	17.8	26.3	2.3	3.8	5.2	7.7	0.8	1.4	2.0	2.9
12	10.8	18.4	24.9	NP	3.2	5.4	7.3	10.7	1.2	2.0	2.7	4.0
14	14.4	24.5	NP	NP	4.2	7.1	9.6	14.3	1.6	2.7	3.6	5.4
16	18.4	NP	NP	NP	5.4	9.1	12.4	18.3	2.0	3.4	4.7	6.9
18	22.9	NP	NP	NP	6.7	11.4	15.4	22.7	2.5	4.3	5.8	8.6
20	27.8	NP	NP	NP	8.1	13.8	18.7	27.6	3.1	5.2	7.0	10.4
22	NP	NP	NP	NP	9.7	16.5	22.3	NP	3.7	6.2	8.4	12.4
24	NP	NP	NP	NP	11.4	19.3	26.2	NP	4.3	7.3	9.9	14.6
26	NP	NP	NP	NP	13.2	22.4	NP	NP	5.0	8.5	11.4	16.9
28	NP	NP	NP	NP	15.1	25.7	NP	NP	5.7	9.7	13.1	19.4
30	NP	NP	NP	NP	17.2	NP	NP	NP	6.5	11.0	14.9	22.0
32	NP	NP	NP	NP	19.4	NP	NP	NP	7.3	12.4	16.8	24.8
34	NP	NP	NP	NP	21.7	NP	NP	NP	8.2	13.9	18.8	NP
36	NP	NP	NP	NP	24.1	NP	NP	NP	9.1	15.4	20.9	NP

TABLE P2904.6.2(2) MINIMUM WATER METER PRESSURE LOSS (PLm)a

FLOW RATE (gallons per minute, gpm)	5/8-INCH METER PRESSURE LOSS (pounds per square inch, psi)	3/4-INCH METER PRESSURE LOSS (pounds per square inch, psi)	1-INCH METER PRESSURE LOSS (pounds per square inch, psi)
	LESS (pounds per square inch, psi)	LESS (pounds per square inch, psi)	LESS (pounds per square inch, psi)
8	2	1	1
10	3	1	1
12	4	1	1
14	5	2	1
16	7	3	1
18	9	4	1
20	11	4	2
22	NP	5	2
24	NP	5	2
26	NP	6	2
28	NP	6	2
30	NP	7	2
32	NP	7	3
34	NP	8	3
36	NP	8	3

TABLE P2904.6.2(3) ELEVATION LOSS (PLe)

ELEVATION (feet)	PRESSURE LOSS (psi)
5	2.2
10	4.4
15	6.5
20	8.7
25	10.9
30	13
35	15.2
40	17.4

TABLE P2904.6.2(5) ALLOWABLE PIPE LENGTH FOR 1-INCH TYPE M COPPER WATER TUBING

SPRINKLER	WATER	AVAILABLE PRESSURE—Pt (psi)									
		15	20	25	30	35	40	45	50	55	60
8	1	806	1075	1343	1612	1881	2149	2418	2687	2955	3224
9	1	648	864	1080	1296	1512	1728	1945	2161	2377	2593
10	1	533	711	889	1067	1245	1422	1600	1778	1956	2134
11	1	447	586	745	894	1043	1192	1341	1491	1640	1789
12	1	381	508	634	761	888	1015	1142	1269	1396	1523
13	1	328	438	547	657	766	875	985	1094	1204	1313
14	1	286	382	477	572	668	763	859	954	1049	1145
15	1	252	336	420	504	588	672	756	840	924	1008
16	1	224	298	373	447	522	596	671	745	820	894
17	1	200	266	333	400	466	533	600	666	733	799
18	1	180	240	300	360	420	479	539	599	659	719
19	1	163	217	271	325	380	434	488	542	597	651
20	1	148	197	247	296	345	395	444	493	543	592

P2904.6.2.1 Available pressure equation.

The pressure available to offset friction loss in the interior piping system (Pt) shall be determined in accordance with the Equation 29-1.

$$Pt = Psub * PLsv * PLm * PLd * PLe * Psp \quad (29-1)$$

where:

- Pt = Pressure used in applying Tables P2904.6.2(4) through P2904.6.2(9).
- Psp = Pressure available from the water supply source.
- PLsv = Pressure loss in the water-service pipe.
- PLm = Pressure loss in the water meter.
- PLd = Pressure loss from devices other than the water meter.
- PLe = Pressure loss associated with changes in elevation.
- Psp = Maximum pressure required by a sprinkler.

P2904.6.2.2 Calculation procedure.

Determination of the required size for water distribution piping shall be in accordance with the following procedure:

Step 1—Determine Psp

Obtain the static supply pressure that will be available from the water main from the water purveyor, or for an individual source, the available supply pressure shall be in accordance with Section P2904.5.1.

Psub will be 0 psi according to the pump (Grundfos CMBE 10-27)

Step 2—Determine PLsv

Use Table P2904.6.2(1) to determine the pressure loss in the water service pipe based on the selected size of the water service.

According to Table P2904.6.2(1) the psi will be 7.1.

Step 3—Determine PLm
Use Table P2904.6.2(2) to determine the pressure loss from the water meter, based on the selected water meter size.

According to table P2904.6.2(2) the pressure loss will be 1 psi.

Step 4—Determine PLd

Determine the pressure loss from devices other than the water meter installed in the piping system supplying sprinklers, such as pressure-reducing valves, backflow preventers, water softeners or water filters. Device pressure losses shall be based on the device manufacturer's specifications. The flow rate used to determine pressure loss shall be the rate from Section P2904.4.2 except that 5 gpm (0.3 L/s) shall be added where the device is installed in a water-service pipe that supplies more than one dwelling. As an alternative to deducting pressure loss from a device, an automatic bypass valve shall be installed to divert flow around the device when a sprinkler activates.

There won't be filters installed.

Step 5—Determine PLe

Use Table P2904.6.2(3) to determine the pressure loss associated with changes in elevation. The elevation used in applying the table shall be the difference between the elevation where the water source pressure was measured and the elevation of the highest sprinkler.

The elevation loss in the system will be 4.4 psi.

Step 6—Determine Psp

Determine the maximum pressure required by any individual sprinkler based on the flow rate from Section P2904.4.1. The required pressure is provided in the sprinkler manufacturer's published data for the specific sprinkler model based on the selected flow rate.

The sprinkler that will be used needs a minimum of 9.1psi.

Step 7—Calculate Pt

Using Equation 29-1, calculate the pressure available to offset friction loss in water-distribution piping between the service valve and the sprinklers.

Using the equation 29-1 the answer will be 284.28. The outcome of this equation will be put in 2904.6.2(5). Now you can see that the available pressure that will be needed for the sprinkler will be less than 15 Psi (1.03 bar).

Step 8—Determine the maximum allowable pipe length


Use Tables P2904.6.2(4) through P2904.6.2(9) to select a material and size for water distribution piping. The piping material and size shall be acceptable if the developed length of pipe between the service valve and the most remote sprinkler does not exceed the maximum allowable length specified by the applicable table. Interpolation of Pt between the tabular values shall be permitted.

The maximum allowable length of piping in Tables P2904.6.2(4) through P2904.6.2(9) incorporates an adjustment for pipe fittings. Additional consideration of friction losses associated with pipe fittings shall not be required.

P2904.7 Instructions and signs.

An owner's manual for the fire sprinkler system shall be provided to the owner. A sign or valve tag shall be installed at the main shutoff valve to the water distribution system stating the following: "Warning, the water system for this home supplies fire sprinklers that require certain flows and pressures to fight a fire. Devices that restrict the flow or decrease the pressure or automatically shut off the water to the fire sprinkler system, such as water softeners, filtration systems and automatic shutoff valves, shall not be added to this system without a review of the fire sprinkler system by a fire protection specialist. Do not remove this sign."

P2904.8 Inspections.

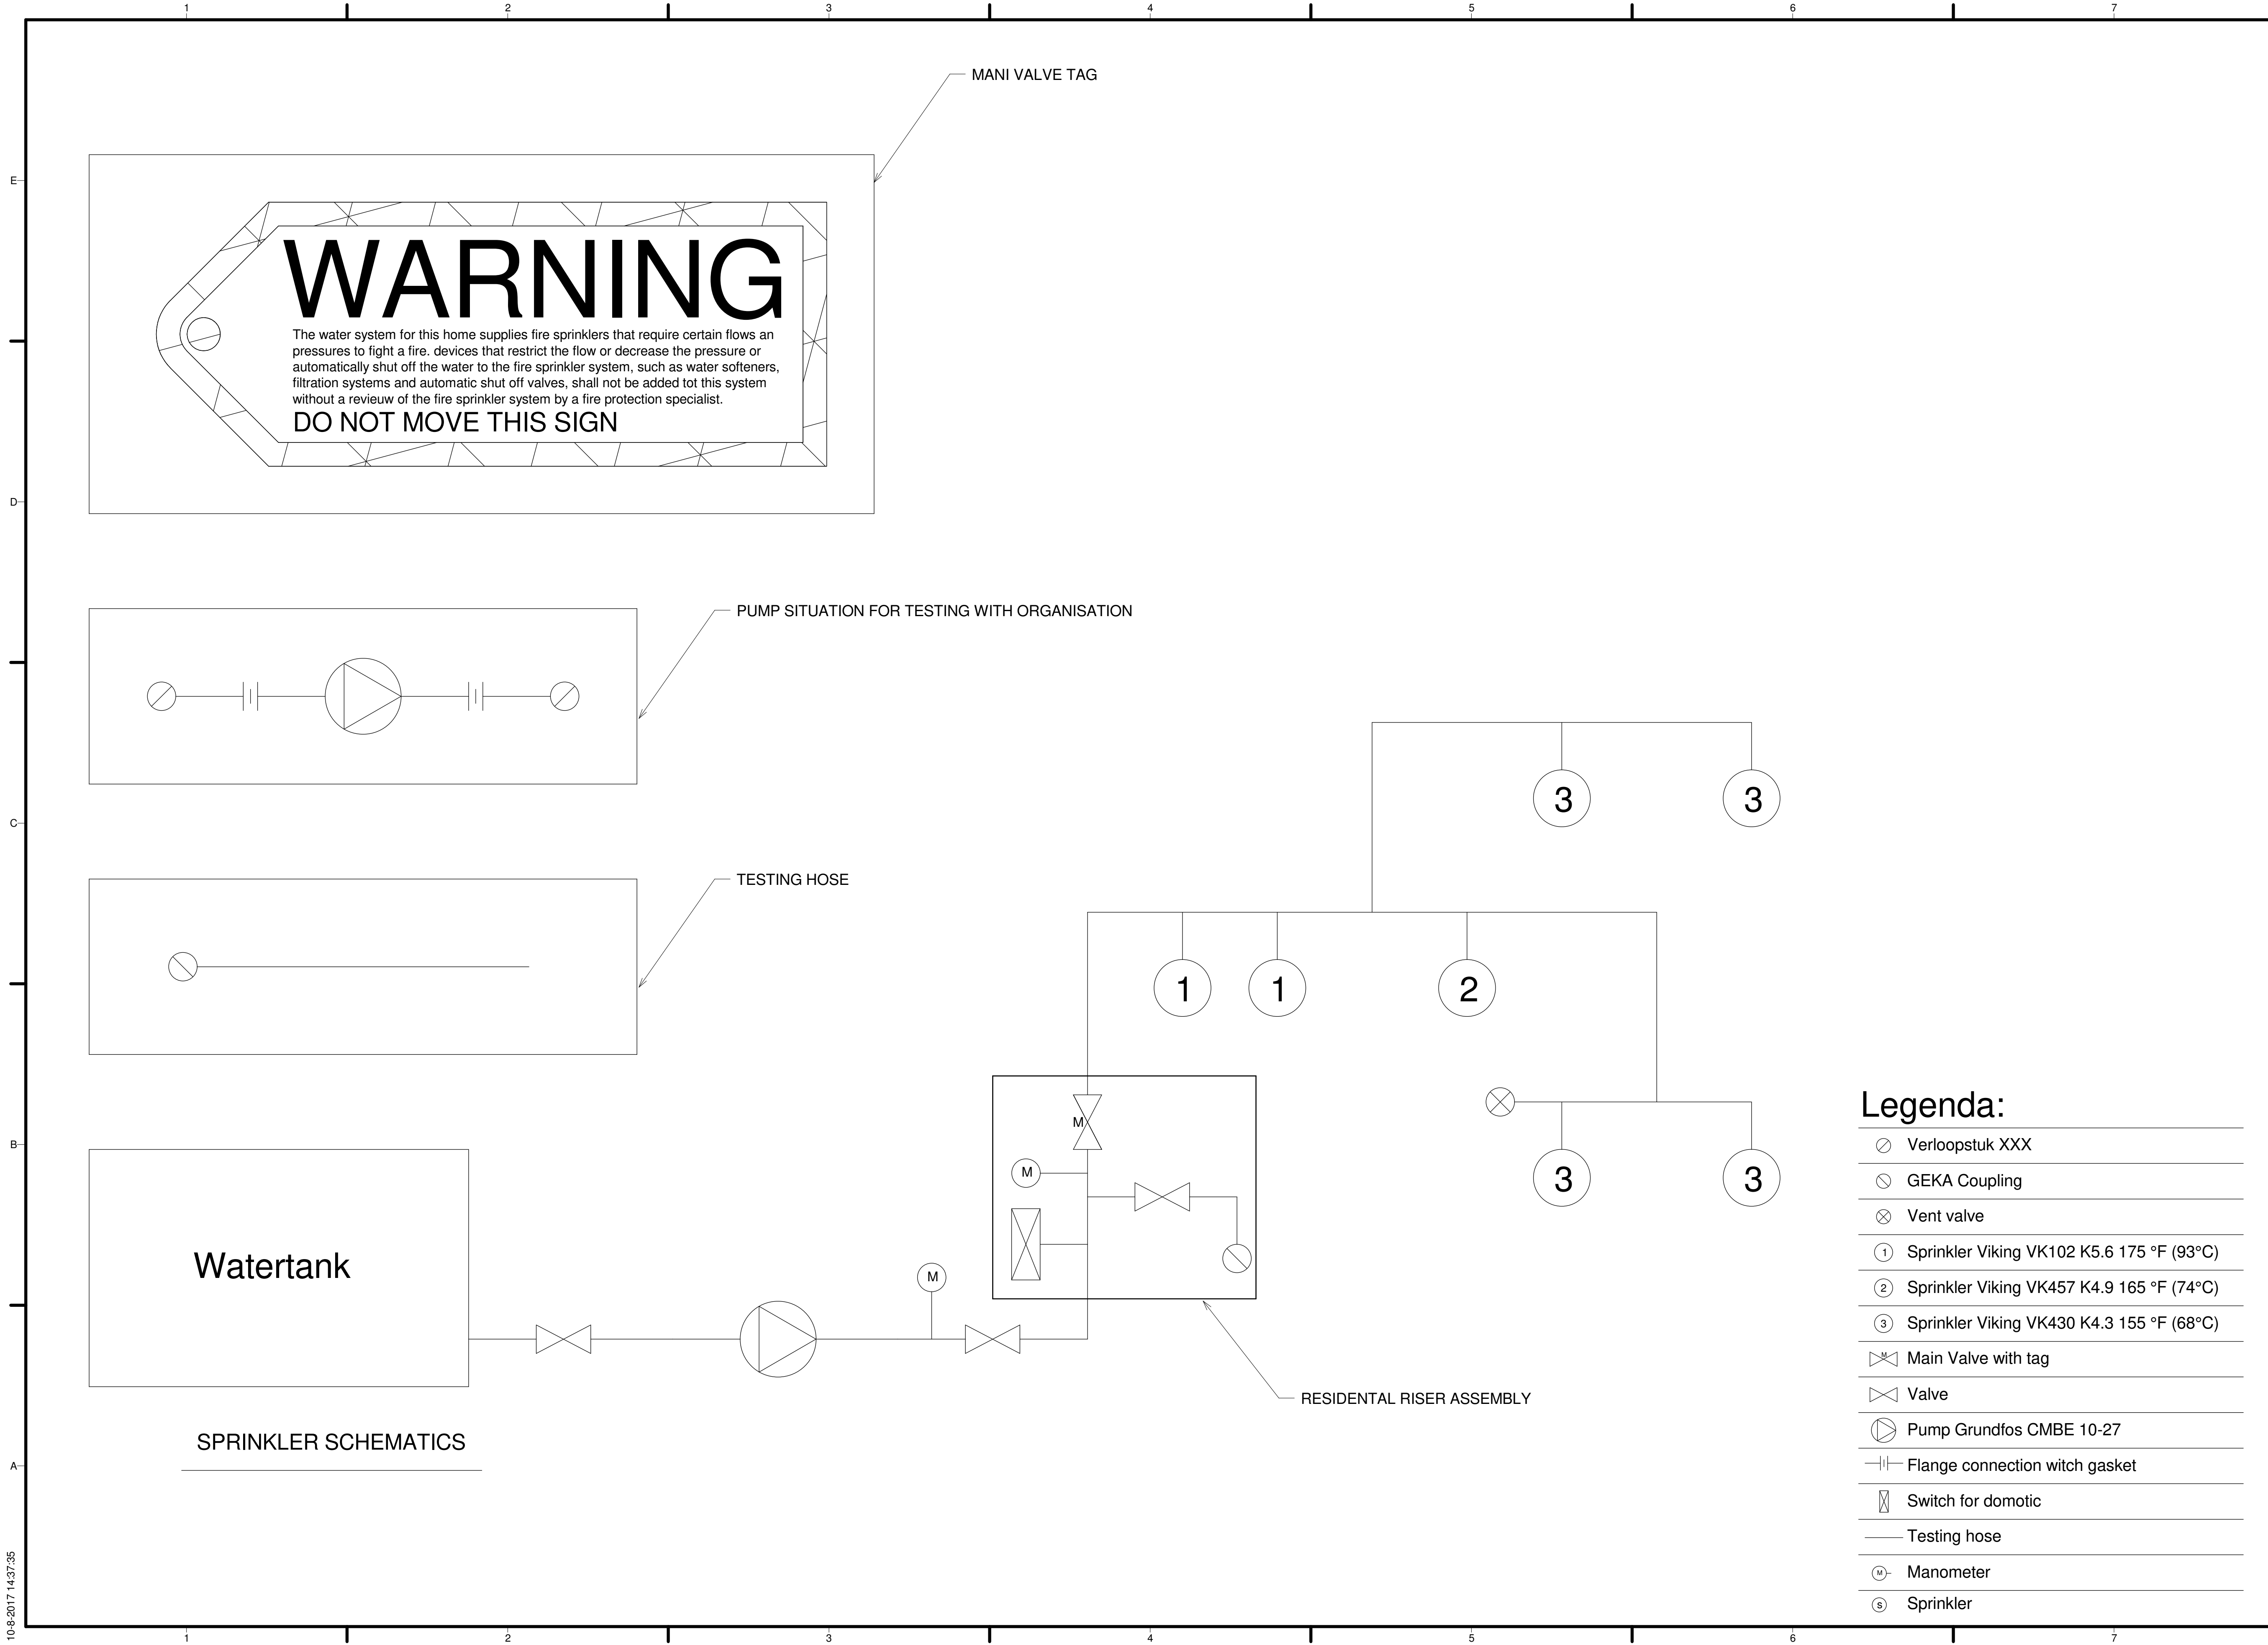

TEAM NAME: Selficient
 ADDRESS: Padualaan 99, 3584CH Utrecht, The Netherlands
 CONTACT: info@selficient.org, www.selficient.org

CONSULTANTS
 ARCHITECTURE
 ENGINEERS
 LANDSCAPING
 SAFETY FIRST CODE CONSULTANTS

CLIENT
 U.S. DEPARTMENT OF ENERGY
 SOLAR DECATHLON 2017
 WWW.SOLARDECATHLON.GOV

MARK	DATE	DESCRIPTION
Rev.00	11-17-2016	90% REVISION
Rev.01	02-24-2017	SECOND DESIGN
Rev.02	08-08-2017	FINAL DESIGN


LOT NUMBER: 106
 DRAWN BY: Huib Snijder
 CHECKED BY: Remco Polle
 COPYRIGHT: NONE; PROJECT IS PUBLIC DOMAIN

SHEET TITLE

SPRINKLER SCHEMATICS

F-100

10-8-2017 14:37:35

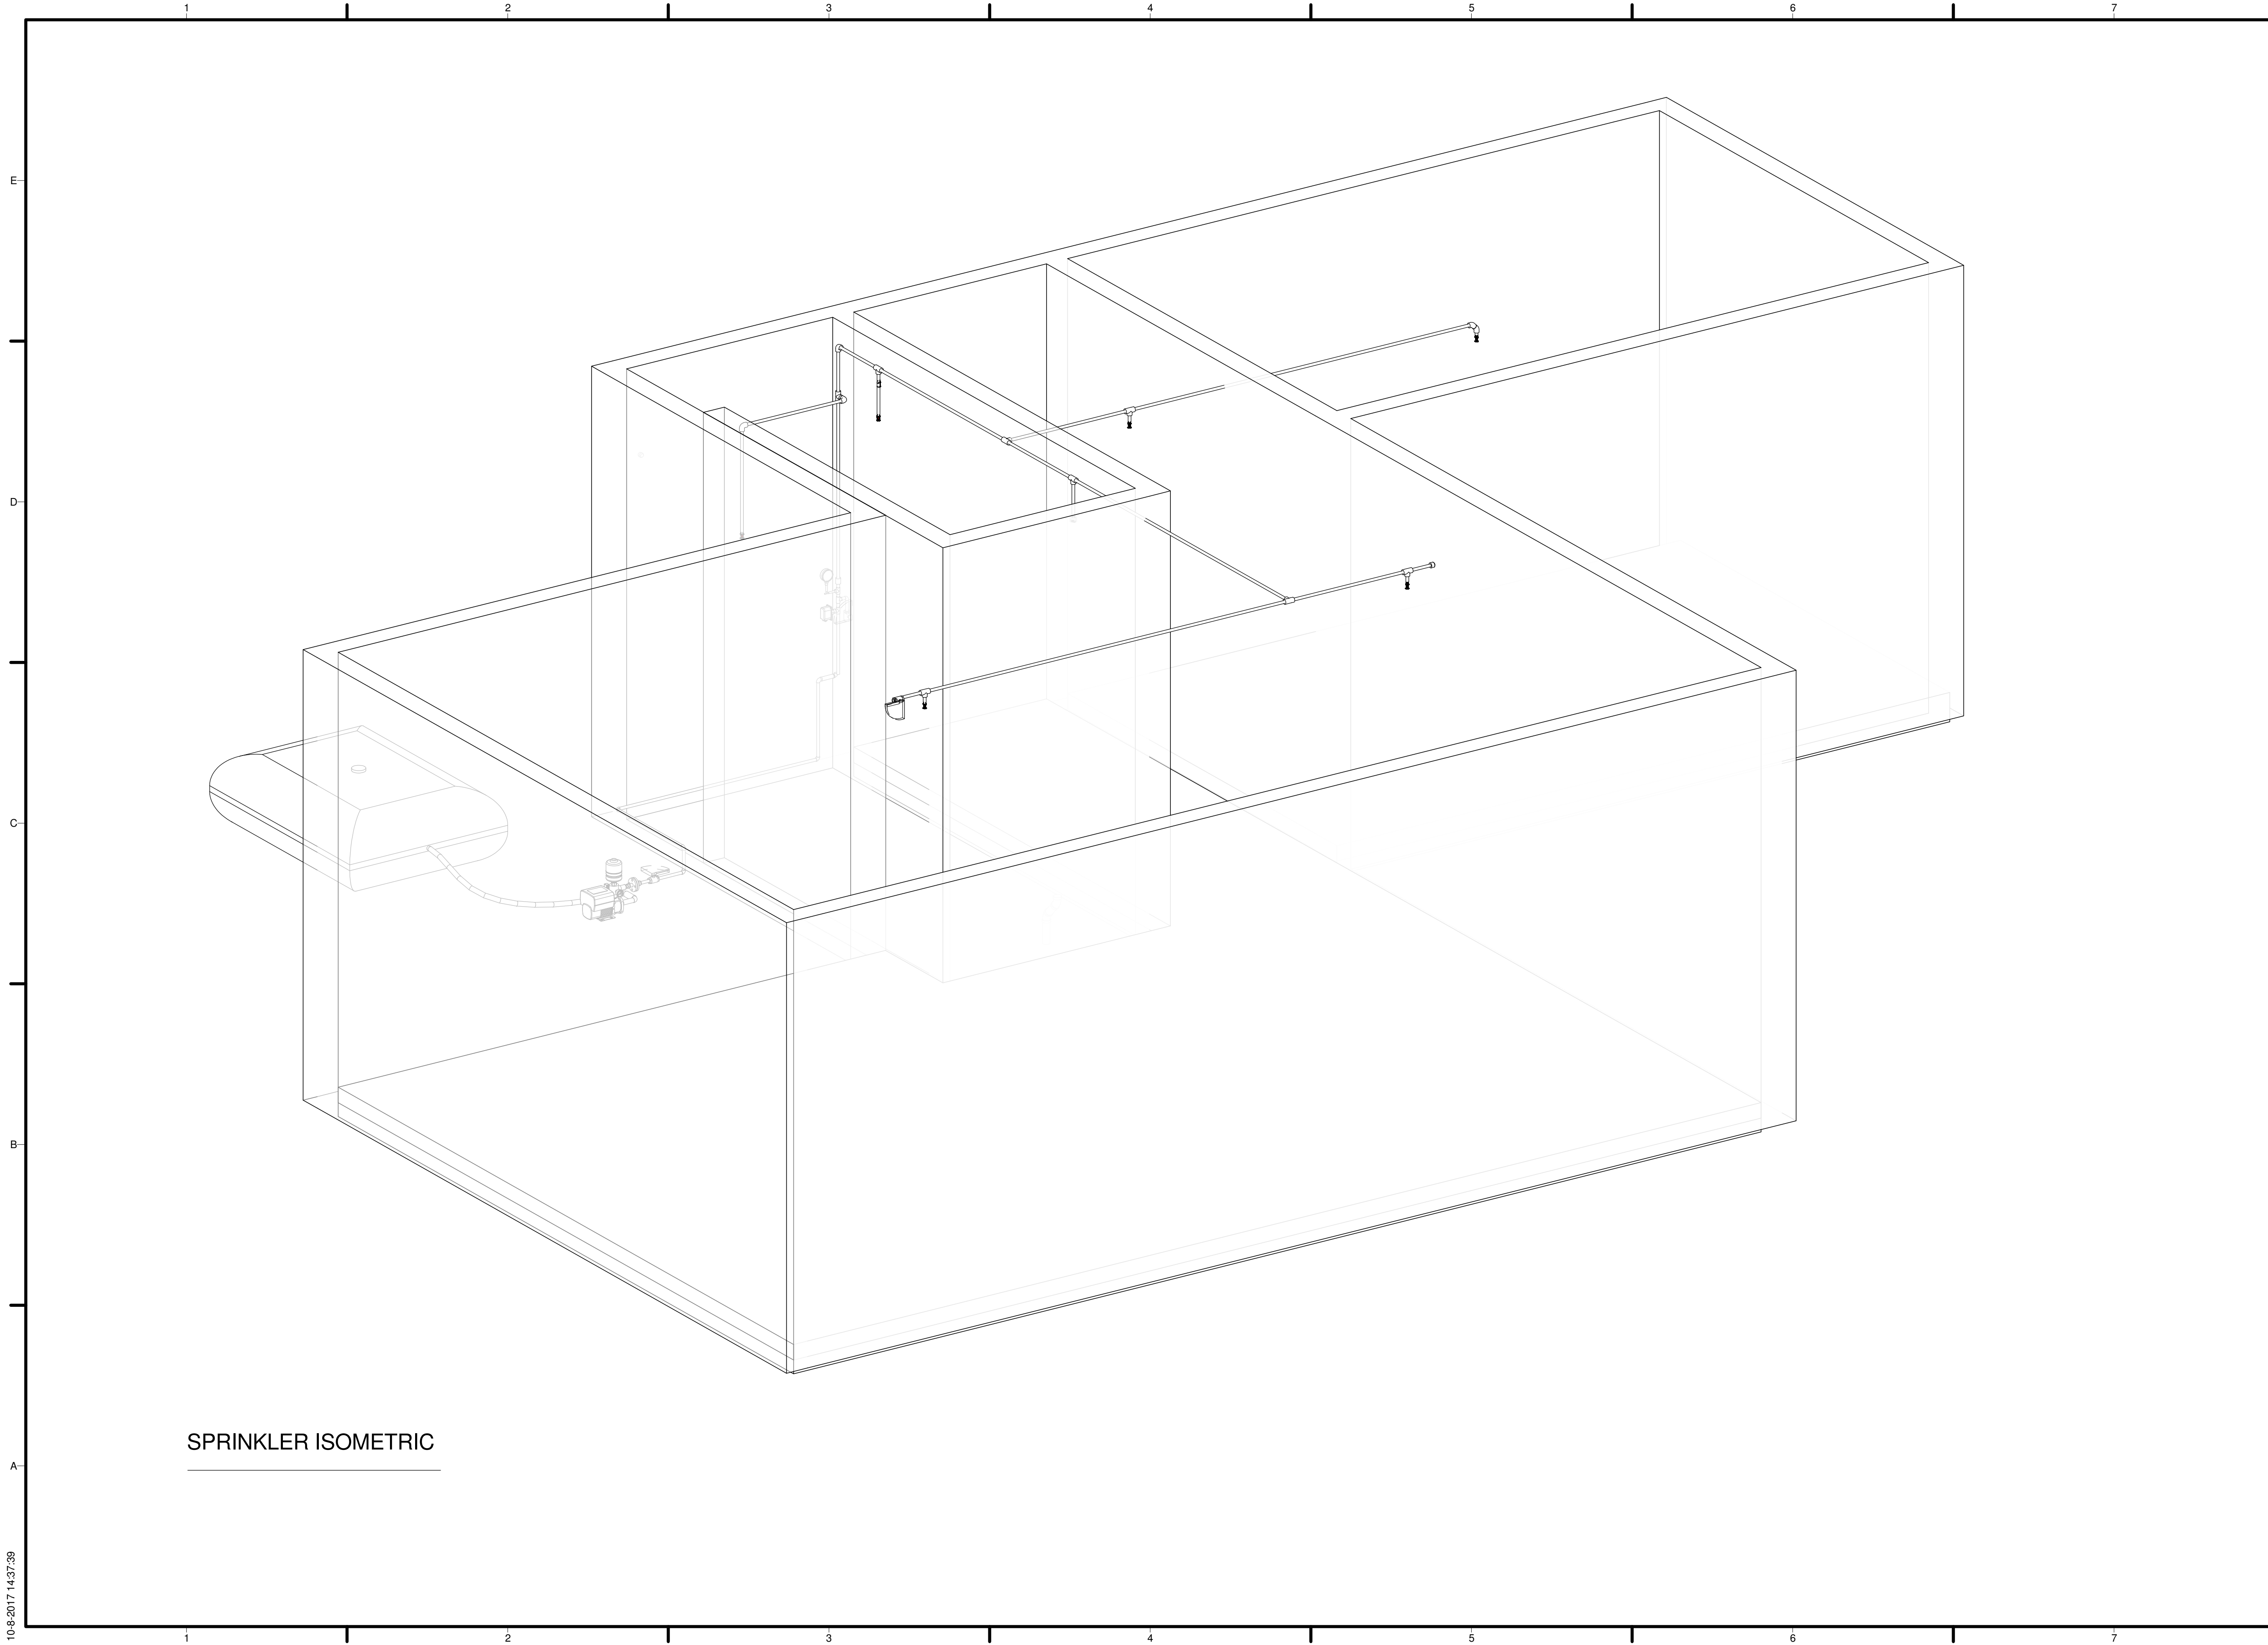


SPRINKLER ISOMETRIC

10-8-2017 14:37:39



TEAM NAME: Selficient
 ADDRESS: Padualaan 99
 3584CH Utrecht
 The Netherlands
 CONTACT: info@selficient.org
 www.selficient.org

CONSULTANTS
 ARCHITECTURE
 ENGINEERS
 LANDSCAPING
 SAFETY FIRST CODE CONSULTANTS

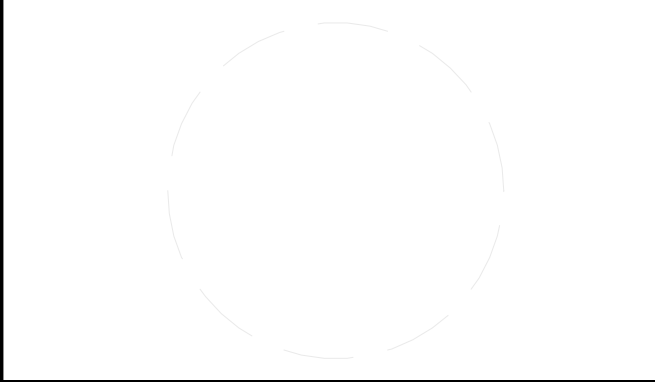

CLIENT
 U.S. DEPARTMENT OF ENERGY
 SOLAR DECATHLON 2017
 WWW.SOLARDECATHLON.GOV




MARK	DATE	DESCRIPTION
Rev.00	11-17-2016	90% REVISION
Rev.01	02-24-2017	SECOND DESIGN
Rev.02	08-08-2017	FINAL DESIGN

LOT NUMBER: 106
 DRAWN BY: Kars Slagter
 CHECKED BY: Remco Polle
 COPYRIGHT: NONE; PROJECT IS PUBLIC DOMAIN

SHEET TITLE
 SPRINKLER ISOMETRIC

F-101

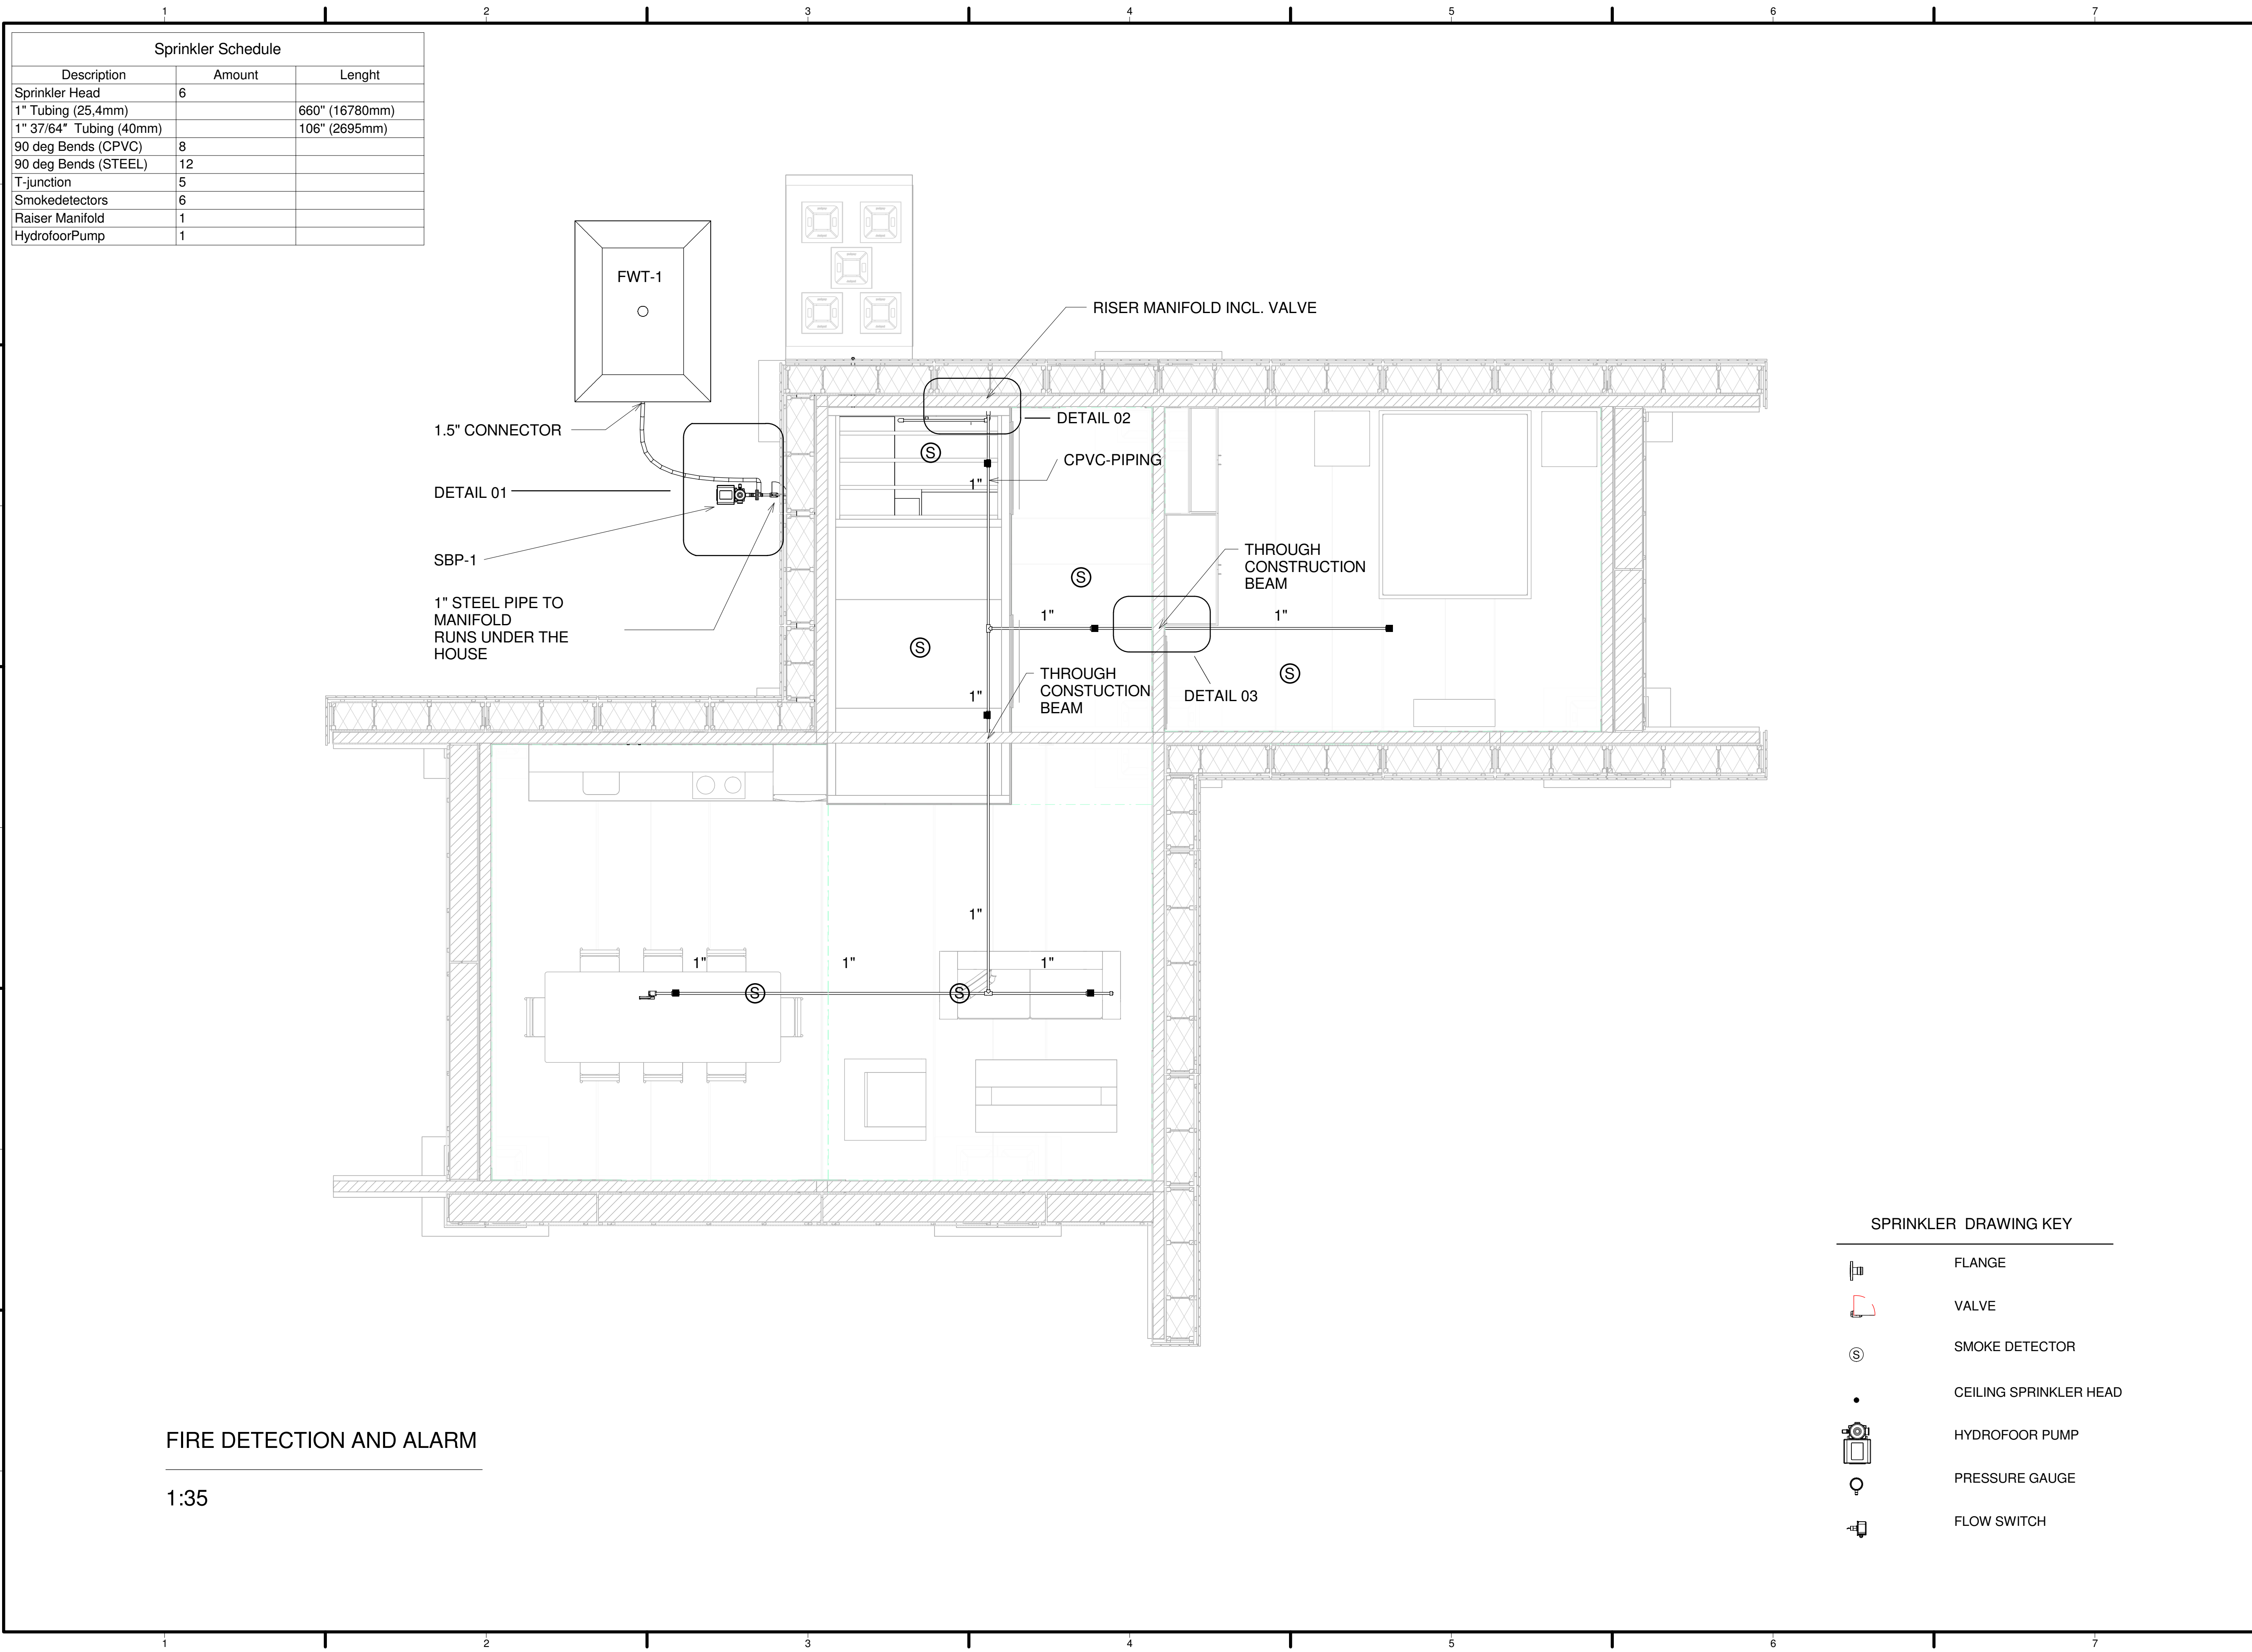


Sprinkler Schedule		
Description	Amount	Lenght
Sprinkler Head	6	
1" Tubing (25.4mm)		660" (16780mm)
1" 37/64" Tubing (40mm)		106" (2695mm)
90 deg Bends (CPVC)	8	
90 deg Bends (STEEL)	12	
T-junction	5	
Smokedetectors	6	
Raiser Manifold	1	
HydrofoorPump	1	



TEAM NAME: Selficient
 ADDRESS: Padualaan 99
 3584CH Utrecht
 The Netherlands
 CONTACT: info@selficient.org
 www.selficient.org

CONSULTANTS
 ARCHITECTURE
 ENGINEERS
 LANDSCAPING
 SAFETY FIRST CODE CONSULTANTS

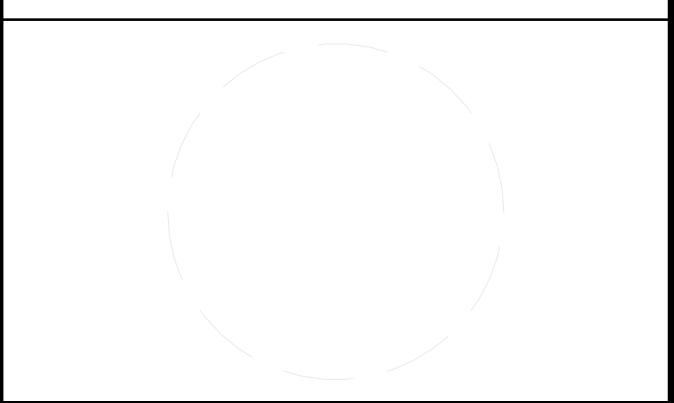

CLIENT
 U.S. DEPARTMENT OF ENERGY
 SOLAR DECATHLON 2017
 WWW.SOLARDECATHLON.GOV



MARK	DATE	DESCRIPTION
Rev.00	11-17-2016	90% REVISION
Rev.01	02-24-2017	SECOND DESIGN
Rev.02	08-08-2017	ADD. SPRINKLER

LOT NUMBER: 106
 DRAWN BY: Kars Slagter
 CHECKED BY: Remco Polle
 COPYRIGHT: NONE; PROJECT IS PUBLIC DOMAIN

SHEET TITLE
FIRE DETECTION AND ALARM


F-200

SPRINKLER DRAWING KEY

- FLANGE
- VALVE
- SMOKE DETECTOR
- CEILING SPRINKLER HEAD
- HYDROFOOR PUMP
- PRESSURE GAUGE
- FLOW SWITCH

TEAM NAME: Selficient
 ADDRESS: Padualaan 99
 3584CH Utrecht
 The Netherlands
 CONTACT: info@selficient.org
 www.selficient.org

CONSULTANTS
 ARCHITECTURE
 ENGINEERS
 LANDSCAPING
 SAFETY FIRST CODE CONSULTANTS

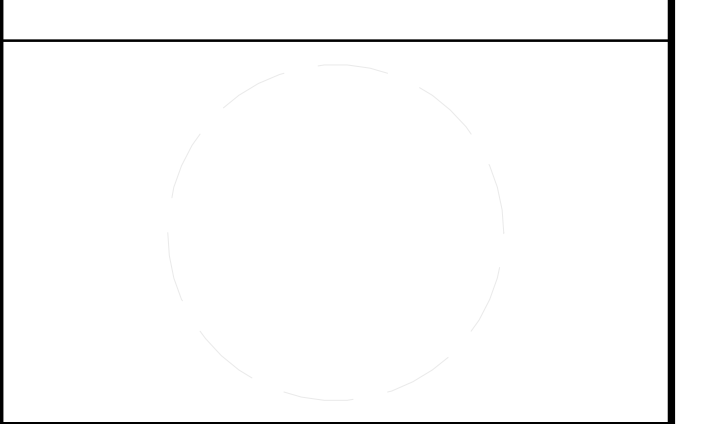

CLIENT
 U.S. DEPARTMENT OF ENERGY
 SOLAR DECATHLON 2017
 WWW.SOLARDECATHLON.GOV




MARK	DATE	DESCRIPTION
Rev.00	11-17-2016	90% REVISION
Rev.01	08-10-2016	CHANGED NOTES


LOT NUMBER: 106
 DRAWN BY: Kars Slagter
 CHECKED BY: Remco Polle
 COPYRIGHT: NONE; PROJECT IS PUBLIC DOMAIN

SHEET TITLE
SPRINKLER DETAILS

F-400

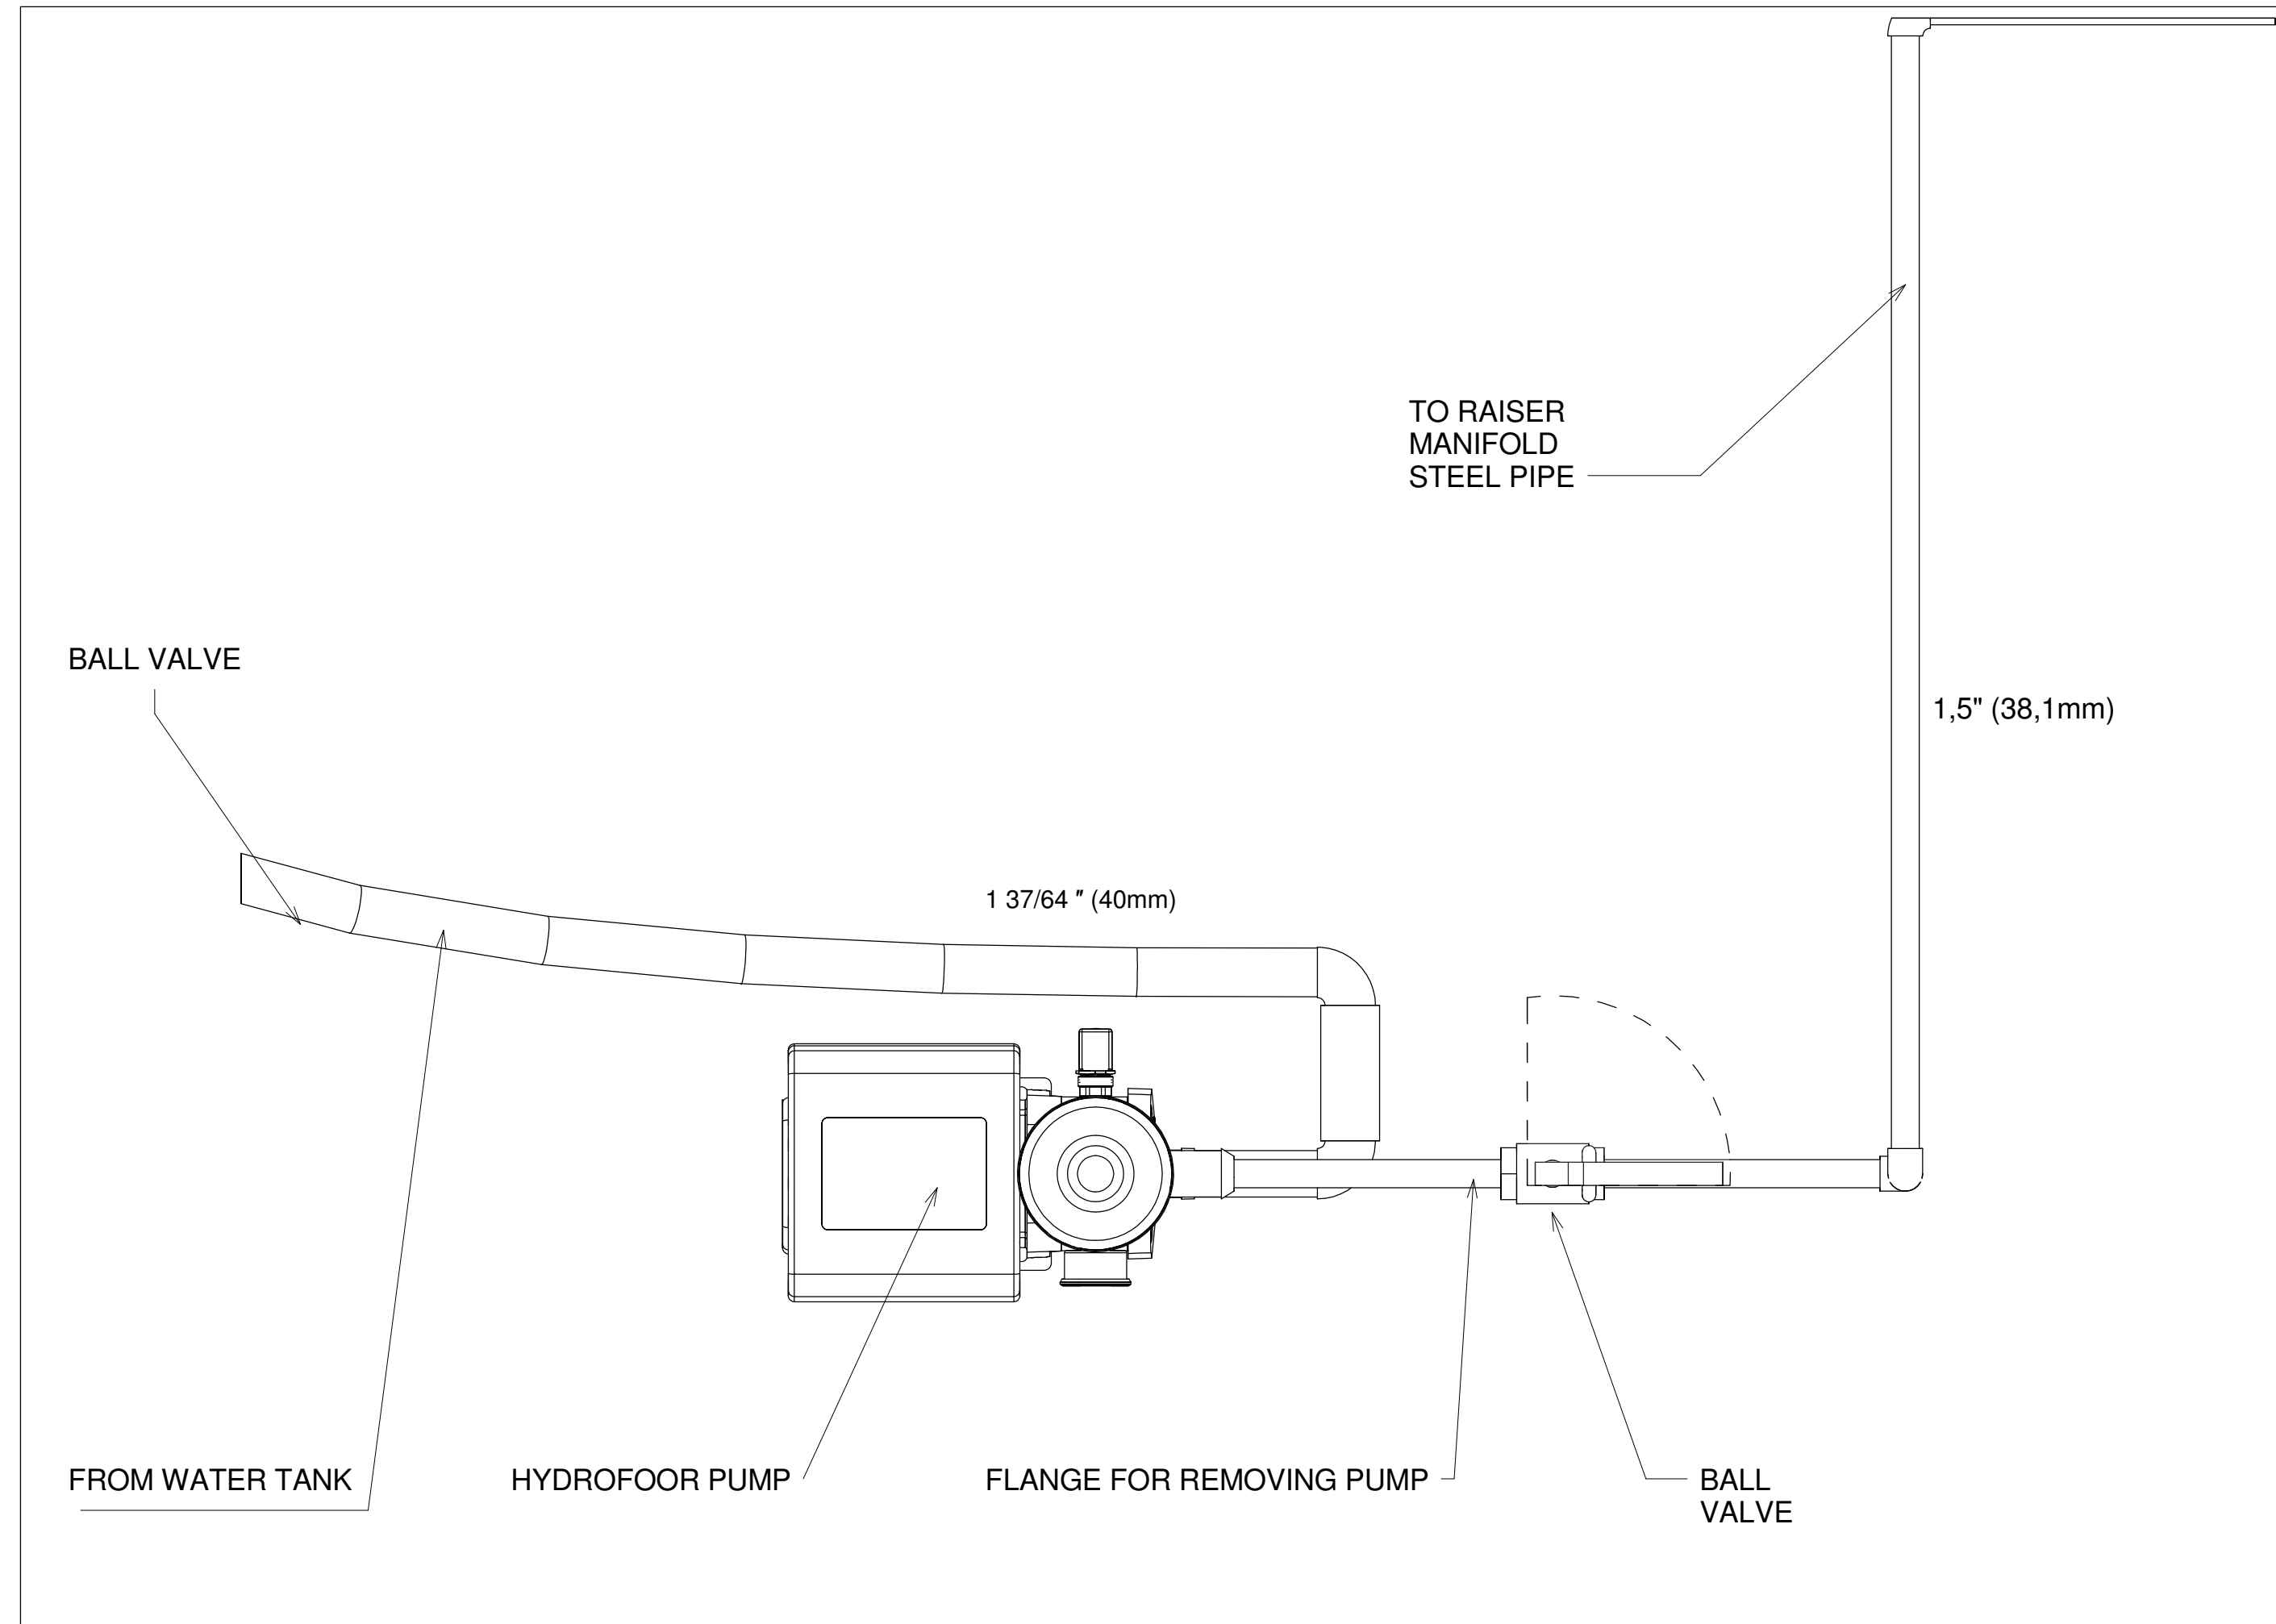

DETAIL 01 - HYDROFOOR PUMP CLOSE-UP

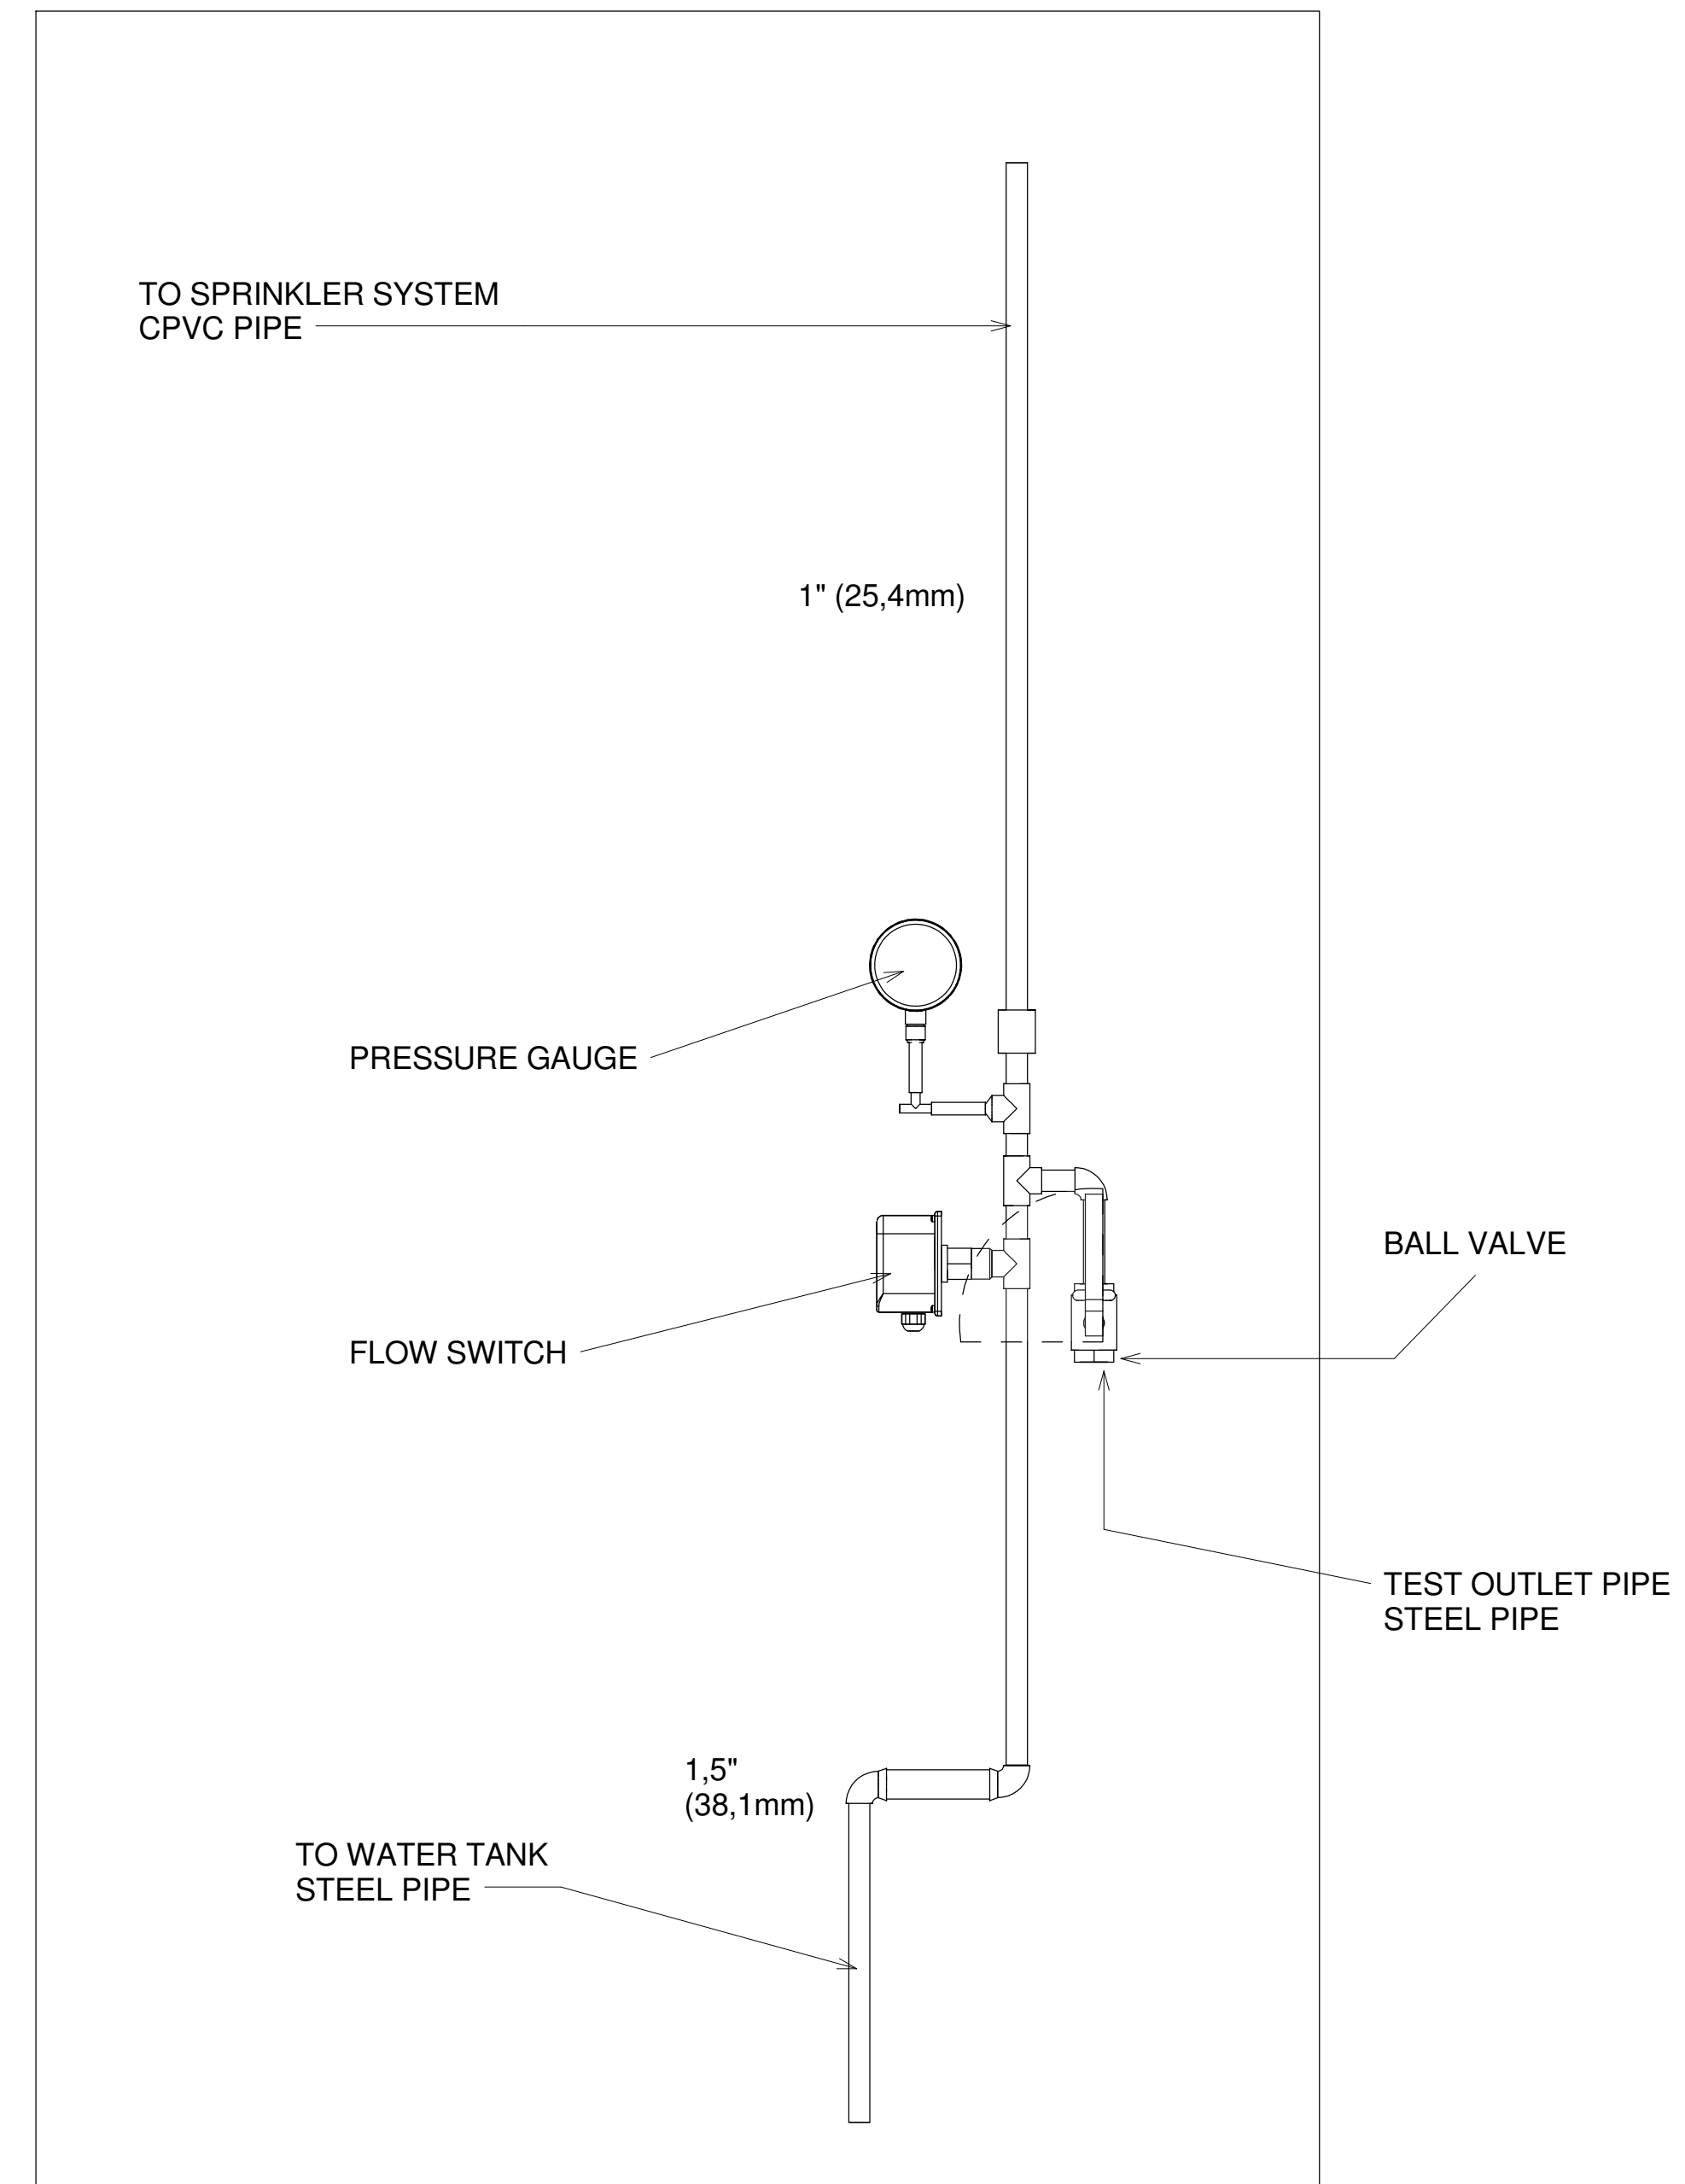


DETAIL 02 - RISER MANIFOLD CLOSE-UP

SPRINKLER DETAILS

1:5

SPRINKLER DRAWING KEY

- FLANGE
- VALVE
- SMOKE DETECTOR
- CEILING SPRINKLER HEAD
- HYDROFOOR PUMP
- PRESSURE GAUGE
- FLOW SWITCH

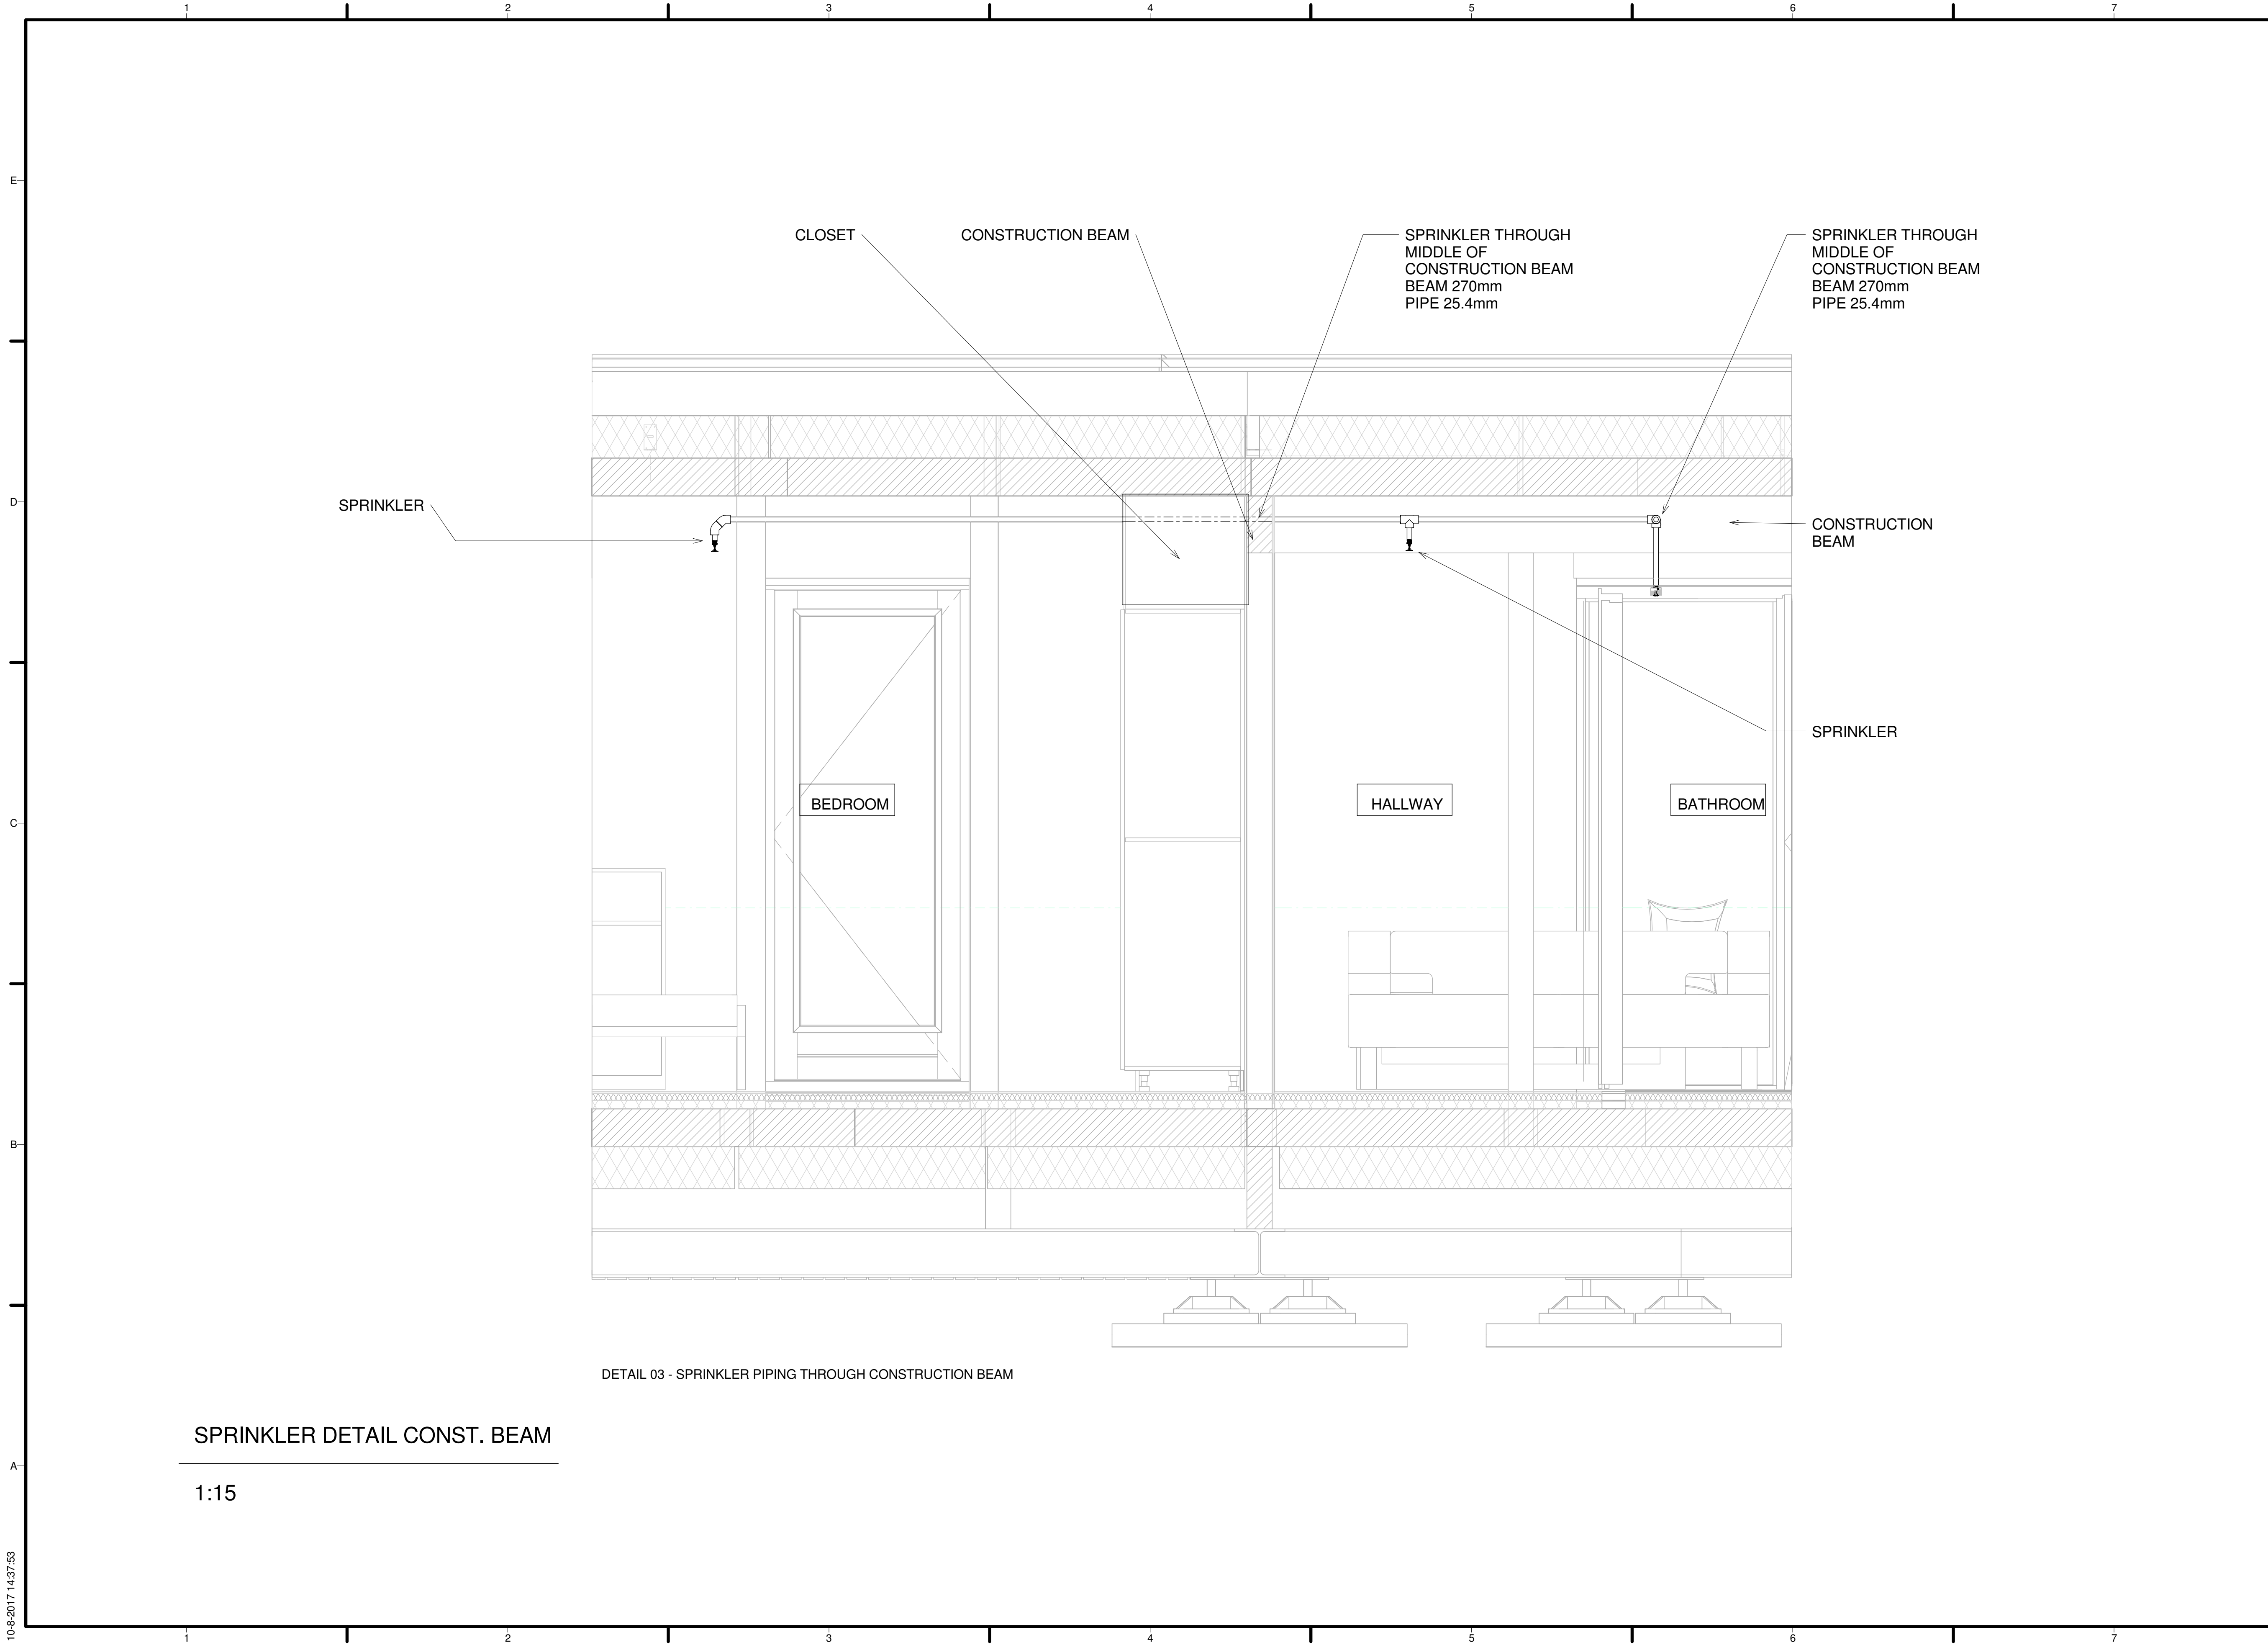

DETAIL 03 - SPRINKLER PIPING THROUGH CONSTRUCTION BEAM

SPRINKLER DETAIL CONST. BEAM


1:15

10-8-2017 14:37:53



TEAM NAME: Selficient
 ADDRESS: Padualaan 99
 3584CH Utrecht
 The Netherlands
 CONTACT: info@selficient.org
 www.selficient.org

CONSULTANTS
 ARCHITECTURE
 ENGINEERS
 LANDSCAPING
 SAFETY FIRST CODE CONSULTANTS

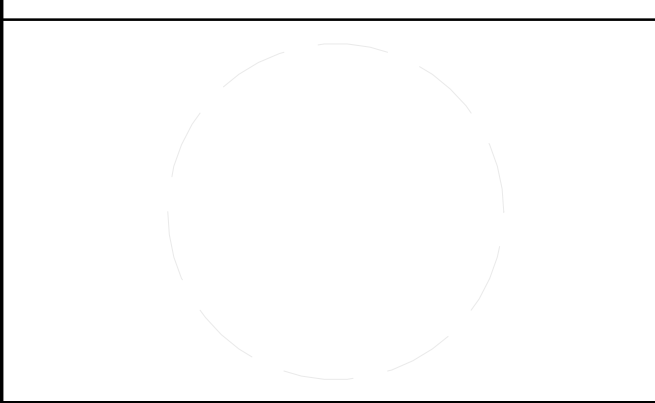

CLIENT
 U.S. DEPARTMENT OF ENERGY
 SOLAR DECATHLON 2017
 WWW.SOLARDECATHLON.GOV



MARK	DATE	DESCRIPTION
Rev.00	11-17-2016	90% REVISION
Rev.01	02-24-2017	SECOND DESIGN
Rev.02	08-08-2017	FINAL DESIGN


LOT NUMBER: 106
 DRAWN BY: Kars Slagter
 CHECKED BY: Remco Polle
 COPYRIGHT: NONE; PROJECT IS PUBLIC DOMAIN

SHEET TITLE
 SPRINKLER DETAIL
 CONST. BEAM

F-401

TEAM NAME: Selficient
 ADDRESS: Padualaan 99
 3584CH Utrecht
 The Netherlands
 CONTACT: info@selficient.org
 www.selficient.org

CONSULTANTS
 ARCHITECTURE
 ENGINEERS
 LANDSCAPING
 SAFETY FIRST CODE CONSULTANTS

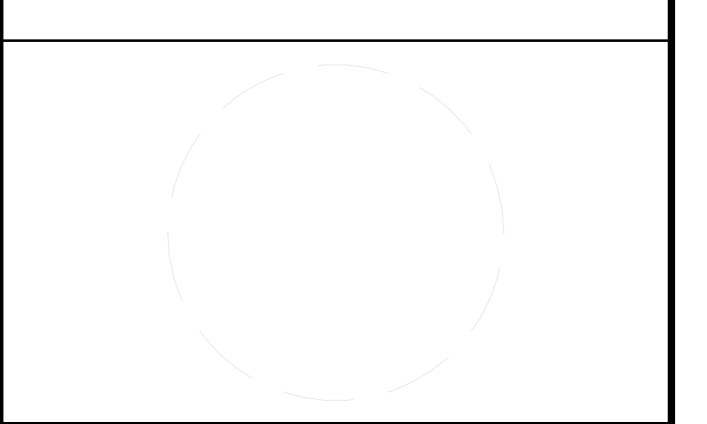

CLIENT
 U.S. DEPARTMENT OF ENERGY
 SOLAR DECATHLON 2017
 WWW.SOLARDECATHLON.GOV




MARK	DATE	DESCRIPTION
Rev.00	11-17-2016	90% REVISION
Rev.01	02-24-2017	SECOND DESIGN
Rev.02	08-08-2017	FINAL DESIGN

LOT NUMBER: 106
 DRAWN BY: Kars Slagter
 CHECKED BY: Remco Polle
 COPYRIGHT: NONE; PROJECT IS PUBLIC DOMAIN

SHEET TITLE
**SPRINKLERS
 CLOSE-UPS**


F-402

**VK102
 SPRINKLER HEAD TECHNICAL ROOM**

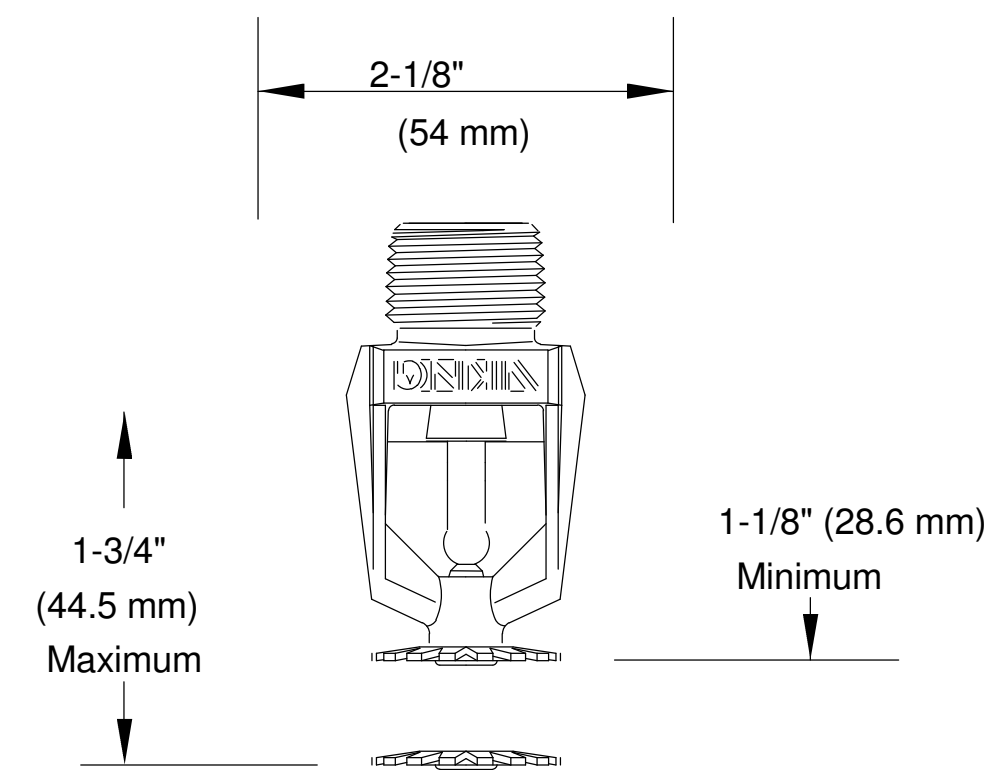


INSTALLED WITH A MICROMATI
 MODEL E - 1 RECESSED ESCUTCHEON
 VIKING STANDARD RESPONSE PENDENT SPRINKLER 10139 (VK102)

**VK457
 SPRINKLER HEAD BATHROOM**

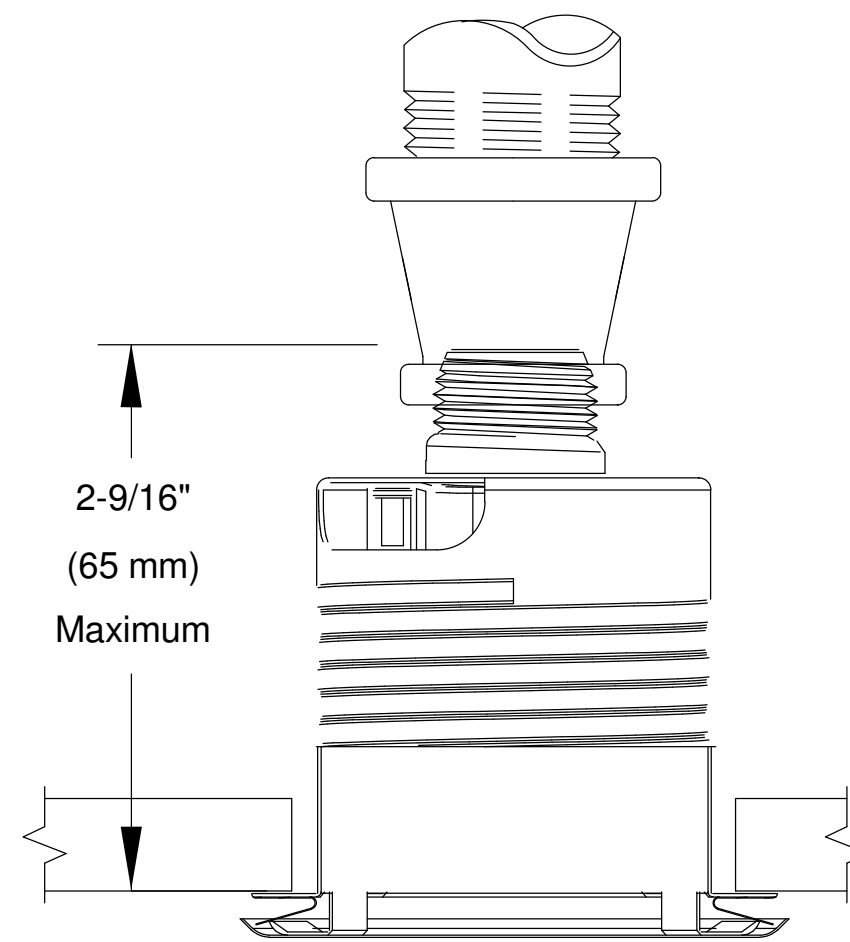

NOTE: UPON SPRINKLER ACTIVATION, THE DEFLECTOR
 DESCENDS TO APPROXIMATELY 13/16" (20.6MM) BELOW
 THE SPRINKLER BODY
 VIKING RESIDENTIAL CONCEALED PENDENT SPRINKLER VK457

**VK430
 SPRINKLER HEAD LIVING AND BEDROOM**

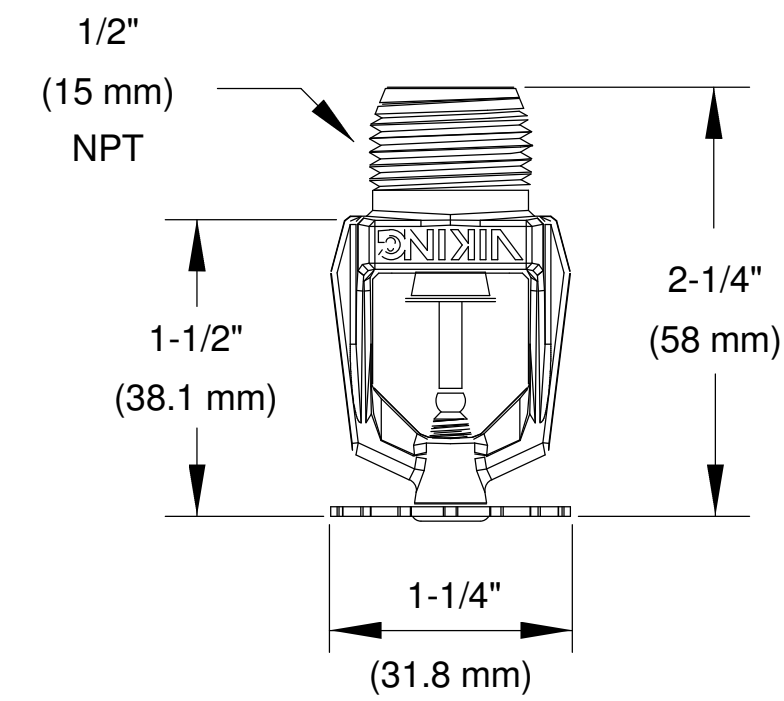

INSTALLED WITH A MICROMATIC
 MODEL E-1 RECESSED ESCUTCHEON
 VIKING RESIDENTIAL PENDENT K4.3 SPRINKLER 09530 (VK430)

SPRINKLER CLOSE-UPS

Fire Suppression Schedule

Type Mark	Room: name	Description	Manufacturer	Model	Count	Dimensions (DxWxH) (mm)	URL
VK102	Tech Room	Sprinkler Head	VIKING	VK102	2	SEE F-402	http://www.vikingcorp.com/vk102-micromatic-standard-response-pendent-sprinkler-k56
VK457	Bathroom	Sprinkler Head	VIKING	VK457	1	SEE F-402	http://www.vikingcorp.com/vk457-residential-concealed-fusible-element-pendent-sprinkler-k49
VK430	Living and Bedroom	Sprinkler Head	VIKING	VK430	4	SEE F-402	http://www.vikingcorp.com/vk430-residential-pendent-sprinkler-k43
FWT-1	Outside	Fire Suppression Water Tank	DAMME Kunststoffen	CUSTOM	1	1500x2000x650	http://www.dammekunststoffen.nl/index.php
SBP-1	Outside	Sprinkler Booster Pump	WILO	MHI 405-1/E/1/230/5 0/2	1	377x232x506	http://productfinder.wilo.com/nl/nl/c0000001100009aa900020023/product.html#tab=range_description
CPVC	Inside	Fire Suppression Piping	Blazemaster	1"		1"	https://www.lubrizol.com/CPVC/Blazemaster/
CPVC	Inside	Tee, Elbows Piping	Blazemaster	1"			https://www.lubrizol.com/CPVC/Blazemaster/
S	Inside	Smoke Detector	First Alert	230V	6		https://www.brandbeveiligingshop.nl/first-alert-first-alert-rookmelder-230-volt-met-10.html
DETAIL 01	Outside	Detail SBP-1	Various		1		
DETAIL 01	Outside	Ball Valve	VIKING	Various	3	25,4mm and 40mm (diameter)	
DETAIL 01	Outside	Flange	VIKING	Various	2	25,4mm and 40mm (diameter)	
DETAIL 02	Tech Room	Detail Riser Manifold	Various				
DETAIL 02	Tech Room	Pressure Gauge	VIKING	DN25	1		http://www.vikingcorp.com/sites/default/files/databook/wetsystems/102407.pdf
DETAIL 02	Tech Room	Ball Valve	VIKING	DN25	1	1"	http://www.vikingcorp.com/sites/default/files/databook/wetsystems/102407.pdf
DETAIL 02	Tech Room	Flow Switch	VIKING	VSR-S Flow Switch	1		http://www.vikingcorp.com/sites/default/files/databook/wetsystems/102407.pdf



TEAM NAME: Selficient
 ADDRESS: Padualaan 99
 3584CH Utrecht
 The Netherlands
 CONTACT: info@selficient.org
 www.selficient.org

CONSULTANTS
 ARCHITECTURE
 ENGINEERS
 LANDSCAPING
 SAFETY FIRST CODE CONSULTANTS



CLIENT
 U.S. DEPARTMENT OF ENERGY
 SOLAR DECATHLON 2017
 WWW.SOLARDECATHLON.GOV




Rev.00	11-17-2016	90% REVISION
Rev.01	02-24-2017	SECOND DESIGN
Rev.02	08-08-2017	FINAL DESIGN
MARK	DATE	DESCRIPTION

LOT NUMBER: 106
 DRAWN BY: Kars Slagter
 CHECKED BY: Remco Polle
 COPYRIGHT: NONE; PROJECT IS PUBLIC DOMAIN

SHEET TITLE
FIRE SUPPRESSION SCHEDULE

F-500

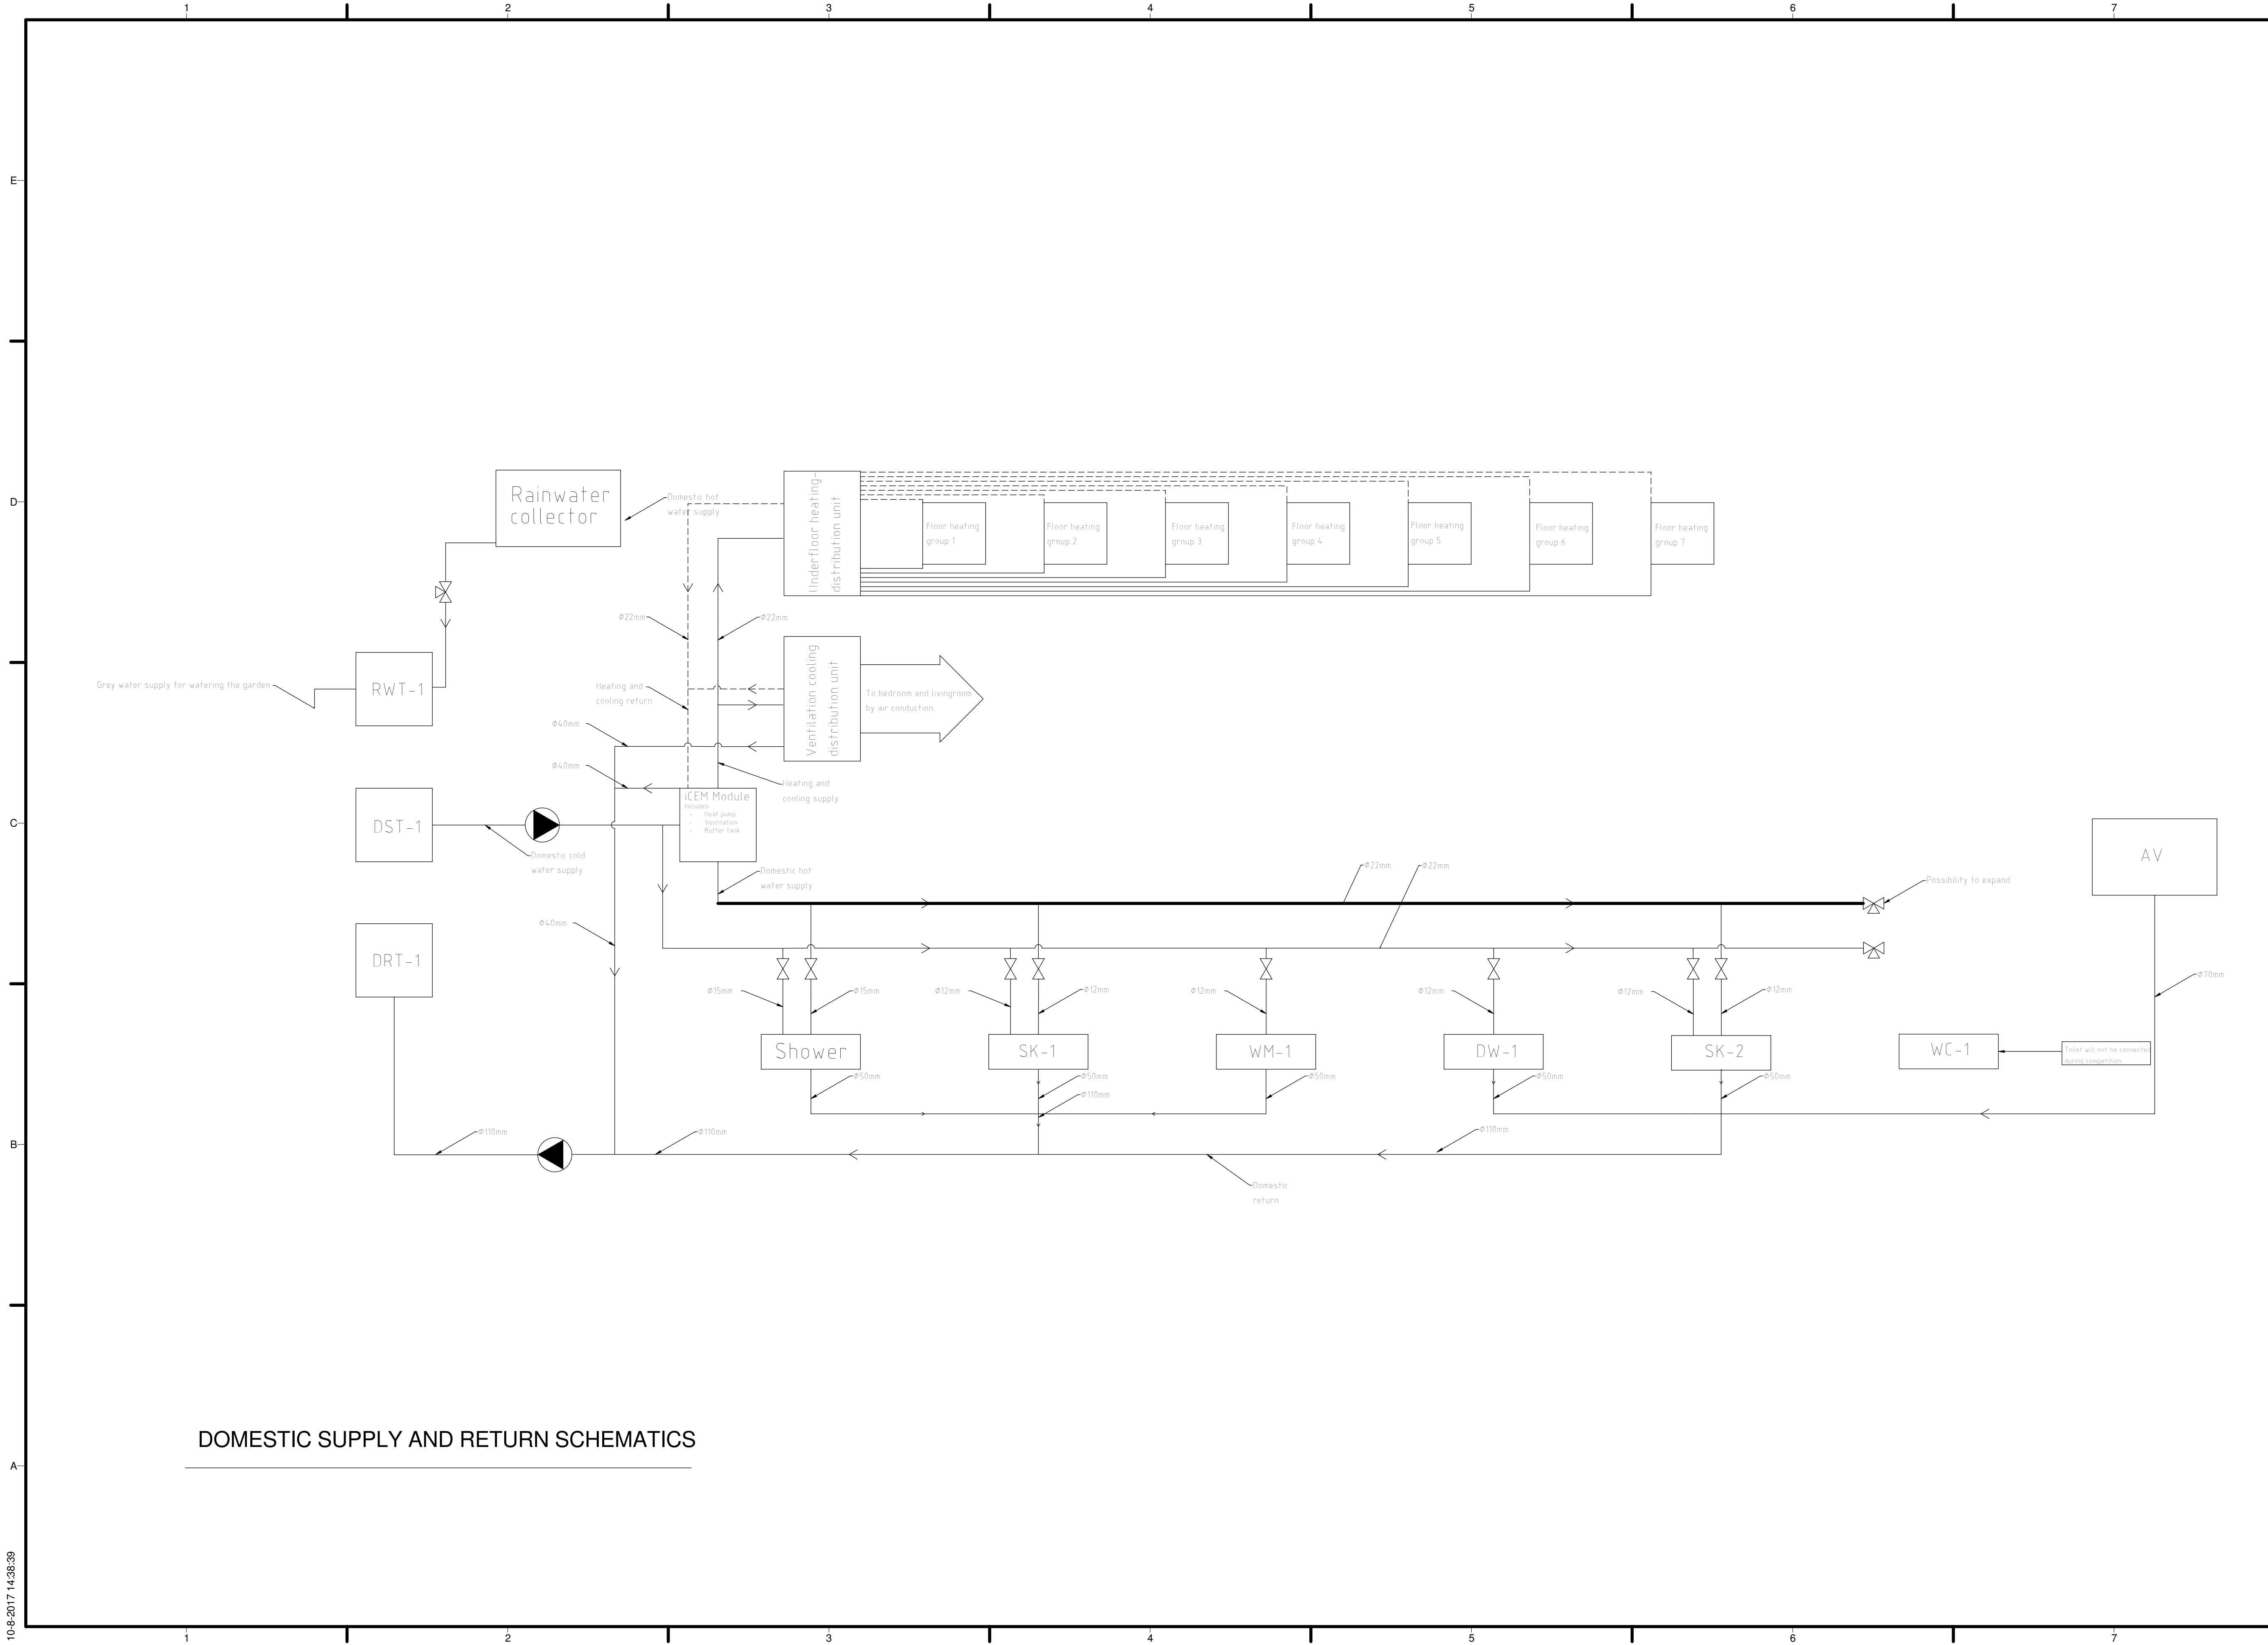


DOMESTIC SUPPLY AND RETURN SCHEMATICS



TEAM NAME: Selficient
 ADDRESS: Padualaan 99
 3584CH Utrecht
 The Netherlands
 CONTACT: info@selficient.org
 www.selficient.org

CONSULTANTS
 ARCHITECTURE
 ENGINEERS
 LANDSCAPING
 SAFETY FIRST CODE CONSULTANTS

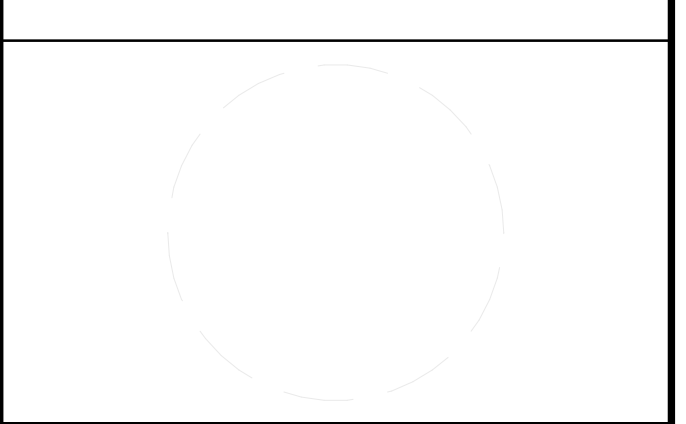

CLIENT
 U.S. DEPARTMENT OF ENERGY
 SOLAR DECATHLON 2017
 WWW.SOLARDECATHLON.GOV




Rev. 00	02-24-2017	ADD. SCHEMATICS
MARK	DATE	DESCRIPTION

LOT NUMBER: 106
 DRAWN BY: Kars Slagter
 CHECKED BY: Remco Polle
 COPYRIGHT: NONE; PROJECT IS PUBLIC DOMAIN

SHEET TITLE
 DOMESTIC SUPPLY AND RETURN SCHEMATICS

P-100

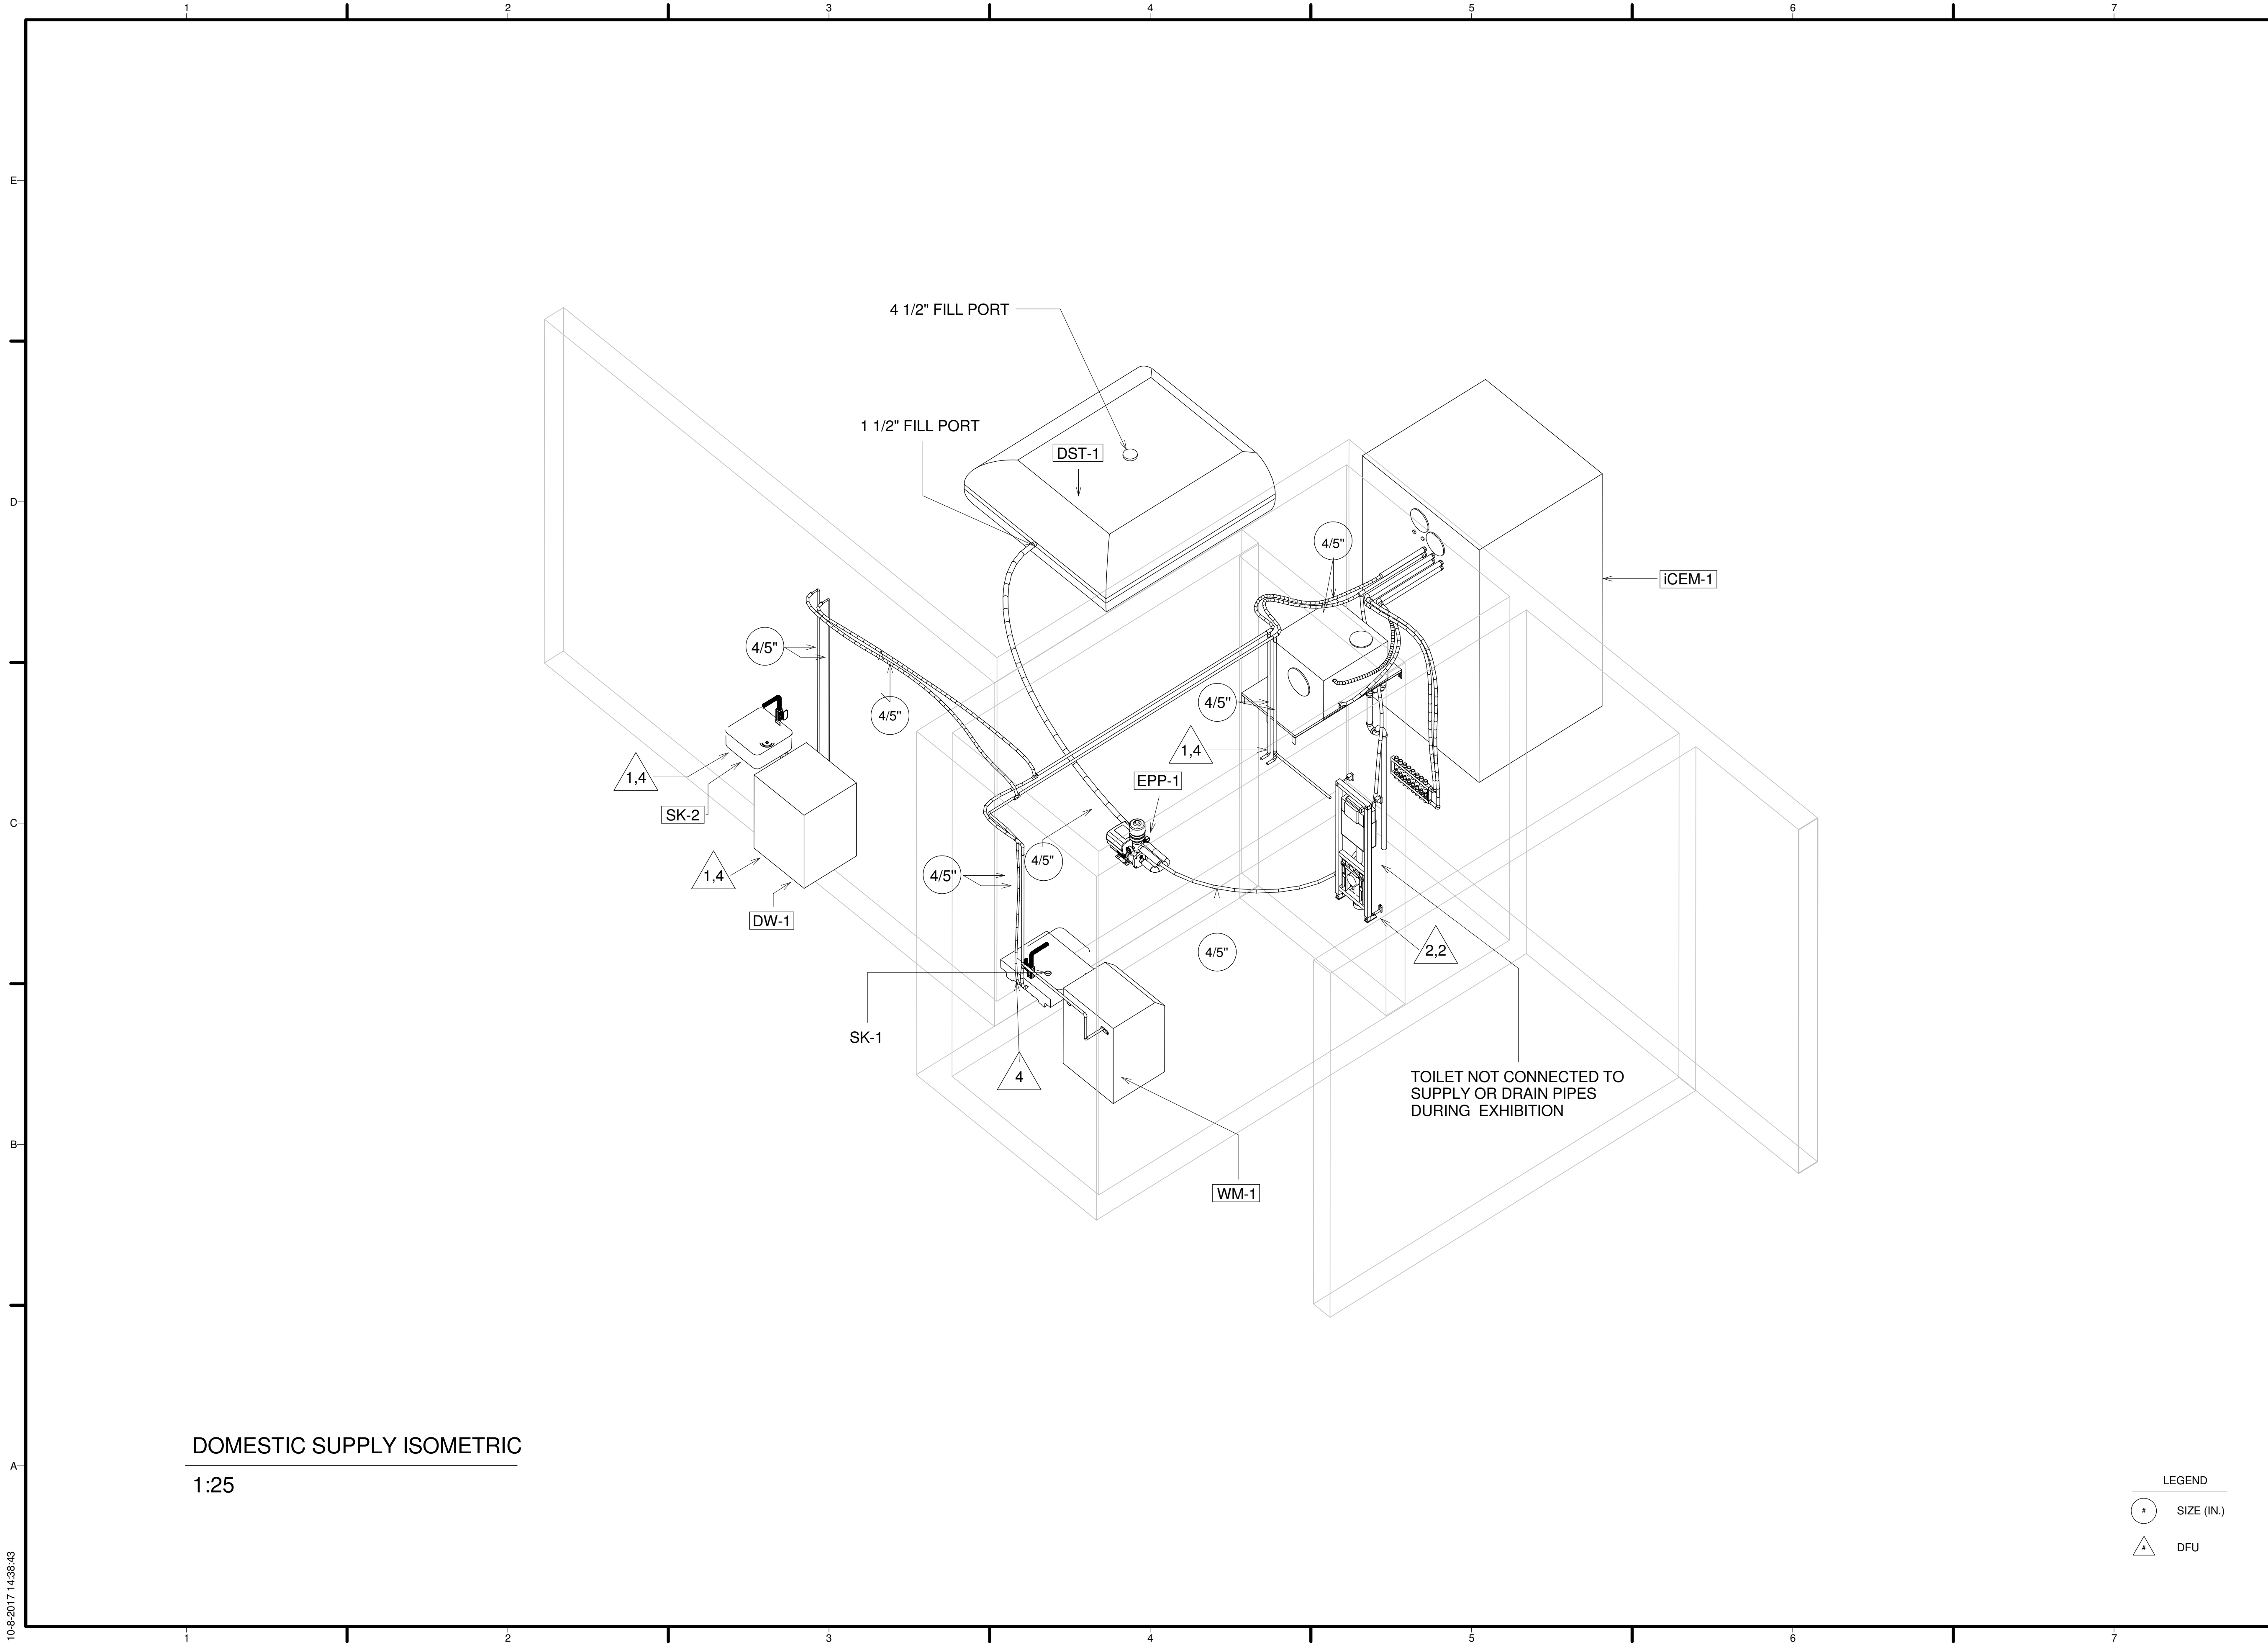

DOMESTIC SUPPLY ISOMETRIC
1:25


LEGEND

○	SIZE (IN.)
△	DFU



TEAM NAME: Selficient
 ADDRESS: Padualaan 99
 3584CH Utrecht
 The Netherlands
 CONTACT: info@selficient.org
 www.selficient.org

CONSULTANTS
 ARCHITECTURE
 ENGINEERS
 LANDSCAPING
 SAFETY FIRST CODE CONSULTANTS

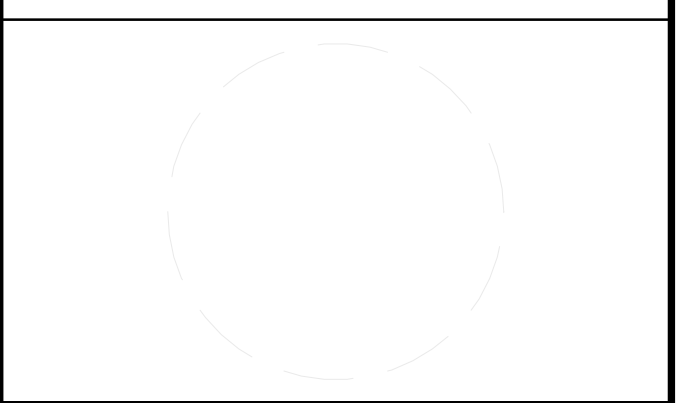

CLIENT
 U.S. DEPARTMENT OF ENERGY
 SOLAR DECATHLON 2017
 WWW.SOLARDECATHLON.GOV




MARK	DATE	DESCRIPTION
Rev.00	11-17-2016	90% REVISION
Rev.01	02-24-2017	SECOND DESIGN
Rev.02	08-08-2017	FINAL DESIGN

LOT NUMBER: 106
 DRAWN BY: Kars Slagter
 CHECKED BY: Remco Polle
 COPYRIGHT: NONE; PROJECT IS PUBLIC DOMAIN

SHEET TITLE
 DOMESTIC SUPPLY ISOMETRIC

P-101

10-8-2017 14:38:43

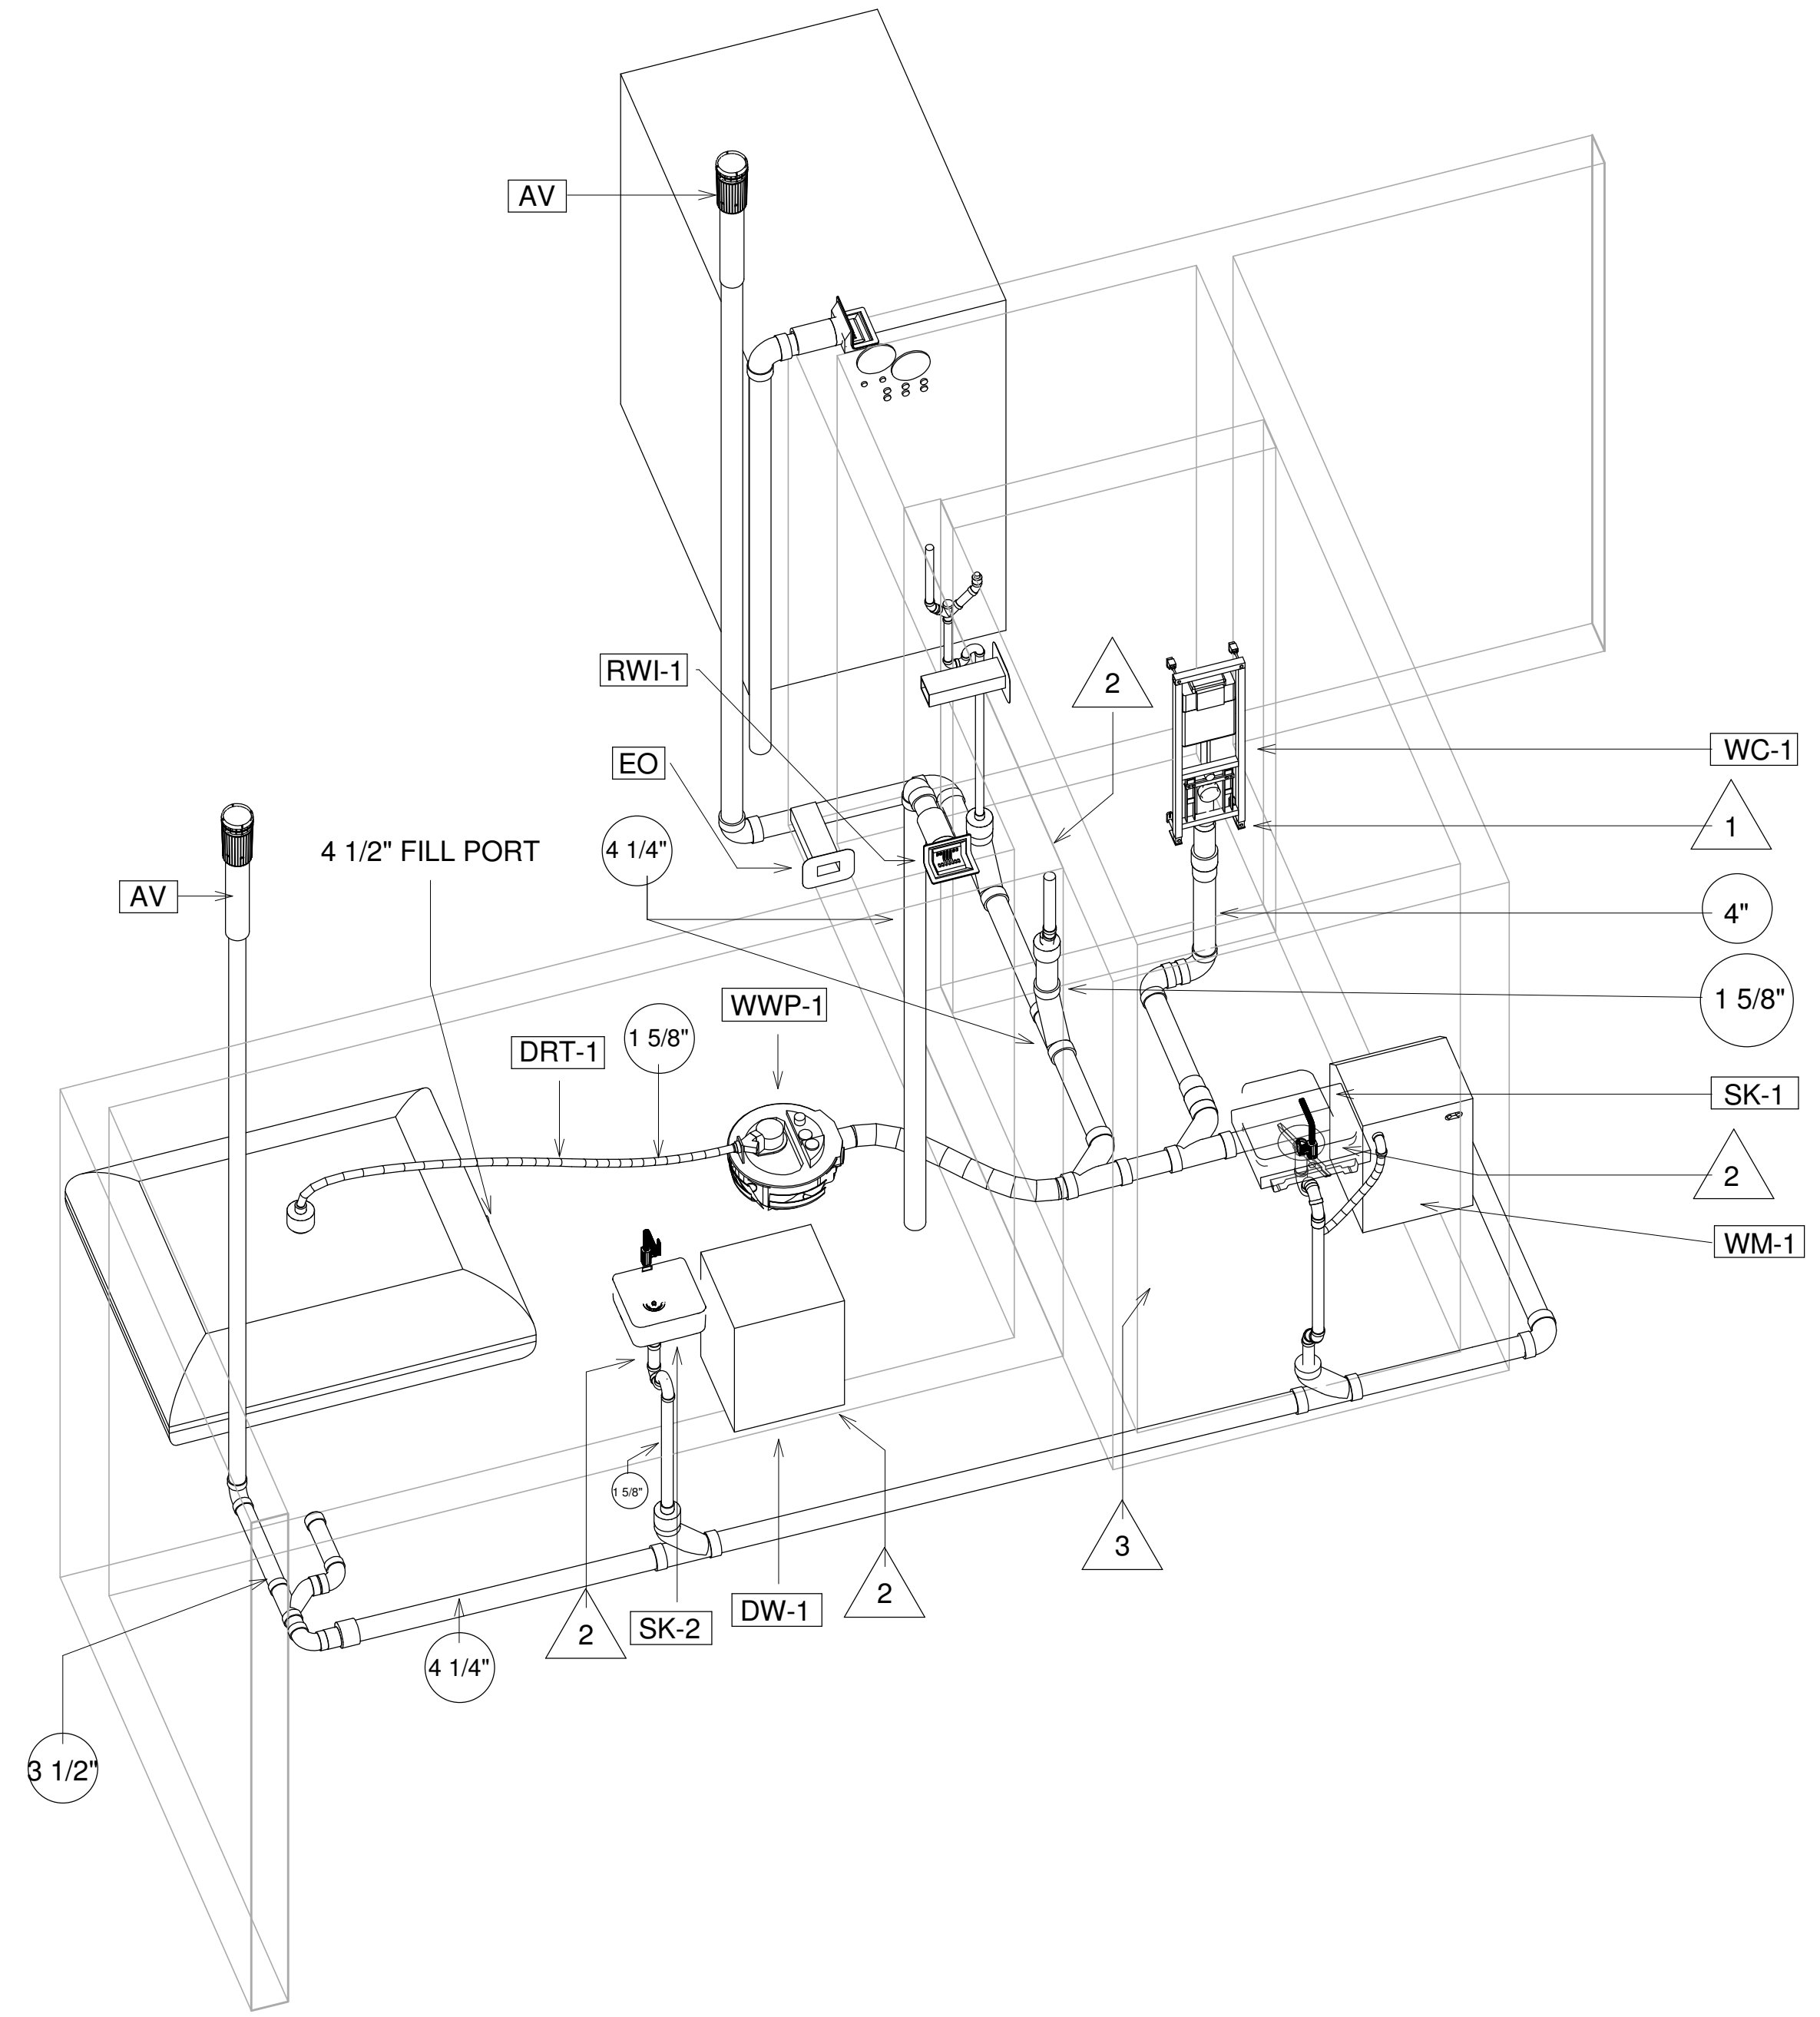

DOMESTIC RETURN ISOMETRIC
1:30


LEGEND

	SIZE (IN.)
	DFU



TEAM NAME: Selficient
 ADDRESS: Padualaan 99
 3584CH Utrecht
 The Netherlands
 CONTACT: info@selficient.org
 www.selficient.org

CONSULTANTS
 ARCHITECTURE
 ENGINEERS
 LANDSCAPING
 SAFETY FIRST CODE CONSULTANTS

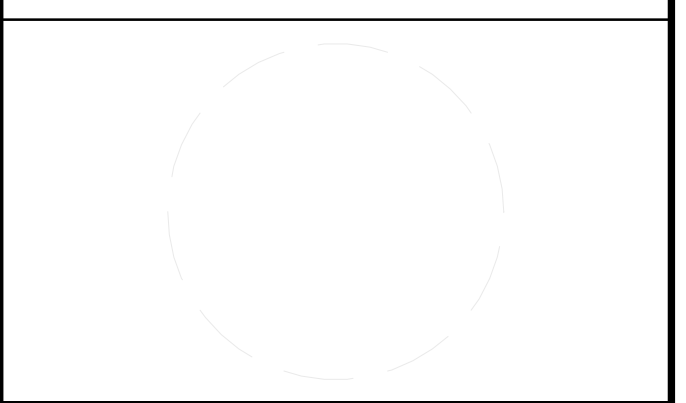

CLIENT
 U.S. DEPARTMENT OF ENERGY
 SOLAR DECATHLON 2017
 WWW.SOLARDECATHLON.GOV




MARK	DATE	DESCRIPTION
Rev.00	11-17-2016	90% REVISION
Rev.01	02-24-2017	SECOND DESIGN
Rev.02	08-08-2017	FINAL DESIGN

LOT NUMBER: 106
 DRAWN BY: Kars Slagter
 CHECKED BY: Remco Polle
 COPYRIGHT: NONE; PROJECT IS PUBLIC DOMAIN

SHEET TITLE
 DOMESTIC RETURN ISOMETRIC

P-102

10-9-2017 14:38:45

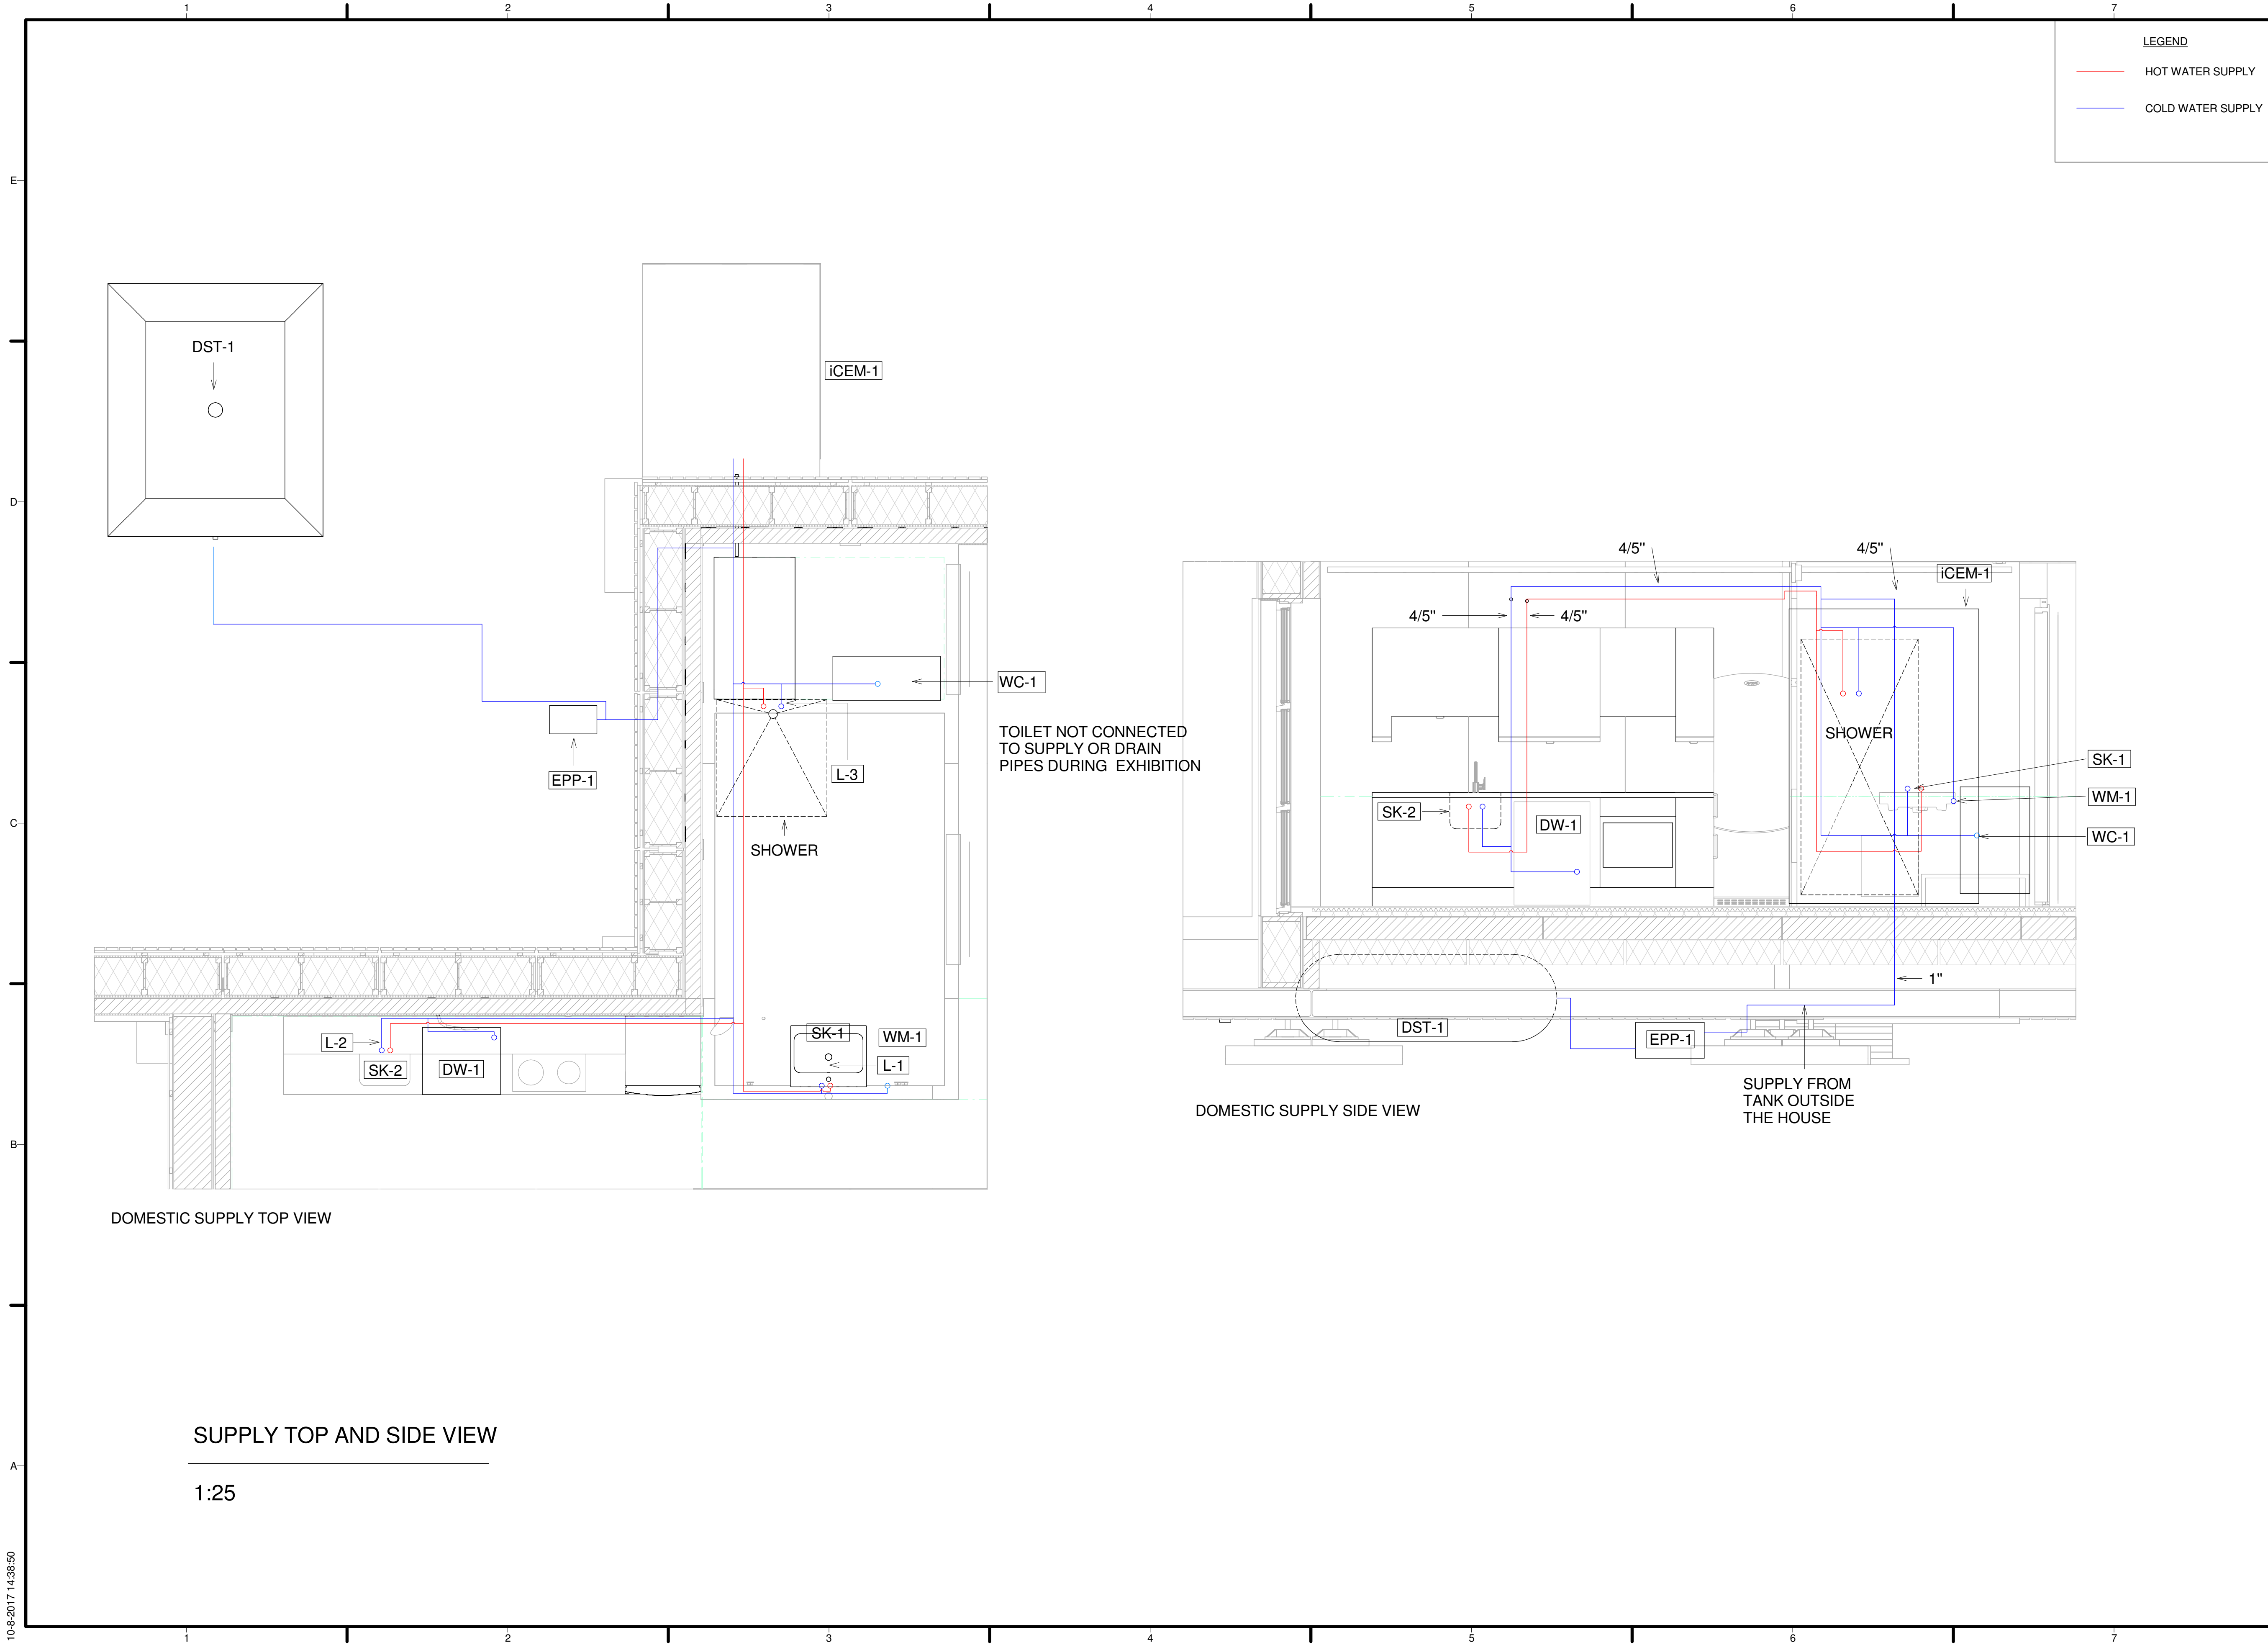

LEGEND


— HOT WATER SUPPLY

— COLD WATER SUPPLY



TEAM NAME: Selficient
 ADDRESS: Padualaan 99
 3584CH Utrecht
 The Netherlands
 CONTACT: info@selficient.org
 www.selficient.org

CONSULTANTS
 ARCHITECTURE
 ENGINEERS
 LANDSCAPING
 SAFETY FIRST CODE CONSULTANTS

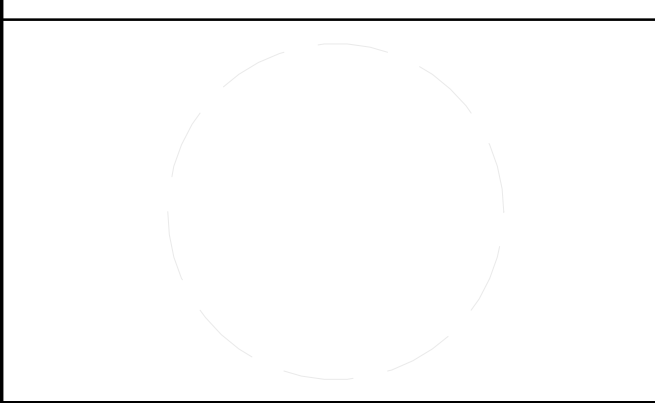

CLIENT
 U.S. DEPARTMENT OF ENERGY
 SOLAR DECATHLON 2017
 WWW.SOLARDECATHLON.GOV




MARK	DATE	DESCRIPTION
Rev.00	11-17-2016	90% REVISION
Rev.01	02-24-2017	SECOND DESIGN
Rev.02	08-08-2017	FINAL DESIGN

LOT NUMBER: 106
 DRAWN BY: Kars Slagter
 CHECKED BY: Remco Polle
 COPYRIGHT: NONE; PROJECT IS PUBLIC DOMAIN

SHEET TITLE
 DOMESTIC SUPPLY
 TOP AND SIDE

P-200

10-9-2017 14:38:50

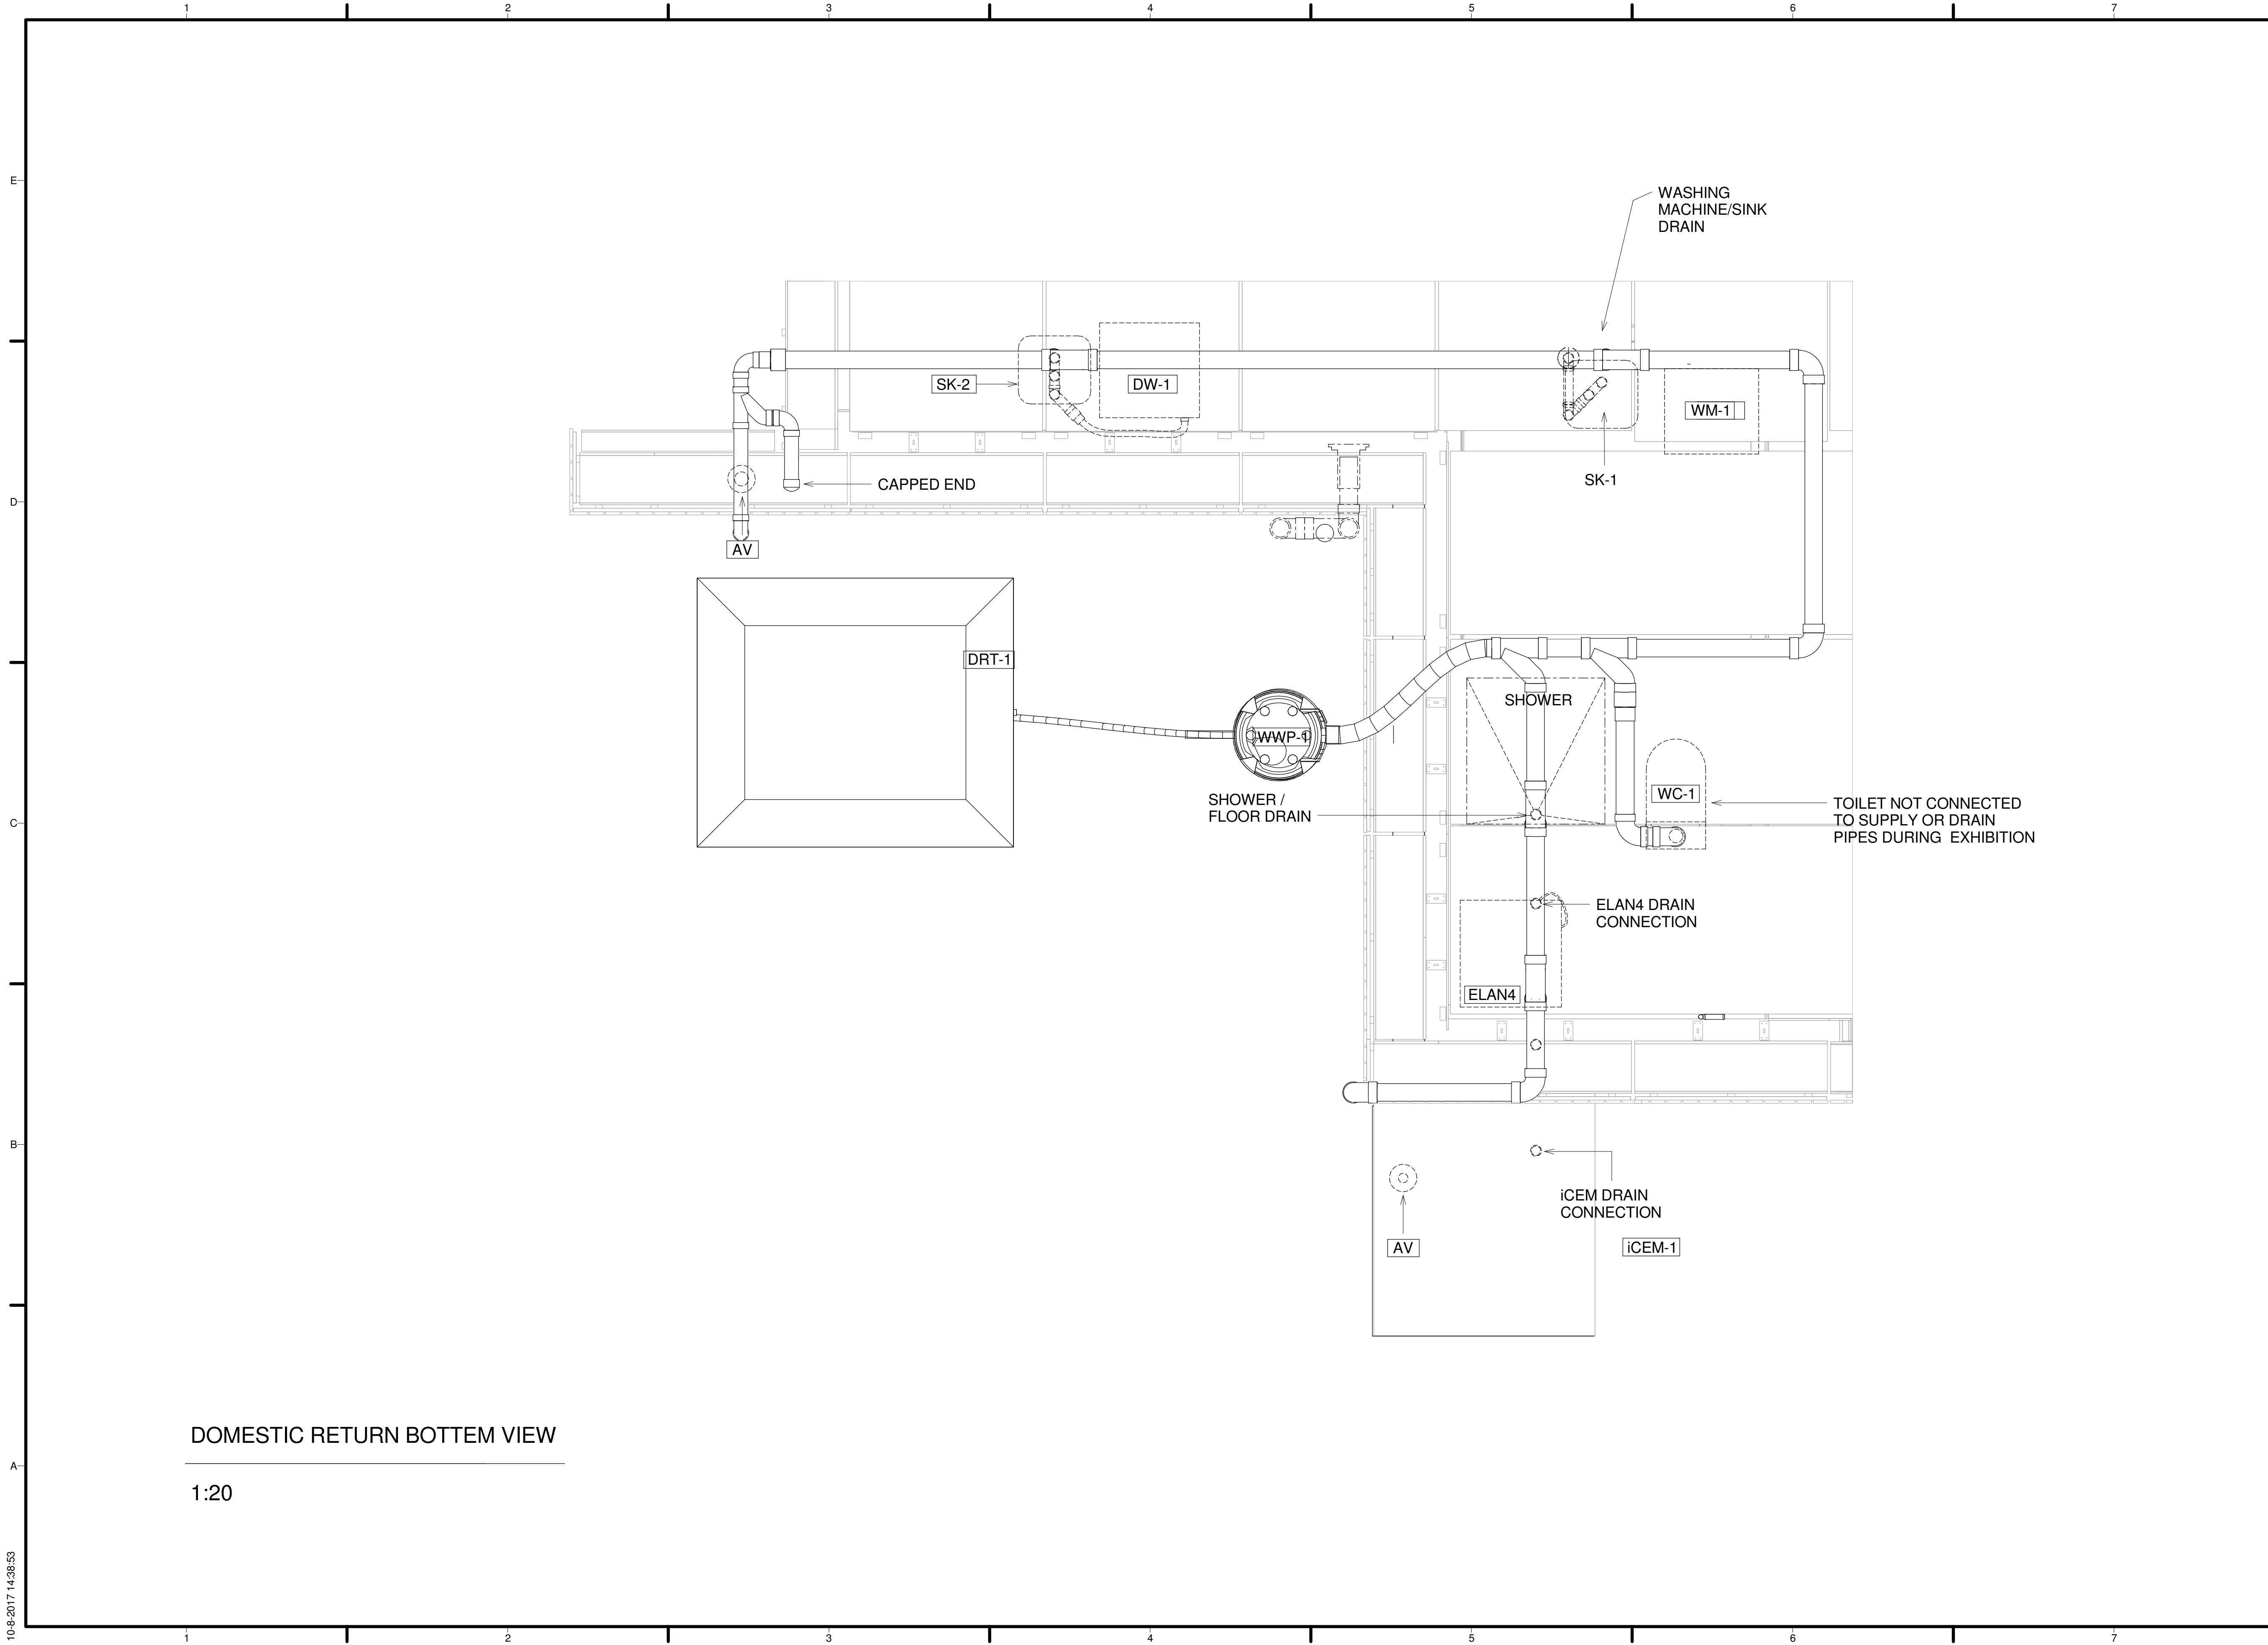


DOMESTIC RETURN BOTTEM VIEW

1:20



TEAM NAME: Selficient
 ADDRESS: Padualaan 99
 3584CH Utrecht
 The Netherlands
 CONTACT: info@selficient.org
 www.selficient.org

CONSULTANTS
 ARCHITECTURE
 ENGINEERS
 LANDSCAPING
 SAFETY FIRST CODE CONSULTANTS

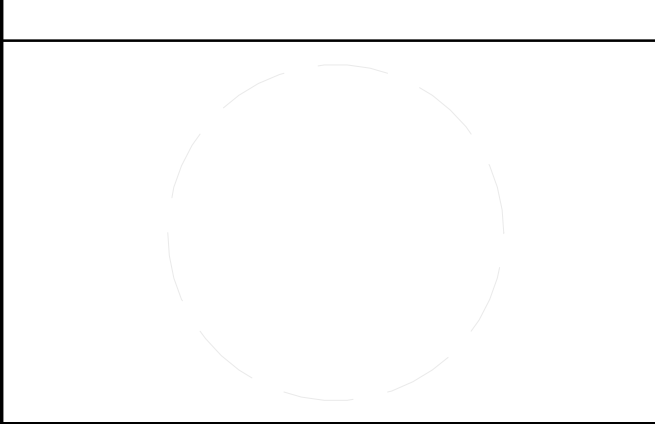

CLIENT
 U.S. DEPARTMENT OF ENERGY
 SOLAR DECATHLON 2017
 WWW.SOLARDECATHLON.GOV




MARK	DATE	DESCRIPTION
Rev.00	11-17-2016	90% REVISION
Rev.01	02-24-2017	SECOND DESIGN
Rev.02	08-08-2017	FINAL DESIGN

LOT NUMBER: 106
 DRAWN BY: Kars Slagter
 CHECKED BY: Remco Polle
 COPYRIGHT: NONE; PROJECT IS PUBLIC DOMAIN

SHEET TITLE
 DOMESTIC RETURN
 BOTTOM VIEW

P-201

10-9-2017 14:38:53

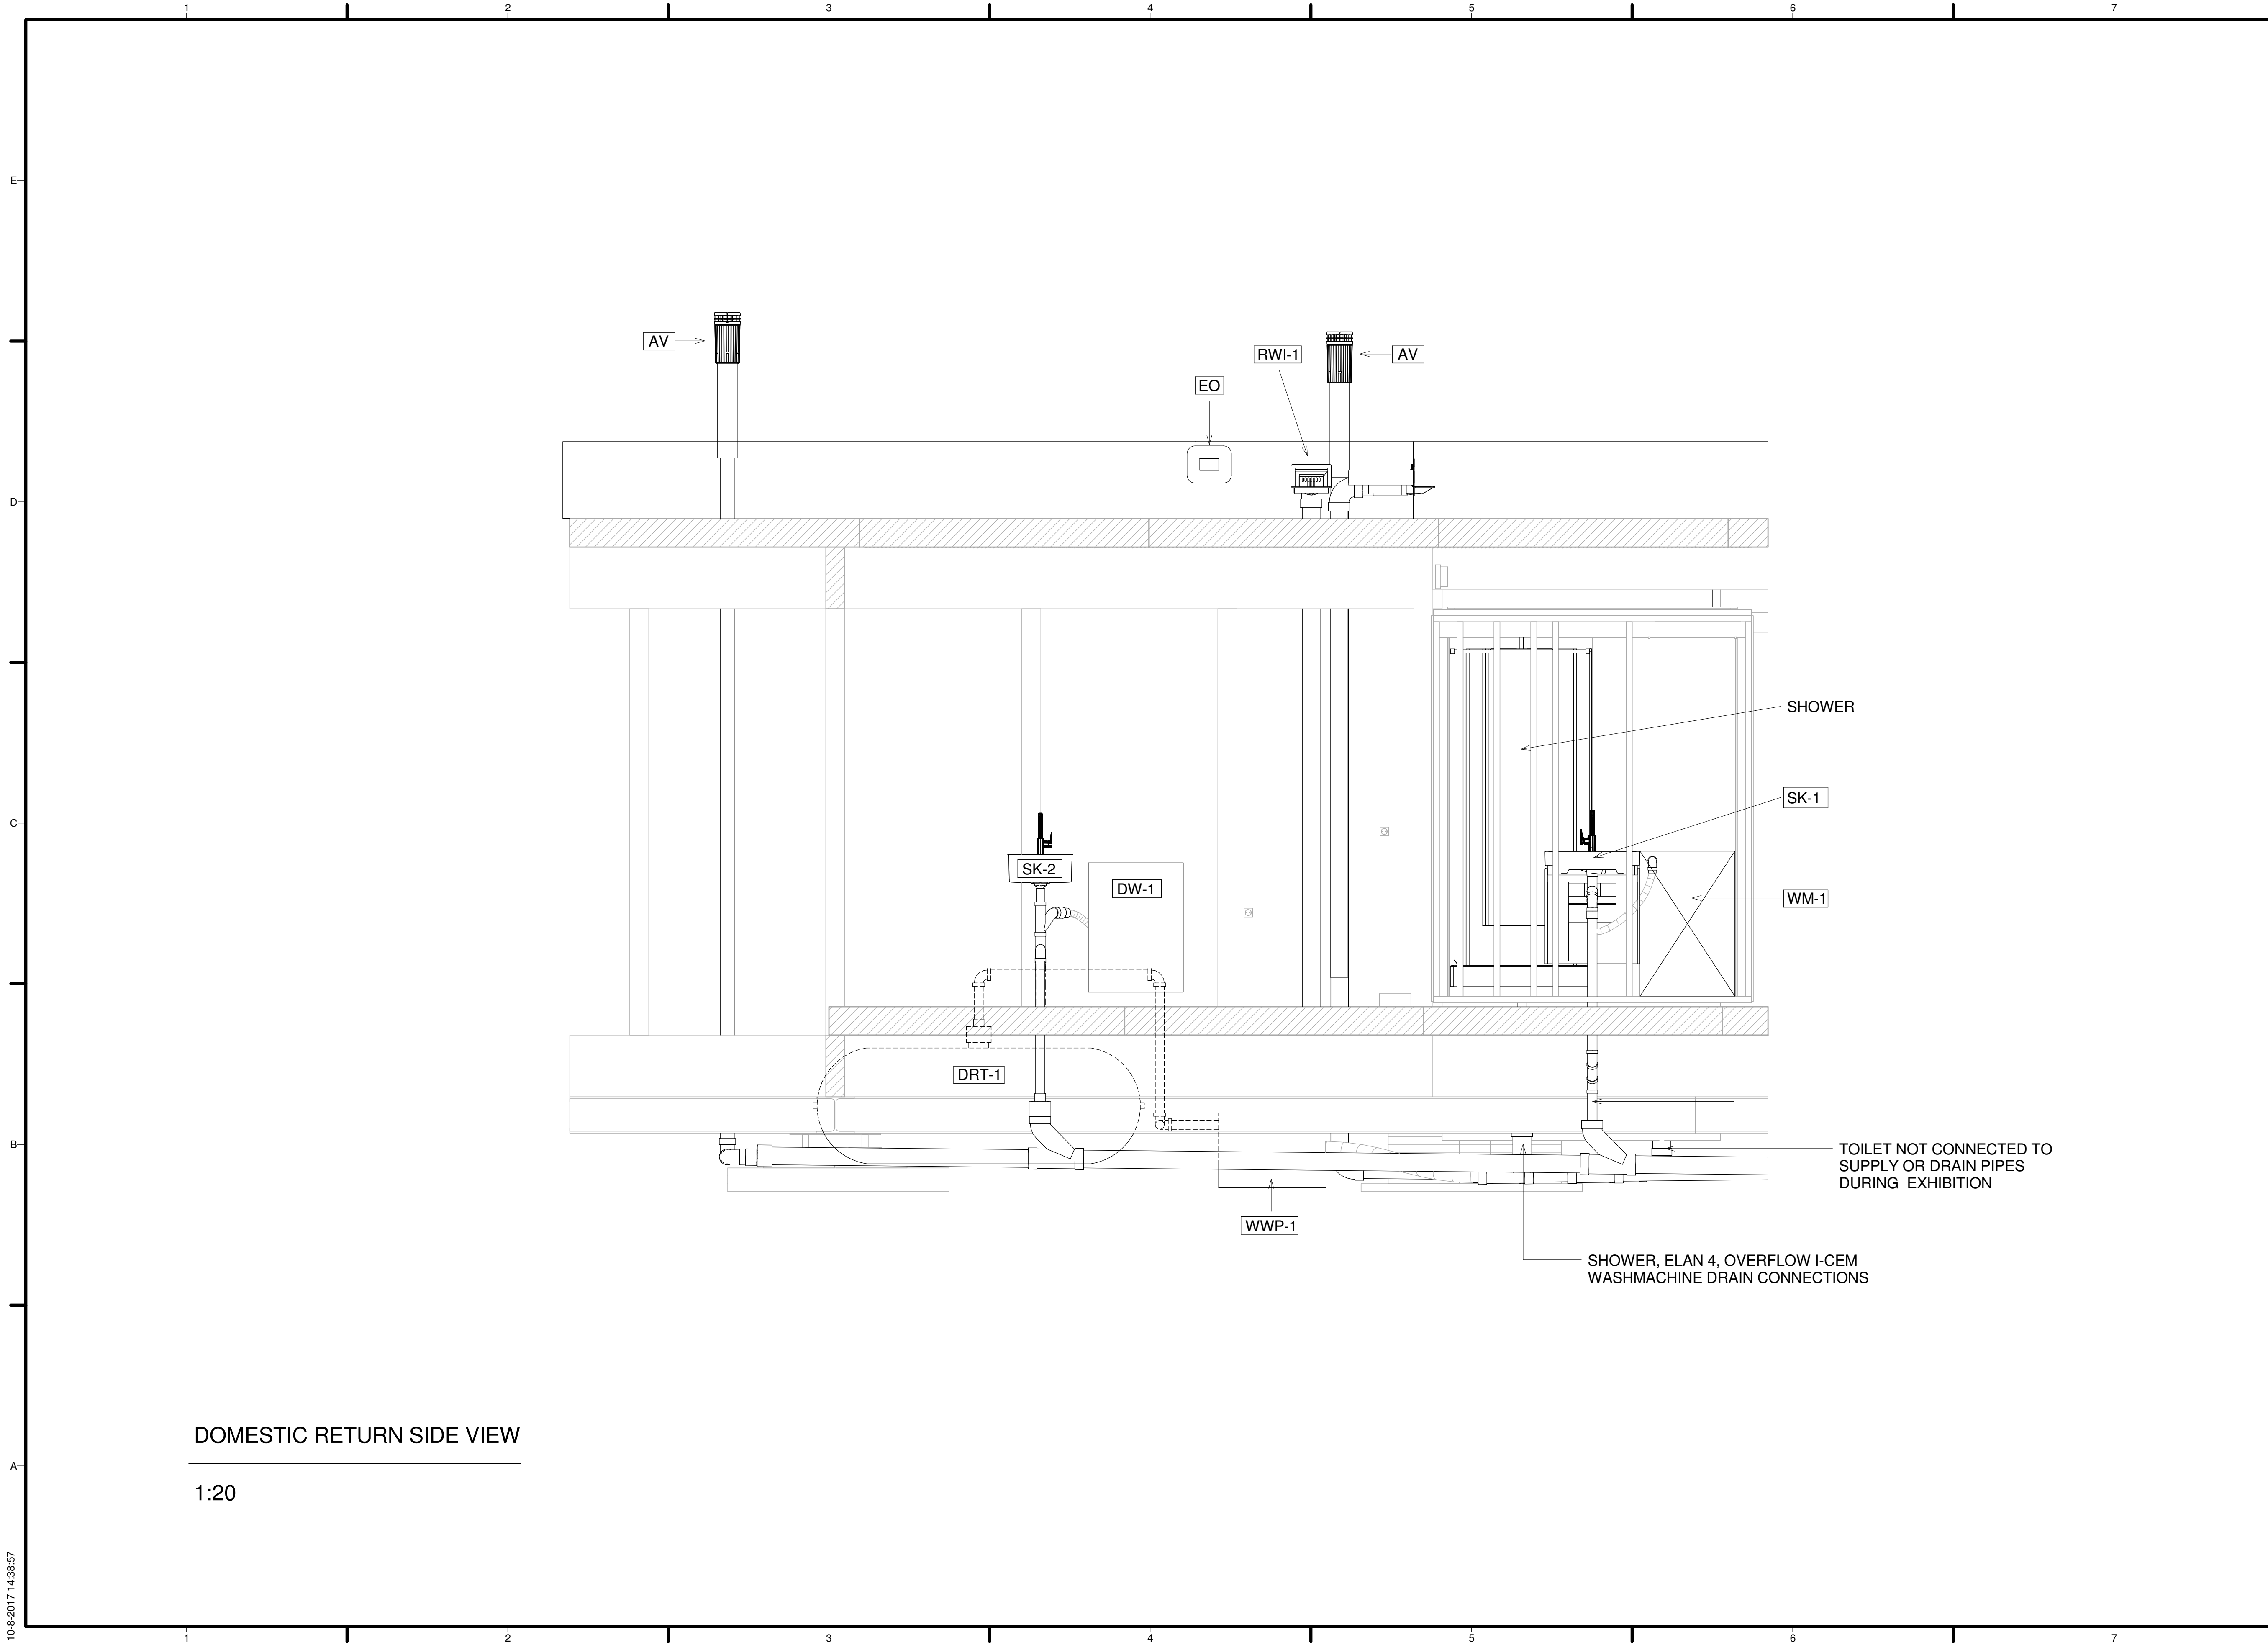


DOMESTIC RETURN SIDE VIEW

1:20



TEAM NAME: Selficient
 ADDRESS: Padualaan 99
 3584CH Utrecht
 The Netherlands
 CONTACT: info@selficient.org
 www.selficient.org

CONSULTANTS
 ARCHITECTURE
 ENGINEERS
 LANDSCAPING
 SAFETY FIRST CODE CONSULTANTS

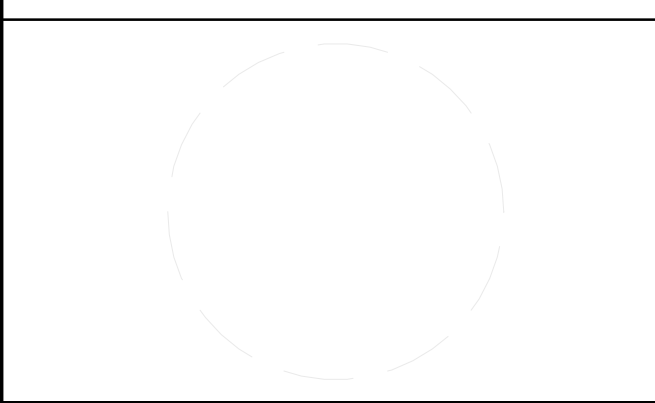

CLIENT
 U.S. DEPARTMENT OF ENERGY
 SOLAR DECATHLON 2017
 WWW.SOLARDECATHLON.GOV



MARK	DATE	DESCRIPTION
Rev.00	11-17-2016	90% REVISION
Rev.01	02-24-2017	SECOND DESIGN
Rev.02	08-08-2017	FINAL DESIGN

LOT NUMBER: 106
 DRAWN BY: Kars Slagter
 CHECKED BY: Remco Polle
 COPYRIGHT: NONE; PROJECT IS PUBLIC DOMAIN


SHEET TITLE
 DOMESTIC RETURN
 SIDE VIEW

P-300

10-8-2017 14:38:57

TEAM NAME: Selficient
 ADDRESS: Padualaan 99
 3584CH Utrecht
 The Netherlands
 CONTACT: info@selficient.org
 www.selficient.org

CONSULTANTS
 ARCHITECTURE
 ENGINEERS
 LANDSCAPING
 SAFETY FIRST CODE CONSULTANTS

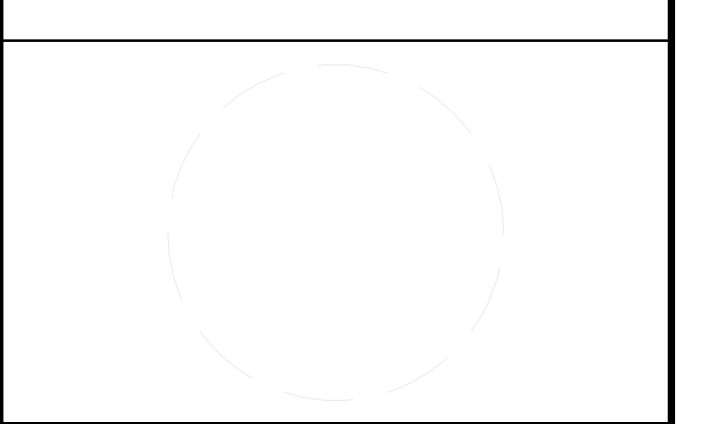

CLIENT
 U.S. DEPARTMENT OF ENERGY
 SOLAR DECATHLON 2017
 WWW.SOLARDECATHLON.GOV





MARK	DATE	DESCRIPTION
Rev.00	11-17-2016	90% REVISION
Rev.01	02-24-2017	SECOND DESIGN
Rev.02	08-08-2017	FINAL DESIGN


LOT NUMBER: 106
 DRAWN BY: Kars Slagter
 CHECKED BY: Remco Polle
 COPYRIGHT: NONE; PROJECT IS PUBLIC DOMAIN

SHEET TITLE
PLUMBING DETAILS

P-400

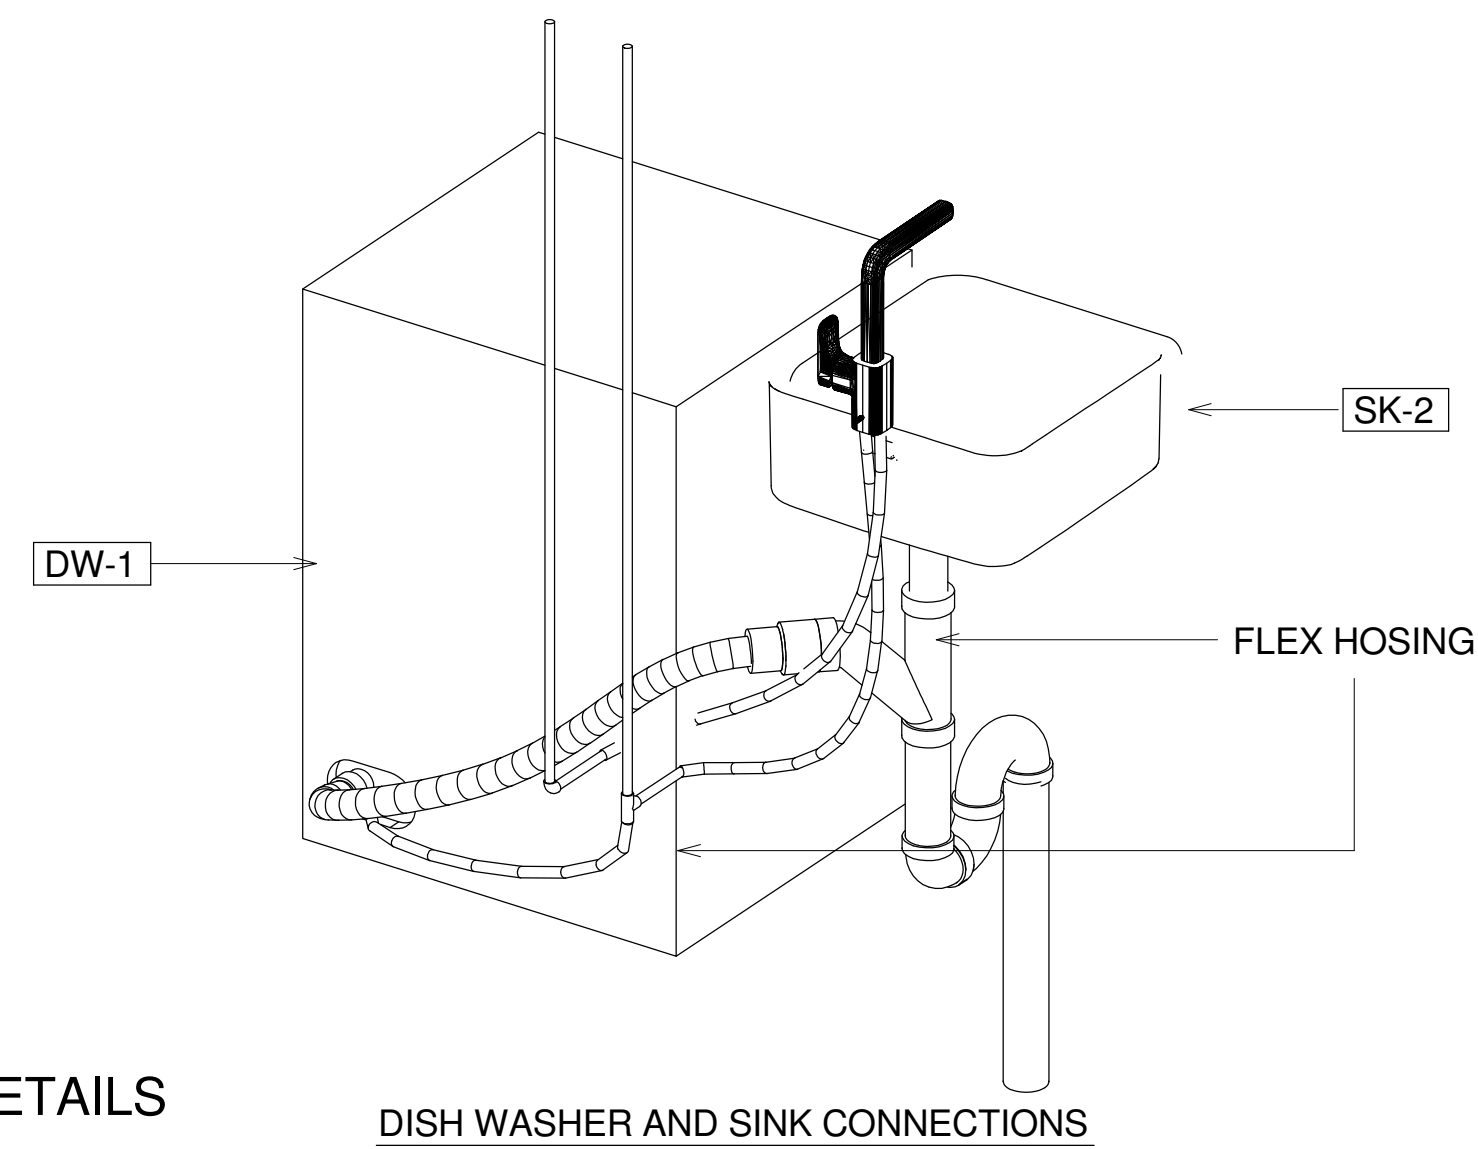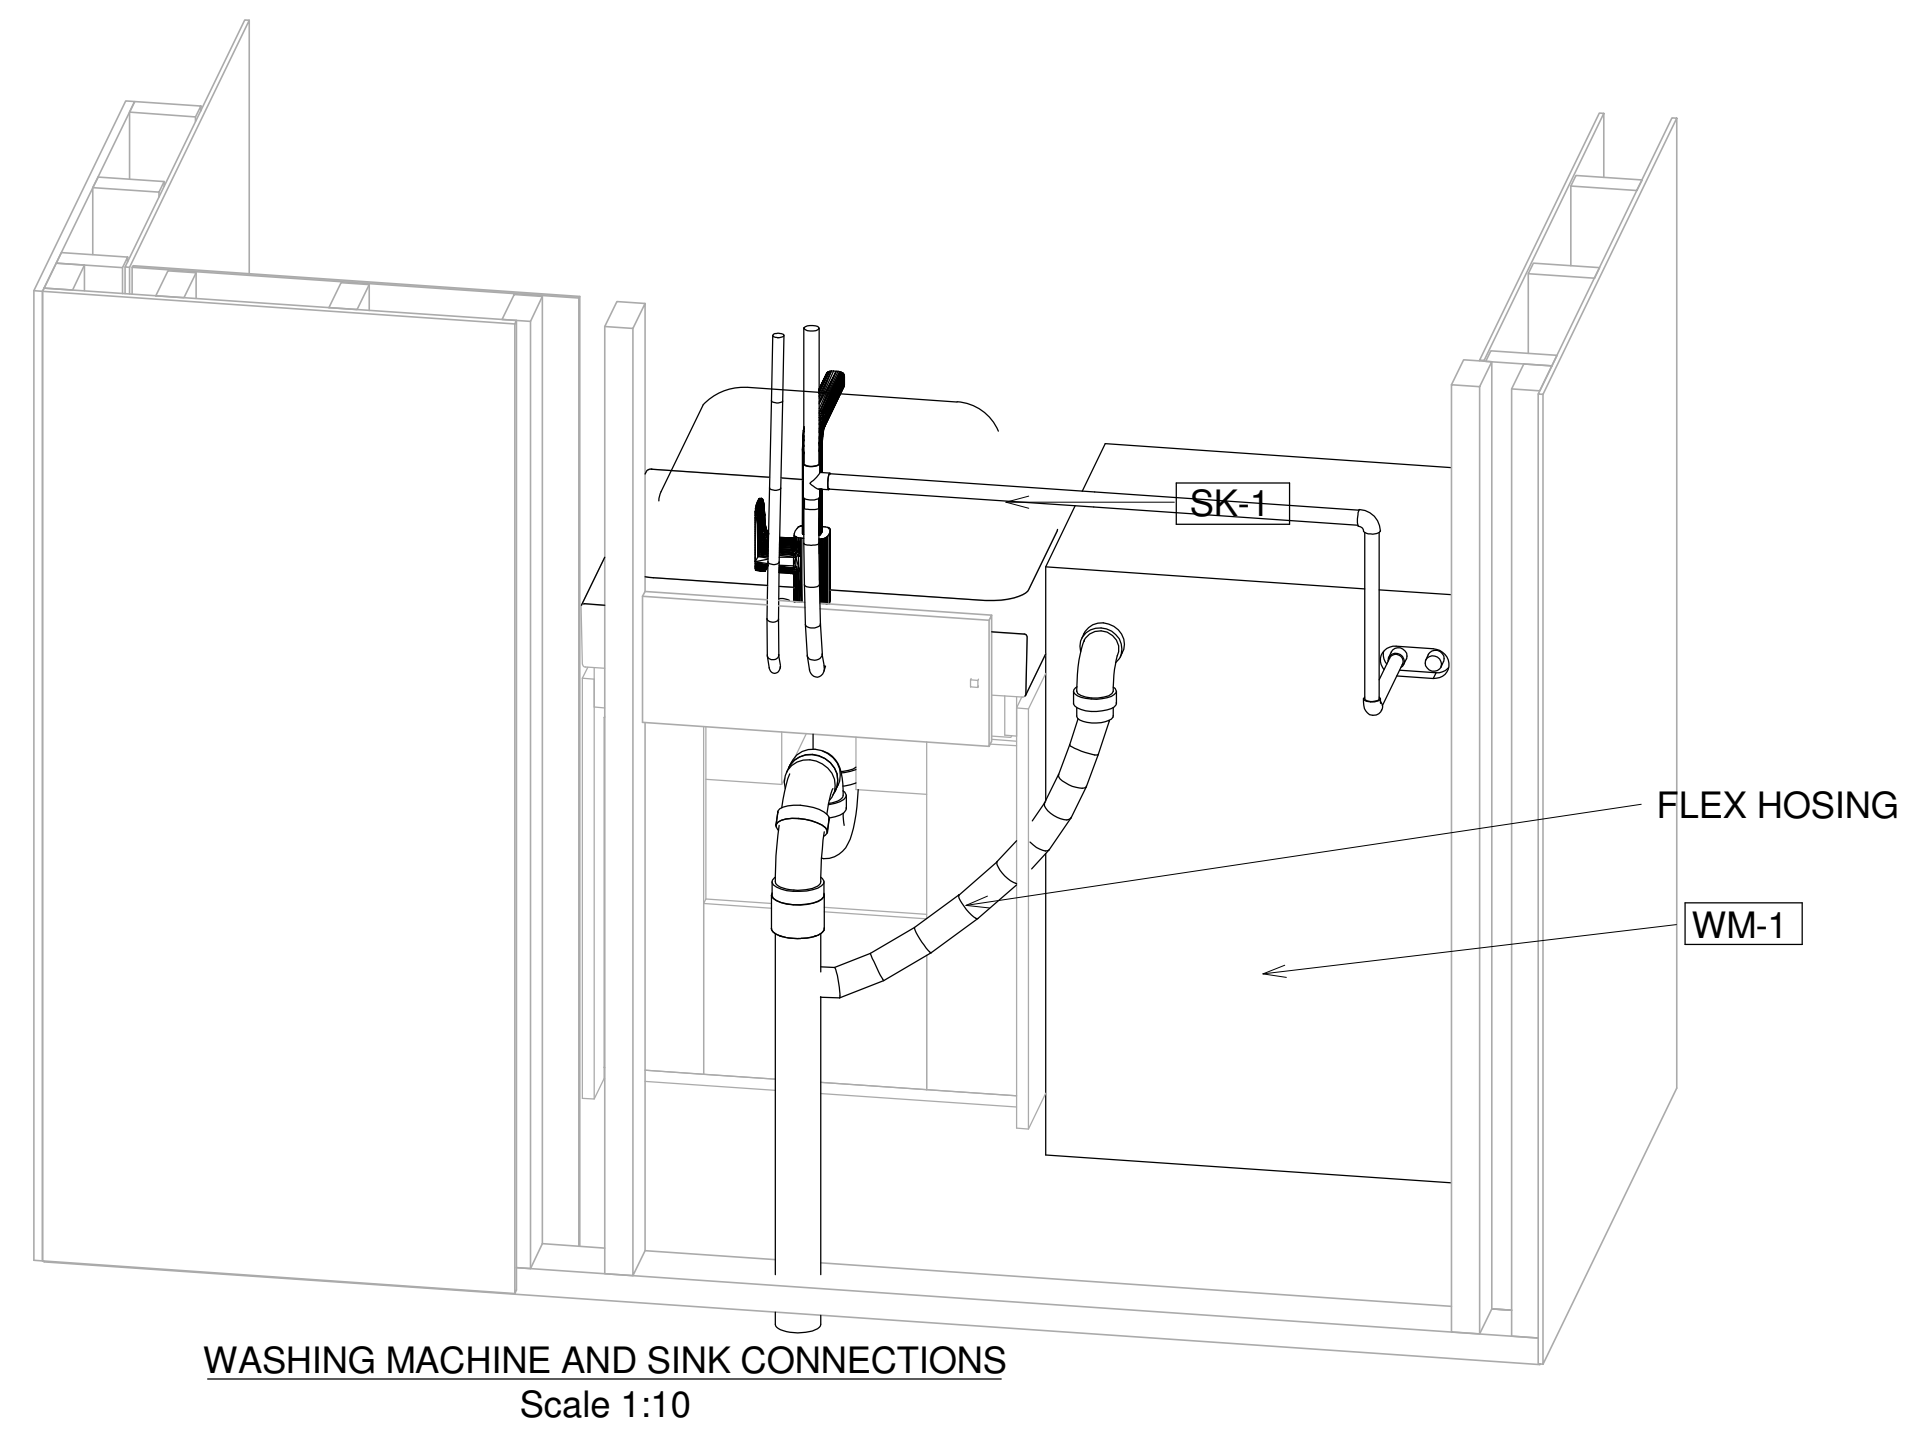

PLUMBING DETAILS
 1:10

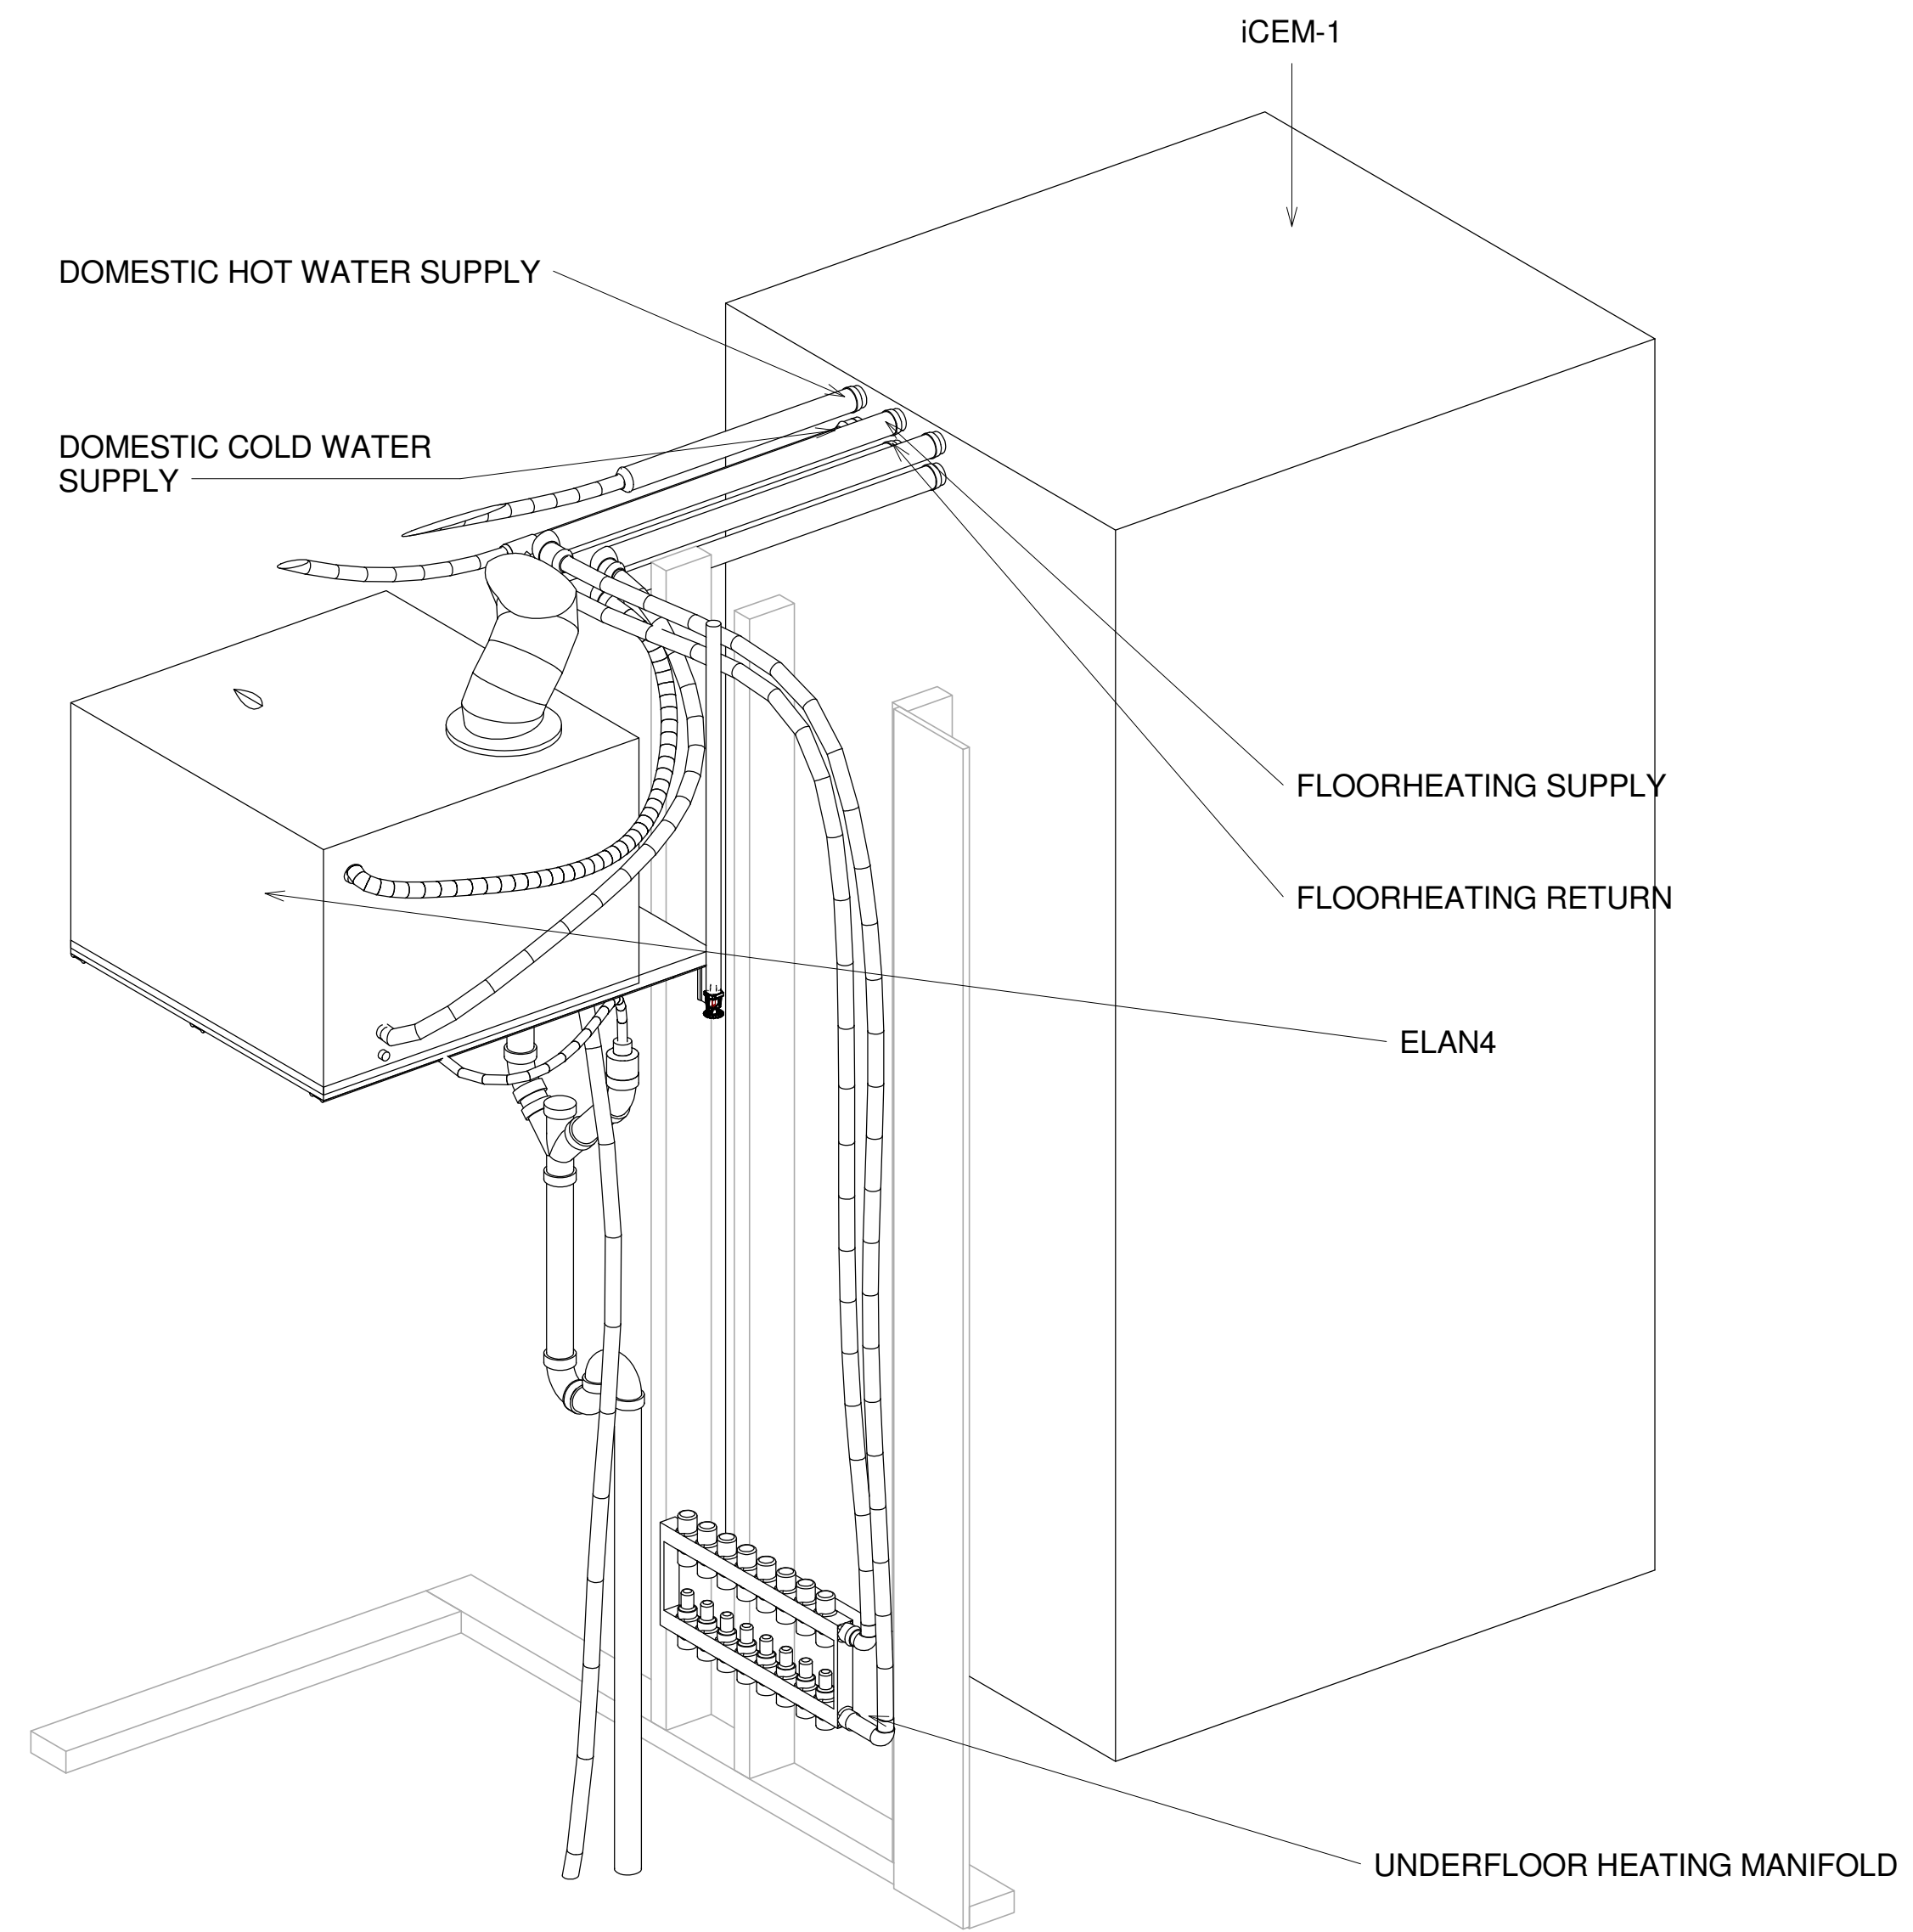

MECHANICAL ROOM (ELAN4, UNDERFLOOR HEATING MANIFOLD & iCEM CONNECTIONS AND PIPING)


Plumbing Fixture Schedule

Type Mark	Room: name	Description	Manufacturer	Model	Count	Dimensions (DxWxH) (mm)	URL
DST-1	Outside	Domestic Supply Tank	DAMME Kunststoffen	CUSTOM MADE	1	1700x2000x650	http://www.dammekunststoffen.nl/index.php
DRT-1	Outside	Domestic Return Tank	DAMME Kunststoffen	CUSTOM MADE	1	1700x2000x650	http://www.dammekunststoffen.nl/index.php
WWP-1	Outside	Waste Water Pump	WILO	DRAINLIFT	1	580x395	
EPP-1	Outside	Electronic Pressure Pump	WILO	FMC	1	377x232x506	
iCEM-1	Mech Room	iCEM module	LG	iCEM	1	1500x980x2410	
WC-1	Bathroom	Water Closet	GEBERIT	MERA COMFORT	1	205x470x1135	
WM-1	Bathroom	Wash Machine	SAMSUNG	WD80J6400AW	1	550x598x818	
SK-2	Bathroom	Sink	SPHINX	T09COLLU06GDS	1	445x393x160	
Shower	Bathroom	Shower	XENZ BV	UPFALL SHOWER	1	900x1200x2130	http://www.upfallshower.com/wp-content/uploads/2015/04/Upfall-Brochure-januari-2017.pdf
SK-1	Kitchen	Sink	IKEA	O.novo	1	500x400x170	
DW-1	Kitchen	Dish Washer	IKEA	DIN29330	1	540x600x840	
RWI-1	Roof	Rainwater Inlet	Marley Alutec	DR450	1	217x148x193	http://www.marleyalutec.co.uk/products/roof-outlet-systems/roof-outlets/?ProductIds=13927
EO	Roof	Emergency overflow	Fleck-dach	FLECK-FRN	1	235x280x500	http://www.fleck-dach.de/cms2/images/pdf/Notueberlauf_BIG_04-11.pdf



TEAM NAME: Selficient
 ADDRESS: Padualaan 99
 3584CH Utrecht
 The Netherlands
 CONTACT: info@selficient.org
 www.selficient.org

CONSULTANTS
 ARCHITECTURE
 ENGINEERS
 LANDSCAPING
 SAFETY FIRST CODE CONSULTANTS

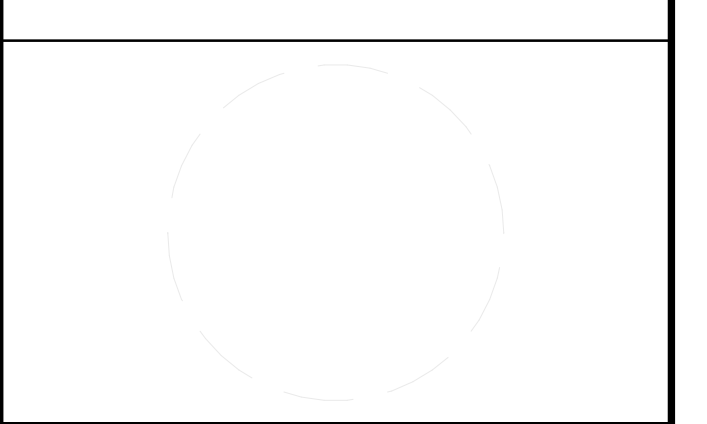

CLIENT
 U.S. DEPARTMENT OF ENERGY
 SOLAR DECATHLON 2017
 WWW.SOLARDECATHLON.GOV



Rev.00	11-17-2016	90% REVISION
Rev.01	02-24-2017	SECOND DESIGN
Rev.02	08-08-2017	FINAL DESIGN
MARK	DATE	DESCRIPTION

LOT NUMBER: 106
 DRAWN BY: Kars Slagter
 CHECKED BY: Remco Polle
 COPYRIGHT: NONE; PROJECT IS PUBLIC DOMAIN

SHEET TITLE
PLUMBING FIXTURE SCHEDULE

P-500


Flow Rate Schedule

FLOW RATE (gpm)	3/4-INCH WATER SERVICE PRESSURE LOSS (psi)				1-INCH WATER SERVICE PRESSURE LOSS (psi)				1 1/4 -INCH WATER SERVICE PRESSURE LOSS (psi)			
	Length of water service pipe (feet)				Length of water service pipe (feet)				Length of water service pipe (feet)			
	40 or less	41 to 75	76 to 100	101 to 150	40 or less	41 to 75	76 to 100	101 to 150	40 or less	41 to 75	76 to 100	101 to 150
	8	5.1	8.7	11.8	17.4	1.5	2.5	3.4	5.1	0.6	1.0	1.3
10	7.7	13.1	17.8	26.3	2.3	3.8	5.2	7.7	0.8	1.4	2.0	2.9
12	10.8	18.4	24.9	NP	3.2	5.4	7.3	10.7	1.2	2.0	2.7	4.0
14	14.4	24.5	NP	NP	4.2	7.1	9.6	14.3	1.6	2.7	3.6	5.4
16	18.4	NP	NP	NP	5.4	9.1	12.4	18.3	2.0	3.4	4.7	6.9
18	22.9	NP	NP	NP	6.7	11.4	15.4	22.7	2.5	4.3	5.8	8.6
20	27.8	NP	NP	NP	8.1	13.8	18.7	27.6	3.1	5.2	7.0	10.4
22	NP	NP	NP	NP	9.7	16.5	22.3	NP	3.7	6.2	8.4	12.4
24	NP	NP	NP	NP	11.4	19.3	26.2	NP	4.3	7.3	9.9	14.6
26	NP	NP	NP	NP	13.2	22.4	NP	NP	5.0	8.5	11.4	16.9
28	NP	NP	NP	NP	15.1	25.7	NP	NP	5.7	9.7	13.1	19.4
30	NP	NP	NP	NP	17.2	NP	NP	NP	6.5	11.0	14.9	22.0
32	NP	NP	NP	NP	19.4	NP	NP	NP	7.3	12.4	16.8	24.8
34	NP	NP	NP	NP	21.7	NP	NP	NP	8.2	13.9	18.8	NP
36	NP	NP	NP	NP	24.1	NP	NP	NP	9.1	15.4	20.9	NP



TEAM NAME: Selficient
 ADDRESS: Padualaan 99, 3584CH Utrecht, The Netherlands
 CONTACT: info@selficient.org, www.selficient.org

CONSULTANTS
 ARCHITECTURE
 ENGINEERS
 LANDSCAPING
 SAFETY FIRST CODE CONSULTANTS

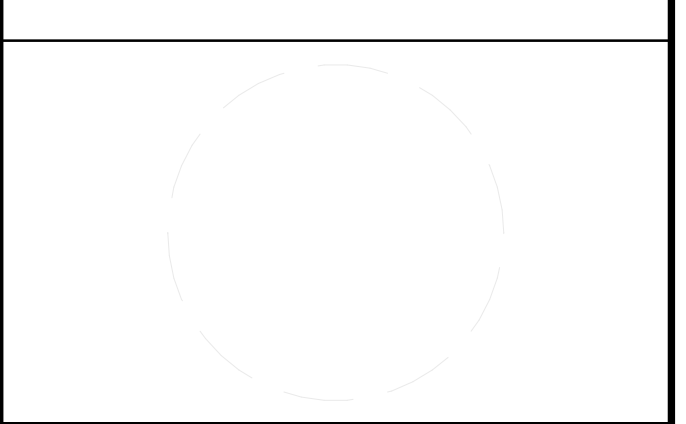

CLIENT
 U.S. DEPARTMENT OF ENERGY
 SOLAR DECATHLON 2017
 WWW.SOLARDECATHLON.GOV




Rev. 00	02-24-2017	ADD. SCHEDULE
MARK	DATE	DESCRIPTION

LOT NUMBER: 106
 DRAWN BY: Kars Slagter
 CHECKED BY: Remco Polle
 COPYRIGHT: NONE; PROJECT IS PUBLIC DOMAIN

SHEET TITLE
FLOW RATE SCHEDULE

P-501

Mech Symbols

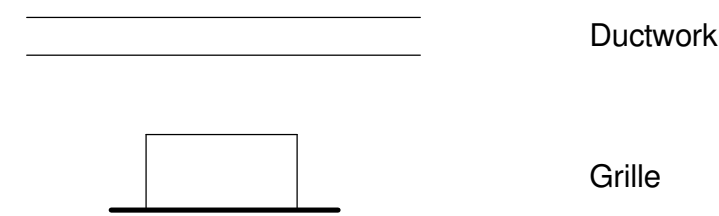

Mech Abbreviations

EG	Exhaust grille
RG	Return grille
VU	Distribution unit floor heating

HVAC notes and symbols

Section R106.11 Information on construction documents

R106.1.1 Information on construction documents. Construction documents shall be drawn upon suitable material. Electronic media documents are permitted to be submitted where approved by the building official. Construction documents shall be of sufficient clarity to indicate the location, nature and extent of the work proposed and show in detail that it will conform to the provisions of this code and relevant laws, ordinances, rules and regulations, as determined by the building official.

Section M1307 Appliance installation

M1307.1 General. Installation of appliances shall conform to the conditions of their listing and label and the manufacturer's instructions. The manufacturer's operating and installation instructions shall remain attached to the appliance.

M1307.2 Anchorage of appliances. Appliances designed to be fixed in position shall be fastened or anchored in an approved manner. In Seismic Design Categories D0, D1 and D2, and in townhouses in Seismic Design Category C, water heaters and thermal storage units shall be anchored or strapped to resist horizontal displacement caused by earthquake motion in accordance with one of the following:

1. Anchorage and strapping shall be designed to resist a horizontal force equal to one-third of the operating weight of the water heater storage tank, acting in any horizontal direction. Strapping shall be at points within the upper one-third and lower one-third of the appliance's vertical dimensions. At the lower point, the strapping shall maintain a minimum distance of 4 inches (102 mm) above the controls.
2. The anchorage strapping shall be in accordance with the appliance manufacturer's recommendations.

Section M1308 Mechanical systems installation

M1308.1 Drilling and notching. Wood-framed structural members shall be drilled, notched or altered in accordance with the provisions of Sections R502.8, R602.6, R602.6.1 and R602.7. Holes in load-bearing members of cold-formed steel light-frame constructions shall be permitted only in accordance with Sections R505.2.6, R603.2.6 and R604.2.6. In accordance with the provisions of Sections R505.3.5, R603.3.4 and R604.3.3, cutting and notching of flanges and lips of load-bearing members of cold-formed steel light frame constructions shall not be permitted. Structural insulated panels (SIPs) shall be drilled and notched or altered in accordance with the provisions of Sections R610.7.

Section M1401 General

M1401.1 Installation. Heating and cooling equipment and appliances shall be installed in accordance with the manufacturer's instructions and the requirements of this code.

M1401.2 Access. Heating and cooling equipment and appliances shall be located with respect to building construction and other equipment and appliances to permit maintenance, servicing and replacement. Clearances shall be maintained to permit cleaning of heating and cooling surfaces; replacement of filters, blowers, motor, controls and vent connections; lubrication of moving parts; and adjustments.

Exception: Acces shall not be required for ducts, piping, or other components approved for concealment.

M1401.3 Equipment and appliances sizing. Heating and cooling equipment and appliances shall be sized in accordance with ACCA Manual S or other approved sizing methodologies based on building loads calculated in accordance with ACCA Manual J or other approved heating and cooling calculation methodologies.

M1401.4 Exterior installations. Equipment and appliances installed outdoors shall be listed and labeled for outdoor installation. Supports and foundations shall prevent excessive vibration, settlement or movement of the equipment. Support and foundations shall be in accordance with Section M1305.1.4.1.

Section M1403 Heat pump equipment

M1403.1 Heat Pumps. Electric heat pumps shall be listed and labeled in accordance with UL 1995 or UL/CSA/ANCE 60335-2-40.

Section M1501 General

M1501.1 Outdoor discharge. The air removed by every mechanical exhaust system shall be discharged to the outdoors in accordance with Section M1506.3. Air shall not be exhausted into an attic, soffit, ridge vent or crawl space.

Exception: Whole-house ventilation-type attic fans that discharge into the attic space of dwelling units having private attics shall be permitted.

Section M1506 Exhaust ducts and exhaust openings

M1506.1 Duct construction. Where exhaust duct construction is not specified in this chapter, construction shall comply with Chapter 16.

M1506.3 Exhaust openings. Air exhaust openings shall terminate not less than 3 feet (914 mm) from property lines; 3 feet (914 mm) from operable and nonoperable openings into the building and 10 feet (3048 mm) from mechanical air intakes except where the opening is located 3 feet (914 mm) above air intake. Openings shall comply with Sections R303.5.2 and R303.6.

Section M1507 Mechanical ventilation

M1507.1 General. Where local exhaust or whole-house mechanical ventilation is provided, the equipment shall be designed in accordance with this section.

M1507.2 Recirculation of air. Exhaust air from bathrooms and toilet rooms shall not be recirculated within a residence or to another dwelling unit and shall be exhausted directly to the outdoors. Exhaust air from bathrooms and toilet rooms shall not discharge into an attic, crawl space or other areas inside the building.

M1507.3 Whole-house mechanical ventilation system. Whole-house mechanical ventilation systems shall be designed in accordance with Sections M1507.3.1 through M1507.3.3.

M1507.3.1 System design. The whole-house ventilation system shall consist of one or more supply or exhaust fans, or a combination of such, and associated ducts and controls. Local exhaust or supply fans are permitted to serve as such a system. Outdoor air ducts connected to the return side of an air handler shall be considered as providing supply ventilation.

M1507.3.2 System controls. The whole-house mechanical ventilation system shall be provided with controls that enable manual override.

Section M1601 Duct construction

M1601.1 Duct design. Duct systems serving heating, cooling and ventilation equipment shall be installed in accordance with the provisions of this section and ACCA Manual D, the appliance manufacturer's installation instructions or other approved methods.

M1601.1.1 Above-ground duct systems. Above-ground duct systems shall conform to the following.

1. Equipment connected to duct systems shall be designed to limit discharge air temperature to not greater than 250°F (121°C).
2. Factory-made ducts shall be listed and labeled in accordance with UL 181 and installed in accordance with the manufacturer's instructions.
3. Fibrous glass duct construction shall conform to the SMACNA Fibrous Glass Duct Construction Standards or NAIMA Fibrous Glass Duct Construction Standards.
4. Field-fabricated and shop-fabricated metal and flexible duct constructions shall conform to the SMACNA HVAC Duct Construction Standards - Metal and Flexible except as allowed by Table M1601.1.1. Galvanized steel shall conform to ASTM A 653.
5. The use of gypsum products to construct return air ducts or plenums is permitted, provided that the air temperature does not exceed 125°F (52°C) and exposed surfaces are not subject to condensation.
6. Duct systems shall be constructed of materials having a flame spread index of not greater than 200.
7. Stud wall cavities and the spaces between solid floor joist to be used as air plenums shall comply with the following conditions:
 - 7.1 These cavities or spaces shall not be used as a plenum for supply air.
 - 7.2 These cavities or spaces shall not be part of a required fire-resistance-rated assembly.
 - 7.3 Stud wall cavities shall not convey air from more than one floor level.
 - 7.4 Stud wall cavities and joist-space plenums shall be isolated from adjacent concealed spaces by tight-fitting fireblocking in accordance with Section R602.8.
 - 7.5 Stud wall cavities in the outside walls of building envelope assemblies shall not be utilized as air plenums.

M1601.4 Installation. Duct installation shall comply with Sections M1601.4.1 through M1601.4.10.

Section M1602 Return air

M1602.1 Outdoor air openings. Outdoor intake openings shall be located in accordance with Section R303.5.1. Opening protection shall be in accordance with Section R303.6.

M1602.2 Return air openings. Return air openings for heating, ventilation and air conditioning systems shall comply with all of the following:

1. Openings shall not be located less than 10 feet (3048 mm) measured in any direction from an open combustion chamber or draft hood of another appliance located in the same room or space.
2. The amount of return air taken from any room or space shall be not greater than the flow rate of supply air delivered to such room or space.
3. Return and transfer openings shall be sized in accordance with the appliance or equipment manufacturer's installation instructions, Manual D or the design of the registered design professional.
4. Return air shall not be taken from a closet, bathroom, toilet room, kitchen, garage, mechanical room, boiler room, furnace room or unconditioned attic.

Exceptions:

1. Taking return air from kitchen is not prohibited where such return air openings serve the kitchen only, and are located not less than 10 feet (3048 mm) from the cooking appliances.
2. Dedicated forced-air systems serving only the garage shall not be prohibited from obtaining return air from the garage.
3. Taking return air from an unconditioned crawl space shall not be accomplished through a direct connection to the return side of a forced-air furnace. Transfer openings in the crawl space enclosure shall not be prohibited.
4. Return air from one dwelling unit shall not be discharged into another dwelling unit.

L1 iCEM module

L1.1 Explanation iCEM module. In the iCEM module, is the ventilation unit located. The ventilation unit is a Renovent Excellent 400.

B1 Special installation specifications:

B1.1 General installation Elan 4. The unit is supplied fully wired. When installing the Elan 4, the water connections and the system air ducts must be at the air outlet side. If the Elan 4 in combination with a heat recovery unit is used, there should also be a condensate drain installed. Then, the unit can be connected to the power grid. See installation Manual Elan 4 for details and installation instructions.

B1.2 General installation Renovent Excellent 400. See installation instructions Renovent Excellent 400 for details and installation manual


B1.3 Explanation and installation distributor unit. The distributor unit divides the hot water in to the different underfloor heating systems(7 heating circuits). The distributor unit is installed against the bathroom module.

Room	Square	Airflow	Vent. rate
Bathroom and toilet	5.3 m ²	50.4 m ³ /h	4.13 1/h
Bedroom	18 m ²	45.36 m ³ /h	1.03 1/h
Living room, Kitchen and Hall	41.5 m ²	134.36 m ³ /h	1.25 1/h
Mechanical room	2.5 m ²	18 m ³ /h	2.77 1/h



TEAM NAME:	Selficient
ADDRESS:	Padualaan 99 3584CH Utrecht The Netherlands
CONTACT:	info@selficient.org www.selficient.org

CONSULTANTS
ARCHITECTURE
ENGINEERS
LANDSCAPING
SAFETY FIRST CODE CONSULTANTS

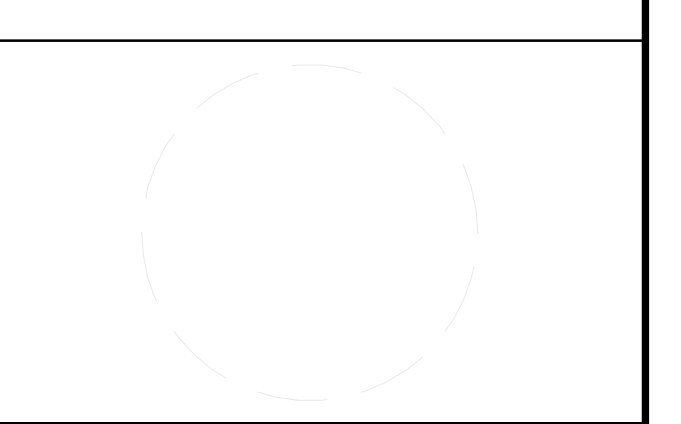

CLIENT	U.S. DEPARTMENT OF ENERGY SOLAR DECATHLON 2017 WWW.SOLARDECATHLON.GOV
--------	---




Rev. 00	02-24-2017	ADD. NOTES AND SYMBOLS
MARK	DATE	DESCRIPTION

LOT NUMBER:	106
DRAWN BY:	Mads de Kock
CHECKED BY:	Remco Polle
COPYRIGHT:	NONE; PROJECT IS PUBLIC DOMAIN

SHEET TITLE	HVAC NOTES AND SYMBOLS
-------------	------------------------

M-001

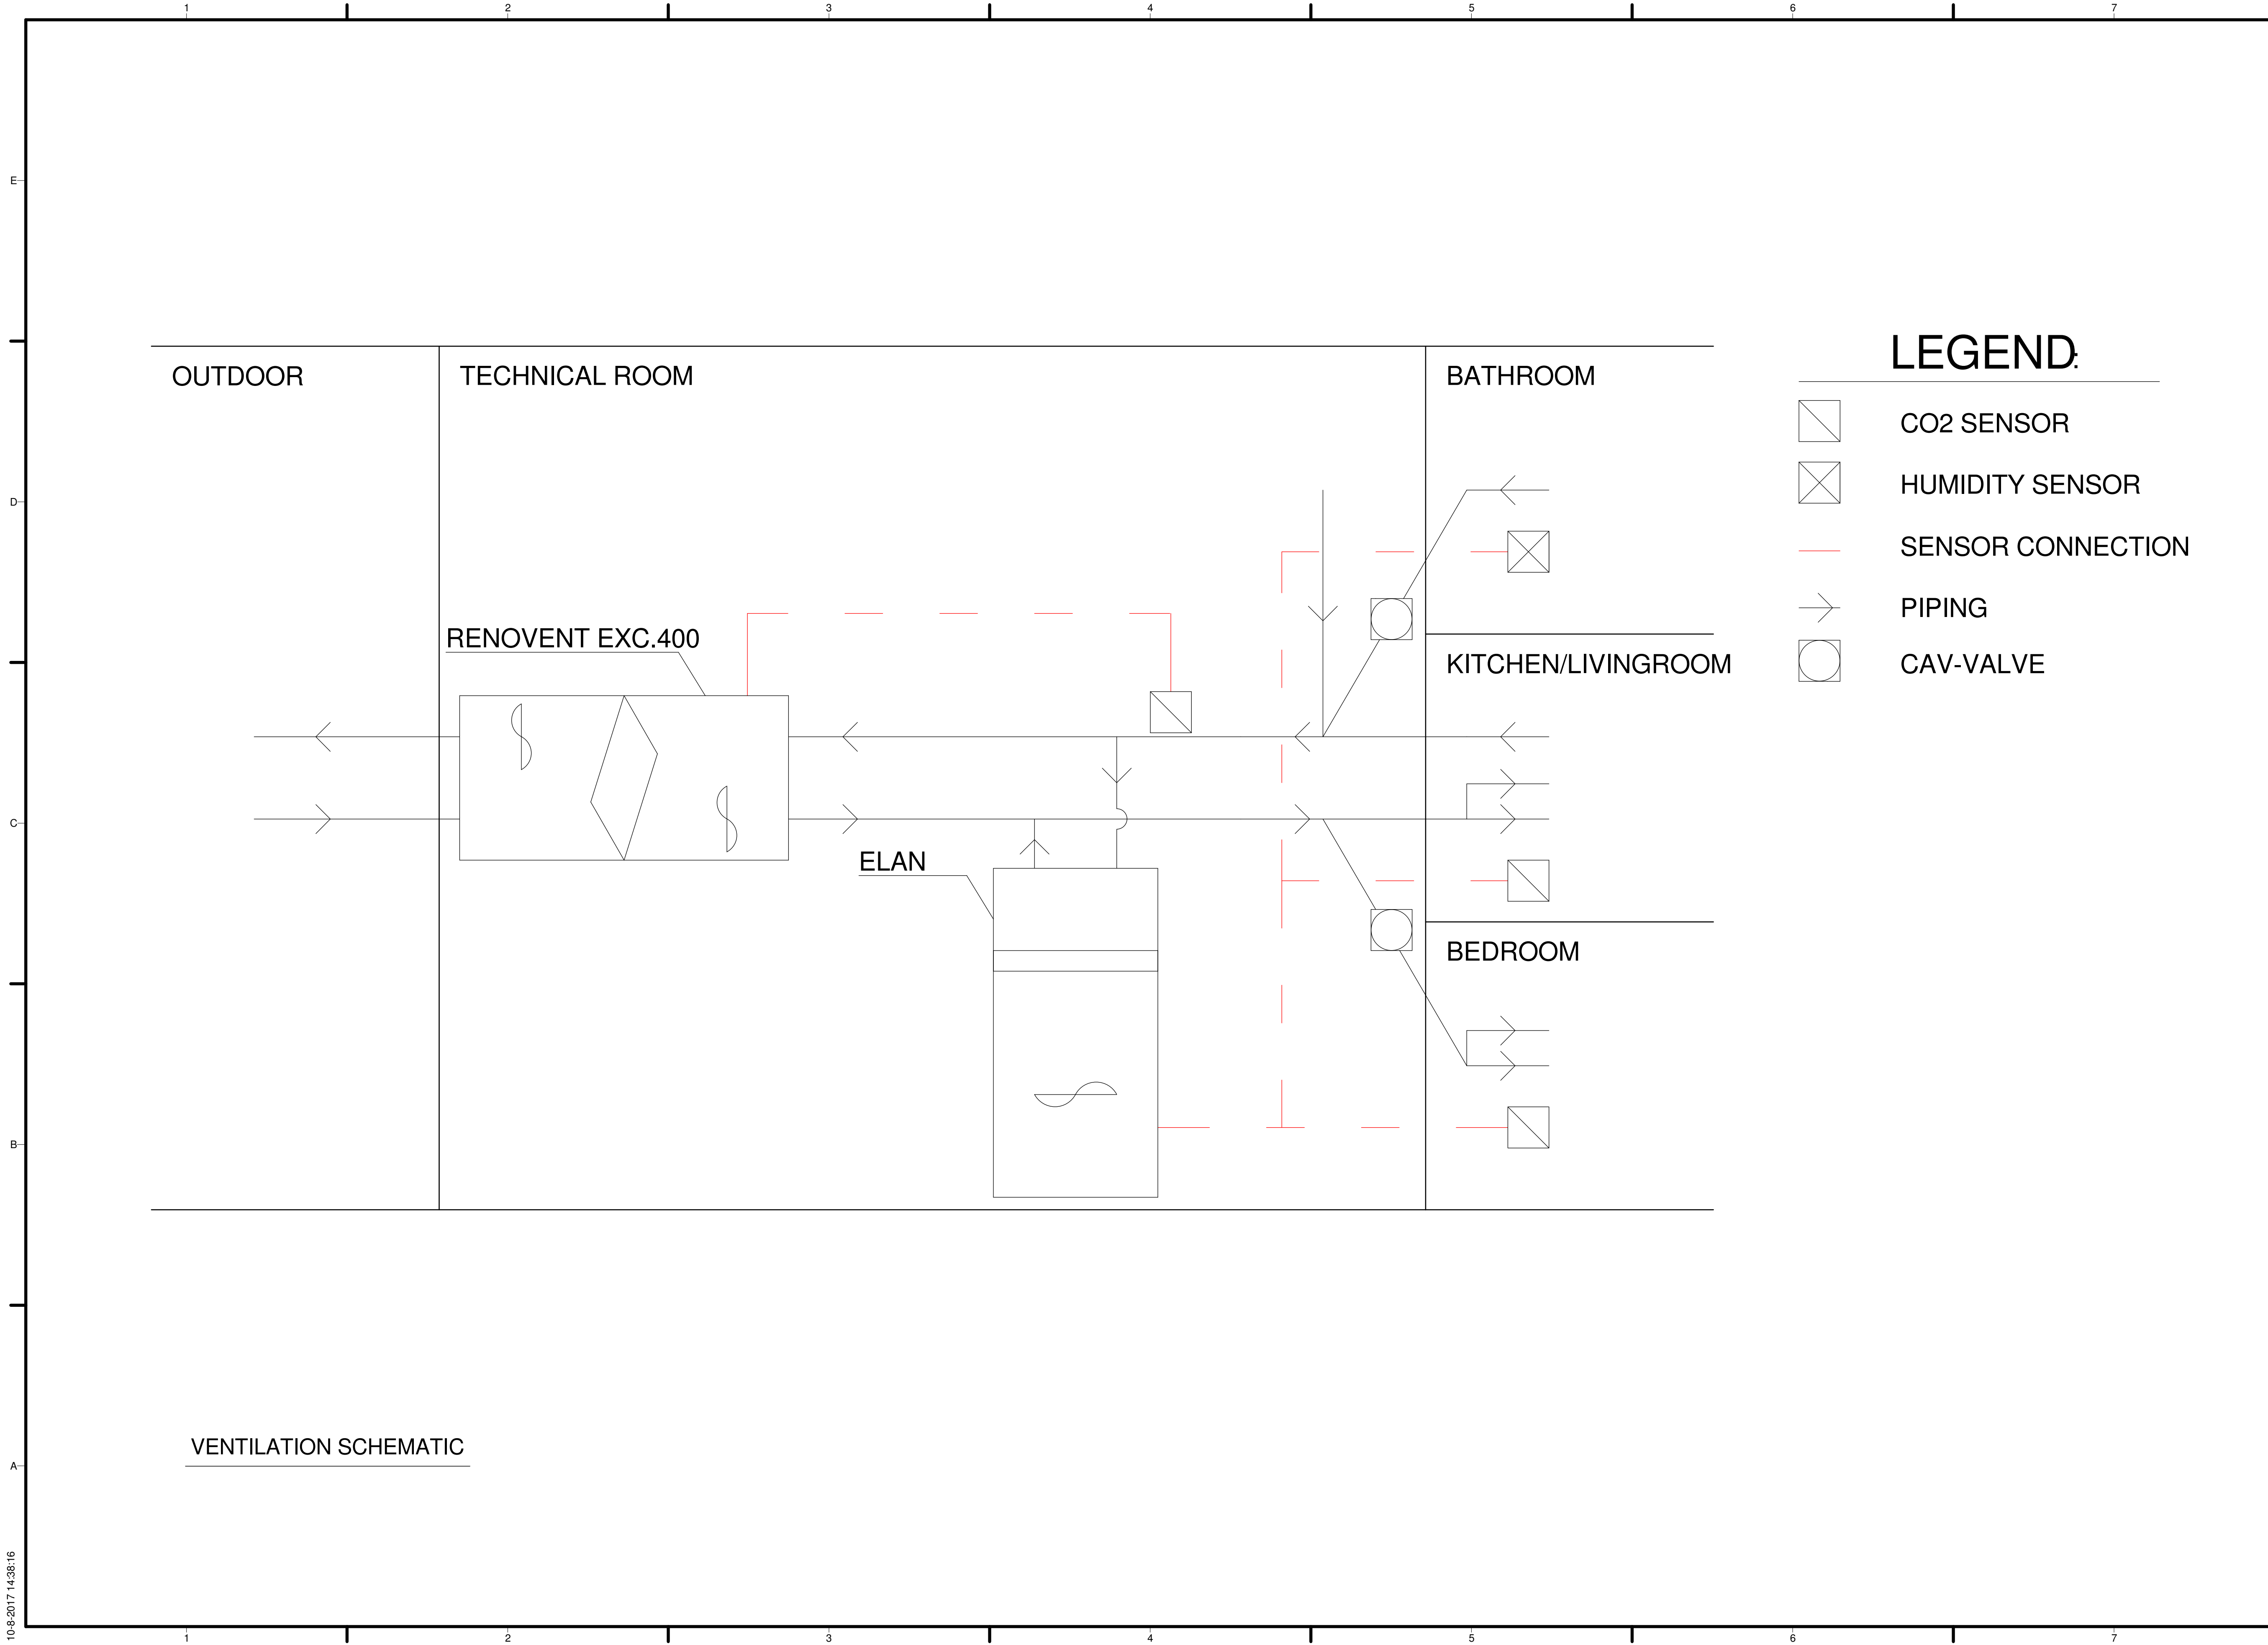

OUTDOOR

TECHNICAL ROOM

BATHROOM




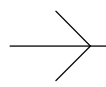
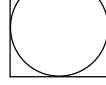
RENOVENT EXC.400

ELAN

KITCHEN/LIVINGROOM

BEDROOM

LEGEND:

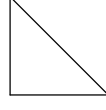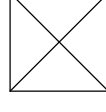
-  CO2 SENSOR
-  HUMIDITY SENSOR
-  SENSOR CONNECTION
-  PIPING
-  CAV-VALVE

VENTILATION SCHEMATIC



TEAM NAME: Selficient
 ADDRESS: Padualaan 99
 3584CH Utrecht
 The Netherlands
 CONTACT: info@selficient.org
 www.selficient.org

CONSULTANTS
 ARCHITECTURE
 ENGINEERS
 LANDSCAPING
 SAFETY FIRST CODE CONSULTANTS

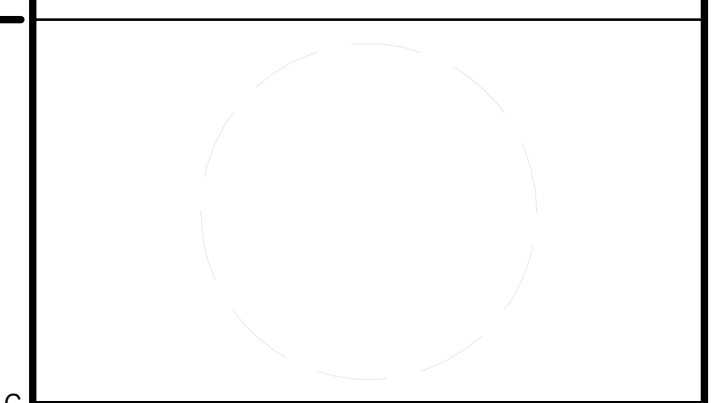

CLIENT
 U.S. DEPARTMENT OF ENERGY
 SOLAR DECATHLON 2017
 WWW.SOLARDECATHLON.GOV




Rev. MARK	DATE	DESCRIPTION
Rev. 00	02-24-2017	ADD. SCHEMATICS
Rev. 01	08-09-2017	ADD. CAV VALVES

LOT NUMBER: 106
 DRAWN BY: Mads de Kock
 CHECKED BY: Remco Polle
 COPYRIGHT: NONE; PROJECT IS PUBLIC DOMAIN

SHEET TITLE
VENTILATION SCHEMATICS

M-100

10-8-2017 14:38:16

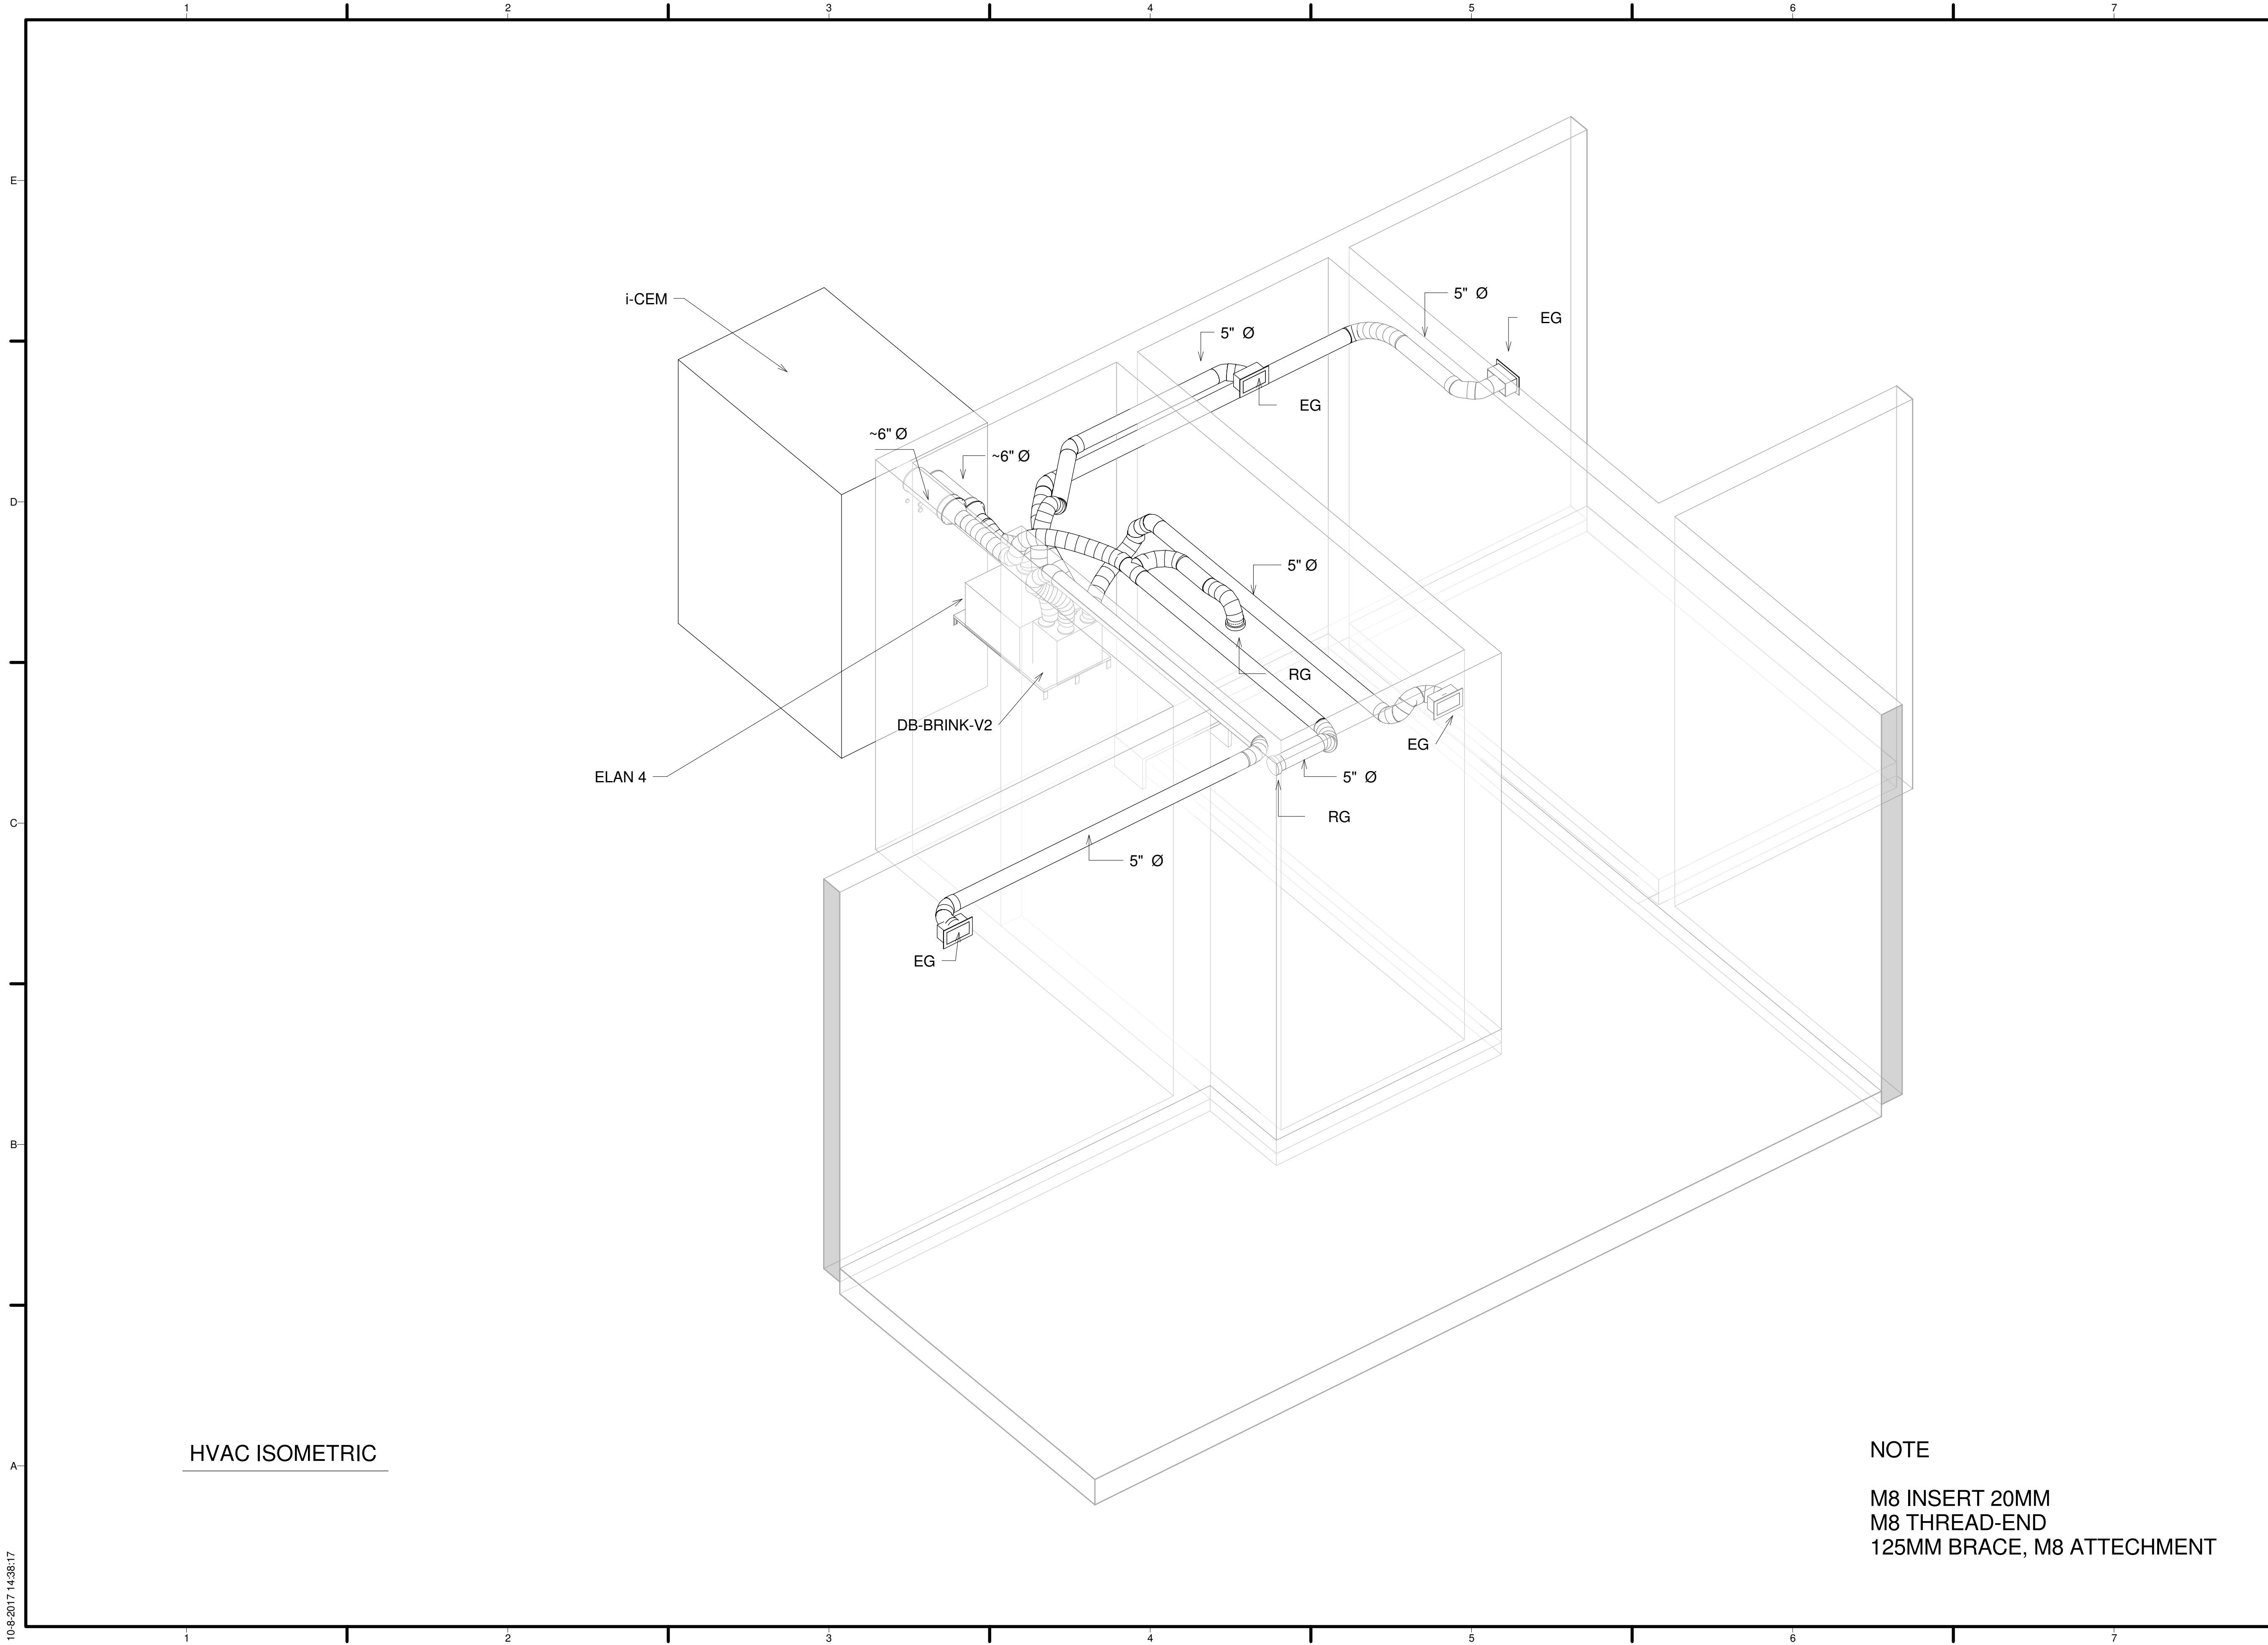


HVAC ISOMETRIC

NOTE
M8 INSERT 20MM
M8 THREAD-END
125MM BRACE, M8 ATTECHMENT



TEAM NAME: Selficient
ADDRESS: Padualaan 99
3584CH Utrecht
The Netherlands
CONTACT: info@selficient.org
www.selficient.org

CONSULTANTS
ARCHITECTURE
ENGINEERS
LANDSCAPING
SAFETY FIRST CODE CONSULTANTS

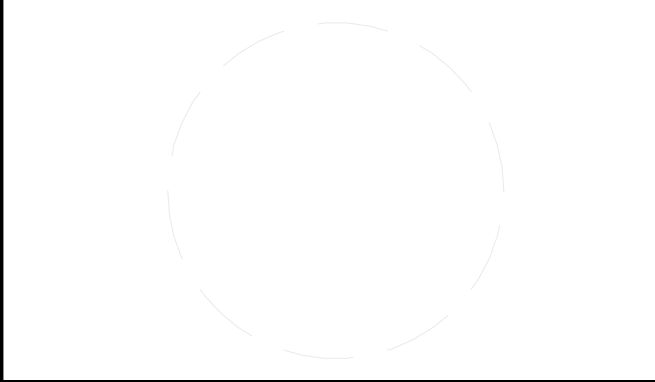

CLIENT
U.S. DEPARTMENT OF ENERGY
SOLAR DECATHLON 2017
WWW.SOLARDECATHLON.GOV




MARK	DATE	DESCRIPTION
Rev. 00	11-17-2016	90% REVISION
Rev. 01	02-24-2017	C TO D - FH DRAWING
Rev. 02	08-08-2017	FINAL DESIGN

LOT NUMBER: 106
DRAWN BY: Mads de Kock
CHECKED BY: Remco Polle
COPYRIGHT: NONE; PROJECT IS PUBLIC DOMAIN

SHEET TITLE
HVAC ISOMETRIC


M-101

10-8-2017 14:38:17

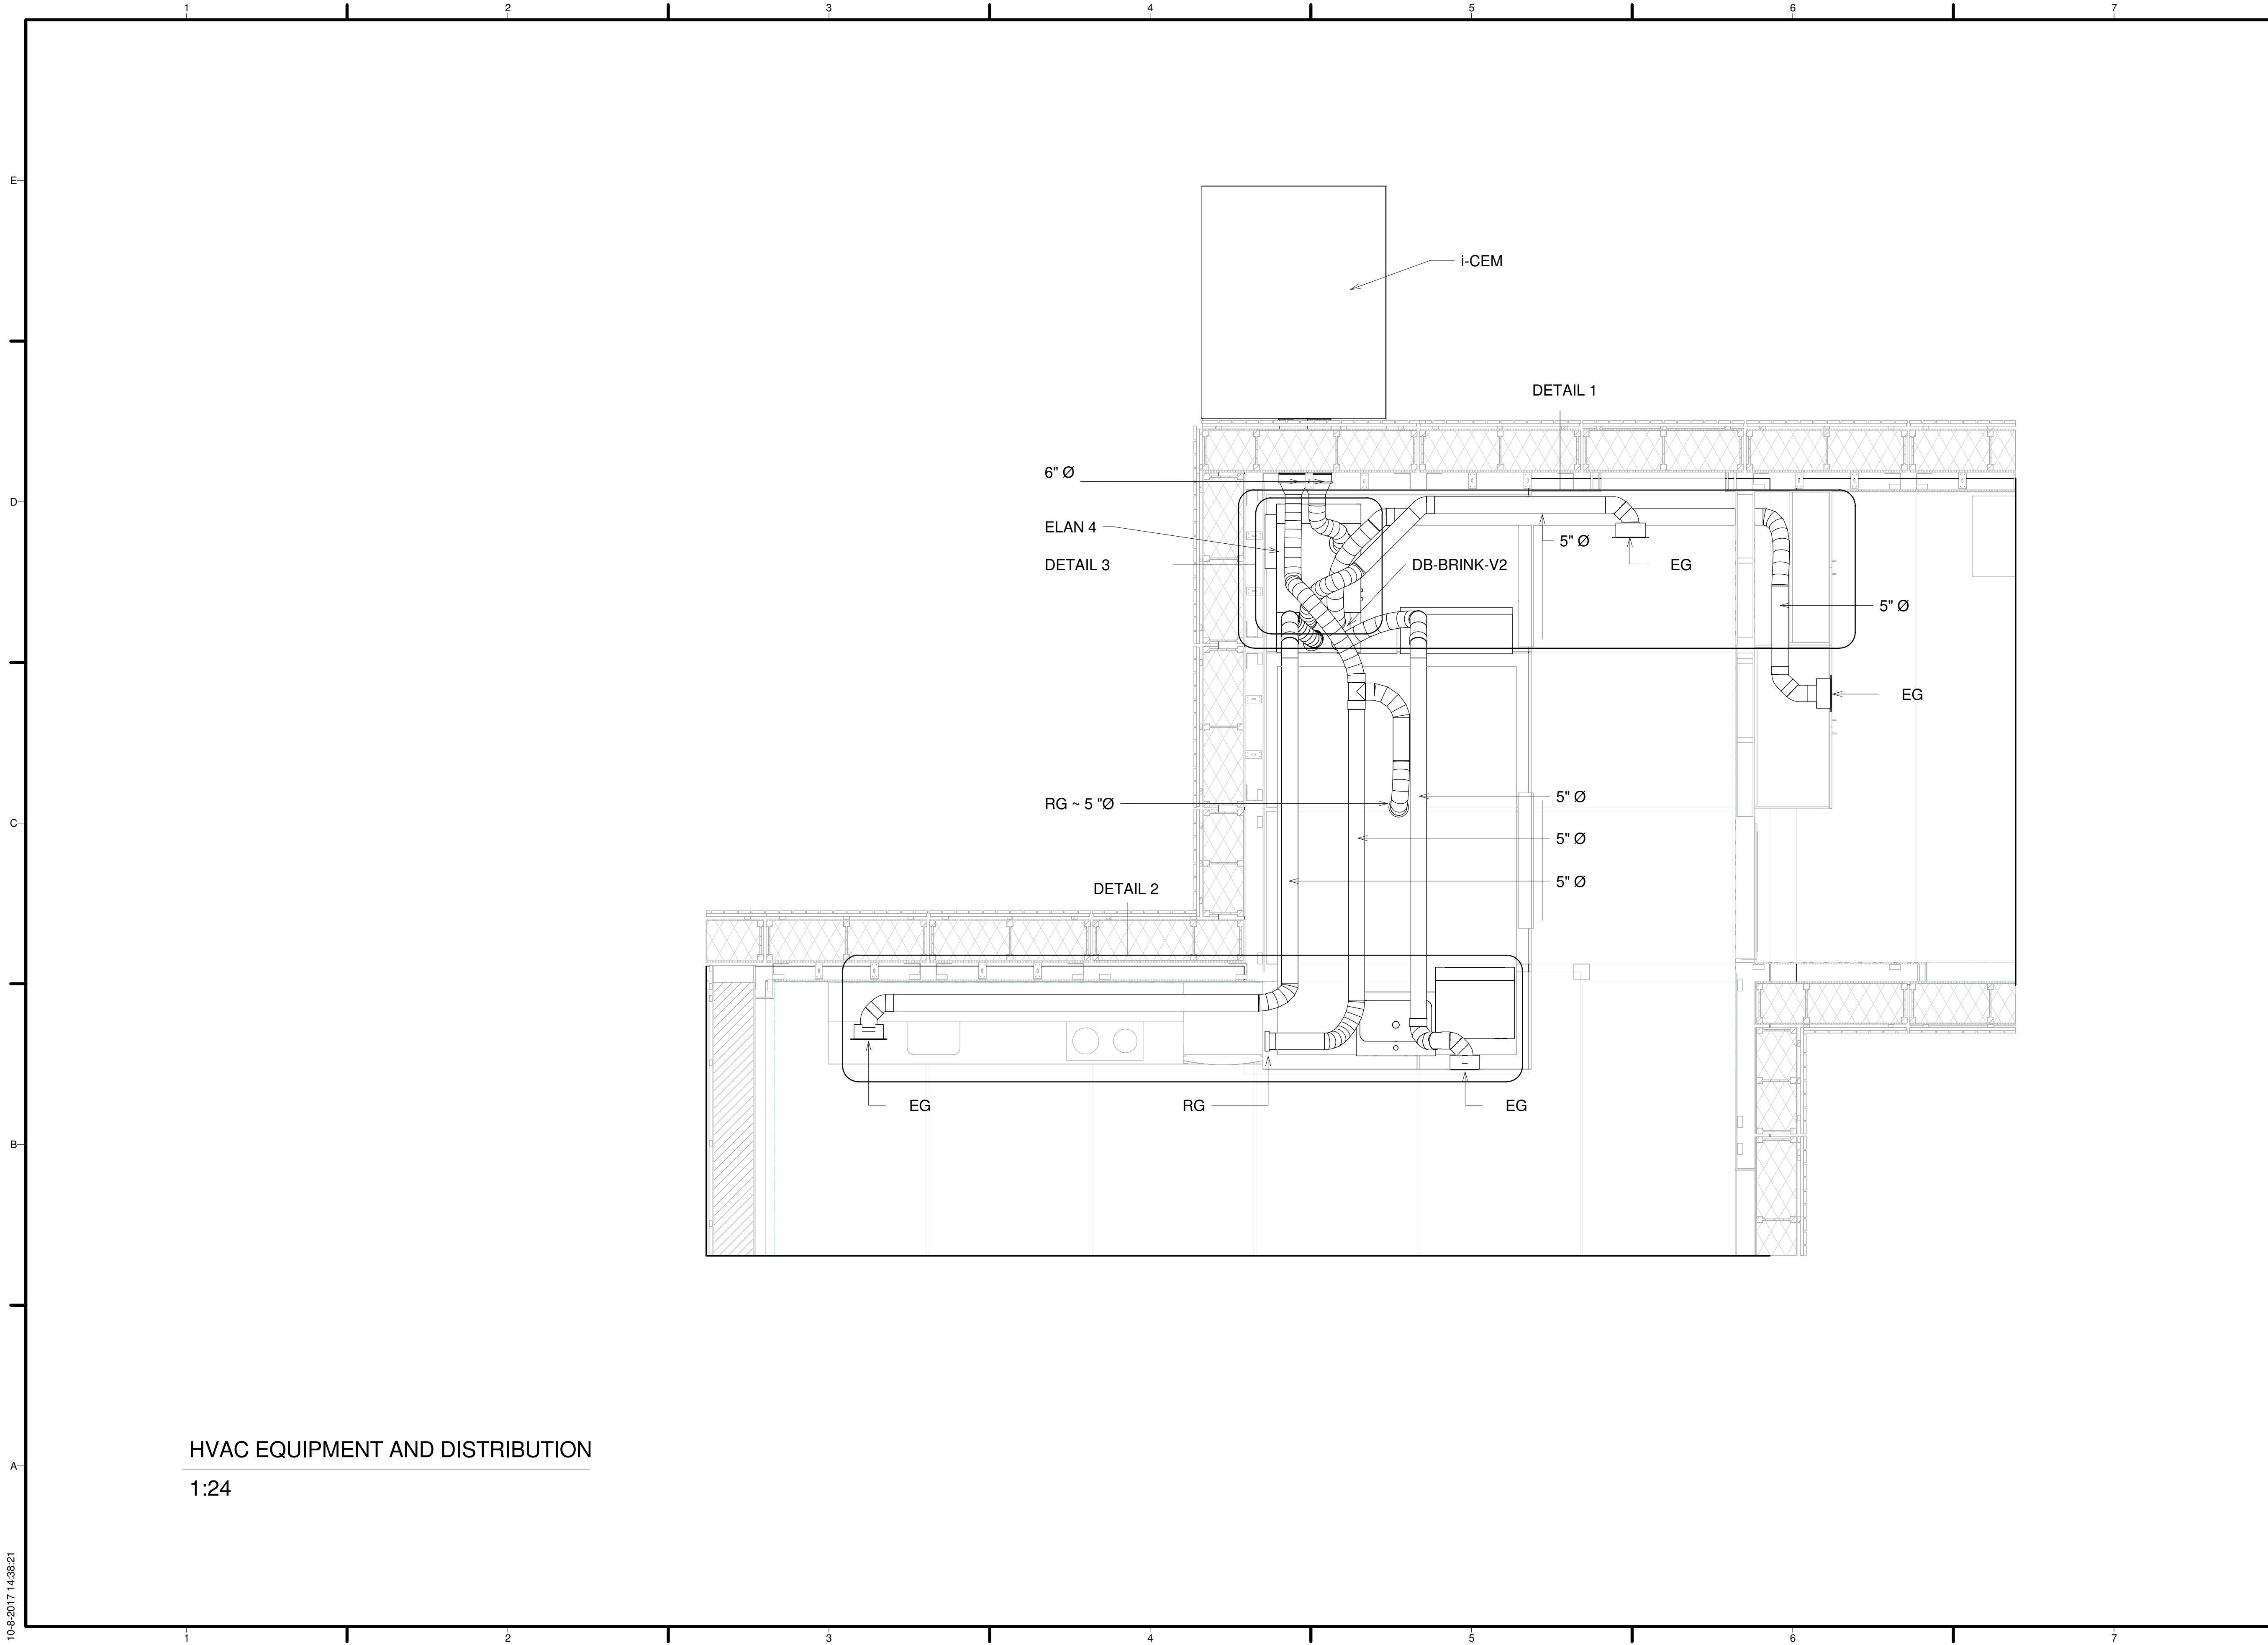

TEAM NAME: Selficient
 ADDRESS: Padualaan 99
 3584CH Utrecht
 The Netherlands
 CONTACT: info@selficient.org
 www.selficient.org

CONSULTANTS
 ARCHITECTURE
 ENGINEERS
 LANDSCAPING
 SAFETY FIRST CODE CONSULTANTS

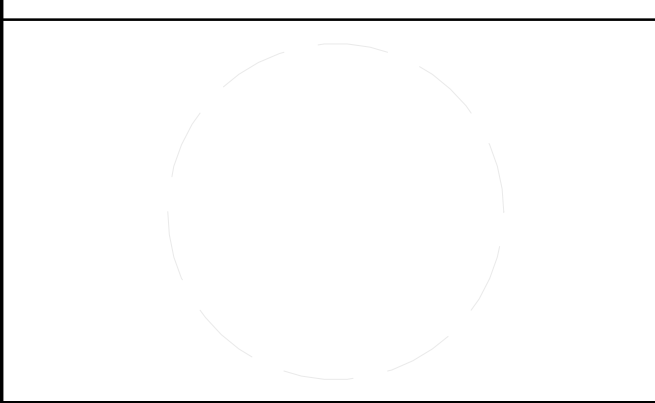

CLIENT
 U.S. DEPARTMENT OF ENERGY
 SOLAR DECATHLON 2017
 WWW.SOLARDECATHLON.GOV



MARK	DATE	DESCRIPTION
Rev. 00	11-17-2016	90% REVISION
Rev. 01	02-24-2017	C TO D + FH DRAWING
Rev. 02	08-08-2017	FINAL DESIGN


LOT NUMBER: 106
 DRAWN BY: Mads de Kock
 CHECKED BY: Remco Polle
 COPYRIGHT: NONE; PROJECT IS PUBLIC DOMAIN

SHEET TITLE
 HVAC EQUIPMENT AND DISTRIBUTION

M-200

HVAC EQUIPMENT AND DISTRIBUTION
 1:24

10-8-2017 14:38:21

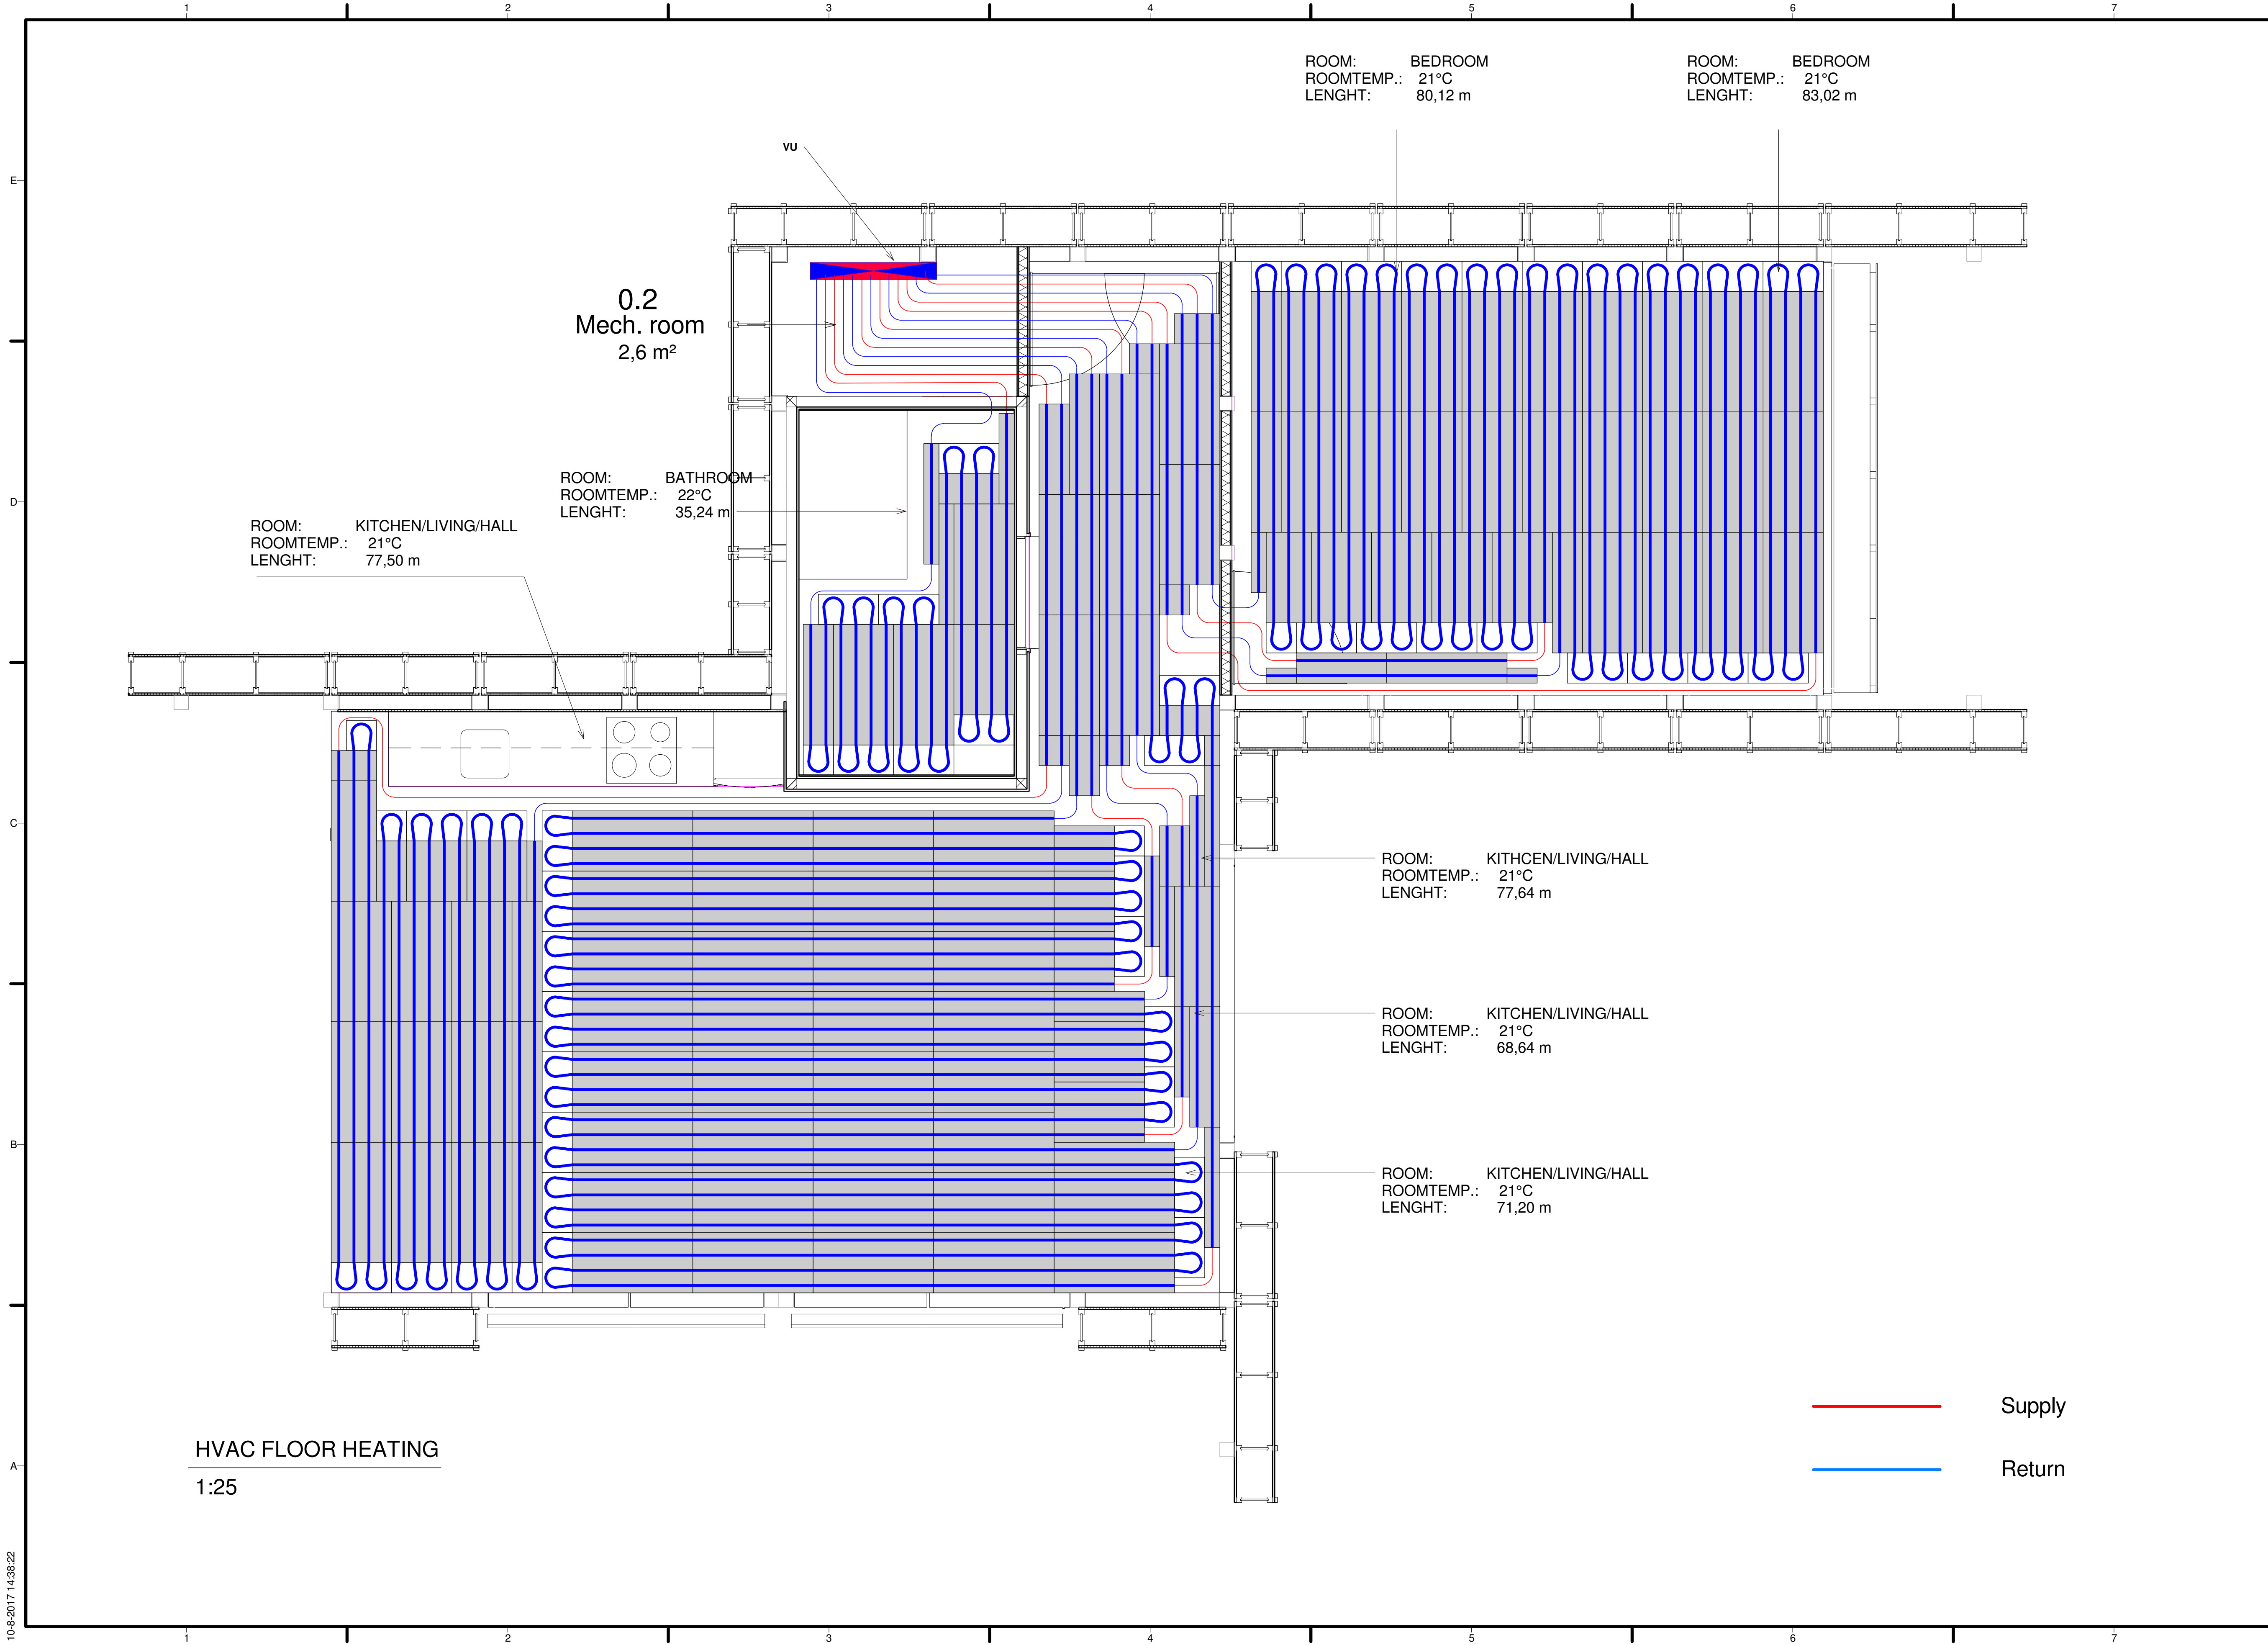

ROOM: BEDROOM
 ROOMTEMP.: 21°C
 LENGHT: 80,12 m

ROOM: BEDROOM
 ROOMTEMP.: 21°C
 LENGHT: 83,02 m

0.2
 Mech. room
 2,6 m²

ROOM: BATHROOM
 ROOMTEMP.: 22°C
 LENGHT: 35,24 m

ROOM: KITCHEN/LIVING/HALL
 ROOMTEMP.: 21°C
 LENGHT: 77,50 m

ROOM: KITCHEN/LIVING/HALL
 ROOMTEMP.: 21°C
 LENGHT: 77,64 m

ROOM: KITCHEN/LIVING/HALL
 ROOMTEMP.: 21°C
 LENGHT: 68,64 m

ROOM: KITCHEN/LIVING/HALL
 ROOMTEMP.: 21°C
 LENGHT: 71,20 m

HVAC FLOOR HEATING
 1:25

— Supply
 — Return



TEAM NAME: Selficient
 ADDRESS: Padualaan 99
 3584CH Utrecht
 The Netherlands
 CONTACT: info@selficient.org
 www.selficient.org

CONSULTANTS
 ARCHITECTURE
 ENGINEERS
 LANDSCAPING
 SAFETY FIRST CODE CONSULTANTS

CLIENT
 U.S. DEPARTMENT OF ENERGY
 SOLAR DECATHLON 2017
 WWW.SOLARDECATHLON.GOV




MARK	DATE	DESCRIPTION
Rev. 00	11-17-2016	90% REVISION
Rev. 01	02-24-2017	C TO D + FH DRAWING
Rev. 02	08-08-2017	FINAL DESIGN

LOT NUMBER: 106
 DRAWN BY: Mads de Kock
 CHECKED BY: Remco Polle
 COPYRIGHT: NONE; PROJECT IS PUBLIC DOMAIN

SHEET TITLE
 HVAC FLOOR HEATING

M-201

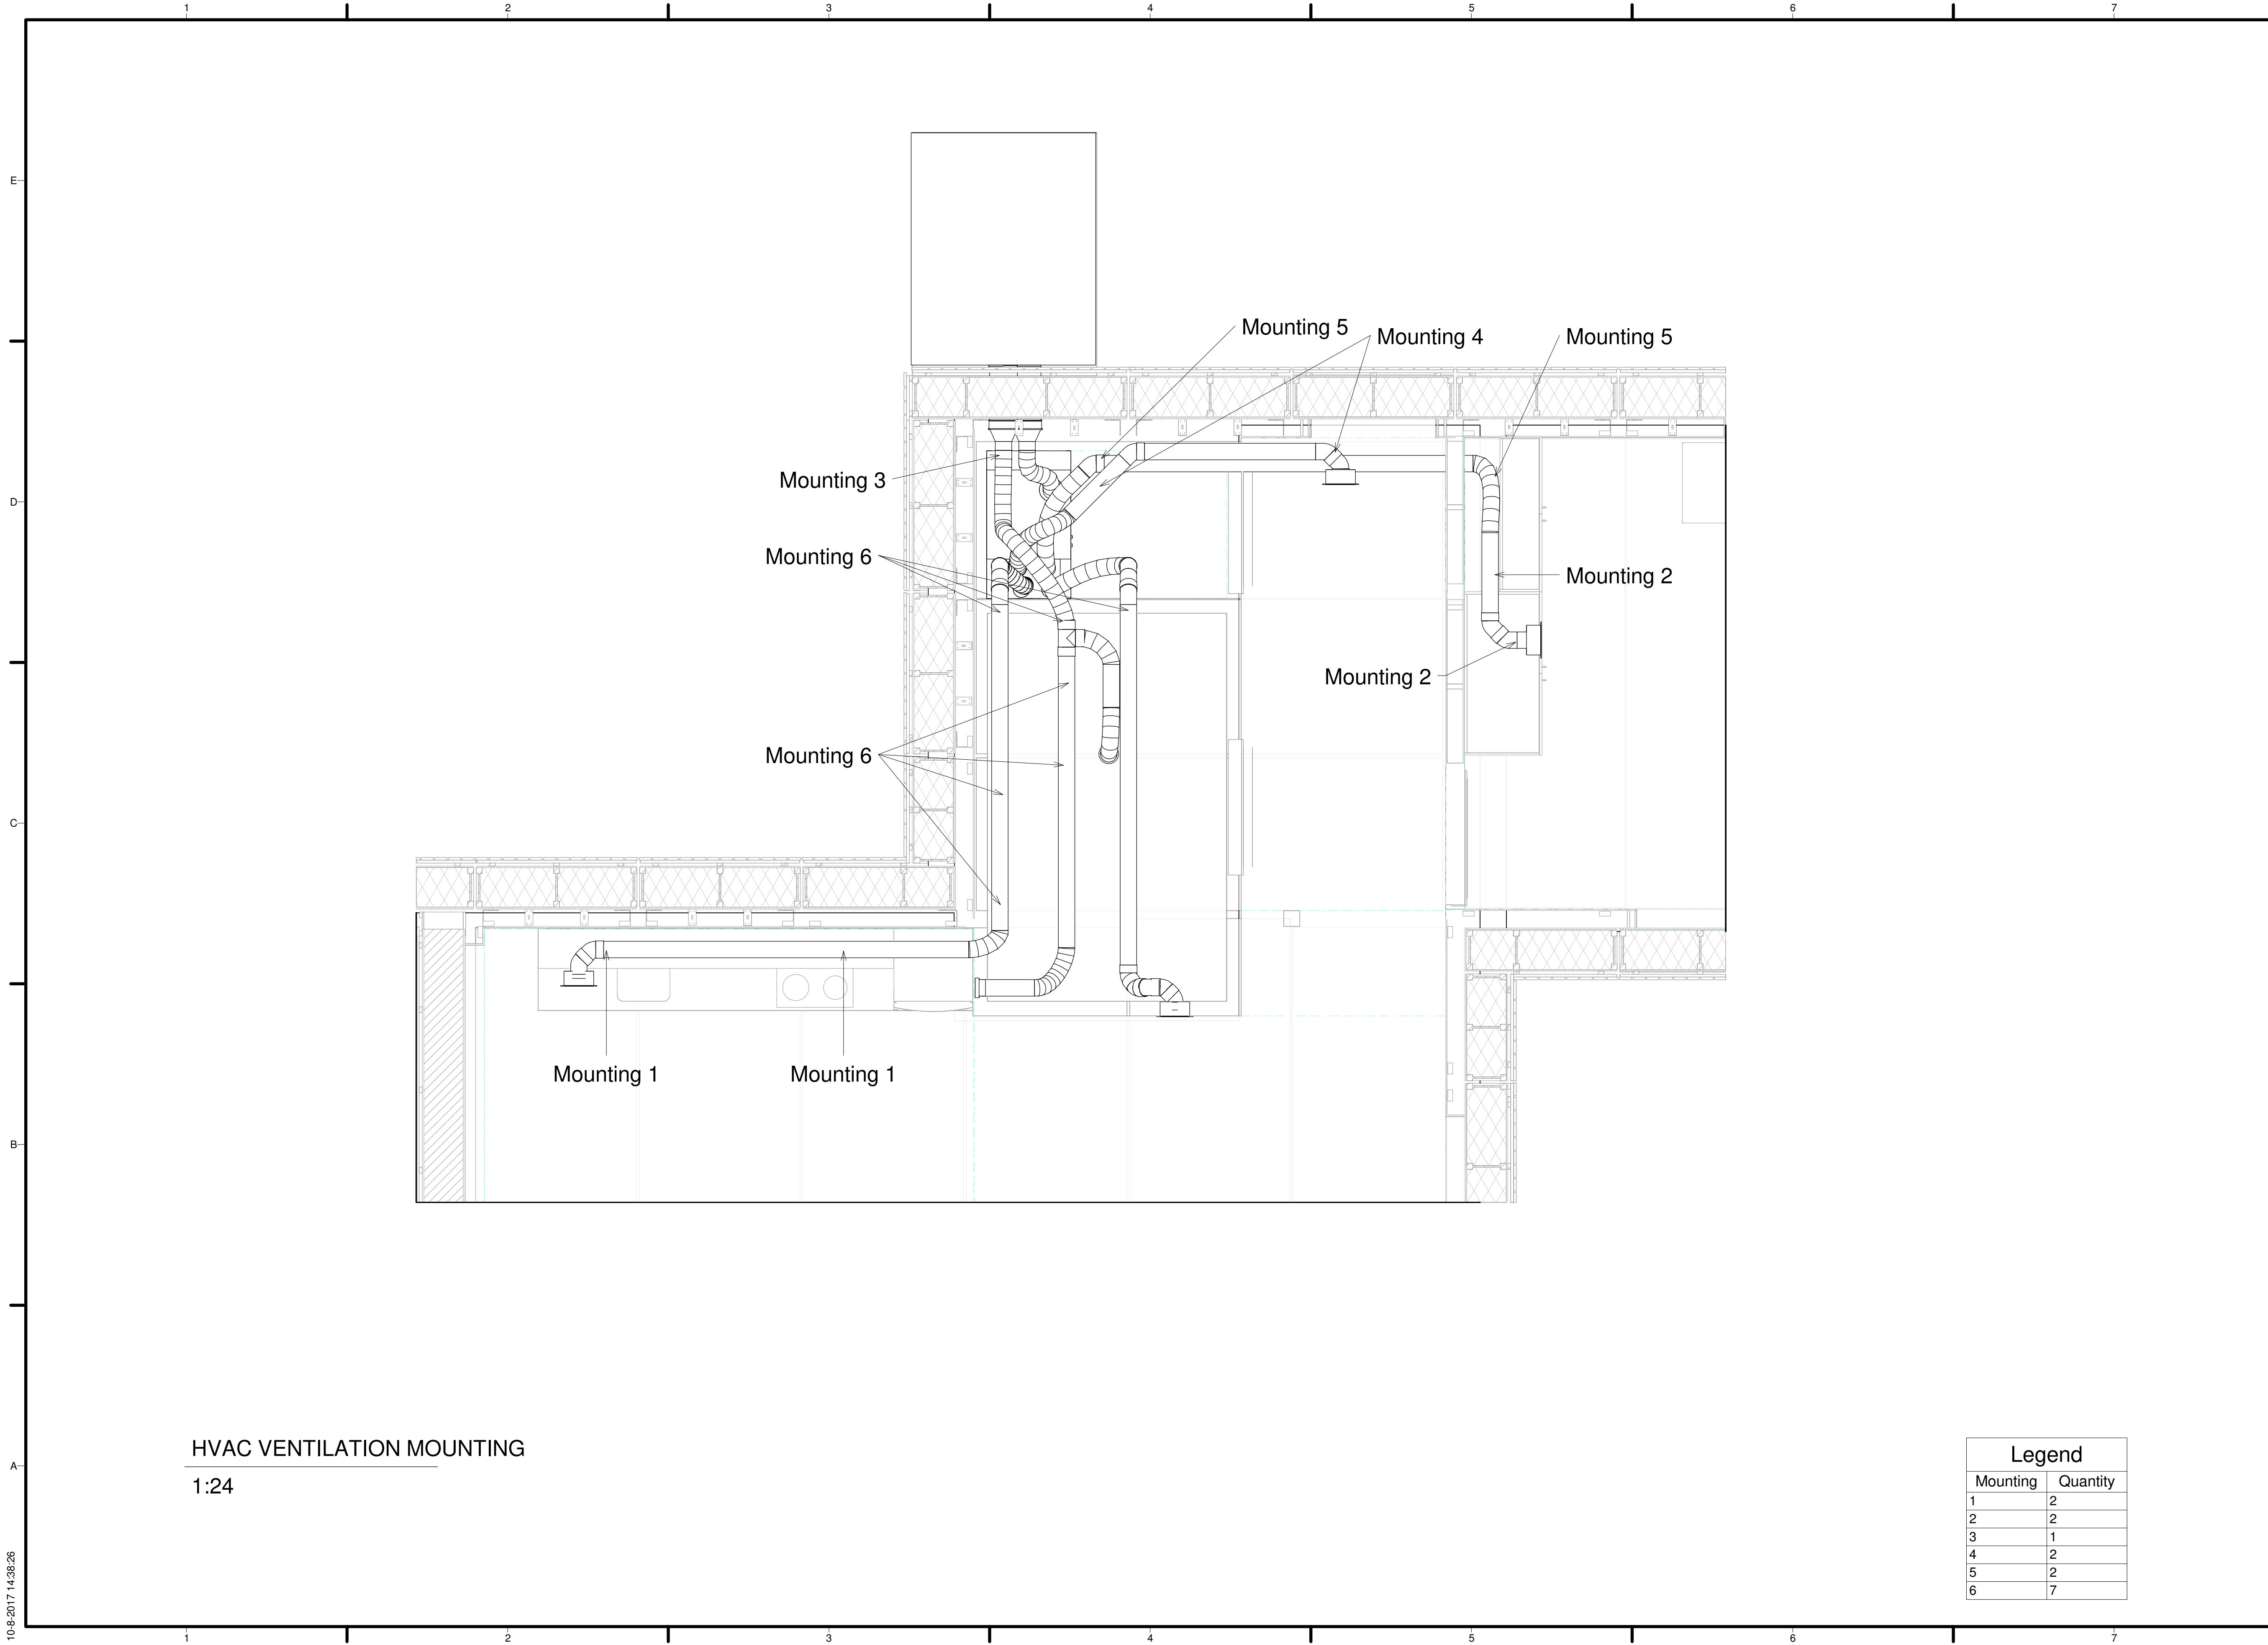


HVAC VENTILATION MOUNTING
1:24

Legend	
Mounting	Quantity
1	2
2	2
3	1
4	2
5	2
6	7



TEAM NAME: Selficient
 ADDRESS: Padualaan 99
 3584CH Utrecht
 The Netherlands
 CONTACT: info@selficient.org
 www.selficient.org

CONSULTANTS
 ARCHITECTURE
 ENGINEERS
 LANDSCAPING
 SAFETY FIRST CODE CONSULTANTS

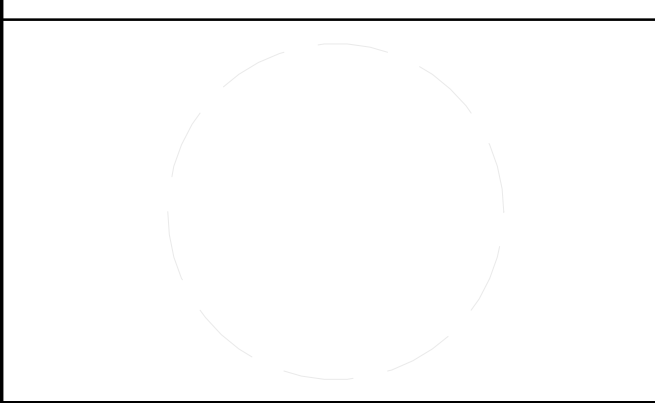

CLIENT
 U.S. DEPARTMENT OF ENERGY
 SOLAR DECATHLON 2017
 WWW.SOLARDECATHLON.GOV




MARK	DATE	DESCRIPTION
Rev. 00	11-17-2016	90% REVISION
Rev. 01	02-24-2017	C TO D - FH DRAWING
Rev. 02	08-08-2017	FINAL DESIGN

LOT NUMBER: 106
 DRAWN BY: Mads de Kock
 CHECKED BY: Remco Polle
 COPYRIGHT: NONE; PROJECT IS PUBLIC DOMAIN

SHEET TITLE
 HVAC-VENTILATION MOUNTING

M-202

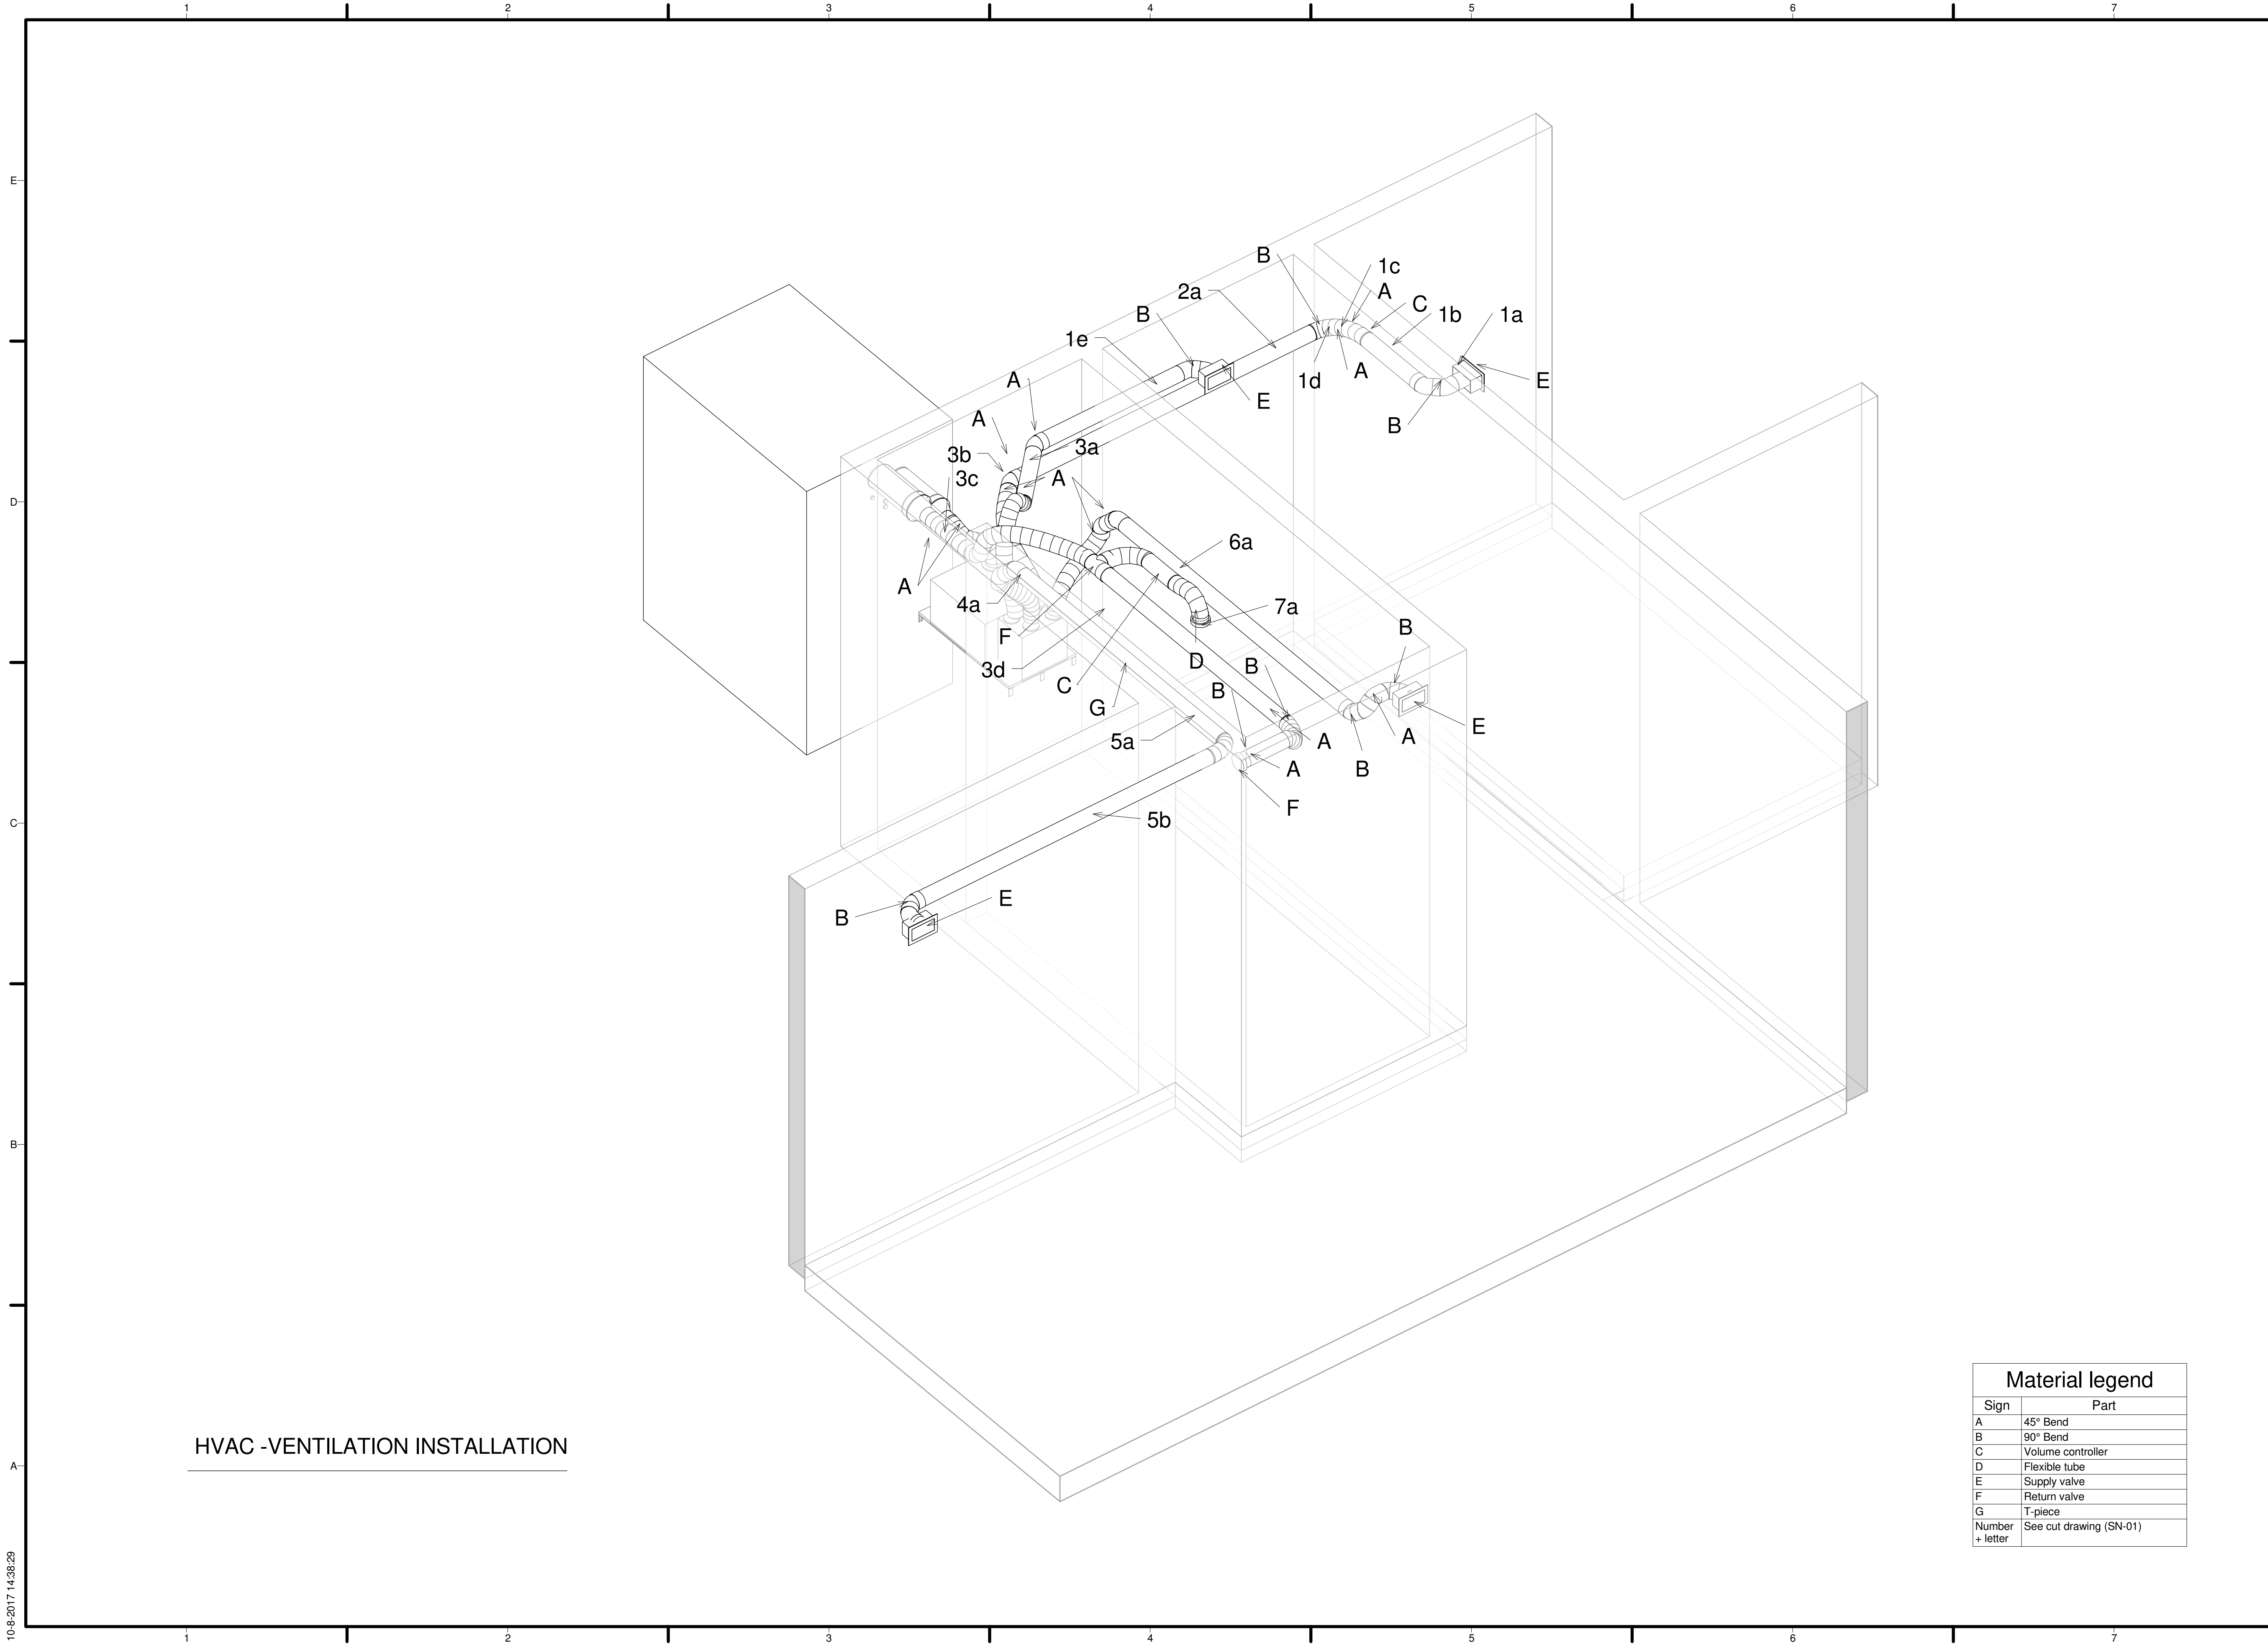


HVAC -VENTILATION INSTALLATION

Material legend	
Sign	Part
A	45° Bend
B	90° Bend
C	Volume controller
D	Flexible tube
E	Supply valve
F	Return valve
G	T-piece
Number + letter	See cut drawing (SN-01)



TEAM NAME: Selficient
 ADDRESS: Padualaan 99
 3584CH Utrecht
 The Netherlands
 CONTACT: info@selficient.org
 www.selficient.org

CONSULTANTS
 ARCHITECTURE
 ENGINEERS
 LANDSCAPING
 SAFETY FIRST CODE CONSULTANTS

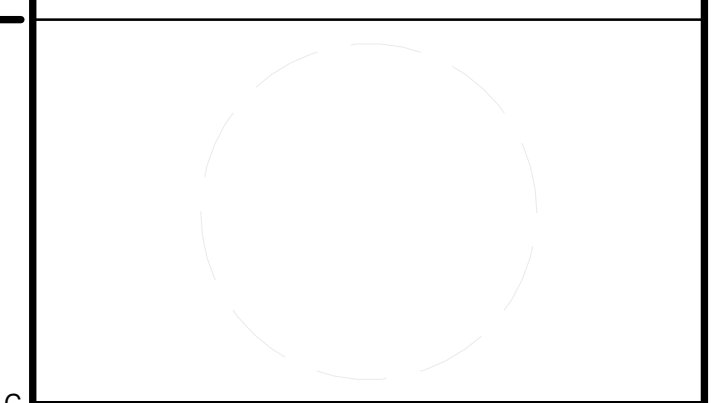

CLIENT
 U.S. DEPARTMENT OF ENERGY
 SOLAR DECATHLON 2017
 WWW.SOLARDECATHLON.GOV




Rev.	DATE	DESCRIPTION
Rev. 00	11-17-2016	90% REVISION
Rev. 01	02-24-2017	C TO D - FH DRAWING
Rev. 02	08-08-2017	FINAL DESIGN


LOT NUMBER: 106
 DRAWN BY: Mads de Kock
 CHECKED BY: Remco Polle
 COPYRIGHT: NONE; PROJECT IS PUBLIC DOMAIN

SHEET TITLE
 HVAC-VENTILATION
 INSTALLATION


M-203

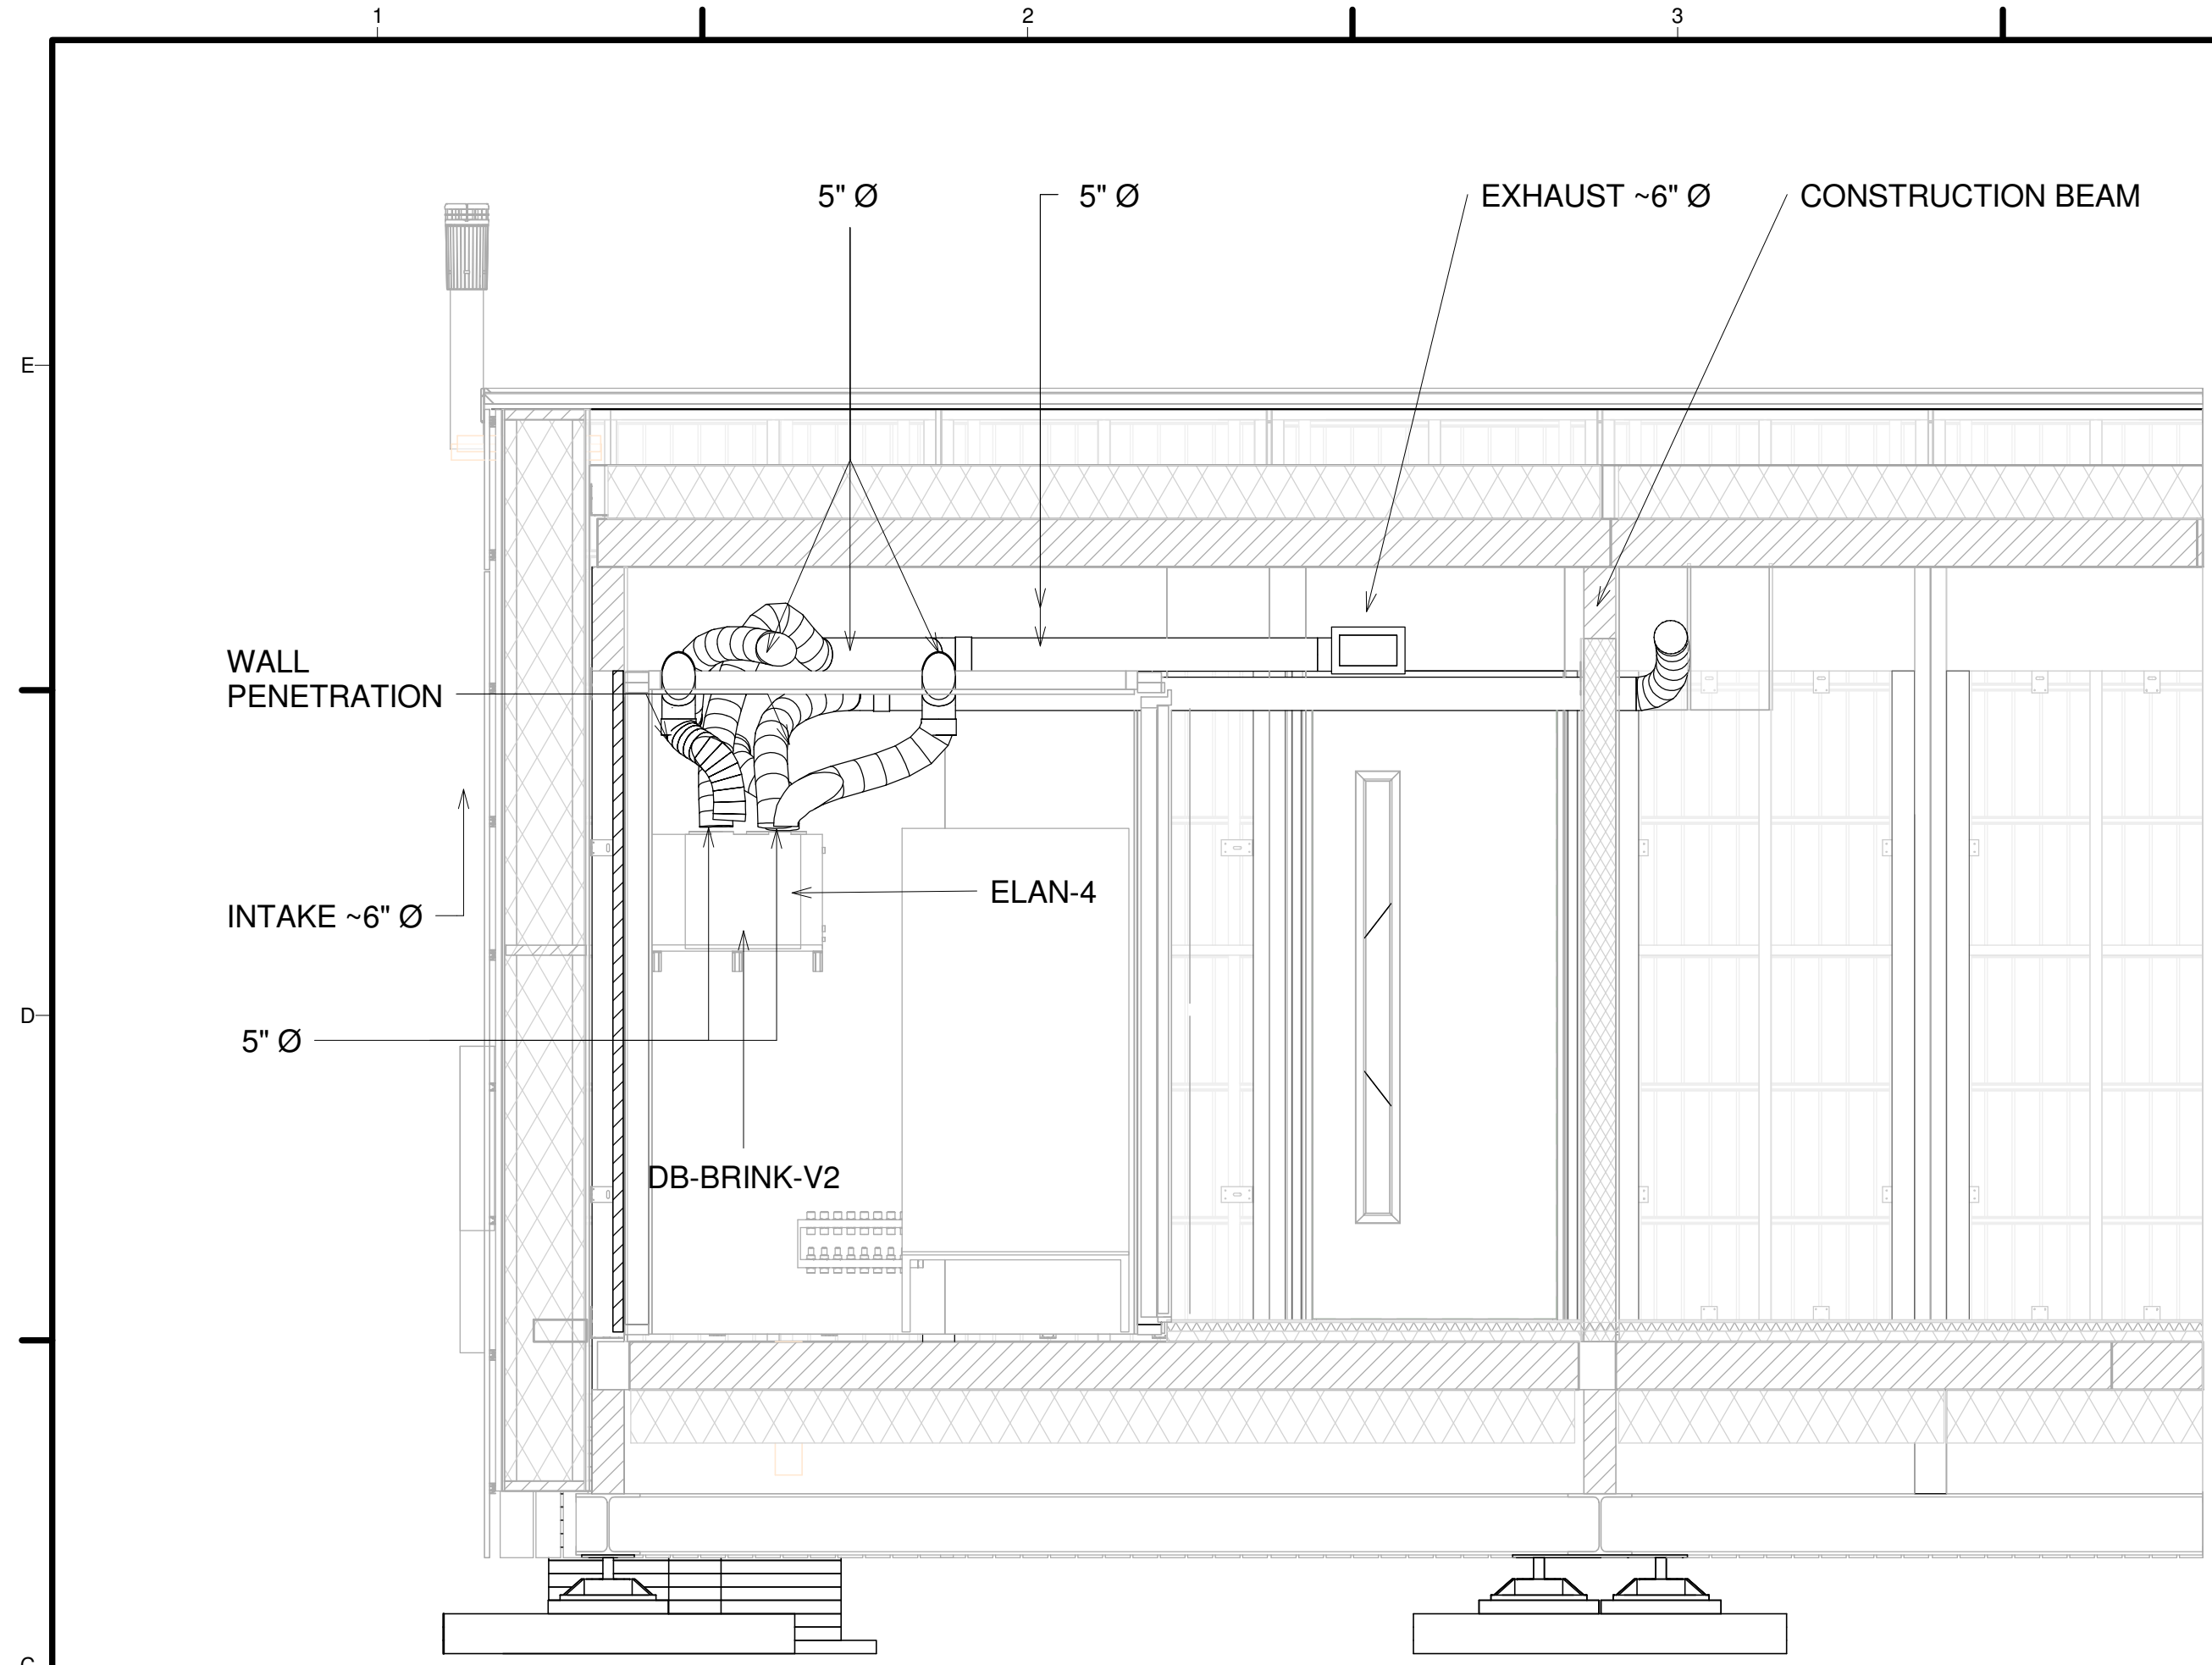

HVAC DETAIL 1

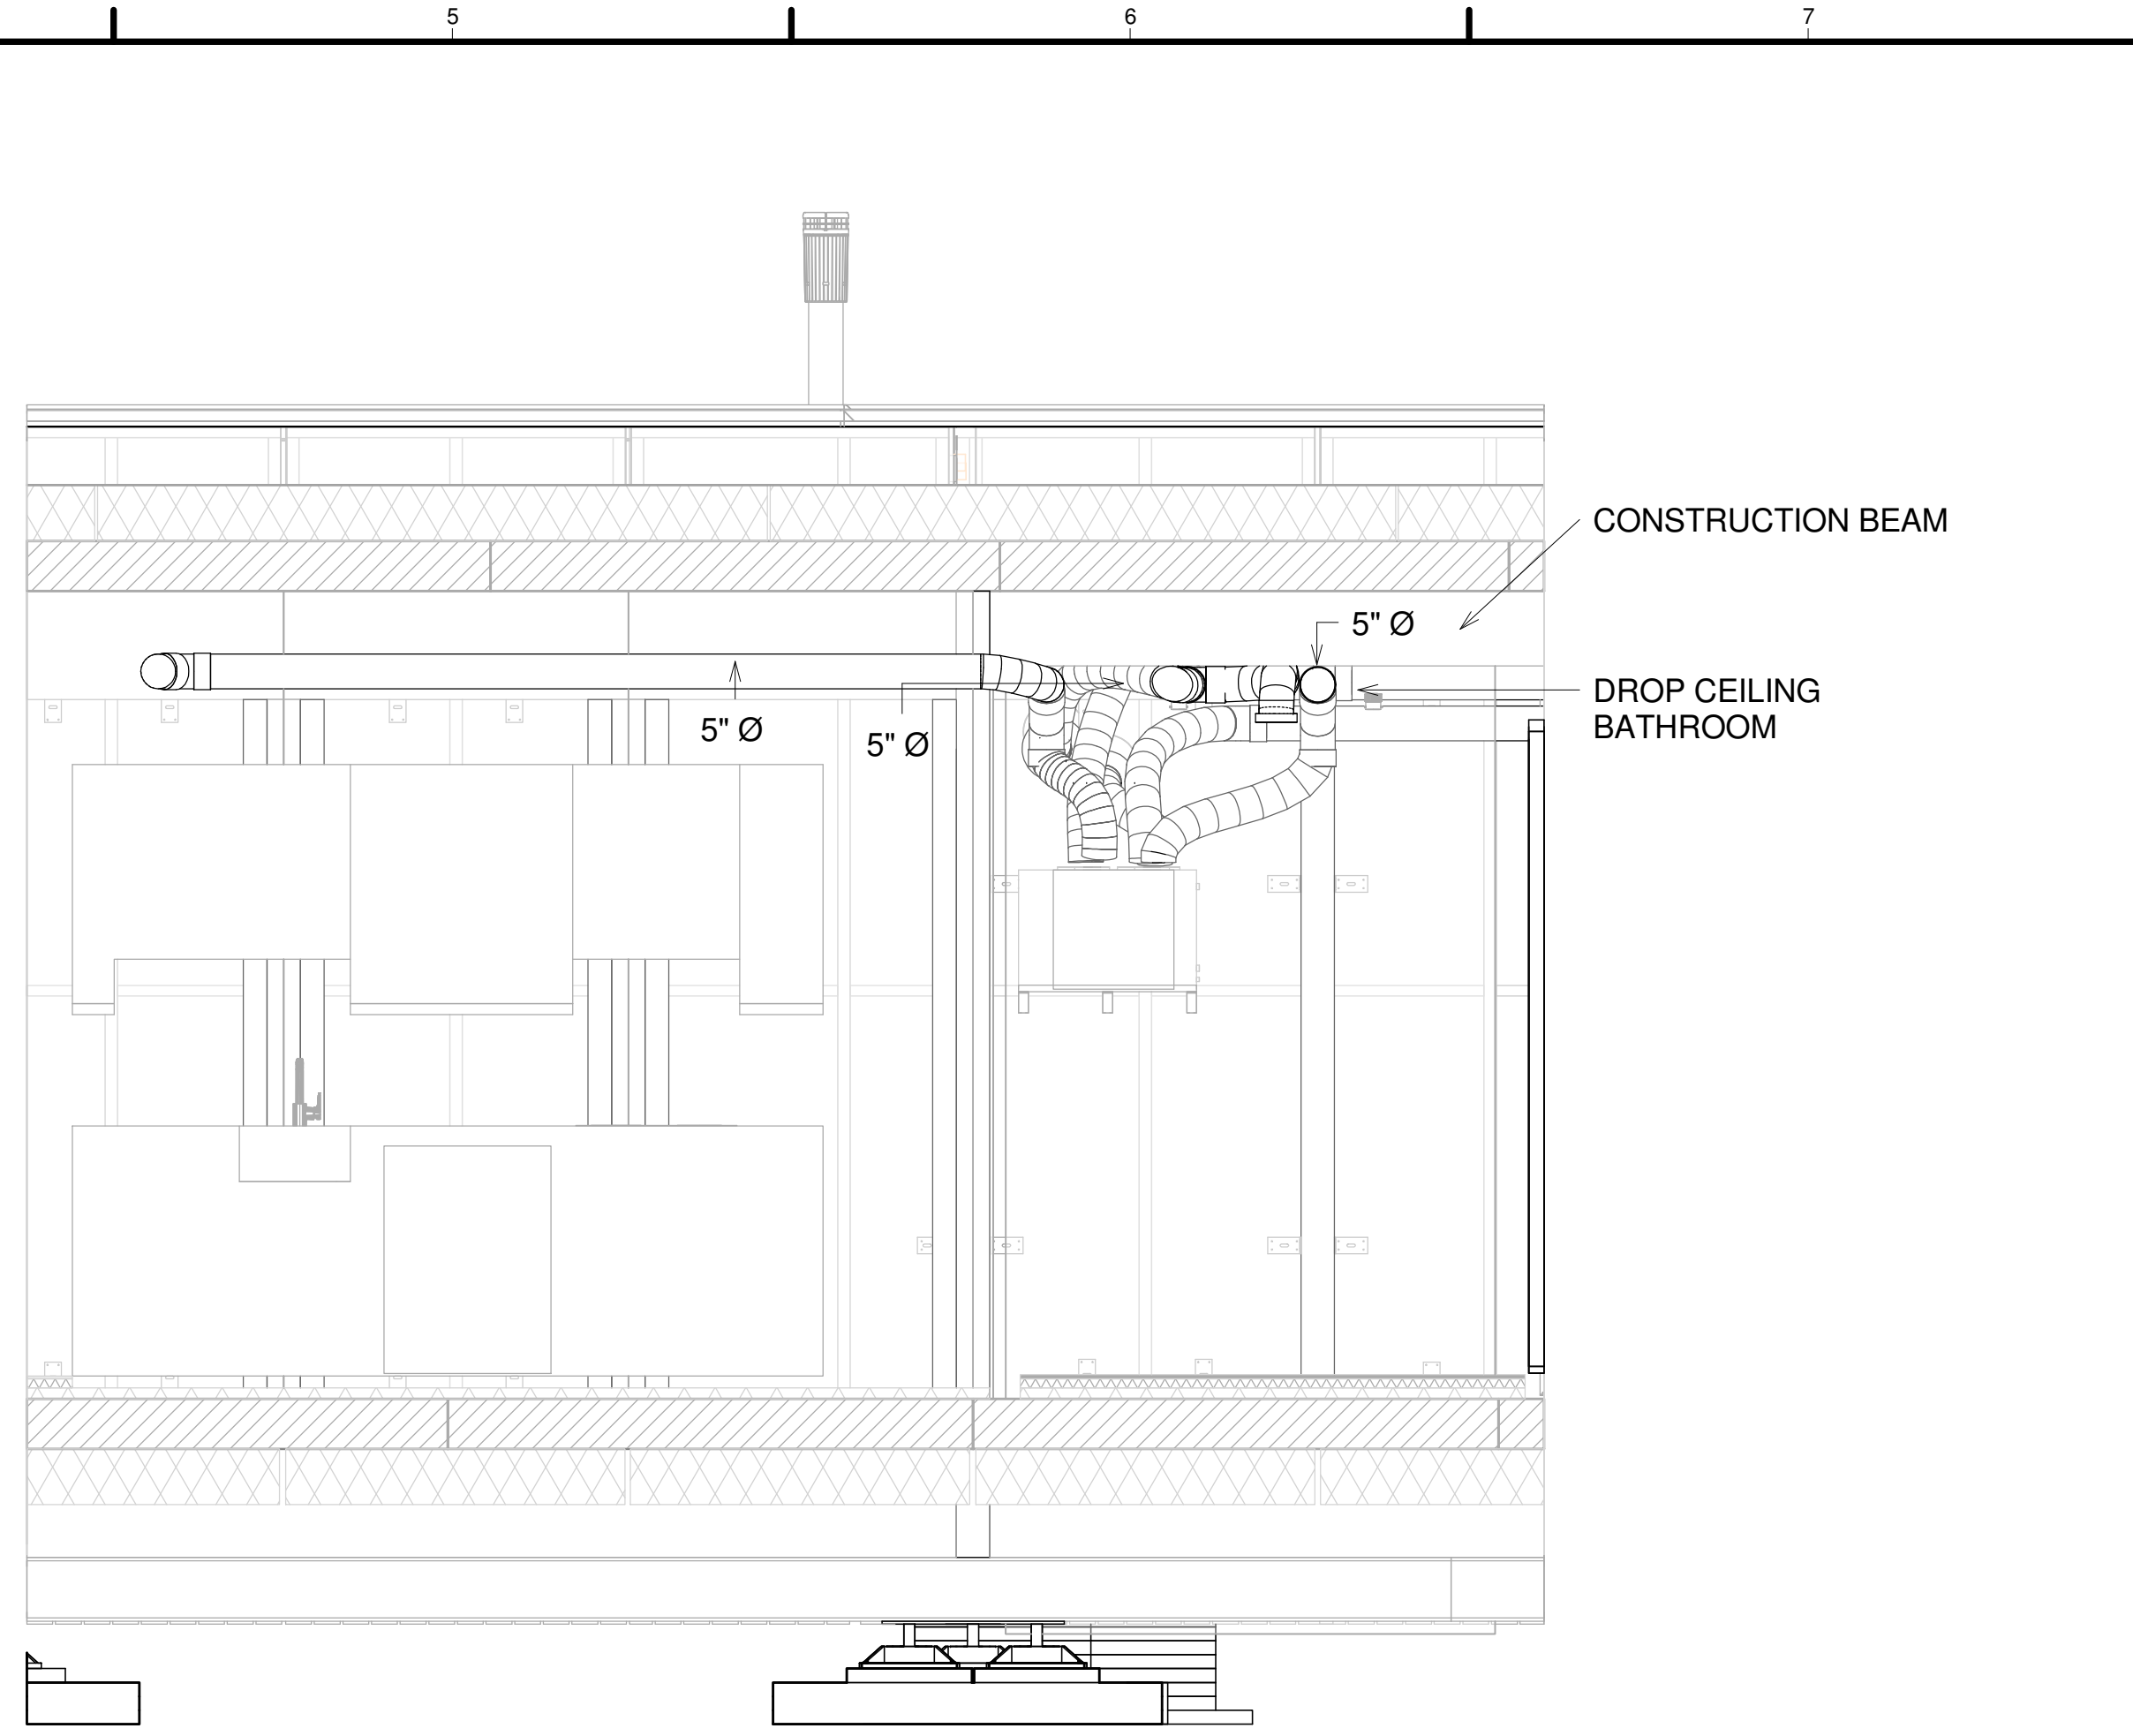

HVAC DETAIL 2

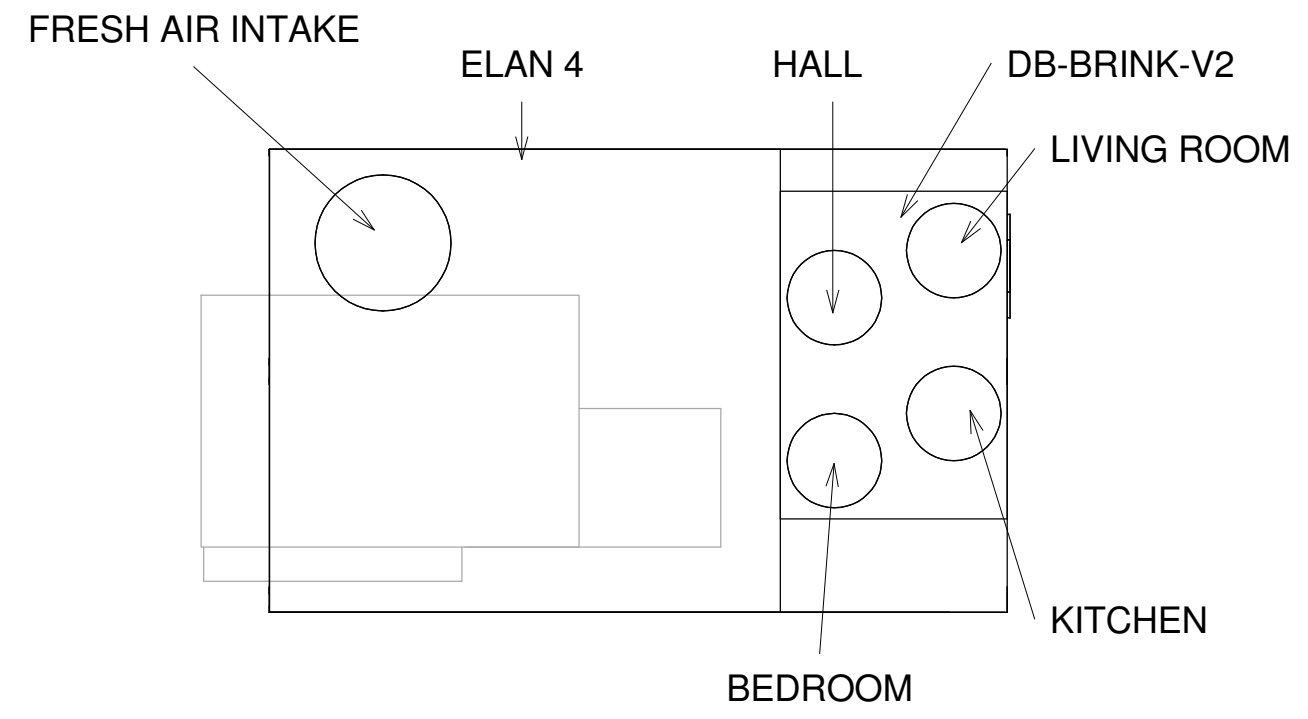

ELAN 4 AND BRINK-V2
TOP VIEW - DETAIL 3
1:12

HVAC DETAILS
1:24



TEAM NAME: Selficient
 ADDRESS: Padualaan 99
 3584CH Utrecht
 The Netherlands
 CONTACT: info@selficient.org
 www.selficient.org

CONSULTANTS
 ARCHITECTURE
 ENGINEERS
 LANDSCAPING
 SAFETY FIRST CODE CONSULTANTS

CLIENT
 U.S. DEPARTMENT OF ENERGY
 SOLAR DECATHLON 2017
 WWW.SOLARDECATHLON.GOV



MARK	DATE	DESCRIPTION
Rev. 00	11-17-2016	90% REVISION
Rev. 01	02-24-2017	C TO D + FH DRAWING
Rev. 02	08-08-2017	FINAL DESIGN

LOT NUMBER: 106
 DRAWN BY: Mads de Kock
 CHECKED BY: Remco Polle
 COPYRIGHT: NONE; PROJECT IS PUBLIC DOMAIN

SHEET TITLE
 HVAC DETAILS

M-400


Mechanical Schedule

Type Mark	Room: name	Description	Manufacturer	Model	Count	Dimensions (DxWxH) (mm)	URL
i-CEM	Tech Room	i-CEM	Centercon	Energy Module	1	1400x2100x2600	
EG	Hallway, Livingroom, Kitchen and Bedroom	Exhaust Grill	Velu	125mm	4	125mm (diameter)	
RG	Bathroom and Kitchen	Return Grill	Velu	125mm	2	125mm (diameter)	
ELAN 4	Tech Room	ELAN 4	Brink	ELAN 4	1	500x500x500	https://www.brinkclimatesystems.nl/nl-nl/professionals/producten/luchtverwarming/elan-4-(1)
DB-Brink-V2	Tech Room	DB-Brink-V2	Brink	Ventilation Distribution Box	1		
Ducts	Inside	Ducts and Bends	Velu	125mm		125mm (diameter)	
Floor Heating	Floor	System Element	Jupiter		93		http://www.jupiter-vloerverwarming.nl/droogbouw-techniek/wat-is-droogbouw/index.php
	Floor	Connection Element	Jupiter		17		http://www.jupiter-vloerverwarming.nl/droogbouw-techniek/wat-is-droogbouw/index.php
	Floor	Side Element	Jupiter		18		http://www.jupiter-vloerverwarming.nl/droogbouw-techniek/wat-is-droogbouw/index.php
	Floor	System Piping	Jupiter		485		http://www.jupiter-vloerverwarming.nl/droogbouw-techniek/wat-is-droogbouw/index.php
	Floor	Side Isolation	Jupiter		62		http://www.jupiter-vloerverwarming.nl/droogbouw-techniek/wat-is-droogbouw/index.php
	Floor	Rahmenholz	Jupiter		62	1000x45x30	http://www.jupiter-vloerverwarming.nl/droogbouw-techniek/wat-is-droogbouw/index.php
	Floor	Ideaal OKO	Jupiter		89		http://www.jupiter-vloerverwarming.nl/droogbouw-techniek/wat-is-droogbouw/index.php



TEAM NAME: Selficient
 ADDRESS: Padualaan 99
 3584CH Utrecht
 The Netherlands
 CONTACT: info@selficient.org
 www.selficient.org

CONSULTANTS
 ARCHITECTURE
 ENGINEERS
 LANDSCAPING
 SAFETY FIRST CODE CONSULTANTS

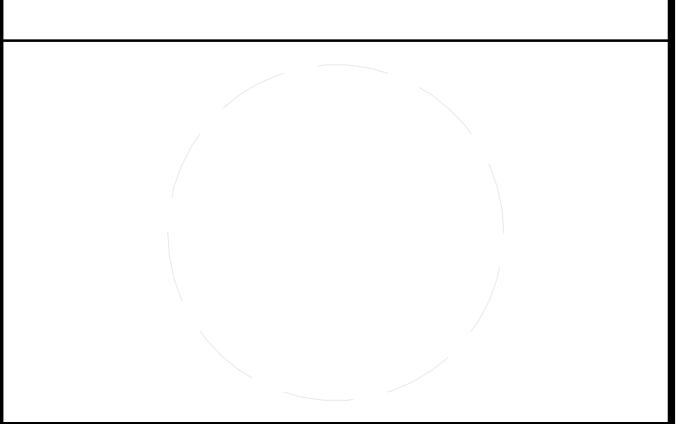

CLIENT
 U.S. DEPARTMENT OF ENERGY
 SOLAR DECATHLON 2017
 WWW.SOLARDECATHLON.GOV



Rev.00	DATE	ADD. SCHEMATICS DESCRIPTION
02-24-2017		

LOT NUMBER: 106
 DRAWN BY: Kars Slagter
 CHECKED BY: Remco Polle
 COPYRIGHT: NONE; PROJECT IS PUBLIC DOMAIN

SHEET TITLE
MECHANICAL SCHEDULE

M-500

MECH ABBRIVIATIONS AND SYMBOLS

	SINGLE WALL SOCKET WATERPROOF
	SINGLE WALL SOCKET
	DUAL WALL SOCKET
	PERILEX
	BIPOLAR SWITCH
	PULSE SWITCH KNX
	TOUCH SCREEN KNX
	FIXED CONNECTION
	FIXED 230V CONNECTION
	DATA POINT
	MOTION DETECTOR
	JUNCTION BOX
	CEILING FIXTURE
	LED SPOT
	SMOKE DETECTOR
	MAGNET CONTACT
	INTERCOM WATERPROOF
	TWILIGHT SWITCH WATERPROOF
KT	COOKING APPLIANCE
OV	OVEN
AFZ	EXTRACTOR
VW	DISHWASHER
WM	WASHING MACHINE
DR	TUMBLE DRYER
RV	MOISTURE SENSOR
KK	FRIDGE
VR	FREEZER
NOTE:	LED STRIP CABLE TO HKL

GENERAL ELECTRICAL NOTES

1. GENERAL NOTES .

1.1 National Electrical Code
The provisions of the 2014 NEC supersede the limited prescriptive electrical requirements contained in Chapters 33-42 of the IRC.

1.2 Installation
Installation of electrical conductors, raceways, and devices shall conform to the 2014 NEC and the 2017 solar decathlon building code.

1.3 Equipment
All electrical equipment shall carry an approved testing agency listing in accordance with IRC section 140.11 and section 110.2 of the NEC , or shall have been approved by the Solar Decathlon building official and Solar Decathlon electrical inspectors for temporary use during the solar decathlon 2017 event.

1.4 Grounding
The grounding electrode conductor from the main service equipment to the Solar Decathlon 2017 organizer utility panel shall be a minimum size of 4 awg copper and shall be bonded by qualified electrical personnel to the organizer grounding electrode system at the organizer utility panel location.

1.4 Equipment Grounding
The equipment grounding electrode conductor shall be the first to be connected and last to be disconnected during installation, de-installation, or servicing of photovoltaic modules and inverters.

1.5 Branch Circuit
Branch circuit conductors shall have an ampacity not less than the maximum load to be served. Conductors shall be sized to carry not less than the larger of NEC 210.19 (A)(1)(a) or (b).

1.6 Conductors
Conductors specified in the electrical plan shall be sized in compliance with NEC table 310.15(B)(16). Minimum AC conductors size shall be 14 AWG. Minimum DC conductors size shall be 12 AWG.

1.6 Insulation of Conductors
Except where otherwise noted, conductors shall be copper with 600 Volt insulation.

1.7 Panelboards
All panelboards shall be provided with a factory installed ground bus for connecting to ground the green or bare ground wire in all branch circuits.

1.8 Electric Vehicle Charging
An outlet installed for the purpose of charging electric vehicles shall be supplied by a separate branch circuit having no other outlets per NEC 210.17.

1.9 Installation route
Team shall provide a clear installation route for organizer ethernet and power cables from the organizer utility panel to the organizer enclosure.

1.10 Branch Circuit Breaker
Team shall supply a dedicated 15A 2P branch circuit breaker and adequate ground and neutral bus bar terminals in the team panel board for voltage sense circuitry connections to the organizer pv monitoring meter to be connected by organizer's qualified electrical personnel.

1.11 Organizer Enclosure
Team shall provide an organizer enclosure of required specifications per Solar Decathlon 2017 team interconnection checklist with adequate conduit fill and pull box access for entrance of organizer sensor wires.



TEAM NAME: Selficient
ADDRESS: Padualaan 99
3584CH Utrecht
The Netherlands
CONTACT: info@selficient.org
www.selficient.org

CONSULTANTS
ARCHITECTURE
ENGINEERS
LANDSCAPING
SAFETY FIRST CODE CONSULTANTS

CLIENT
U.S. DEPARTMENT OF ENERGY
SOLAR DECATHLON 2017
WWW.SOLARDECATHLON.GOV




Rev. 00	02-24-2017	ADD. NOTES AND SYMBOLS
Rev. 01	08-08-2017	UPDATE NOTES, SYMBOLS
MARK	DATE	DESCRIPTION

LOT NUMBER: 106
DRAWN BY: Kars Slagter
CHECKED BY: Remco Polle
COPYRIGHT: NONE; PROJECT IS PUBLIC DOMAIN

SHEET TITLE
ELECTRICAL SYMBOLS AND NOTES

E-001

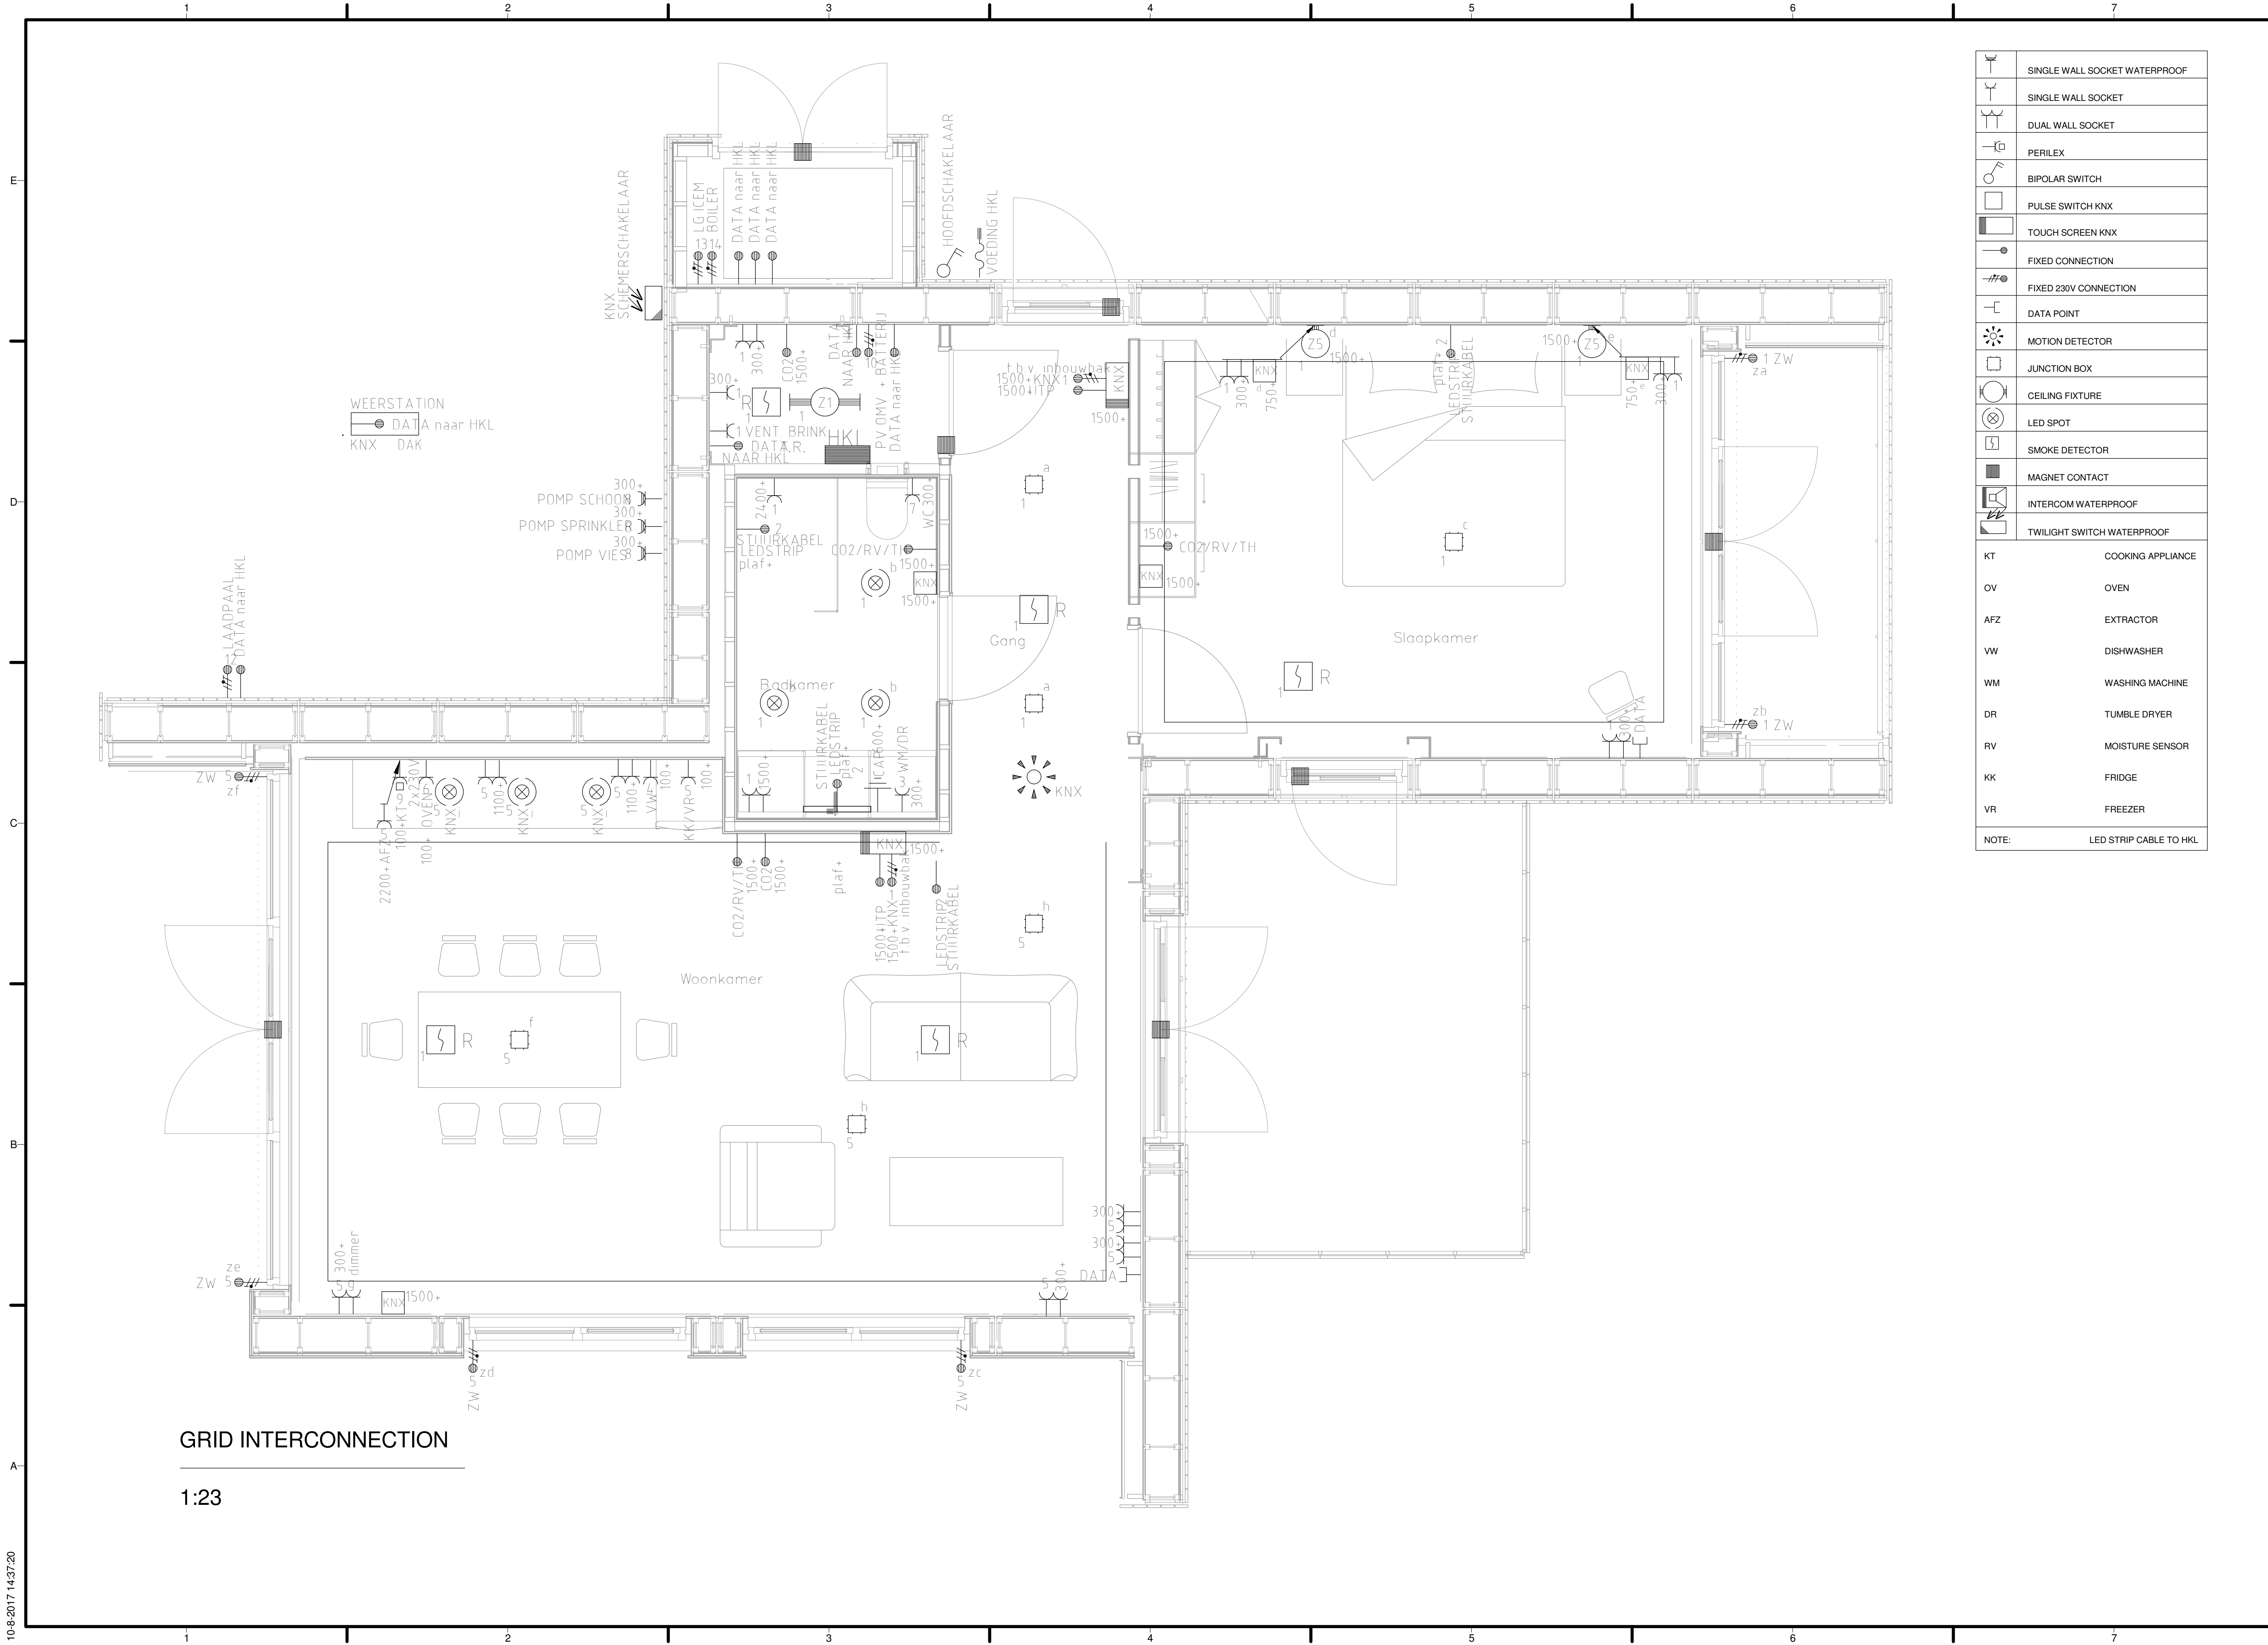


	SINGLE WALL SOCKET WATERPROOF
	SINGLE WALL SOCKET
	DUAL WALL SOCKET
	PERILEX
	BIPOLAR SWITCH
	PULSE SWITCH KNX
	TOUCH SCREEN KNX
	FIXED CONNECTION
	FIXED 230V CONNECTION
	DATA POINT
	MOTION DETECTOR
	JUNCTION BOX
	CEILING FIXTURE
	LED SPOT
	SMOKE DETECTOR
	MAGNET CONTACT
	INTERCOM WATERPROOF
	TWILIGHT SWITCH WATERPROOF
	COOKING APPLIANCE
	OVEN
	EXTRACTOR
	DISHWASHER
	WASHING MACHINE
	TUMBLE DRYER
	MOISTURE SENSOR
	FRIDGE
	FREEZER

NOTE: LED STRIP CABLE TO HKL



TEAM NAME: Selficient
 ADDRESS: Padualaan 99, 3584CH Utrecht, The Netherlands
 CONTACT: info@selficient.org, www.selficient.org

CONSULTANTS
 ARCHITECTURE
 ENGINEERS
 LANDSCAPING
 SAFETY FIRST CODE CONSULTANTS

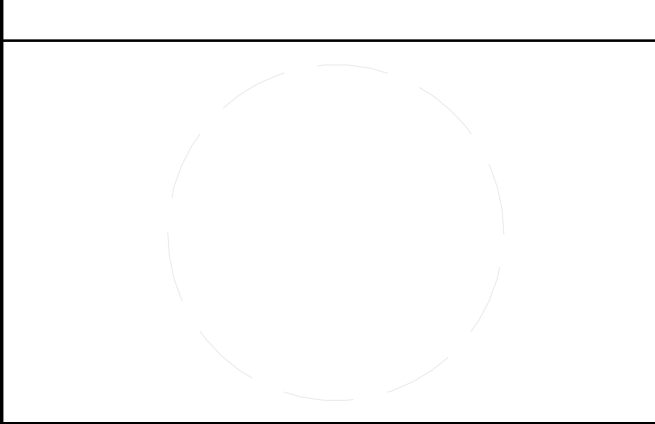

CLIENT
 U.S. DEPARTMENT OF ENERGY
 SOLAR DECATHLON 2017
 WWW.SOLARDECATHLON.GOV




MARK	DATE	DESCRIPTION
Rev.00	11-17-2016	90% REVISION
Rev.01	02-24-2017	SECOND DESIGN
Rev.02	08-08-2017	FINAL DESIGN

LOT NUMBER: 106
 DRAWN BY: Kars Slagter
 CHECKED BY: Remco Polle
 COPYRIGHT: NONE; PROJECT IS PUBLIC DOMAIN

SHEET TITLE
GRID INTERCONNECTION

E-100

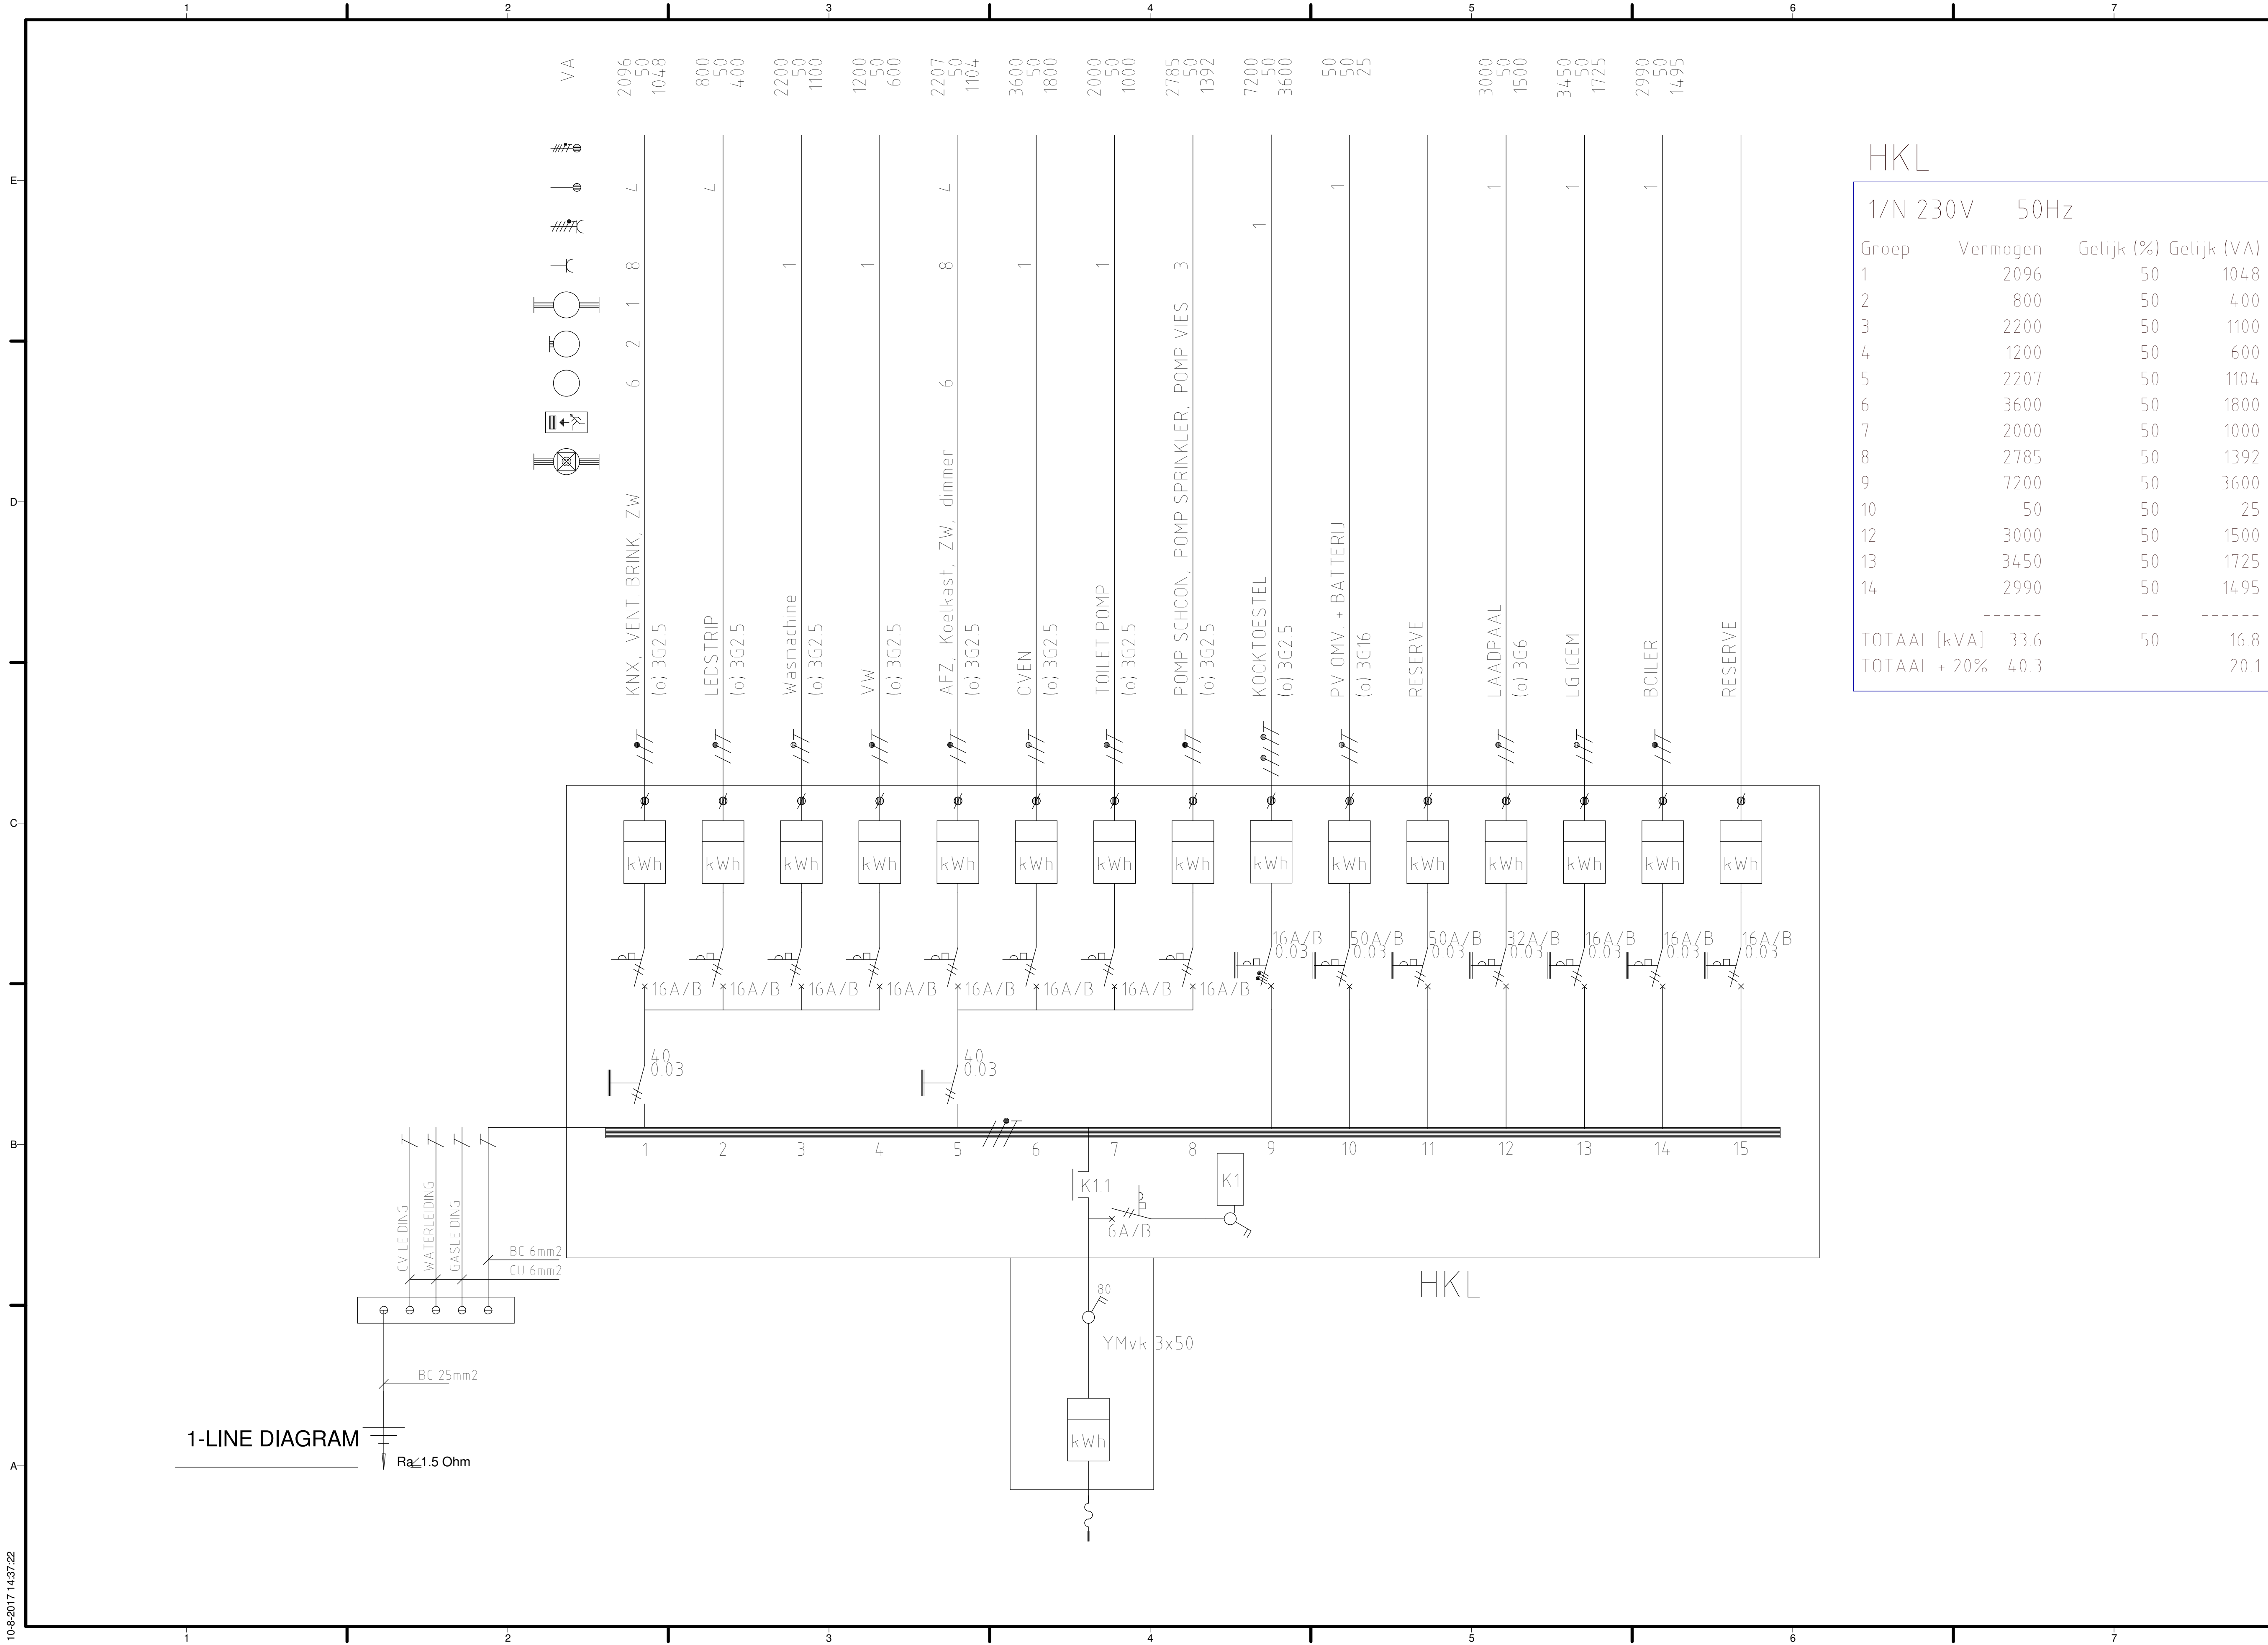

HKL


1/N 230V 50Hz

Groep	Vermogen	Gelijk (%)	Gelijk (VA)
1	2096	50	1048
2	800	50	400
3	2200	50	1100
4	1200	50	600
5	2207	50	1104
6	3600	50	1800
7	2000	50	1000
8	2785	50	1392
9	7200	50	3600
10	50	50	25
12	3000	50	1500
13	3450	50	1725
14	2990	50	1495
TOTAAL [kVA]			33.6
TOTAAL + 20%			40.3
Gelijk (%)			50
Gelijk (VA)			16.8
Gelijk (VA) + 20%			20.1



TEAM NAME: Selficient
 ADDRESS: Padualaan 99, 3584CH Utrecht, The Netherlands
 CONTACT: info@selficient.org, www.selficient.org

CONSULTANTS
 ARCHITECTURE
 ENGINEERS
 LANDSCAPING
 SAFETY FIRST CODE CONSULTANTS

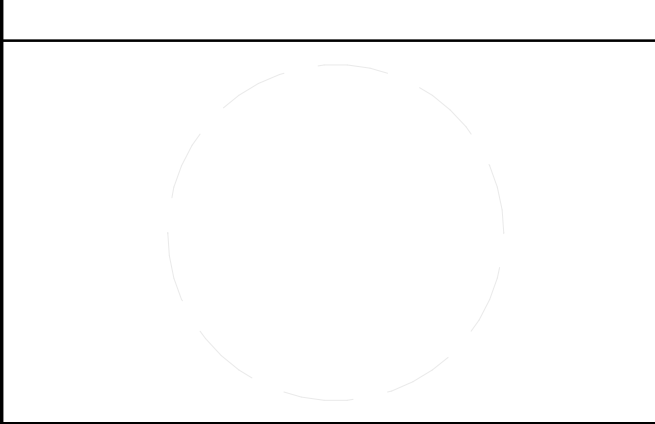

CLIENT
 U.S. DEPARTMENT OF ENERGY
 SOLAR DECATHLON 2017
 WWW.SOLARDECATHLON.GOV



MARK	DATE	DESCRIPTION
Rev.00	11-17-2016	90% REVISION
Rev.01	02-24-2017	SECOND DESIGN
Rev.02	08-08-2017	FINAL DESIGN

LOT NUMBER: 106
 DRAWN BY: Kars Slagter
 CHECKED BY: Remco Polle
 COPYRIGHT: NONE; PROJECT IS PUBLIC DOMAIN

SHEET TITLE
1-LINE DIAGRAM

E-200

TEAM NAME: Selficient
 ADDRESS: Padualaan 99
 3584CH Utrecht
 The Netherlands
 CONTACT: info@selficient.org
 www.selficient.org

CONSULTANTS
 ARCHITECTURE
 ENGINEERS
 LANDSCAPING
 SAFETY FIRST CODE CONSULTANTS

CLIENT
 U.S. DEPARTMENT OF ENERGY
 SOLAR DECATHLON 2017
 WWW.SOLARDECATHLON.GOV





MARK	DATE	DESCRIPTION
Rev.00	11-17-2016	90% REVISION
Rev.01	02-24-2017	SECOND DESIGN
Rev.02	08-08-2017	FINAL DESIGN

LOT NUMBER: 106
 DRAWN BY: Kars Slagter
 CHECKED BY: Remco Polle
 COPYRIGHT: NONE; PROJECT IS PUBLIC DOMAIN

SHEET TITLE
 3-LINE DIAGRAM


E-201

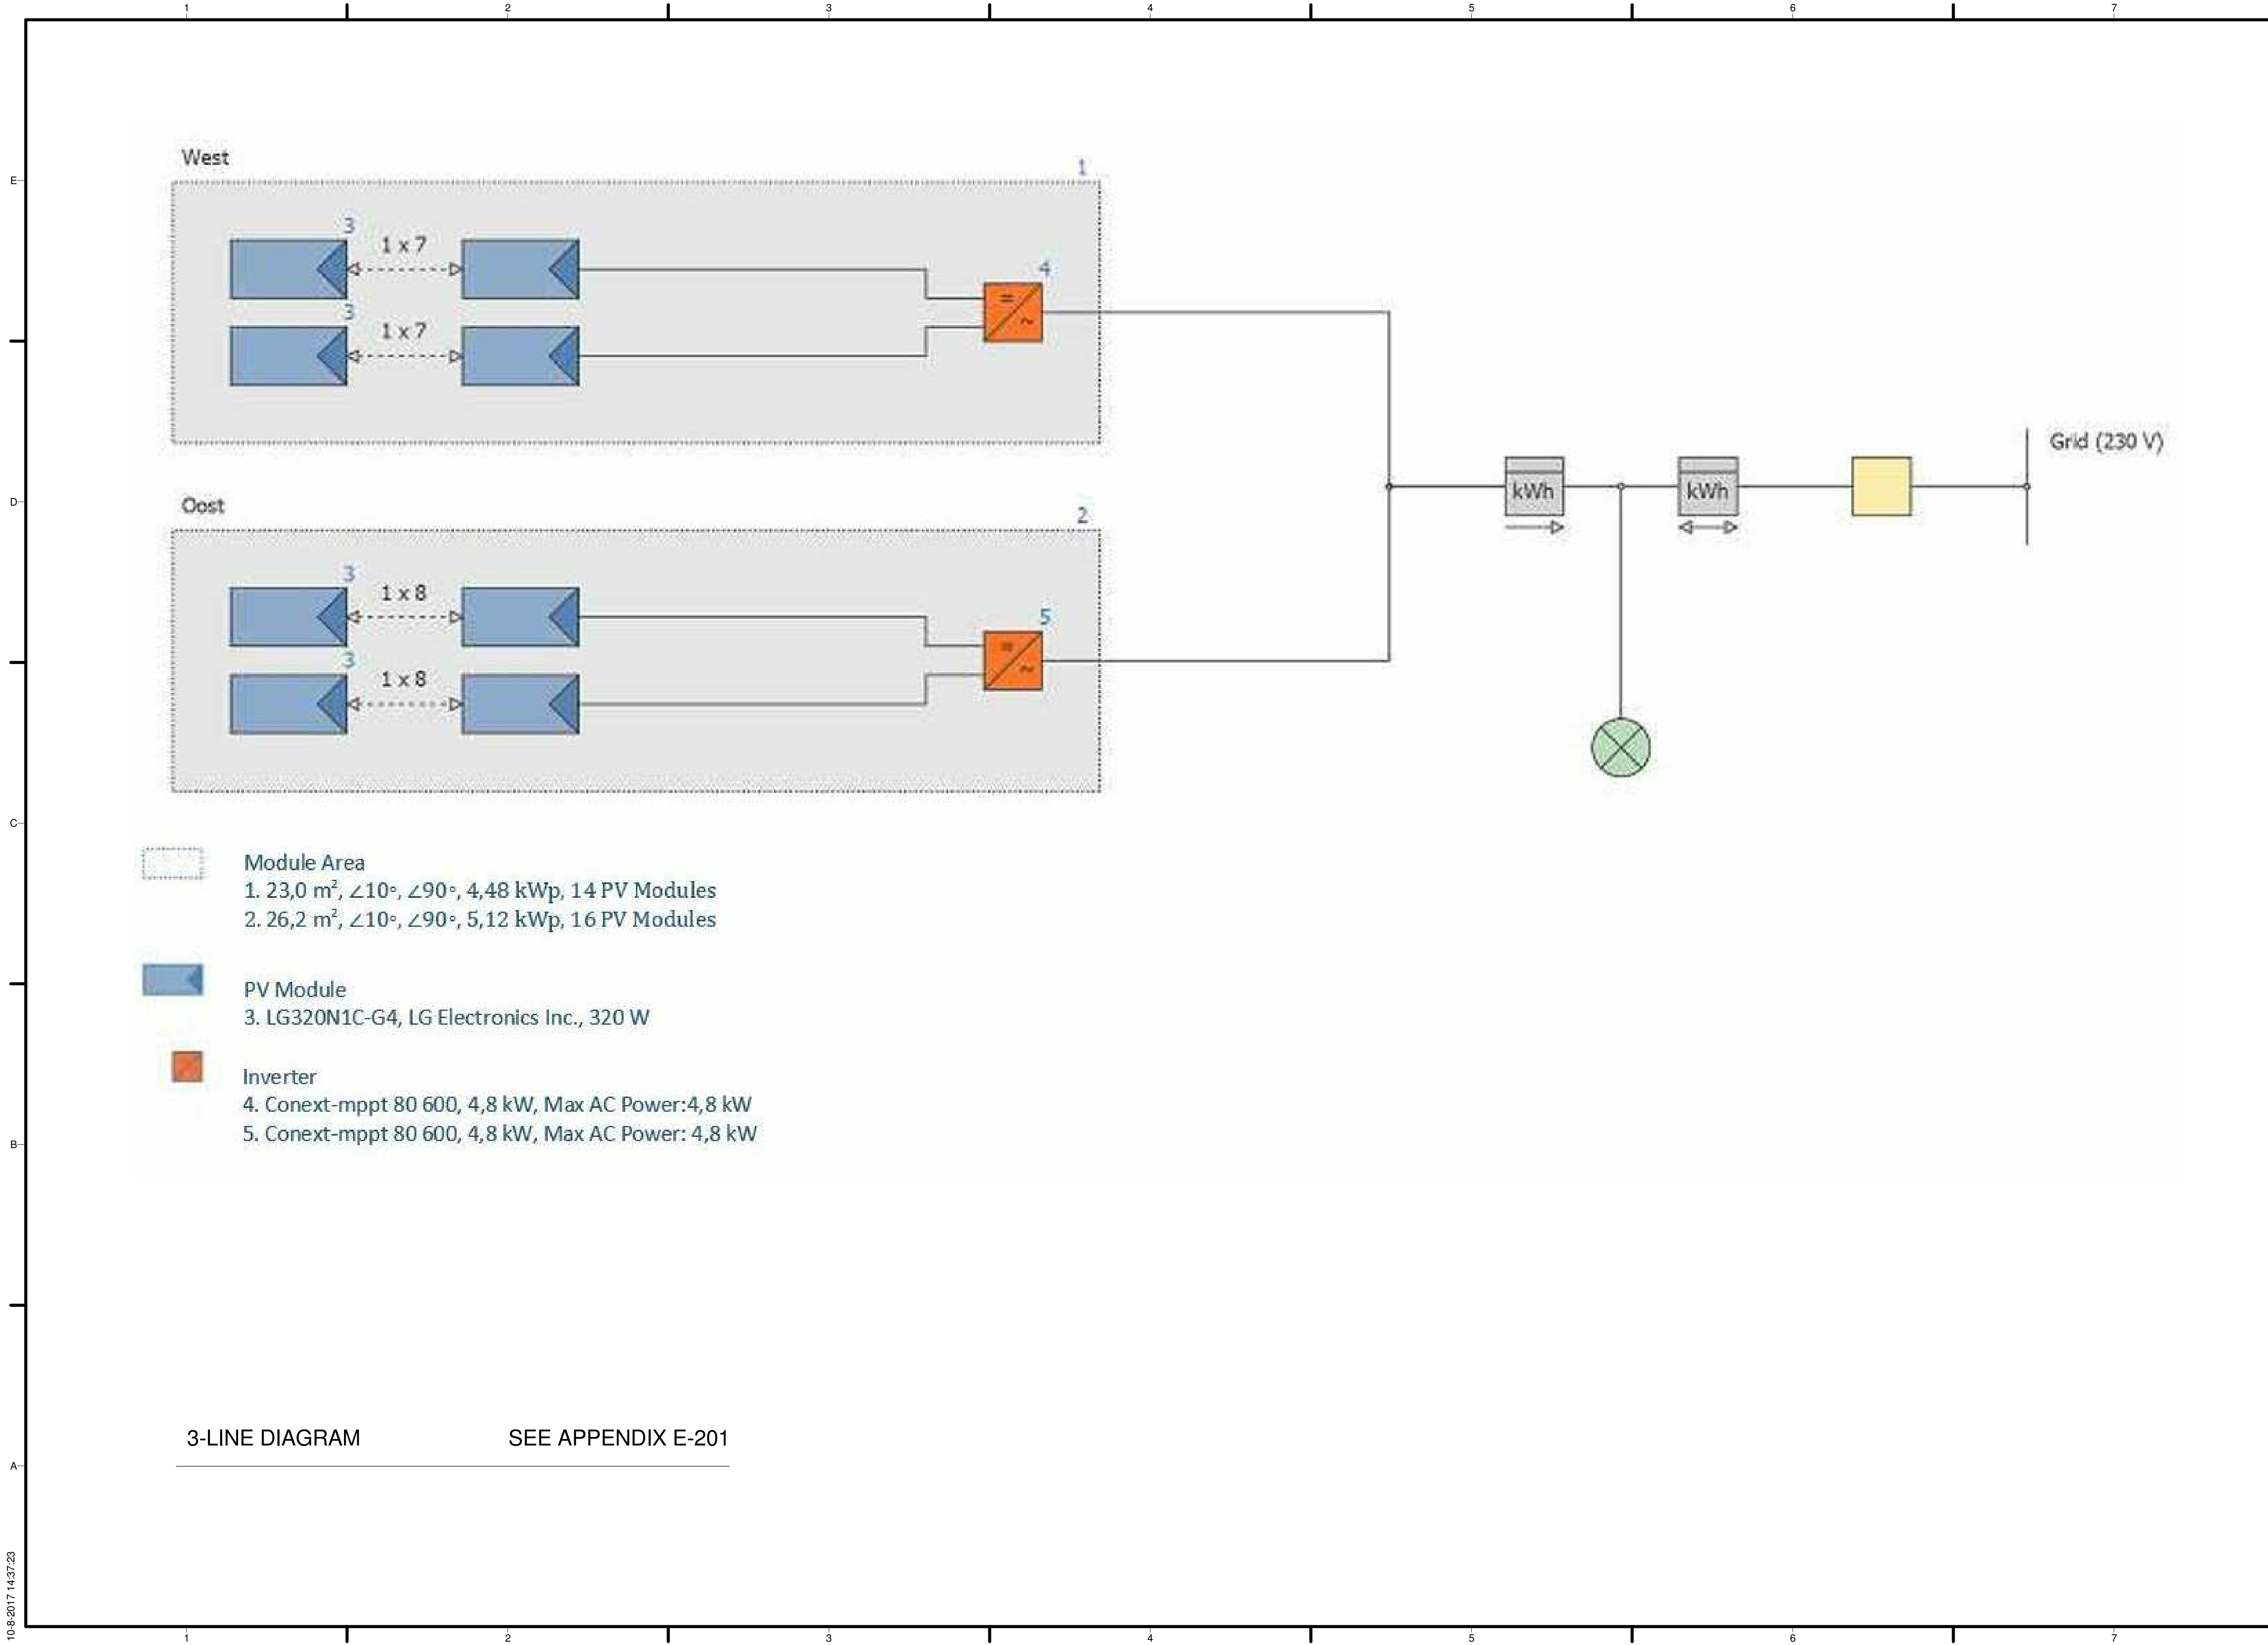

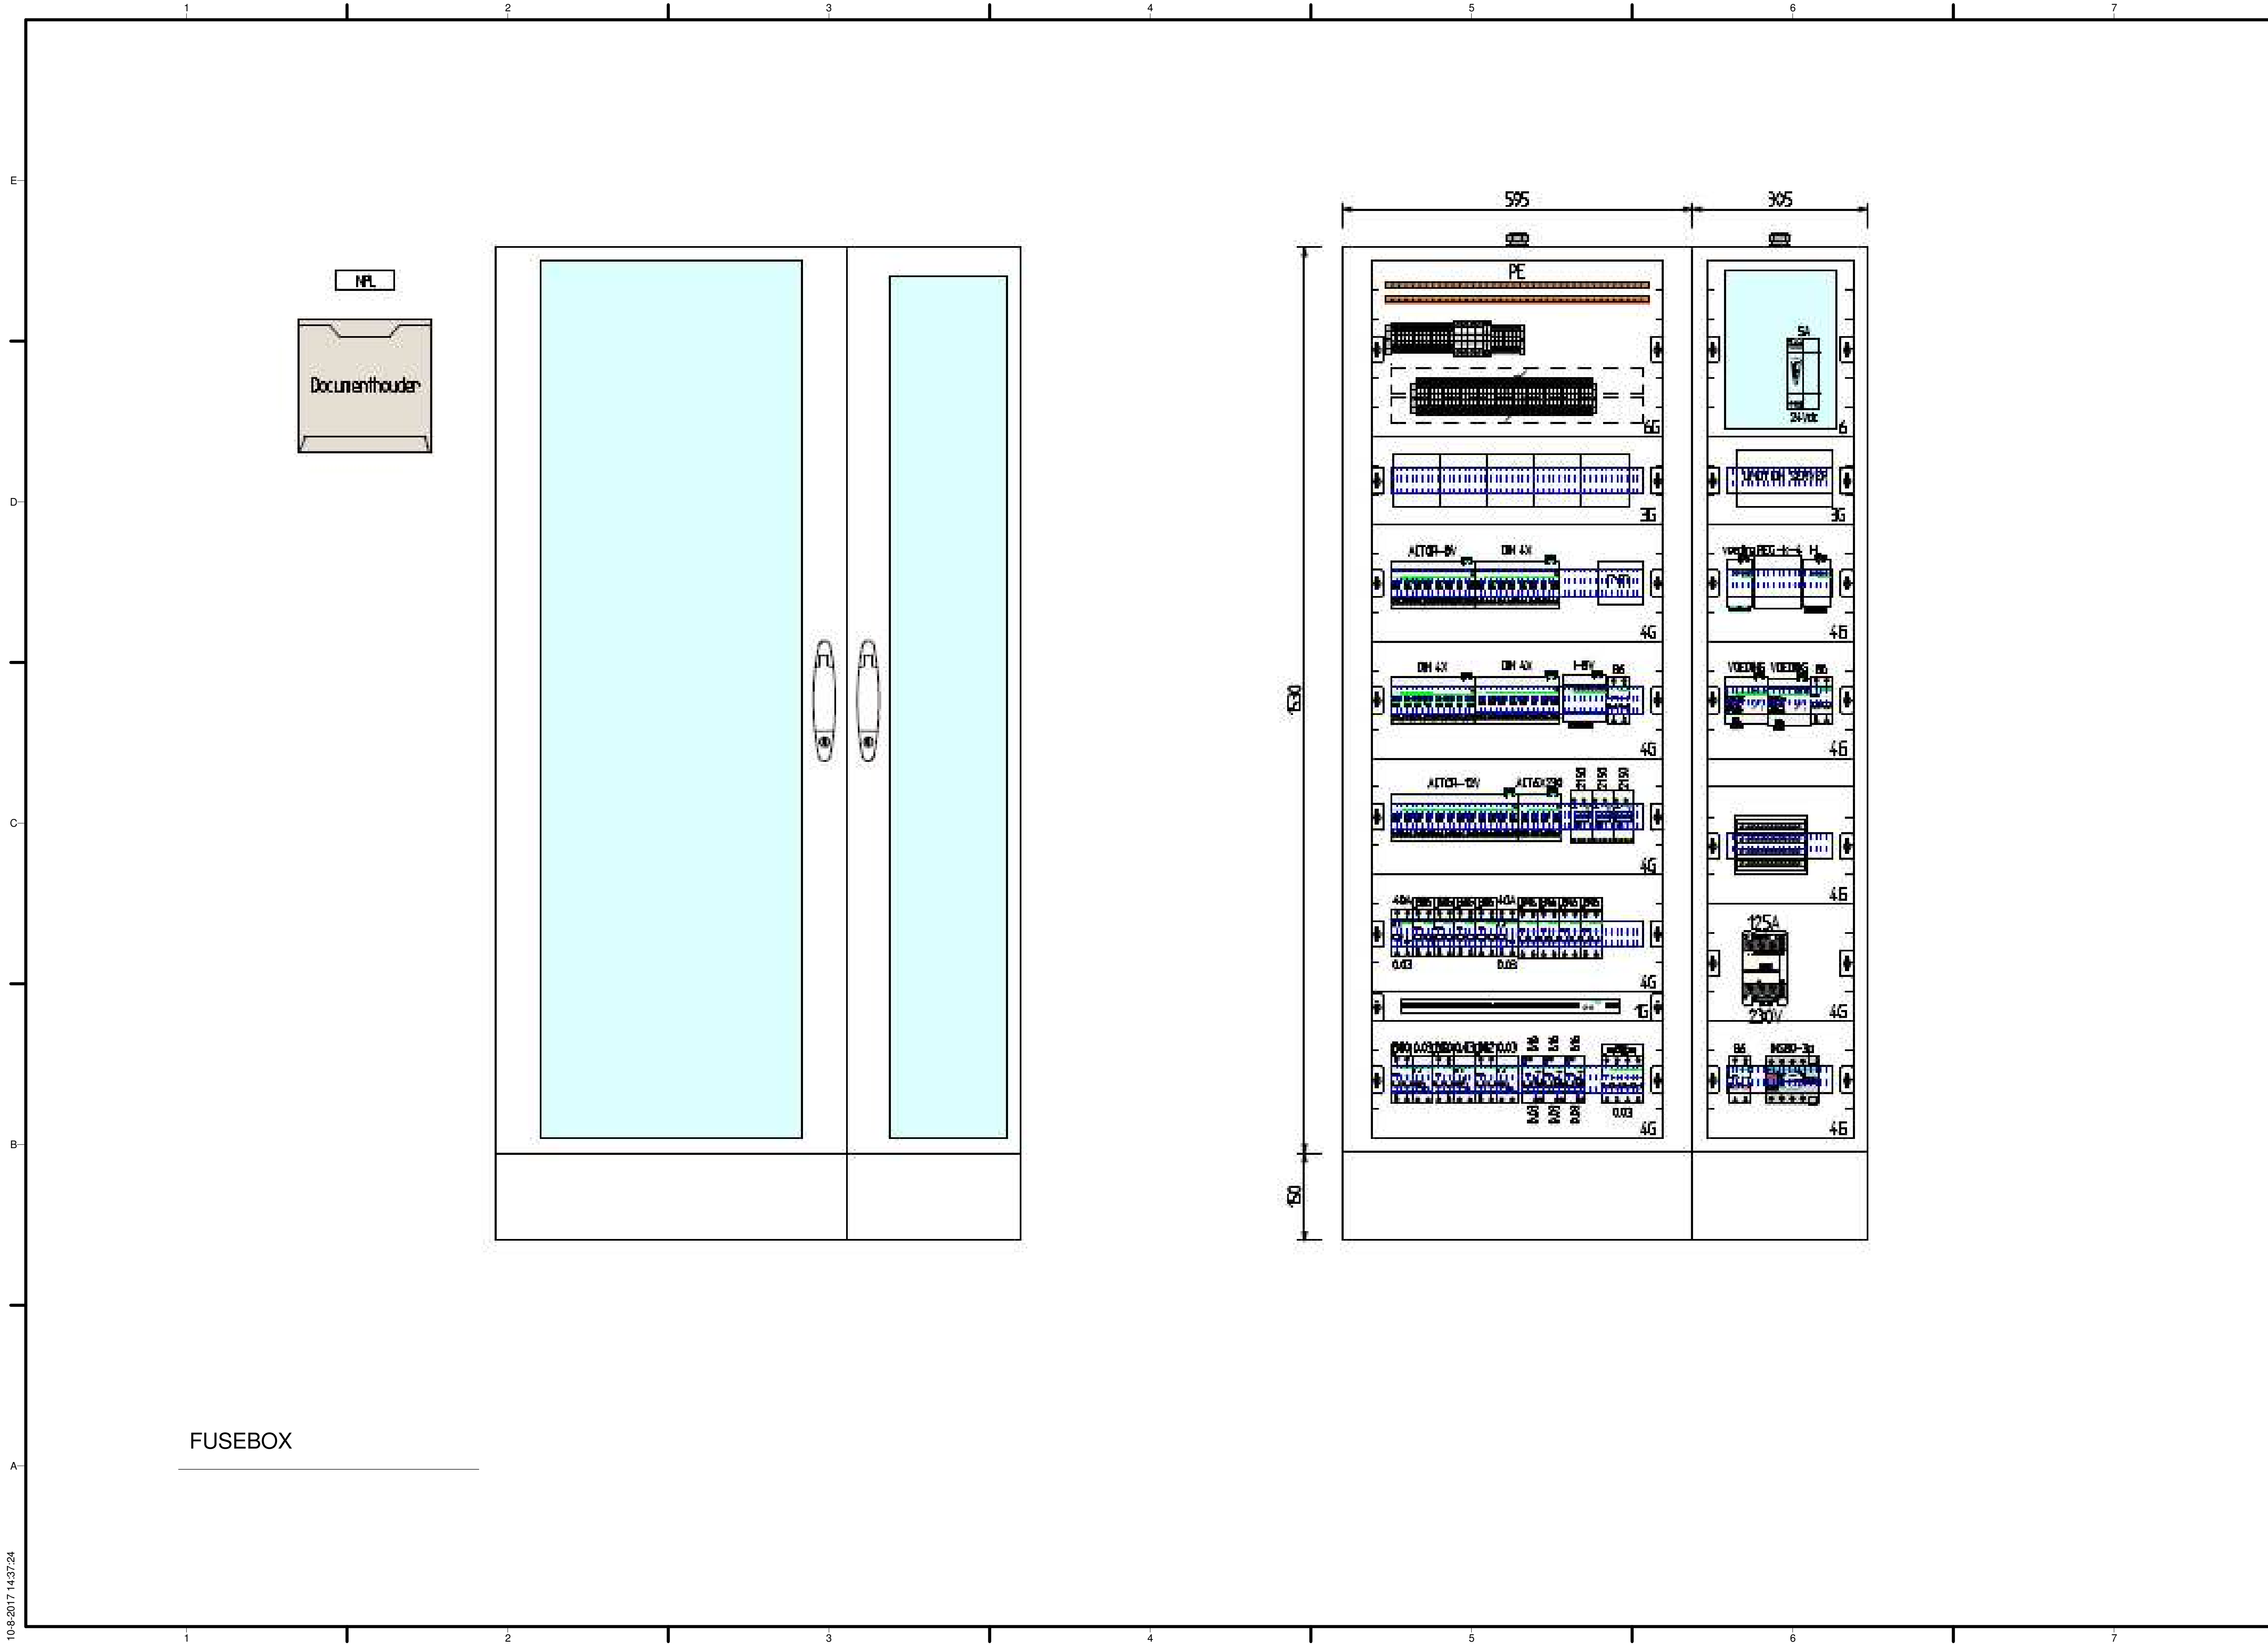

TEAM NAME: Selficient
 ADDRESS: Padualaan 99
 3584CH Utrecht
 The Netherlands
 CONTACT: info@selficient.org
 www.selficient.org

CONSULTANTS
 ARCHITECTURE
 ENGINEERS
 LANDSCAPING
 SAFETY FIRST CODE CONSULTANTS

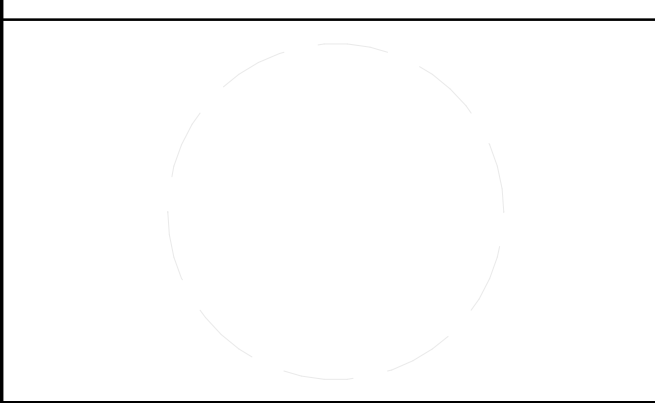

CLIENT
 U.S. DEPARTMENT OF ENERGY
 SOLAR DECATHLON 2017
 WWW.SOLARDECATHLON.GOV



MARK	DATE	DESCRIPTION
Rev.00	11-17-2016	90% REVISION
Rev.01	02-24-2017	SECOND DESIGN
Rev.02	08-08-2017	FINAL DESIGN

LOT NUMBER: 106
 DRAWN BY: Kars Slagter
 CHECKED BY: Remco Polle
 COPYRIGHT: NONE; PROJECT IS PUBLIC DOMAIN

SHEET TITLE
FUSEBOX

E-300

SEE APPENDIX E-500



TEAM NAME: Selficient
 ADDRESS: Padualaan 99
 3584CH Utrecht
 The Netherlands
 CONTACT: info@selficient.org
 www.selficient.org

CONSULTANTS
 ARCHITECTURE
 ENGINEERS
 LANDSCAPING
 SAFETY FIRST CODE CONSULTANTS



CLIENT
 U.S. DEPARTMENT OF ENERGY
 SOLAR DECATHLON 2017
 WWW.SOLARDECATHLON.GOV



Rev.00	11-17-2016	90% REVISION
Rev.01	08-08-2017	FINAL DESIGN
MARK	DATE	DESCRIPTION

LOT NUMBER: 106
 DRAWN BY: Thijs Morel
 CHECKED BY: Remco Polle
 COPYRIGHT: NONE; PROJECT IS PUBLIC DOMAIN

SHEET TITLE
ACTION LIST

E-500

Electrical Schedule

Type Mark	Room: name	Description	Manufacturer	Model (Artikelnummer)	Count	Dimensions (DxWxH) (mm)	URL
KT	Kitchen	Cooking appliance	IKEA	403.039.34	1	510x580x56	http://www.ikea.com/be/nl/catalog/products/40303934/
OV	Kitchen	Oven	IKEA	803.009.57	1	567x594x455	http://www.ikea.com/nl/nl/catalog/products/80300957/
AFZ	Kitchen	Extractor	IKEA	903.046.10	1	355x561x358	http://www.ikea.com/nl/nl/catalog/products/90304610/
VW	Kitchen	Dish washer	IKEA	803.520.36	1	550x596x818	http://www.ikea.com/nl/nl/catalog/products/80352036/
WM	Bathroom	Washing machine	Samsung	572799	1	600x600x850	https://www.wasmachinestore.nl/product/572799/samsung-wd80j6400aw.html
DR	Bathroom	Dryer	Samsung	572799	1	600x600x850	https://www.wasmachinestore.nl/product/572799/samsung-wd80j6400aw.html
RV	Every room	Space moisture sensor	Schneider Electric/Brink	MTN6005-0001	3	74x74x31	http://www.schneider-electric.com/en/product/MTN6005-0001/knx-co2%2C-humidity-and-temperature-sensor-ap
KK	Kitchen	Refrigerator	IKEA	203.127.60	1	677x595x1845	http://www.ikea.com/nl/nl/catalog/products/20312760/
VR	Kitchen	Freezer	IKEA	203.127.60	1	677x595x1845	http://www.ikea.com/nl/nl/catalog/products/20312760/
Lightning							
a	Hallway	Ceiling light	Lechlade	-	1	-	https://lampgigant.nl/lamp/lechlade-plafondlamp-modern-design-wit/
b	Bathroom	Led spot	YPHIX	50258907	3	7x75x22	https://www.ledlampendirect.nl/led-inbouwspot-argenta-aluminium-rond-ip65-
c	Bedroom	Ceiling light	Lechlade	-	1	-	https://lampgigant.nl/lamp/lechlade-plafondlamp-modern-design-wit/
d	Bedroom	Wall light	YPHIX	50228056	1	197x76x111	https://www.ledlampendirect.nl/wandlamp-nalo-spot-230v-gu10-rvs-854.html
e	Bedroom	Wall light	YPHIX	50228056	1	197x76x111	https://www.ledlampendirect.nl/wandlamp-nalo-spot-230v-gu10-rvs-854.html
f	Living room	Ceiling light	Lampgigant	-	1	730x200x1100	https://lampgigant.nl/lamp/landelijke-eettafelamp-milicia-zwart/
g	Living room	Standing light	Lampgigant	-	1	-	https://lampgigant.nl/lamp/landelijke-houten-bruine-vloerlamp-joleen-stoffen-
h	Living room	Ceiling light	Lampgigant	-	1	-	https://lampgigant.nl/lamp/industrie-hanqlamp-flow-greige-grijs-taupe/
i	Kitchen	Led spot	123Ledspots	11882299	1	7x75x22	https://www.123ledspots.nl/inbouw-en-opbouw-led-spot-monaco-4w-dimbaar.html
Shading							
za	Bedroom	Shading	Smits	-	1	7x732x2465	http://www.wonninkprojectzonwering.nl/
zb	Bedroom	Shading	Smits	-	1	7x732x2465	http://www.wonninkprojectzonwering.nl/
zc	Living room	Shading	Smits	-	1	7x1352x2465	http://www.wonninkprojectzonwering.nl/
zd	Living room	Shading	Smits	-	1	7x1352x2465	http://www.wonninkprojectzonwering.nl/
ze	Living room	Shading	Smits	-	1	7x2009x2465	http://www.wonninkprojectzonwering.nl/
zf	Living room	Shading	Smits	-	1	7x2009x2465	http://www.wonninkprojectzonwering.nl/
HKL							
KNX Power Supply 0,4A	Technical room	KNX Power Supply 0,4A	Schneider Electric	MTN693003	1	92x17.5x68.1	http://www.schneider-electric.com/en/product/MTN693003/power-supply-reg%2C-24-v-dc--0.4-a-%2C-light-grey
KNX Power Supply AC 24V	Technical room	KNX Power Supply AC 24V	Schneider Electric	MTN684064	1	90x72x65	http://www.schneider-electric.com/en/product/MTN684064/knx-power-supply-reg-k-640-ma%2C-light-grey
HomeLynk	Technical room	HomeLynk	Schneider Electric	LSS100100	1	58x52x90	http://www.schneider-electric.com/en/product/LSS100100/homelynk-logic-controller/
U.Motion KNX Server Plus	Technical room	U.Motion KNX Server Plus	Schneider Electric	MTN6501-0002	1	63x162x95	http://www.schneider-electric.com/en/product/MTN6501-0002/u.motion--knx-server-plus/
KNX Weather Station	Technical room	KNX Weather Station	Schneider Electric	MTN682991	1	-	http://www.schneider-electric.com/en/product/MTN682991/weather-station-reg-k-4-gang%2C-light-grey
KNX Heating actor	Technical room	KNX Heating actor	Schneider Electric	MTN6730-0001	1	-	http://www.schneider-electric.com/en/product/MTN6730-0001/heating-actuator-reg-k-6x230-0.16-a-%2C-light-grey
KNX Shading actor	Technical room	KNX Shading actor	Schneider Electric	MTN649808	1	-	http://www.schneider-electric.com/en/product/MTN649808/blind-actuator-reg-k-8x-10-with-manual-mode%2C-light-grey



TEAM NAME: Selficient
 ADDRESS: Padualaan 99
 3584CH Utrecht
 The Netherlands
 CONTACT: info@selficient.org
 www.selficient.org

CONSULTANTS
 ARCHITECTURE
 ENGINEERS
 LANDSCAPING
 SAFETY FIRST CODE CONSULTANTS



CLIENT
 U.S. DEPARTMENT OF ENERGY
 SOLAR DECATHLON 2017
 WWW.SOLARDECATHLON.GOV



Rev.00	02-24-2017	ADD. SCHEDULE
Rev.01	08-08-2017	FINAL DESIGN
MARK	DATE	DESCRIPTION

LOT NUMBER: 106
 DRAWN BY: Kars Slagter
 CHECKED BY: Remco Polle
 COPYRIGHT: NONE; PROJECT IS PUBLIC DOMAIN

SHEET TITLE
ELECTRICAL SCHEDULE

E-501A

Electrical Schedule

Binary Input	Technical room	Binary Input	Schneider Electric	MTN644592	1	65x72x90	http://www.schneider-electric.com/en/product/MTN644592/binary-input-reg-k-8x10%2C-light-grey
Smoke Detector Link	Technical room	Smoke Detector Link	Schneider Electric	MTN548001	1	34x50x44	http://www.schneider-electric.com/en/product/MTN548001/flush-mounted-system-relay-for-argus-smoke-detector/
KNX Universal dimmer actor	Technical room	KNX Universal dimmer actor	Schneider Electric	MTN6710-0004	3	-	http://www.schneider-electric.com/en/product/MTN6710-0004/knx-universal-dimming-actuator-ll-reg-k-4x230-250w/
12-fold Switch actor	Technical room	12-fold Switch actor	Schneider Electric	MTN648493	3	-	http://www.schneider-electric.co.uk/en/product/MTN648493/switch-actuator-reg-k-12x230-16-with-manual-mode%2C-light-grey
Zennio Lumentio DX4	Technical room	Zennio Lumentio DX4	Schneider Electric	10241798	5	67x90x79	http://zennio.com/products/lighting/lumentio-dx4
Smartlink	Technical room	Smartlink	Schneider Electric	A9XMZA08	1	40x359x23	http://www.schneider-electric.com/en/product/A9XMZA08/acti9-smartlink-si-b---modbus-tcp-ip-and-wireless-communication-module/
ACTI9 Powertag	Technical room	ACTI9 Powertag	Schneider Electric	A9MEM1521	9	42.7x35.4x16.5	http://www.schneider-electric.com/en/product/A9MEM1521/acti-9---powertag---1p%2Bn---up-position---maximum-63a---energy-sensor
IEM-21	Technical room	IEM-21	Schneider Electric	A9MEM2155	3	64x90x36	http://www.schneider-electric.com/en/product/A9MEM2155/modular-single-phase-power-meter-iem2155---230v---63a-with-comm-modbus---mid/
Legend							
Single wall socket waterproof	Outside	Single wall socket waterproof	Schneider Electric	MTN2300-8019	3	61x73x83	https://www.elektrobode.nl/products/merten-opb-wcd-ra-klapdeksel-kindbev-pw-aquastar-mtn2300-8019
Single wall socket	Bathroom, technical room and kitchen	Single wall socket	Schneider Electric	MTN2300-6034	7	71x71x40	http://www.schneider-electric.com/en/product/MTN2300-6034/schuko-socket-outlet%2C-shutter%2C-screwless-terminals%2C-anthracite%2C-system-design
Dual wall socket	Bedroom, technical room, bathroom, living room and kitchen	Dual wall socket	Schneider Electric	MTN2300-6034	11	71x71x40	http://www.schneider-electric.com/en/product/MTN2300-6034/schuko-socket-outlet%2C-shutter%2C-screwless-terminals%2C-anthracite%2C-system-design
Perilex	Kitchen	Perilex	ABL	540534	1	-	https://www.technischeunie.nl/product/prd1999974773
Bipolar switch	Outside	Bipolar switch	Schneider Electric	VCFN25GE	1	106x82.5x131	http://www.schneider-electric.com/en/product/VCFN25GE/tesys-mini-vario---enclosed-emergency-stop-switch-disconnector---20-a/
Pulse switch KNX	Bedroom, bathroom and living room	Pulse switch KNX	Schneider Electric	MTN6215-5910	5	30x71x71	http://www.schneider-electric.com/en/product/MTN6215-5910/knx-multitouch-pro%2C-system-design
Touchscreen KNX	Hallway and living room	Touchscreen KNX	Schneider Electric	MTN6260-0315	2	92x306x525	http://www.schneider-electric.com/en/product/MTN6260-0315/u.motion-client-touch-15/
Fixed connection	Every room	Fixed connection	-	-	18	-	-
Fixed 230V connection	Every room	Fixed 230V connection	-	-	12	-	-
Data point	Bedroom and living room	Data point	Schneider Electric	MTN4564-6034	2	71x71x23	http://www.schneider-electric.com/en/product/MTN4564-6034/cen.pl.-f.-2-gng-modular-jack-w.-label-ld-%26-dust-slide%2C-anthracite%2C-sys.-design
Motion detector	Hallway	Motion detector	Schneider Electric	MTN630919	1	-	http://www.schneider-electric.com/en/product/MTN630919/knx-argus-presence-with-light-control-and-ir-receiver%2C-polar-white
Junction box	Bedroom, living room and hallway	Junction box	Attema	1598762	6	45x95x45	https://www.technischeunie.nl/product/prd1999983007?_requestid=1875427&q=1598762
Ceiling fixture	Technical room	Ceiling fixture	Philips	531765	1	155x630x65	https://www.karwei.nl/assortiment/massive-victory-line-ll-armatuur-2x-10w-led/p/B531765
Led spot	Bathroom and kitchen Bedroom, technical room, living room and hallway	Led spot	YPHIX and 123Leds	50258907 and 11882996	6	?x90x50 and ?x75x22	https://www.ledlampdirect.nl/led-inbouwspot-argentina-aluminium-rond-ip65-straalwaterdicht-dimbaar-en-kantelbaar-7w-vervangt-60w.html
Smoke detector	Bedroom, technical room, living room and hallway	Smoke detector	Schneider Electric	MTN5480-1119	5	?x?x49	http://www.schneider-electric.com/en/product/MTN5480-1119/argus-smoke-detector---rf-duo---polar-white/
Magnet contact	Bedroom, technical room, living room and hallway	Magnet contact	ENOcean	LSS10020032	9	?x78x25	http://www.schneider-electric.com/en/product/LSS10020032/ecostruxure-building-expert-enocean-room-occupancy-sensor/
Intercom waterproof	Outside	Intercom waterproof	Schneider Electric	MTN6910-0033	1	52x331x130	http://www.schneider-electric.com/en/product/MTN6910-0033/u.motion-door-station-set%2C-1-unit
Twilight switch waterproof	Roof	Twilight switch waterproof	Schneider Electric	MTN663991	1	-	http://www.schneider-electric.com/en/product/MTN663991/knx-brightness-and-temperature-sensor%2C-light-grey



TEAM NAME: Selficient
 ADDRESS: Padualaan 99
 3584CH Utrecht
 The Netherlands
 CONTACT: info@selficient.org
 www.selficient.org

CONSULTANTS
 ARCHITECTURE
 ENGINEERS
 LANDSCAPING
 SAFETY FIRST CODE CONSULTANTS



CLIENT
 U.S. DEPARTMENT OF ENERGY
 SOLAR DECATHLON 2017
 WWW.SOLARDECATHLON.GOV




Rev.	DATE	DESCRIPTION
Rev.00	11-17-2016	90% REVISION
Rev.01	02-24-2017	SECOND DESIGN
Rev.02	08-08-2017	FINAL DESIGN
MARK	DATE	DESCRIPTION

LOT NUMBER: 106
 DRAWN BY: Author
 CHECKED BY: Checker
 COPYRIGHT: NONE; PROJECT IS PUBLIC DOMAIN

SHEET TITLE
ELECTRICAL SCHEDULE

E-501B

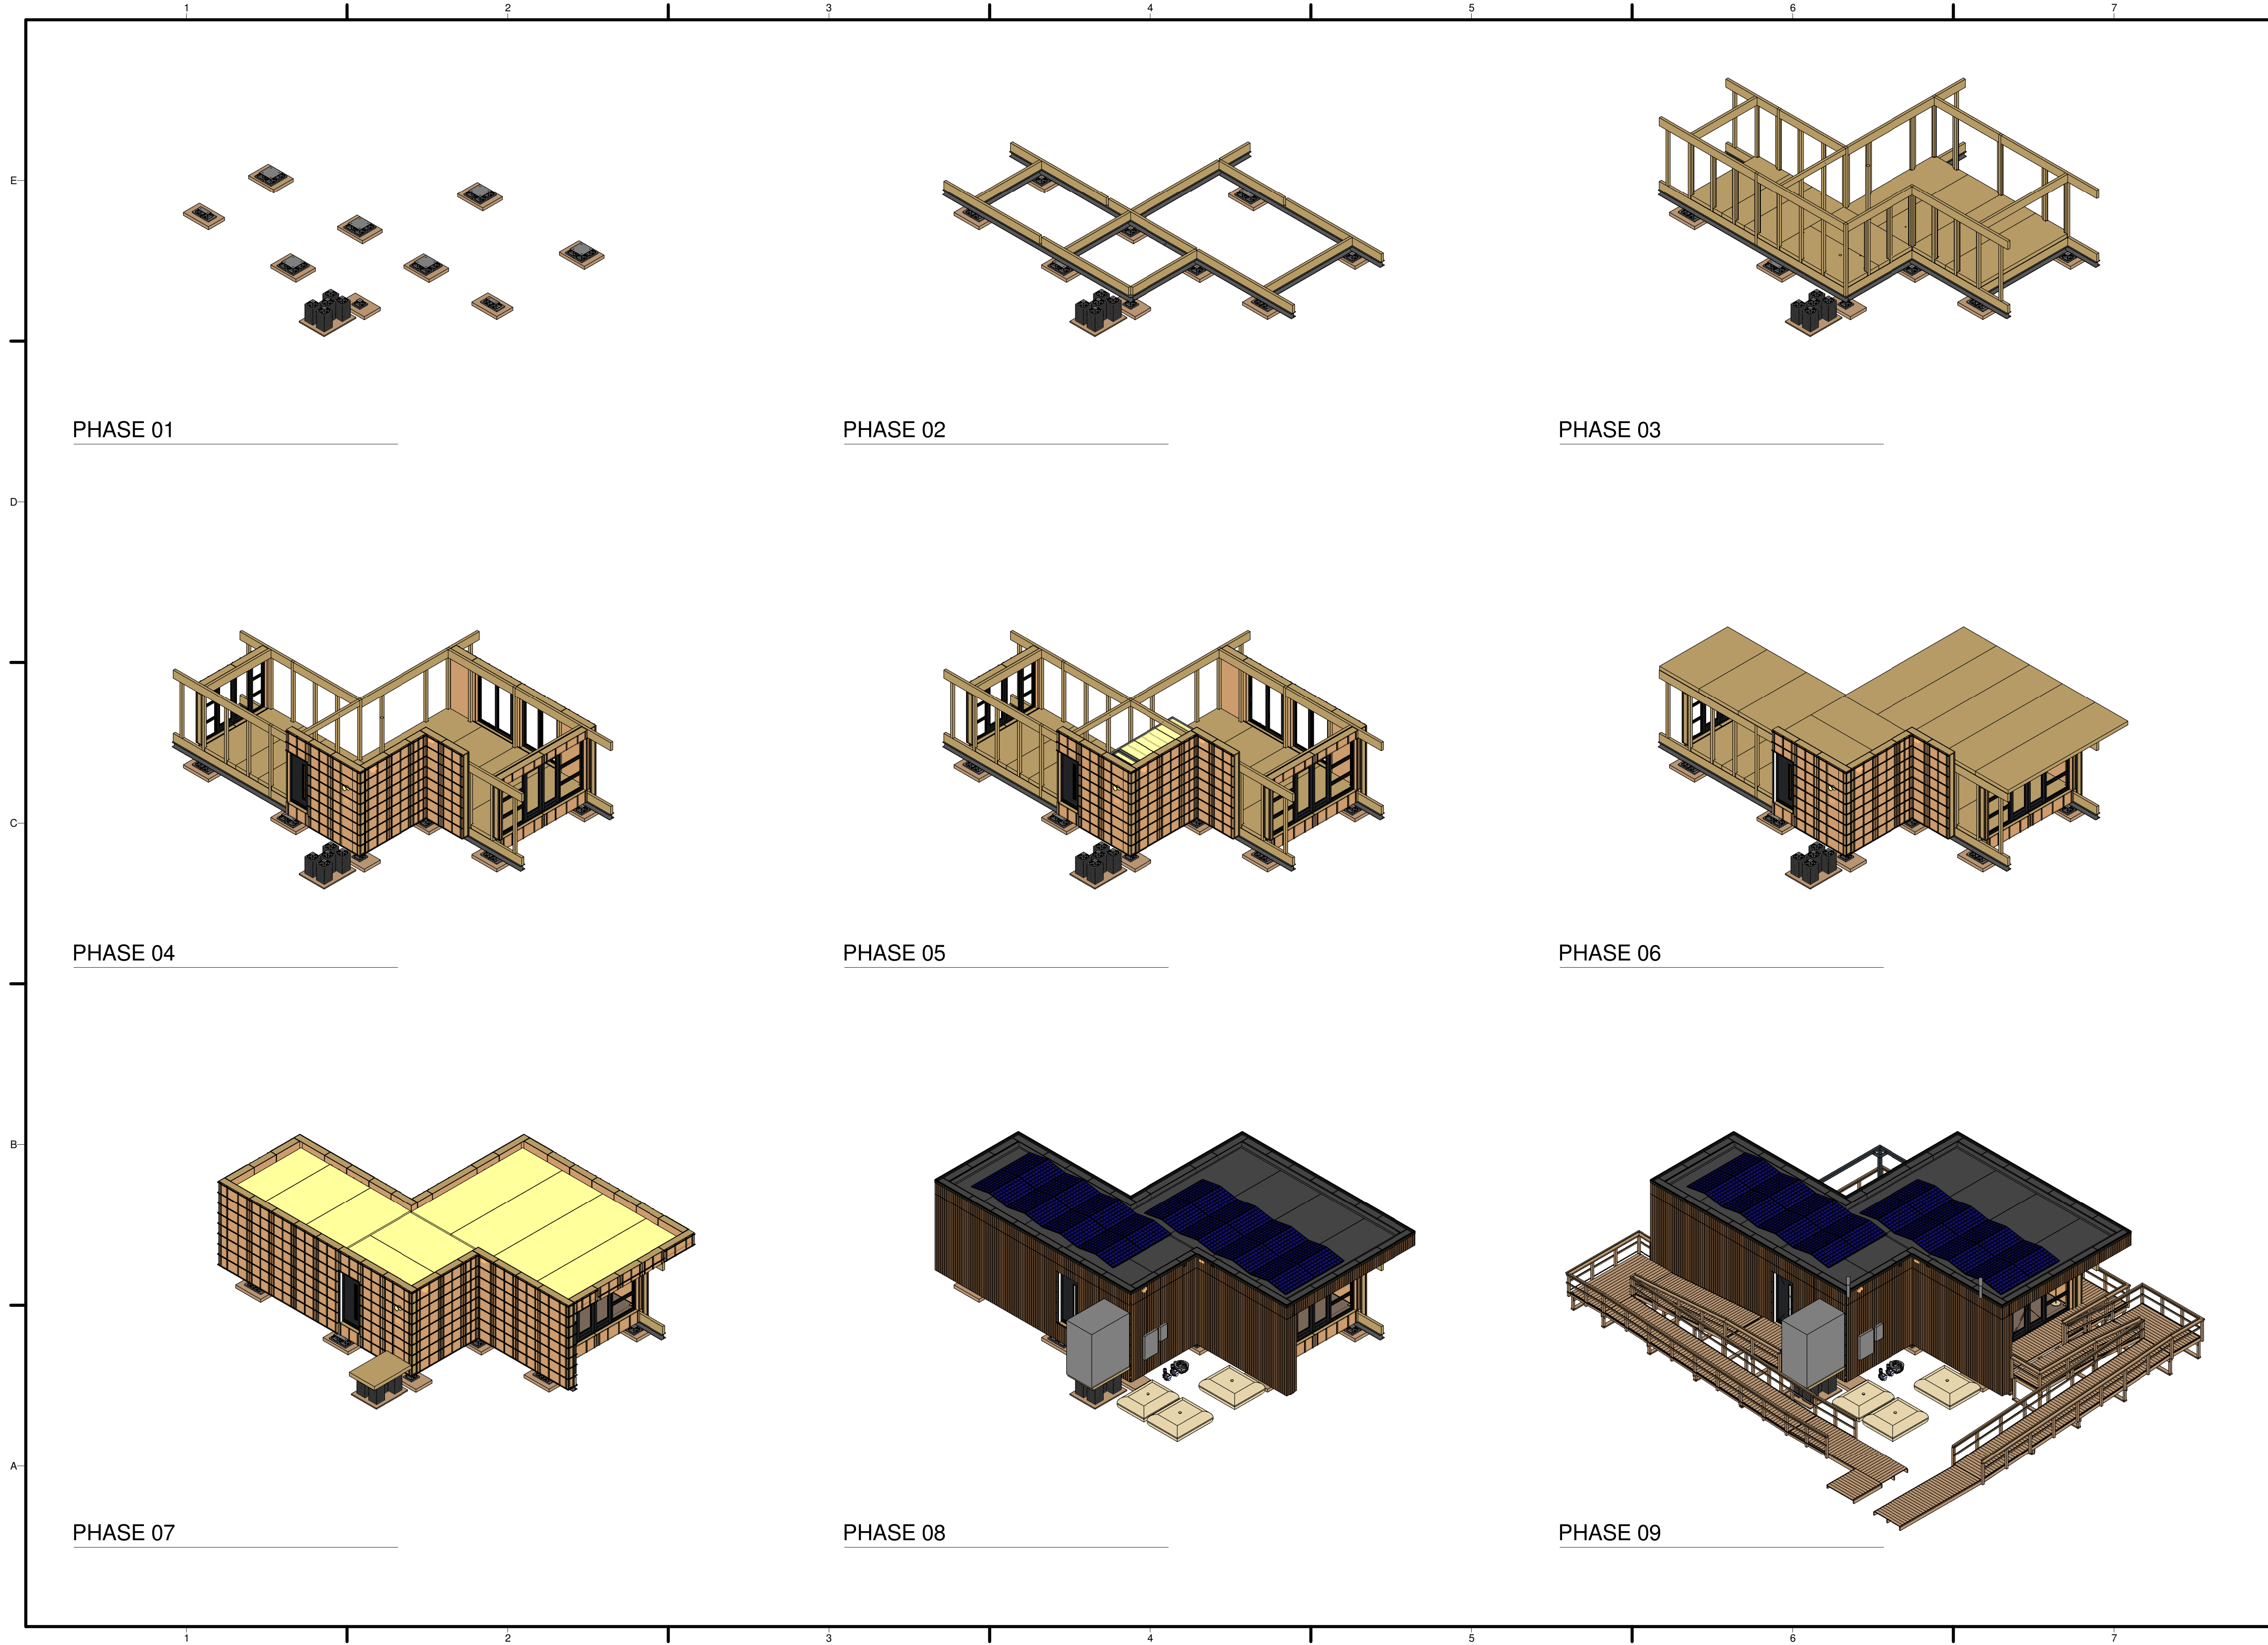

PHASE 01

PHASE 02

PHASE 03

PHASE 04

PHASE 05

PHASE 06

PHASE 07


PHASE 08

PHASE 09



TEAM NAME: Selficient
 ADDRESS: Padualaan 99
 3584 CH Utrecht
 CONTACT: info@selficient.org
 www.selficient.org

CONSULTANTS
 ARCHITECTURE
 ENGINEERS
 LANDSCAPING
 SAFETY FIRST CODE CONSULTANTS

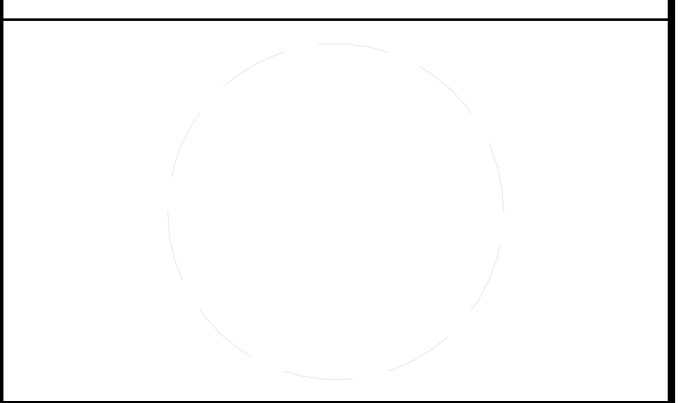

CLIENT
 U.S. DEPARTMENT OF ENERGY
 SOLAR DECATHLON 2017
 WWW.SOLARDECATHLON.GOV



0	17-11-2016	90% revision

MARK	DATE	DESCRIPTION

LOT NUMBER: 106
 DRAWN BY: SELFICIENT
 CHECKED BY: Selficient
 COPYRIGHT: NONE; PROJECT IS PUBLIC DOMAIN

SCALE:
 SHEET TITLE

OPERATIONS

O-100

APPENDIX E-201

Company

Solar Comfort



Onderdeel van de J.C. van Kessel Groep

Tielerweg 19c
4191 NE
Nederland

Contact Person:
Aart van Driel

Phone: 0623516175
E-Mail: Avandriel@solarcomfort.nl

Client

Hogeschool Utrecht

Contact Person:
Thijs Morel

Project


Address:
Denver, Colorado
Start of Operation Date: 12-10-2016
Project Description:



Decathlon 2017 Selficient

Grid connected PV System with Electrical Appliances

Climate Data	DENVER INTL AP (1991 - 2005)
PV Generator Output	9,6 kWp
PV Generator Surface	49,2 m ²
Number of PV Modules	30
Number of Inverters	2

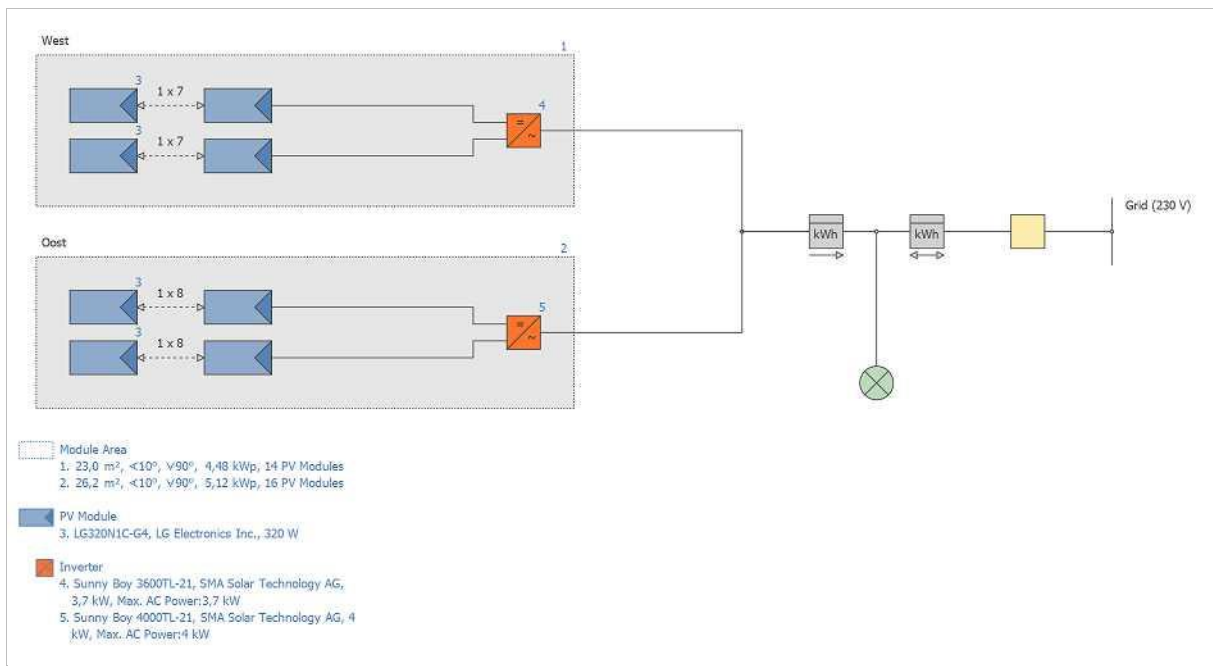

The yield

PV Generator Energy (AC grid)	14.185 kWh
Own Consumption (Average)	5.183 kWh
Grid Feed-in	9.002 kWh
Spec. Annual Yield	1.477,64 kWh/kWp
Performance Ratio (PR)	85,7 %
Own Power Consumption	36,5 %
CO ₂ Emissions avoided	8.511 kg / year

Your Gain

Total investment costs	0,00 €
Return on Assets	267,18 %
Amortization Period	0,0 Years
Electricity Production Costs	0 €/kWh

Customer Number: -
 Project Number: Selficient
 Date of Offer: 9-8-2017



Project Designer: Aart van Driel
 Company: Solar Comfort

Decathlon 2017 Selficient

Set-up of the system

Climate Data	DENVER INTL AP
Type of System	Grid connected PV System with Electrical Appliances

Consumption

Total Consumption	12636 kWh
Load Peak	1,4 kW

PV Generator 1. Module Area

Name	West
PV Modules*	14 x LG320N1C-G4
Manufacturer	LG Electronics Inc.
Inclination	10 °
Orientation	East 90 °
Installation Type	Mounted - Roof
PV Generator Surface	23,0 m ²
Shading	0 %

PV Generator 2. Module Area

Name	Oost
PV Modules*	16 x LG320N1C-G4
Manufacturer	LG Electronics Inc.
Inclination	10 °
Orientation	East 90 °
Installation Type	Roof parallel
PV Generator Surface	26,2 m ²
Shading	0 %

Inverter

1. Module Area	West
Inverter 1*	1 x Sunny Boy 3600TL-21
Manufacturer	SMA Solar Technology AG
Configuration	MPP 1: 1 x 7 MPP 2: 1 x 7

2. Module Area	Oost
Inverter 1*	1 x Sunny Boy 4000TL-21
Manufacturer	SMA Solar Technology AG
Configuration	MPP 1: 1 x 8 MPP 2: 1 x 8

AC Mains

Number of Phases	1
Mains Voltage (1-phase)	230 V
Displacement Power Factor (cos phi)	+/- 1

Decathlon 2017 Selficient

Simulation Results

PV System

PV Generator Output	9,6 kWp
Spec. Annual Yield	1.477,64 kWh/kWp
Performance Ratio (PR)	85,7 %

PV Generator Energy (AC grid)	14.185 kWh/year
Own Consumption	5.183 kWh/year
Grid Feed-in	9.002 kWh/year
Regulation at Feed-in Point	0 kWh/year

Own Power Consumption (Average)	36,5 %
CO ₂ Emissions avoided	8.511 kg / year

Appliances

Appliances	12.636 kWh/year
Stand-by Consumption	24 kWh/year
Total Consumption	12.660 kWh/year
covered by PV power	5.183 kWh/year
covered by grid	7.476 kWh/year

Solar Fraction	40,9 %
----------------	--------

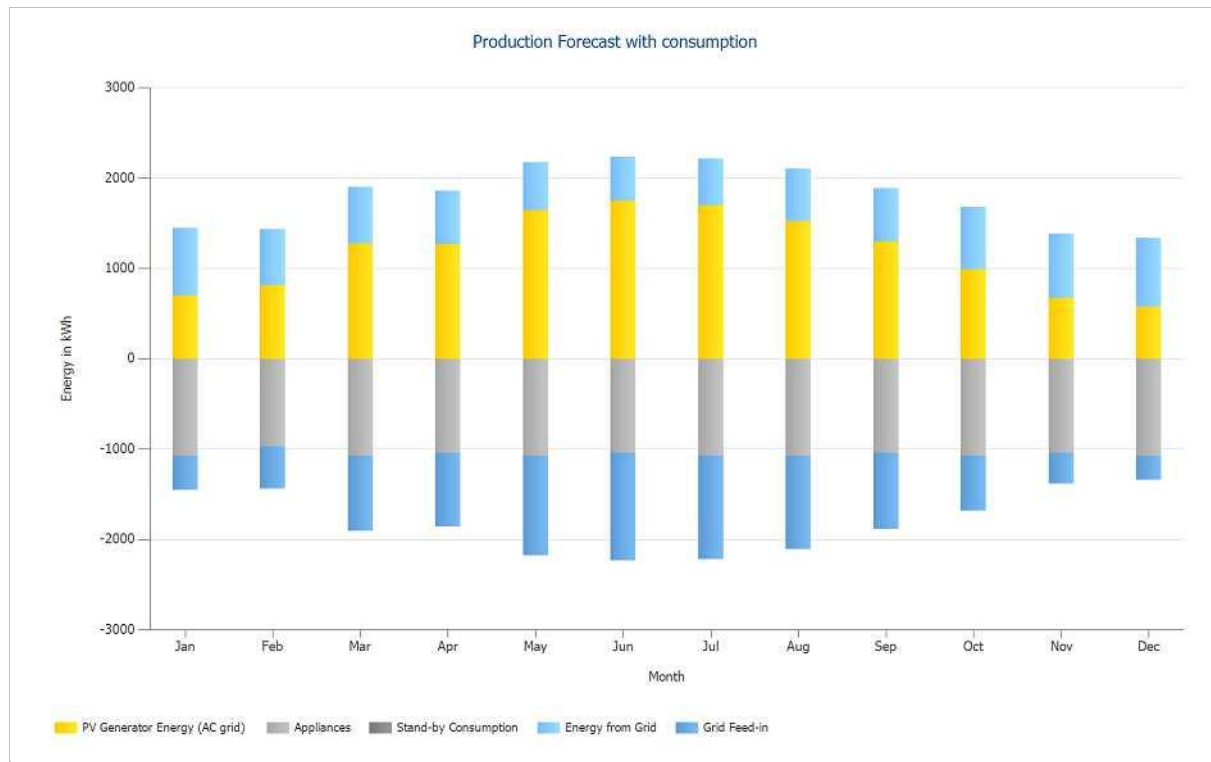


Figure: Production Forecast with consumption

Decathlon 2017 Selficient

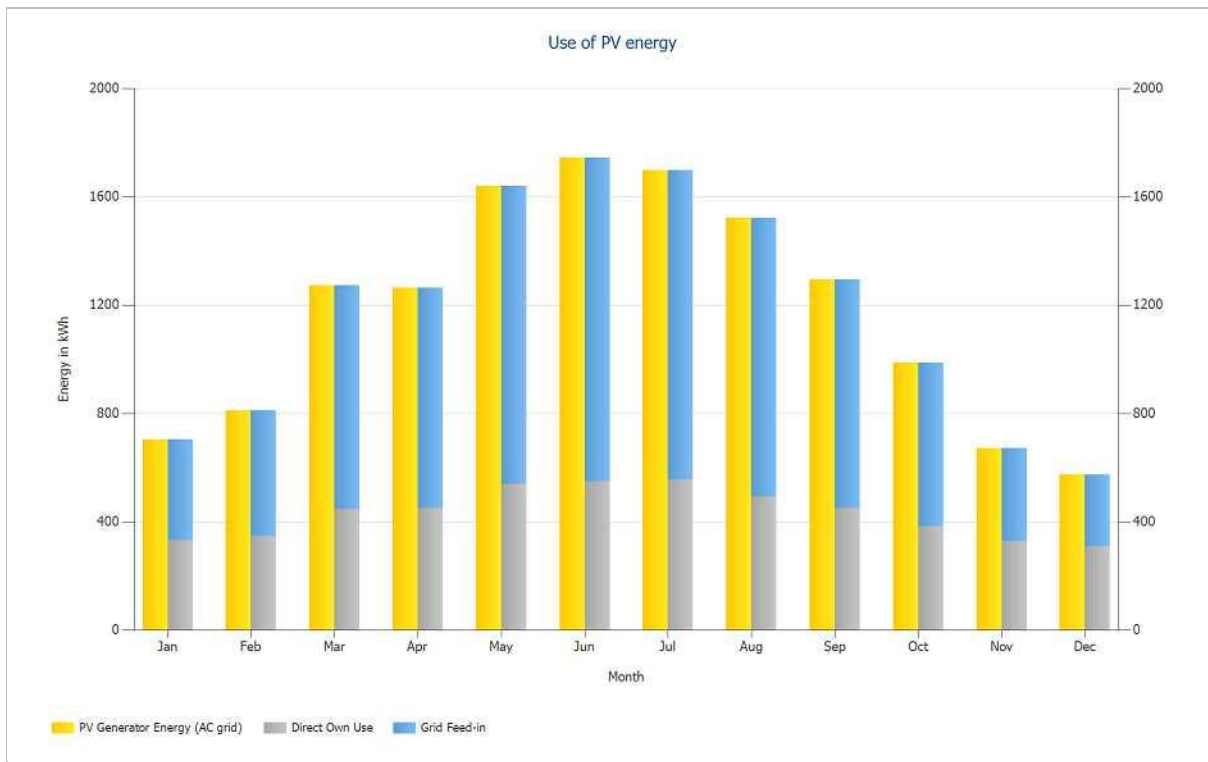


Figure: Use of PV energy

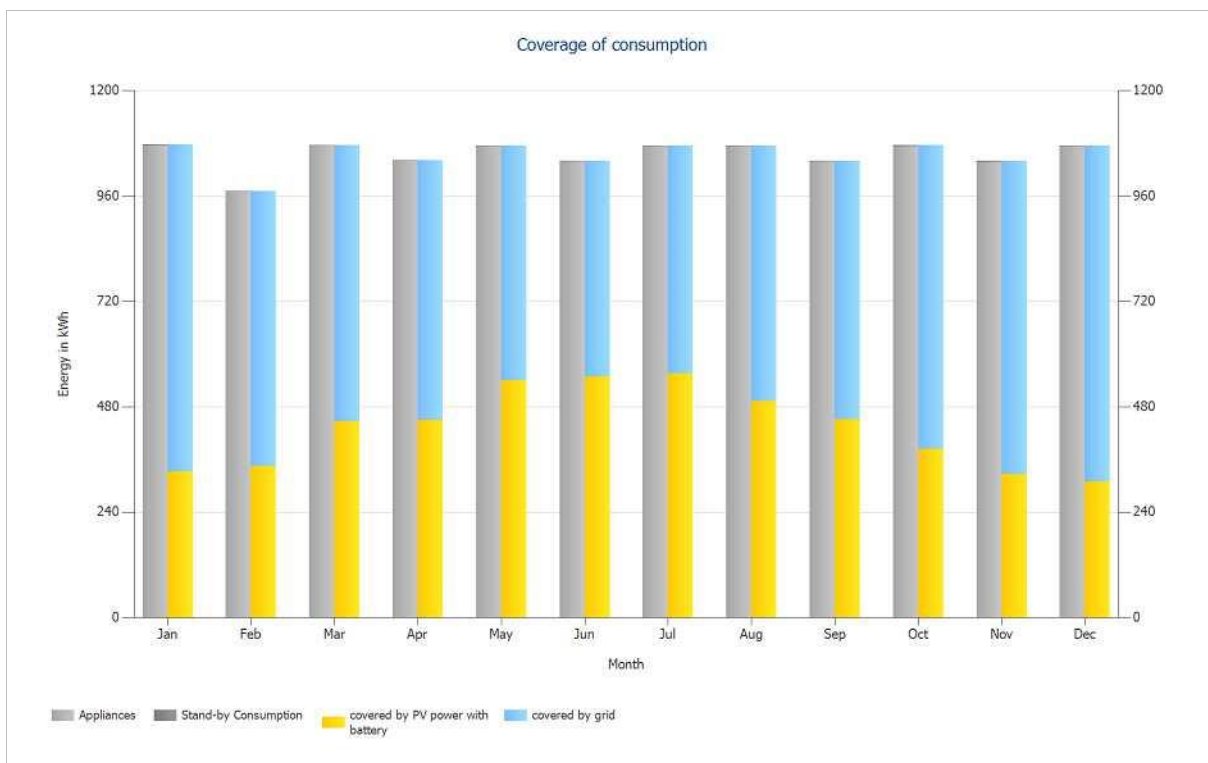


Figure: Coverage of consumption (in a normal situation)

Customer Number: -
Project Number: Selficient
Date of Offer: 9-8-2017



Project Designer: Aart van Driel
Company: Solar Comfort

Decathlon 2017 Selficient

Results per Module Area

West

PV Generator Output	4,48 kWp
PV Generator Surface	23,0 m ²
Global Radiation at the Module	1722,6 kWh/m ²
PV Generator Energy (AC grid)	6628,2 kWh/year
Spec. Annual Yield	1479,5 kWh/kWp
Performance Ratio (PR)	85,8 %

Oost

PV Generator Output	5,12 kWp
PV Generator Surface	26,2 m ²
Global Radiation at the Module	1722,6 kWh/m ²
PV Generator Energy (AC grid)	7557,4 kWh/year
Spec. Annual Yield	1476,1 kWh/kWp
Performance Ratio (PR)	85,6 %

Decathlon 2017 Selficient

PV System Energy Balance

Global radiation - horizontal	1.670,2 kWh/m²	
Deviation from standard spectrum	50,11 kWh/m ²	3,00 %
Ground Reflection (Albedo)	2,61 kWh/m ²	0,15 %
Orientation and inclination of the module surface	-0,34 kWh/m ²	-0,02 %
Shading	0,00 kWh/m ²	0,00 %
Reflection on the Module Interface	0,00 kWh/m ²	0,00 %
Global Radiation at the Module	1.722,6 kWh/m²	

$$\begin{aligned}
 & 1.722,6 \text{ kWh/m}^2 \\
 & \times 49,2 \text{ m}^2 \\
 & = 84.752,0 \text{ kWh}
 \end{aligned}$$

Global PV Radiation	84.752,0 kWh	
Soiling	0,00 kWh	0,00 %
STC Conversion (Rated Efficiency of Module 19,52 %)	-68.204,27 kWh	-80,48 %
Rated PV Energy	16.547,7 kWh	
Low-light performance	-164,73 kWh	-1,00 %
Deviation from the nominal module temperature	-659,36 kWh	-4,02 %
Diodes	-78,62 kWh	-0,50 %
Mismatch (Manufacturer Information)	-312,90 kWh	-2,00 %
Mismatch (Configuration/Shading)	0,00 kWh	0,00 %
PV Energy (DC) without inverter regulation	15.332,1 kWh	
Regulation on account of the MPP Voltage Range	0,00 kWh	0,00 %
Regulation on account of the max. DC Current	0,00 kWh	0,00 %
Regulation on account of the max. DC Power	0,00 kWh	0,00 %
Regulation on account of the max. AC Power/cos phi	-52,37 kWh	-0,34 %
MPP Matching	-180,45 kWh	-1,18 %
PV energy (DC)	15.099,3 kWh	

Energy at the Inverter Input	15.099,3 kWh	
Input voltage deviates from rated voltage	-237,10 kWh	-1,57 %
DC/AC Conversion	-533,56 kWh	-3,59 %
Stand-by Consumption	-23,60 kWh	-0,16 %
Total Cable Losses	-143,05 kWh	-1,00 %
PV energy (AC) minus standby use	14.162,0 kWh	
PV Generator Energy (AC grid)	14.185,3 kWh	

Decathlon 2017 Selficient

Cashflow Table

	year 1	year 2	year 3	year 4	year 5
Electricity Savings	€ 532,48	€ 512,22	€ 494,54	€ 479,03	€ 465,36
Annual Cash Flow	€ 532,48	€ 512,22	€ 494,54	€ 479,03	€ 465,36
Accrued Cash Flow (Cash Balance)	€ 532,48	€ 1.044,70	€ 1.539,25	€ 2.018,28	€ 2.483,64
	year 6	year 7	year 8	year 9	year 10
Electricity Savings	€ 453,24	€ 442,42	€ 432,72	€ 423,95	€ 415,99
Annual Cash Flow	€ 453,24	€ 442,42	€ 432,72	€ 423,95	€ 415,99
Accrued Cash Flow (Cash Balance)	€ 2.936,87	€ 3.379,30	€ 3.812,02	€ 4.235,97	€ 4.651,96
	year 11	year 12	year 13	year 14	year 15
Electricity Savings	€ 408,69	€ 401,98	€ 395,75	€ 389,94	€ 384,49
Annual Cash Flow	€ 408,69	€ 401,98	€ 395,75	€ 389,94	€ 384,49
Accrued Cash Flow (Cash Balance)	€ 5.060,65	€ 5.462,63	€ 5.858,38	€ 6.248,32	€ 6.632,81
	year 16	year 17	year 18	year 19	year 20
Electricity Savings	€ 379,34	€ 374,46	€ 369,80	€ 365,34	€ 361,05
Annual Cash Flow	€ 379,34	€ 374,46	€ 369,80	€ 365,34	€ 361,05
Accrued Cash Flow (Cash Balance)	€ 7.012,15	€ 7.386,61	€ 7.756,41	€ 8.121,75	€ 8.482,80
	year 21				
Electricity Savings	€ 356,91				
Annual Cash Flow	€ 356,91				
Accrued Cash Flow (Cash Balance)	€ 8.839,72				

Degradation and inflation rates are applied on a monthly basis over the entire observation period.
 This is done in the first year.

Decathlon 2017 Selficient

PV Module: LG320N1C-G4

Manufacturer	LG Electronics Inc.
Available	Yes

Electrical Data

Cell Type	Si monocrystalline
Only Transformer Inverters suitable	No
Number of Cells	60
Number of Bypass Diodes	3

Mechanical Data

Width	1000 mm
Height	1640 mm
Depth	40 mm
Frame Width	10 mm
Weight	17 kg
Framed	No

I/V Characteristics at STC

MPP Voltage	33,6 V
MPP Current	9,53 A
Nominal output	320 W
Open Circuit Voltage	40,9 V
Short-Circuit Current	10,05 A
Increase open circuit voltage before stabilisation	0 %

I/V Part Load Characteristics

Values source	Manufacturer/user-created
Irradiance	200 W/m ²
Voltage in MPP at Part Load	32,5 V
Current in MPP at Part Load	1,94 A
Open Circuit Voltage (Part Load)	37,9 V
Short Circuit Current at Part Load	2,05 A

Further

Voltage Coefficient	-114,52 mV/K
Electricity Coefficient	3,02 mA/K
Output Coefficient	-0,37 %/K
Incident Angle Modifier	100 %
Maximum System Voltage	1000 V
Spec. Heat Capacity	920 J/(kg*K)
Absorption Coefficient	70 %
Emissions Coefficient	85 %

Customer Number: -
Project Number: Selficient
Date of Offer: 9-8-2017



Project Designer: Aart van Driel
Company: Solar Comfort

Decathlon 2017 Selficient

Inverter: Sunny Boy 3600TL-21 (Conext MPPT 80 600)

Manufacturer	SMA Solar Technology AG
Available	Yes
Electrical Data	
DC Power Rating	3,88 kW
AC Power Rating	3,68 kW
Max. DC Power	3,88 kW
Max. AC Power	3,68 kW
Stand-by Consumption	10 W
Night Consumption	1 W
Feed-in from	32 W
Max. Input Current	30 A
Max. Input Voltage	750 V
Nom. DC Voltage	400 V
Number of Feed-in Phases	1
Number of DC Inlets	4
With Transformer	No
Change in Efficiency when Input Voltage deviates from Rated Voltage	0,99 %/100V
MPP Tracker	
Output Range < 20% of Power Rating	97 %
Output Range > 20% of Power Rating	98,9 %
No. of MPP Trackers	2
Max. Input Current per MPP Tracker	15 A
Max. Input Power per MPP Tracker	3,68 kW
Min. MPP Voltage	125 V
Max. MPP Voltage	500 V

Customer Number: -
Project Number: Selficient
Date of Offer: 9-8-2017



Project Designer: Aart van Driel
Company: Solar Comfort

Decathlon 2017 Selficient

Inverter: Sunny Boy 4000TL-21 (Conext MPPT 80 600)

Manufacturer SMA Solar Technology AG
Available Yes

Electrical Data

DC Power Rating	4,2 kW
AC Power Rating	4 kW
Max. DC Power	4,2 kW
Max. AC Power	4 kW
Stand-by Consumption	10 W
Night Consumption	1 W
Feed-in from	32 W
Max. Input Current	30 A
Max. Input Voltage	750 V
Nom. DC Voltage	400 V
Number of Feed-in Phases	1
Number of DC Inlets	4
With Transformer	No
Change in Efficiency when Input Voltage deviates from Rated Voltage	0,99 %/100V

MPP Tracker


Output Range < 20% of Power Rating	97 %
Output Range > 20% of Power Rating	98,9 %
No. of MPP Trackers	2
Max. Input Current per MPP Tracker	15 A
Max. Input Power per MPP Tracker	4,2 kW
Min. MPP Voltage	125 V
Max. MPP Voltage	500 V

Customer Number: -
Project Number: Selficient
Date of Offer: 9-8-2017



Project Designer: Aart van Driel
Company: Solar Comfort

Decathlon 2017 Selficient

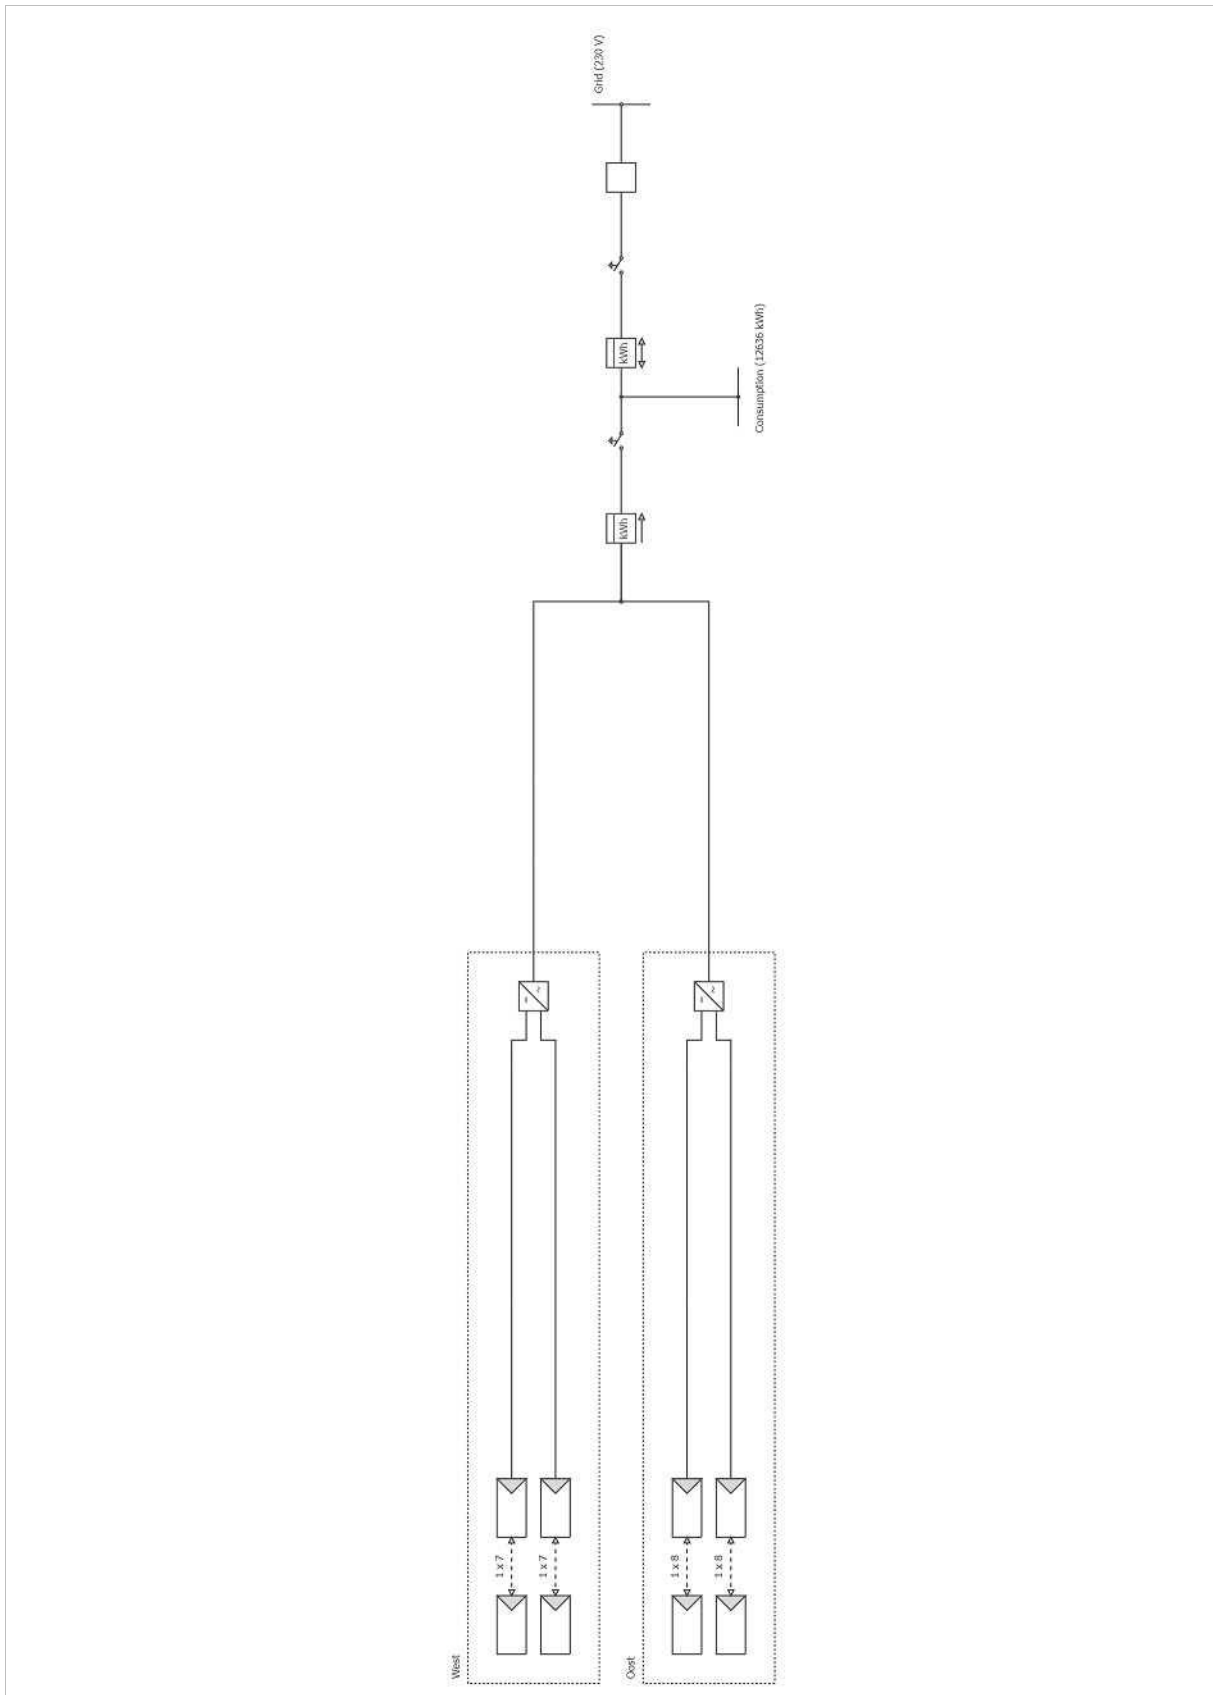

APPENDIX E-500

RF Action list						Dimming actor				
						Z04	Z07	Z05	Z06	Z02
						Switch 01	Switch 02	Switch 03	Switch 04	Switch 05
Description	Groupaddress switch/movement	Groupaddress dim/step	Groupaddress val/height	Logic Adress	1.1.20 channel 1	1.1.20 channel 2	1.1.20 channel 3	1.1.20 channel 4	1.1.21 channel 1	
1 Multi touch pro 1.1.1 (Scenes)	7/0/2			1.1.62						
2 Multi touch pro 1.1.2 (Scenes)	7/0/3			1.1.62						
3 Multi touch pro 1.1.3 (Scenes)	7/0/4			1.1.62						
4 Multi touch pro 1.1.4 (Scenes)	7/0/5			1.1.62						
5 Multi touch pro 1.2.1 (Ceiling light)	0/0/7		0/3/6	1.1.62		Switch on/off				
6 Multi touch pro 1.3.1 (LED strip)	4/0/1		4/2/1	1.1.62						
7 Multi touch pro 1.4.1 (Blinds)			3/1/0	1.1.62						
8 Multi touch pro 1.5.1 (Heating/cooling)				1.1.62						
9 Multi touch pro 1.6.1 (Bed left)			0/3/4	1.1.62			Switch on/off			
10 Multi touch pro 1.6.2 (Bed right)			0/3/5	1.1.62				Switch on/off		
11 Multi touch pro 1.7.1 (Energy usage)			4/6/0	1.1.62						
12 Multi touch pro 1.7.2 (CO2 value)			6/1/0	1.1.62						
13 Multi touch pro 1.8.1 (Settings)				1.1.62						
14 Multi touch pro 2.1.1 (Scenes)	7/1/0			1.1.63						
15 Multi touch pro 2.1.2 (Scenes)	7/1/1			1.1.63						
16 Multi touch pro 2.1.3 (Scenes)	7/1/2			1.1.63						
17 Multi touch pro 2.1.4 (Scenes)	7/1/2			1.1.63						
18 Multi touch pro 2.2.1 (Lamp corner SW)			0/3/10	1.1.63						
19 Multi touch pro 2.2.2 (Lamp dinner table)			0/3/11	1.1.63						
20 Multi touch pro 2.3.1 (Ceiling light)			0/3/8	1.1.63						
21 Multi touch pro 2.3.2 (Kitchen spots)			0/3/12	1.1.63						
22 Multi touch pro 2.4.1 (LED strip)	4/0/2		4/2/2	1.1.63						
23 Multi touch pro 2.5.1 (blinds)			3/1/2	1.1.63						
24 Multi touch pro 2.5.2 (blinds)			3/1/4	1.1.63						
25 Multi touch pro 2.6.1 (Heating/cooling)				1.1.63						
26 Multi touch pro 2.7.1 (Settings)				1.1.63						
27 Multi touch pro 3.1.1 (Scenes)	7/2/0			1.1.64						
28 Multi touch pro 3.1.2 (Scenes)	7/2/1			1.1.64						
29 Multi touch pro 3.1.3 (Scenes)	7/2/2			1.1.64						
30 Multi touch pro 3.1.4 (Scenes)	7/2/3			1.1.64						
31 Multi touch pro 3.2.1 (Spots)	0/0/2		0/3/1	1.1.64					Switch on/off	
32 Multi touch pro 3.3.1 (LED strip)	4/0/0		4/2/0	1.1.64						
33 Multi touch pro 3.4.1 (Settings)				1.1.64						
34 Push button pro 1.1 (Scene wake up)	7/0/0			1.1.60		Switch on				
35 Push button pro 1.2 (Blind down/up)	7/0/6			1.1.60		Switch off				
36 Push button pro 1.3 (Lamp bed left)	0/0/5		0/2/4	1.1.60			Switch on			
37 Push button pro 1.4 (Lamp bed left)	0/0/5		0/2/4	1.1.60			Switch off			
38 Push button pro 2.1 (Lamp bed right)	0/0/6		0/2/5	1.1.61				Switch on		
39 Push button pro 2.2 (Lamp bed right)	0/0/6		0/2/5	1.1.61				Switch off		
40 Push button pro 2.3 (Scene wake up)	7/0/1			1.1.61		Switch on				
41 Push button pro 2.4 (Blind down/up)	7/0/7			1.1.61		Switch off				
42 PIR Hallway	0/0/4			1.1.1	Switch on					
43 Combisensor (wind)				1.1.44						
44 Combisensor (rain)				1.1.44						
45 Combisensor (twilight)				1.1.44						
46 Combisensor (sun east)				1.1.44						
47 Combisensor (sun south)				1.1.44						
48 Combisensor (sun west)				1.1.44						
49 Combisensor (all up)				1.1.44						

