


NOTE: SEE STRUCTURAL DWGS FOR MORE COMPLETE INFORMATION ON FOUNDATION SUPPORTS

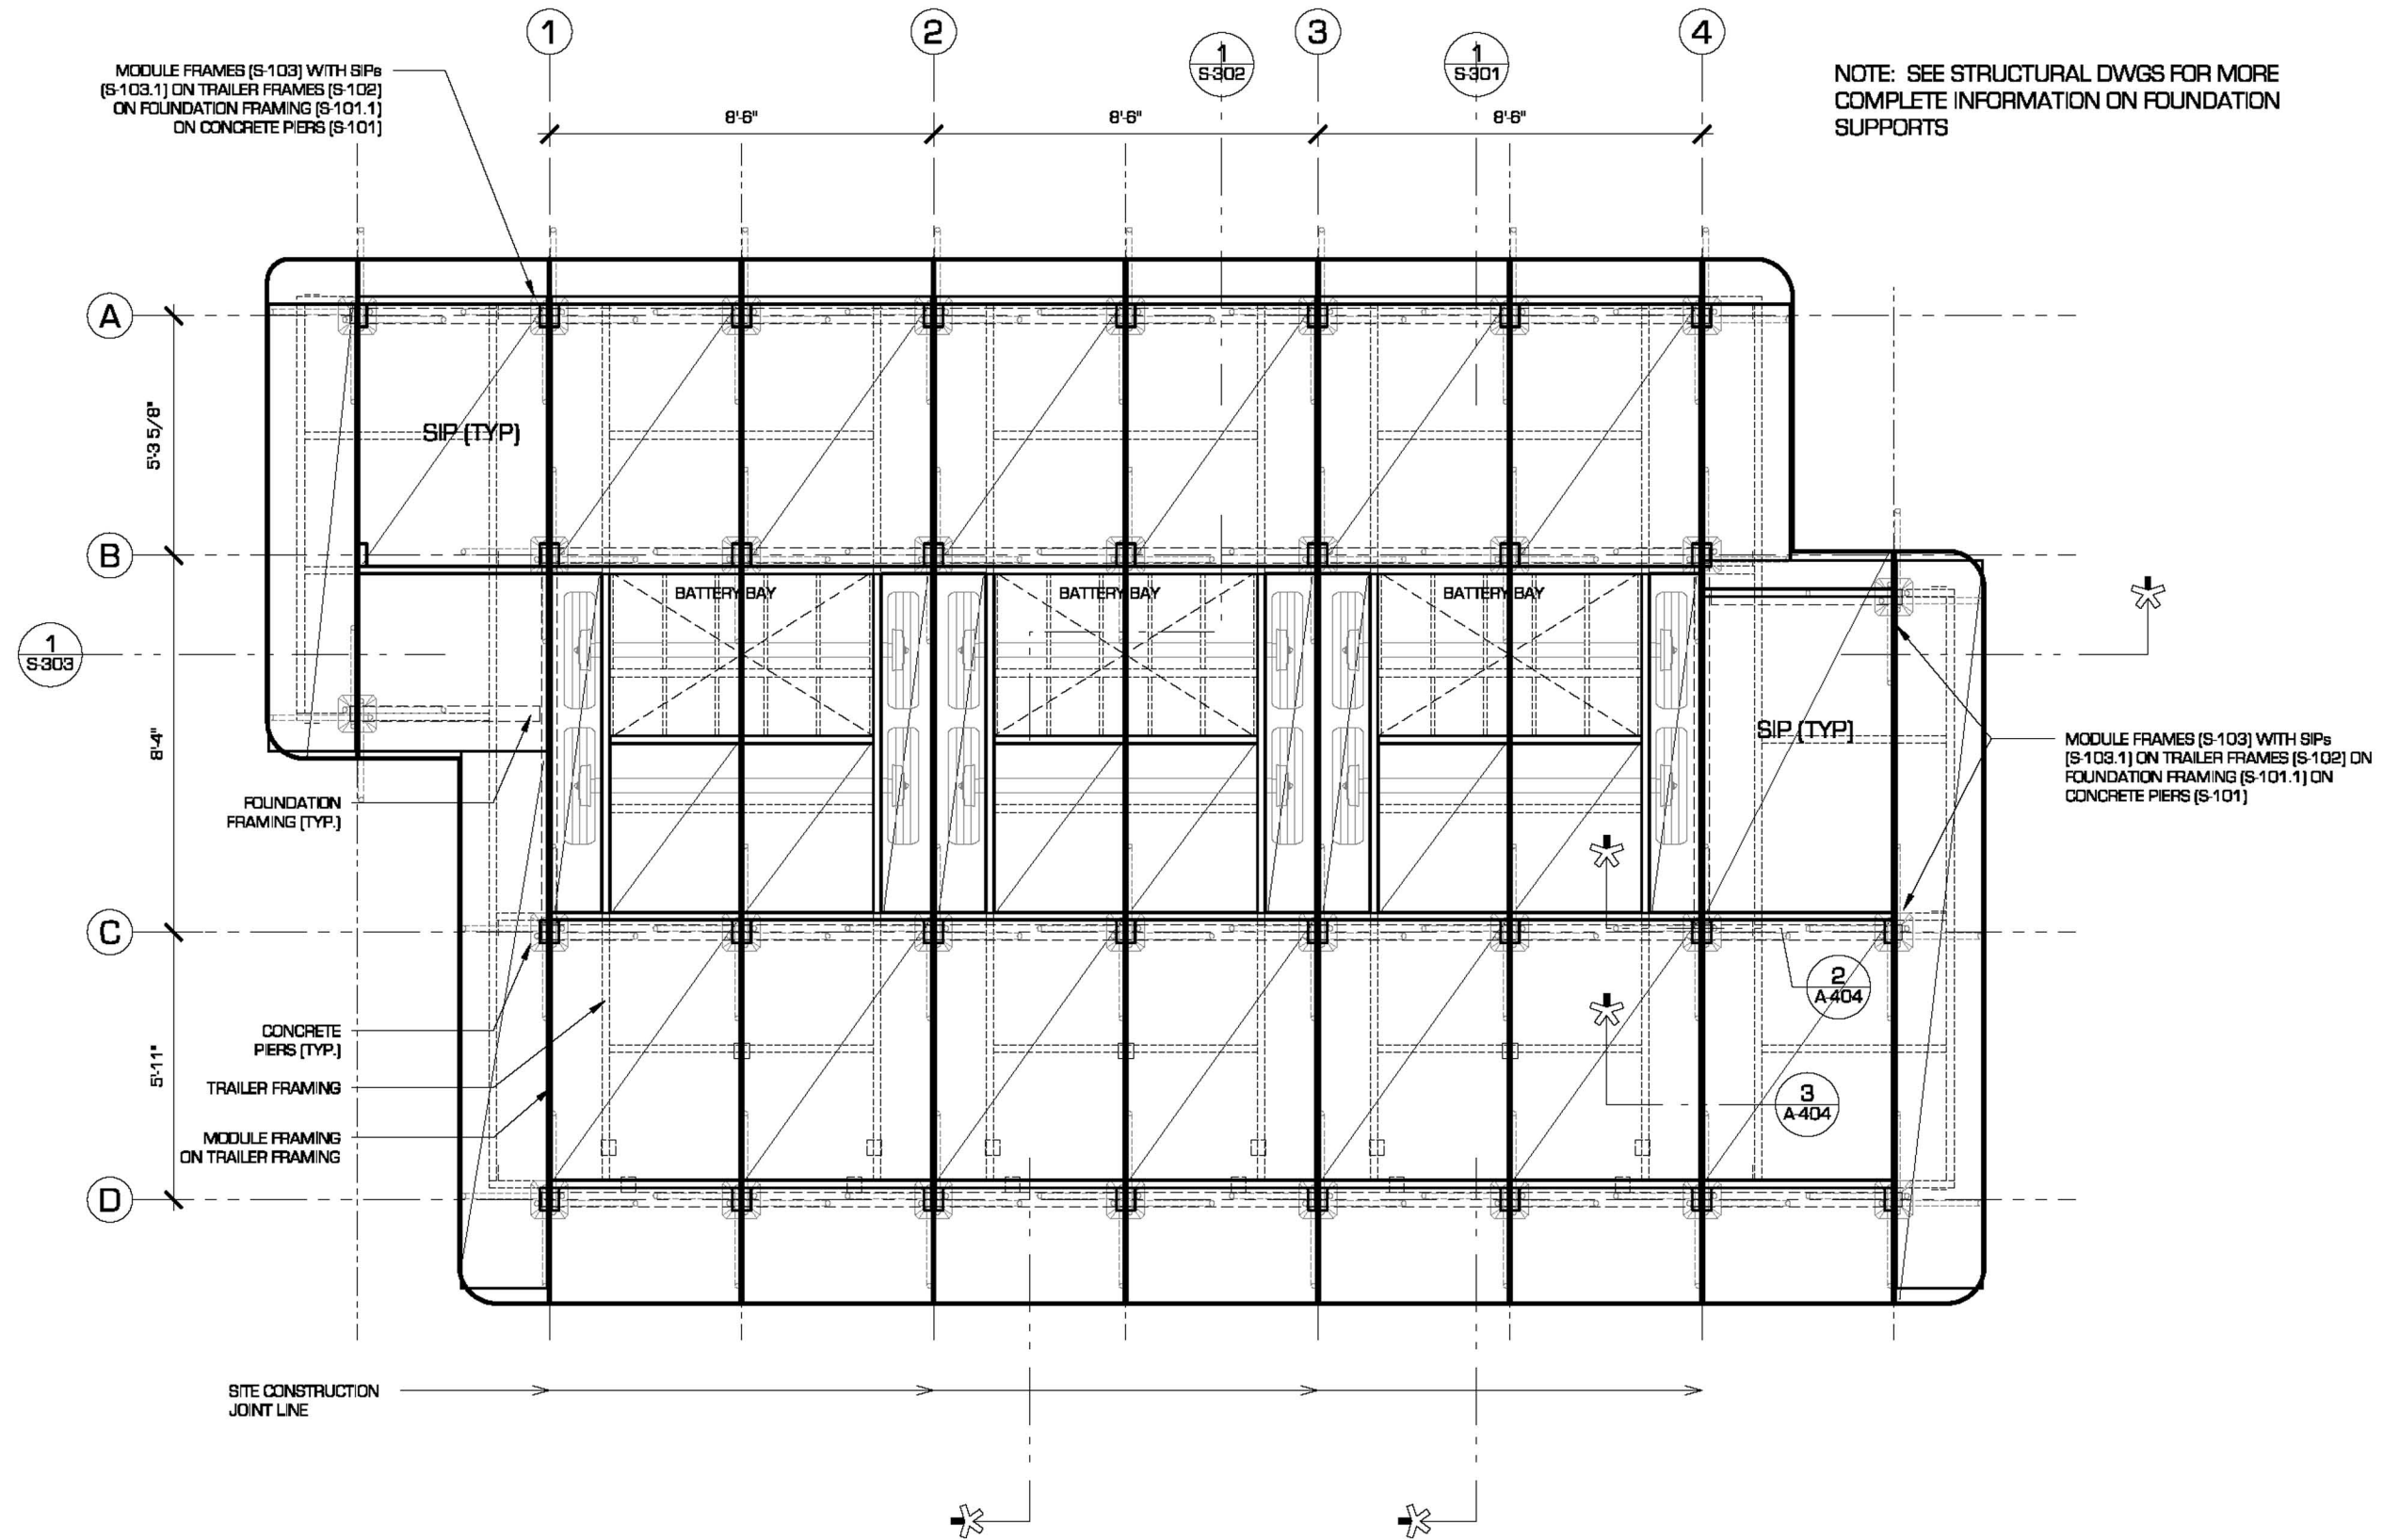

A-001 FOUNDATIONS PLAN

SCALE: 1/4" = 1'-0"



Design Drawings +
Submittals
June 15, 2004

Drawing Submittals
90% Completion
February 8, 2005

Interim Submittals
95% Completion
May 2, 2005

Final Submittals
As-Built Drawings
August 9, 2005

A-001