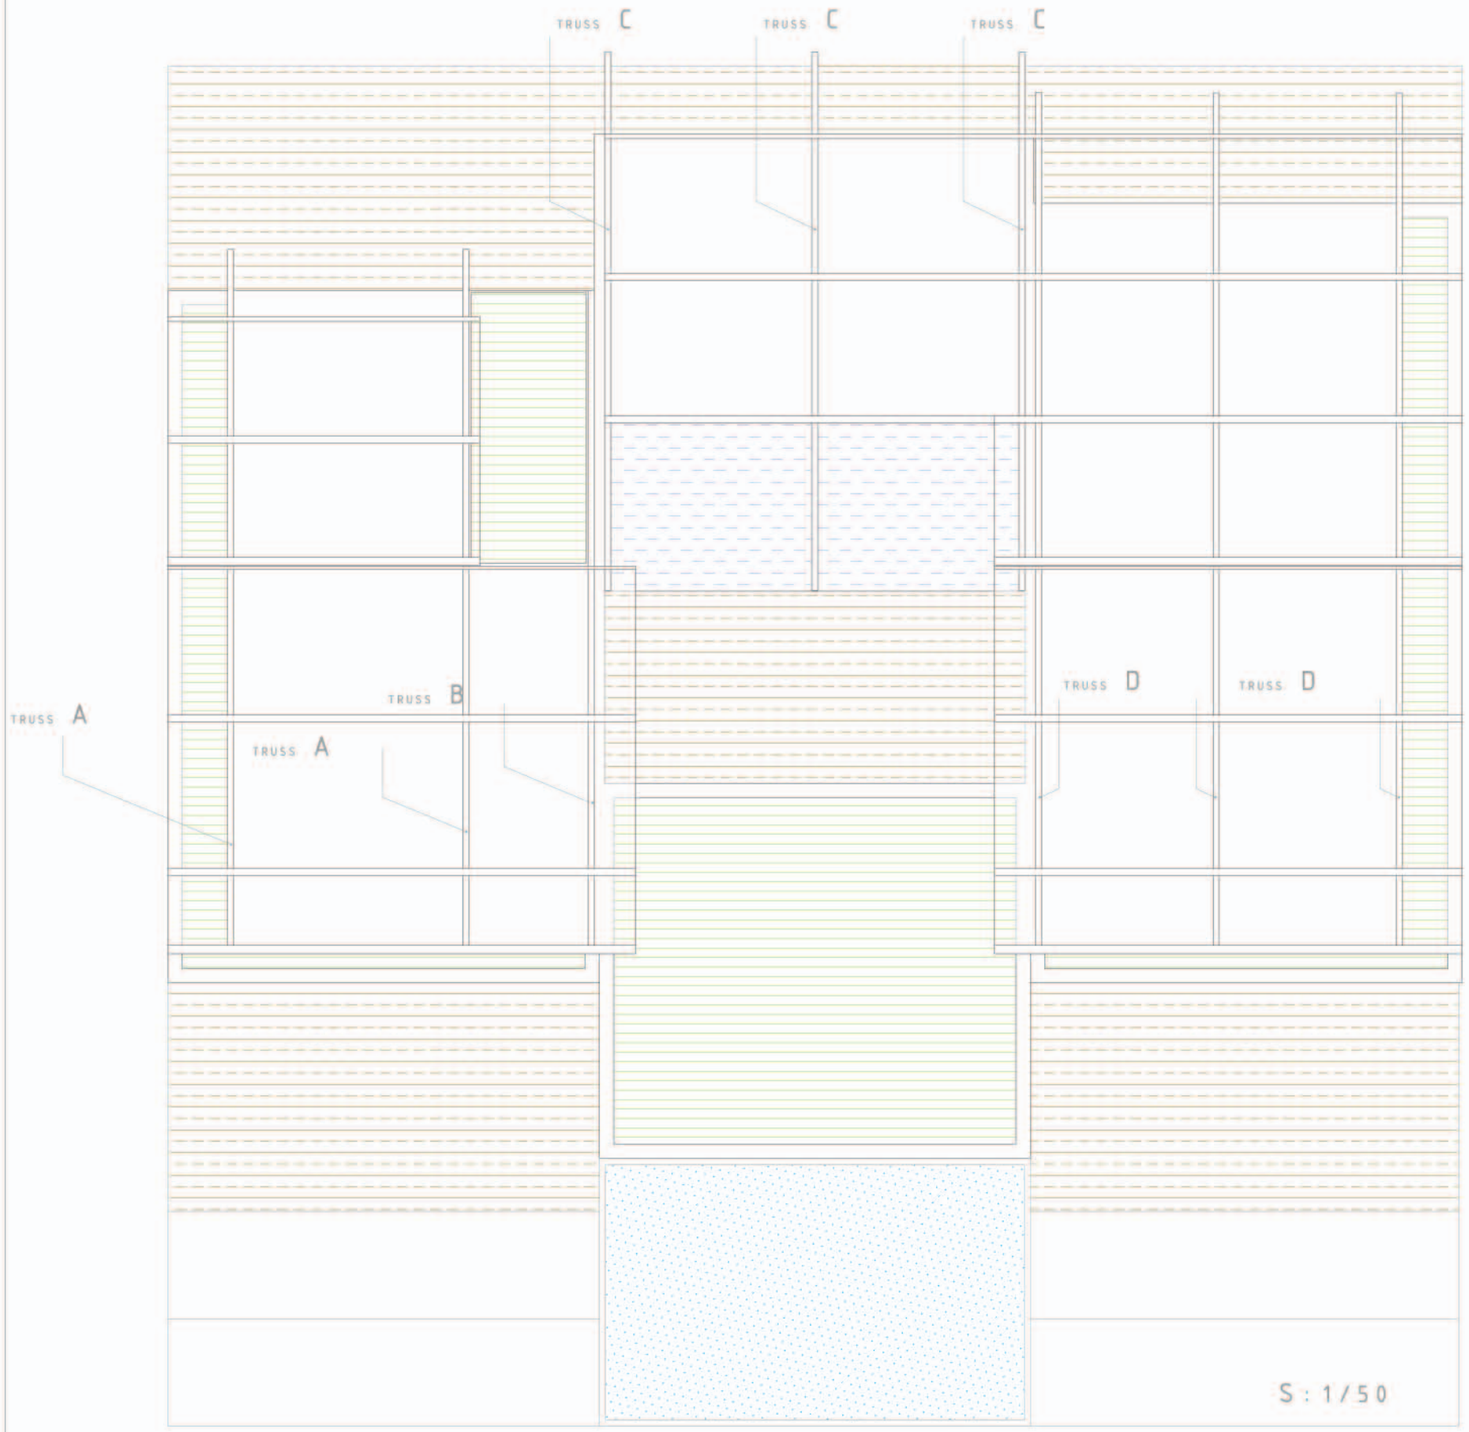

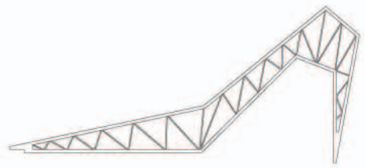

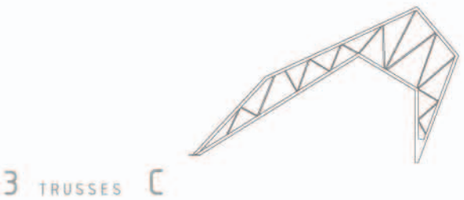

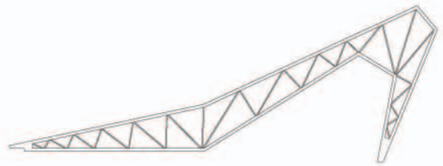

S : 1/100

FLOOR
GREEN ROOF
WATER SURFACE
SOLAR COLLECTORS

2005 UPM madrid

S-21

DATE: 08.04.2005

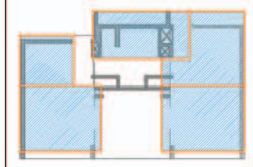

SCALE_1:50

0 0.5 1m

0 1 2 3ft

1:50

S-21 01/7

ROOF FRAMING

COORDINATORS SUPERVISORS DECATHLETES

LUIS CLIMENT
plan designer

CARLOS BERMEJO
design coordinator

MIGUEL GOMEZ
general coordinator

JOE WORCESTER
professional engineer

ESTEFANIA CAAMAÑO
general coordinator

JAVIER NEILA
architecture manager

ALFONSO GARCIA-SANTOS
construction manager

magic BOX
unfolding under the sun

Universidad Politécnica de Madrid (UPM)