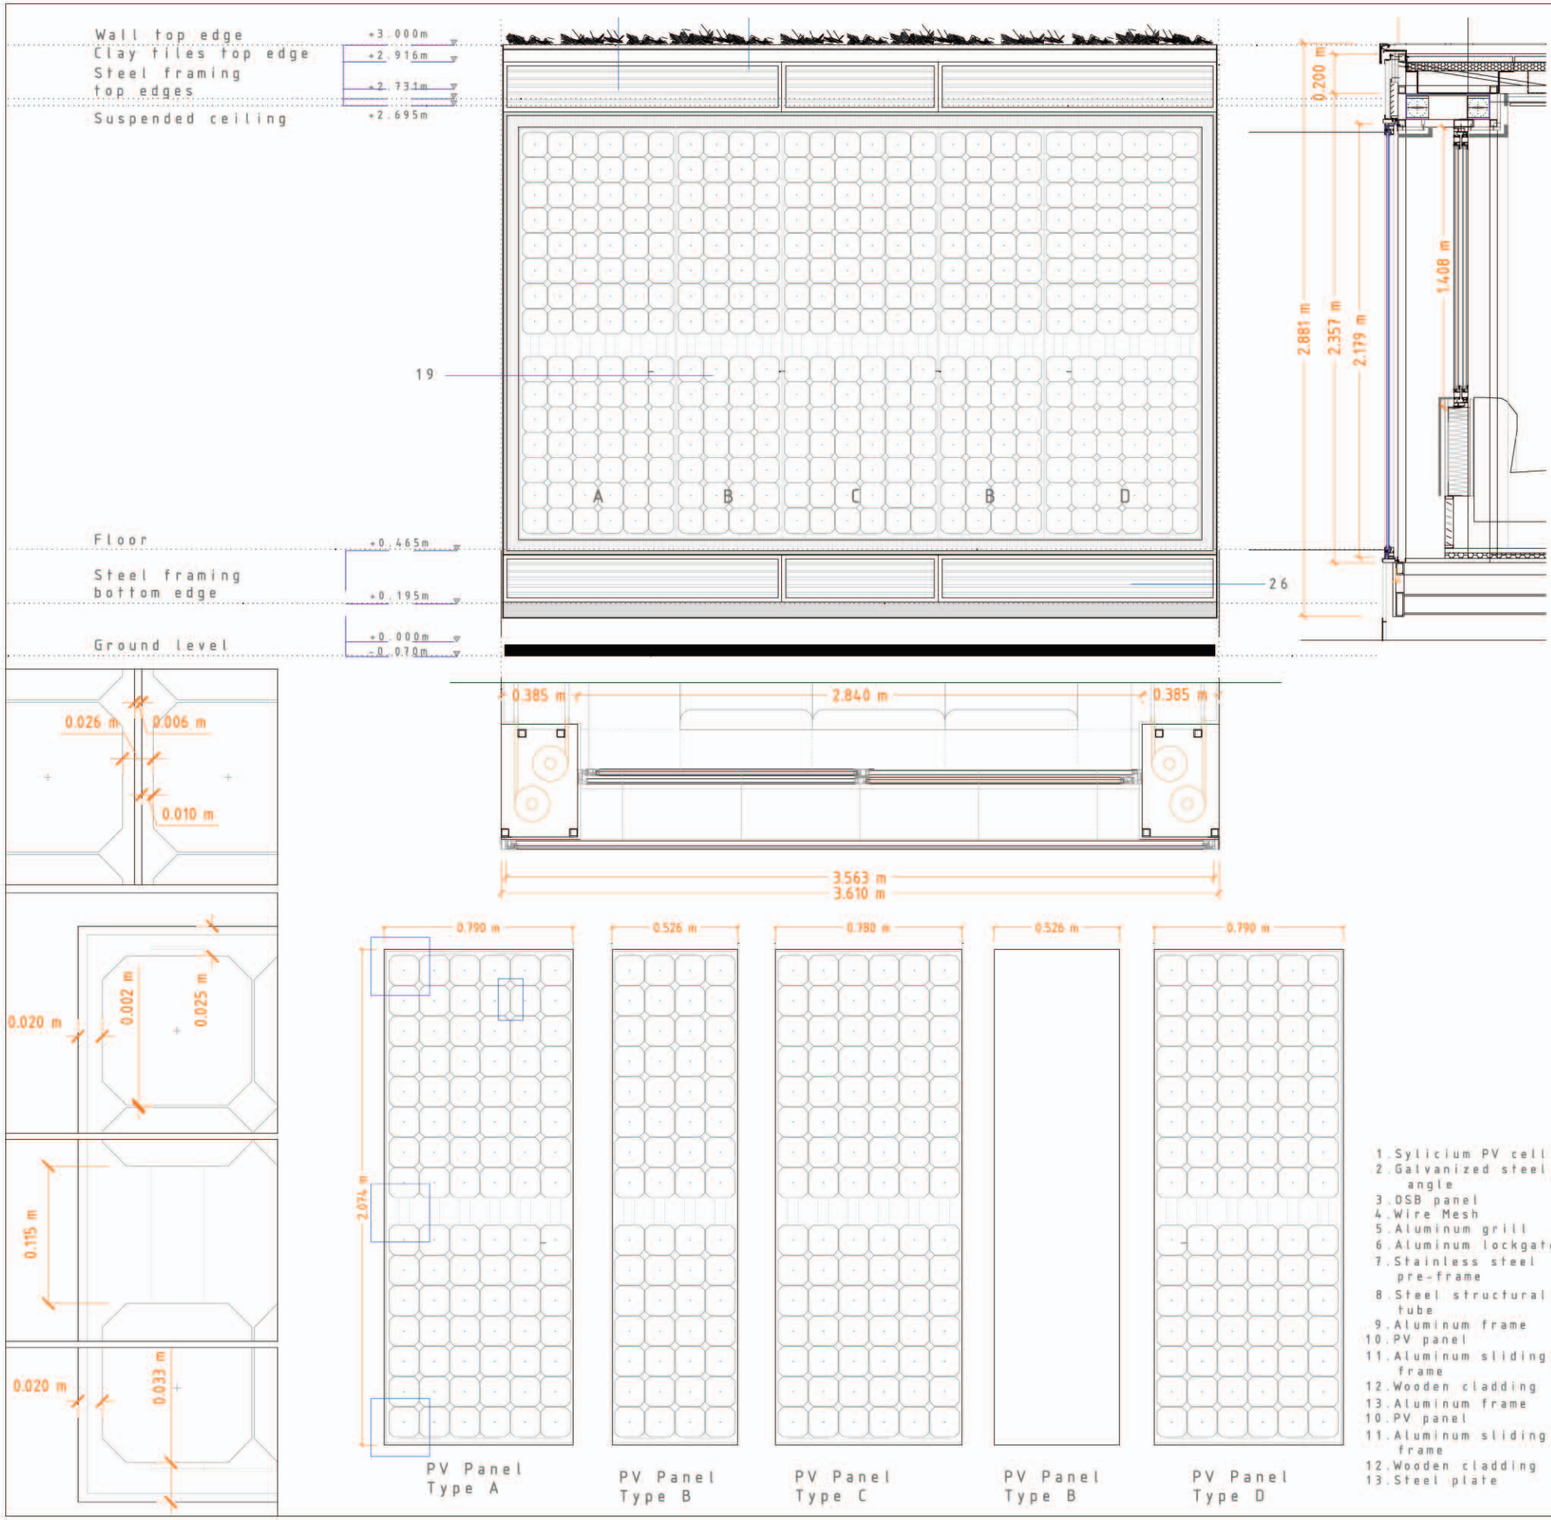


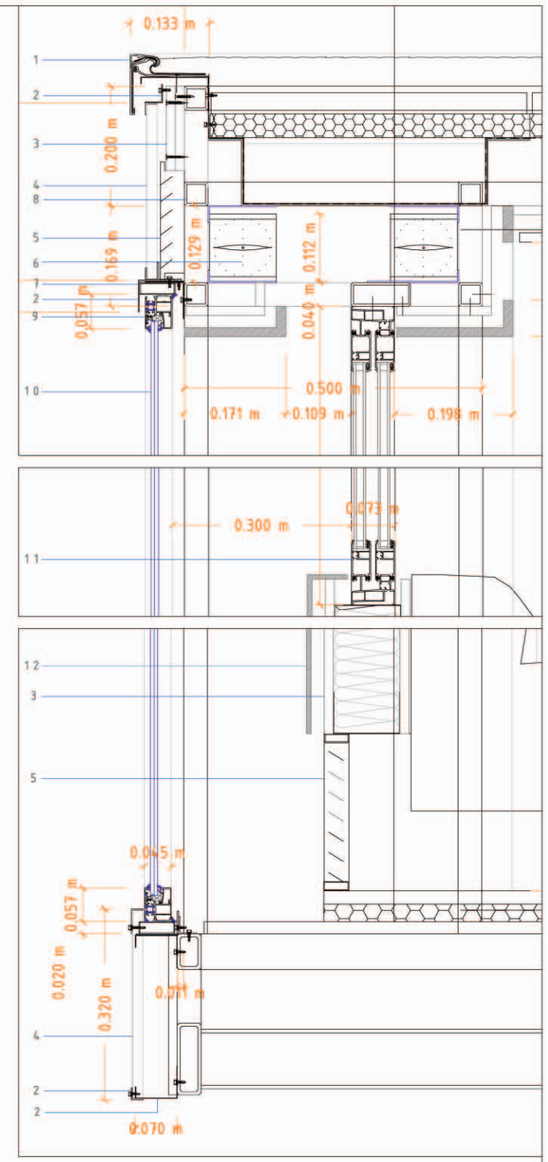


1. Sylicium PV cell
2. Galvanized steel angle
3. OSB panel
4. Wire Mesh
5. Aluminum grill
6. Aluminum lockgate
7. Stainless steel pre-frame
8. Steel structural tube
9. Aluminum frame
10. PV panel
11. Aluminum sliding frame
12. Wooden cladding
13. Aluminum frame
10. PV panel
11. Aluminum sliding frame
12. Wooden cladding
13. Steel plate

BC-47

DATE: 08.04.2005

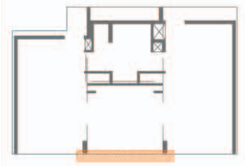

SEVERAL SCALES

SCALE 1:5
SCALE 1:10
SCALE 1:20
SCALE 1:30

SEVERAL SCALES

BC-47 06/07

GLAZING-FRAMING: PV SOUTH WALL

COORDINATORS SUPERVISORS DECATHLETES

DANIEL CARDOSO
plan designer

CARLOS BERMEJO
design coordinator

MIGUEL GOMEZ
general coordinator

idom

ANTONIO VILLANUEVA
IDOM industrial engineer

ALFONSO GARCIA-SANTOS
construction manager

JAVIER NEILA
architecture manager

ESTEFANIA CAAMAÑO
general coordinator

magic BOX

Universidad Politécnica de Madrid (UPM)