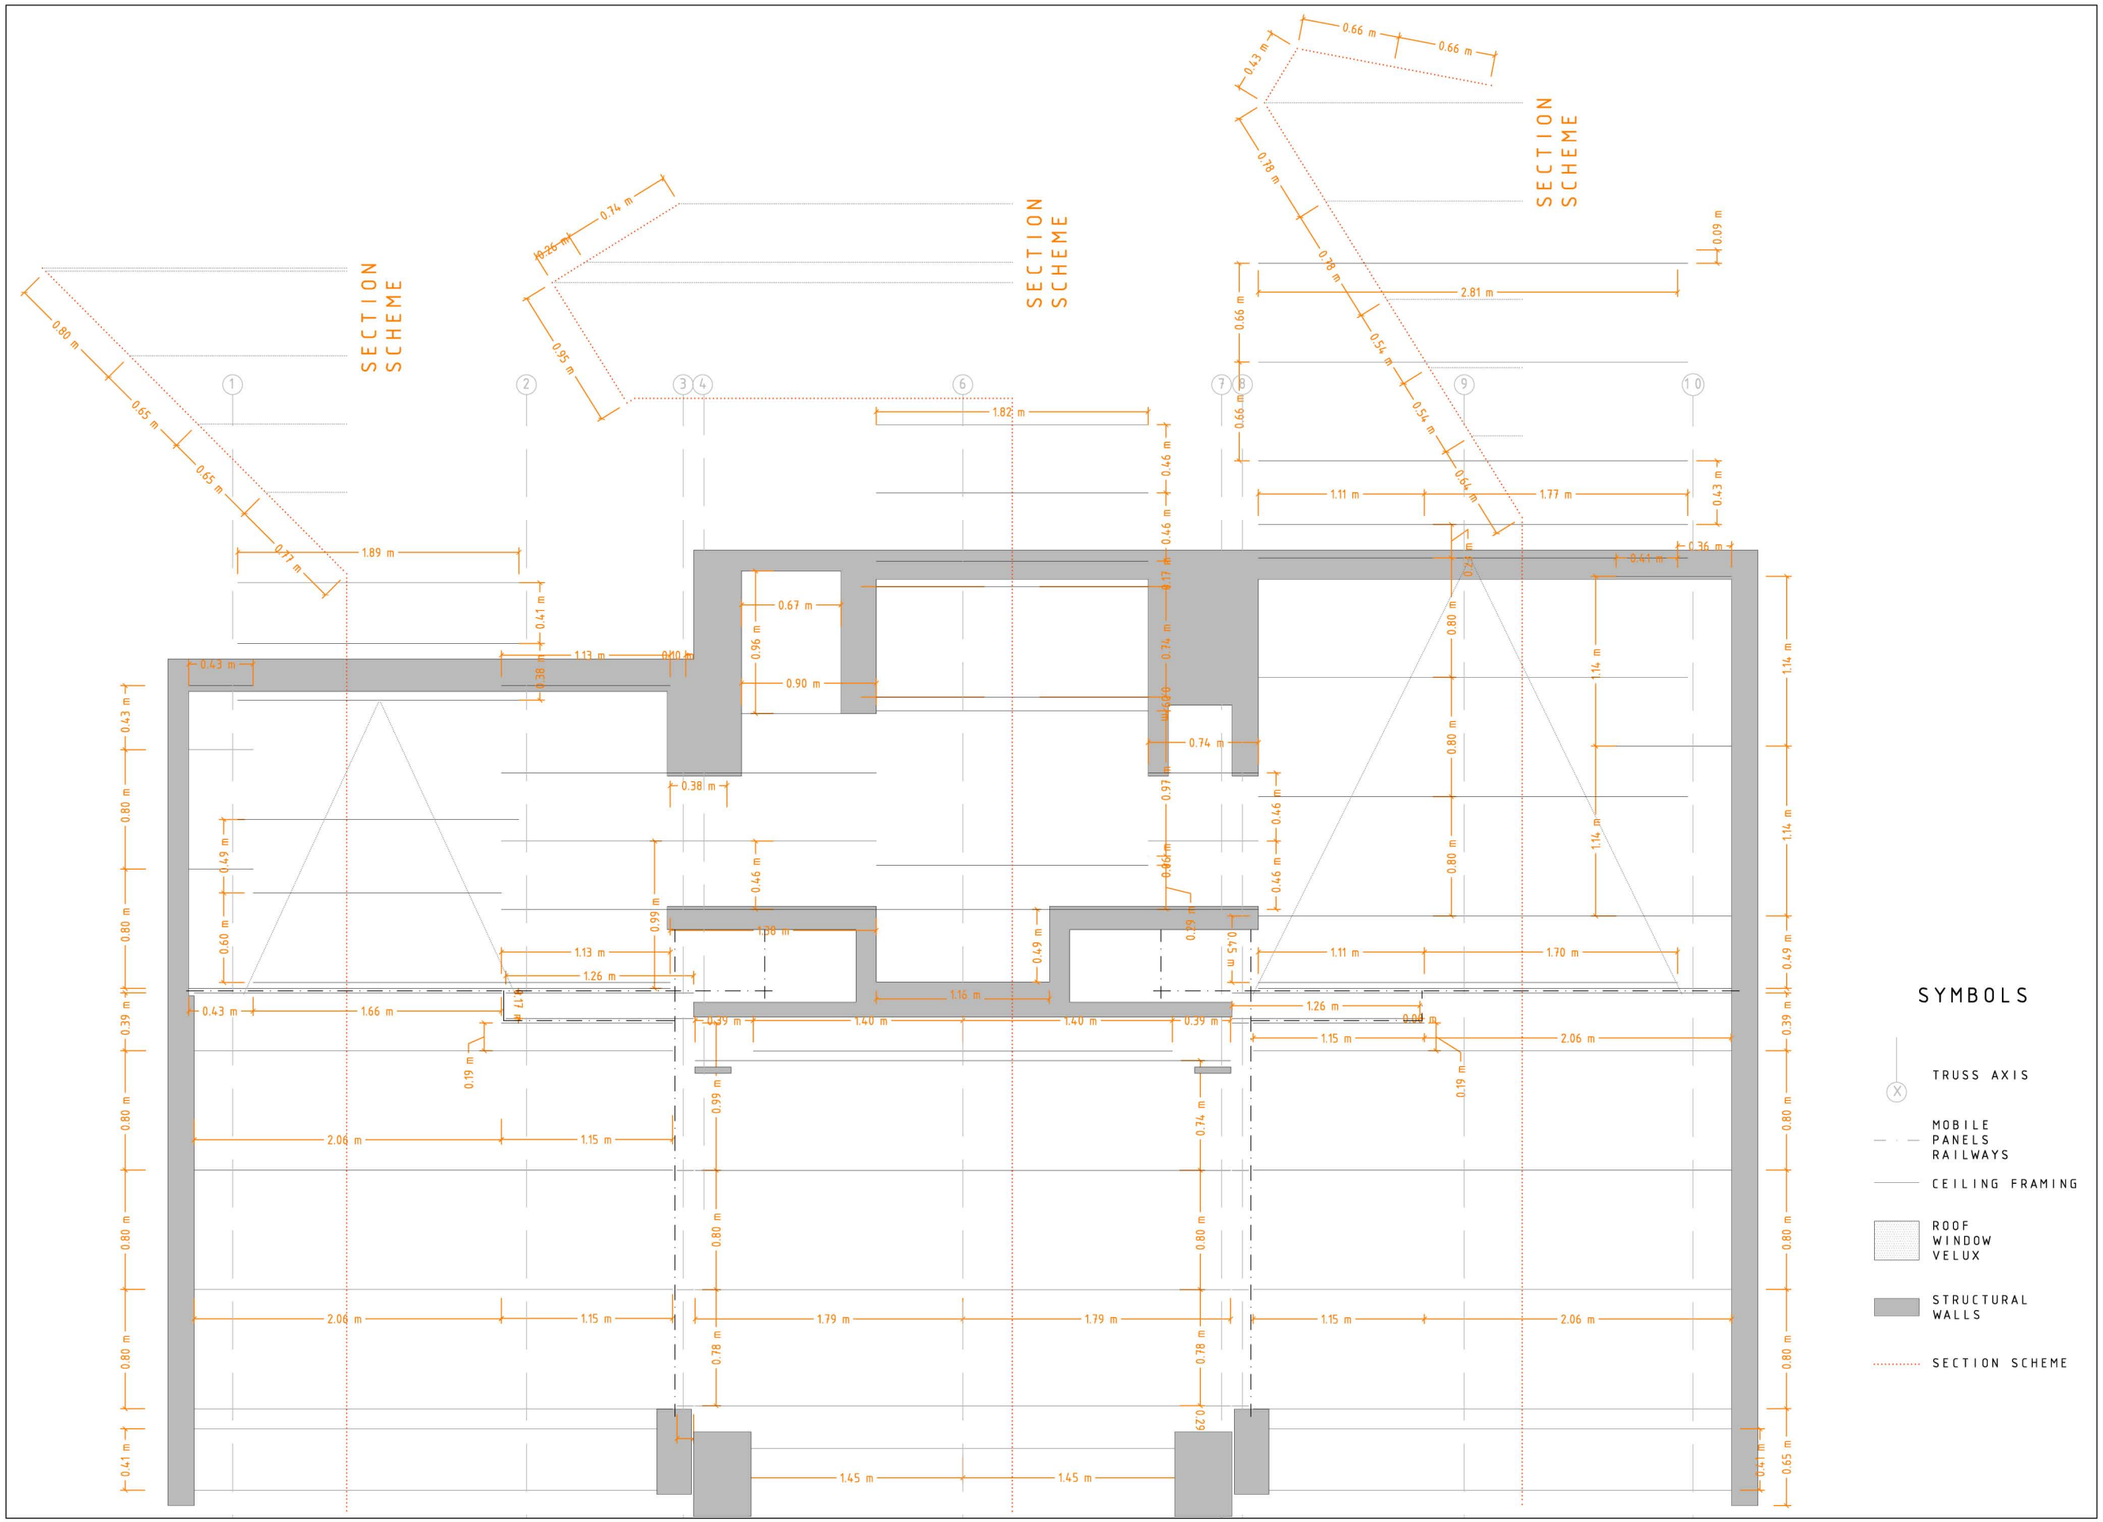

2005 UPM madrid
SOLAR DECATHLON

BC-39

DATE: 08.04.2005

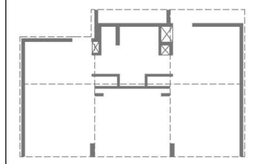

SCALE_1:40

0 0.5 1m

0 1 2 3ft

1:40

BC-39

02/03

DECATHLETES

RAFAEL PALOMARES
plan designer

CARLOS BERMEJO
design coordinator

MIGUEL GOMEZ
general coordinator

COORDINATORS

ALFONSO GARCIA-SANTOS
construction manager

JAVIER NEILA
architecture manager

ESTEFANIA CAAMAÑO
general coordinator

CEILING FRAMING

magic BOX
unfolding under the sun

Universidad Politécnica de Madrid (UPM)