UNFOLDED AND PULLED-UP LAYOUT




SECTION

E:1/15

UNFOLDED (NOT PULLED-UP) LAYOUT

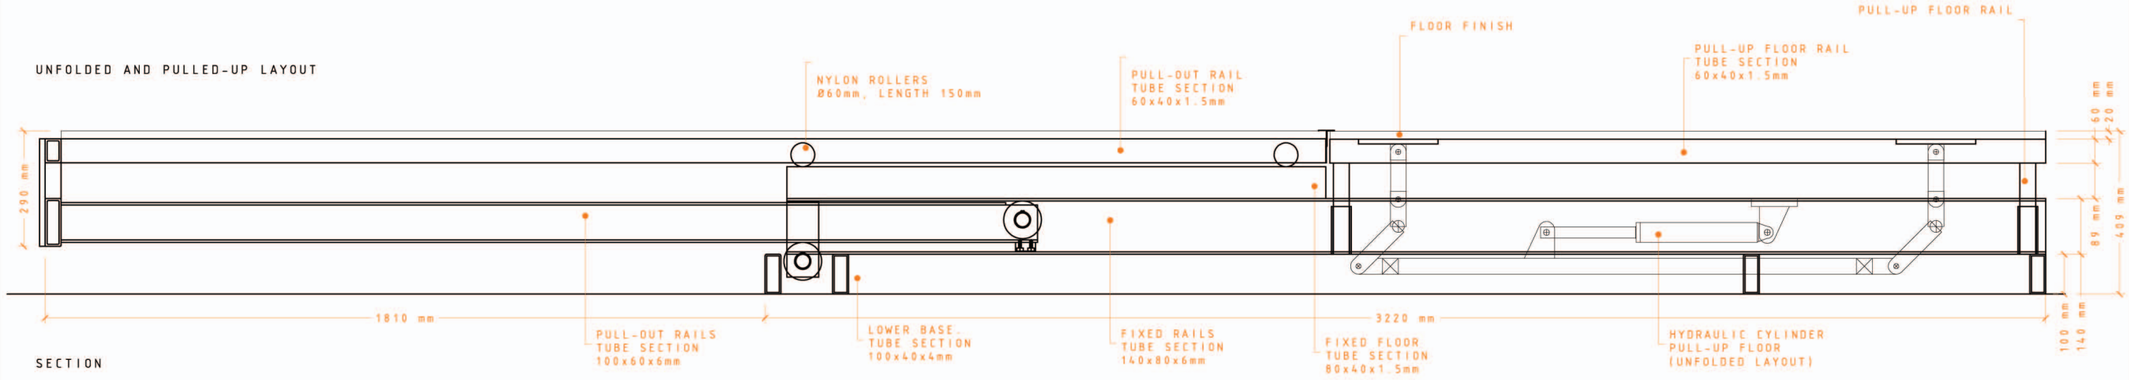


SECTION

E:1/15

FOLDED (NOT PULLED-UP) LAYOUT

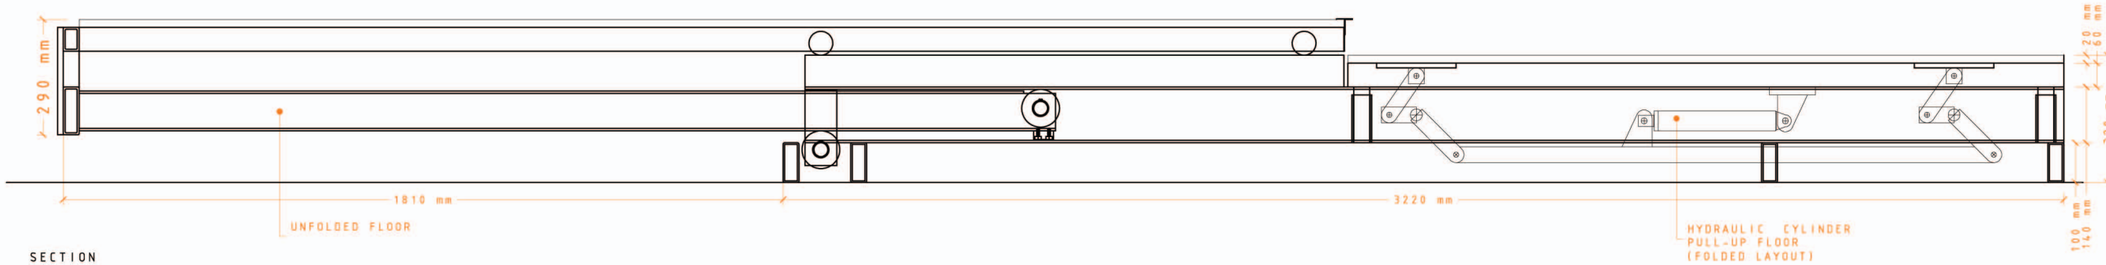


SECTION

E:1/10

2005 UPM madrid
SOLAR DECATHLON

S-19

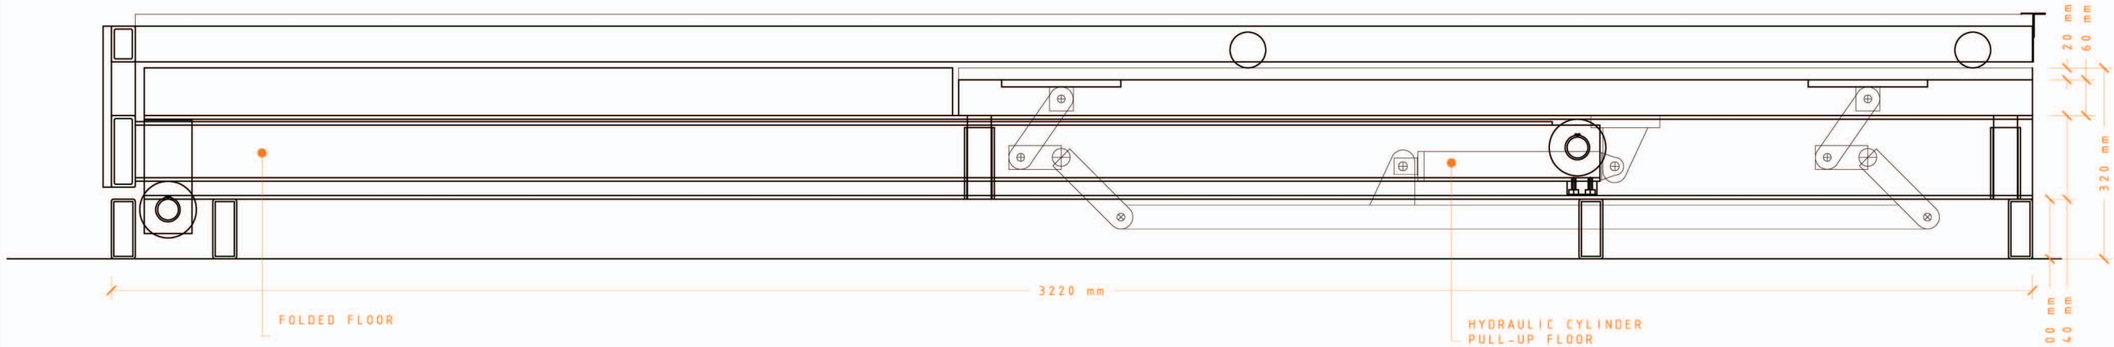DATE: 08.04.2005



04/06

S-19

SCALE_1:30

0 0.5 1m

0 1 2 3ft

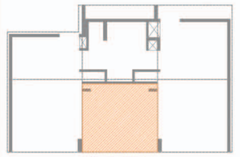1:30

DECATHLETES SUPERVISORS

JOAQUIN HIDALGO
plan designer

CARLOS BERMEJO
design coordinator

MIGUEL GOMEZ
general coordinator

JOE WORCESTER
professional engineer

COORDINATORS

ALFONSO GARCIA-SANTOS
construction manager

JAVIER NEILA
architecture manager

ESTEFANIA CAAMAÑO
general coordinator

MOVABLE MODULE

magic BOX
unfolding under the sun

Universidad Politécnica de Madrid (UPM)