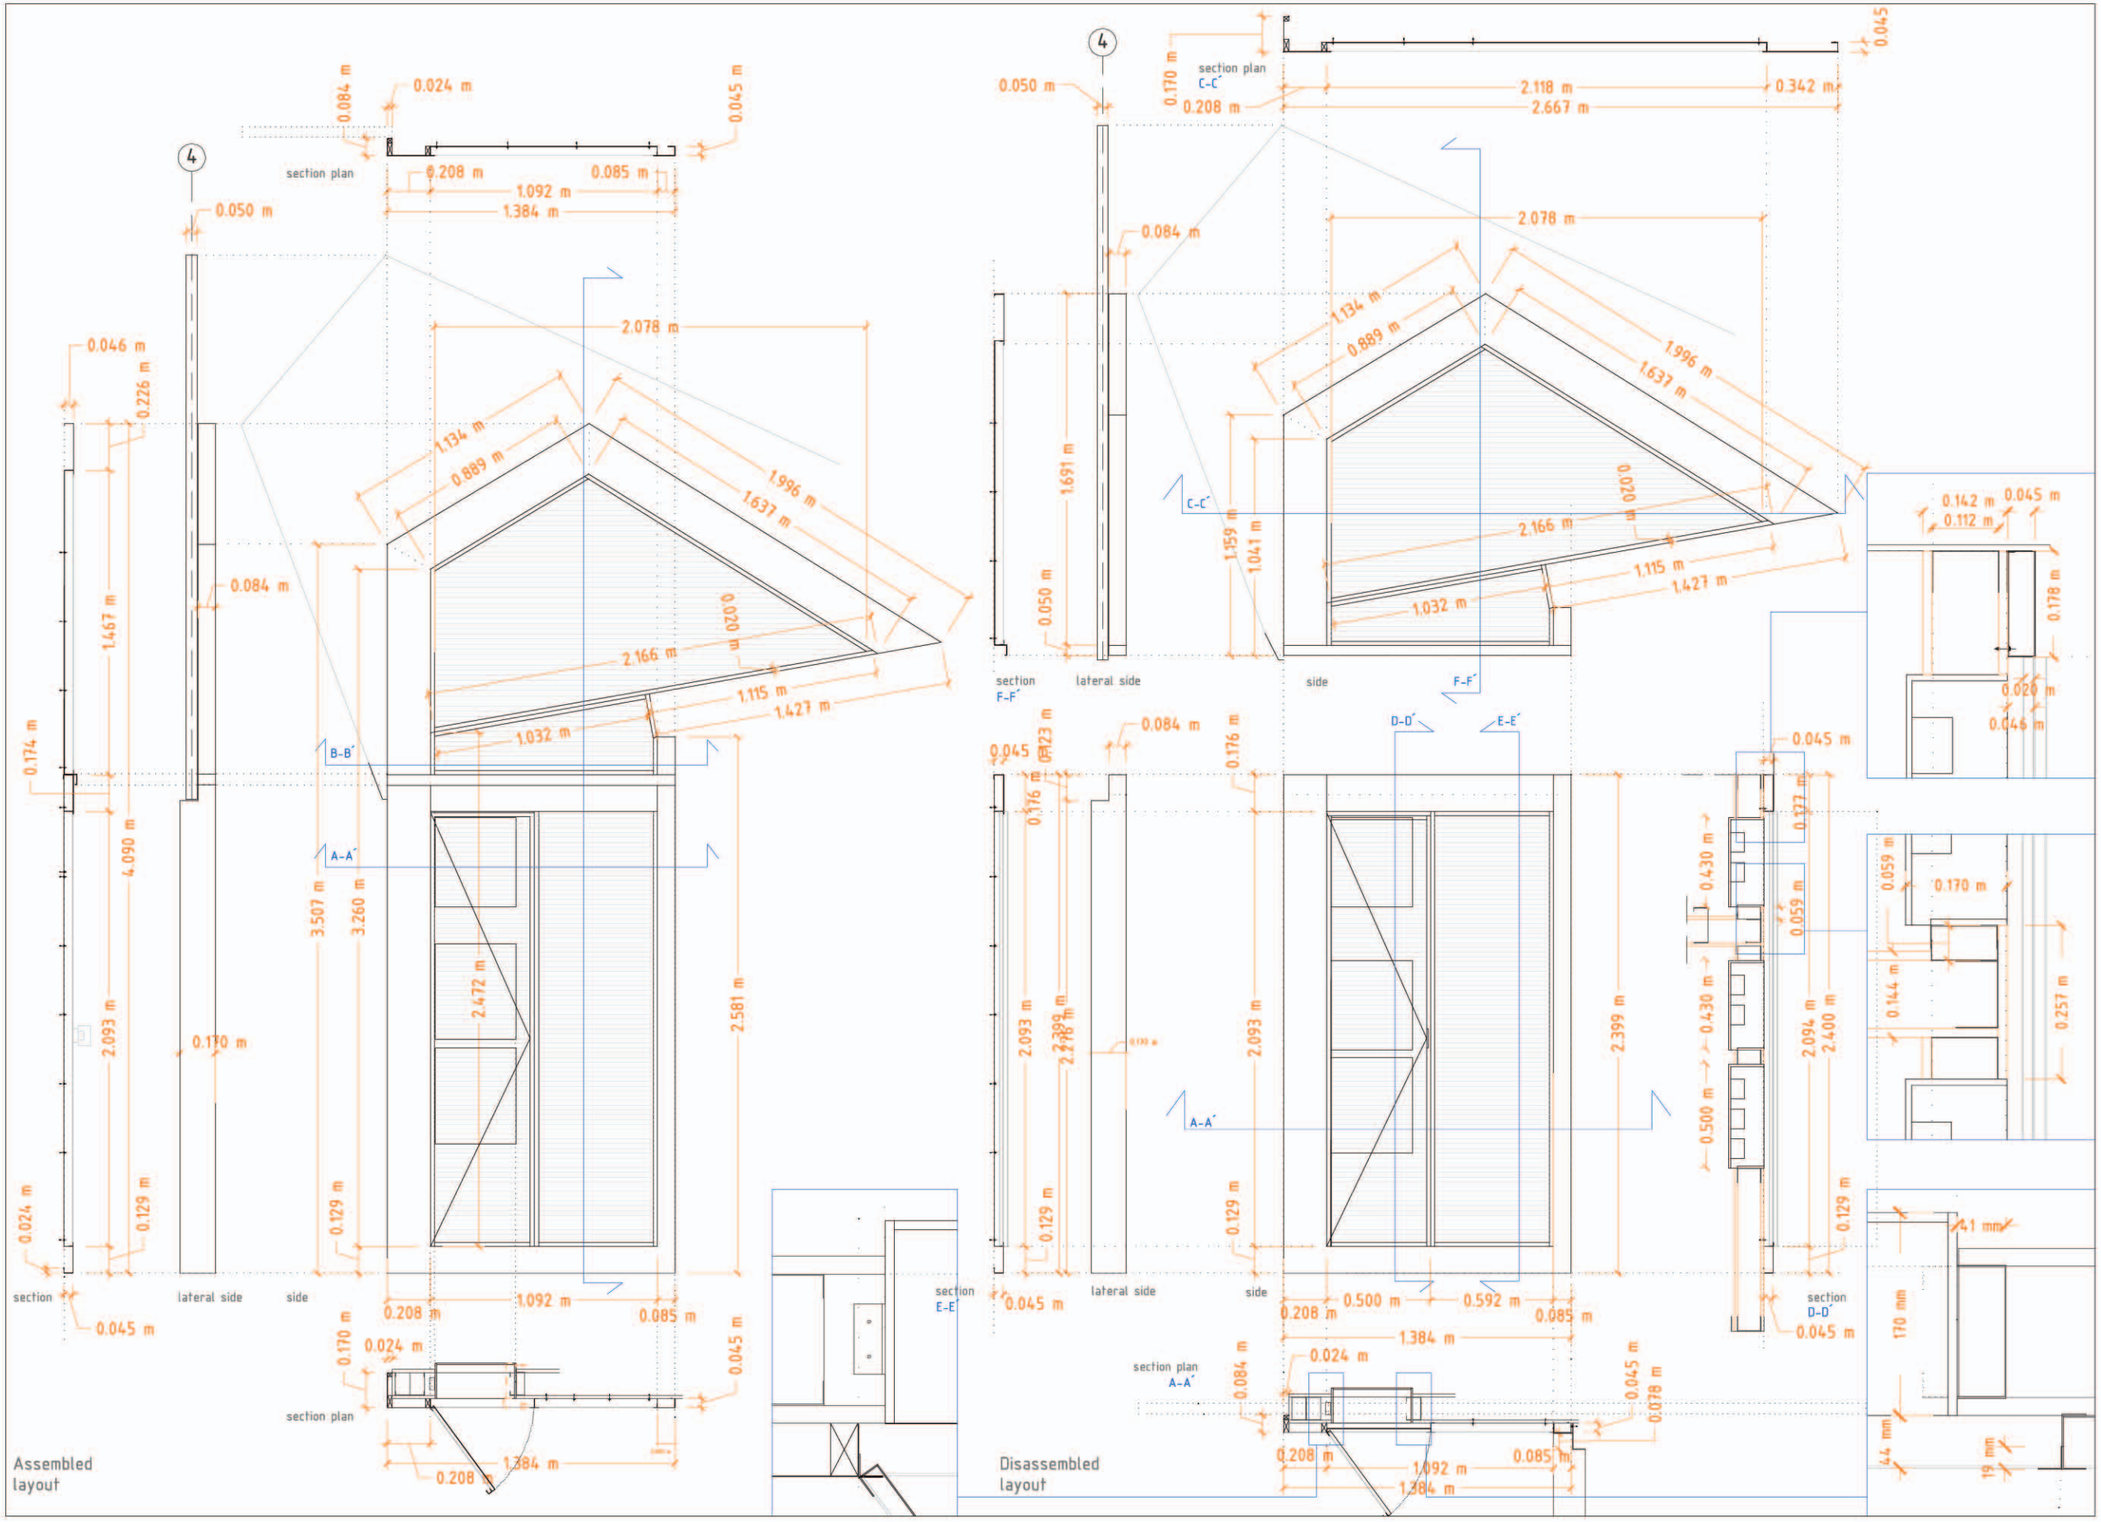

2005 UPM

BC-44

DATE: 08.04.2005

SEVERAL SCALES

SCALE_1:5
SCALE_1:10
SCALE_1:30

COORDINATORS SUPERVISORS DE CATHLETES

DANIEL CARDOSO
plan designer

CARLOS BERMEJO
design coordinator

MIGUEL GOMEZ
general coordinator

ALFONSO GARCIA-SANTOS
construction manager

JAVIER NEILA
architecture manager

ESTEFANIA CAAMAÑO
general coordinator

BC-44 03/04

SEVERAL SCALES

EXT.FINISH:PV-EQUIPMENT ROOM

magic BOX

Universidad Politécnica de Madrid (UPM)