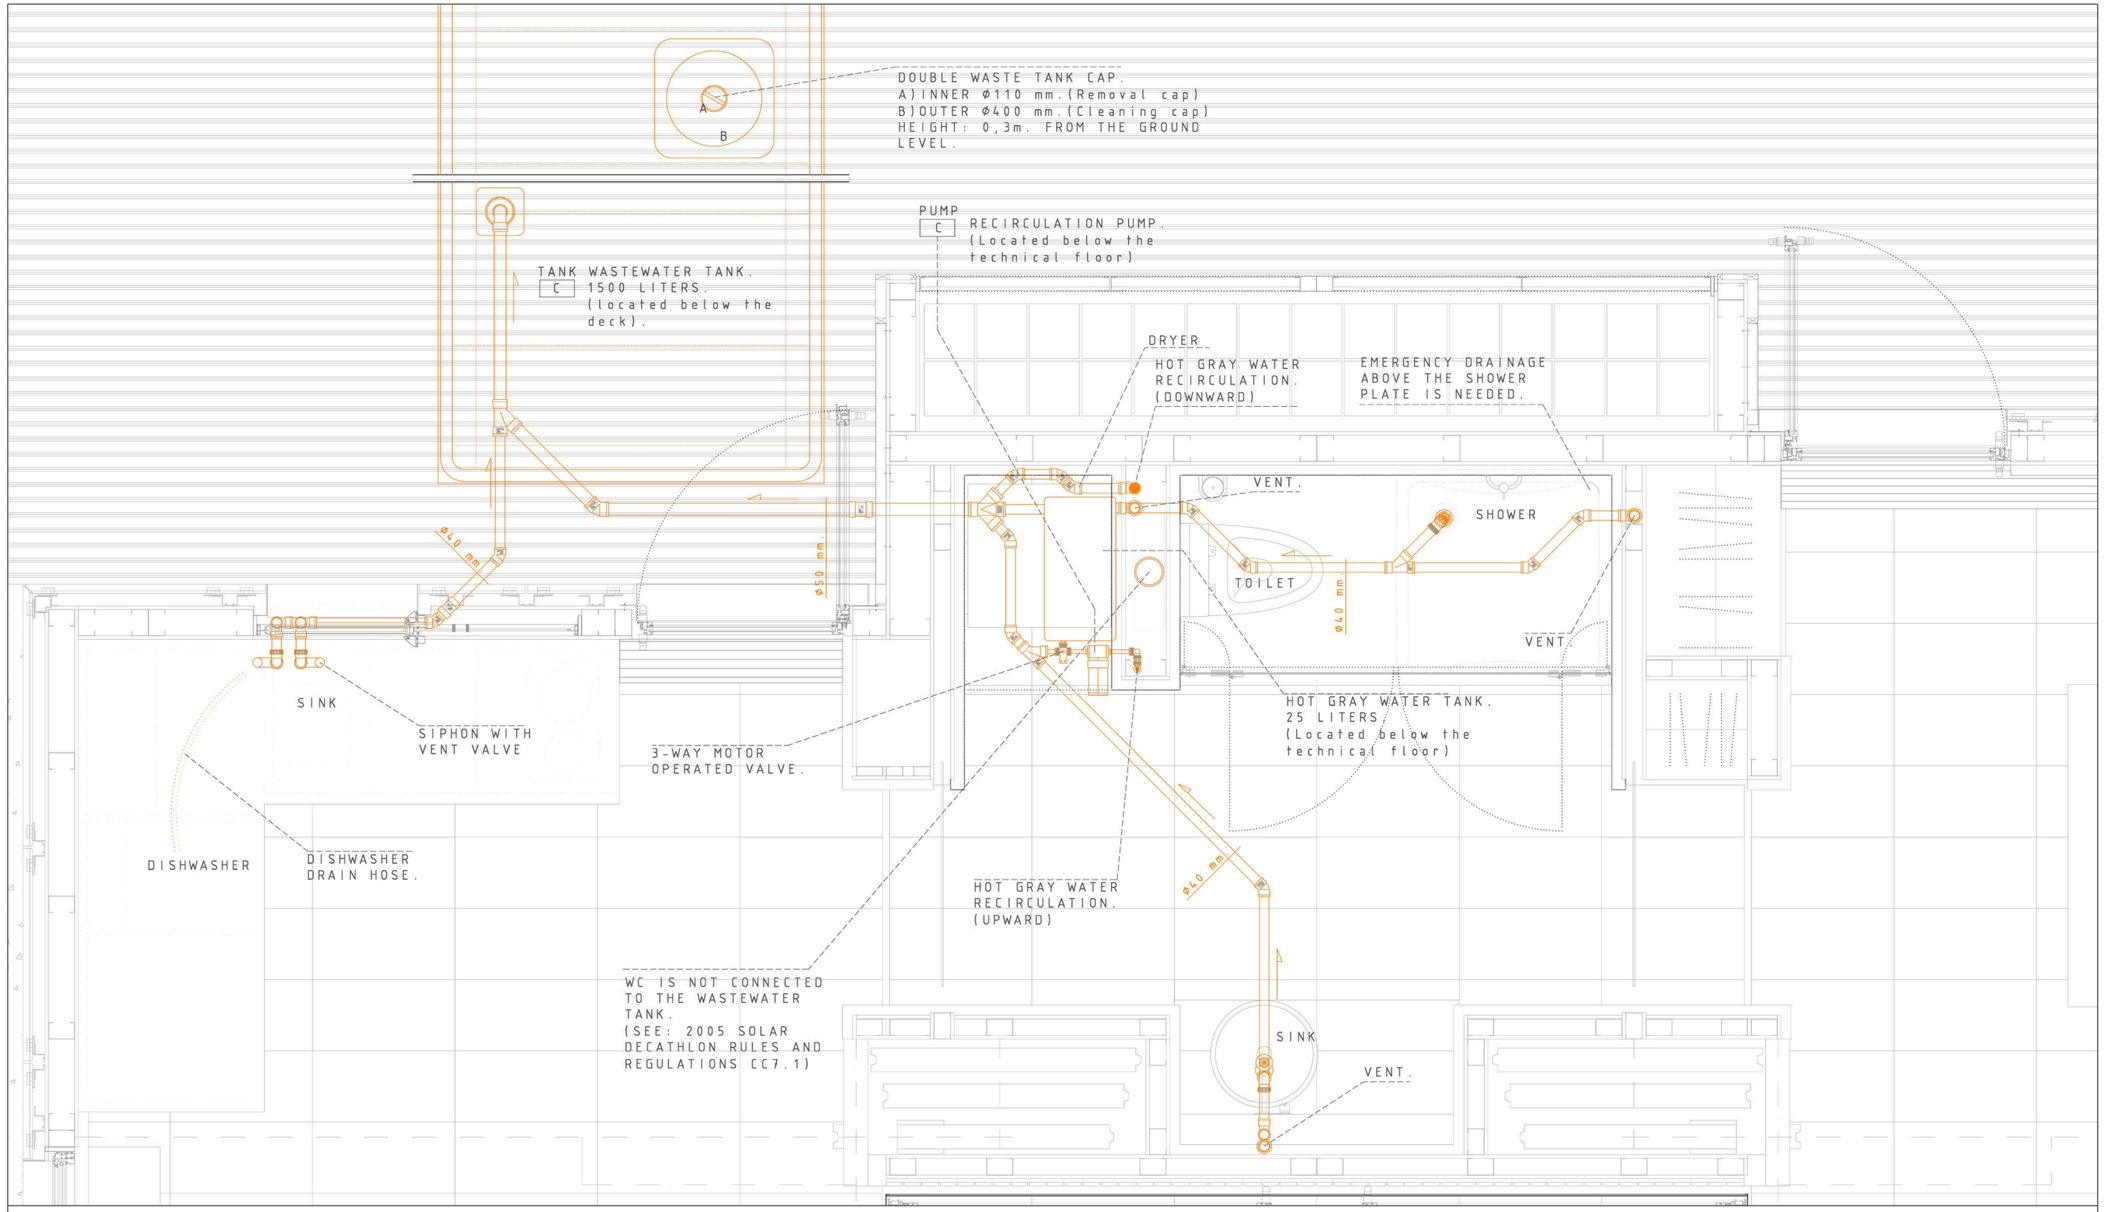

GRAY WATER DISPOSAL SYSTEM IN DETAIL.

PVC. Drains assembly is made with PVC pipes and PVC parts.

NUEVA TERRAIN RANGE AND DIMENSIONS. DRAINAGE PARTS.

PVC PIPES. SOIL APPLICATION.

References	Nominal diameter D.N.	Colour RAL 7003	E	Weight pipe kg	Total length pipe m
200.32.30	32	Grey	3,0	1,215	3
200.32.58	32	Grey	3,0	2,349	5,8
200.32.58.10	32	White	3,0	2,349	5,8
200.40.30	40	Grey	3,0	1,551	3
200.40.58	40	Grey	3,0	2,998	5,8
200.40.58.10	40	White	3,0	2,998	5,8
200.50.30	50	Grey	3,0	1,970	3
200.50.58	50	Grey	3,0	3,809	5,8
100.83.30**	83	Grey	3,2	3,549	3
100.83.58**	83	Grey	3,2	6,861	5,8
100.110.30	110	Grey	3,2	4,860	3
100.110.58	110	Grey	3,2	9,396	5,8

PVC ELBOW.

References	Nominal diameter N.D.	Colour	Weight part	Mouth type	Angle α°	A	B
201.32.92	32	Grey	51	H-H	91 1/4	25	25
201.32.135	32	Grey	45	H-H	135	15	15
201.32.92.10	32	White	51	H-H	91 1/4	25	21
201.32.135.10	32	White	45	H-H	135	15	15
201.40.92	40	Grey	70	H-H	91 1/4	39	39
201.40.135	40	Grey	56	H-H	135	11	11
201.40.92.10	40	White	70	H-H	91 1/4	39	39
201.40.135.10	40	White	56	H-H	135	11	11
201.50.92	50	Grey	109	H-H	91 1/4	41,5	41,5
201.50.135	50	Grey	88	H-H	135	17	17
101.83.92	83	Grey	329	H-H	92 1/2	94	94
101.83.135	83	Grey	243	H-H	135	25,5	25,5
101.110.92	110	Grey	475	H-H	92 1/2	107	100
101.110.92.10	110	White	475	H-H	92 1/2	107	100
101.110.135	110	Grey	349	H-H	135	30	30
101.110.135.10	110	White	349	H-H	135	30	30

PVC SINGLE BRANCH.

References	Nominal diameter N.D.	Colour	Weight part	Mouth type	Angle α°	A	B	C
204.32.135	32	Grey	79	H-H	135	44,5	44,5	11,5
204.32.40.135	32 X 40	Grey	82	H-H	135	44,5	44,5	7,5
204.32.135.10	32	White	79	H-H	135	44,5	44,5	11,5
204.40.92	40	Grey	95	H-H	91 1/4	35	20	35
204.40.135	40	Grey	107	H-H	135	53	53	14
204.40.92.10	40	White	95	H-H	91 1/4	35	20	35
204.40.135.10	40	White	107	H-H	135	53	53	14
204.50.92	50	Grey	154	H-H	91 1/4	41,5	26	44
204.50.135	50	Grey	166	H-H	135	65	62	17
104.83.92	83	Grey	495	H-H	92 1/2	88	35	70
104.83.135	83	Grey	494	H-H	135	108	101,5	19
104.110.92	110	Grey	655	H-H	92 1/2	101,5	45	104
104.110.135	110	Grey	746	H-H	135	136.5	136.5	26

VENT SYSTEM IN DETAIL

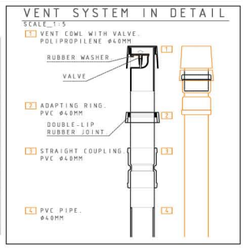

P-55

DATE: 08.04.2005

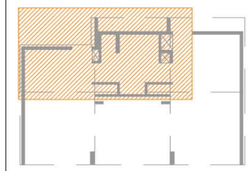

SCALE_1:25

0 0.5 0.75m

0 1 2 2.5ft

1:25

P-55 04/07

PLUMBING DRAWINGS. DRAINS.

ATHLETES
SOFIA MELERO
GONZALO USED
plan designer
CARLOS BERMEJO
design coordinator
MIGUEL GOMEZ
general coordinator

SUPERVISORS DECATHLON
idom ENGINEERING, ARCHITECTURE AND CONSULTING
ANTONIO VILLANUEVA
IDOM/professional supervisor

COORDINATORS
ALFONSO GARCIA-SANTOS
construction manager
JAVIER NEILA
architecture manager
ESTEFANIA CAAMAÑO
general coordinator

magic BOX
unfolding under the sun
Universidad Politécnica de Madrid (UPM)