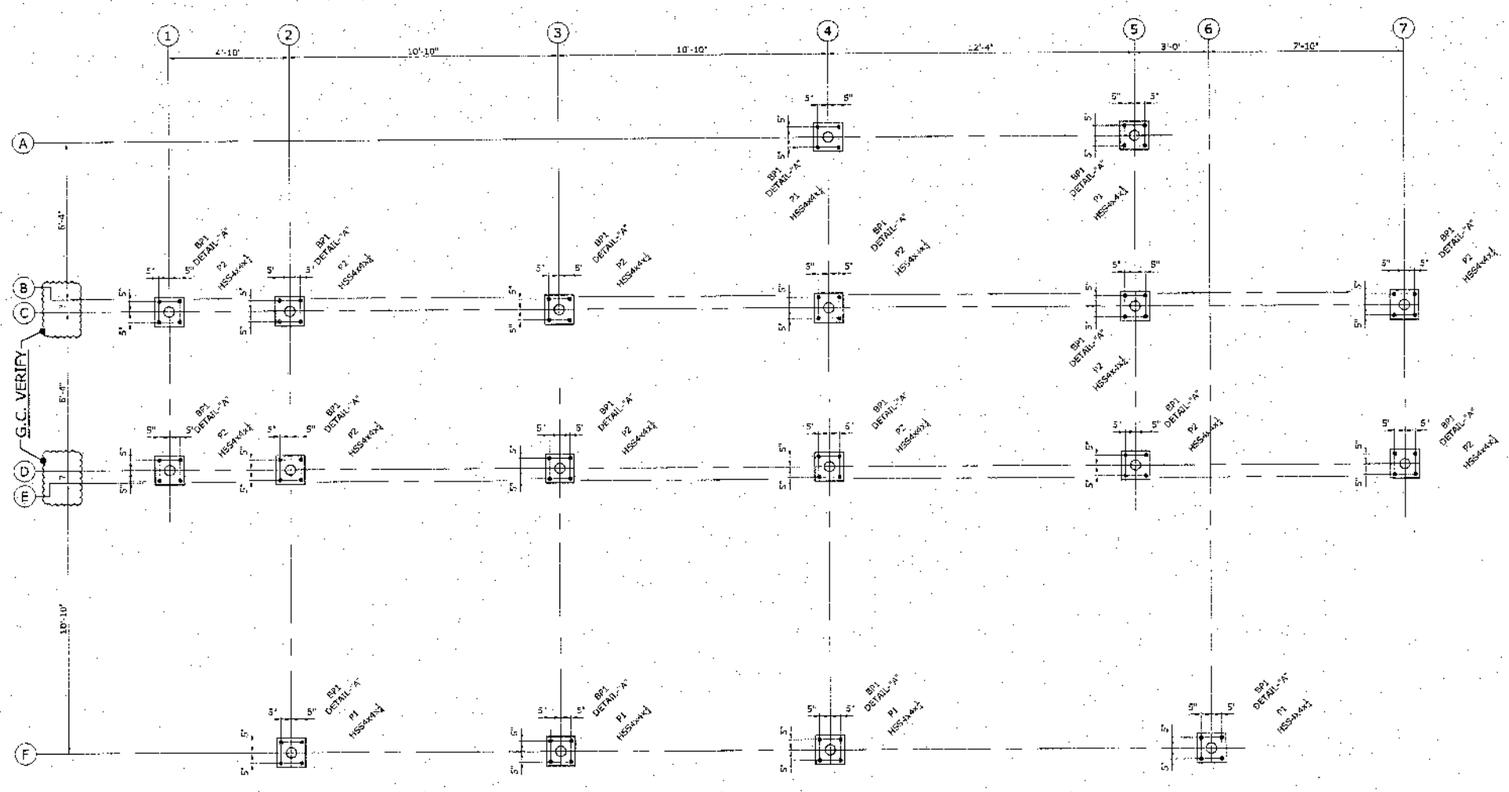

ANCHOR BOLT SETTING PLAN

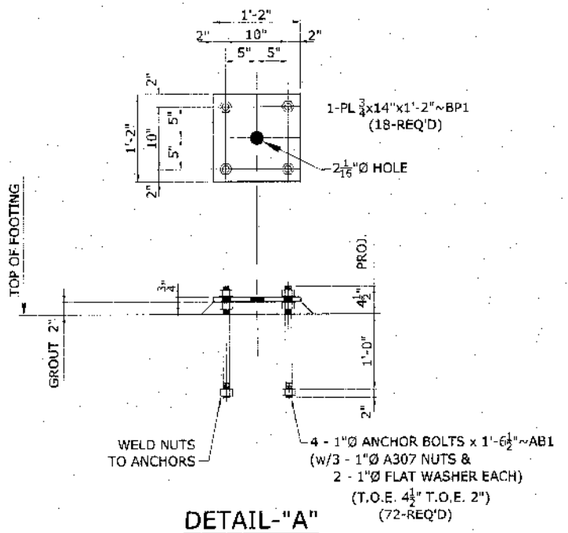

DETAIL-"A"

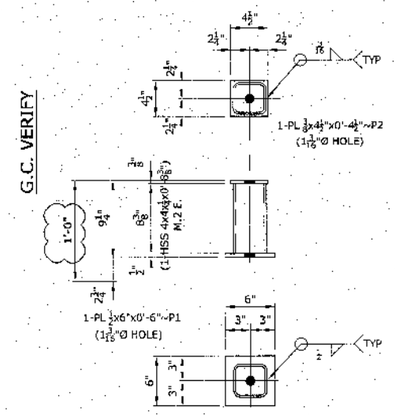

6-POSTS~P1

6-1"Ø A325 BOLTS x 11" (FIELD)
6-1"Ø A325 NUTS (FIELD)
6-1"Ø HD. WASHERS (FIELD)

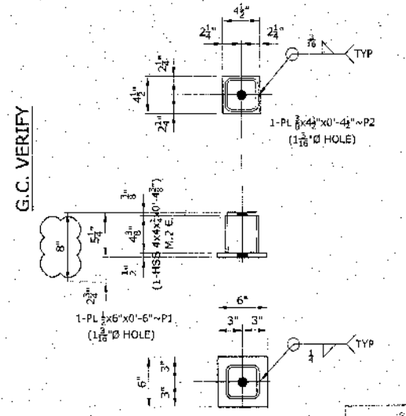

12-POSTS~P2

12-1"Ø A325 BOLTS x 6" (FIELD)
12-1"Ø A325 NUTS (FIELD)
12-1"Ø HD. WASHERS (FIELD)

ISSUED FOR APPROVAL ONLY
MOORE & MORFORD, INC.

Caycon Construction, Inc.
DATE 9-24 By Ron Sears

B P	A B	P	MOORE & MORFORD INC. GREENSBURG, PA. 15601
1	1	1	
		2	JOB POWDER MILL MODULAR BUILDING
			LOCATION RECTOR, PA.
			PURCHASER CAYCON CONSTRUCTION
			ARCHITECT
			DESCRIPTION ANCHOR BOLT PLAN & DETAILS
			DR. PGM 9-21-07 HOLES AS NOTED
			CH. JPM 9-24-07 HSS = A500-B
			WELD: LHE70T-4 MATERIAL PL's & L's = A36
			BOLTS AS NOTED
			PAINT ONE - SHOP COAT SHERWIN WILLIAMS B50NV2002 HOT DIP GALV.
			S.O. NO. S88739 SHEET NO. 1 OF